


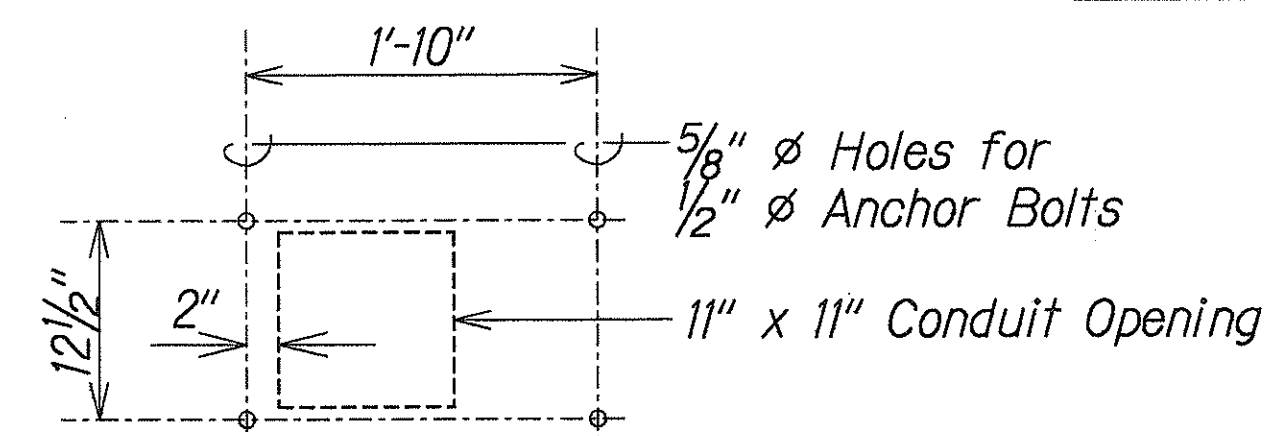
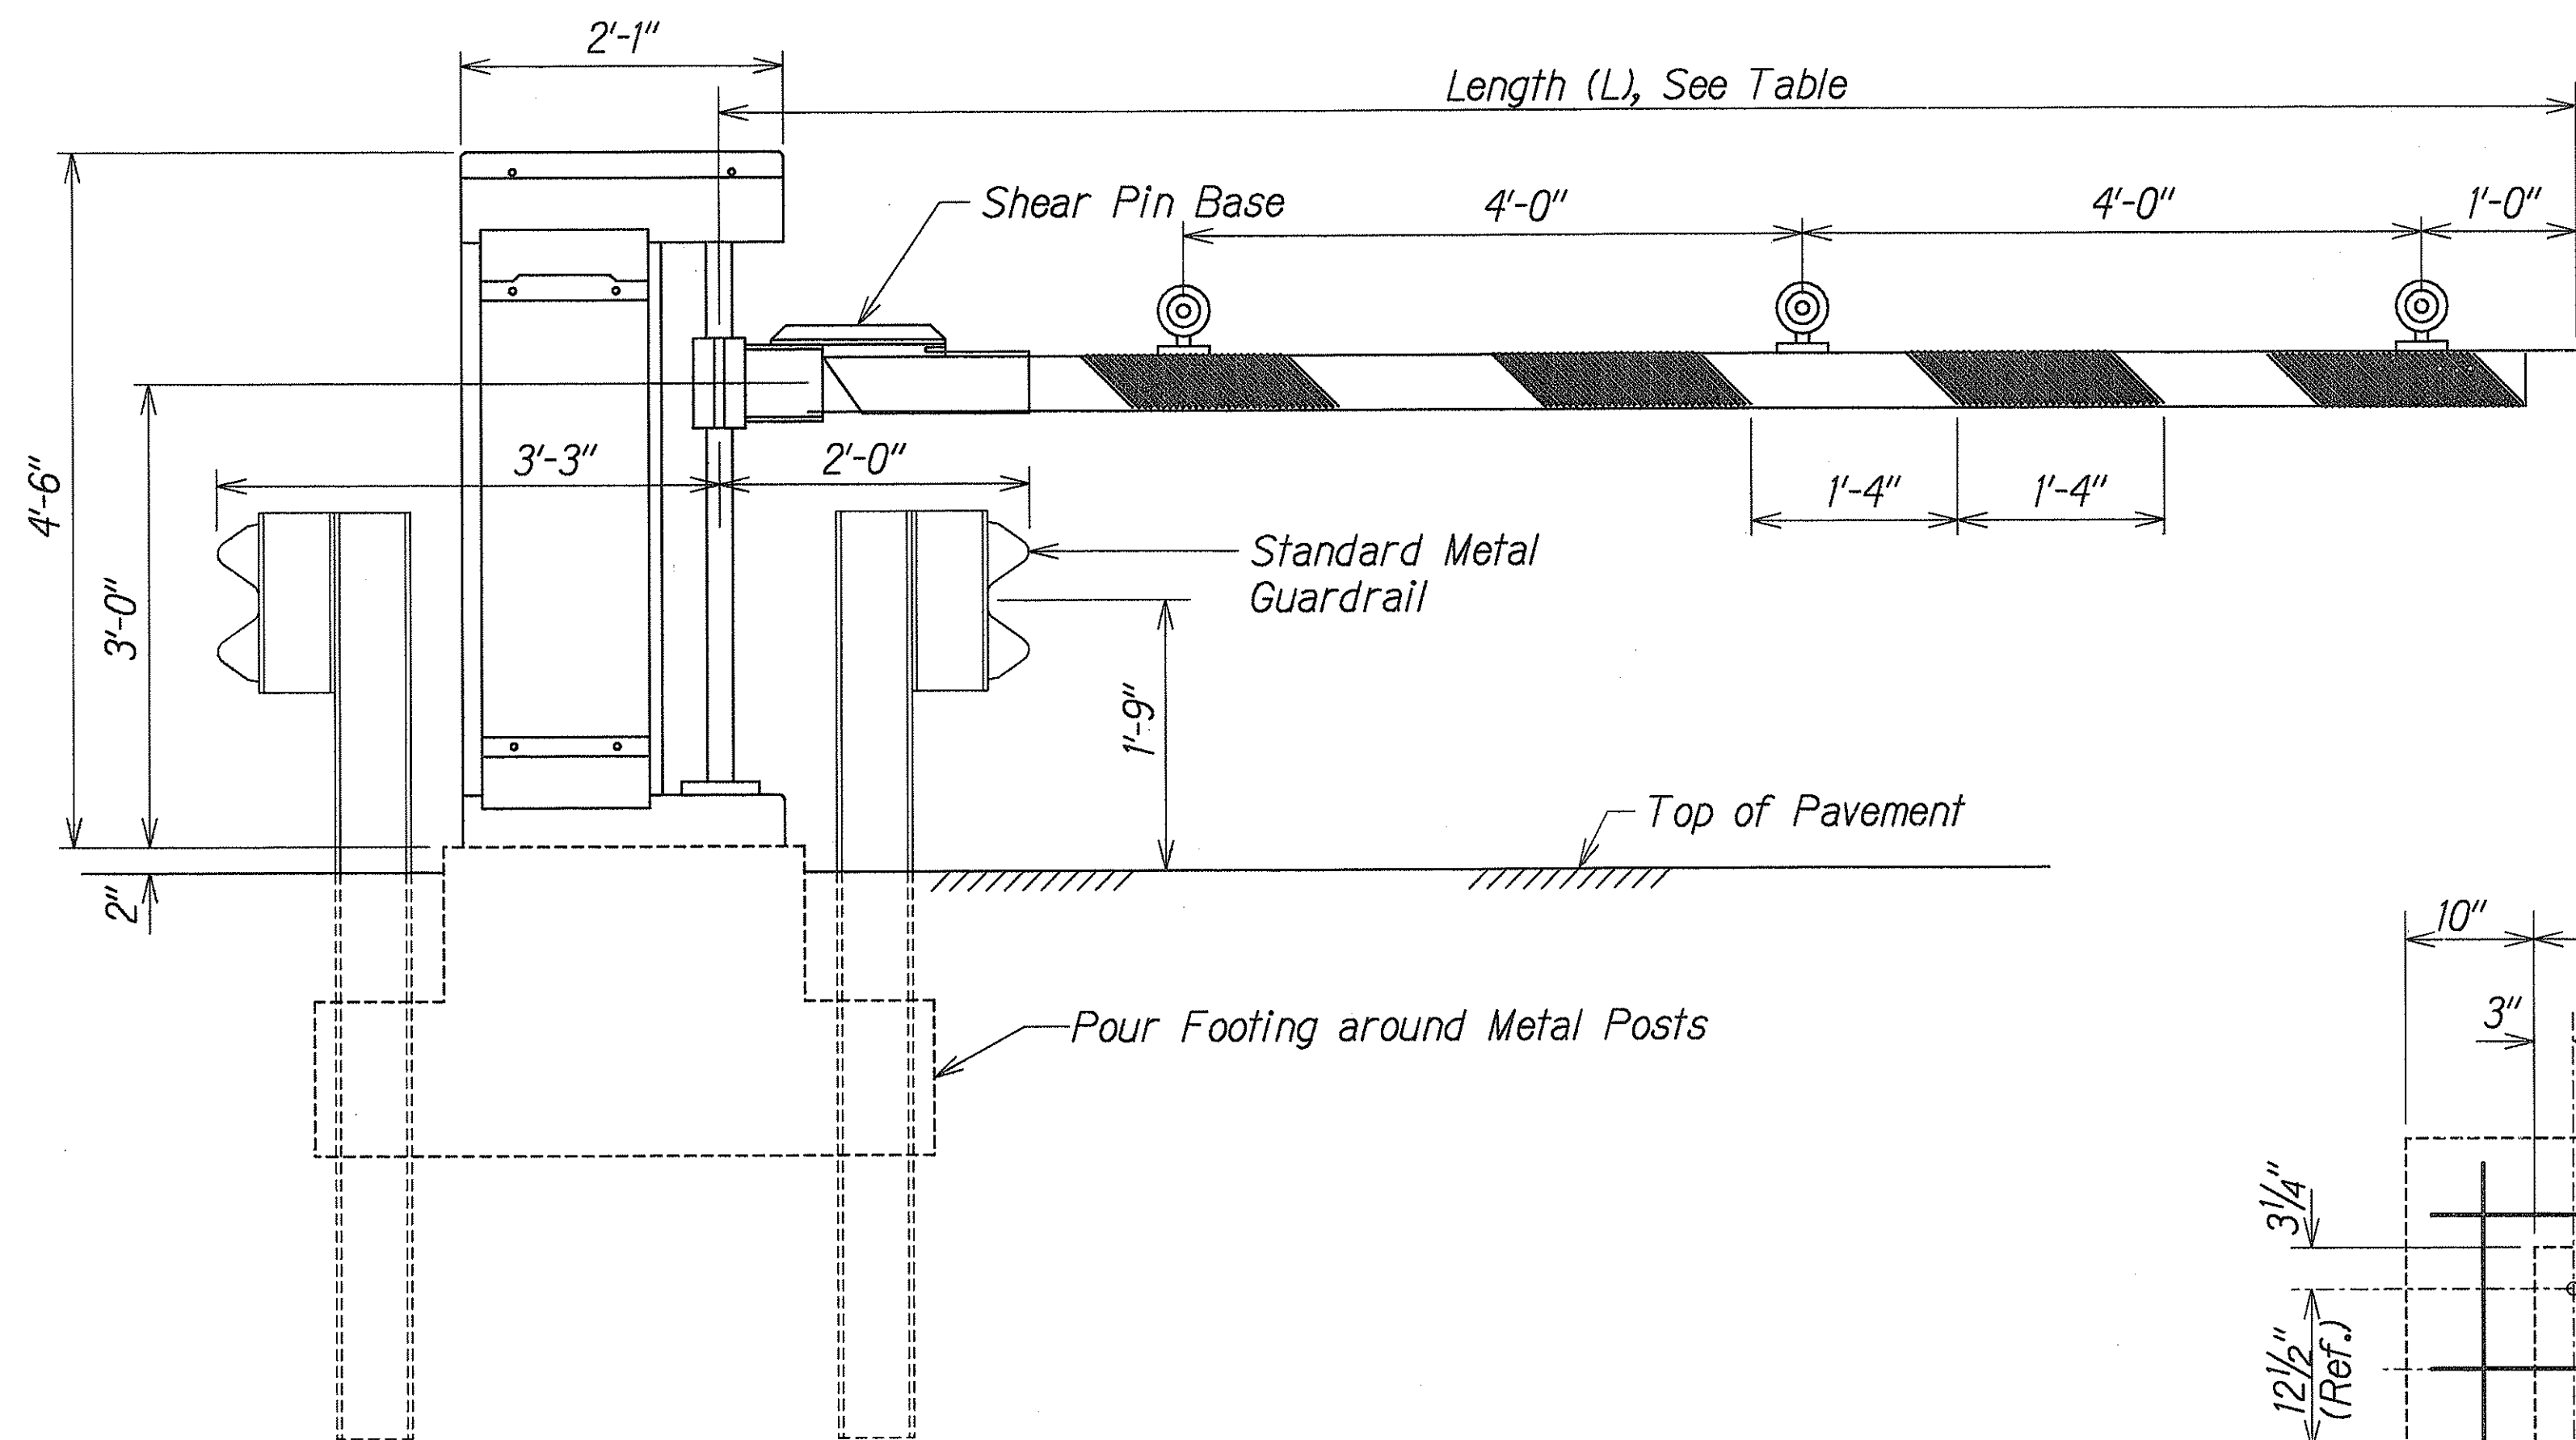
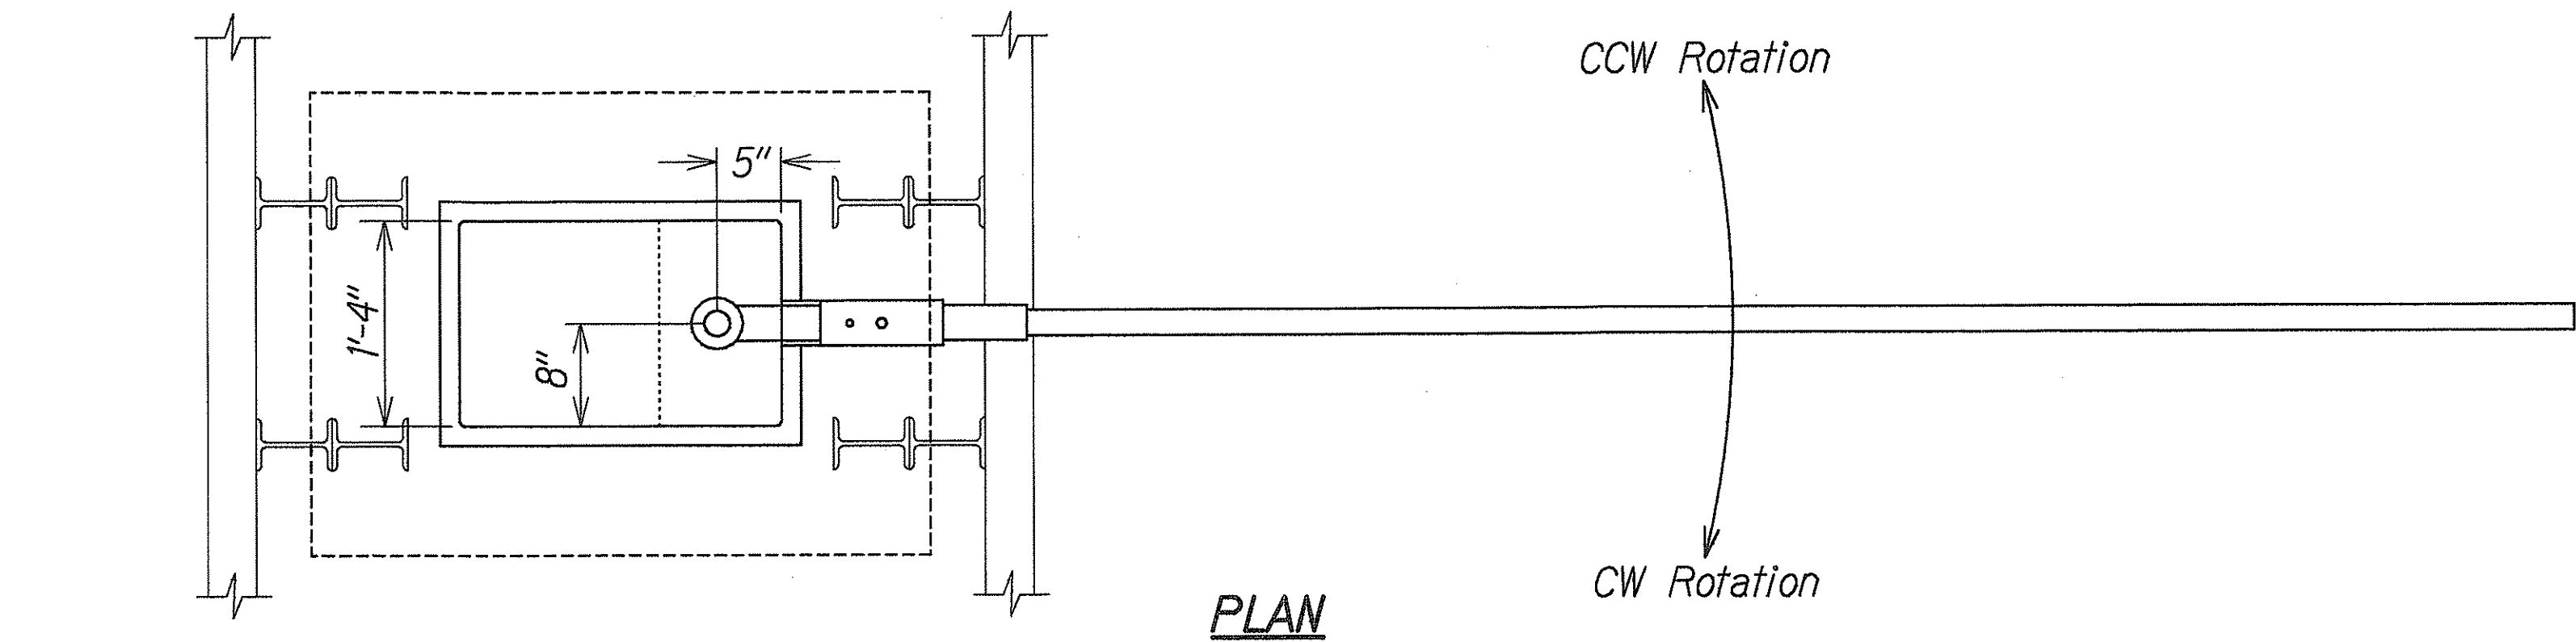


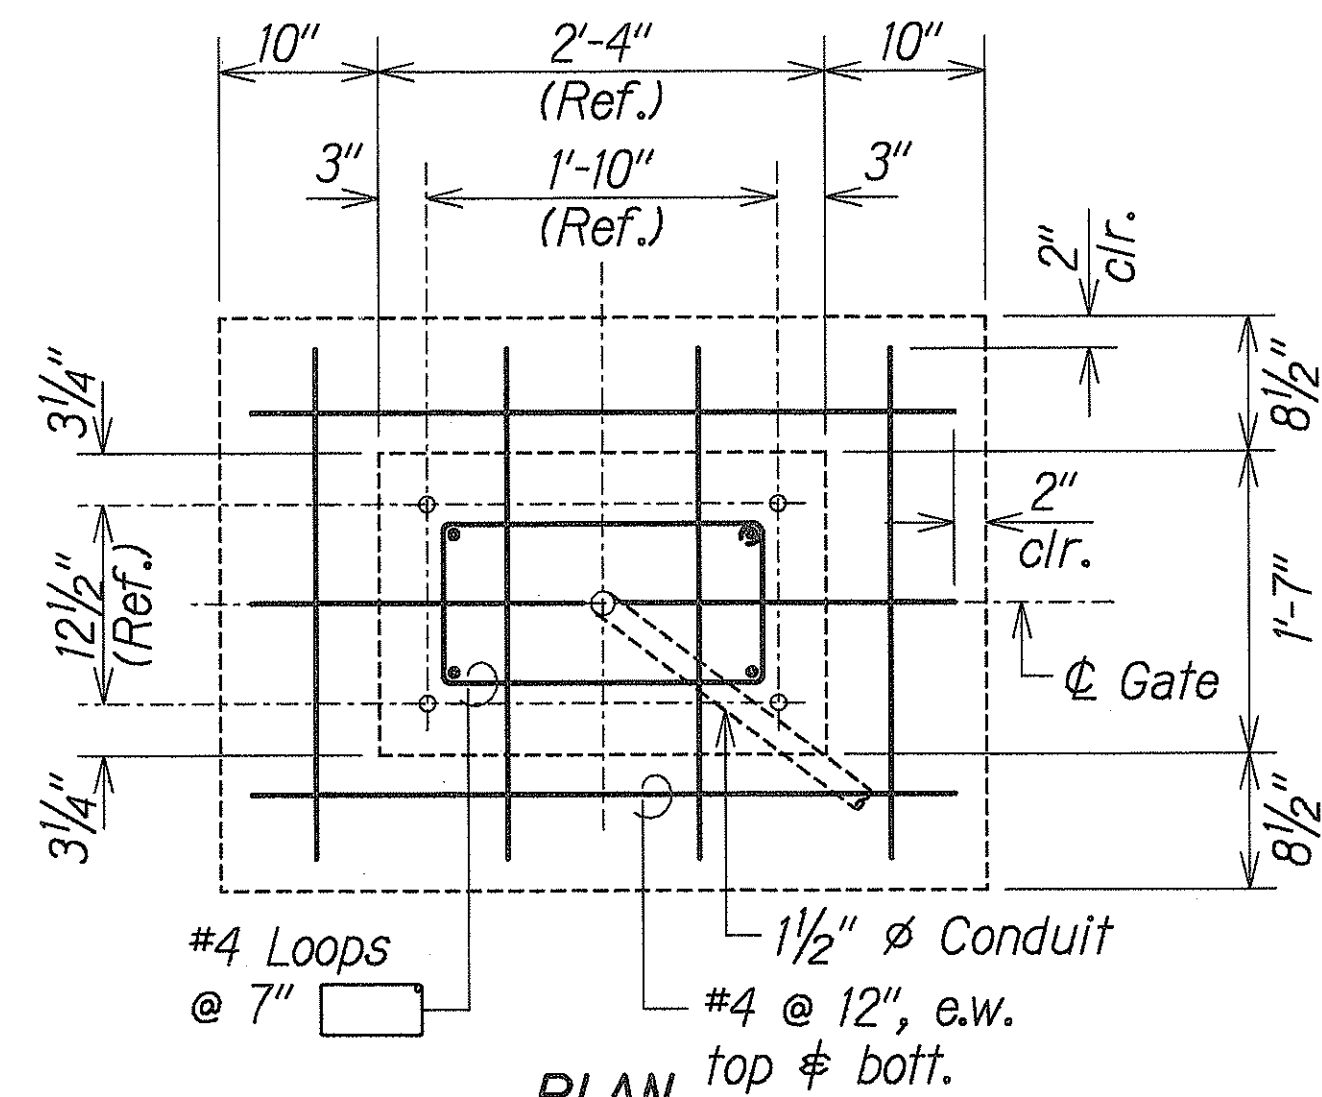

GATE STAND DETAIL 2
Scale: 1" = 1'-0" DT4DT4

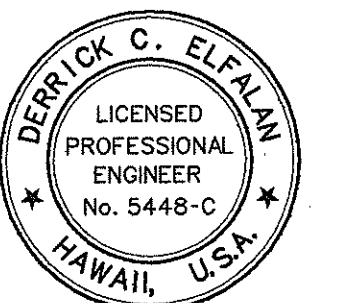

SWING GATE INSTALLATION DETAIL 1
Scale: 1" = 1'-0" F1 to F4, F6, F7 DT4

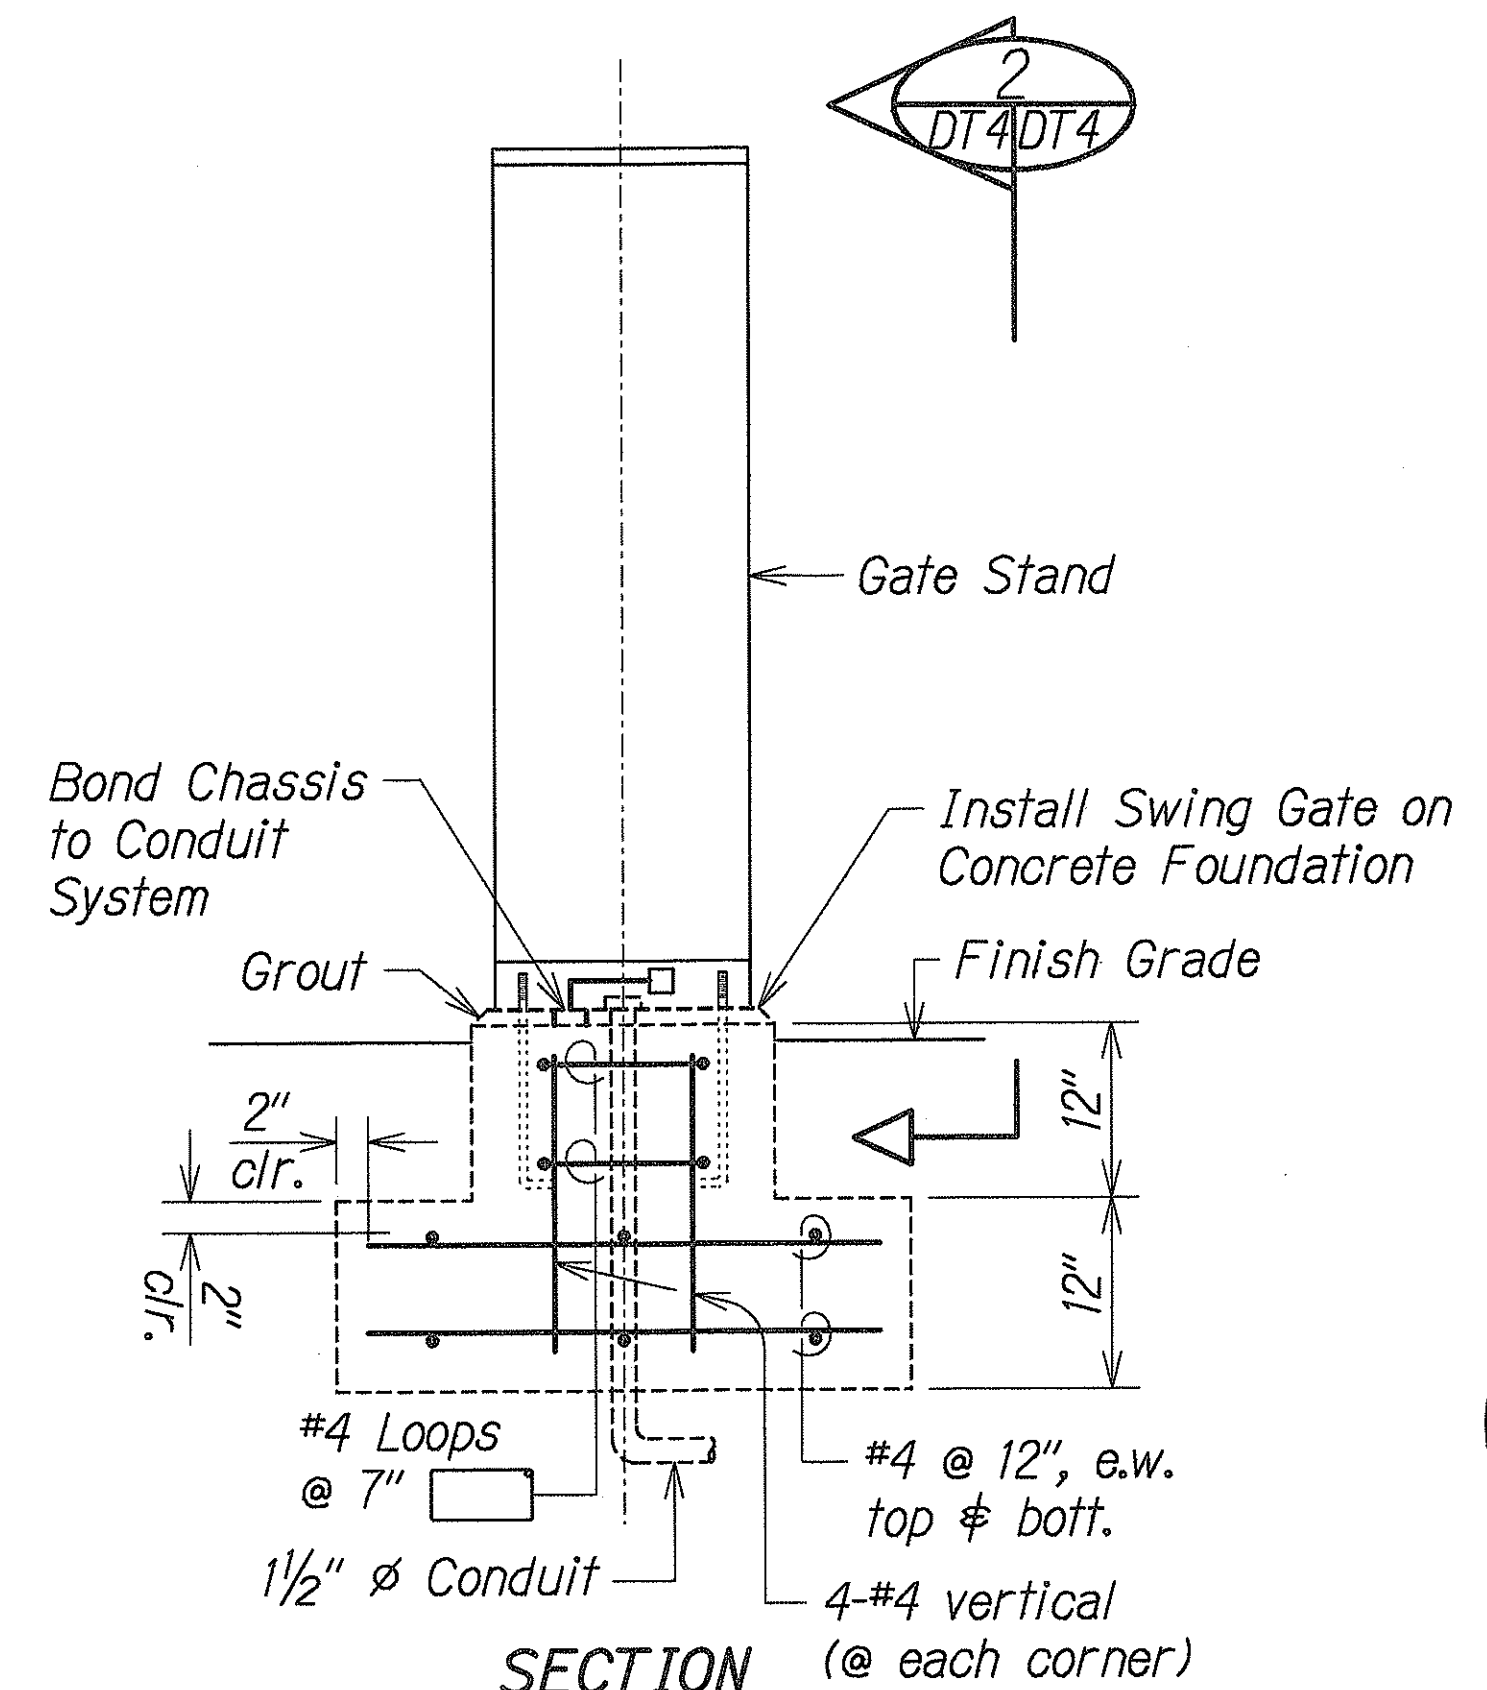

THIS WORK WAS PREPARED BY ME OR UNDER MY SUPERVISION
Derrick C. Elfan
Per Enr, Inc.
dba PARK ENGINEERING

STATE OF HAWAII
DEPARTMENT OF TRANSPORTATION
HIGHWAYS DIVISION

SWING GATE DETAILS


INTERSTATE ROUTE H-1
CONTRAFLOW AND SHOULDER LANE
Waialae Interchange to Keolu Interchange
PROJECT NO. HIEFG-01-96

Scale: 1" = 1'-0" Date: October, 1997

SHEET No. **DT4** OF **8** SHEETS

C.O. ADD. 180

3/20/98	Revised Gate Footing Detail and Guardrail Type to Standard at Gate.
11/17/97	Revised Gate Stand Detail Note.
DATE	REVISION

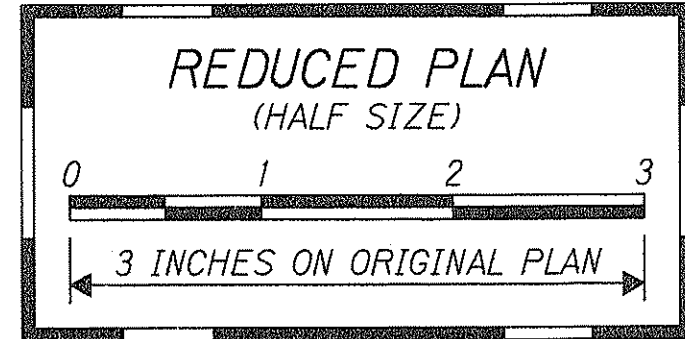

ORIGINAL PLAN	DATE
DESIGNED BY	DESIGNED BY
NOTED BY	NOTED BY
CHECKED BY	CHECKED BY
DATE	DATE