
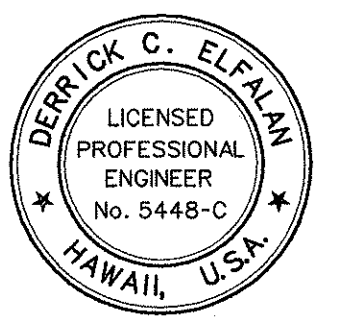
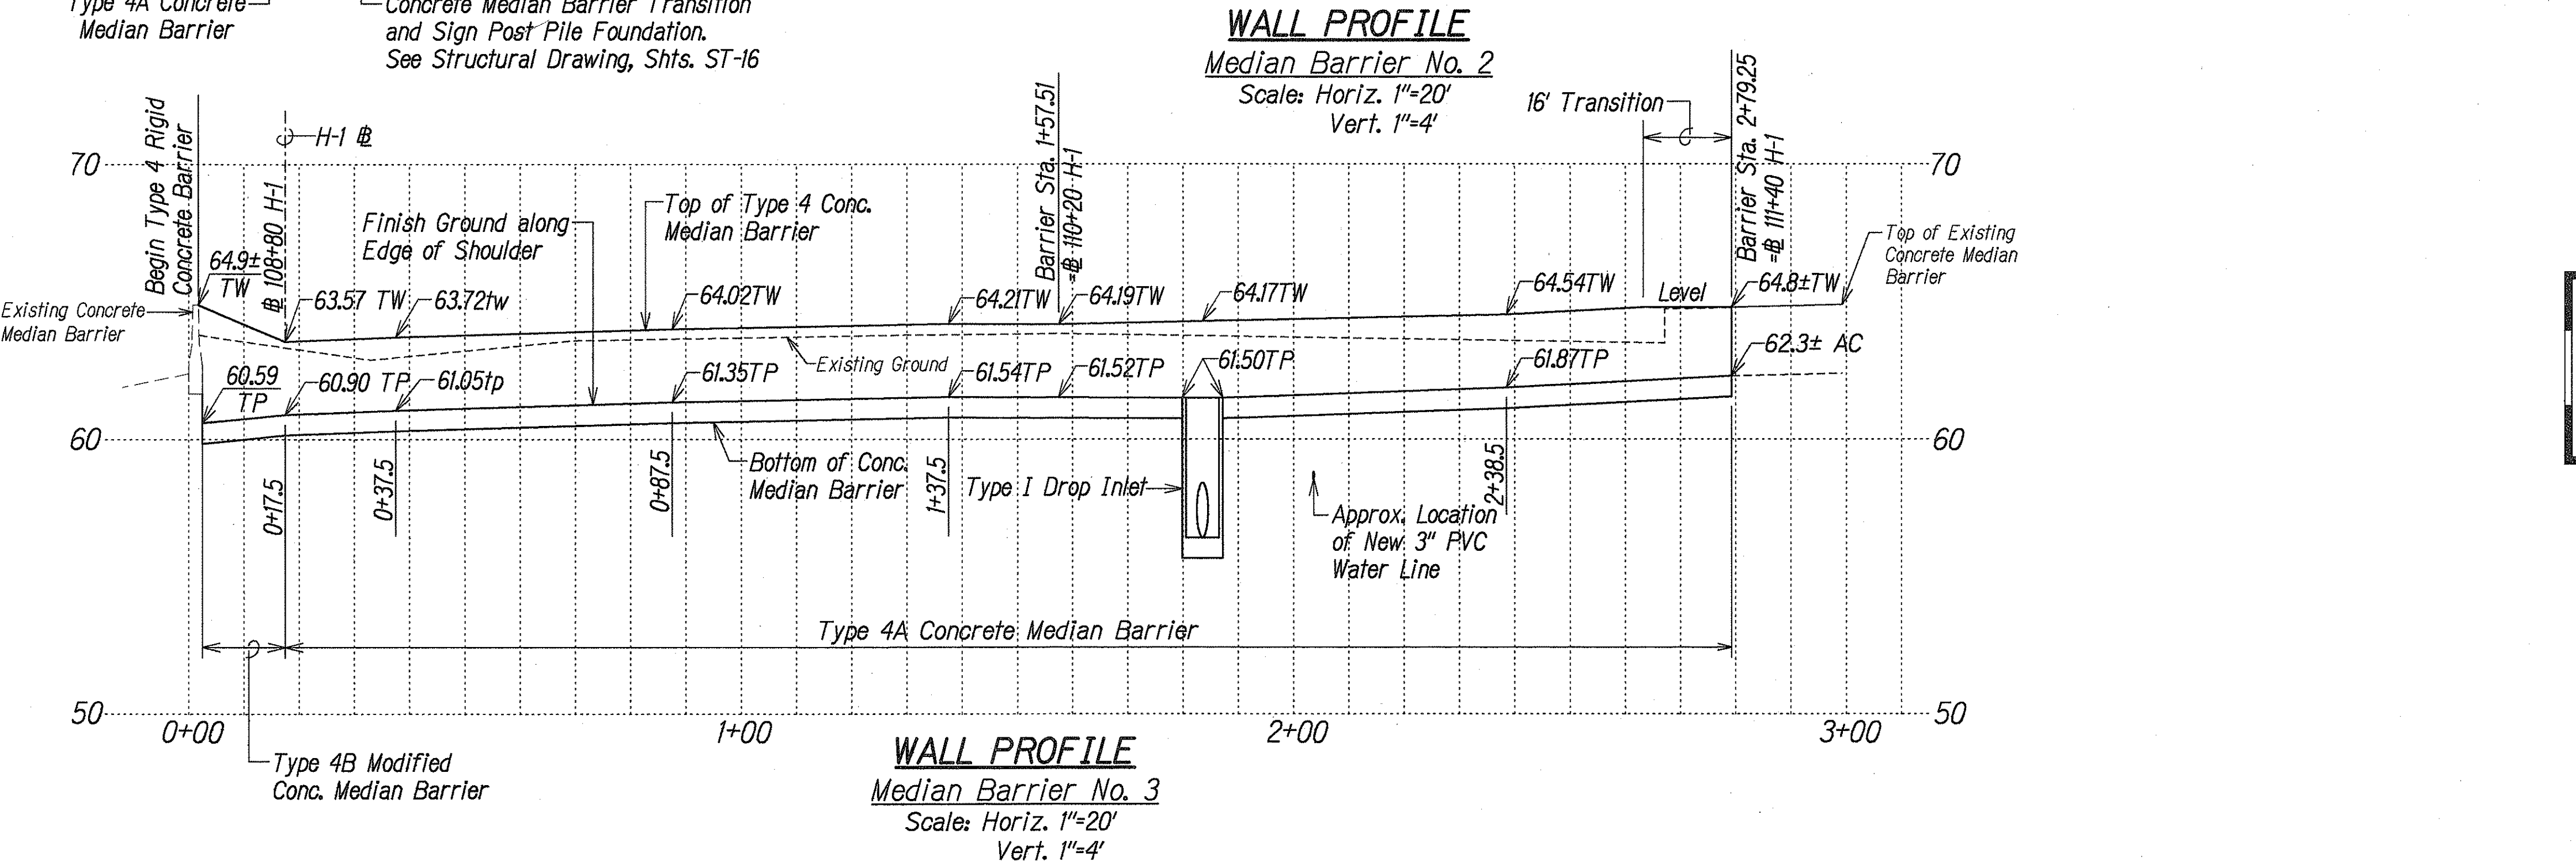
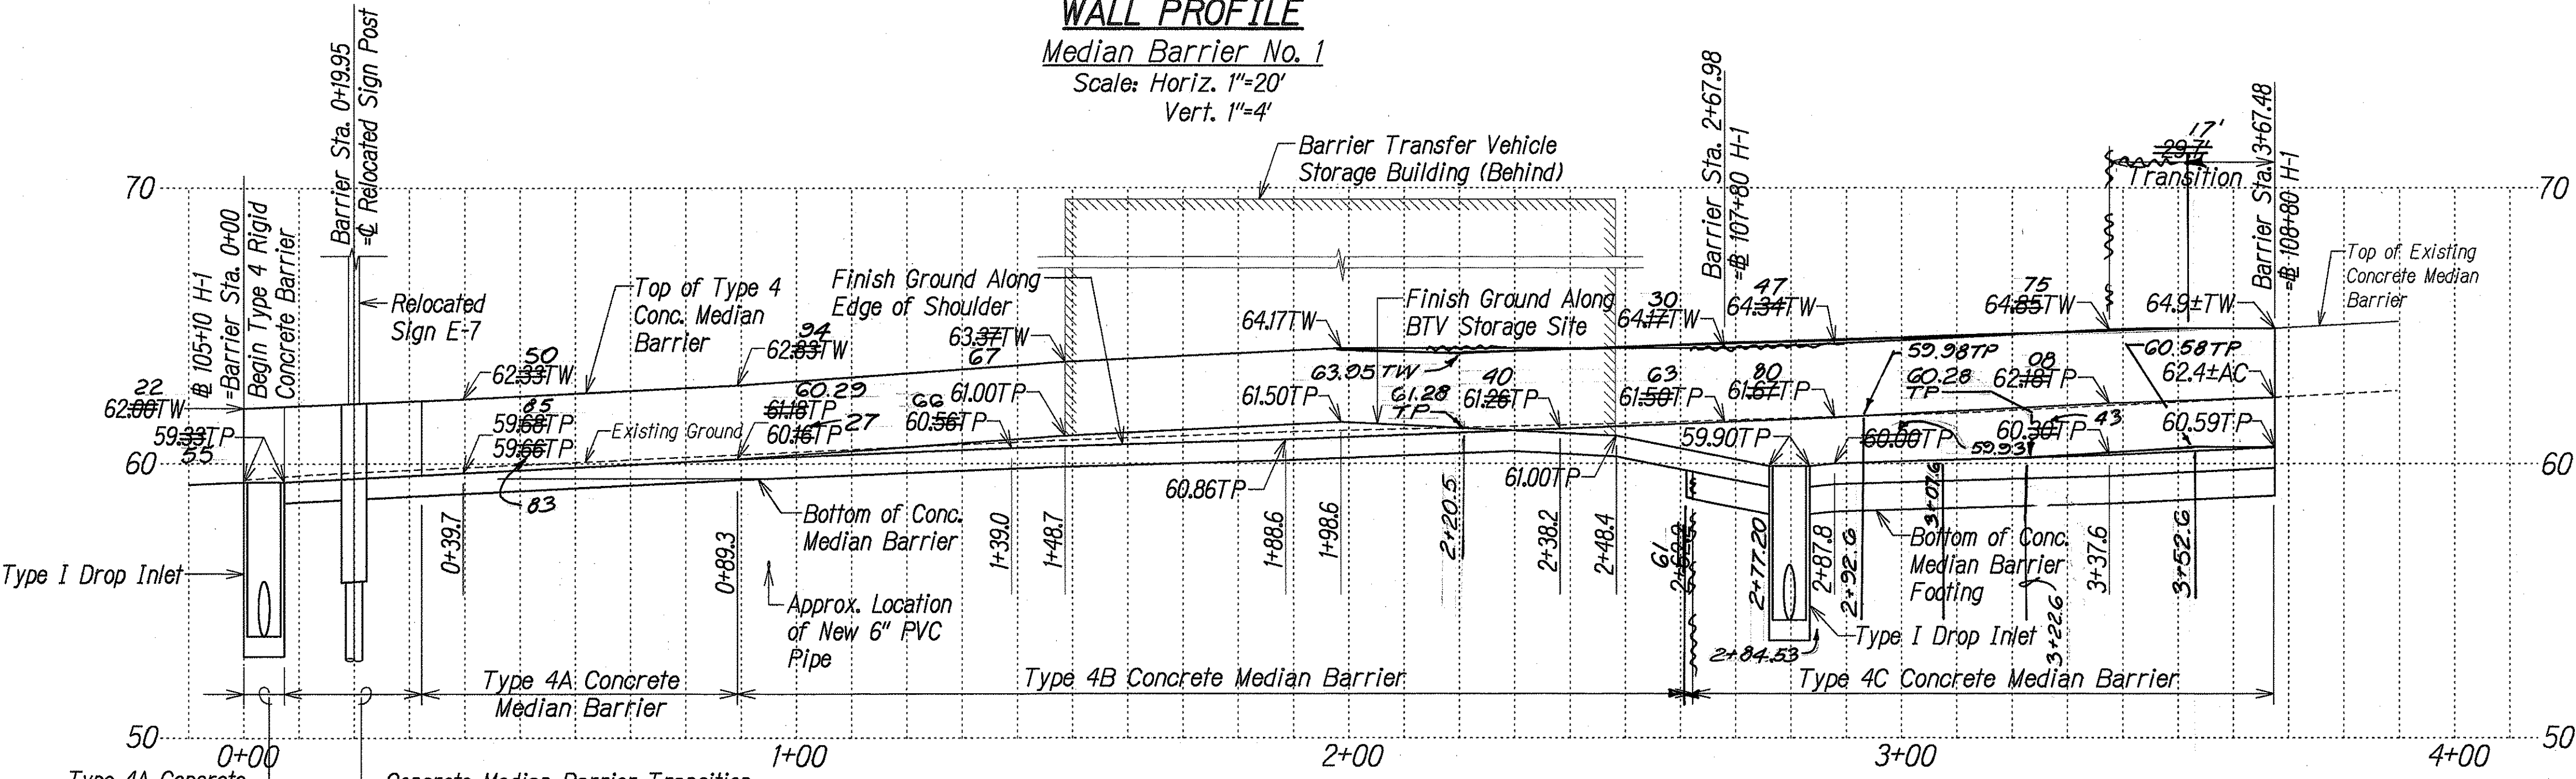


FED. ROAD DIST. NO.	STATE	PROJ. NO.	FISCAL YEAR	SHEET NO.	TOTAL SHEETS
HAWAII	HAW.	HIEFG-01-96	1998	102	344

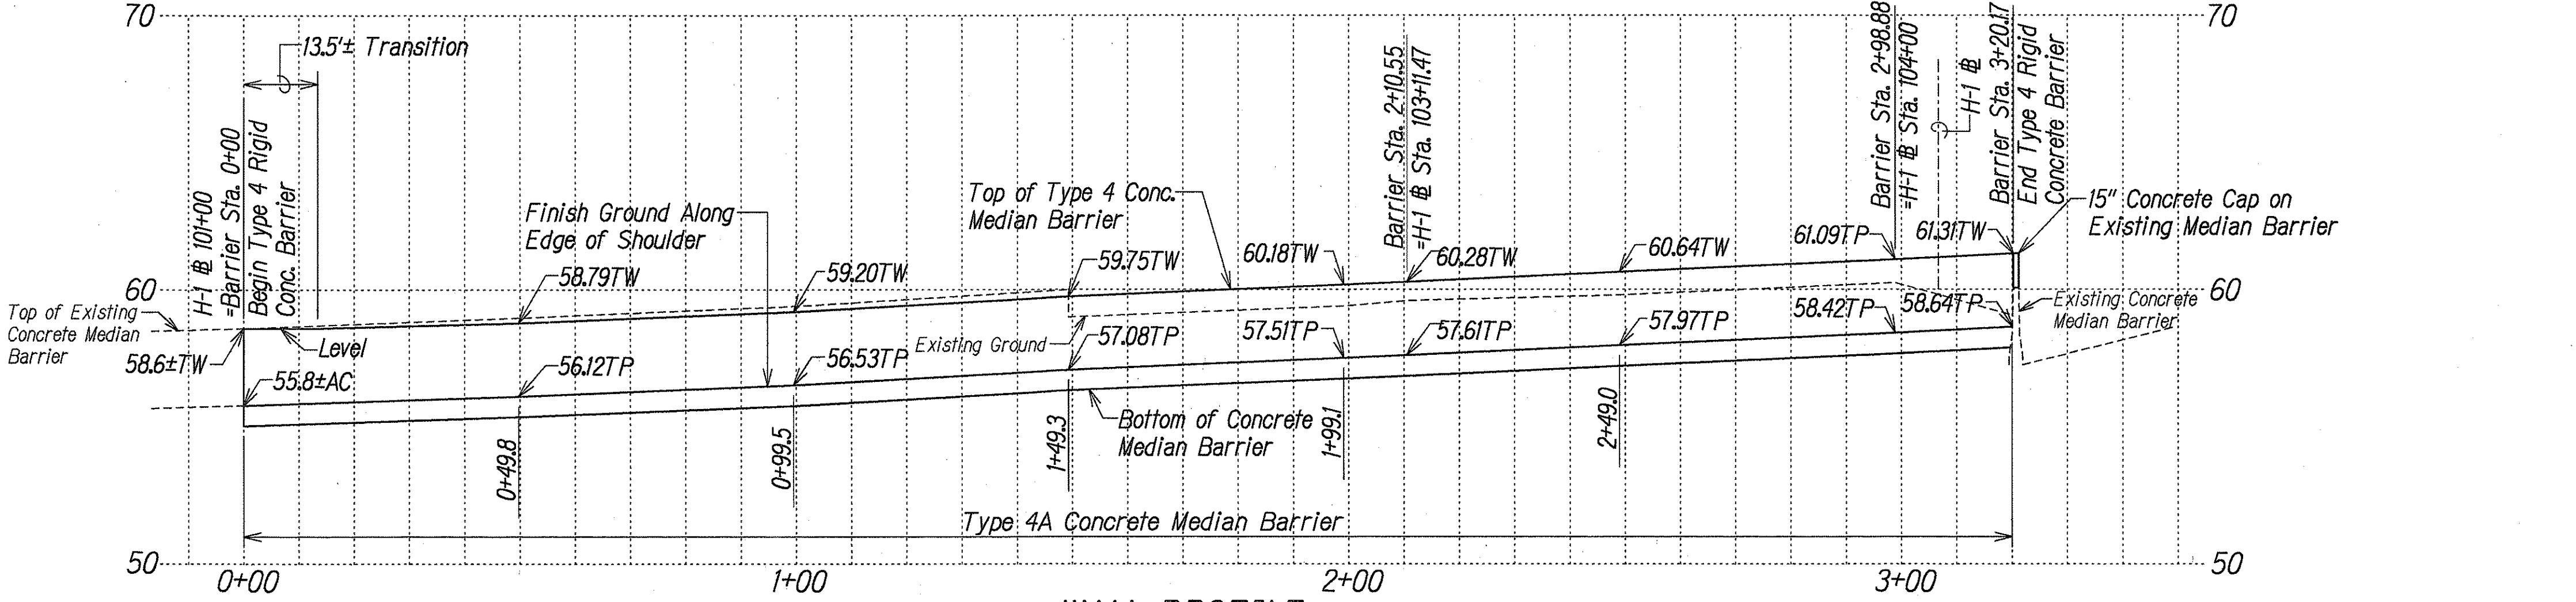

THIS WORK WAS PREPARED BY ME OR UNDER MY SUPERVISION
[Signature]
P/E, Inc.
800 PARK ENGINEERING

STATE OF HAWAII
DEPARTMENT OF TRANSPORTATION
HIGHWAYS DIVISION

WALL PROFILES
BARRIER TRANSFER VEHICLE
(BTV) STORAGE SITE

INTERSTATE ROUTE H-1
CONTRAFLOW AND SHOULDER LANE
PROJECT NO. HIEFG-01-96

Scale: As Shown Date: October, 1997

SHEET No. **H4** OF **4** SHEETS

SURVEY PLOTTED BY	DATE
DESIGNED BY	
NOTED BY	
CHECKED BY	
ORIGINAL PLAN	
NOTE BOOK	
N.	

"AS-BUILT"