

INDEX TO DRAWINGS	
SHEET NO.	DESCRIPTION
1	TITLE SHEET
2	STANDARD PLANS SUMMARY
3	GENERAL NOTES AND LEGEND
4 - 7	TYPICAL SECTIONS
8	TYPICAL SECTIONS AND QUARDGUARD DETAIL
9	SRT-350 - SLOTTED RAIL TERMINAL
10 - 20	ROADWAY PLANS
21 - 44	WAIAWA INTERCHANGE IMPROVEMENTS
45 - 49	DRAINAGE DETAILS
50	PAVEMENT MARKING LEGEND AND NOTES
51 - 60	PAVEMENT MARKING AND SIGNING PLAN
61	FRAME LAYOUT DETAILS
62 - 63	SIGN DETAIL
64	TRAFFIC SUMMARIES
65	NPDES NOTES

Sheet Nos @65-1 and @235-1 are supplementary sheets to this project. Total sheet count after "As-Built" posting 67 shits.

DESIGN UNIT "E"

DESIGNED BY

J. FUJIMOTO

P. S. & E. BY

587-2249

PHONE

FEB. 1997

DATE

STATE OF HAWAII

DEPARTMENT OF TRANSPORTATION

HIGHWAYS DIVISION

HONOLULU, HAWAII

"AS-BUILT"

PLANS FOR

INTERSTATE ROUTE H-1 RESURFACING


VICINITY OF WAIPAHU STREET TO WAIAWA ROAD

FEDERAL-AID PROJECT NO. IM-H1-1(224)

DISTRICT OF EWA

ISLAND OF OAHU


LIMITS OF PROJECT

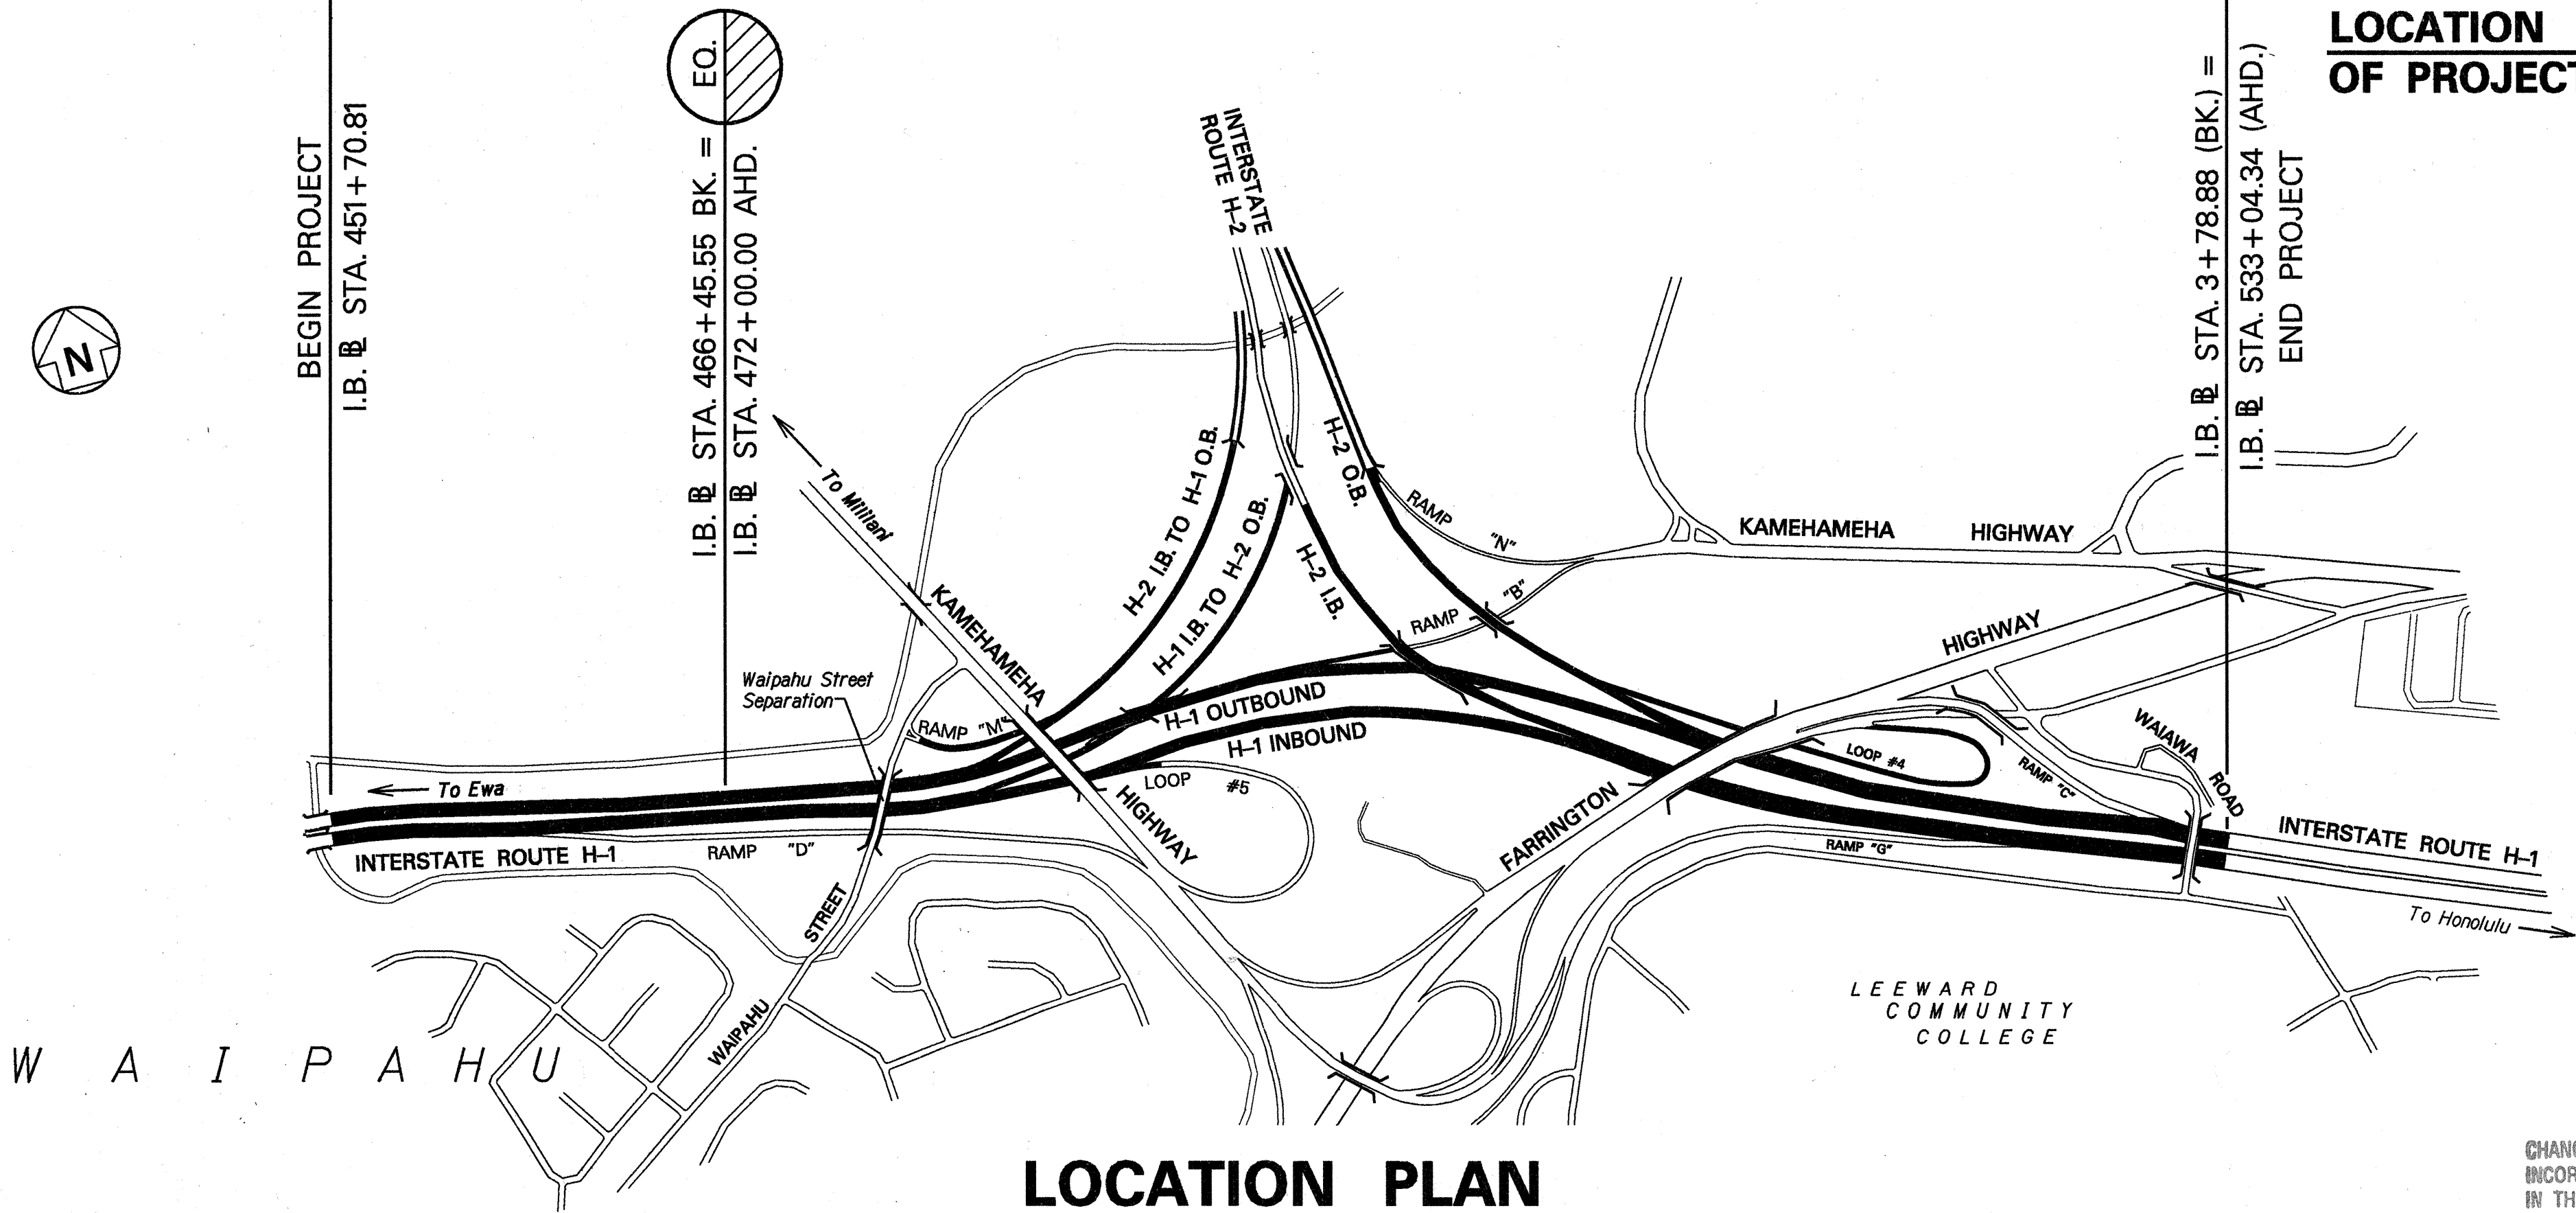



LOCATION PLAN

GROSS LENGTH OF PROJECT.....1.63 MILES


NET LENGTH OF PROJECT.....1.63 MILES

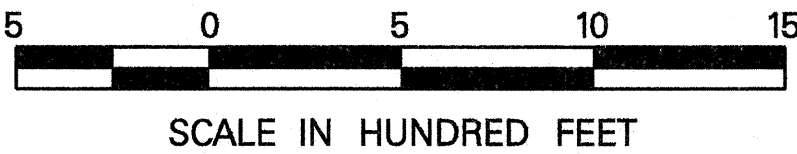

FED. ROAD DIST. NO.	STATE	FED. AID PROJ. NO.	FISCAL YEAR	SHEET NO.	TOTAL SHEETS
HAWAII	HAW.	IM-H1-1(224)	1997	1	65

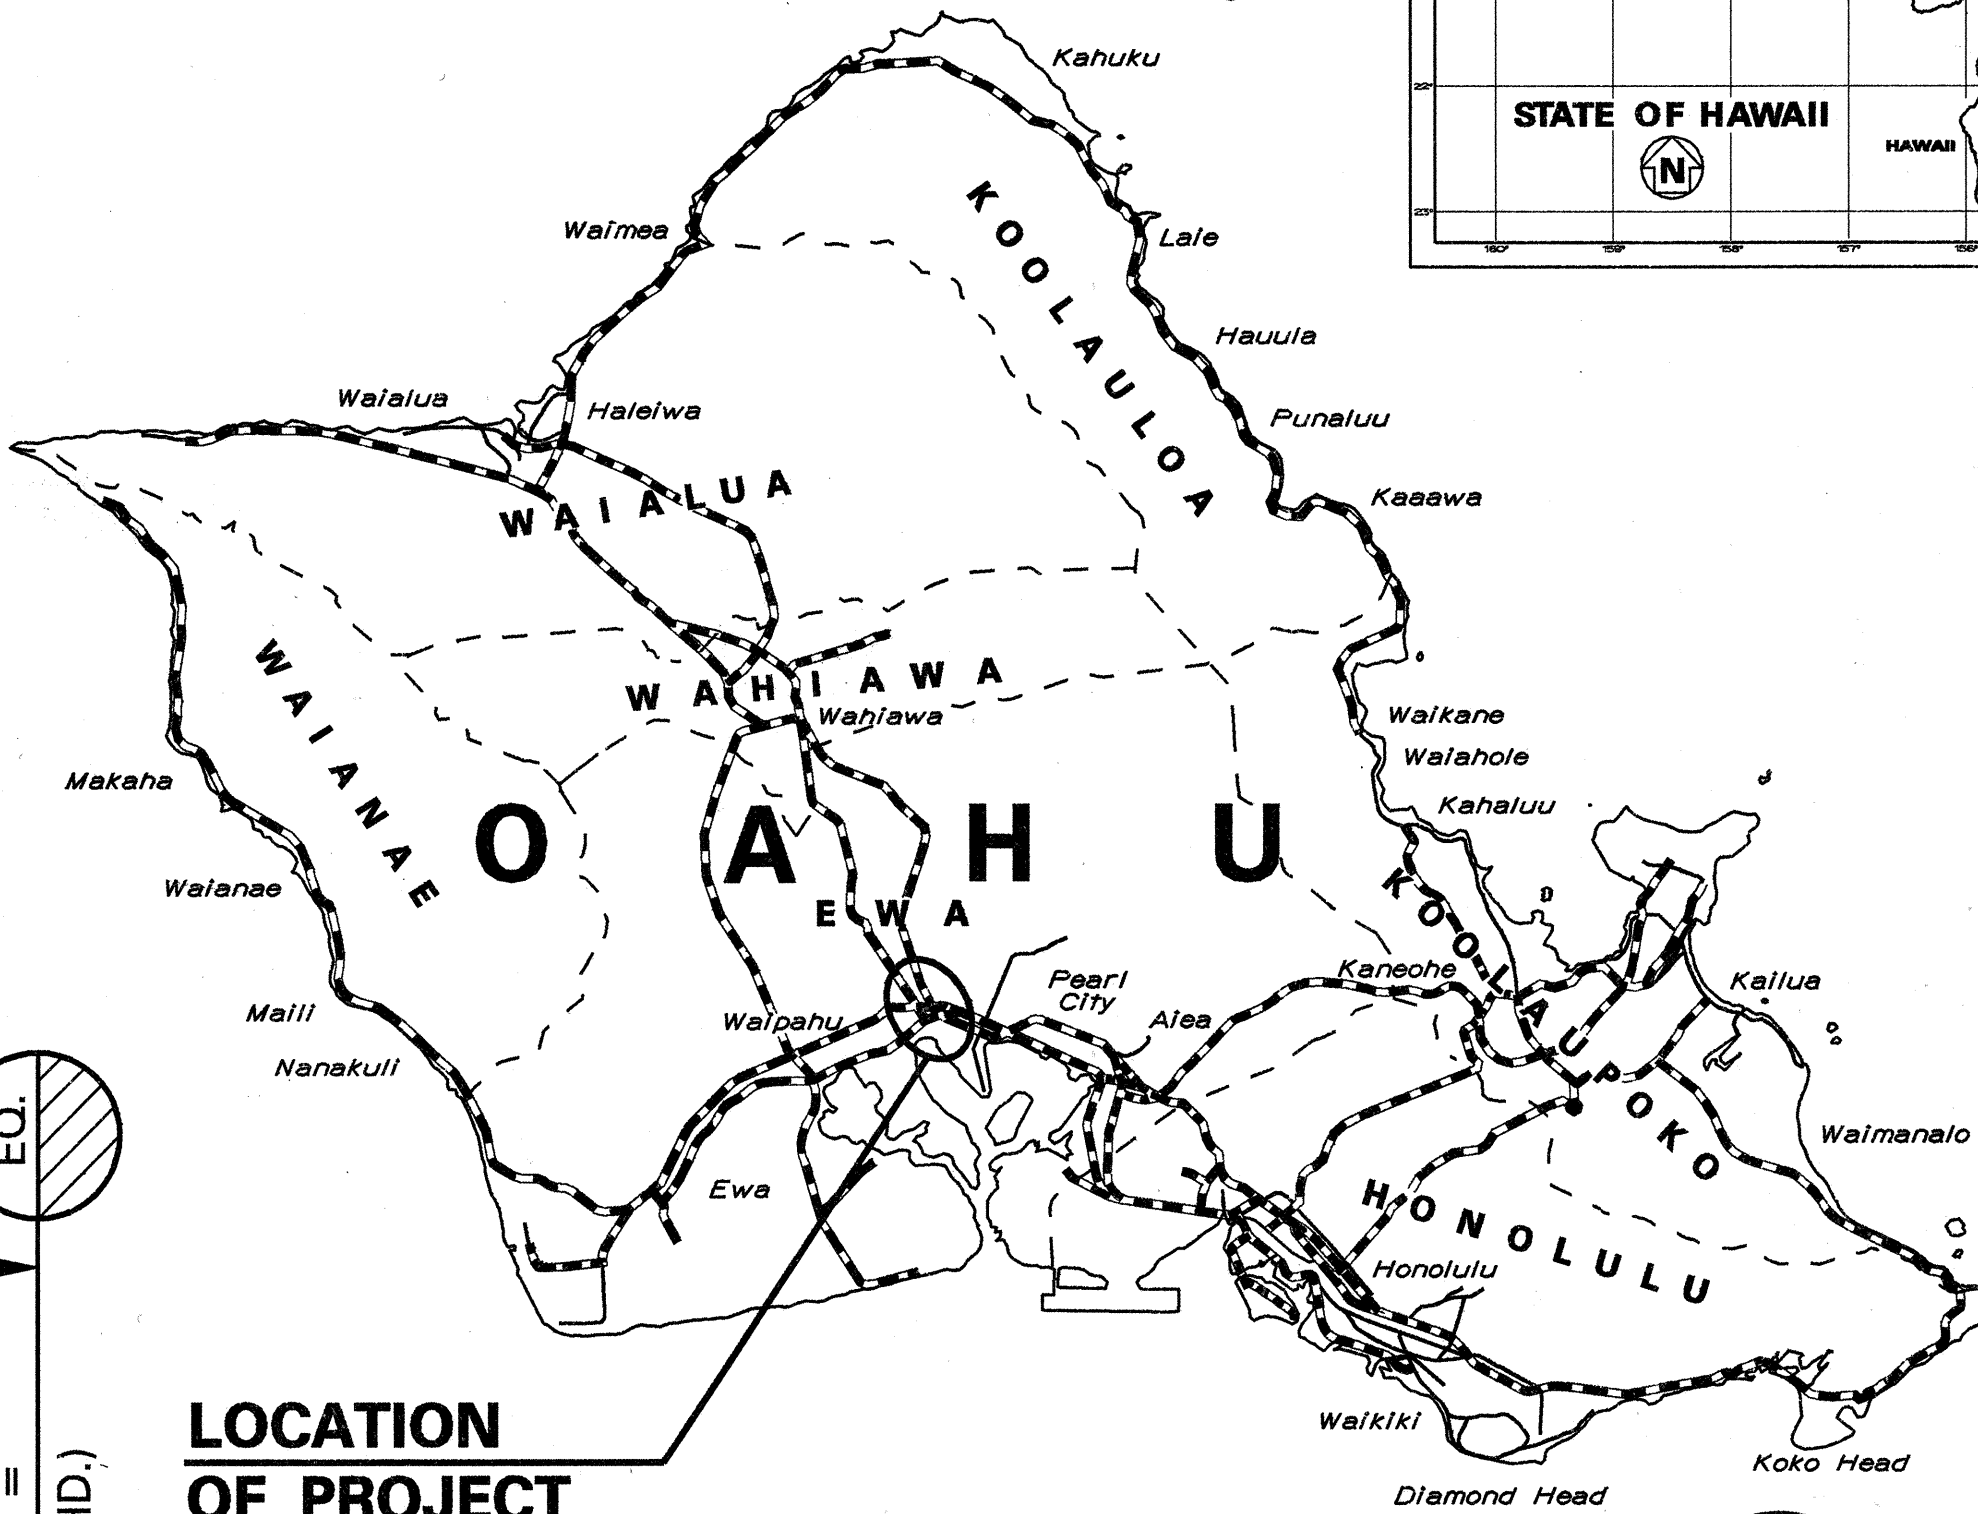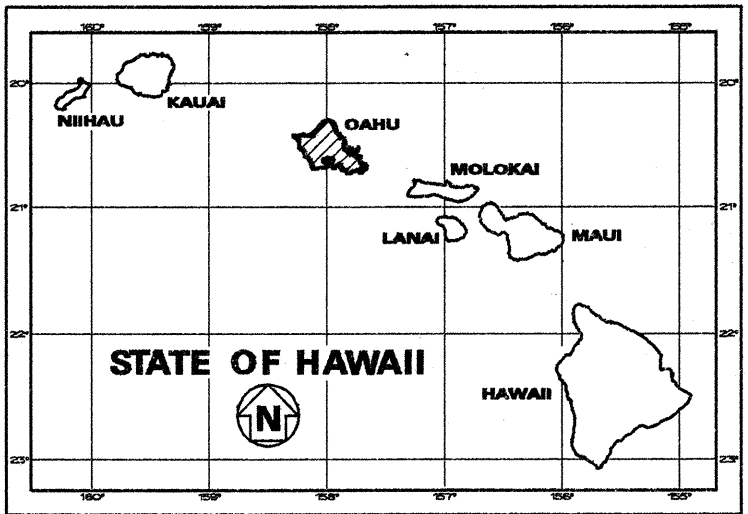

LOCATION OF PROJECT

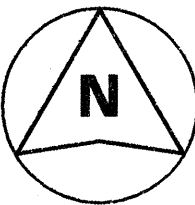

SCALE IN MILES

FEDERAL AID PROJECTS PREVIOUSLY CONSTRUCTED OR UNDER CONSTRUCTION

MILE POST 7.76 TO MILE POST 9.39

DESIGN DESIGNATION

ADT (1996)	124,800
ADT (2006)	172,600
DHV	15,500
D	65/35
T	3.0 %
V	55 M.P.H.

CHANGES MADE DURING CONSTRUCTION HAVE BEEN INCORPORATED ON THESE PLANS EXCEPT CHANGES IN THE ORIGINAL THEORETICAL QUANTITIES. FOR ACTUAL QUANTITIES, REFER TO PROJECT LEDGER AND/OR COMPUTATION BOOK.

Robert Shi 5-05-03
RESIDENT ENGINEER DATE

DEPARTMENT OF TRANSPORTATION STATE OF HAWAII	
APPROVED:	6/6/97
DIR. OF TRANSPORTATION	DATE