


TRUE NORTH
SCALE : 1" = 20'

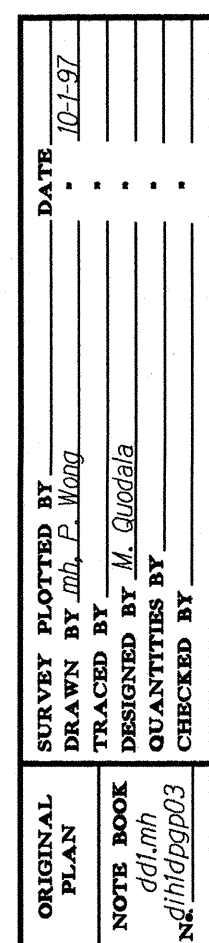


STATE OF HAWAII
DEPARTMENT OF TRANSPORTATION
HIGHWAYS DIVISION



PAVEMENT GRADE PLAN
RAMP EW & RAMP KW
INTERSTATE ROUTE H-1
Kunia Interchange Improvements
F. A. I. Project No. 1M-HI-1(219)

Scale: 1"=20' Date: Oct. 1997

SHEET No. 2 OF 2 SHEETS

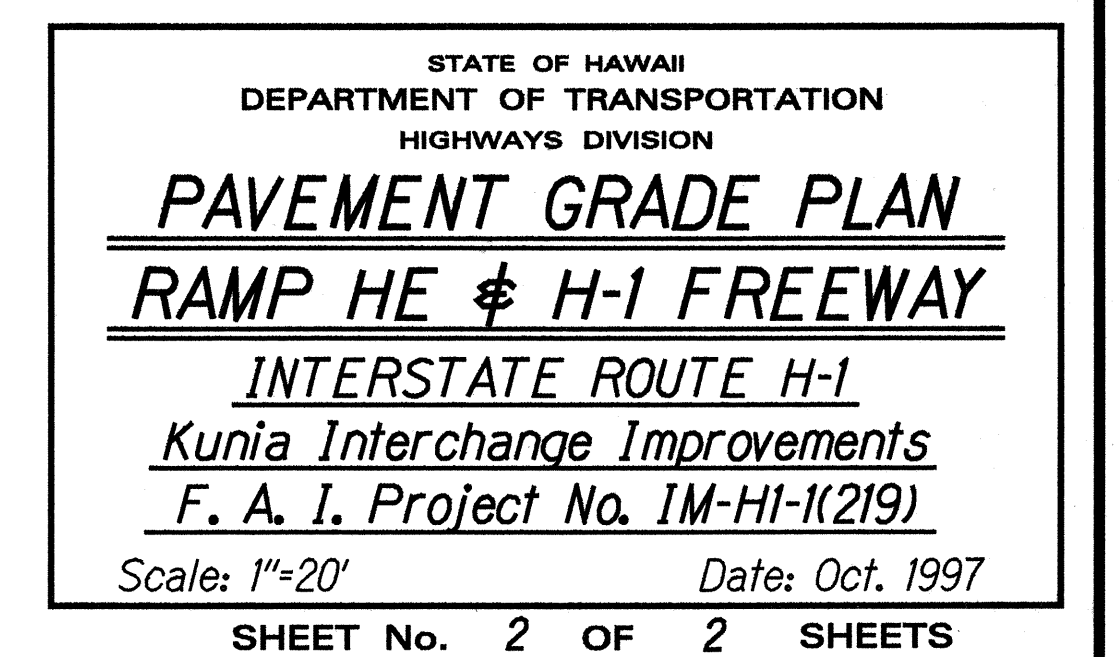

FED. ROAD DIST. NO.	STATE	FED. AID PROJ. NO.	FISCAL YEAR	SHEET NO.	TOTAL SHEETS
HAWAII	HAW.	IM-HI-1(219)	1998	57	378

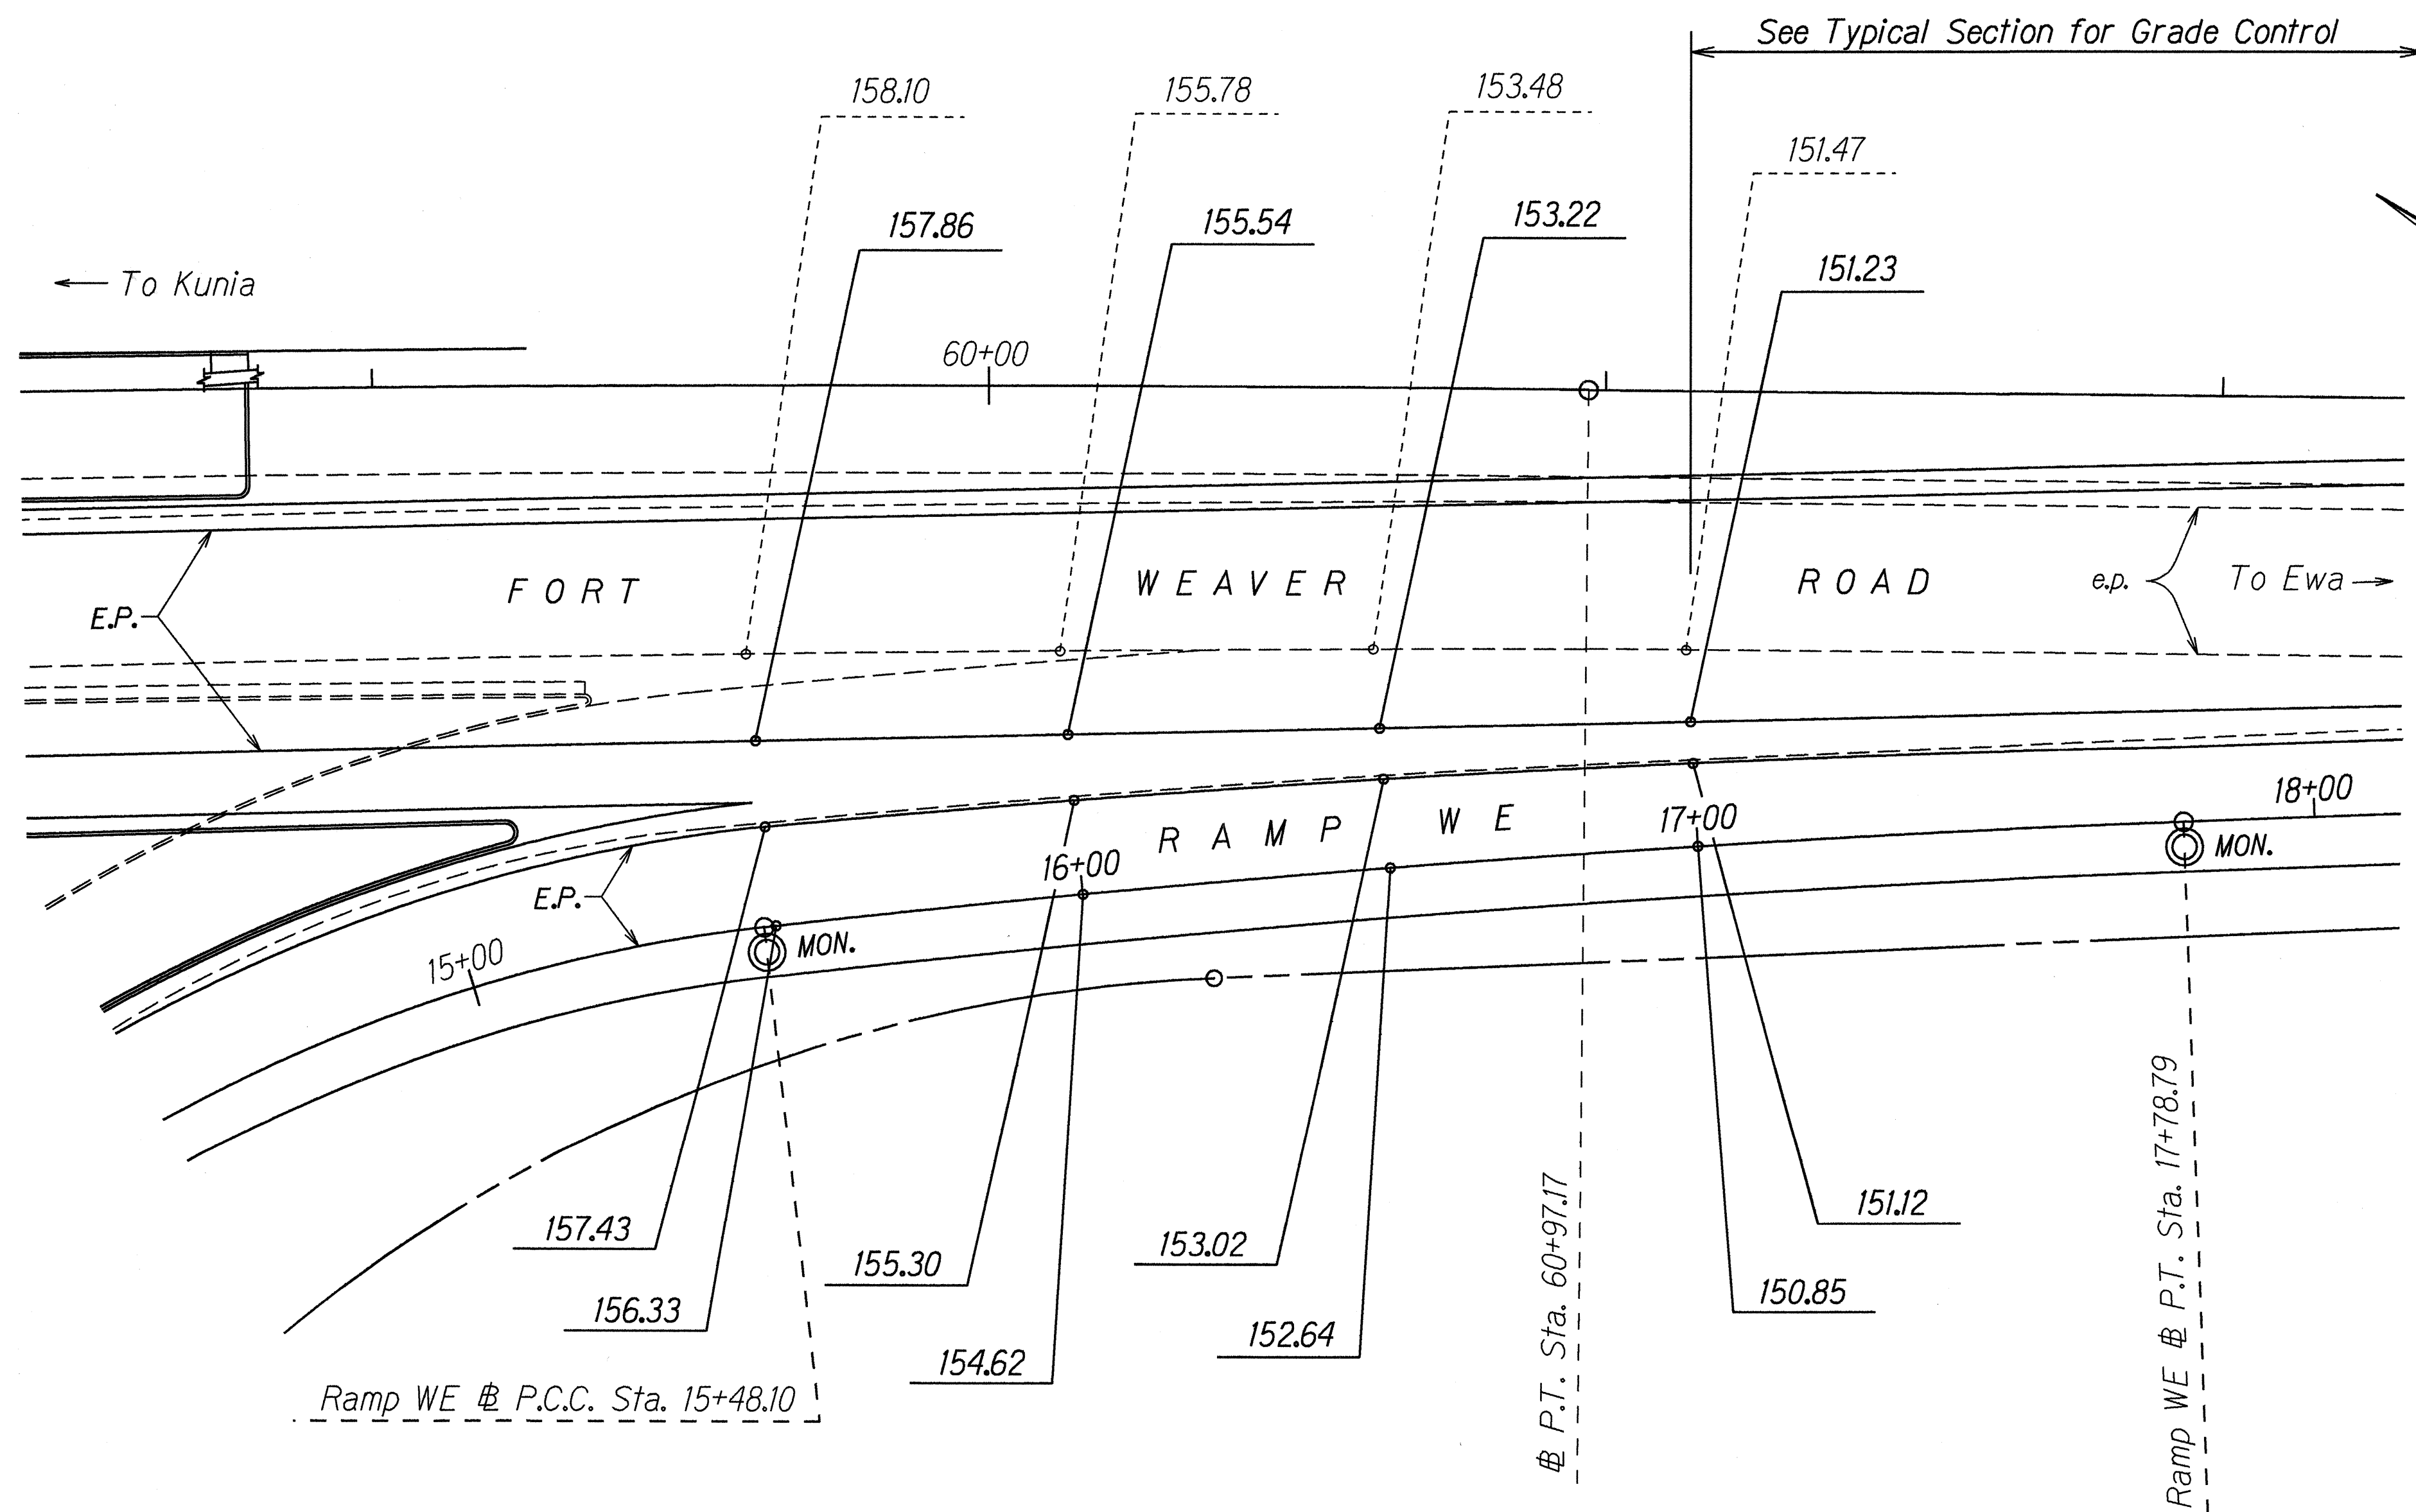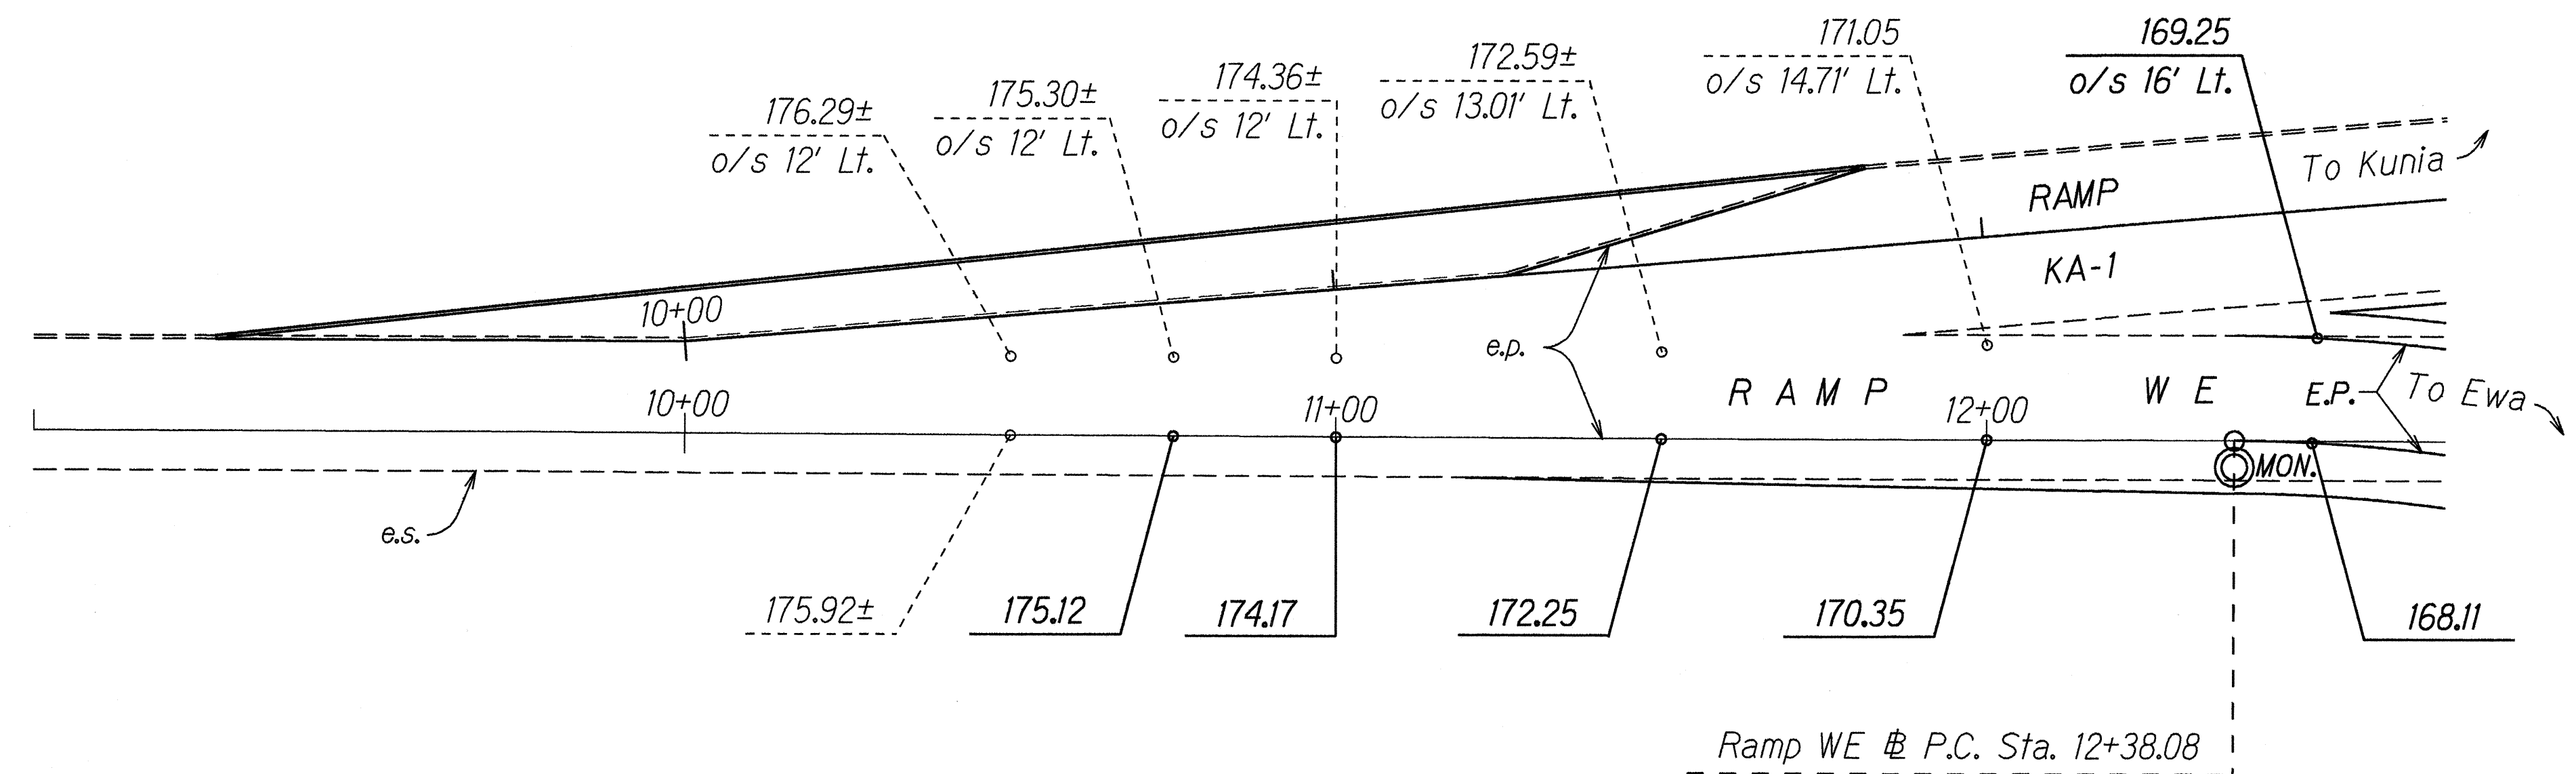

ORIGINAL PLAN	DATE
DESIGNED BY	10/1/97
NOTED BY	
CHECKED BY	


STATE OF HAWAII
DEPARTMENT OF TRANSPORTATION
HIGHWAYS DIVISION

PAVEMENT GRADE PLAN
RAMP WE & FT. WEAVER RD.
INTERSTATE ROUTE H-1
Kunia Interchange Improvements
F. A. I. Project No. IM-HI-1(219)

Scale: 1"=20' Date: Oct. 1997

SHEET No. 1 OF 1 SHEETS

FED. ROAD DIST. NO.	STATE	FED. AID PROJ. NO.	FISCAL YEAR	SHEET NO.	TOTAL SHEETS
HAWAII	HAW.	IM-HI-1(219)	1998	C.O.57S-1	378

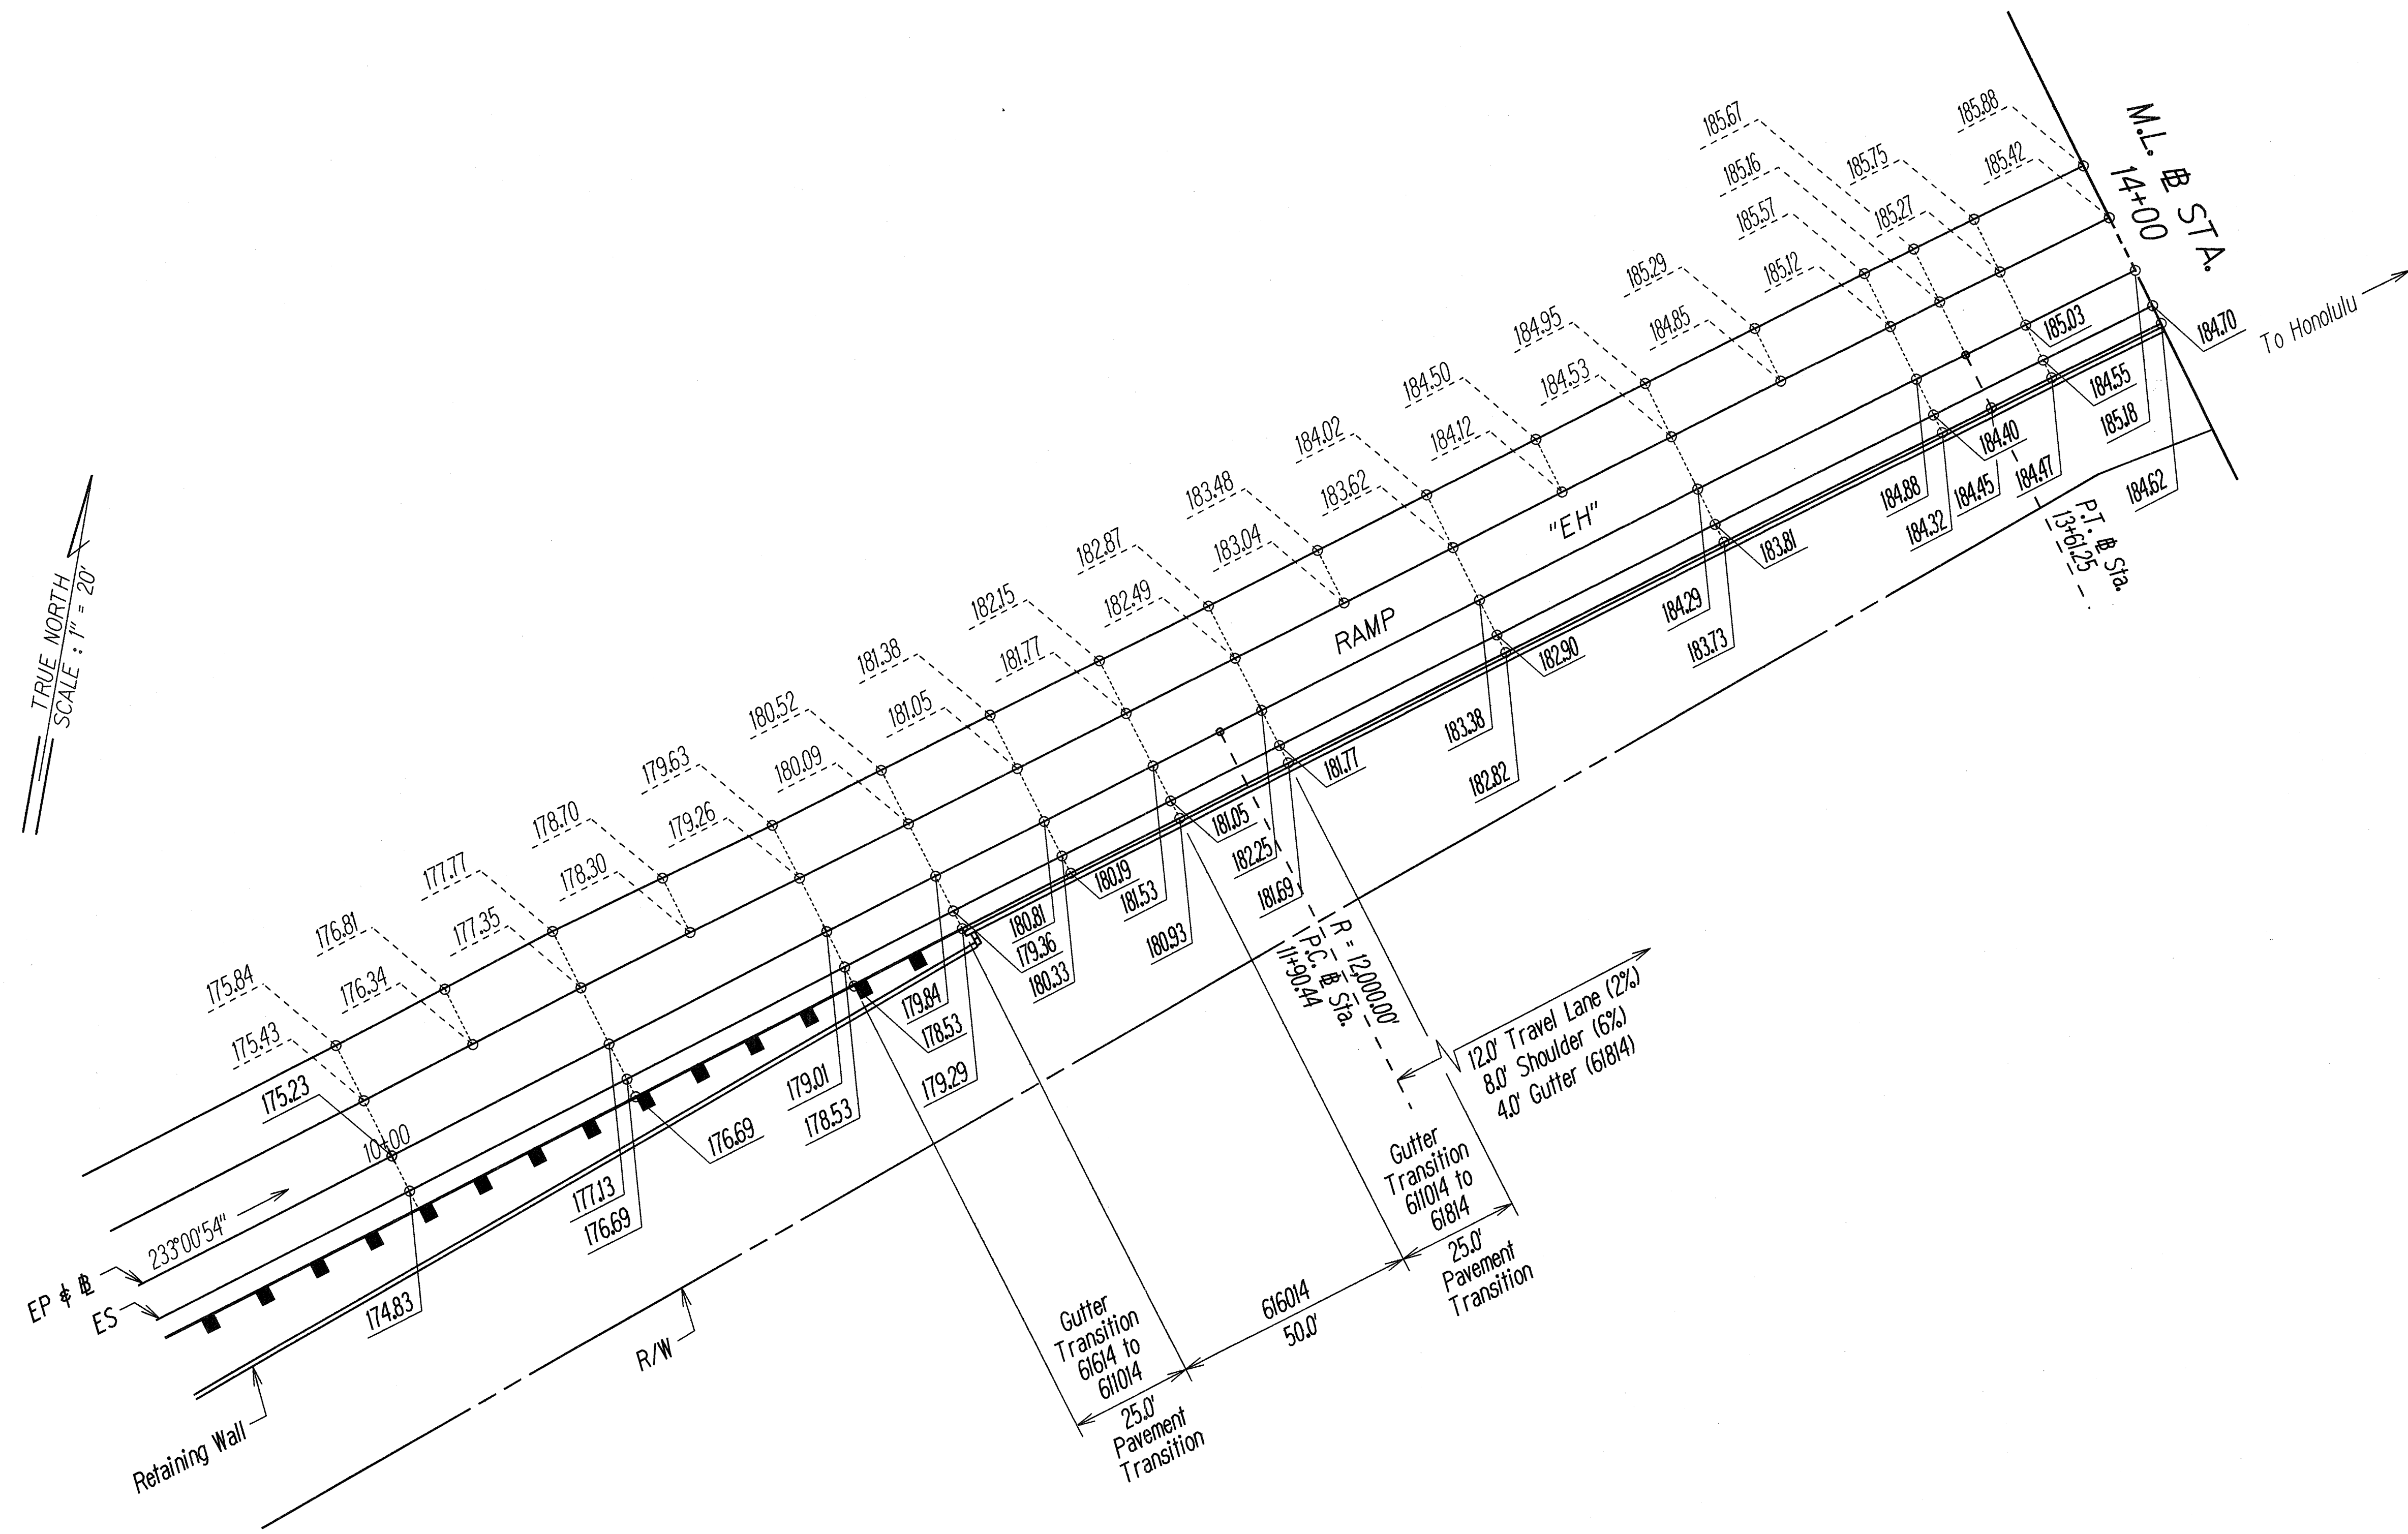

LEGEND

- 175.23 existing elevation
- 175.23 New Elevation

4/19/00	Added sheet for pavement grades at Ramp EH
DATE	REVISION

STATE OF HAWAII
DEPARTMENT OF TRANSPORTATION
HIGHWAYS DIVISION

PAVEMENT GRADE

RAMP "EH"

INTERSTATE ROUTE H-1

Kunia Interchange Improvements

F. A. I. Project No. IM-HI-1(219)


Scale: 1"=20' Date: April, 2000

SHEET No. 1 OF 2 SHEETS

C.O. 57S-1

ORIGINAL PLAN	DATE	4/13/00
DESIGNED BY	DESIGNED BY	DESIGNED BY
NOTED BY	NOTED BY	NOTED BY
CHECKED BY	CHECKED BY	CHECKED BY

FED. ROAD DIST. NO.	STATE	FED. AID PROJ. NO.	FISCAL YEAR	SHEET NO.	TOTAL SHEETS
HAWAII	HAW.	IM-HI-1(219)	1998	C.O.57S-2	378

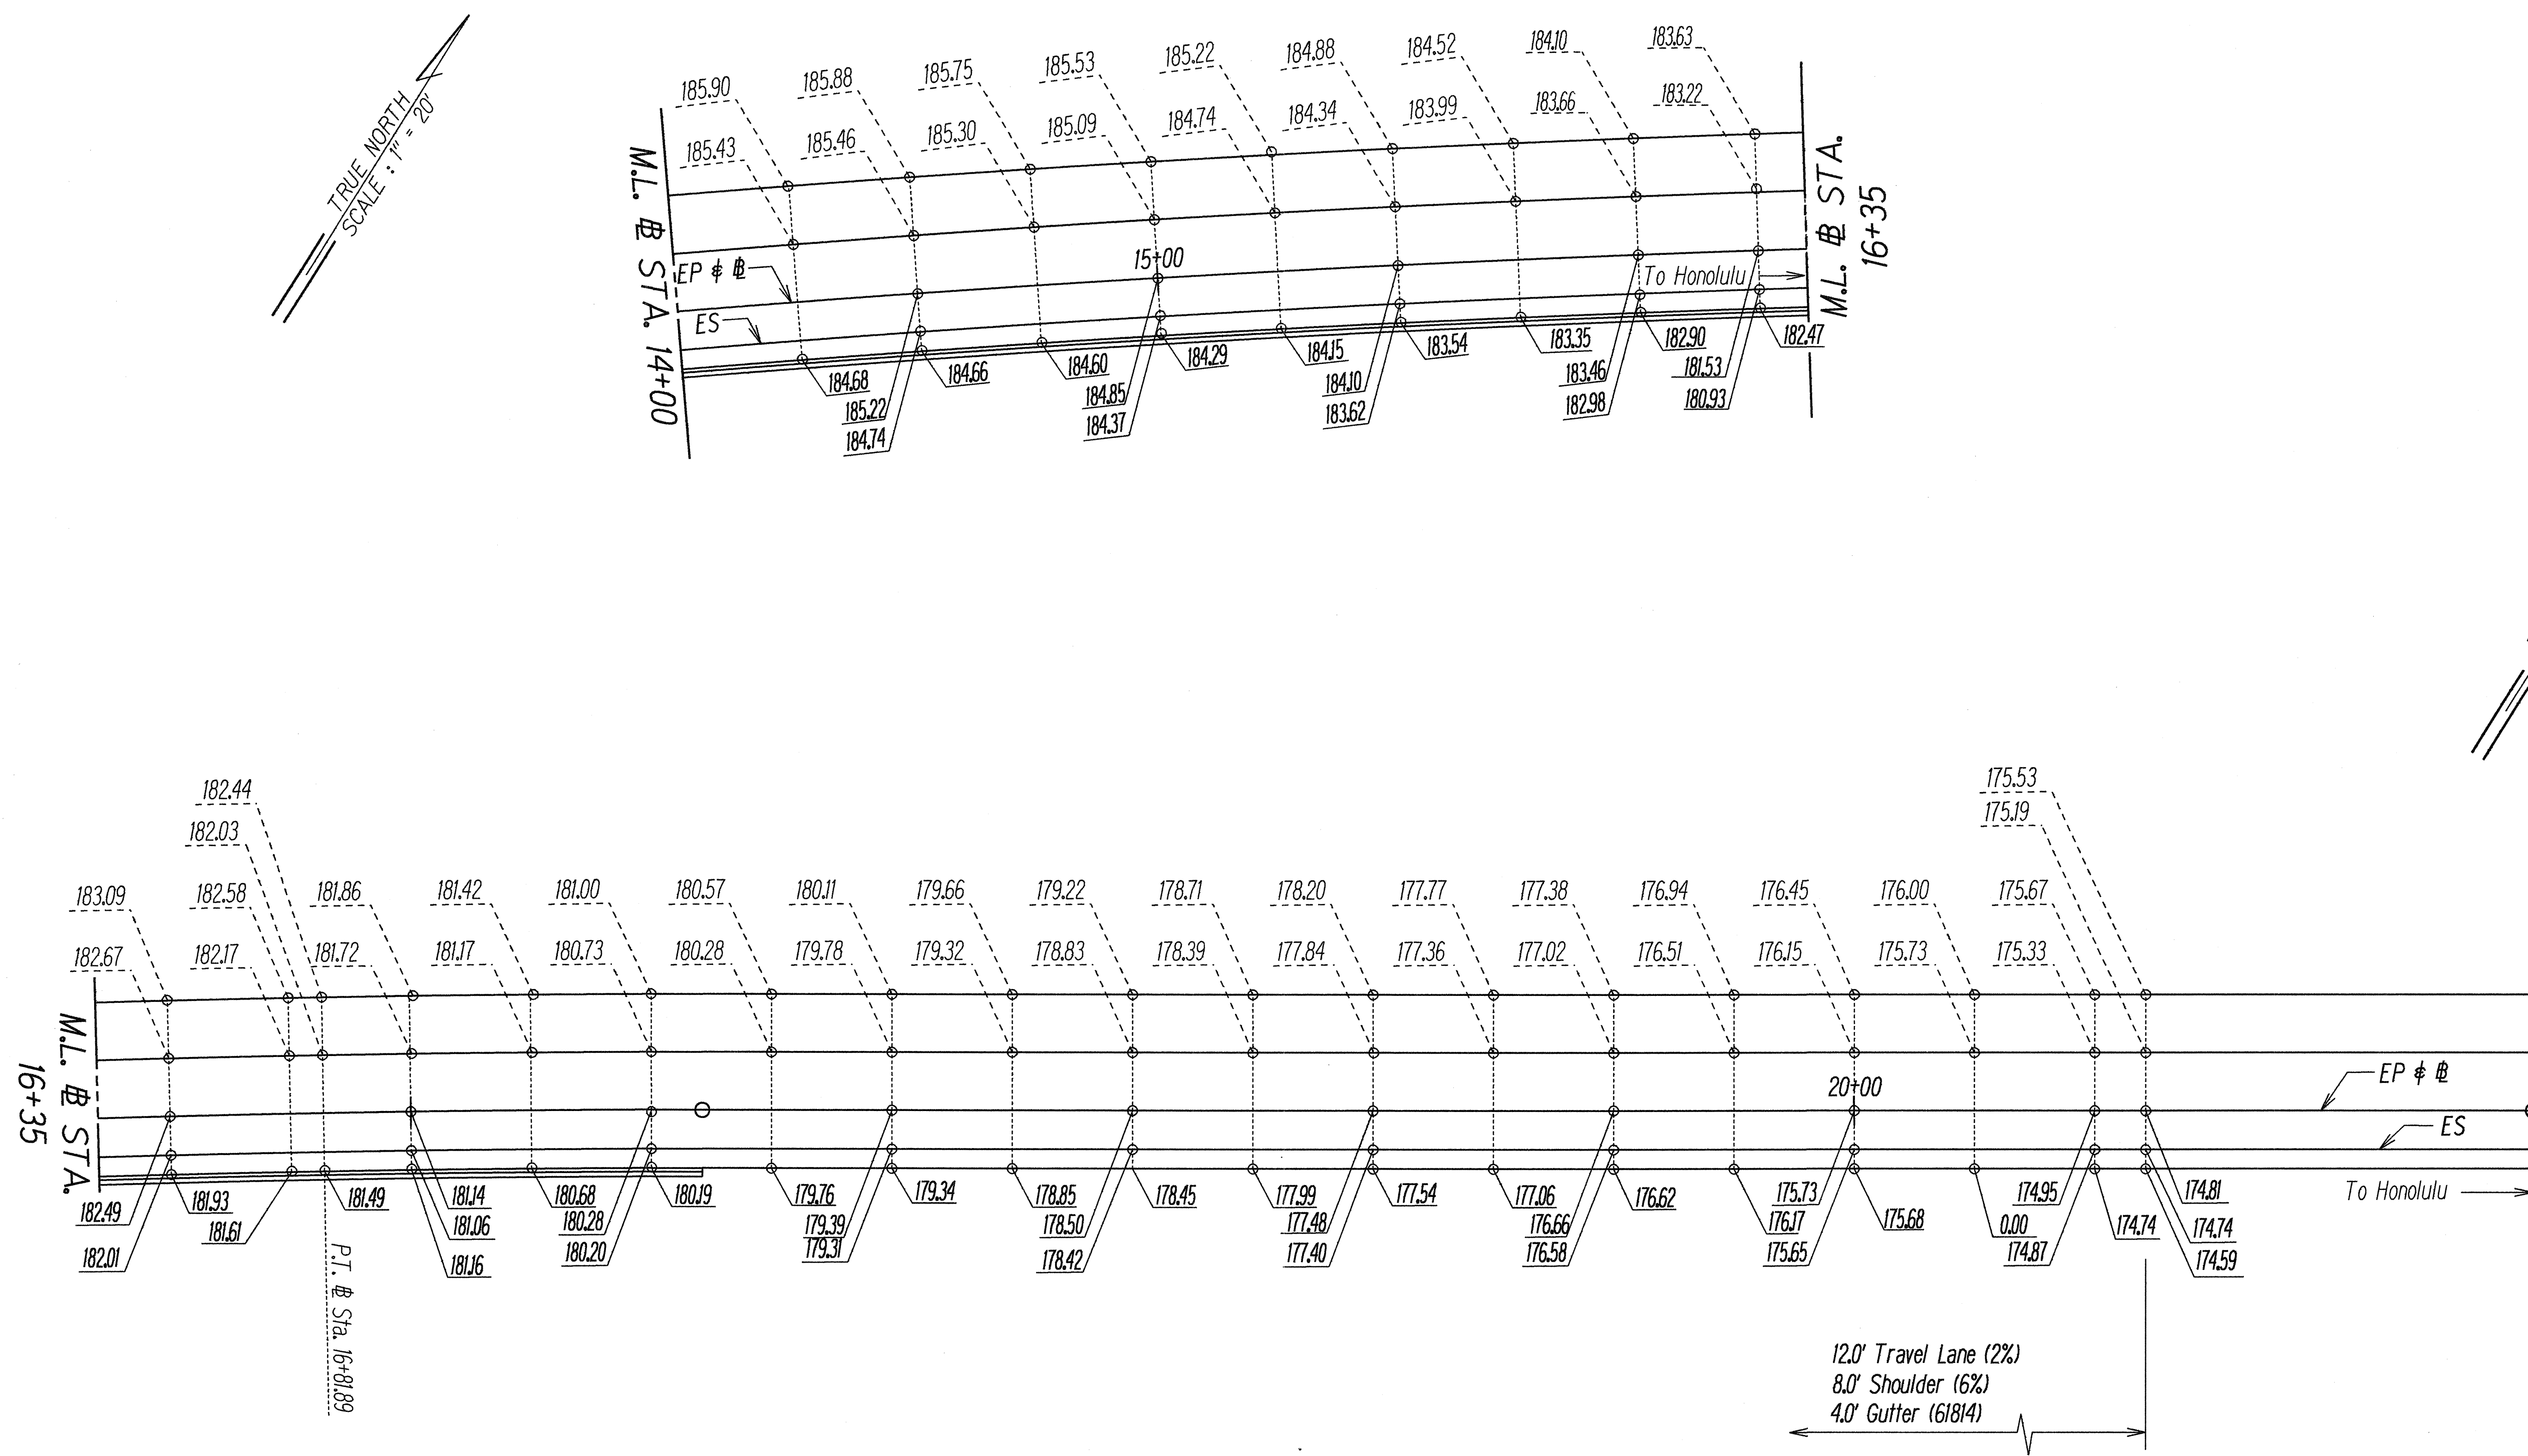

ORIGINAL PLAN	DATE
NOTED BY	
DESIGNED BY	
QUANTITIES BY	
CHECKED BY	

4/19/00	Added sheet for pavement grades at Ramp EH.
DATE	REVISION

STATE OF HAWAII
DEPARTMENT OF TRANSPORTATION
HIGHWAYS DIVISION

PAVEMENT GRADE

RAMP "EH"

INTERSTATE ROUTE H-1

Kunia Interchange Improvements


F. A. I. Project No. IM-HI-1(219)

Scale: 1"=20' Date: April, 2000

SHEET No. 2 OF 2 SHEETS

C.O.57S-2


FED. ROAD DIST. NO.	STATE	FED. AID PROJ. NO.	FISCAL YEAR	SHEET NO.	TOTAL SHEETS
HAWAII	HAW.	IM-HI-1(29)	1998	C.O.57S-4	378

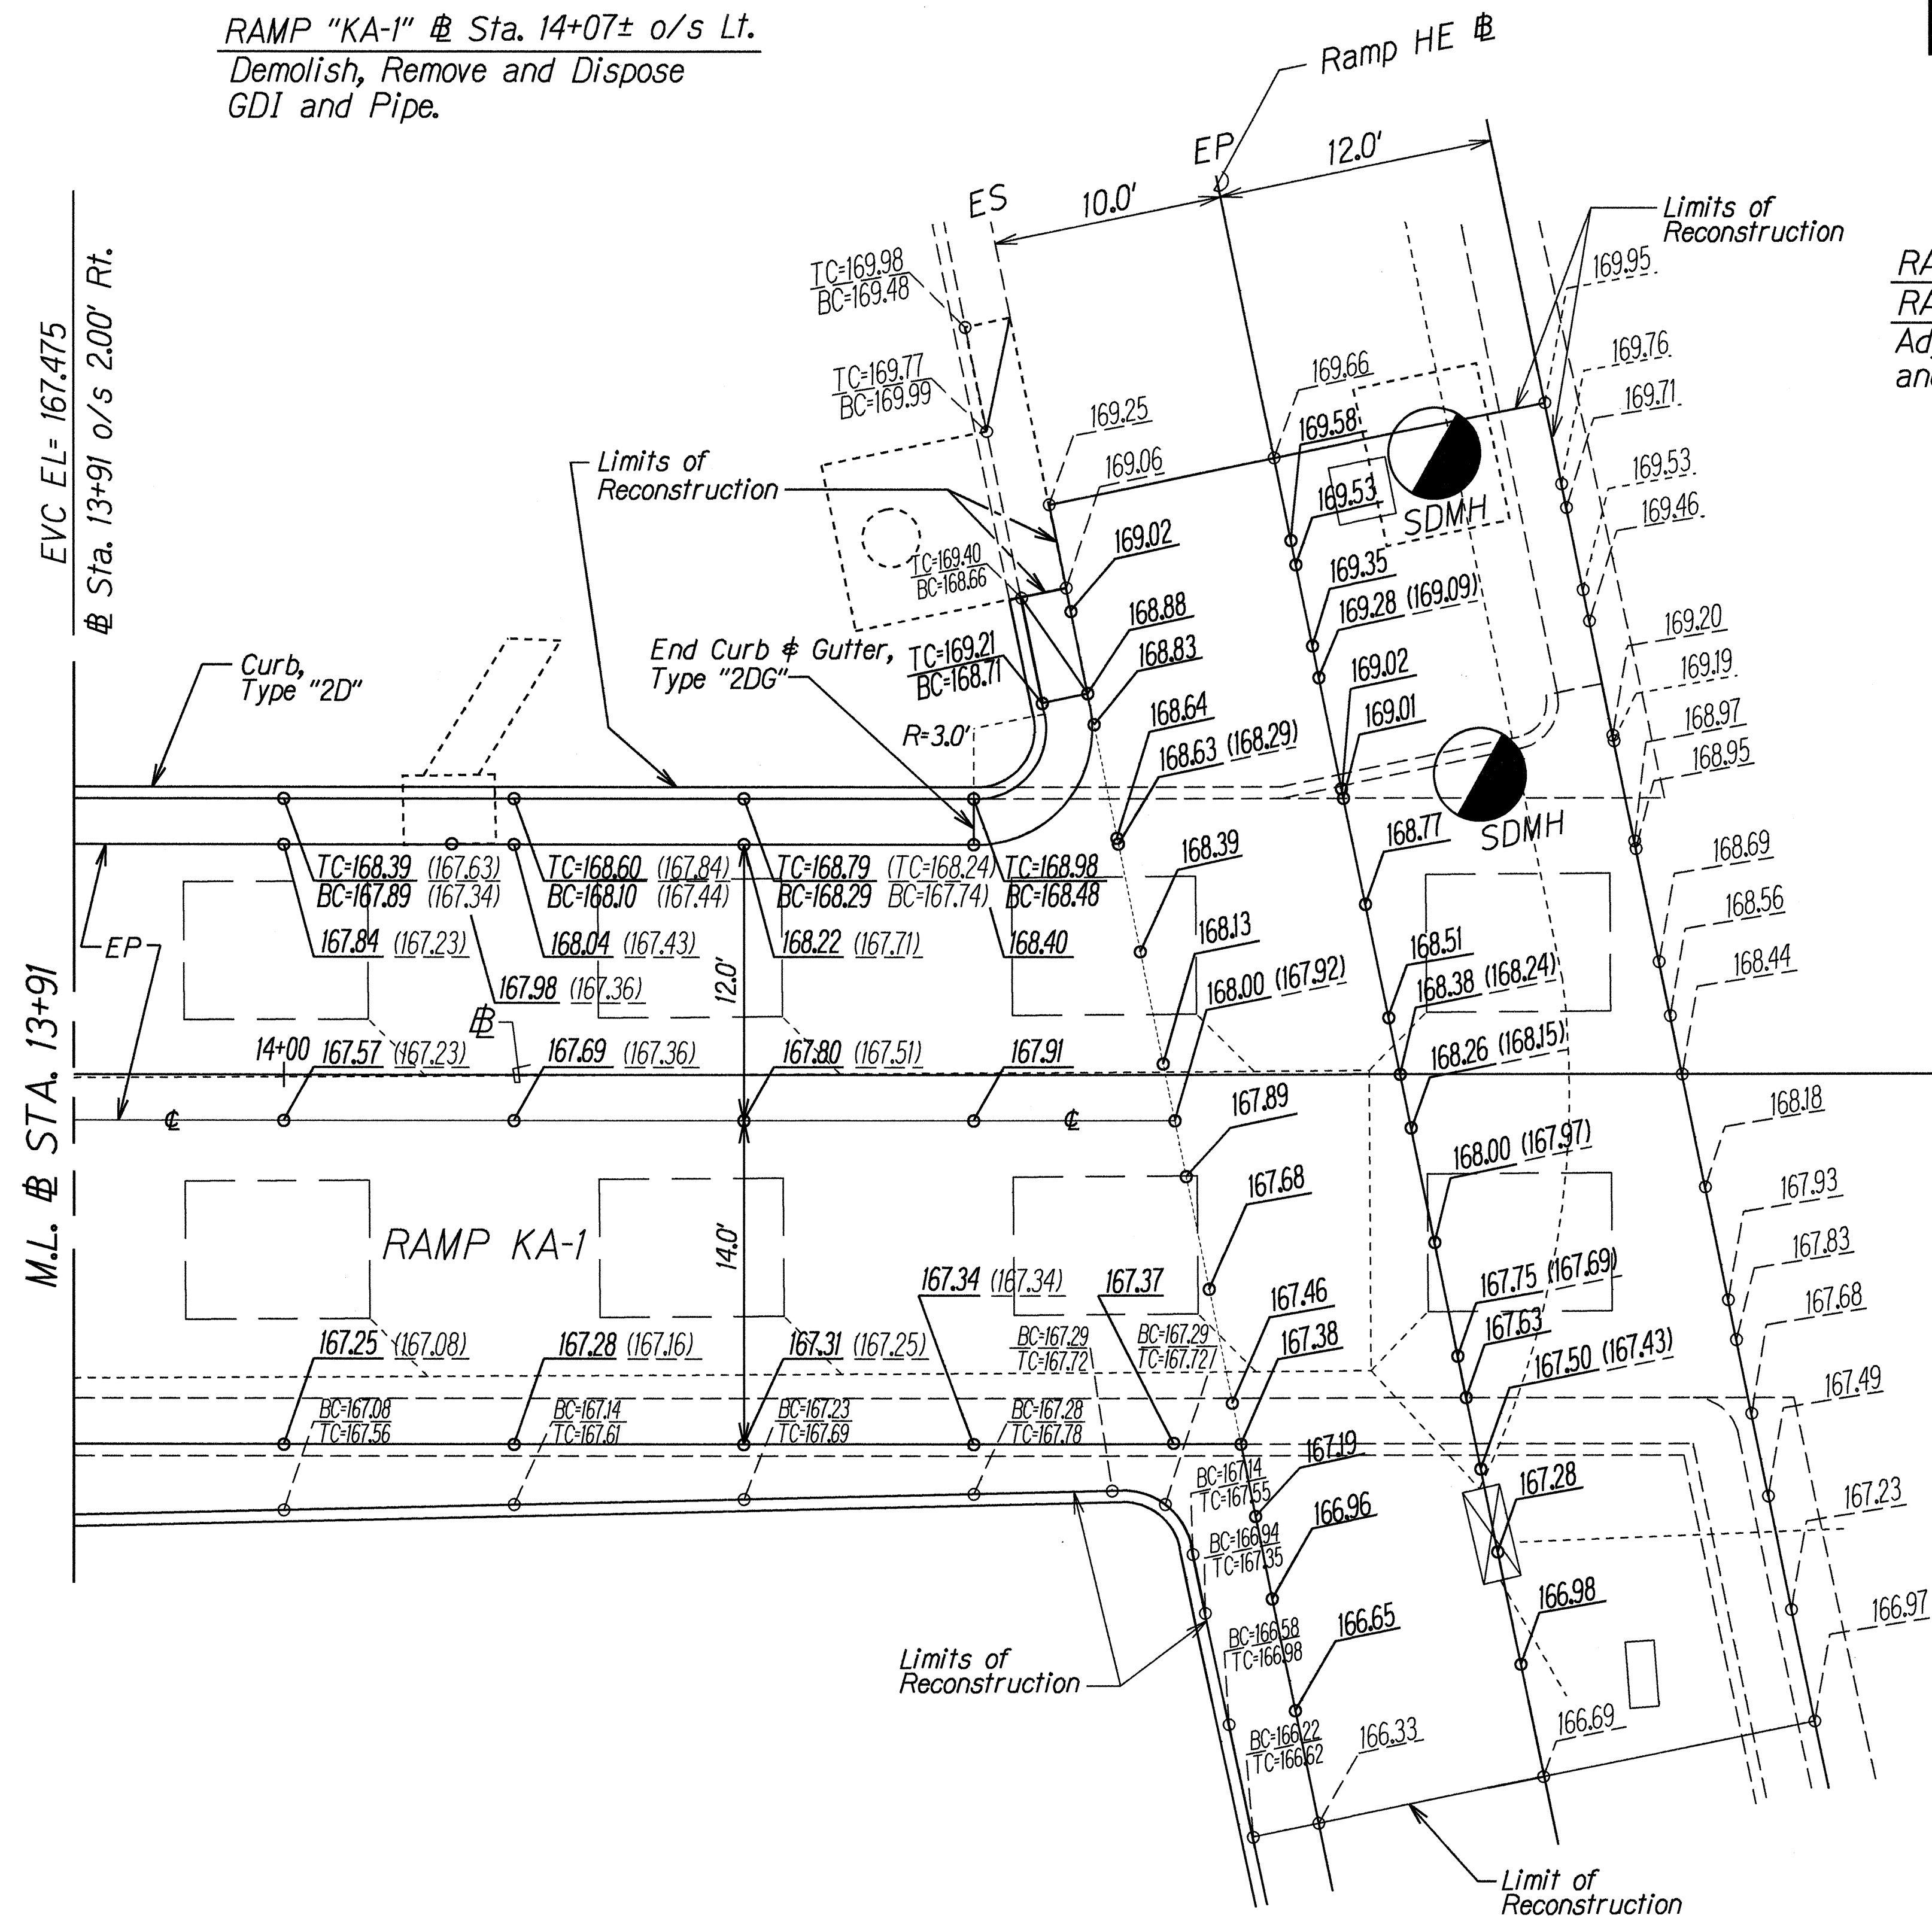

NOTES:

- Layout and location of New Pavement Markings/Markers shall be the same as current, existing Pavement Marking/Markers.
- Cold Plane existing pavement, as needed, to provide a minimum thickness of 1 1/2" Asphalt Pavement, Mix No. IV.

LEGEND

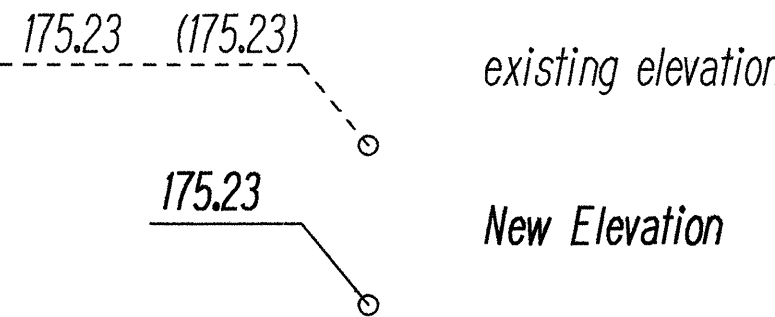

12/12/00	Added sheet for pavement grades at Ramp KA-1
DATE	REVISION

STATE OF HAWAII
DEPARTMENT OF TRANSPORTATION
HIGHWAYS DIVISION

PAVEMENT GRADE
RAMP "KA-1"
INTERSTATE ROUTE HI
Kunia Interchange Improvements
F.A.I. Project No. IM-HI-1(29)

Scale: 1"=5' Date: Dec., 2000

SHEET No. 2 OF 2 SHEETS