SUMMARY OF SIGNS								
A CONTRACTOR OF THE CONTRACTOR	MESSAGE	QUANTITY						
DESIGNATION		<= 10 SQ. FT		> 10 SQ. FT		RELOCATE		
		W/POST	WO/POST	W/POST	WO/POST	WO/POST		
R3-1-B	(SYMBOL) NO RIGHT TURN		1			1		
R3-4-B	(SYMBOL) NO U TURN		1					
R17-3	TURN LEFT ON LEFT ARROW ONLY		1					
W3-3	(SYMBOL) SIGNAL AHEAD	1						
(SUPP. PANEL)	SIGNAL AHEAD		1					
	TOTALS	1	4			1		

	1		
DESIGNATION	MESSAGE	W/POST	
CG20-2A	END ROAD WORK	3	
CW20-1Ad	ROAD WORK AHEAD		
	TOTALS	3	

SUMMARY OF PAVEMENT MARKINGS				
DESCRIPTION	QUANTITY			
PAVEMENT MARKERS				
TYPE A	16 EA.			
TYPE C	60 EA.			
TYPE D	2 EA.			
TYPE H	18 EA.			
TYPE J	5 EA.			
TAPE - TYPE I OR THERMOPLASTIC EXTRUSION				
8-INCH PAVEMENT STRIPE (WHITE)	510 L.F.			
TAPE - TYPE II OR THERMOPLASTIC EXTRUSION				
DBL 4-INCH PAVEMENT STRIPE (YELLOW)	55 LF.			
4-INCH PAVEMENT STRIPE (WHITE)	700 L.F.			
4-INCH PAVEMENT STRIPE (YELLOW)	570 LF.			
12-INCH PAVEMENT STRIPE (WHITE)	360 LF.			
TAPE - TYPE III OR THERMOPLASTIC EXTRUSION				
4-INCH PAVEMENT STRIPE (WHITE)	50 LF.			
4-INCH PAVEMENT STRIPE (YELLOW)	100 LF.			
12-INCH PAVEMENT STRIPE (WHITE)	80 L.F.			
PAVEMENT ARROW	11 EA.			
PAVEMENT WORD	1 EA.			



STATE OF HAWAII
DEPARTMENT OF TRANSPORTATION
HIGHWAYS DIVISION
MISCELLANEOUS

<u>SUMMARIES</u>

INTERSTATE ROUTE H-1, WAIAU I.C.


Traffic Signals at Moanalua Road

PROJECT NO. H1E-01-98

Scale: None

Date: Nov., 1997

SHEETS

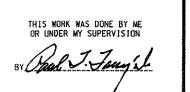

SHEET No. / OF

FISCAL SHEET TOTAL SHEETS

H1E-01-98 1998

> 10 SQ. FT

WO/POST

W/POST

FED. ROAD DIST. NO. STATE

HAWAII

WO/POST

<= 10 SQ. FT

SUMMARY OF CONSTRUCTION SIGNS

HAW.

QUANTITY