	INDEX TO DRAWINGS
SHEET NO.	DESCRIPTION
1	TITLE SHEET
2	STANDARD PLANS SUMMARY
3	PAVEMENT MARKING, LEGEND, DETAILS & NOTES
4	SIGNING & PAVEMENT MARKING PLAN
5	GENERAL NOTES AND LEGEND TRAFFIC SIGNAL SYSTEM
6	MOANALUA ROAD INTERCONNECT
7	TRAFFIC SIGNAL PLAN
8	POWER SOURCE
9	LOOP DETECTOR DETAILS
10 – 12	TRAFFIC SIGNAL DETAILS
13	MISCELLANEOUS SUMMARIES

<u> </u>	

STATE OF HAWAII

DEPARTMENT OF TRANSPORTATION


HIGHWAYS DIVISION HONOLULU, HAWAII "AS-BUILT"


PLANS FOR

INTERSTATE ROUTE H-1, WAIAU I. C.

TRAFFIC SIGNALS AT MOANALUA ROAD PROJECT NO. H1E-01-98

> DISTRICT OF EWA ISLAND OF OAHU

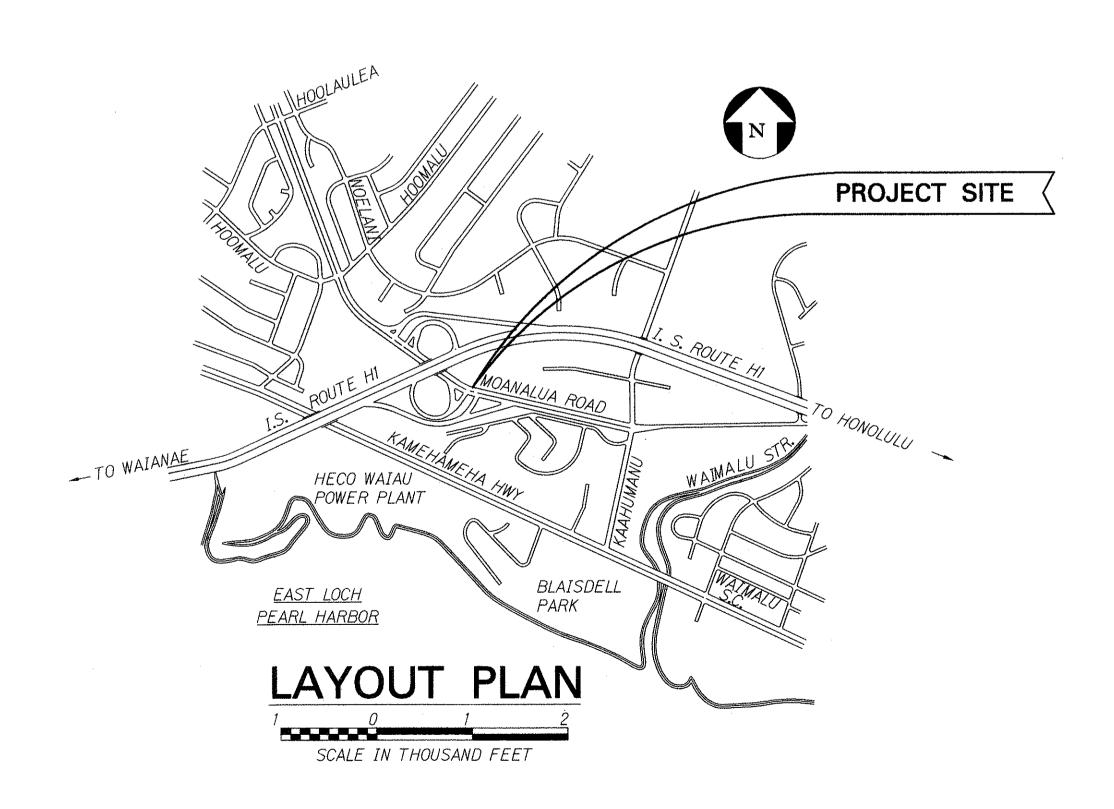

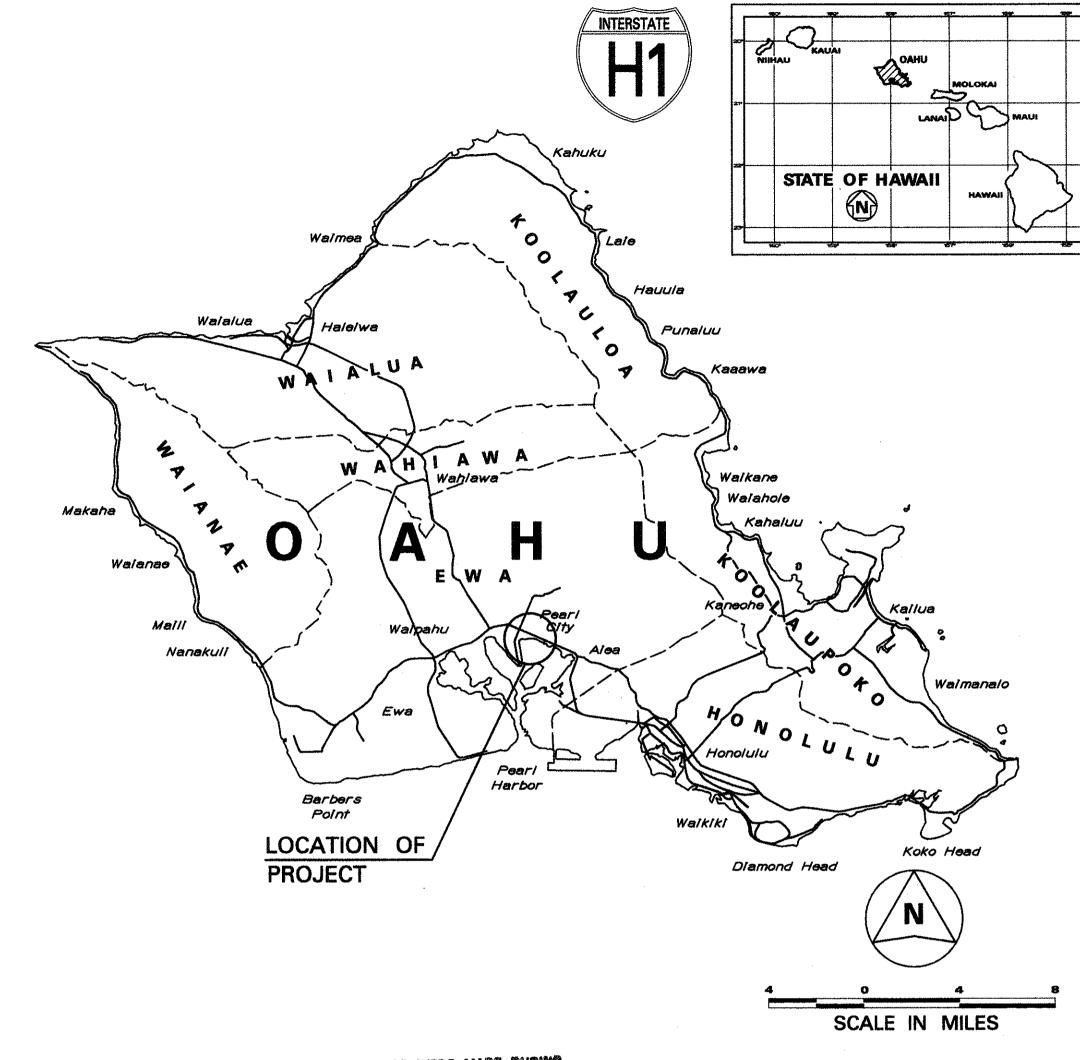

FED. ROAD DIST. NO.

FISCAL SHEET YEAR NO.

PROJ. NO.

H1E-01-98

NO SIGNIFICANT CHANGES WERE MADE DURING CONSTRUCTION ON THESE PLANS EXCEPT CHANGES IN THE ORIGINAL THEORETICAL QUANTITIES. FOR ACTUAL QUANTITIES, REFER TO PROJECT LEDGES

DEPARTMENT OF TRANSPORTATION STATE OF HAWAII

APPROVED: DIR. OF TRANSPORTATION

DATE