	INDEX TO DRAWINGS
SHEET NO.	DESCRIPTION
1	TITLE SHEET
2	STANDARD PLANS SUMMARY
	TYPICAL CONCRETE REPAIRS,
3	GENERAL NOTES AND ESTIMATED
	QUANTITIES
4	LAYOUT PLAN AND NOTES
A section of the sect	

STATE OF HAWAII

DEPARTMENT OF TRANSPORTATION

HIGHWAYS DIVISION HONOLULU, HAWAII


"AS-BUILT"
PLANS FOR

INTERSTATE ROUTE H-1

WAIAWA BRIDGE NO. 1
REPAIR SPALLS ON DECK
PROJECT NO. H1D-01-98M

DISTRICT OF EWA ISLAND OF OAHU

SCALE IN HUNDRED FEET

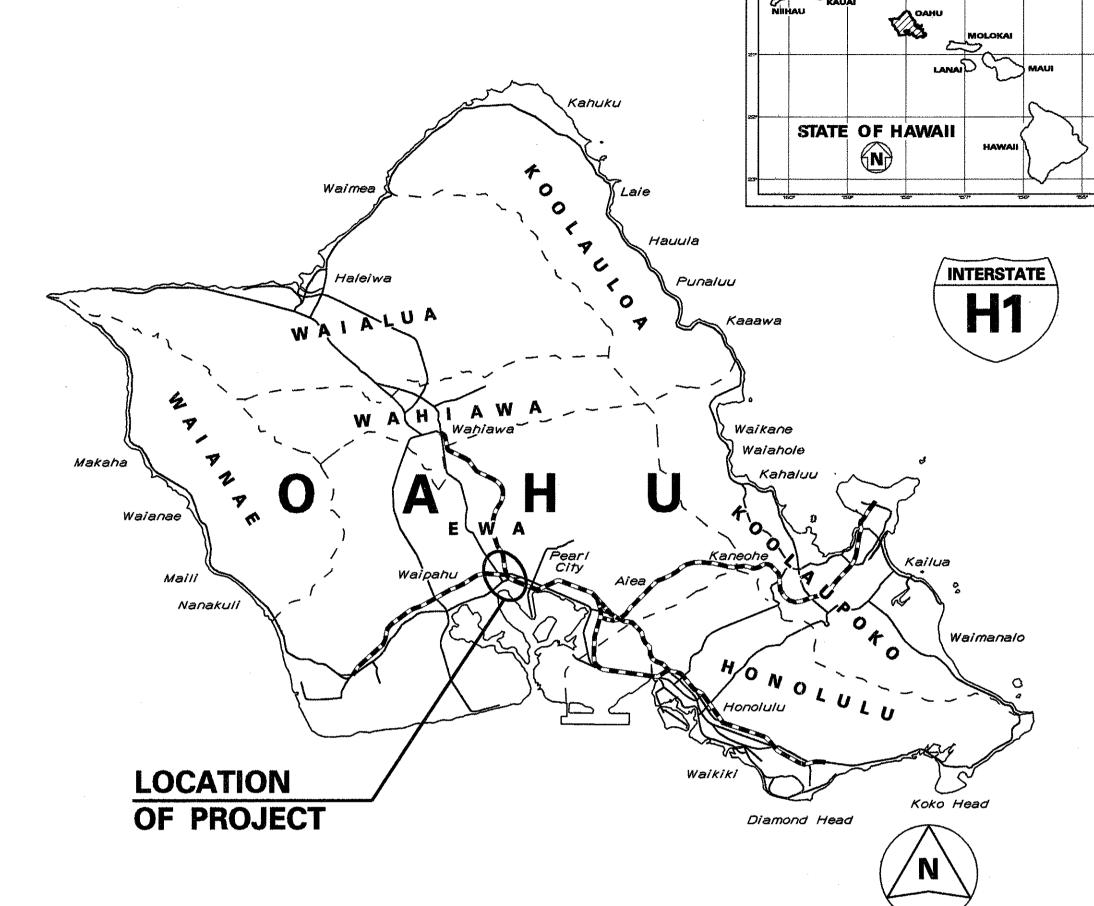

---- FEDERAL AID INTERSTATE PROJECTS PREVIOUSLY CONSTRUCTED OR UNDER CONSTRUCTION

MILE POST 9.13

NO SIGNIFICANT CHANGES WERE MADE DURING CONSTRUCTION ON THESE PLANS FXCEPT CHANGES IN THE ORIGINAL THEORETICAL QUANTITIES. FOR ACTUAL QUANTITIES, REFER TO PROJECT LEDGER AND/OR COMPUTATION BOOK.


SCALE IN MILES

DEPARTMENT OF TRANSPORTATION STATE OF HAWAII

APPROVED:

DIR. OF TRANSPORTATION

ATION DATE

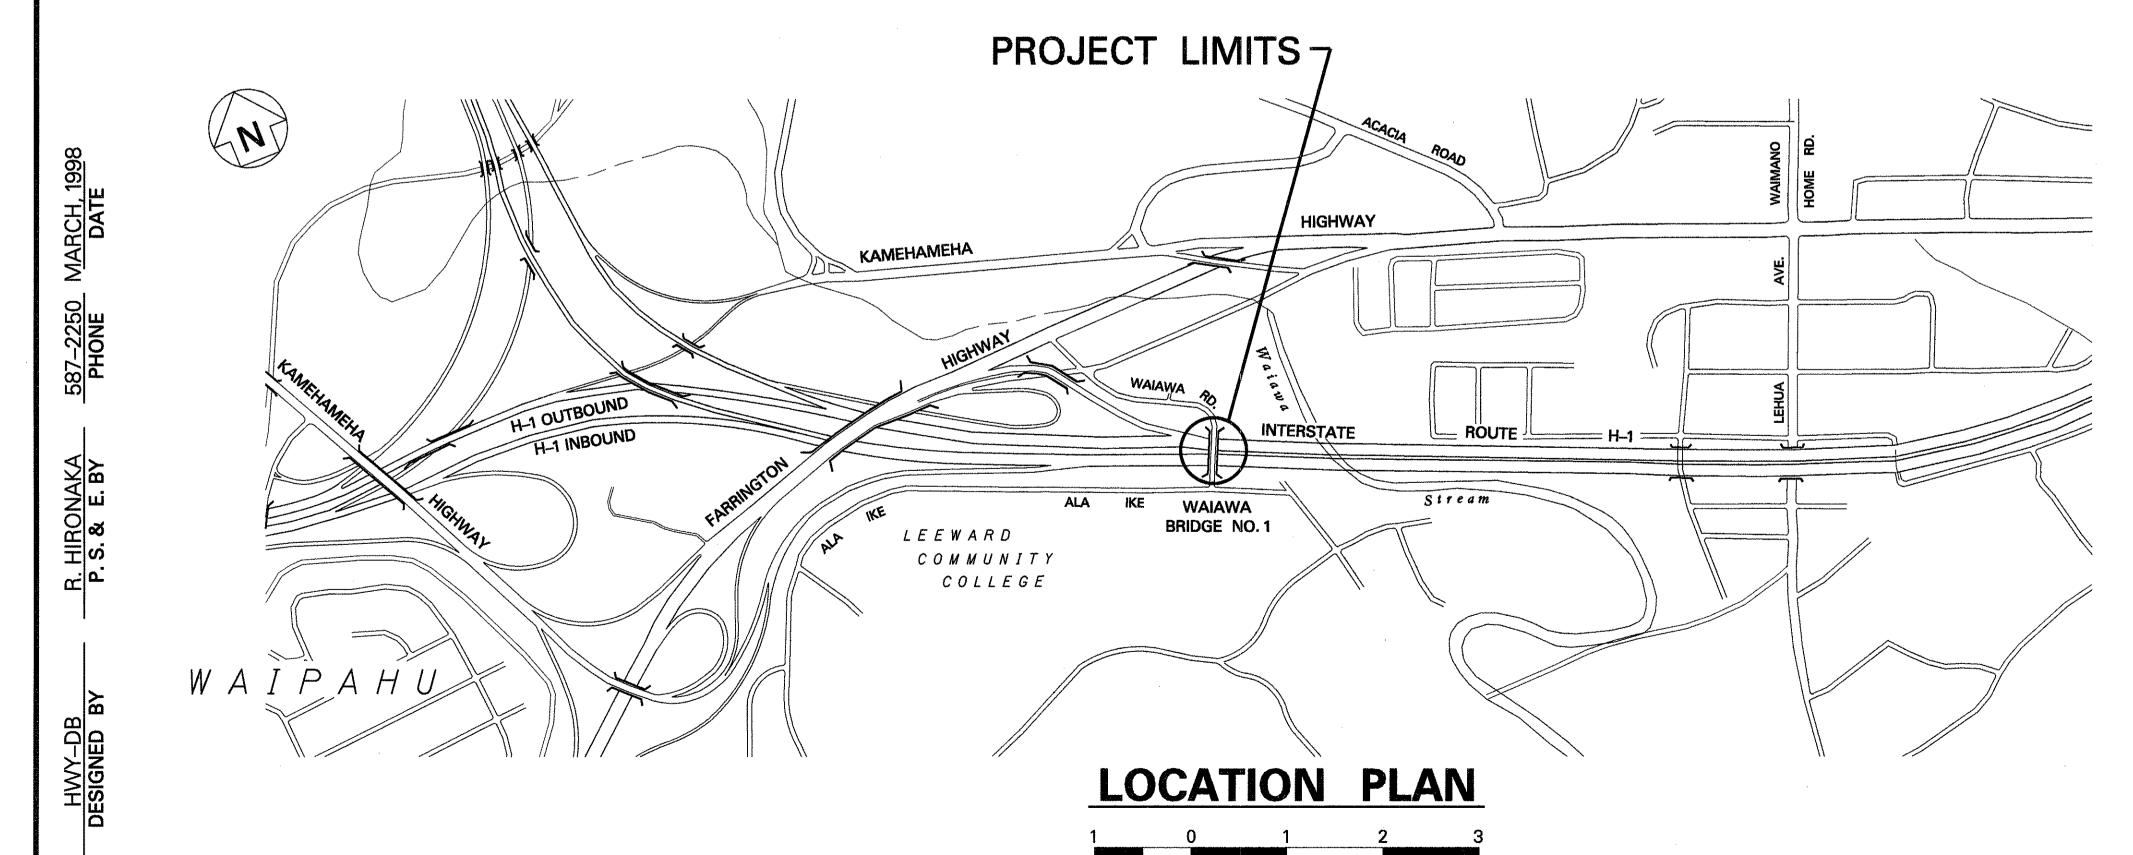

FISCAL SHEET YEAR NO.

H1D-01-98M