


FED. ROAD DIST. NO.	STATE	PROJ. NO.	FISCAL YEAR	SHEET NO.	TOTAL SHEETS
HAWAII	HAW.	HIC-02-98M	1998	6	13

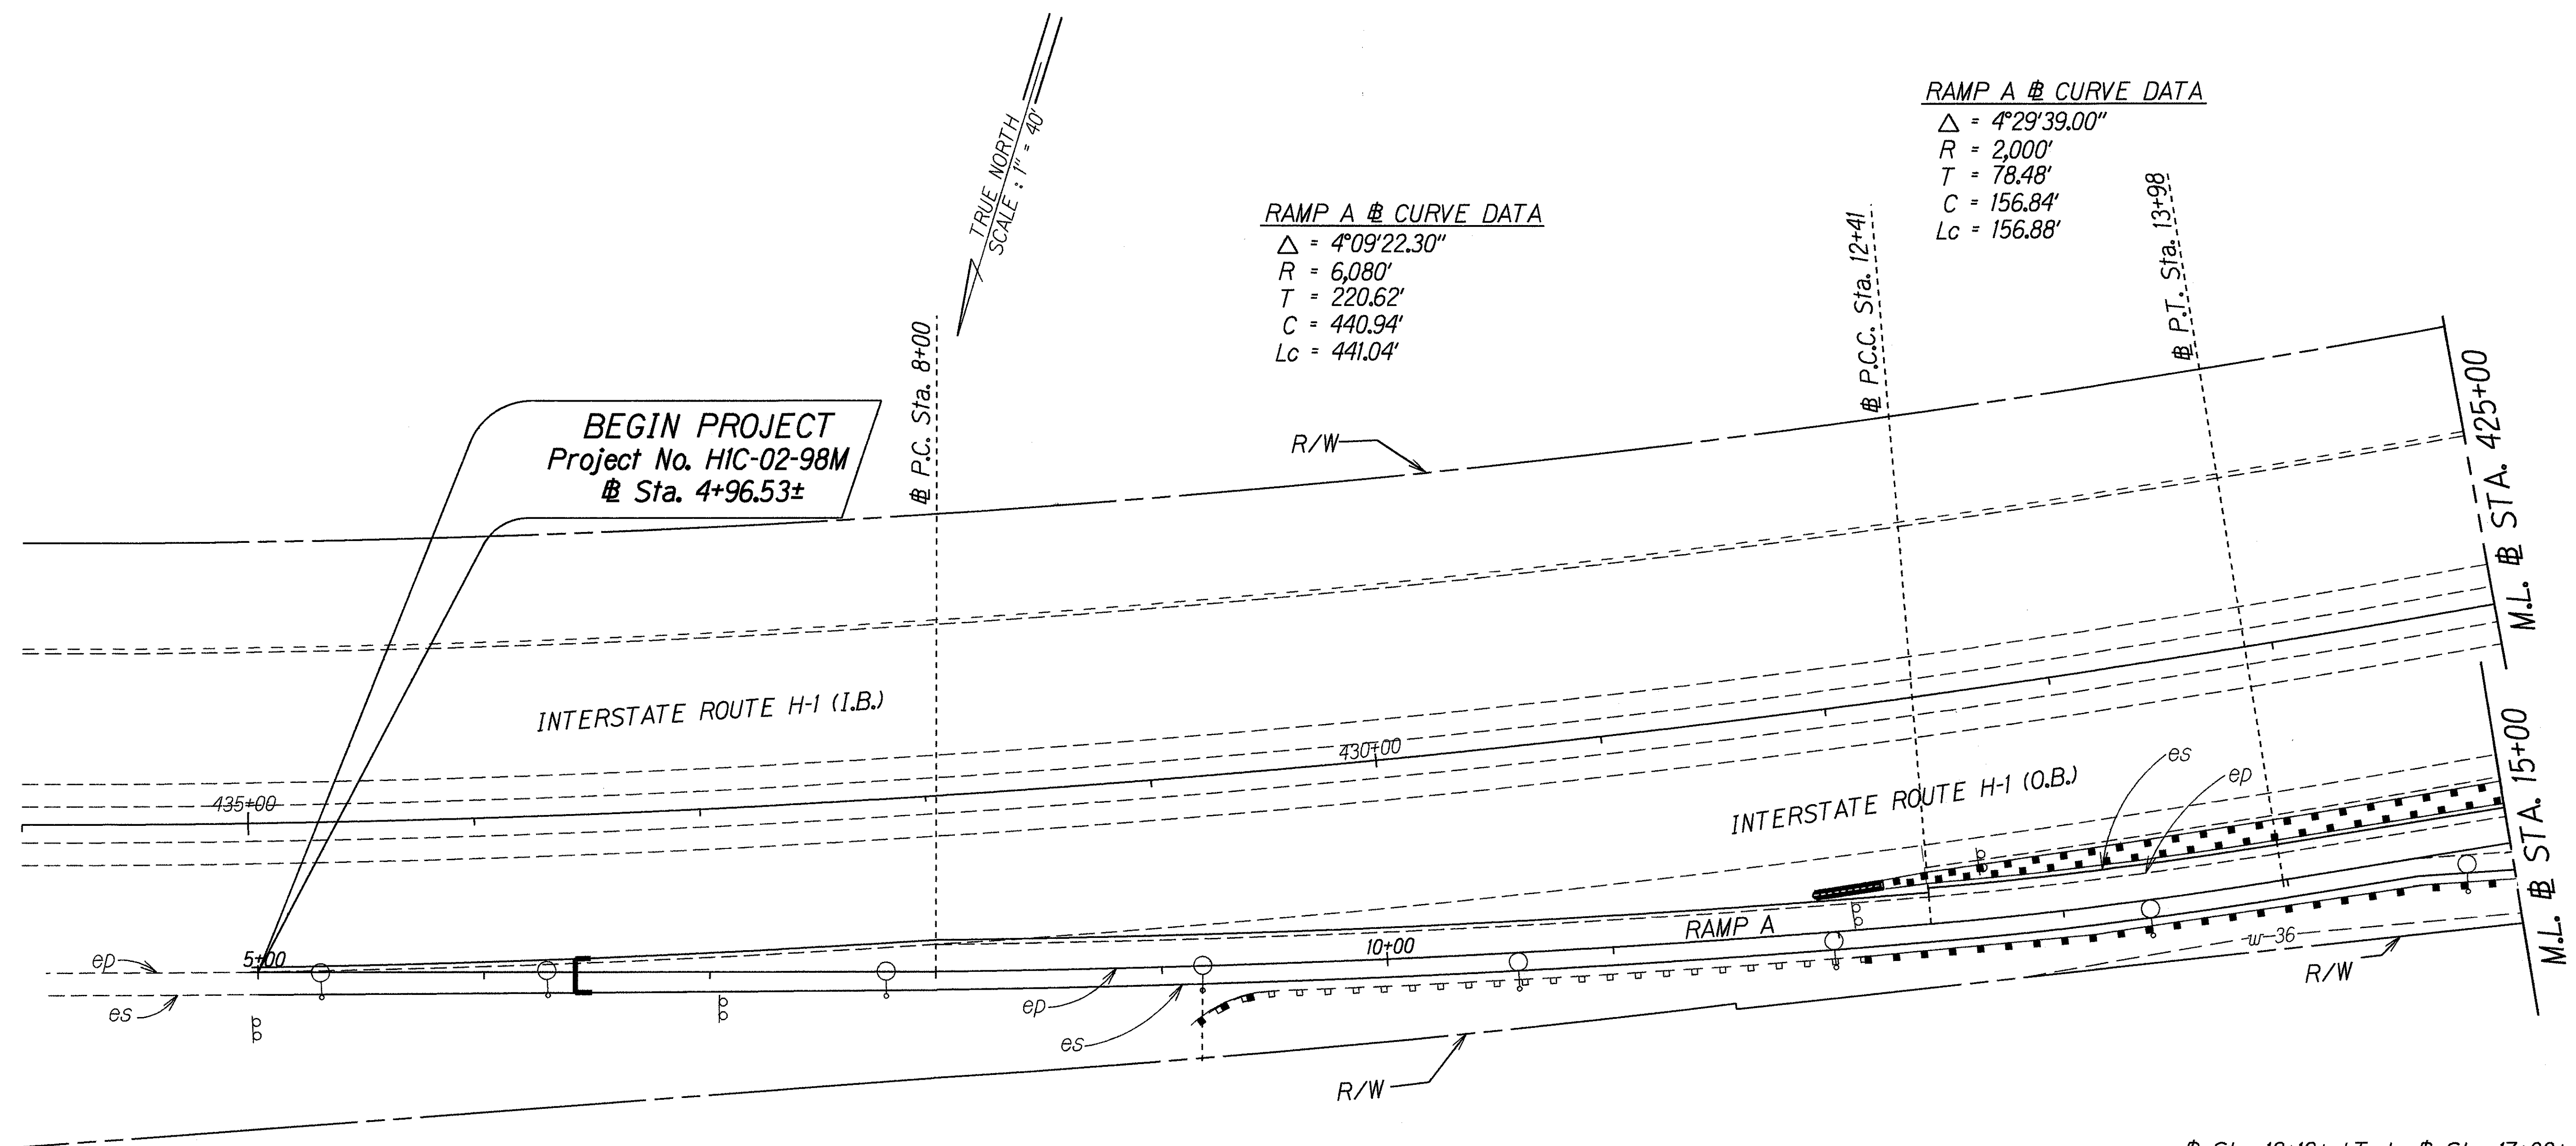


SURVEY PLOTTED BY	DATE
DRAWN BY	2/12/98
TRACED BY	
NOTED BY	
CHECKED BY	

STATE OF HAWAII DEPARTMENT OF TRANSPORTATION HIGHWAYS DIVISION	
ROADWAY PLANS	
INTERSTATE ROUTE H-1 RESURFACING OF WAIKELE OFF-RAMP (OUTBOUND)	
PROJECT NO. HIC-02-98M	
Scale: 1"=40'	Date: Apr., 1998
SHEET No. 1 OF 2 SHEETS	

FED. ROAD DIST. NO.	STATE	PROJ. NO.	FISCAL YEAR	SHEET NO.	TOTAL SHEETS
HAWAII	HAW.	HIC-02-98M	1998	7	13

Sta. 12+00± LT. to # Sta. 18+00± LT.
Guardrail to be Installed by Another Contractor
Under Project No. 1M-HI-1(223).

TRUE NORTH
SCALE: 1" = 40'

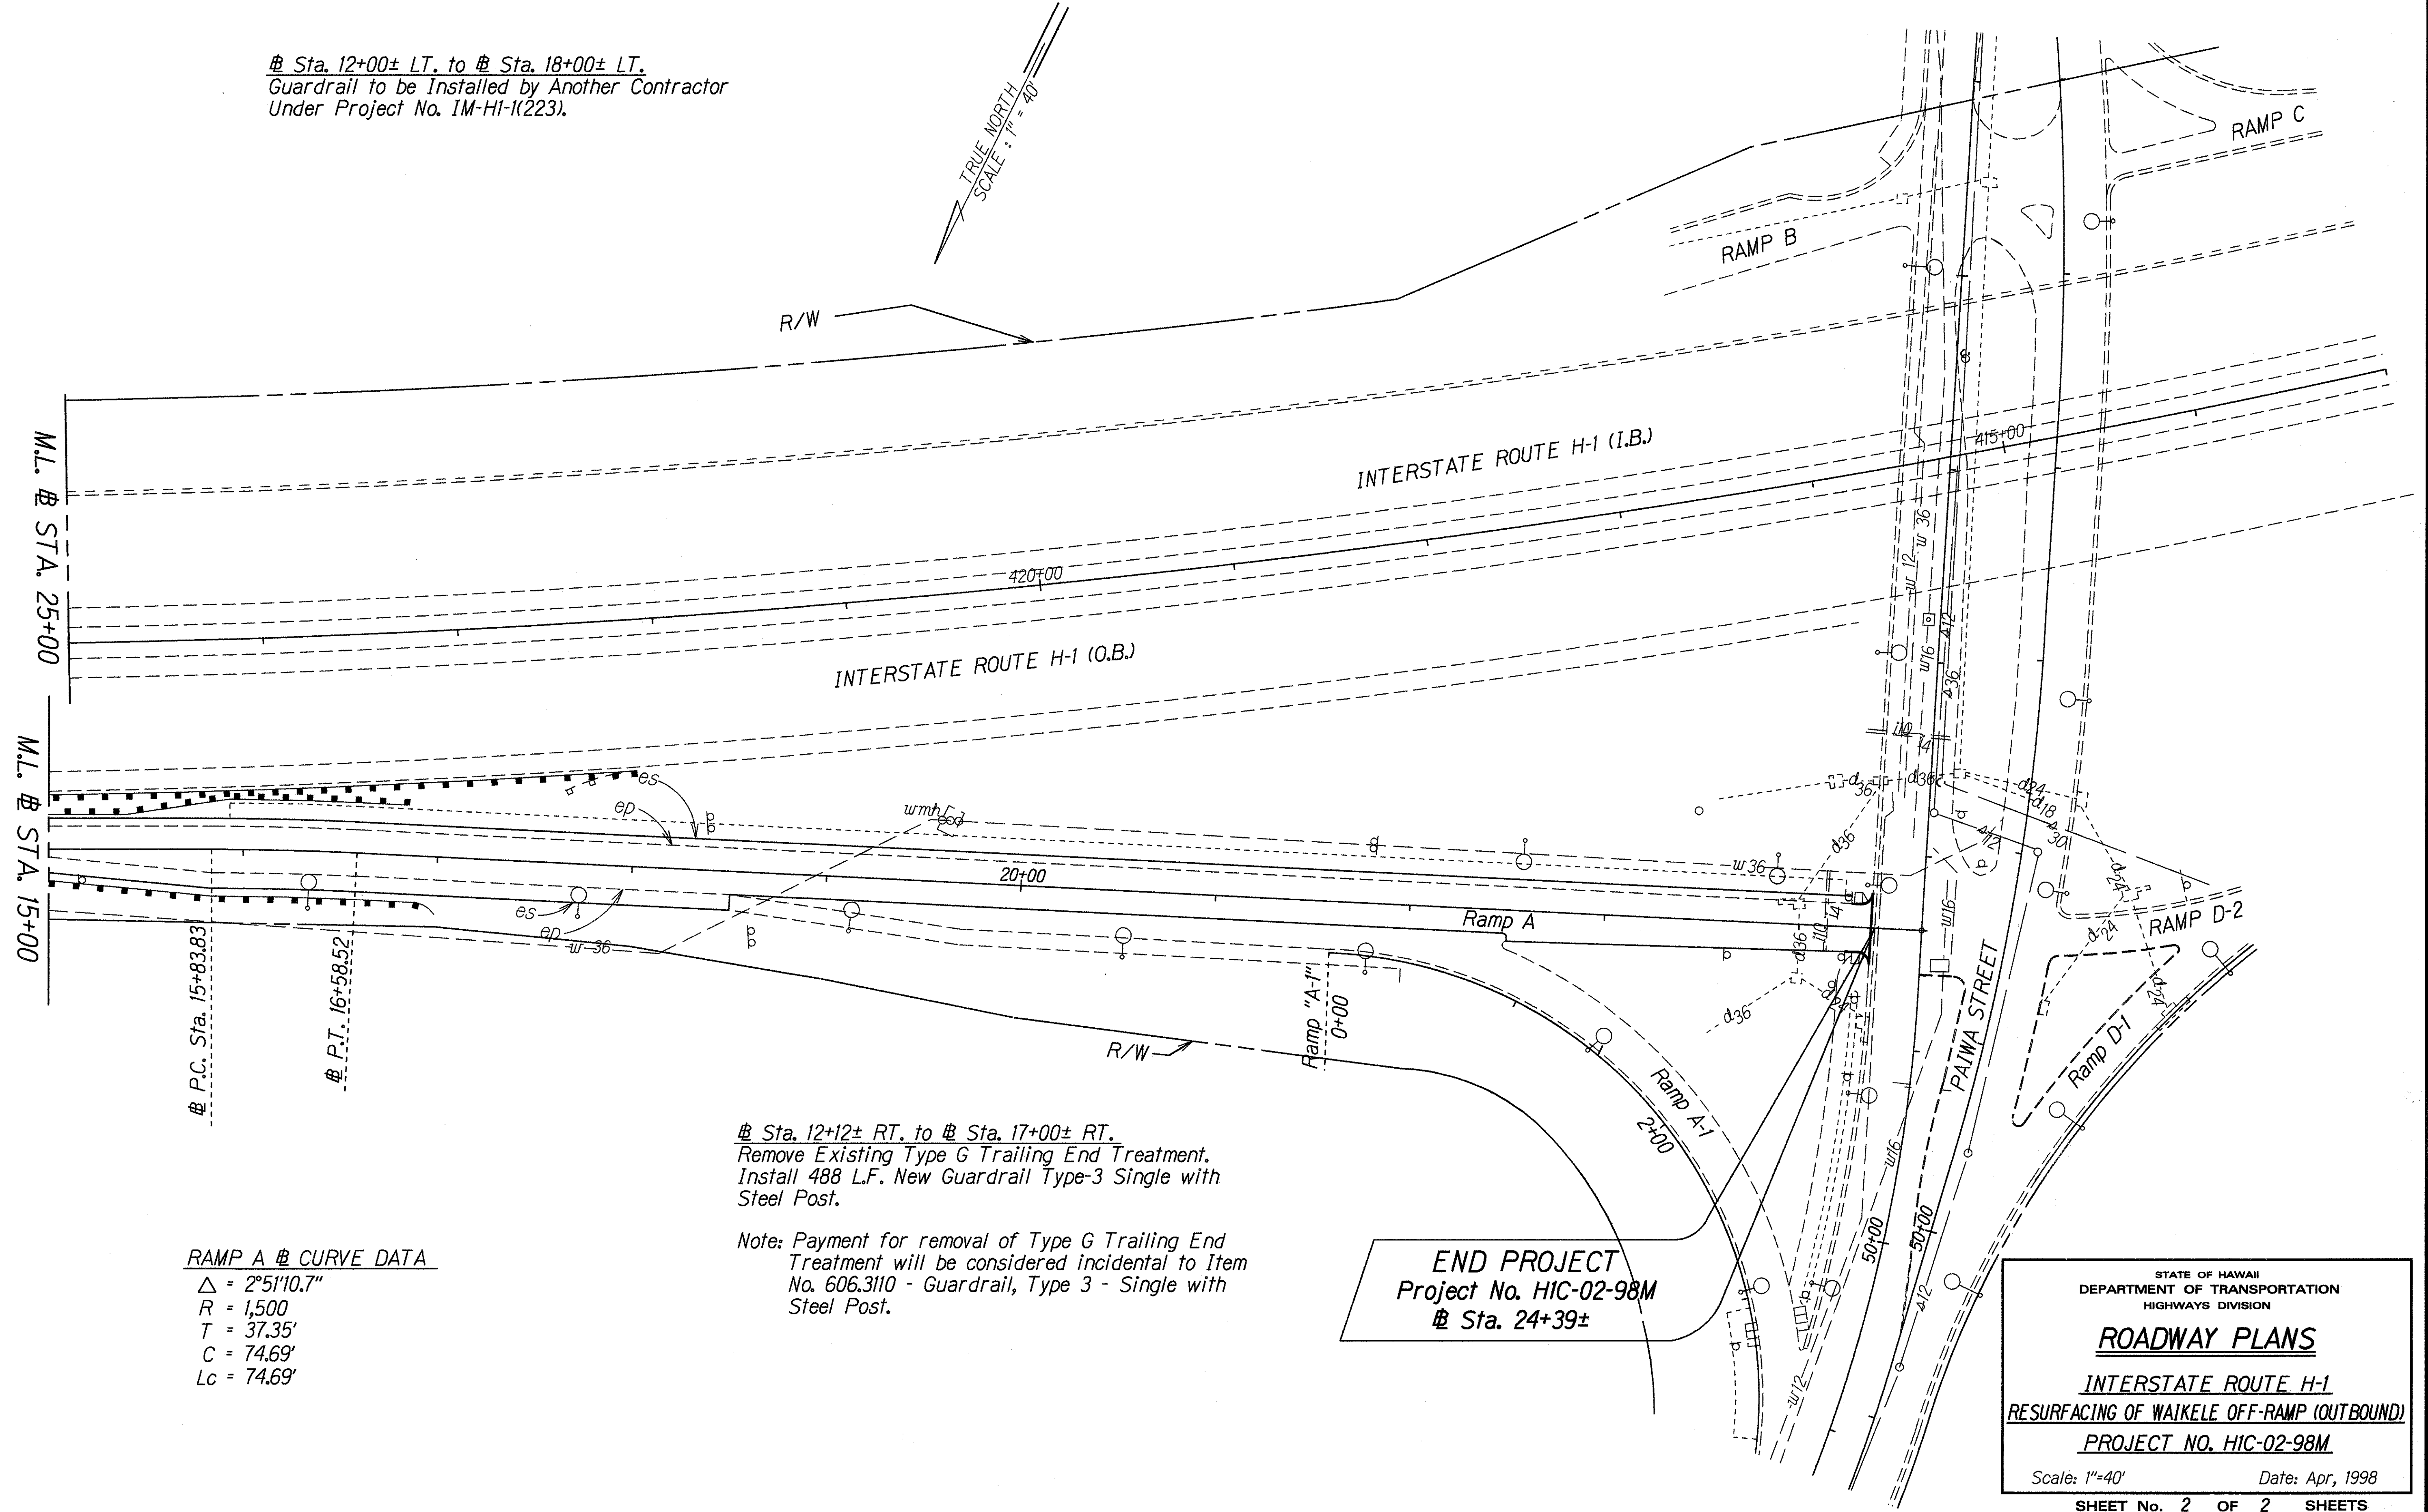

RAMP A @ CURVE DATA
 $\Delta = 2^\circ 51' 10.7''$
 $R = 1,500$
 $T = 37.35'$
 $C = 74.69'$
 $Lc = 74.69'$

Sta. 12+12± RT. to # Sta. 17+00± RT.
Remove Existing Type G Trailing End Treatment.
Install 488 L.F. New Guardrail Type-3 Single with
Steel Post.

Note: Payment for removal of Type G Trailing End
Treatment will be considered incidental to Item
No. 606.3110 - Guardrail, Type 3 - Single with
Steel Post.

END PROJECT
Project No. HIC-02-98M
Sta. 24+39±

ORIGINAL PLAN	DATE
2/12/99	
SURVEY PLOTTED BY	
DRAWN BY	
DESIGNED BY	
QUANTITIES BY	
CHECKED BY	

STATE OF HAWAII
DEPARTMENT OF TRANSPORTATION
HIGHWAYS DIVISION

ROADWAY PLANS

INTERSTATE ROUTE H-1
RESURFACING OF WAIKELE OFF-RAMP (OUTBOUND)
PROJECT NO. HIC-02-98M

Scale: 1"=40' Date: Apr, 1998

SHEET No. 2 OF 2 SHEETS