

FED. ROAD DIST. NO.	STATE	PROJ. NO.	FISCAL YEAR	SHEET NO.	TOTAL SHEETS
HAWAII	HAW.	HWY-O-05-95	1996	4	5

Emergency Telephone




LEGEND FOR AS-BUILT POSTINGS

Squiggly line for as-built deletion

Double line for as-built deletion

Roadway Text for as-built posting

EMERGENCY TELEPHONE LOCATIONS	
INTERSTATE ROUTE H-1	
EASTBOUND	WESTBOUND
M. P. 17.00 17.58	M. P. 17.25 16.92
M. P. 19.25 19.74	M. P. 19.00 18.62
M. P. 20.00 19.84	M. P. 19.90 19.10
M. P. 21.20 20.92	M. P. 20.45 20.07
M. P. 21.80 22.20	M. P. 21.40 20.79
M. P. 23.60 23.32	Relocated to Kipapa Gulch South Bound Kam Hwy 99 M. P. 22.68 22.68
Relocated to 0.80 M after Kunia off-ramp H-1 West M. P. 24.22 24.85	M. P. 24.58 25.20
M. P. 25.70 26.00	M. P. 26.05 26.51

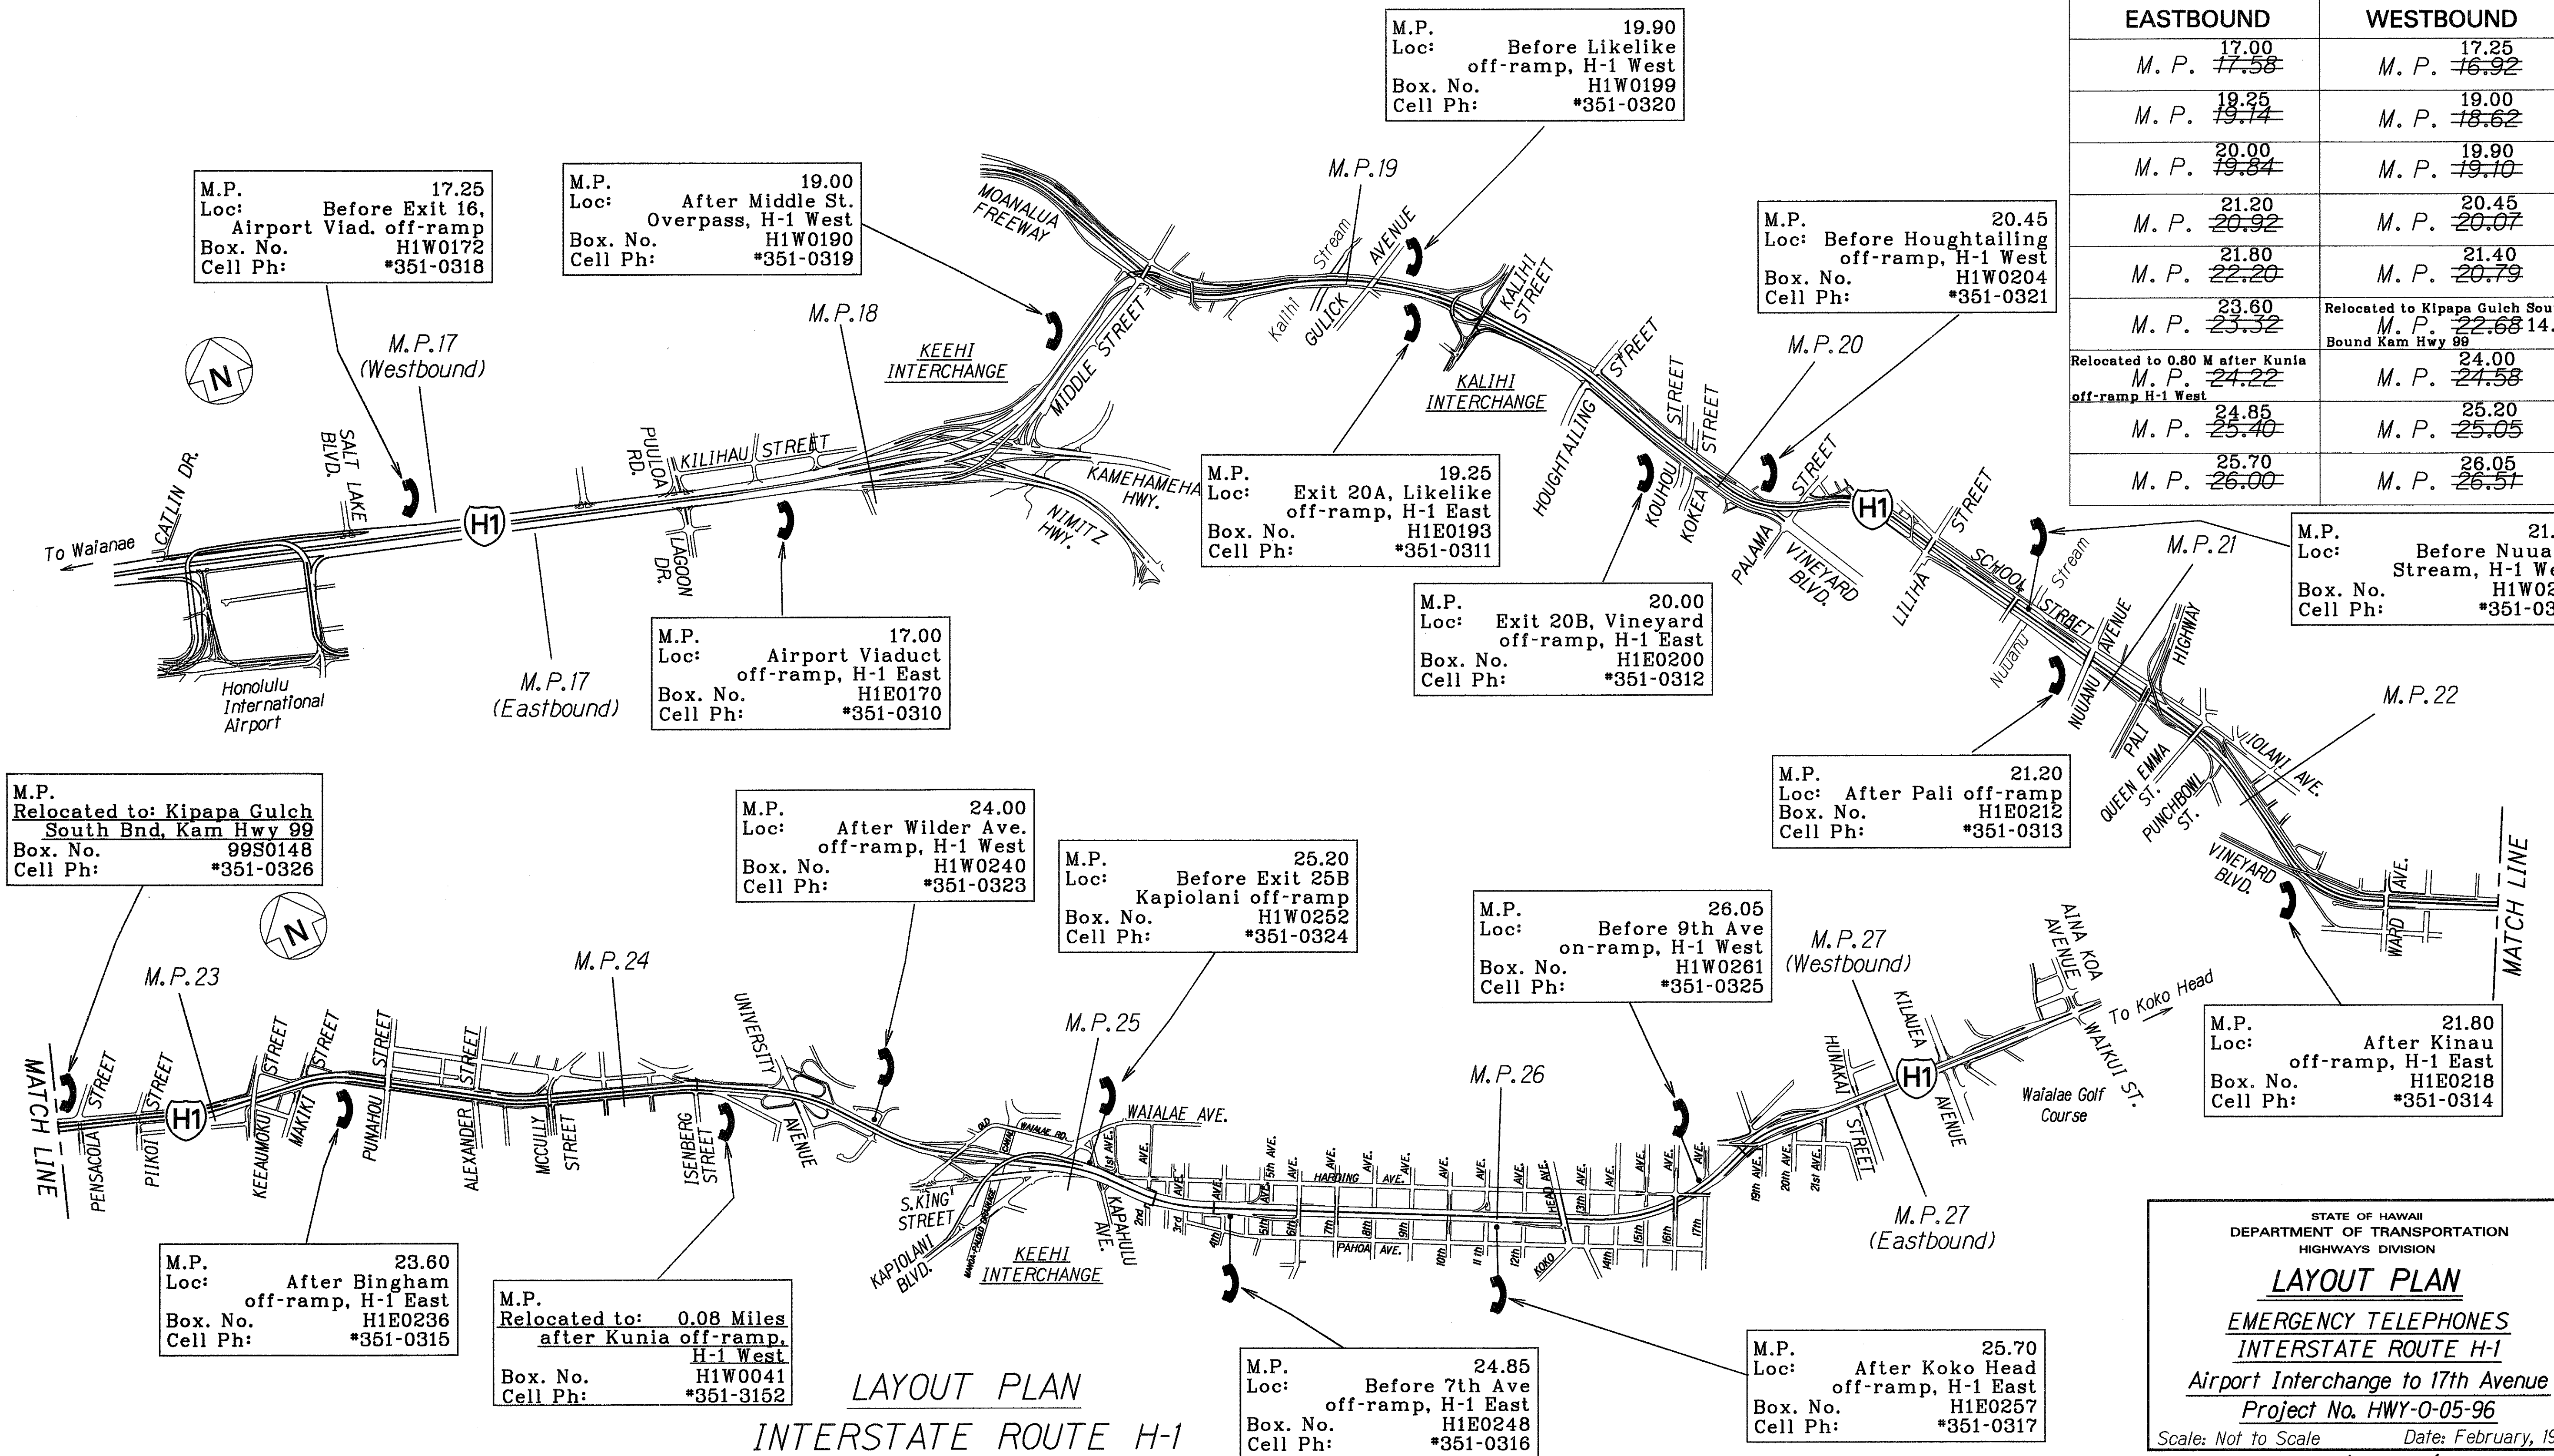

DATE	DATE
DESIGNED BY	DESIGNED BY
TRACED BY	TRACED BY
NOTED BY	NOTED BY
CHECKED BY	CHECKED BY

LAYOUT PLAN
INTERSTATE ROUTE H-1

STATE OF HAWAII
DEPARTMENT OF TRANSPORTATION
HIGHWAYS DIVISION

LAYOUT PLAN

EMERGENCY TELEPHONES
INTERSTATE ROUTE H-1
Airport Interchange to 17th Avenue
Project No. HWY-O-05-96

Scale: Not to Scale Date: February, 1996

SHEET NO. 1 OF 1 SHEETS