	Marketing to the control of the cont
	INDEX TO DRAWINGS
SHEET NO.	DESCRIPTION
1	TITLE SHEET
2	STANDARD PLANS SUMMARY
3	GENERAL NOTES, TYPICAL INSTALLATION AND SIGN DETAILS
4	LAYOUT PLAN
5	MISCELLANEOUS DETAILS
<u> </u>	

STATE OF HAWAII

DEPARTMENT OF TRANSPORTATION


HIGHWAYS DIVISION HONOLULU, HAWAII "AS-BUILT"

PLANS FOR

EMERGENCY TELEPHONES INTERSTAE ROUTE H-1

AIRPORT INTERCHANGE TO 17TH AVENUE PROJECT NO. HWY-0-05-96

> DISTRICT OF HONOLULU ISLAND OF OAHU

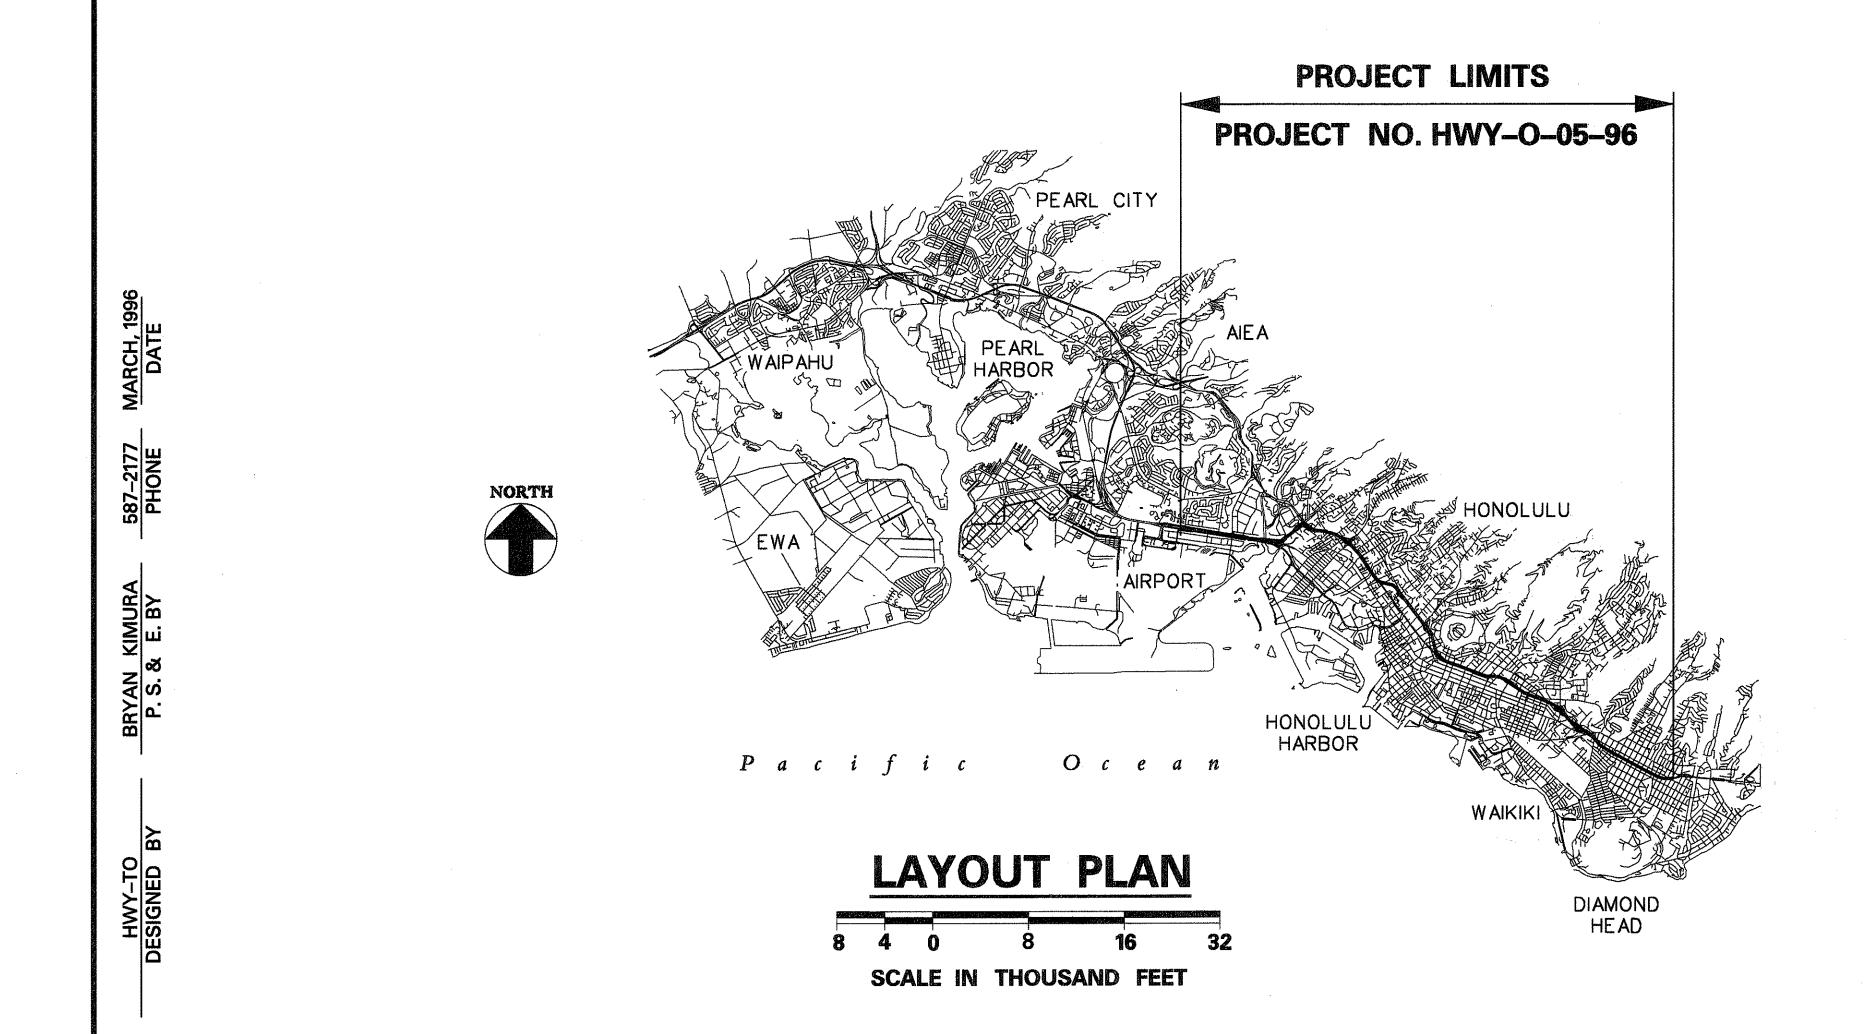

STATE OF HAWAII

FED. ROAD DIST. NO.

FISCAL SHEET YEAR NO.

PROJ. NO.

HAW. HWY-0-05-96

INTERSTATE H1 PROJECT LOCATION SCALE IN MILES

> ---- FEDERAL AID PROJECTS PREVIOUSLY CONSTRUCTED OR UNDER CONSTRUCTION

> > MILE POST 16.980 TO MILE POST 26.770

CHANGES MADE DURING CONSTRUCTION HAVE BEEN NOTED IN RED ON THESE TRACINGS AND CHECKED BY

Sidney S. C. Tre RESIDENT ENGINEER

DEPARTMENT OF TRANSPORTATION STATE OF HAWAII