

GENERAL

1. IN GENERAL, THE WORK SHALL CONFORM TO THE "HAWAII STANDARD SPECIFICATIONS FOR ROAD AND BRIDGE CONSTRUCTION" (LATEST EDITION) AND AASHTO STANDARD SPECIFICATION FOR HIGHWAY BRIDGES W/ CURRENT INTERIMS.
- REINFORCED CONCRETE
1. UNLESS OTHERWISE NOTED, ALL STRUCTURAL CONCRETE SHALL BE CLASS 'A CONFORMING TO THE ABOVE SPECIFICATION. BRIDGE DECK CONCRETE WHICH SHALL BE CLASS "BD".
2. ALL REINFORCING STEEL SHALL CONFORM TO ASTM A615 GRADE 60. EXCEPT STIRRUPS AND TIES SHALL BE GRADE 40.
3. UNLESS OTHERWISE NOTED, SPLICES, LAPS, DOWEL EXTENSIONS AND EMBEDMENTS SHALL BE 50 BAR DIAMETERS MINIMUM.
4. ALL REINFORCING BARS MARKED CONTINUOUS (CONT.) ON THE PLANS SHALL BE LAPPED 40 BAR DIAMETERS MINIMUM.
5. STAGGER ALL SPLICES AS SPECIFIED.
6. ALL WELDING OF REINFORCING SHALL CONFORM TO "STRUCTURAL WELDING CODE - REINFORCING STEEL" (AWS D1.4).
7. REBARS SHALL BE SUPPORTED, BENT AND PLACED AS PER AASHTO AND THE "HAWAII STANDARD SPECIFICATIONS FOR ROAD AND BRIDGE CONSTRUCTION" (LATEST EDITION). UNLESS OTHERWISE NOTED, ALL HOOKS SHALL BE STANDARD HOOKS.
8. MINIMUM COVER IN INCHES FOR REBARS FOR CAST-IN-PLACE CONCRETE:
- | | |
|------------------------------------|--------|
| CONCRETE CAST AGAINST EARTH | 3" |
| DECK SLAB | |
| TOP BARS | 1-1/2" |
| BOTTOM BARS | 1-1/4" |
| BEAMS | |
| OUTSIDE FACE TO STIRRUPS | 1-1/2" |
| MAIN REINFORCING | 2" |
| ABUTMENTS, PIERS & RETAINING WALLS | 2" |
| COLUMNS - TO TIES | 2" |
9. AT TIME CONCRETE IS PLACED, REINFORCING SHALL BE FREE FROM MUD, OIL, LAITANCE, MILL SCALE, RUST OR OTHER DELETERIOUS COATINGS.
10. REINFORCEMENT, ANCHOR BOLTS, DOWELS AND ALL OTHER EMBEDDED ITEMS SHALL BE POSITIVELY SECURED BEFORE PLACING CONCRETE.
11. WHEN REBARS OR THREADED RODS ARE DRILLED AND GROUTED IN PLACE USE SIKADUR HI-MOD EPOXY OR APPROVED EQUAL. FOLLOW THE MANUFACTURER'S INSTRUCTIONS FOR INSERT INSTALLATION.

BRIDGE

1. CENTER PIER AND ABUTMENT FOOTINGS DESIGNED TO BEAR ON WEATHERED BASALT. THIS CONDITION WAS ASSUMED TO BE ENCOUNTERED AT THE SAME ELEVATIONS AS THE EXISTING FOUNDATIONS (EXCEPT AT ABUTMENT #2). ANY OVEREXCAVATION THAT MAY BE REQUIRED SHALL BE BACKFILLED WITH A MINIMUM OF CLASS 'D' CONCRETE AT THE CONTRACTOR'S EXPENSE AND AS DIRECTED BY THE ENGINEER. AT ABUTMENT #2 OVEREXCAVATION IS ANTICIPATED. SEE DETAIL C/S-10.
2. BACKFILL BELOW ABUTMENT ROCKERS SHALL BE IN PLACE BEFORE ROCKER IS POURED. THE REMAINDER OF THE BACKFILL SHALL BE PLACED AFTER ENTIRE DECK IS CURED AND SHALL BE BROUGHT UP SIMULTANEOUSLY AT EACH ABUTMENT TO PREVENT UNBALANCED EARTH PRESSURES.
3. VERTICAL PIER COLUMN BARS SHALL BE ARRANGED IN SUCH A MANNER AS TO MISS PIER CAP REINFORCING ABOVE.
4. IN GENERAL, TOP OF CONCRETE DECK OF STRUCTURE SHALL BE CONSTRUCTED TO FOLLOW THE FINISH ROADWAY GRADES WITH ADJUSTMENTS FOR CAMBER AND DEFLECTION OF THE PRESTRESSED GIRDERS AS SHOWN ON THE PRESTRESSED CAMBER DIAGRAM.
5. CLOSURE STRIP AND OVERLAY SHALL NOT BE POURED ^{until} ~~LESS THAN 60~~ DAYS AFTER THE BRIDGE SIDEWALKS AND CONCRETE RAILINGS HAVE BEEN POURED. NO CONCRETE TRUCK OR OTHER HEAVY EQUIPMENT SHALL BE PERMITTED ON THE BRIDGE DURING THE CLOSURE STRIP POUR, unless placement of concrete can be completed w/in 90 minutes NOR FOR A MIN. OF 24 HOURS AFTER INITIAL SET OF CONC. and there is no measurable change in deflection of the new bridge deck.
6. SALVAGE EXISTING PIPE RAILS AND HAUL TO THE HDOT DISTRICT YARD.
7. SALVAGE EXISTING RAIL POSTS. RAILING POSTS MAY BE REUSED WHEN APPROVED BY THE ENGINEER. REFINISH WHEN REQUIRED BY THE ENGINEER.

RETAINING WALLS

1. ALL FOOTINGS SHALL BEAR ON FIRM UNDISTURBED NATURAL SOILS OR PROPERLY COMPACTED STRUCTURAL FILL. THE BOTTOM OF ALL FOOTING EXCAVATIONS SHALL BE INSPECTED AND APPROVED BY A QUALIFIED FOUNDATION ENGINEER PRIOR TO PLACEMENT OF REINFORCING STEEL OR CONCRETE. COMPACT ANY STRUCTURAL FILL UNDER FOOTING TO 95% MAXIMUM RELATIVE DENSITY IN ACCORDANCE WITH THE STANDARD SPECIFICATIONS.
2. ALL WATER, MUD AND DEBRIS SHALL BE REMOVED FROM THE BOTTOM OF FOOTING EXCAVATIONS PRIOR TO THE PLACEMENT OF CONCRETE.
3. AN 18" THICK CONTINUOUS BLANKET OF FREE DRAINING GRAVEL SHALL BE PLACED AT THE BACK OF ALL WALLS. AT THE BOTTOM OF THE BLANKET A 6 INCH MINIMUM DIAMETER PERFORATED DRAIN PIPE SHALL BE PLACED AND SLOPED TO DAY LIGHT AS DIRECTED BY THE ENGINEER.
4. THE GRAVEL SHALL BE HARD, TOUGH, DURABLE ROCK WRAPPED IN A FILTER FABRIC AND SHALL CONFORM TO THE FOLLOWING GRADATION:

SIEVE SIZE	% PASSING BY DRY WEIGHT
1-1/2 INCH	90 - 100
3/4 INCH	50 - 100
NO. 4	0 - 50
NO. 200	0 - 5

STANDARD SIZE AGGREGATES NO. 6, 57 AND 67 AND 1-1/2 INCH FILTER MATERIALS SHOULD SATISFY THIS GRADATION REQUIREMENT. FILTER FABRIC SHALL BE MIRAFI 140N OR ALTERNATE TYPE APPROVED BY THE ENGINEER.

5. BACKFILL SHALL CONSIST OF ON SITE MATERIAL APPROVED BY THE SOILS ENGINEER. BACKFILL SHALL BE COMPACTED TO 90% MAXIMUM RELATIVE DENSITY IN ACCORDANCE WITH THE STANDARD SPECIFICATIONS UNDER THE DIRECTION OF THE ENGINEER.

PRESTRESSED CONCRETE

1. ALL CONCRETE SHALL BE NORMAL WEIGHT WITH AGGREGATES CONFORMING TO ASTM C-33.
2. THE FABRICATOR SHALL BE A COMPANY SPECIALIZING IN PROVIDING PRECAST, PRESTRESSED CONCRETE PRODUCTS AND SERVICES NORMALLY ASSOCIATED WITH THE INDUSTRY FOR AT LEAST 3 YEARS, AND CERTIFIED BY THE PCI.
3. PRESTRESSING STRANDS SHALL BE UNCOATED, 1/2" DIAMETER 7-WIRE, LOW RELAXATION STRANDS, GRADE 270K CONFORMING TO AASHTO M203.
4. MINIMUM CONCRETE STRENGTH AT RELEASE, f'_{ci} = 4,500 PSI. MINIMUM CONCRETE STRENGTH AT 28 DAYS, f'_c = 6,000 PSI.
5. THE FOLLOWING ESTIMATED CENTERLINE CAMBERS & DEFLECTIONS ARE PROVIDED FOR THE CONTRACTOR'S INFORMATION:

	G104	G120
* CAMBER (UP) @ ERECTION	1 1/4"	2"
* INITIAL DEFLECTION (DOWN) FROM DECK, SIDEWALK & RAILING LOADS	1/2"	1"
* ADDITIONAL NET DEFLECTION (DOWN) FROM LONG TERM EFFECTS	1/2"	1 1/8"

6. GIRDERS SHALL BE ERECTED NO SOONER THAN 90 DAYS AFTER CASTING.
7. PLAN LENGTH SHALL BE INCREASED AS NECESSARY TO COMPENSATE FOR SHORTENING DUE TO PRESTRESS AND SHRINKAGE.
8. EXTRA CAUTION MUST BE EXERCISED IN HANDLING AND PLACING ALL GIRDERS.
9. THE TOP SURFACE OF THE GIRDER FLANGE SHALL BE ROUGHENED IN ACCORDANCE WITH THE STANDARD SPECIFICATIONS.
10. IF THE LIFTING LOOPS EXTEND WITHIN 3" OF THE TOP OF THE ROADWAY SLAB THEY SHALL BE CUT OFF PRIOR TO POURING THE ROADWAY SLAB. ALL LIFTING STRANDS SHALL BE OF THE SAME MATERIAL AND STRENGTH AS THE PRESTRESSING STRANDS. WRAP THE LIFTING LOOPS SO THAT EACH STRAND WILL CARRY ITS SHARE OF THE TOTAL LOAD. EXTEND LIFTING LOOPS SO THAT EACH STAND WILL CARRY ITS SHARE OF THE TOTAL LOAD. EXTEND LIFTING LOOPS ENDING WITH A 9" LONG 90 DEG. HOOK TO WITHIN 3" CLEAR OF THE BOTTOM OF THE GIRDER.
11. CUT ALL STRANDS FLUSH WITH THE GIRDER ENDS AND PAINT WITH AN APPROVED EPOXY RESIN.


DESIGN CRITERIA

1. THE FOUNDATION DESIGN IS BASED ON THE RECOMMENDATIONS IN THE FOUNDATION INVESTIGATION REPORT BY PSC ASSOCIATES, INC., JOB NO. 91152.10.
- 7,000 PSF BEARING ON WEATHERED BASALT
3,000 PSF BEARING ON OTHER NON-EXPANSIVE SOILS
45 PCF ACTIVE PRESSURE (TOP FREE)
65 PCF AT REST (TOP RESTRAINED)
360 PCF PASSIVE PRESSURE (REDUCE 1/3 WHEN COMBINED WITH FRICTION)
0.45 COEFF. OF FRICTION ON BASALT, CONCRETE & GRANULAR FILL
0.40 COEFF. OF FRICTION ON OTHER ON-SITE SOILS
2. AASHTO STANDARD SPECIFICATIONS FOR HIGHWAY BRIDGES FOURTEENTH EDITION 1989 AND ALL SUBSEQUENT INTERIMS.
- LIVE LOAD: HS20-44
- SEISMIC DESIGN: CATEGORY 'B'
ACCELERATION COEFF. 0.15
SITE COEFF. (S) 1.2

ABBREVIATIONS

AASHTO	AMERICAN ASSOCIATION OF STATE HIGHWAY AND TRANSPORTATION OFFICIALS
ABUT.	ABUTMENT
ALT.	ALTERNATE
ALUM.	ALUMINUM
APPROX.	APPROXIMATE
ASTM	AMERICAN SOCIETY FOR TESTING AND MATERIALS
@	AT
AZ.	AZIMUTH
BM.	BEAM
BRG.	BEARING
BET.	BETWEEN
BOT.	BOTTOM
CL	CENTER LINE
CLR.	CLEAR
COL.	COLUMN
CONC.	CONCRETE
CONT.	CONTINUOUS
C.R.	CORROSION RESISTANT
DBL.	DOUBLE
DET.	DETAIL
DIA.	DIAMETER
DFT.	DRAFT
DWGS.	DRAWINGS
EA.	EACH
E.F.	EACH FACE
ELECT.	ELECTRICAL
ELEV., EL.	ELEVATION
E.W.	EACH WAY
EXIST'G	EXISTING
EXP.	EXPANSION
EXT.	EXTERIOR
FT.	FEET
FIN.	FINISH
FTG.	FOOTING
GALV.	GALVANIZED
GRSP	GROUTED RUBBLE SLOPED PROJECTION
HDWL.	HEADWALL
HORIZ.	HORIZONTAL
INT.	INTERIOR
JT.	JOINT
L	LENGTH
LG.	LONG
LOC.	LOCATION
LONGIT.	LONGITUDINAL
MAX.	MAXIMUM
MECH.	MECHANICAL
MIN.	MINIMUM
NC	NATIONAL COARSE
NO.	NUMBER
N.T.S.	NOT TO SCALE
O.C.	ON CENTER
PAVEM'T	PAVEMENT
P/S	PER SIDE
P.I.	POINT OF INTERSECTION
R	RADIUS/RADII
REF.	REFERENCE
REINF.	REINFORCEMENT
REQ'D	REQUIRED
SC.	SCALE
SL.	SLOPE
SPAC'G, SPCG.	SPACING
SPECS.	SPECIFICATIONS
STD.	STANDARD
STIRR.	STIRRUP
SYMM.	SYMMETRICAL
TB	TOP OF BEAM ELEVATION
THK.	THICK
T&B	TOP & BOTTOM
TOL.	TOLERANCE
TS	TOP OF SEAT ELEVATION
TYP.	TYPICAL
VERT.	VERTICAL
W/	WITH
W.P.	WORKING POINT

FED. ROAD DIST. NO.	STATE	FED. AID PROJ. NO.	FISCAL YEAR	SHEET NO.	TOTAL SHEETS
HAWAII	HAW.	PMT-H1C-01-97			

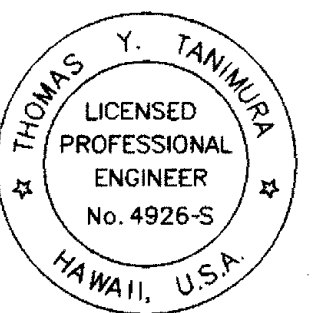

THIS WORK WAS PREPARED BY ME OR UNDER MY SUPERVISION.
Thomas Y. Taniguchi
Signature

5/4/99 Revise Notes


DATE REVISION

STATE OF HAWAII
DEPARTMENT OF TRANSPORTATION
HIGHWAYS DIVISION

GENERAL NOTES


MANAGER'S DRIVE BRIDGE WIDENING
INTERSTATE ROUTE H-1

FED. ROAD DIST. NO.	STATE	FED. AID PROJ. NO.	FISCAL YEAR	SHEET NO.	TOTAL SHEETS
HAWAII	HAW.	PMT-HIC-01-97			

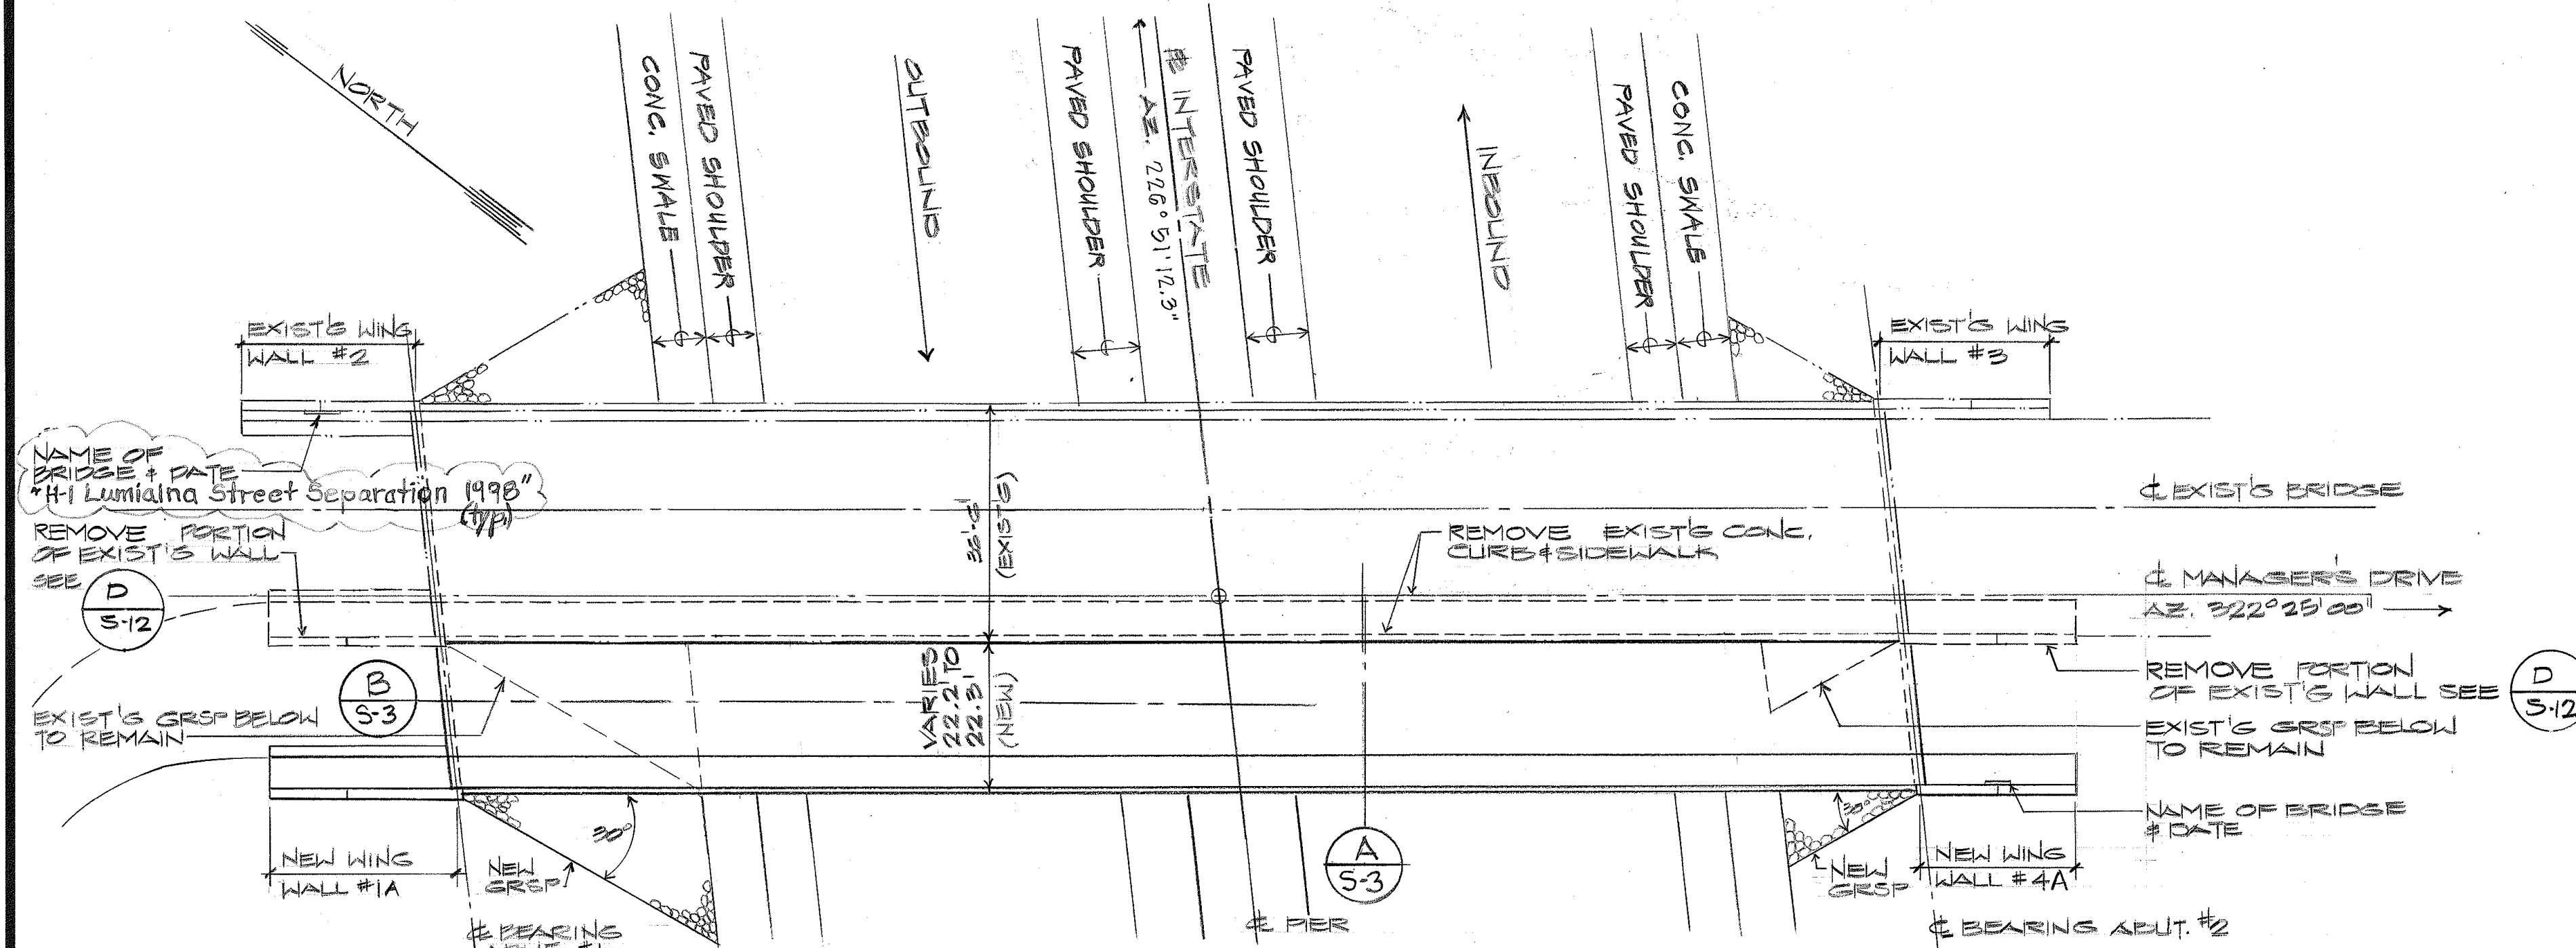


BRIDGE LAYOUT PLAN

SC: 1" = 20'-0"

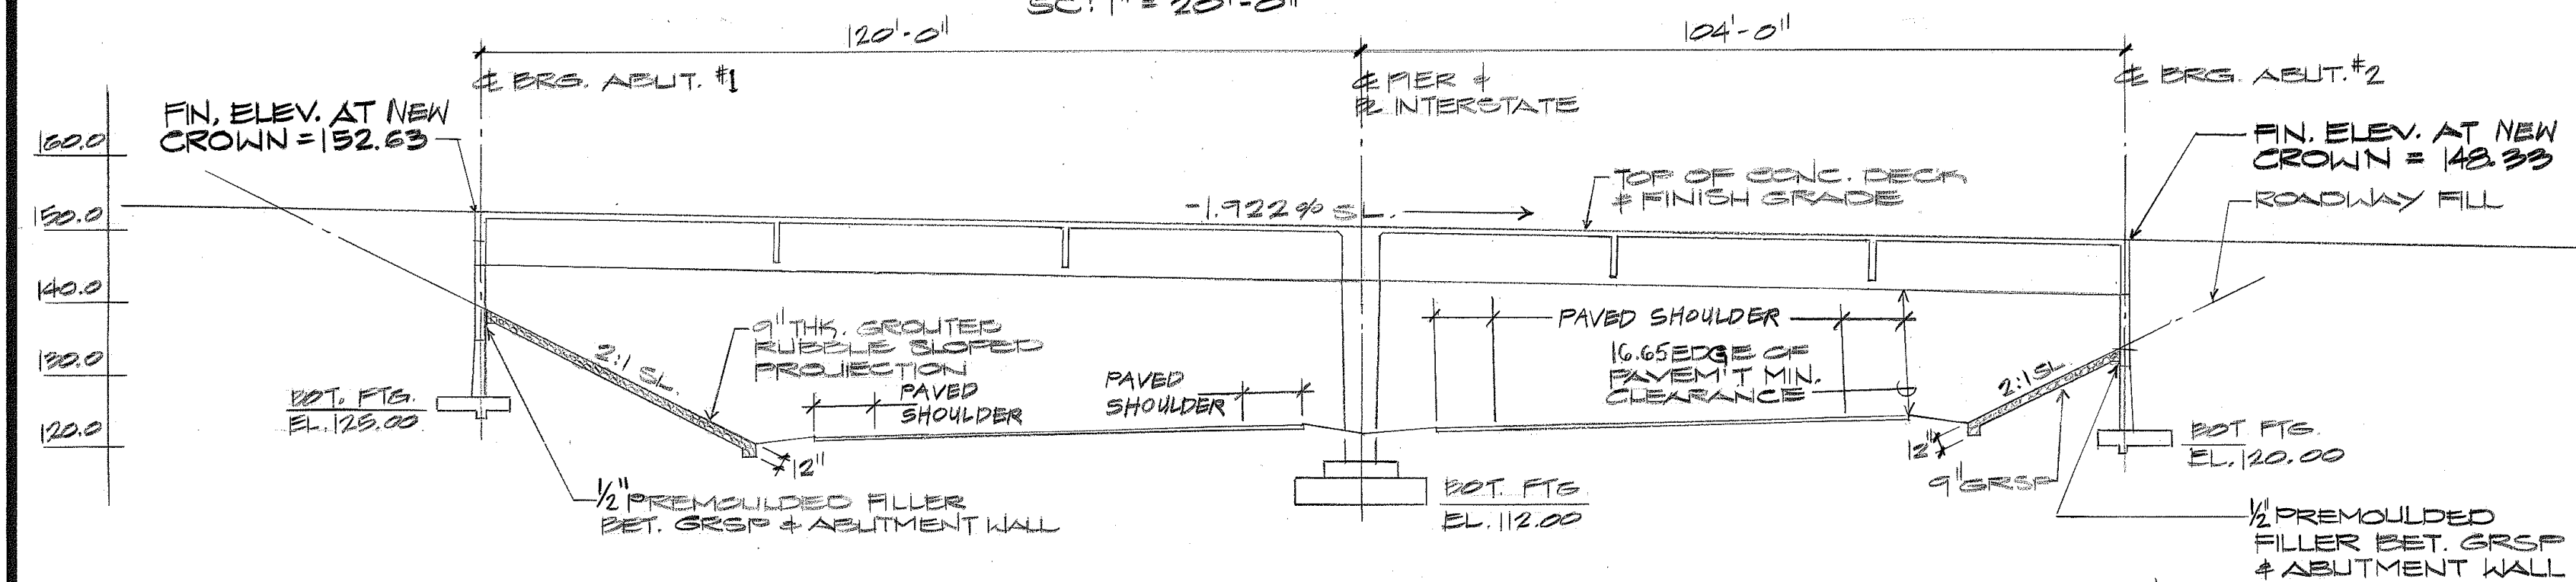

BRIDGE PROFILE - SECTION

SC: 1" = 20'-0"

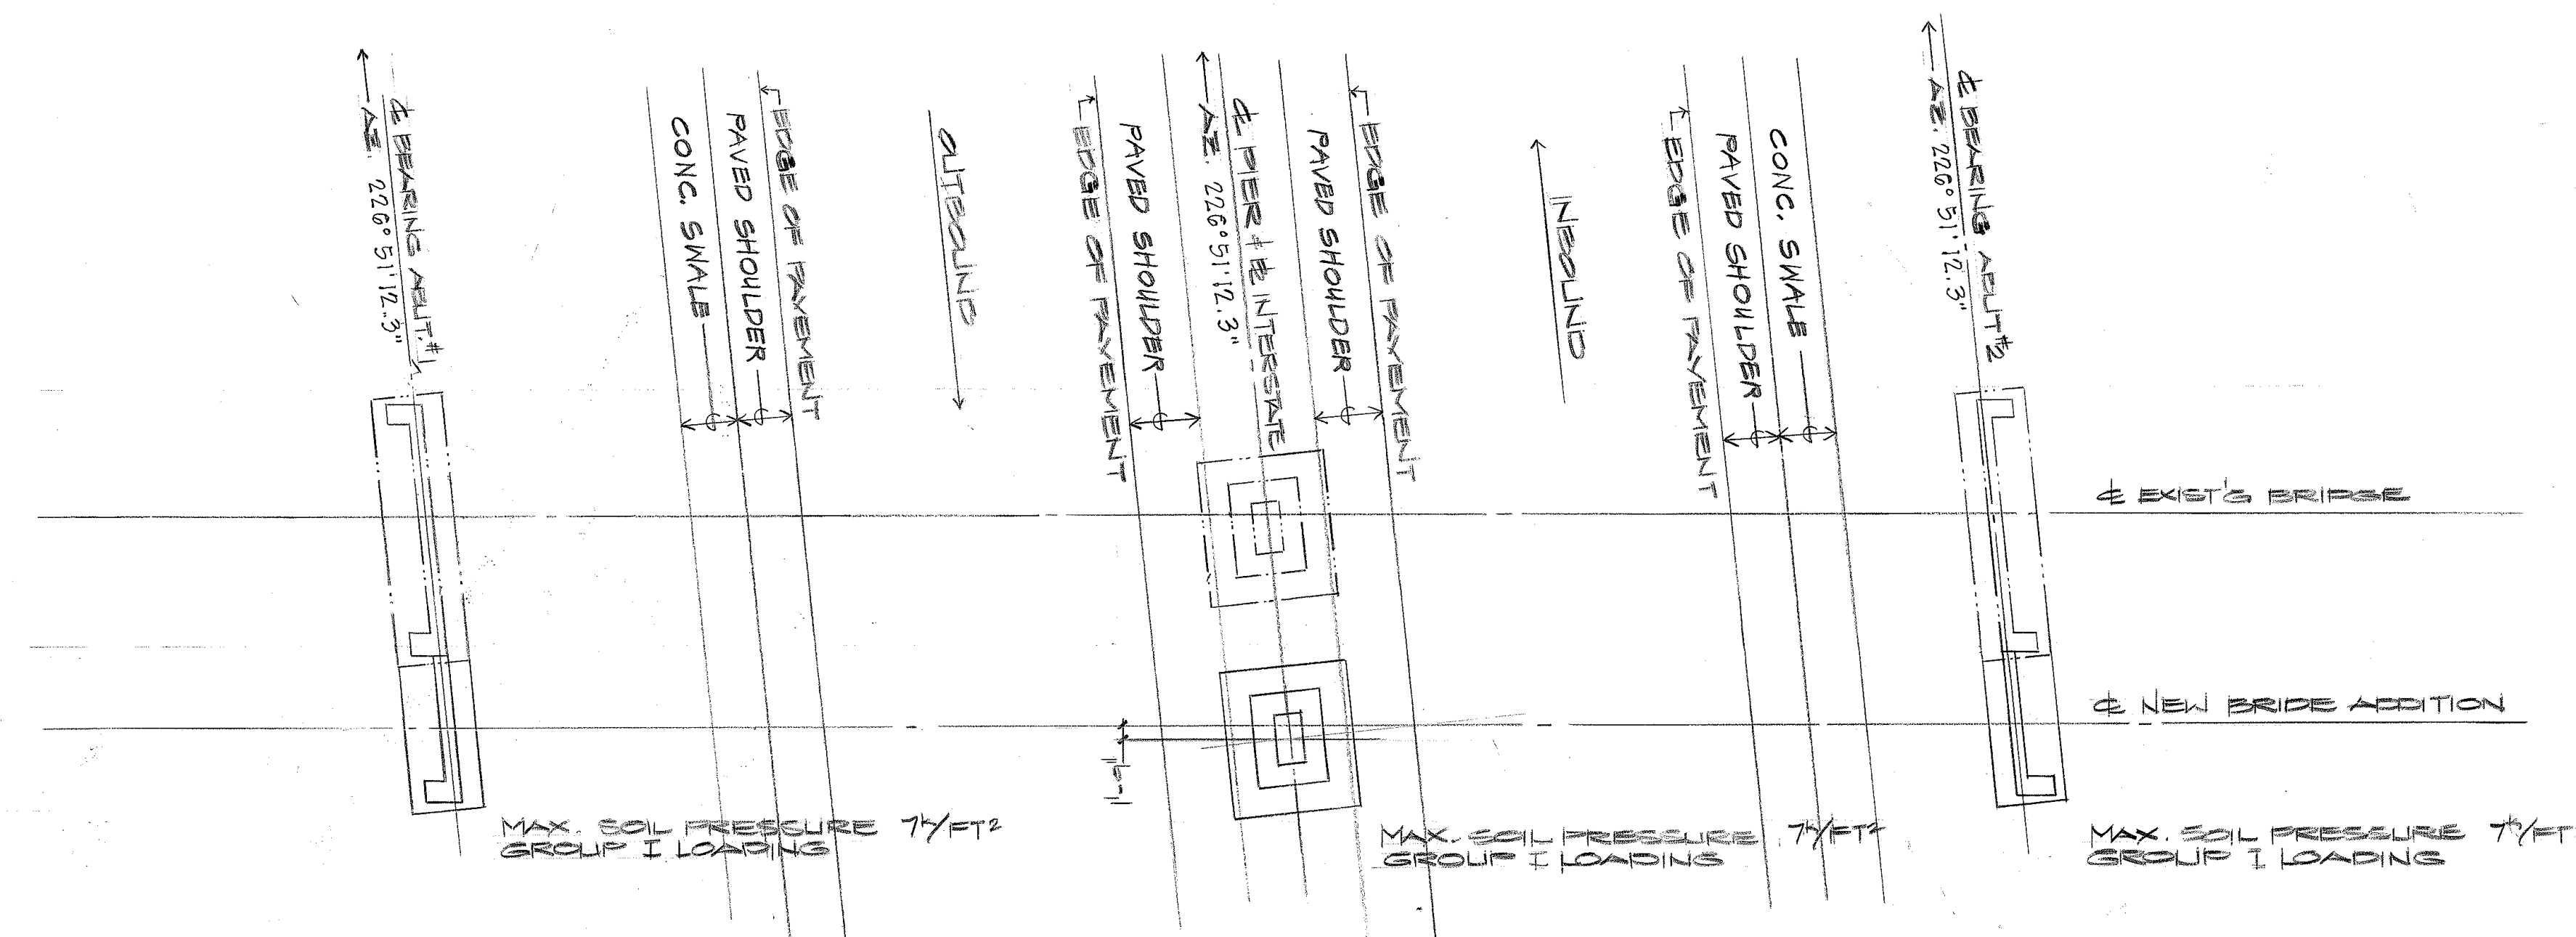


FOUNDATION PLAN

SC: 1" = 20'-0"

NOTES: 1. CONTRACTOR TO INSTALL SAFETY NETTING UNDER THE GIRDERS AFTER THEIR INSTALLATION. SHOP DRAWINGS SHALL BE SUBMITTED FOR APPROVAL.

2. CONTRACTOR TO PROVIDE PUMP TO PREVENT STORM WATER FROM SITTING IN FOOTING EXCAVATION.

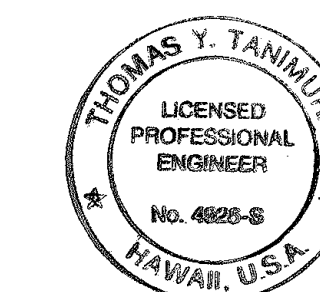

THIS WORK WAS PREPARED BY ME OR UNDER MY SUPERVISION.
Signature


5/4/99 Add Sign Name
DATE REVISION

STATE OF HAWAII
DEPARTMENT OF TRANSPORTATION
HIGHWAYS DIVISION

LAYOUT PLAN & PROFILE
MANAGER'S DRIVE BRIDGE WIDENING
INTERSTATE ROUTE H-1


SHEET No. 5-2 OF 16 SHEETS

FED. ROAD DIST. NO.	STATE	FED. AID PROJ. NO.	FISCAL YEAR	SHEET NO.	TOTAL SHEETS
HAWAII	HAW.	PMT-HIC-01-97			

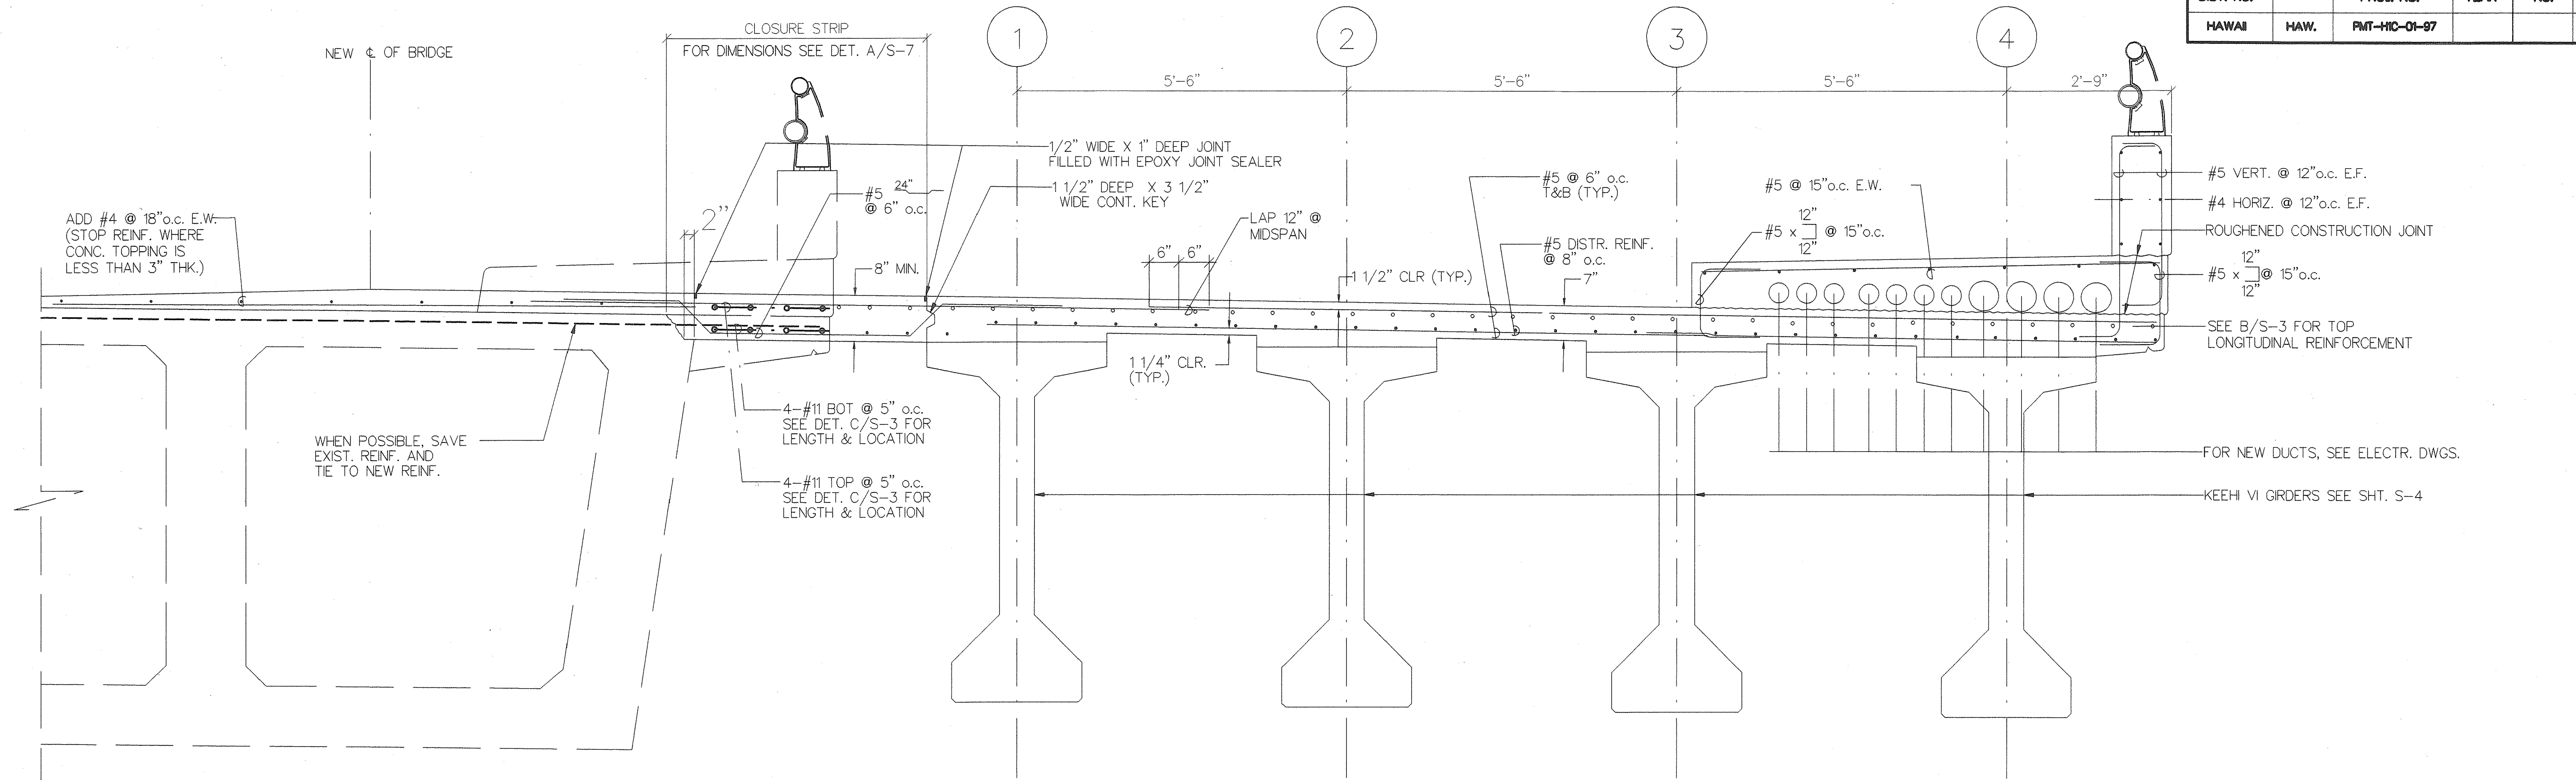


TYPICAL SECTION
SC: 3/4" = 1'-0"

A
S-3

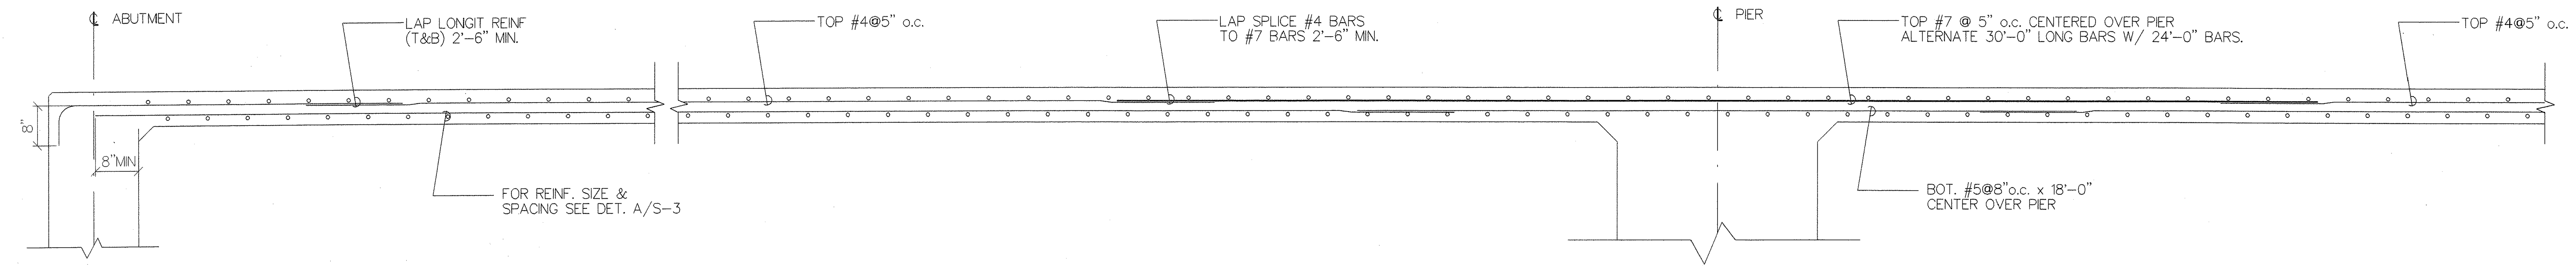

DECK SECTION SHOWING LONGITUDINAL REINFORCING
SC: 3/4" = 1'-0"


B
S-3

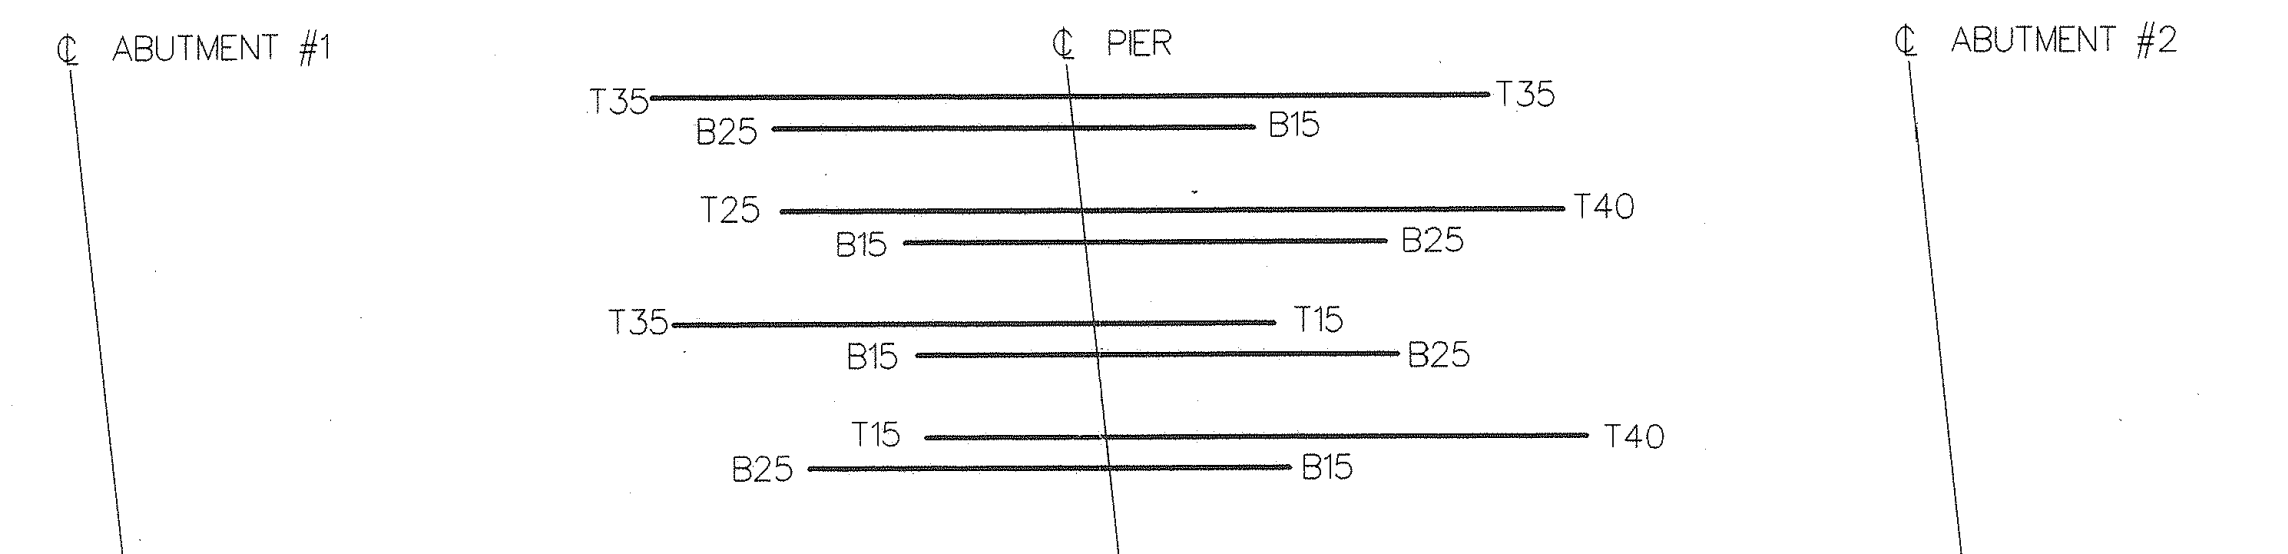

LAYOUT PLAN SHOWING DECK LONGIT. REINF. TO BE REPLACED IN CLOSURE STRIP
N.T.S.

C
S-3

- NOTE:
1. 'T' INDICATES TOP BAR, 'B' INDICATES BOTTOM BAR.
 2. '25' INDICATES LENGTH TO END OF BAR MEASURED FROM CENTER LINE OF PIER EQUALS 25 FEET.
 3. ALL BARS SHOWN ARE #11 BARS.
 4. LAP #4 BARS 2'-6" TO #11 BARS, SIMILAR TO DET. B/S-3.
 5. THESE BARS REPLACE LONGIT. REINF. FROM REMOVED SECTION OF EXISTING BRIDGE.

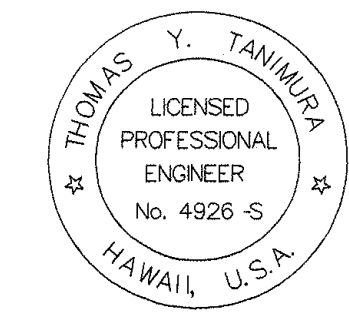


THIS WORK WAS PREPARED BY
ME OR UNDER MY SUPERVISION.
Thomas Y. Taniguchi
Signature

STATE OF HAWAII
DEPARTMENT OF TRANSPORTATION
HIGHWAYS DIVISION


TYPICAL CROSS SECTION
AND DECK REINFORCING

MANAGER'S DRIVE BRIDGE WIDENING
INTERSTATE ROUTE H-1


FED. ROAD DIST. NO.	STATE	FED. AID PROJ. NO.	FISCAL YEAR	SHEET NO.	TOTAL SHEETS
HAWAII	HAW.	PMT-HIC-01-97			

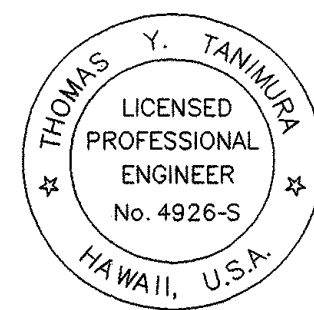


THIS WORK WAS PREPARED BY ME OR UNDER MY SUPERVISION.
T. Y. Tanikura
 Signature

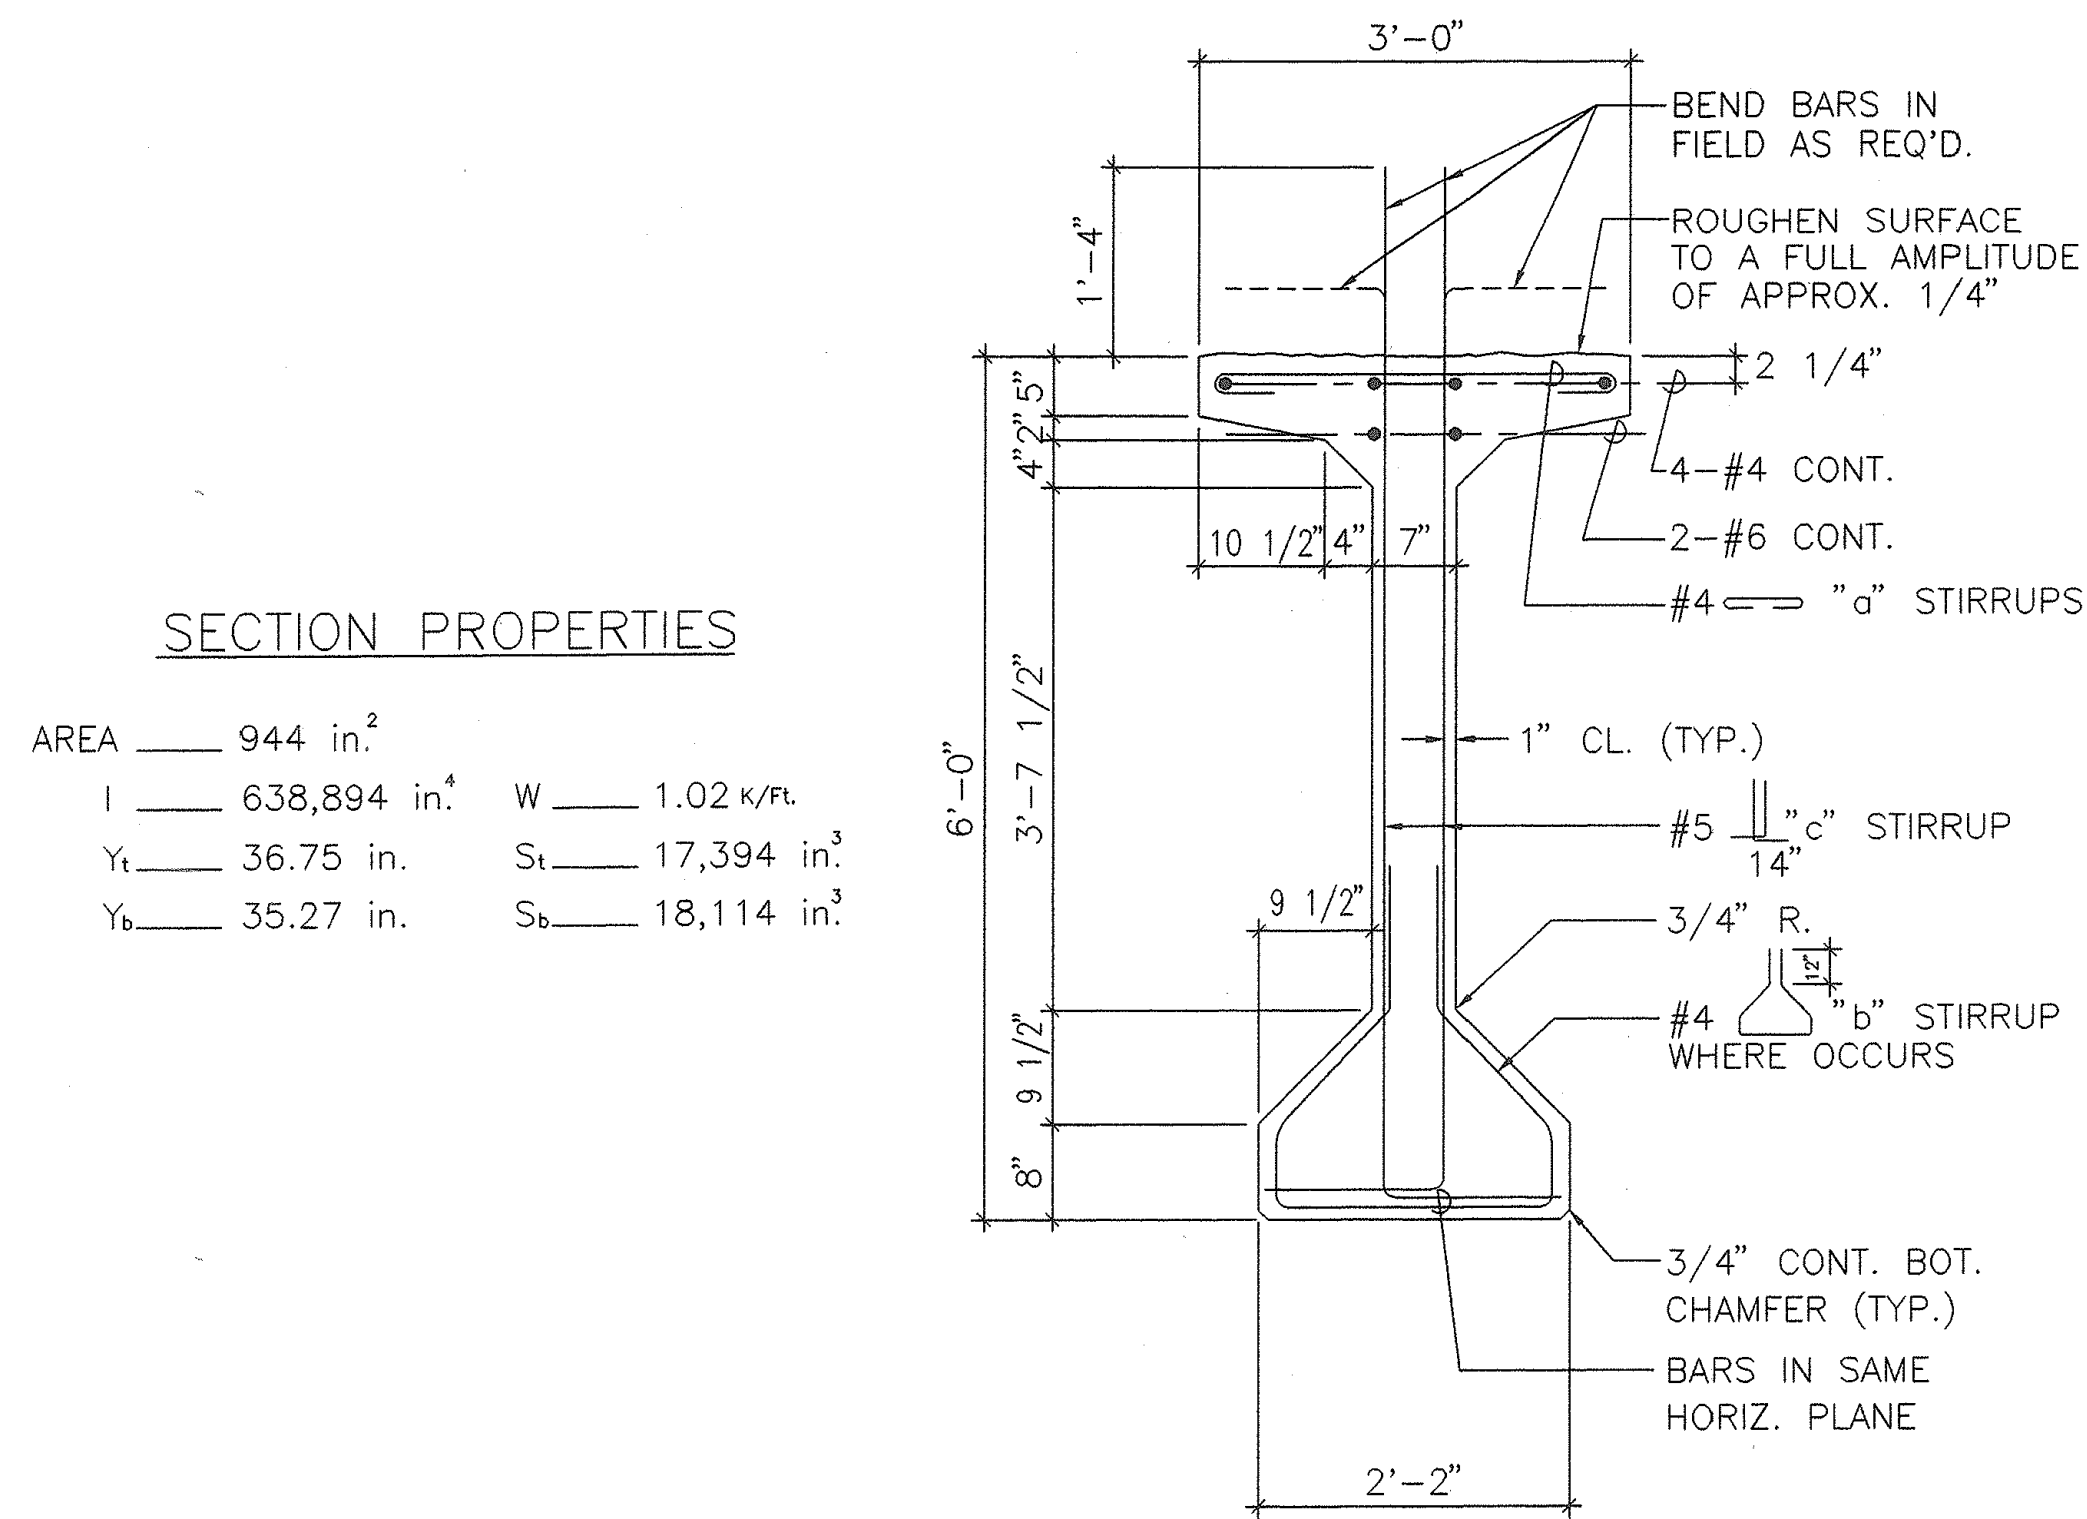


TYP. PRESTRESSED CONCRETE GIRDER - KEEHI VI
 SC: 3/4" = 1'-0" (A) S-4

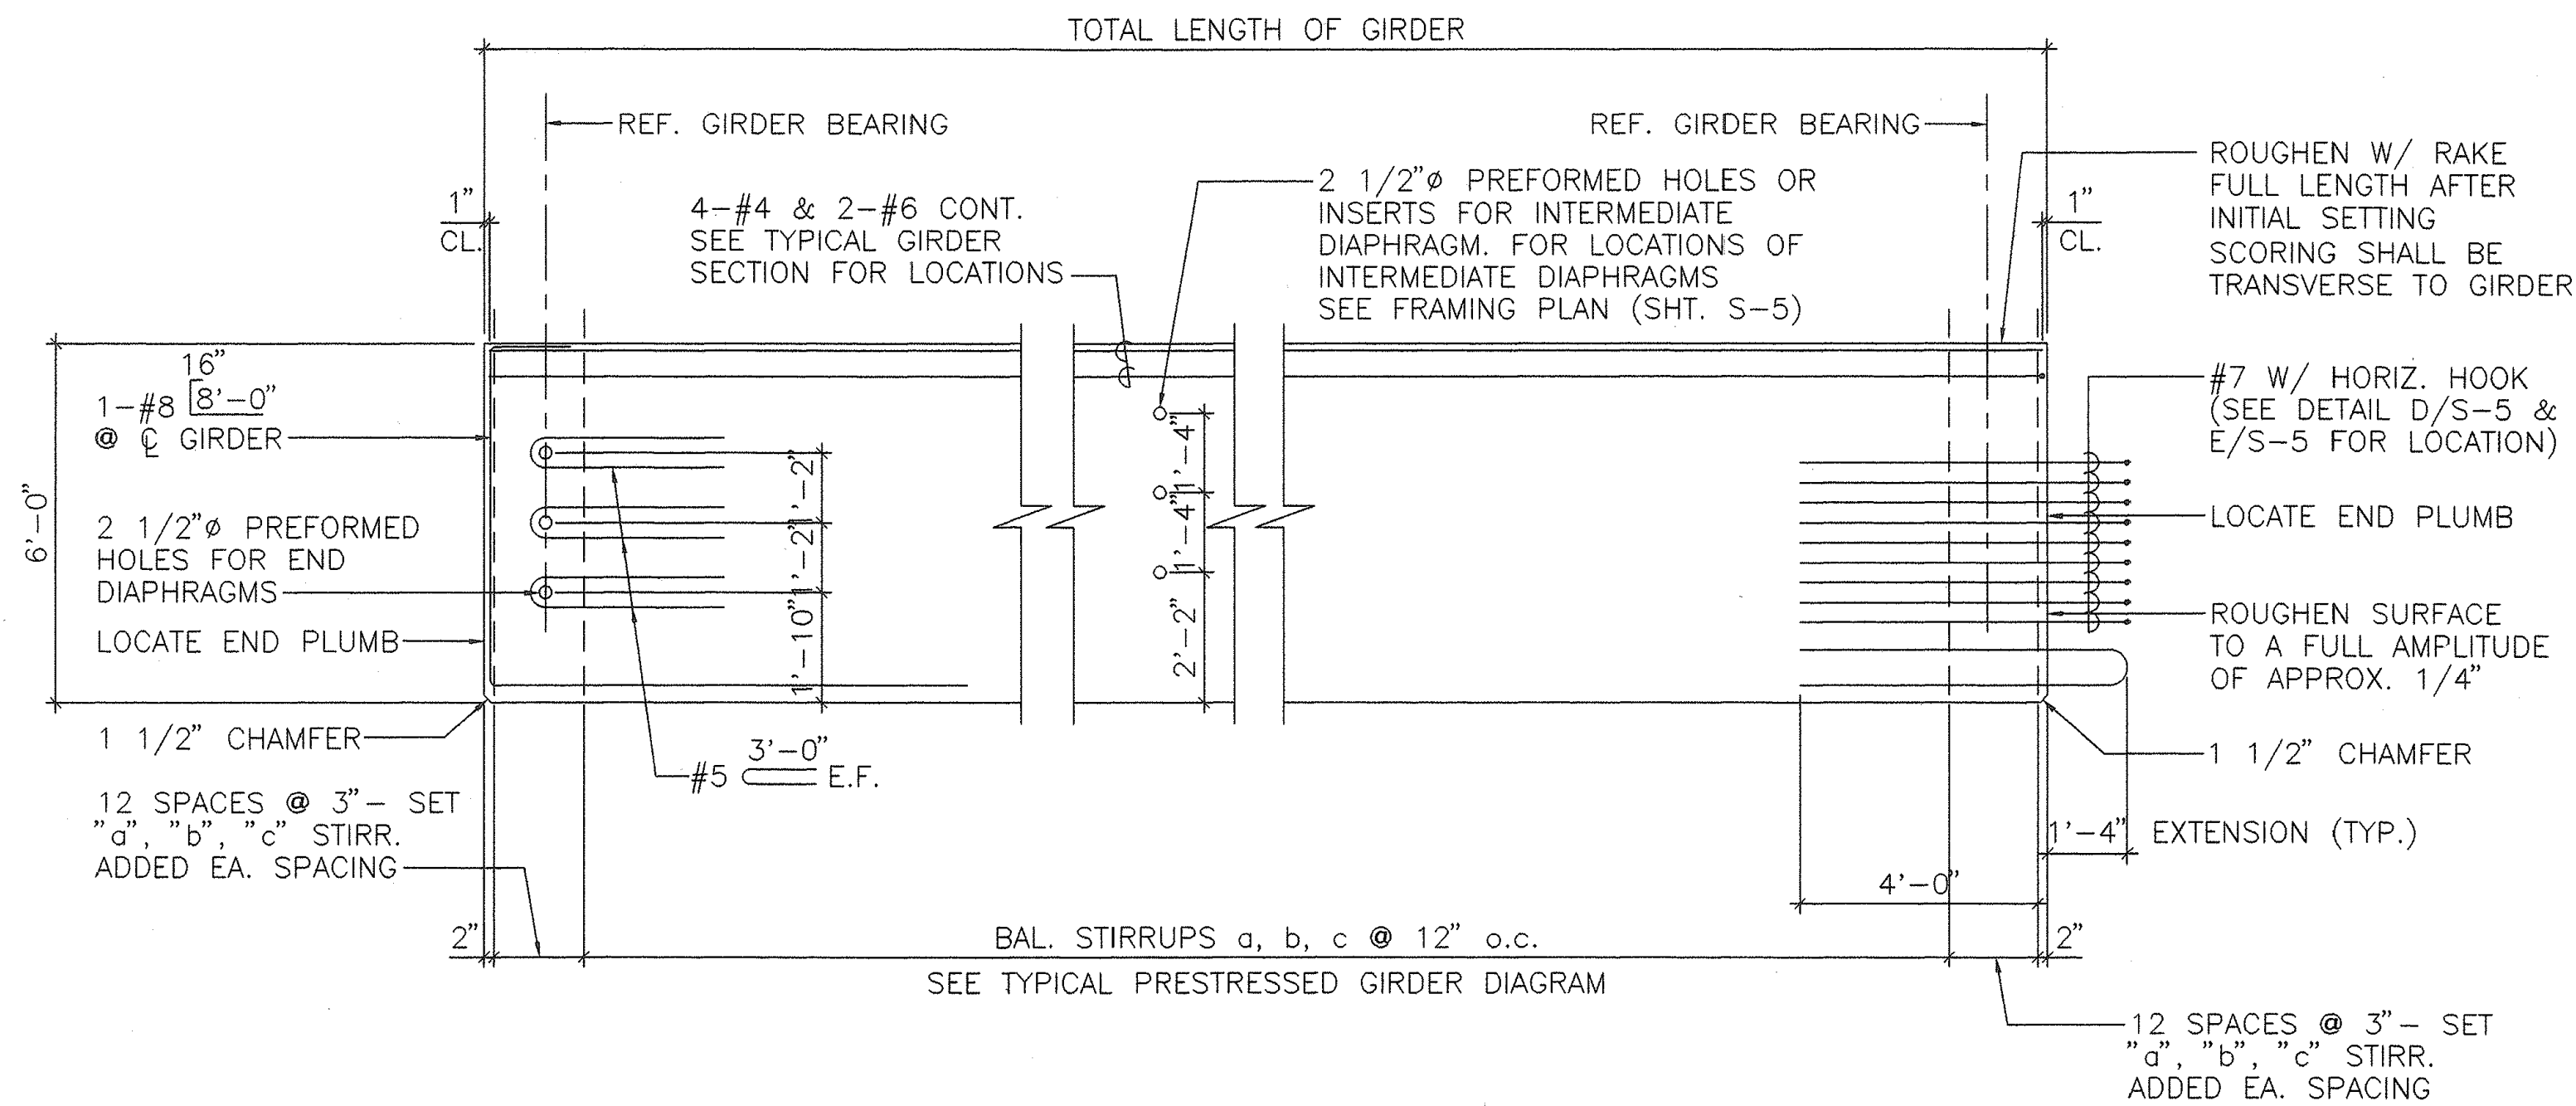


EXPANSION END
 ELEVATION - TYPE KEEHI VI GIRDER END DETAILS
 SC: 3/8" = 1'-0" (B) S-4

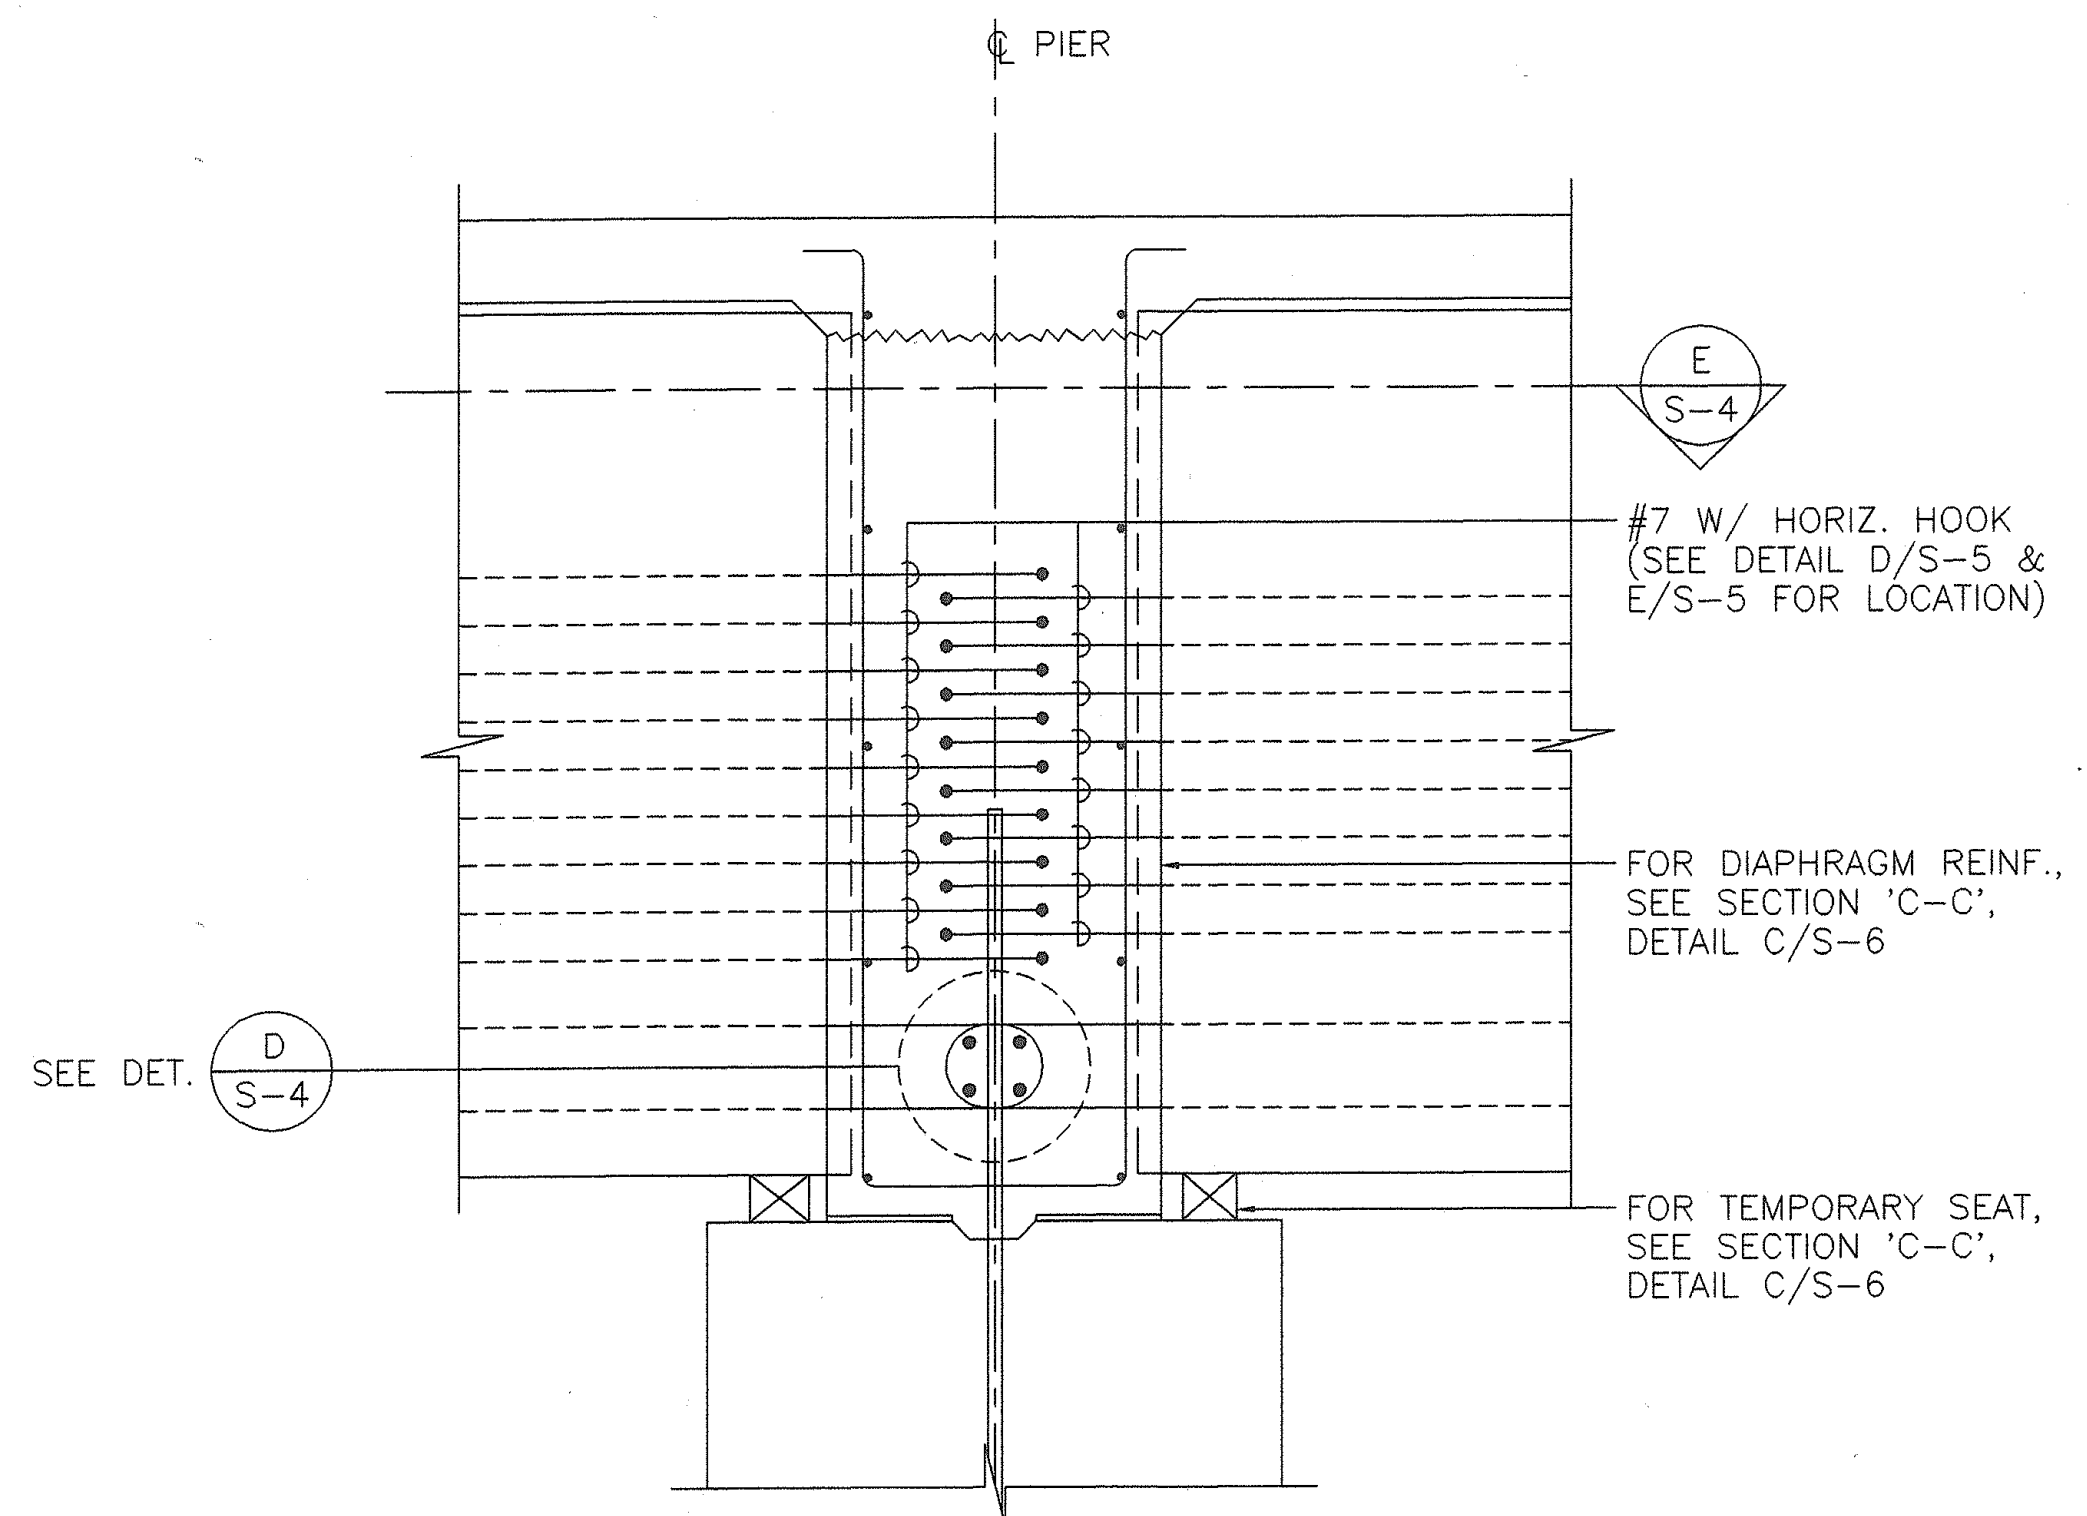

GIRDER REINF. @ CENTER PIER DIAPHRAGM
 SC: 3/4" = 1'-0" (C) S-4

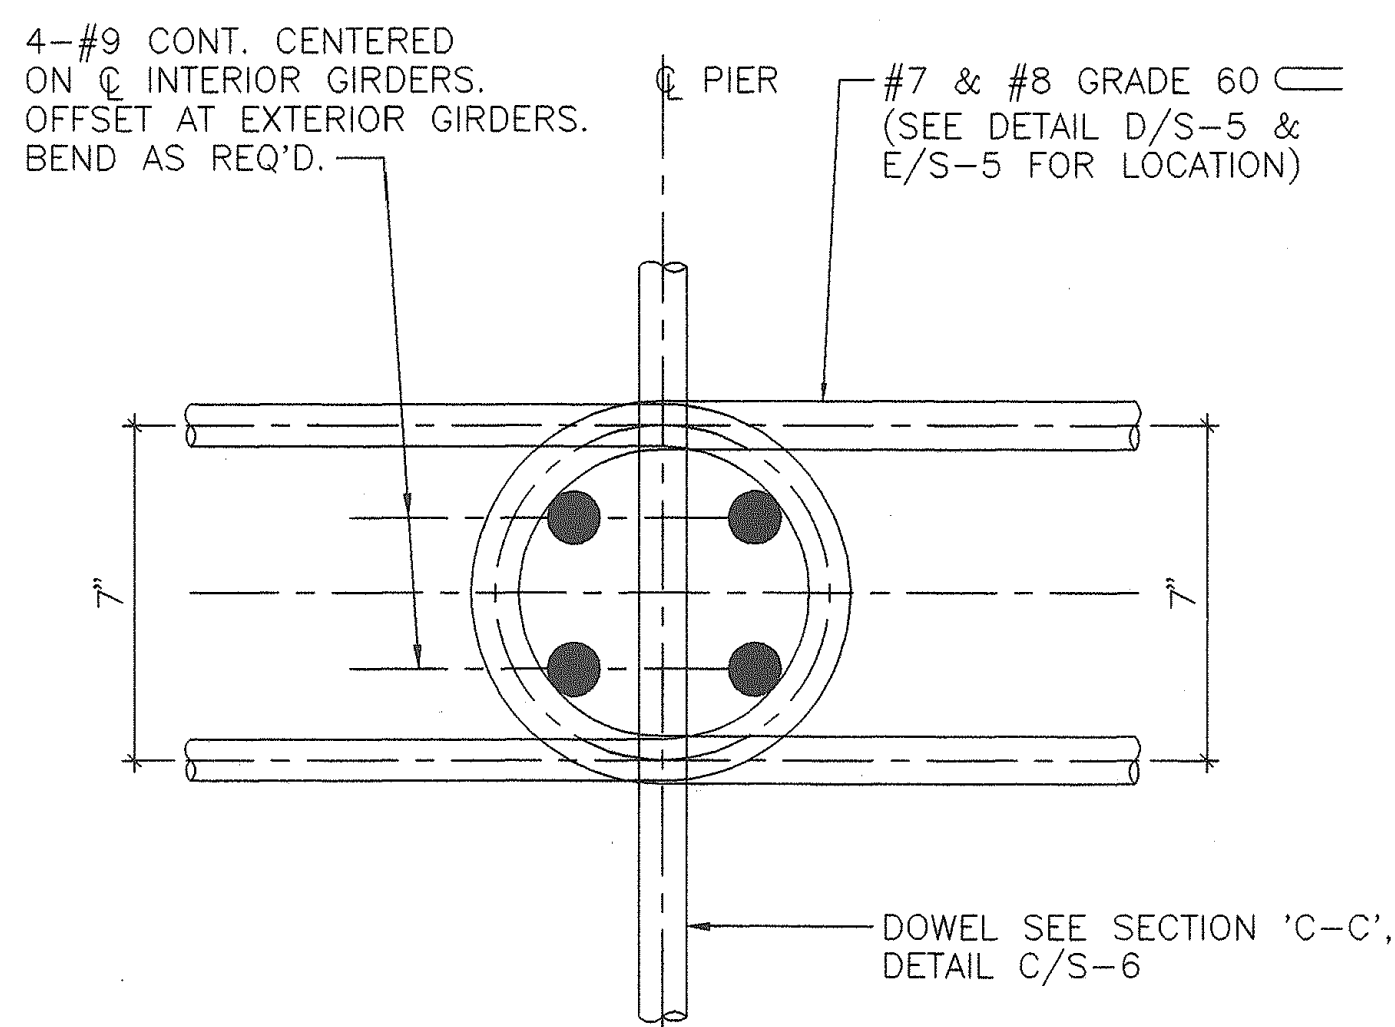

DETAIL
 SC: 3" = 1'-0" (D) S-4

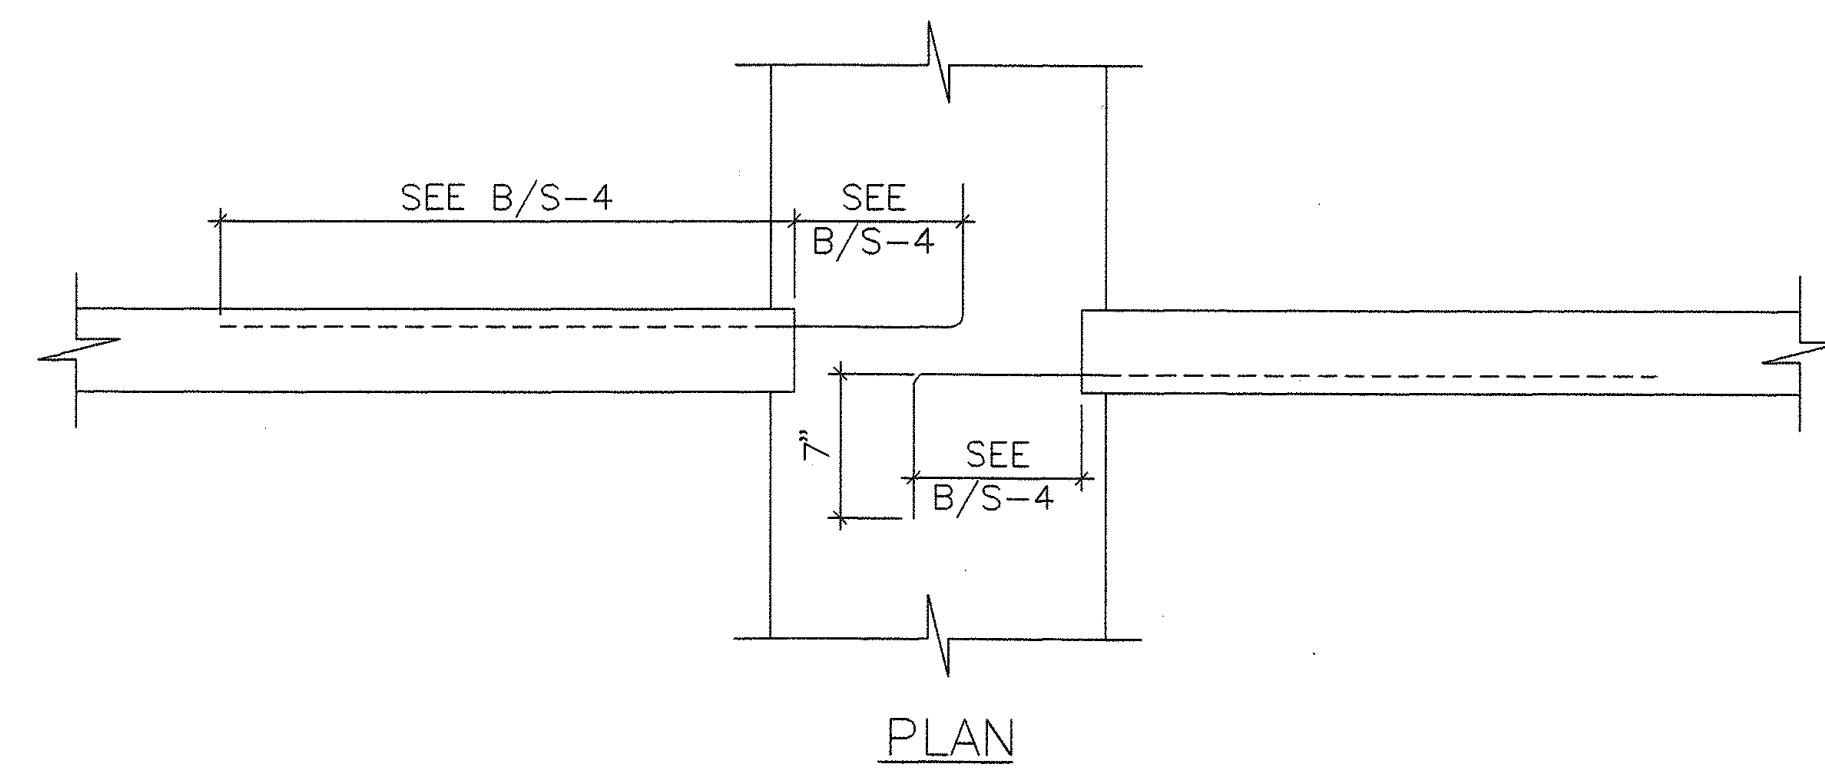

SECTION
 SC: 3/4" = 1'-0" (E) S-4

STATE OF HAWAII
 DEPARTMENT OF TRANSPORTATION
 HIGHWAYS DIVISION


PRESTRESS GIRDER DETAILS

MANAGER'S DRIVE BRIDGE WIDENING
 INTERSTATE ROUTE H-1


SHEET NO. S-4 OF 16 SHEETS

SURVEY PLOTTED BY
DRAWN BY
CHECKED BY
QUANTITIES BY
ORIGINAL PLAN
NOTE BOOK
No.


FED. ROAD DIST. NO.	STATE	FED. AID PROJ. NO.	FISCAL YEAR	SHEET NO.	TOTAL SHEETS
HAWAII	HAW.	PMT-HIC-01-97			

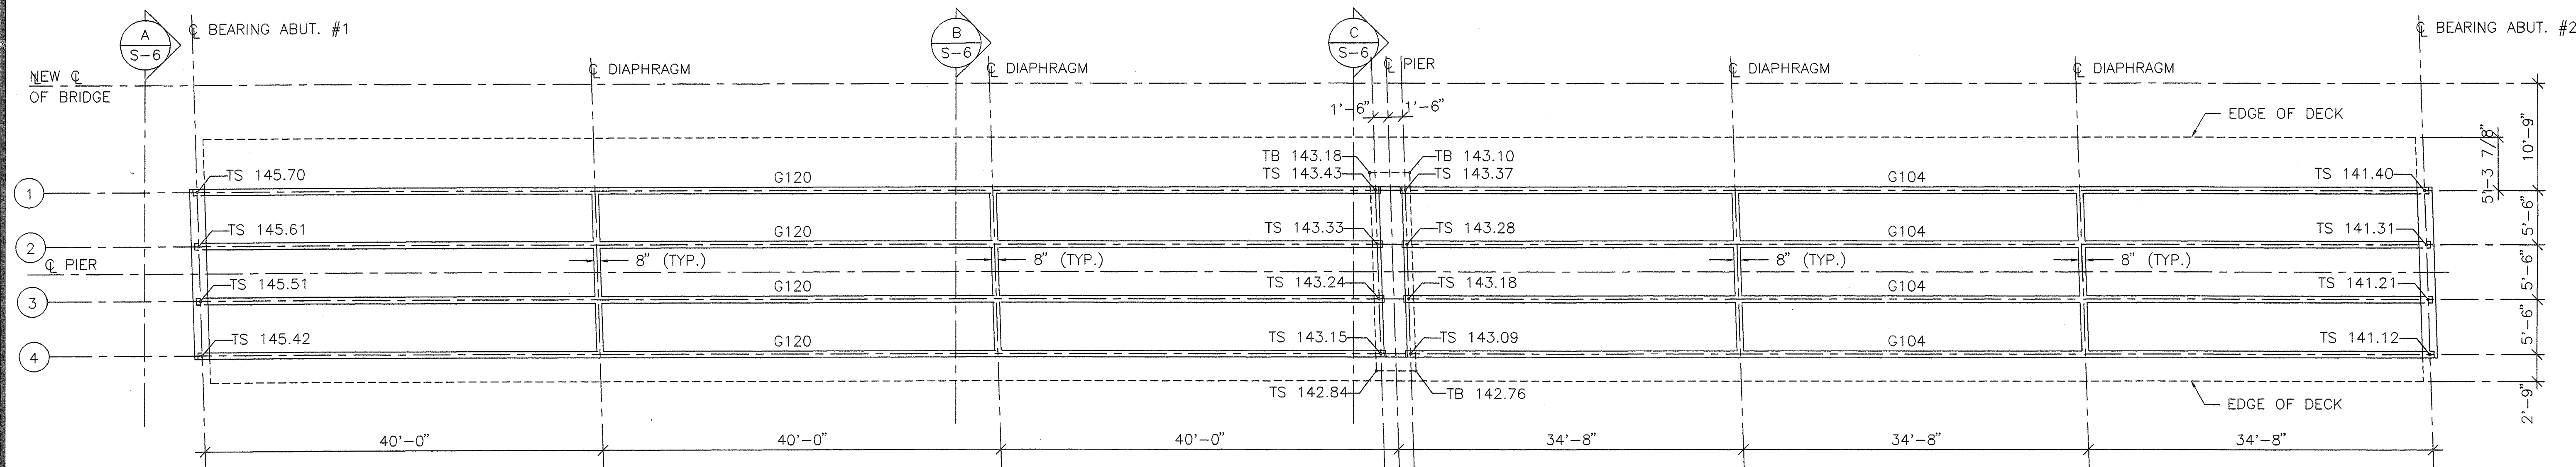


FRAMING PLAN & GIRDER SEAT ELEVATIONS
SC: 1/8" = 1'-0"

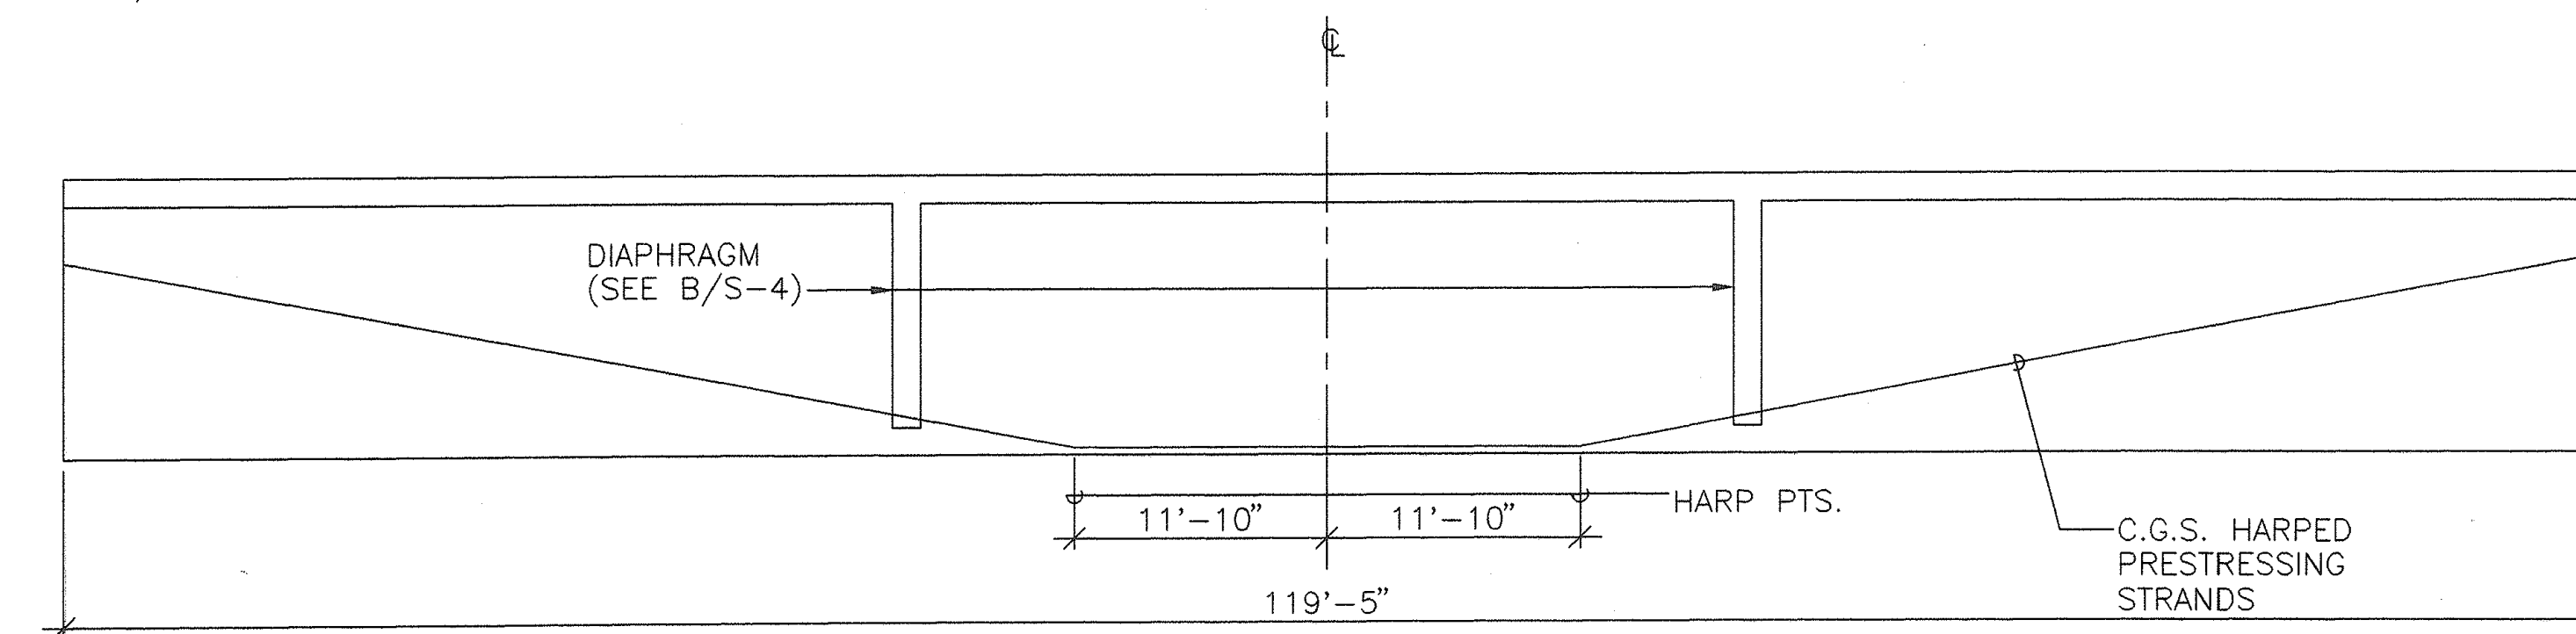

G120 GIRDER ELEVATION
SC: HORIZ. 1/8" = 1'-0" VERT. 1/4" = 1'-0"

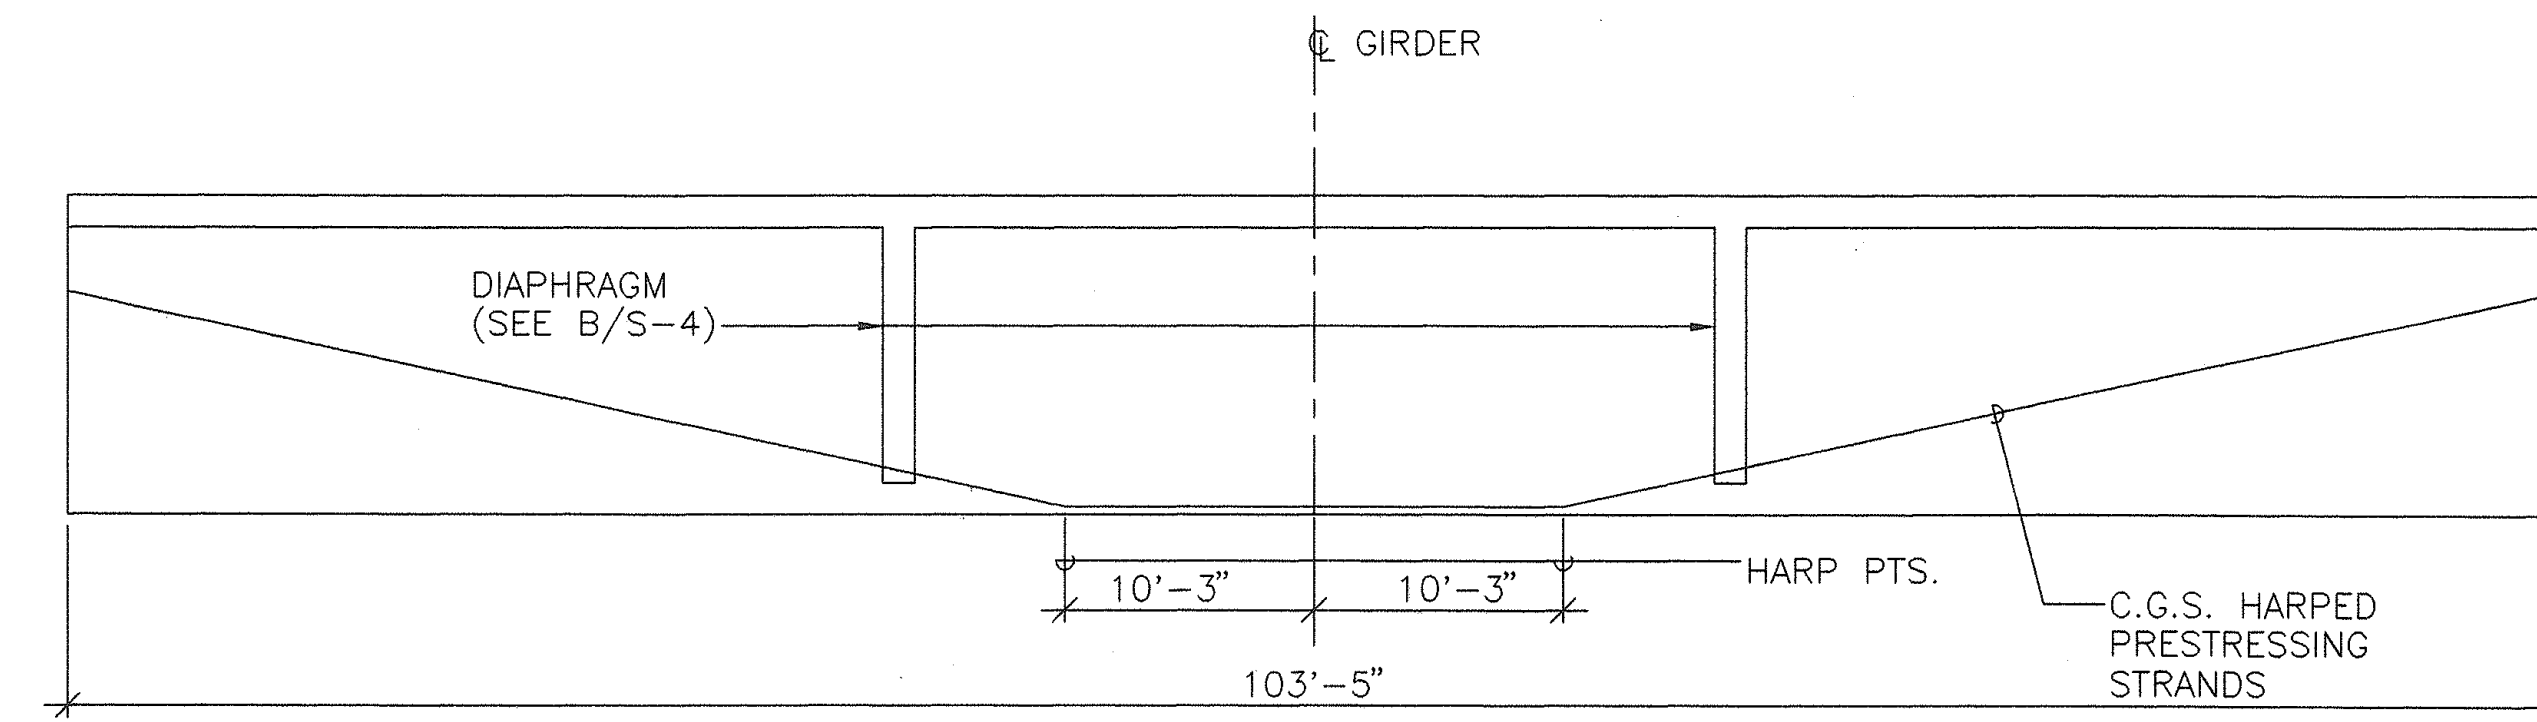


G104 GIRDER ELEVATION
SC: HORIZ. 1/8" = 1'-0" VERT. 1/4" = 1'-0"

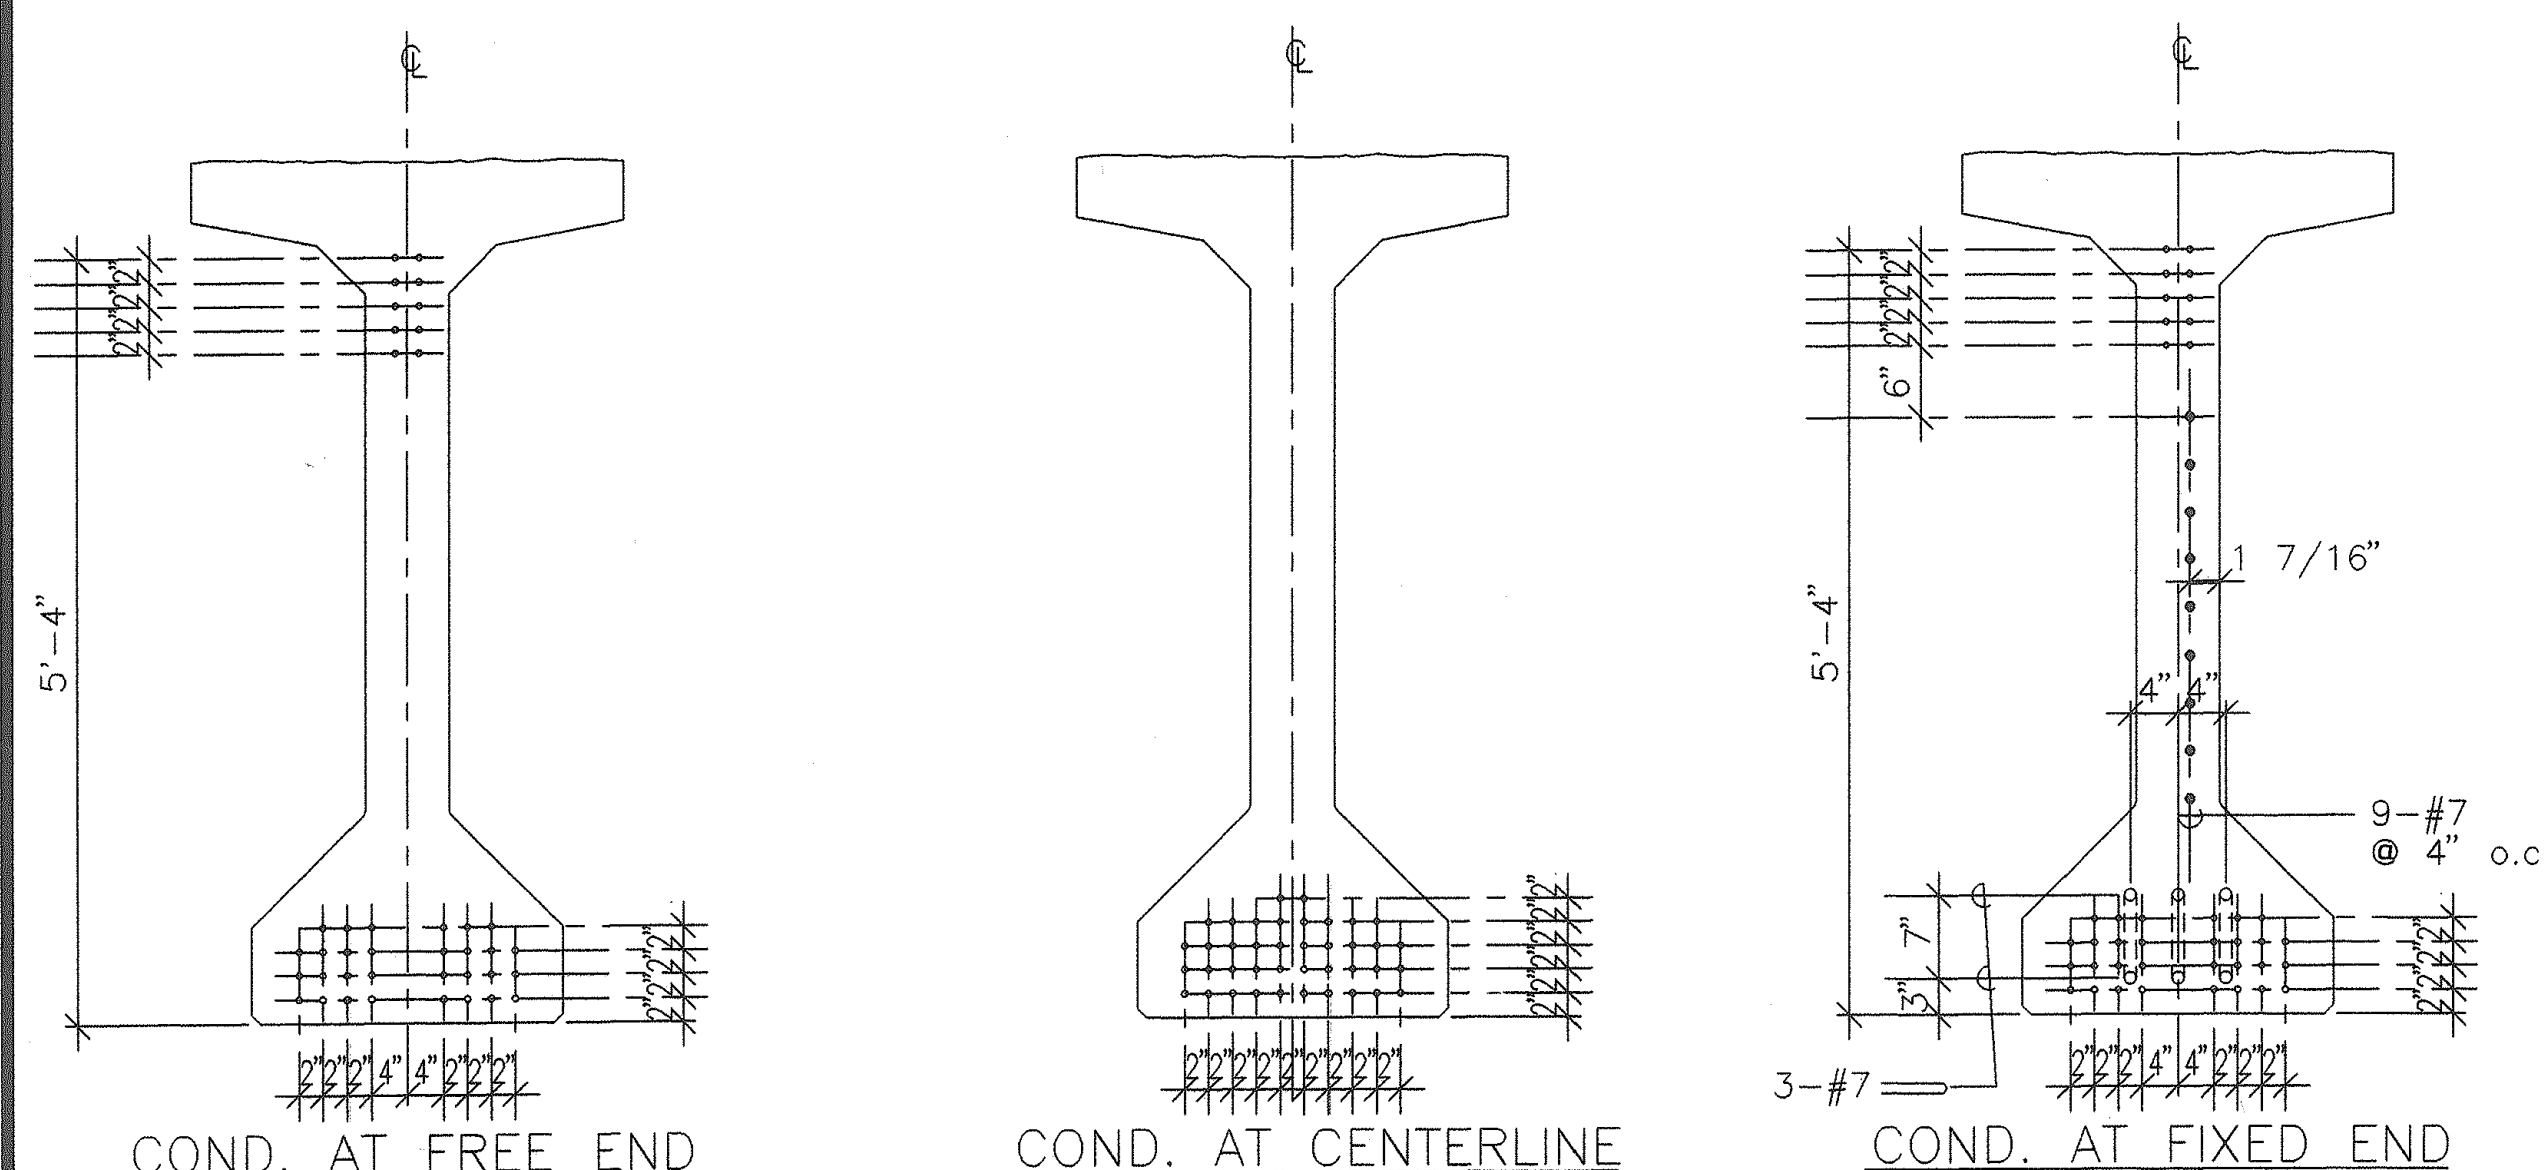


INITIAL PRESTRESS (PULL) = 30.98K/STRAND FINAL PRESTRESS (AFTER ALL LOSSES) = 25.26K/STRAND

STRAND PATTERNS FOR G120 GIRDERS (40 STRANDS/GIRDER)
SC: 3/4" = 1'-0"

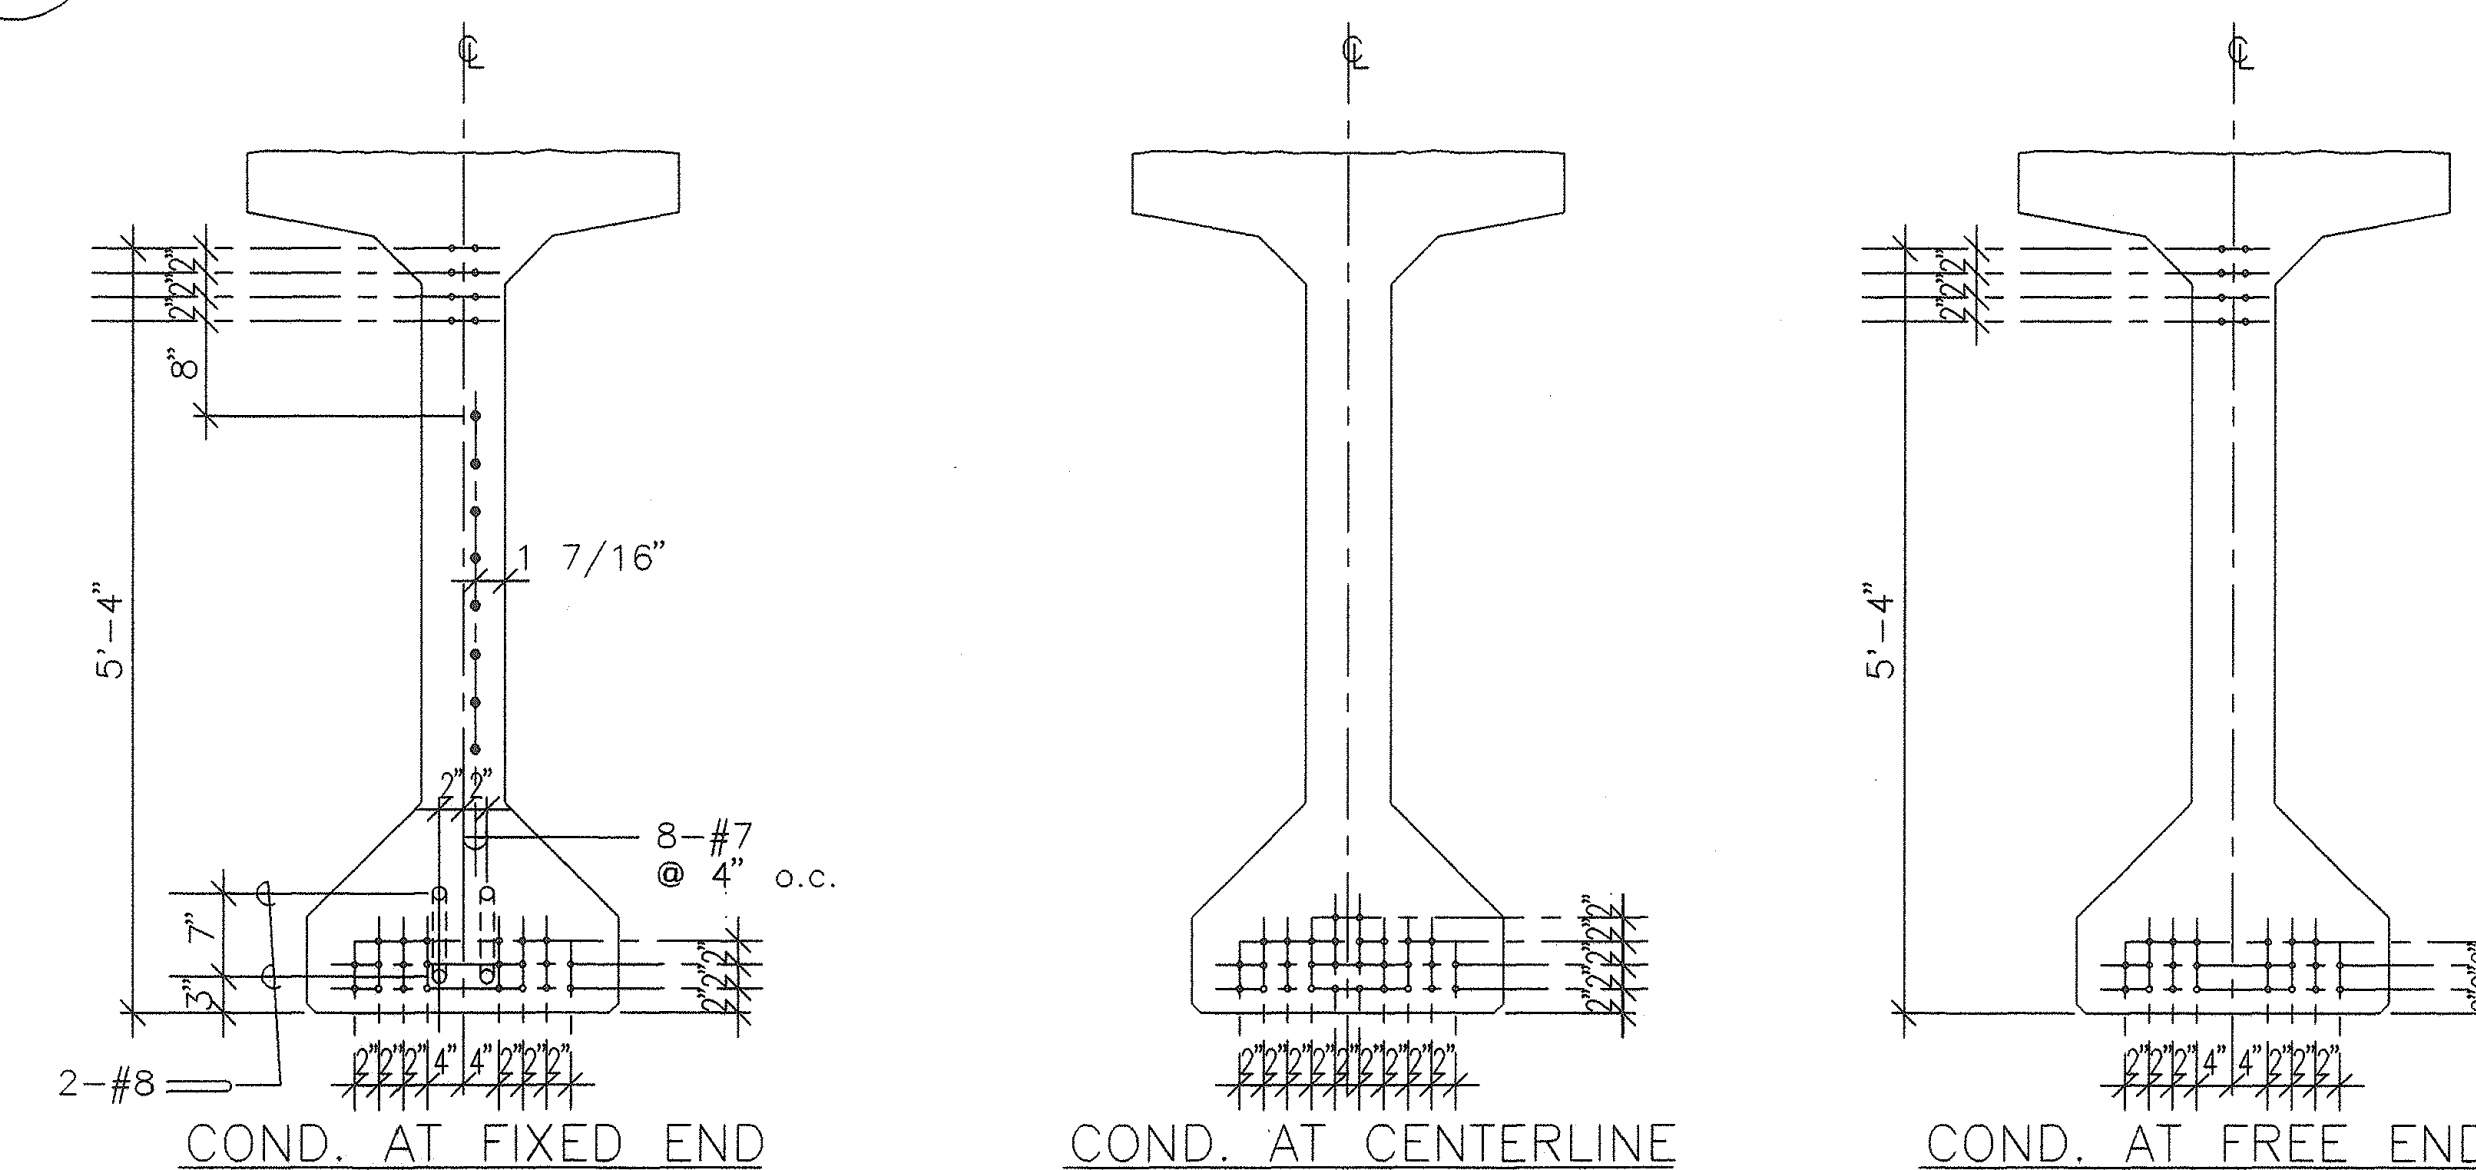

INITIAL PRESTRESS (PULL) = 30.98K/STRAND FINAL PRESTRESS (AFTER ALL LOSSES) = 26.02K/STRAND

STRAND PATTERNS FOR G104 GIRDERS (30 STRANDS/GIRDER)
SC: 3/4" = 1'-0"

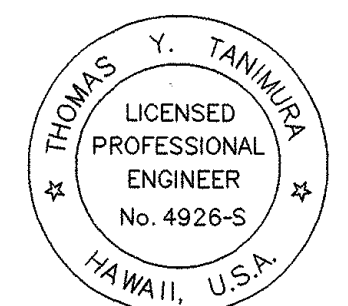


THIS WORK WAS PREPARED BY
ME OR UNDER MY SUPERVISION.
TY Taniguchi
Signature

STATE OF HAWAII
DEPARTMENT OF TRANSPORTATION
HIGHWAYS DIVISION


FRAMING PLAN, GIRDER
ELEVATIONS & STRAND DETAILS

MANAGER'S DRIVE BRIDGE WIDENING
INTERSTATE ROUTE H-1


FED. ROAD DIST. NO.	STATE	FED. AID PROJ. NO.	FISCAL YEAR	SHEET NO.	TOTAL SHEETS
HAWAII	HAW.	FMT-HIC-01-97			

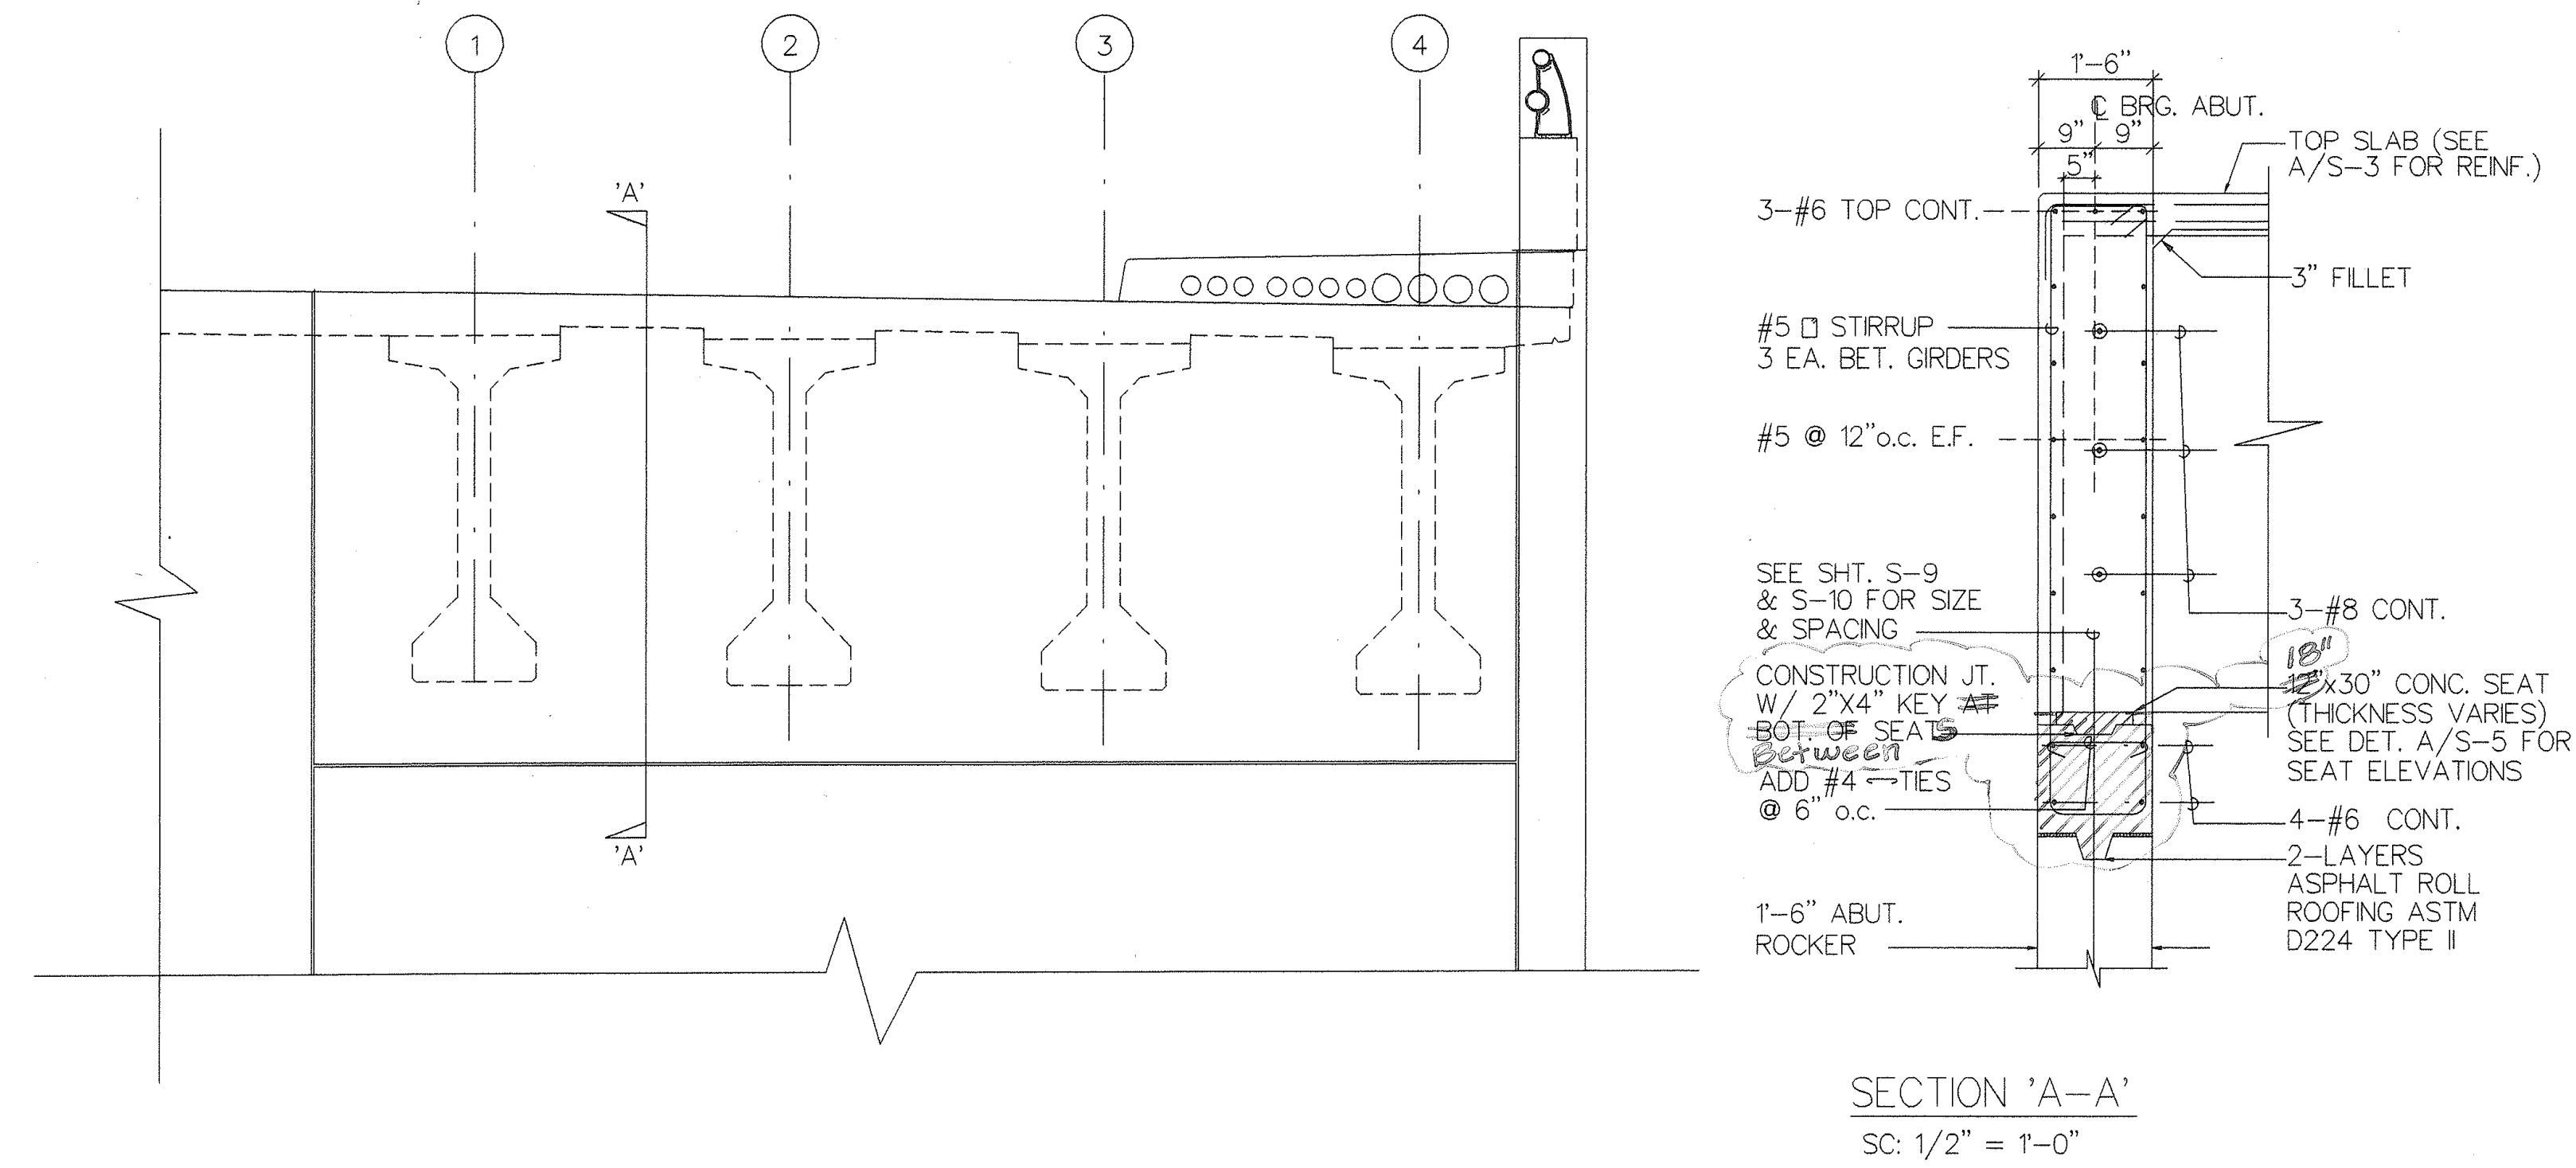


ABUTMENT BEAM ELEVATION & SECTION
SC: 3/8" = 1'-0"

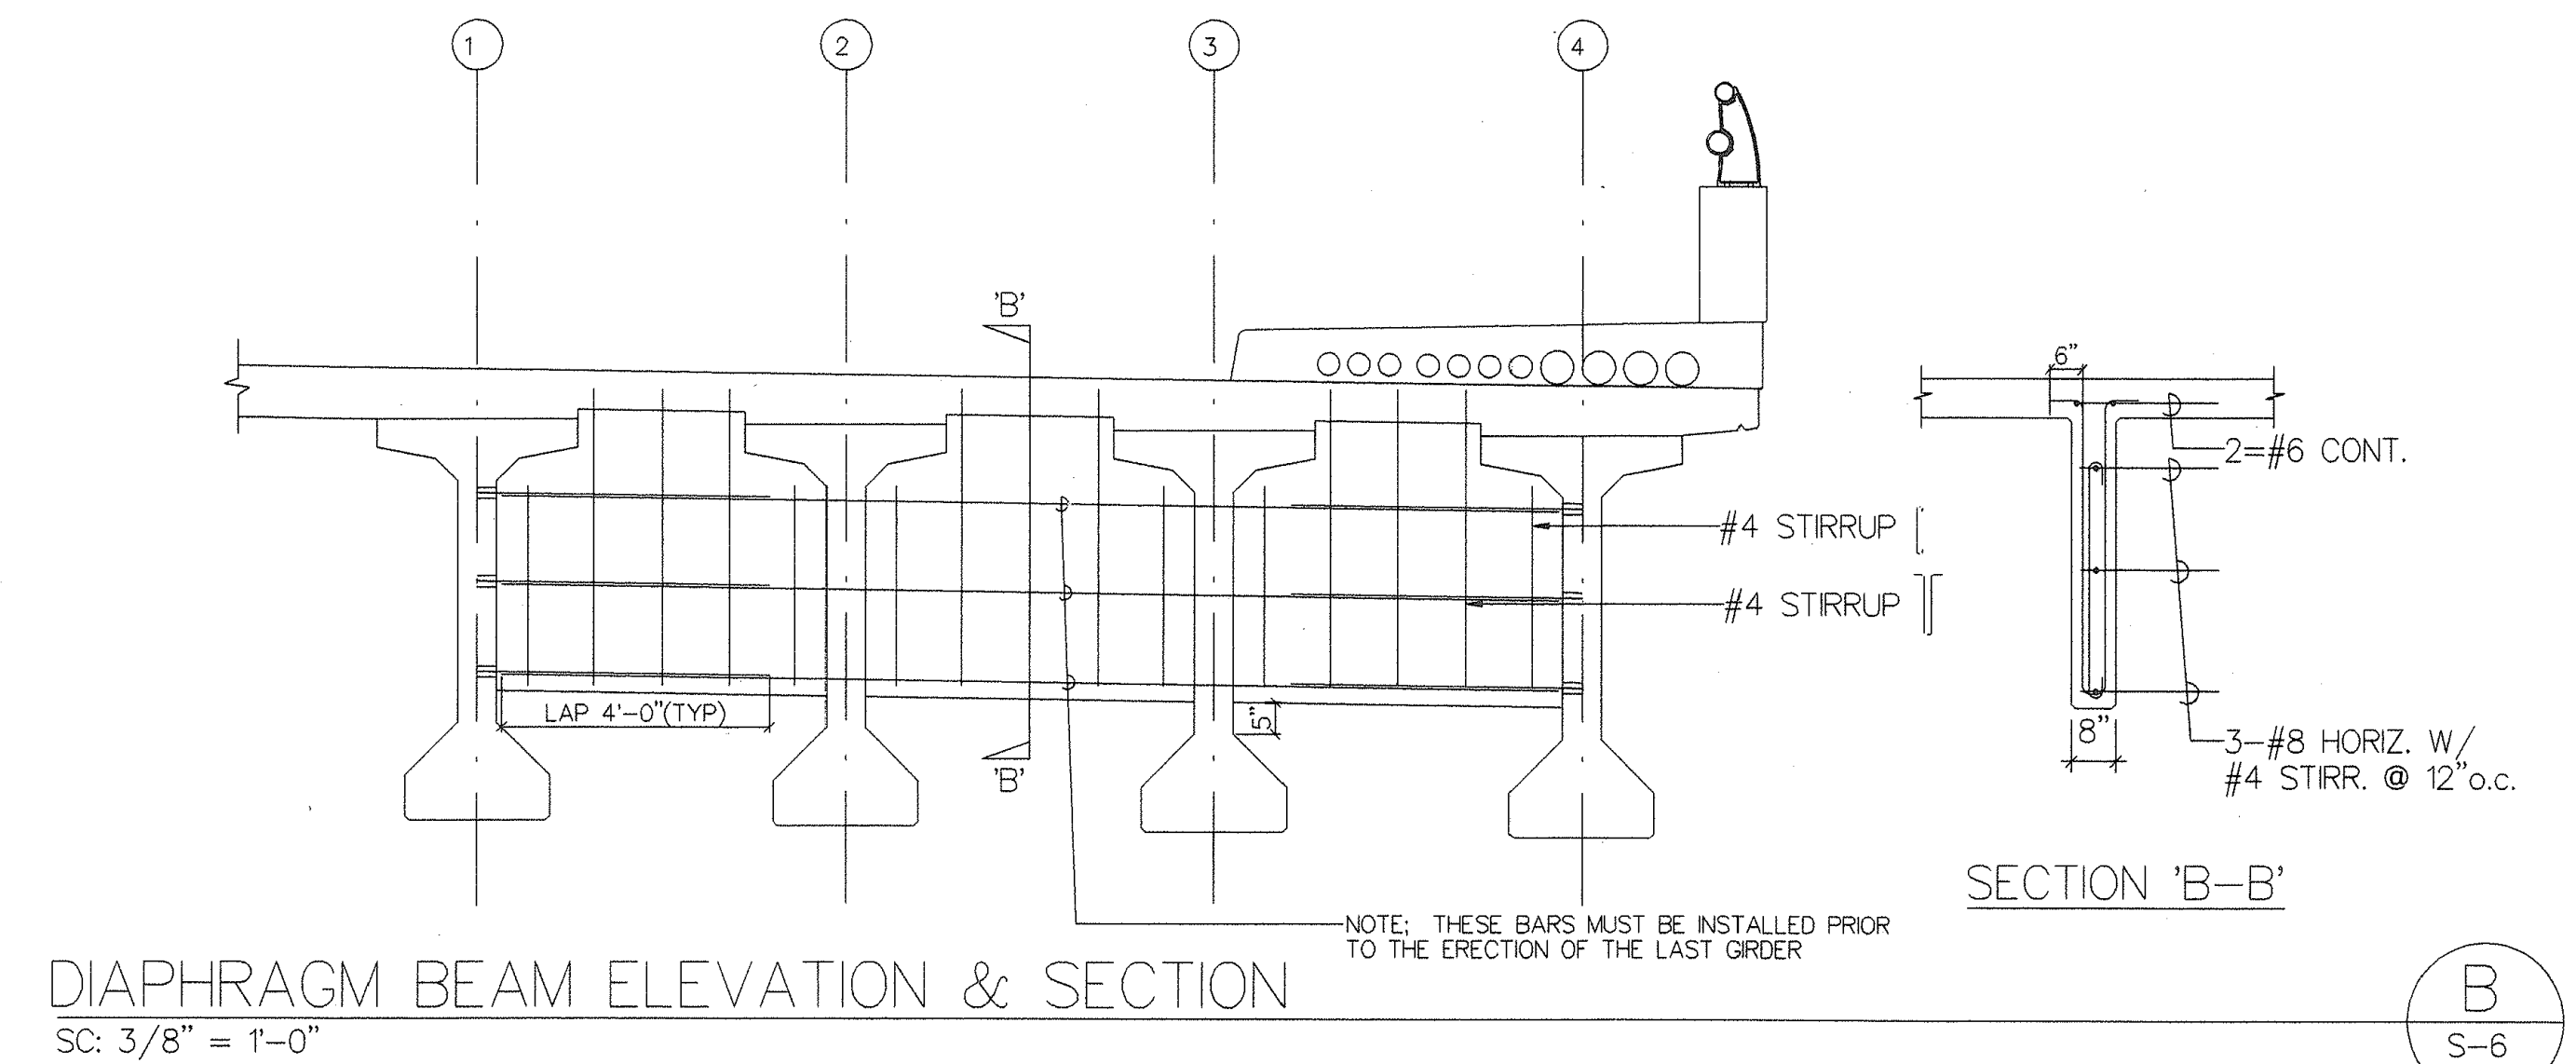

DIAPHRAGM BEAM ELEVATION & SECTION
SC: 3/8" = 1'-0"

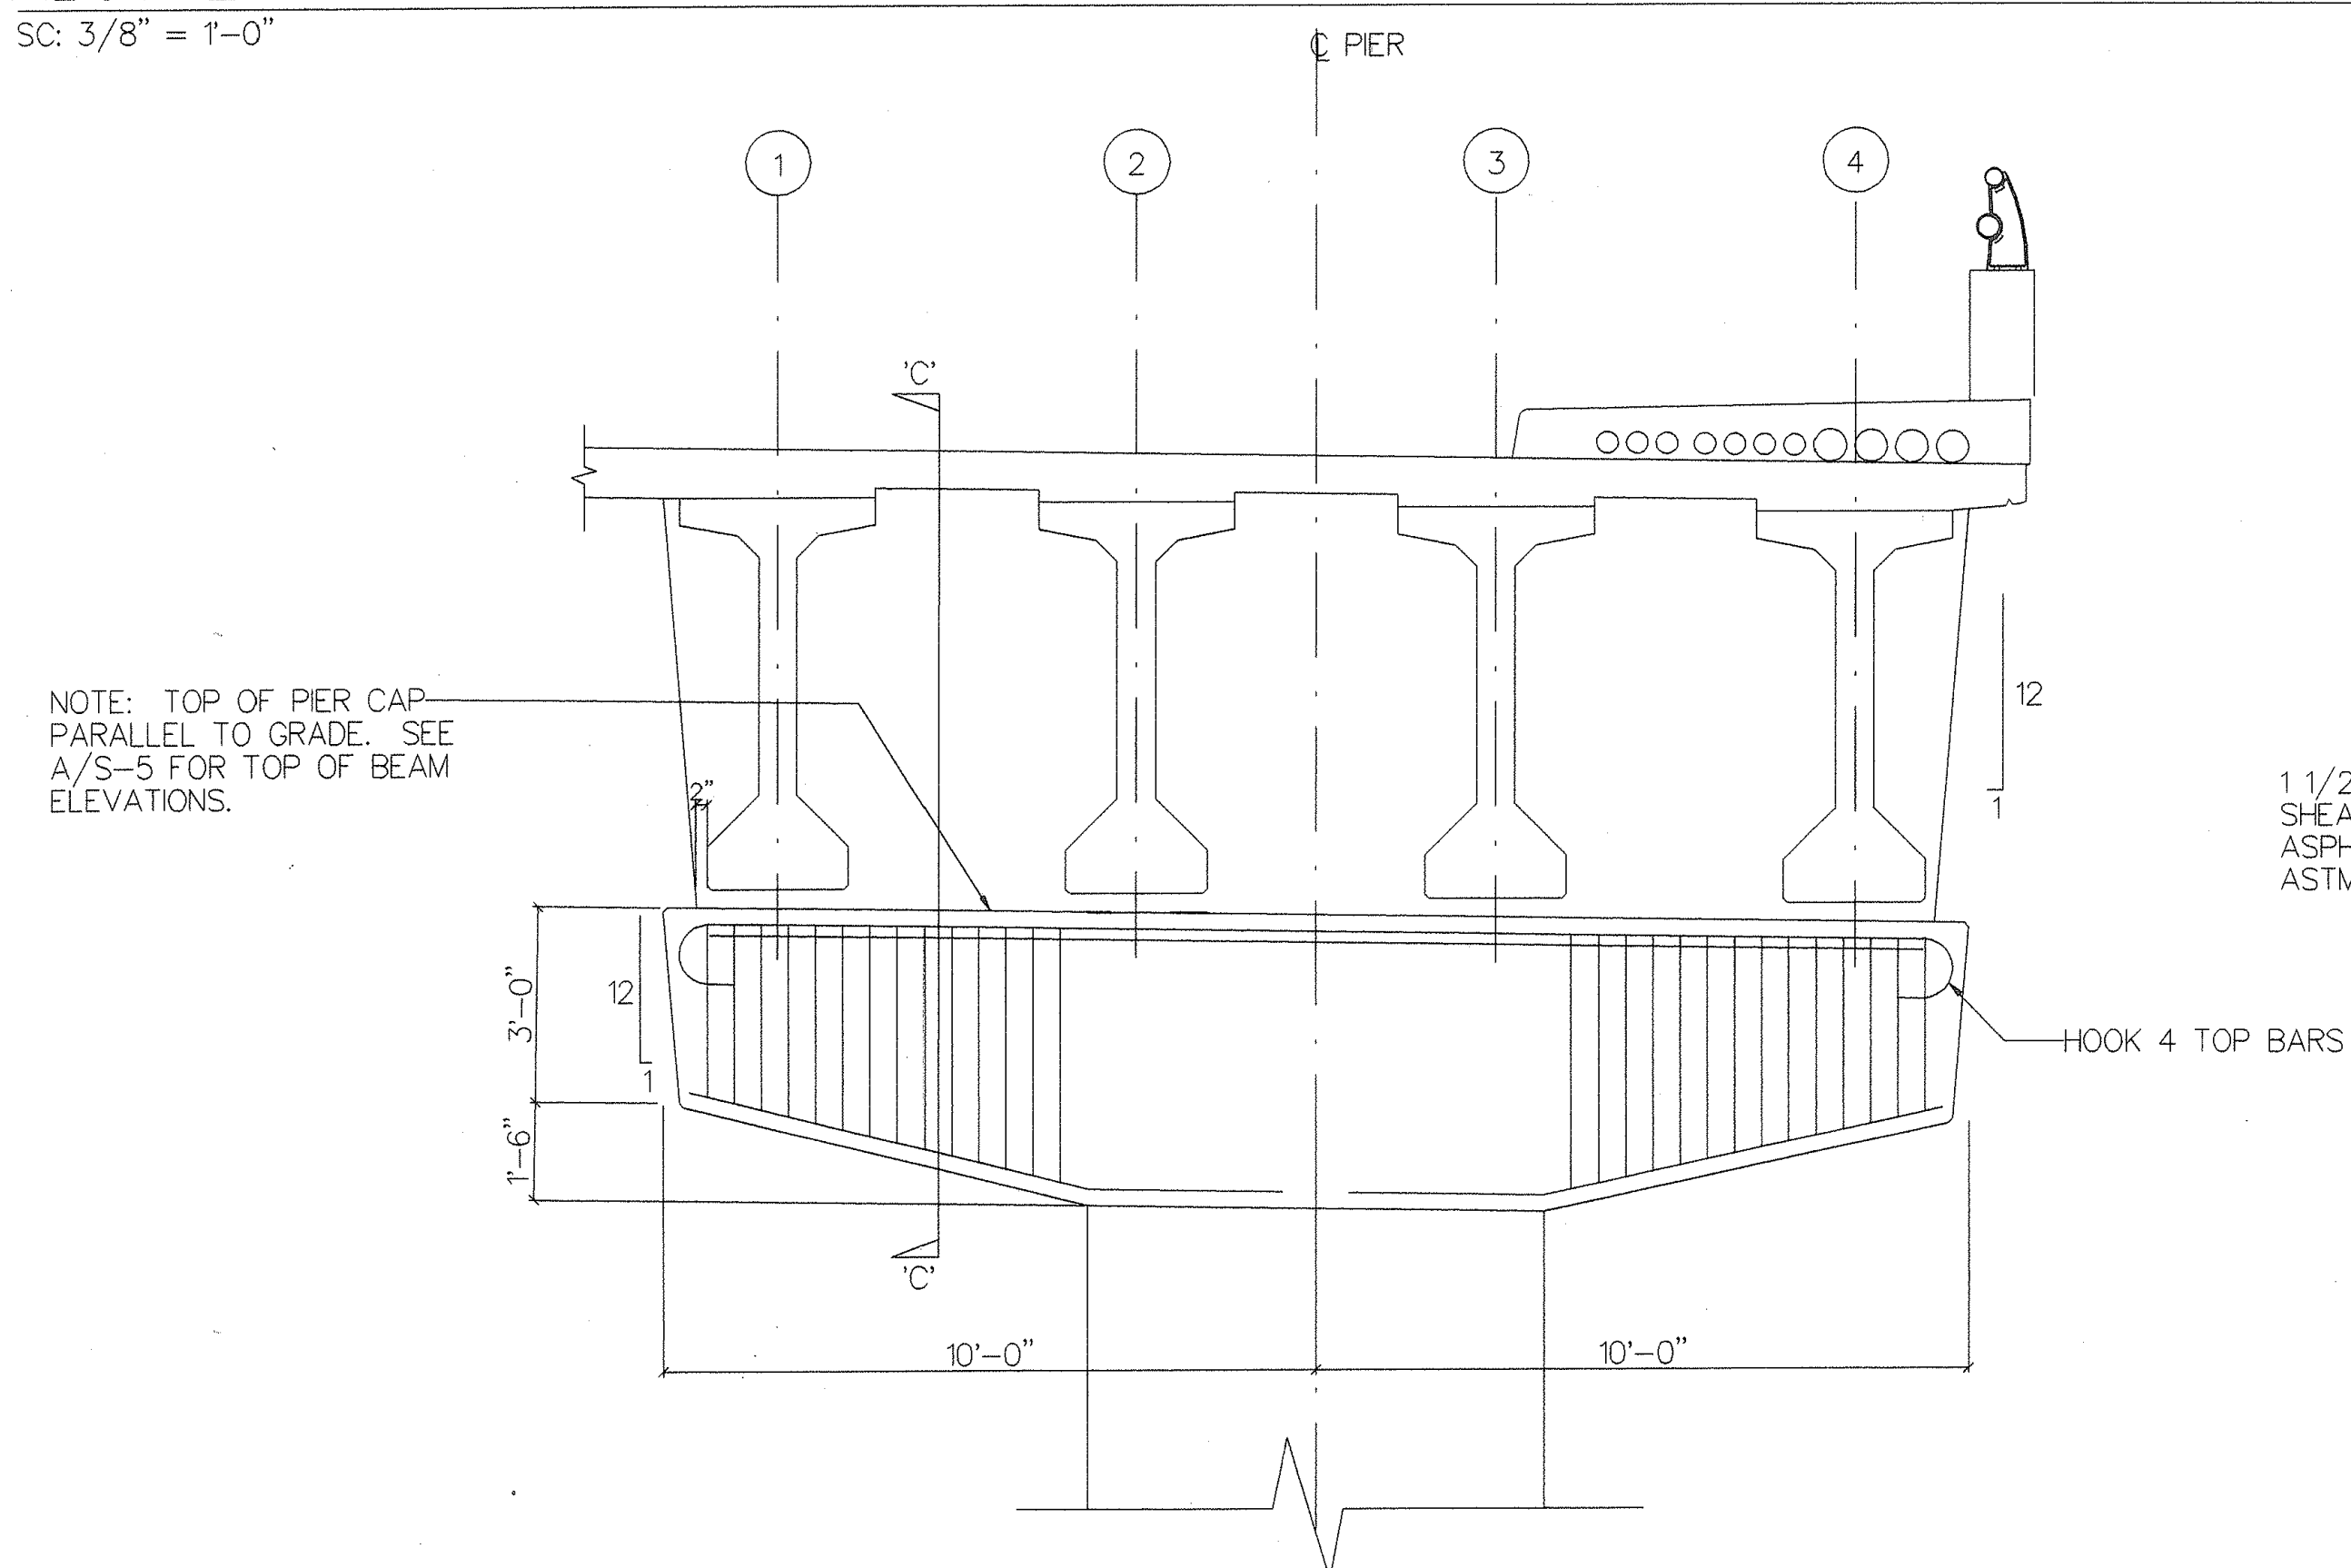


PIER BEAM ELEVATION & SECTION
SC: 3/8" = 1'-0"

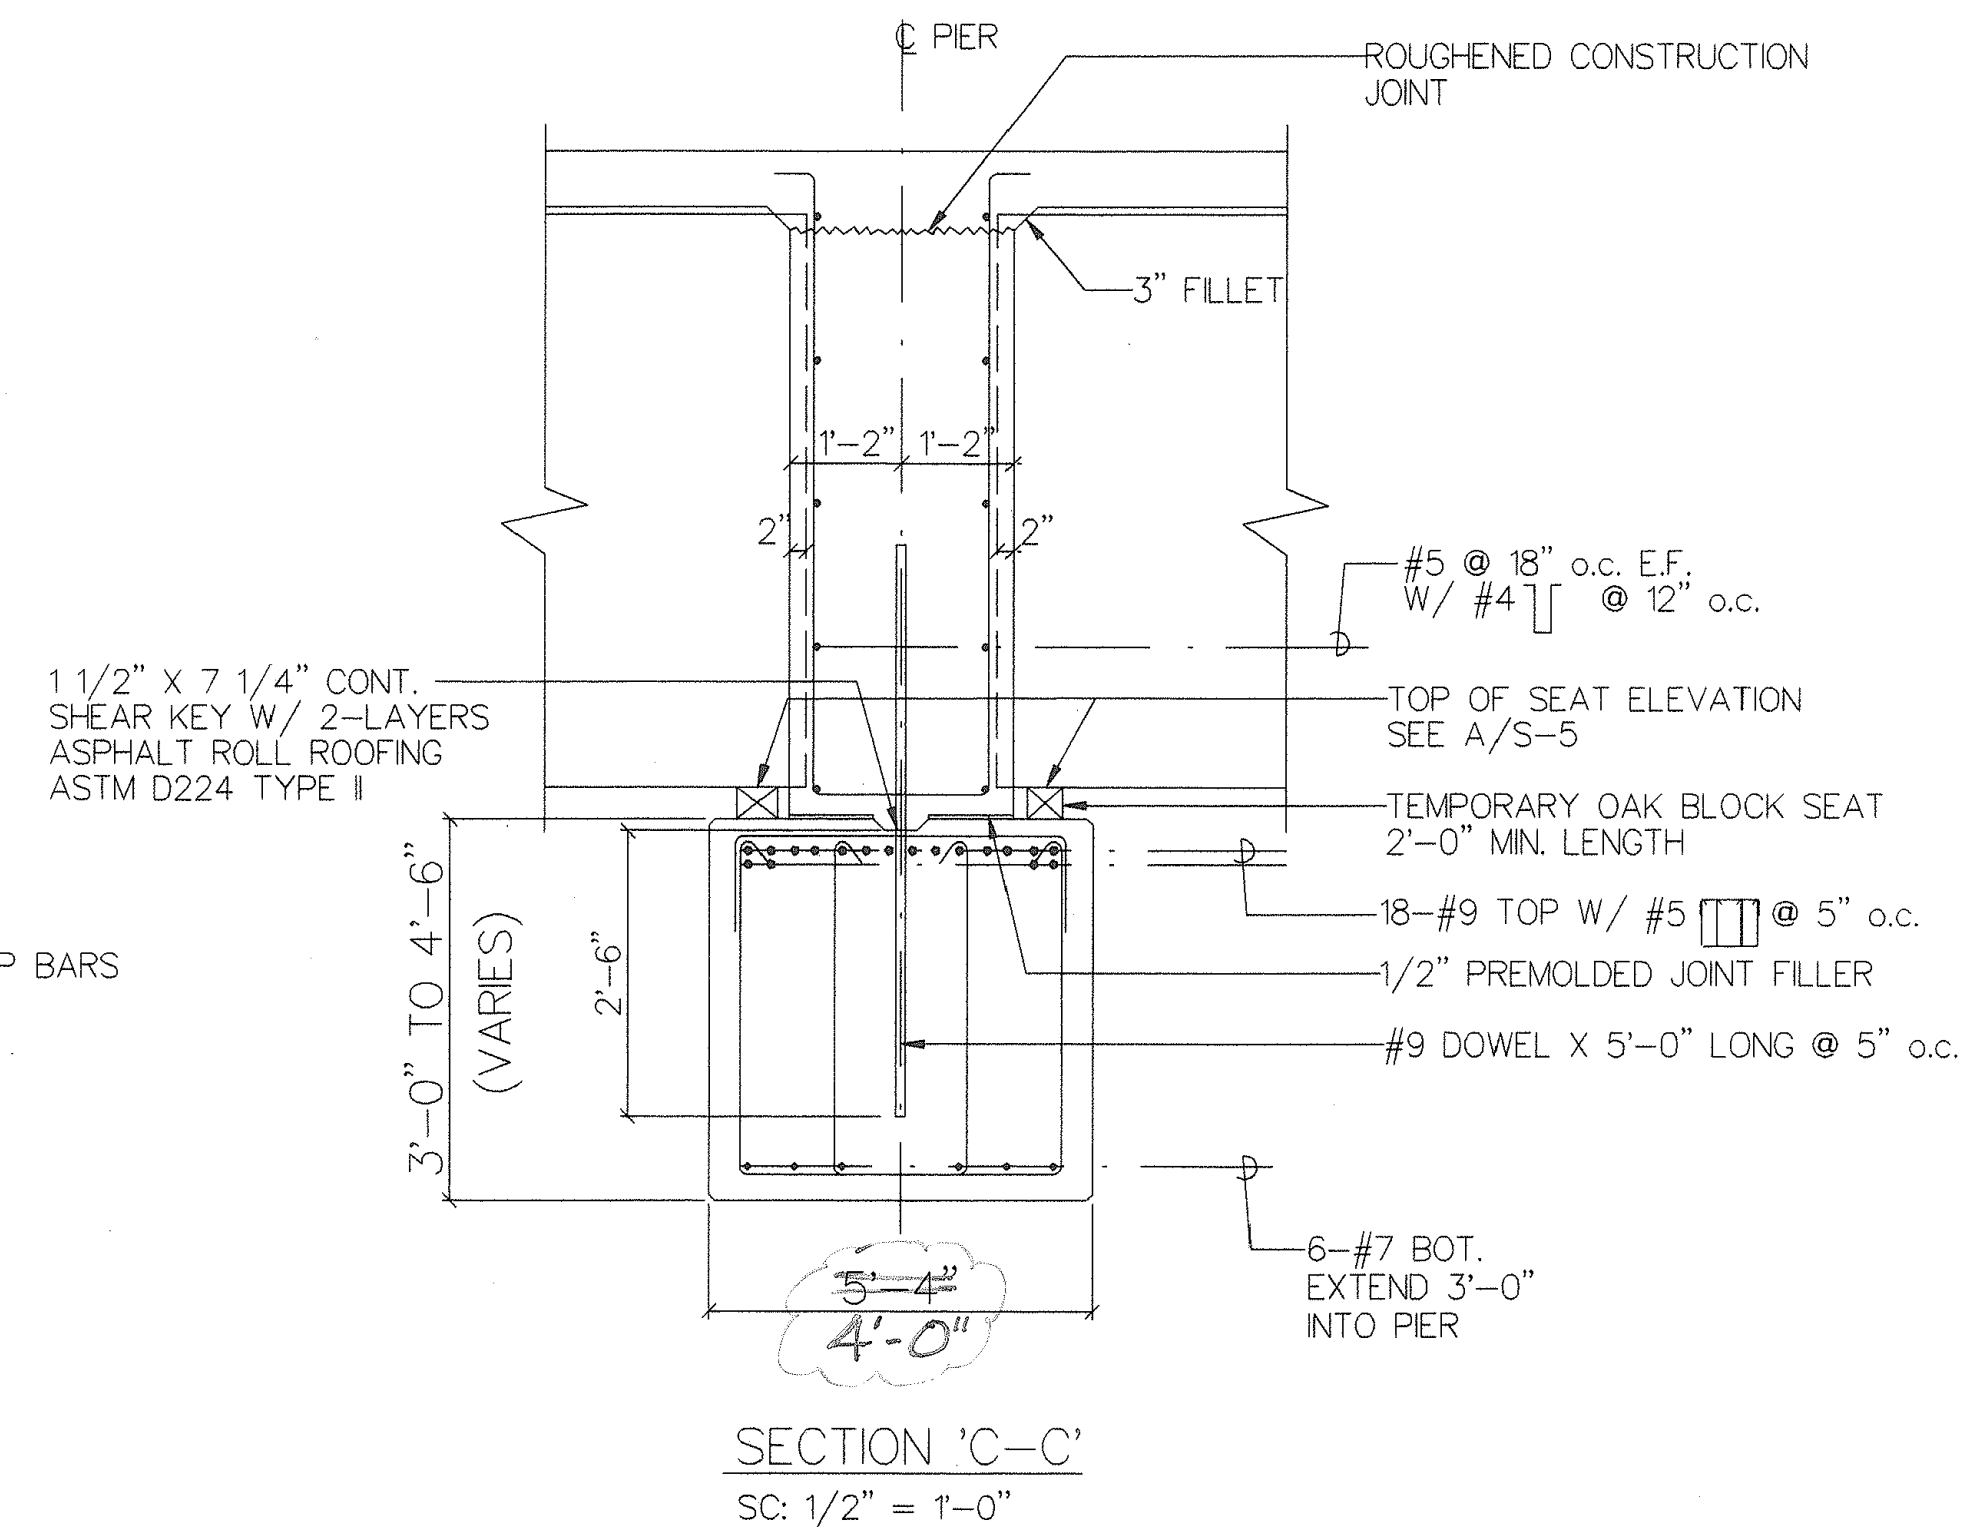

SECTION 'C-C'
SC: 1/2" = 1'-0"

ORIGINAL PLAN	SURVEY PLOTTED BY _____	_____
	DRAWN BY _____	_____
NOTE BOOK	TRACED BY _____	_____
	DESIGNED BY _____	_____
	QUANTITIES BY _____	_____
	CHECKED BY _____	_____
No. _____		_____

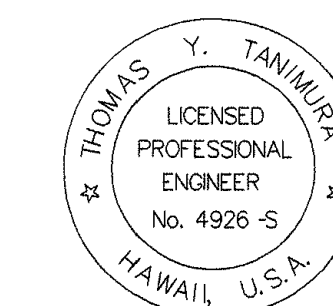


THIS WORK WAS PREPARED BY
ME OR UNDER MY SUPERVISION.
Ty Tennison
Signature

5/4/99	Revise Seat Condition & Beam Dimensions
DATE	REVISION

STATE OF HAWAII
DEPARTMENT OF TRANSPORTATION
HIGHWAYS DIVISION

ABUTMENT, PIER AND
DIAPHRAGM BEAMS

MANAGER'S DRIVE BRIDGE WIDENING
INTERSTATE ROUTE H-1







A
S-7

4

ORIGINAL PLAN	SURVEY PLOTTED BY _____
NOTE BOOK	DRAWN BY _____
	TRACED BY _____
	DESIGNED BY _____
	QUANTITIES BY _____
No. _____	CHECKED BY _____

FED. ROAD DIST. NO.	STATE	FED. AID PROJ. NO.	FISCAL YEAR	SHEET NO.	TOTAL SHEETS
HAWAII	HAW.	PMT-HIC-01-97			

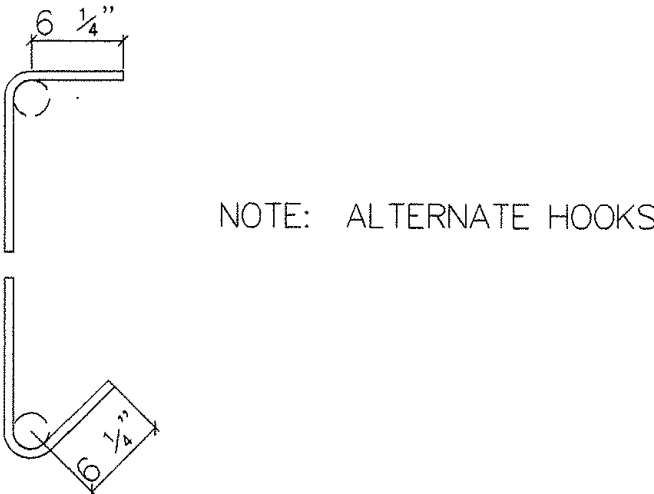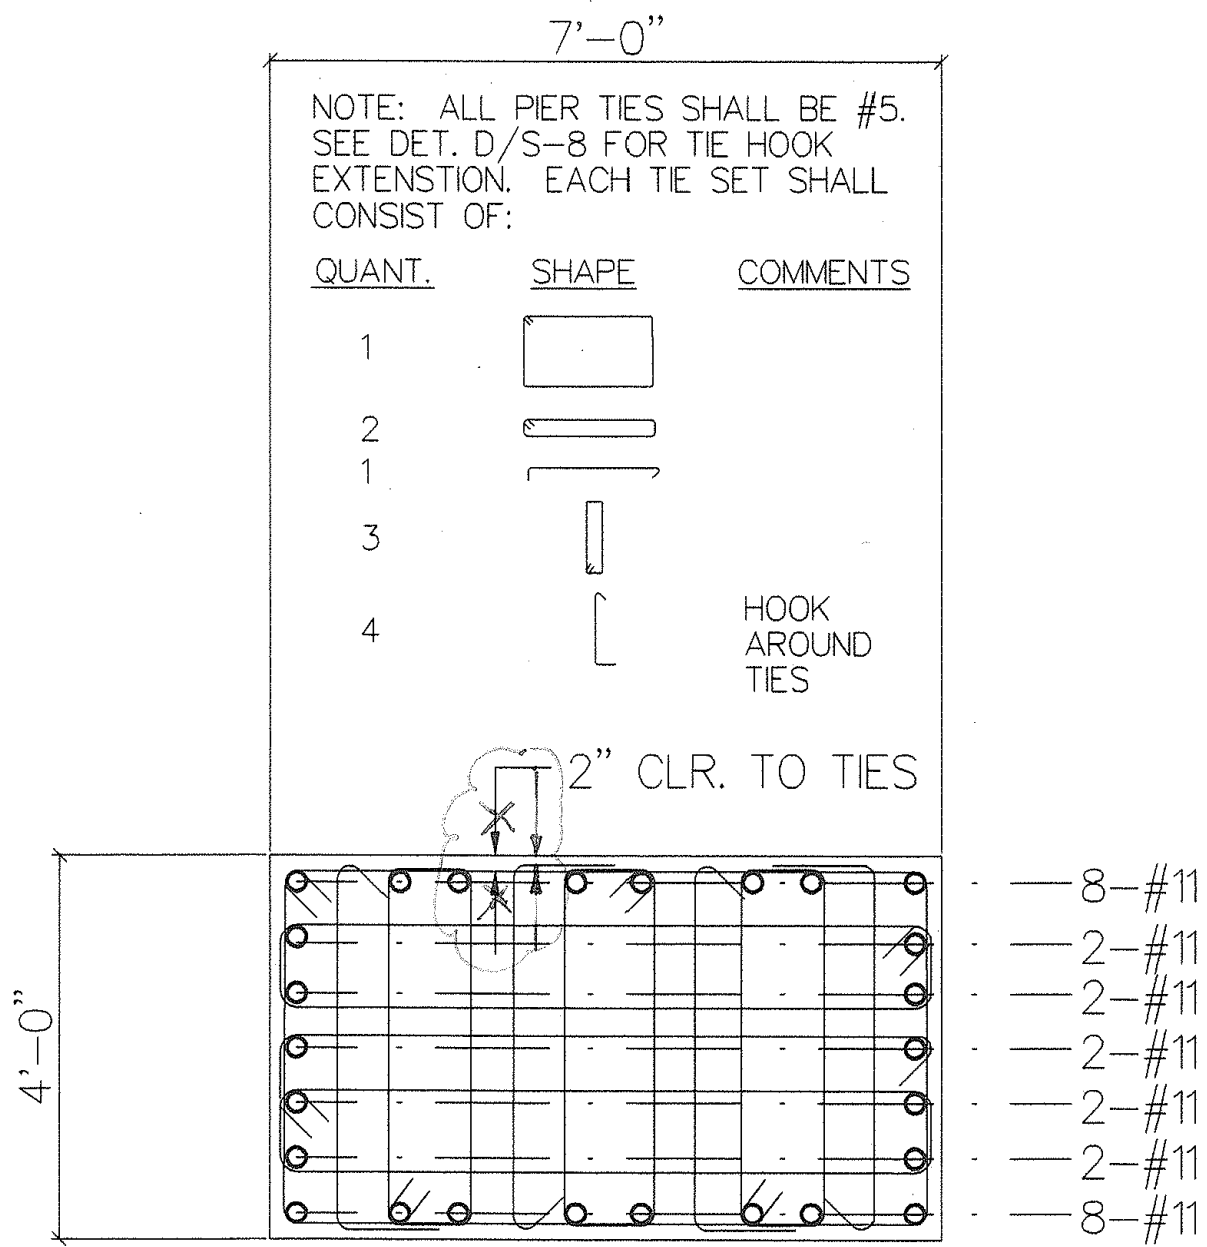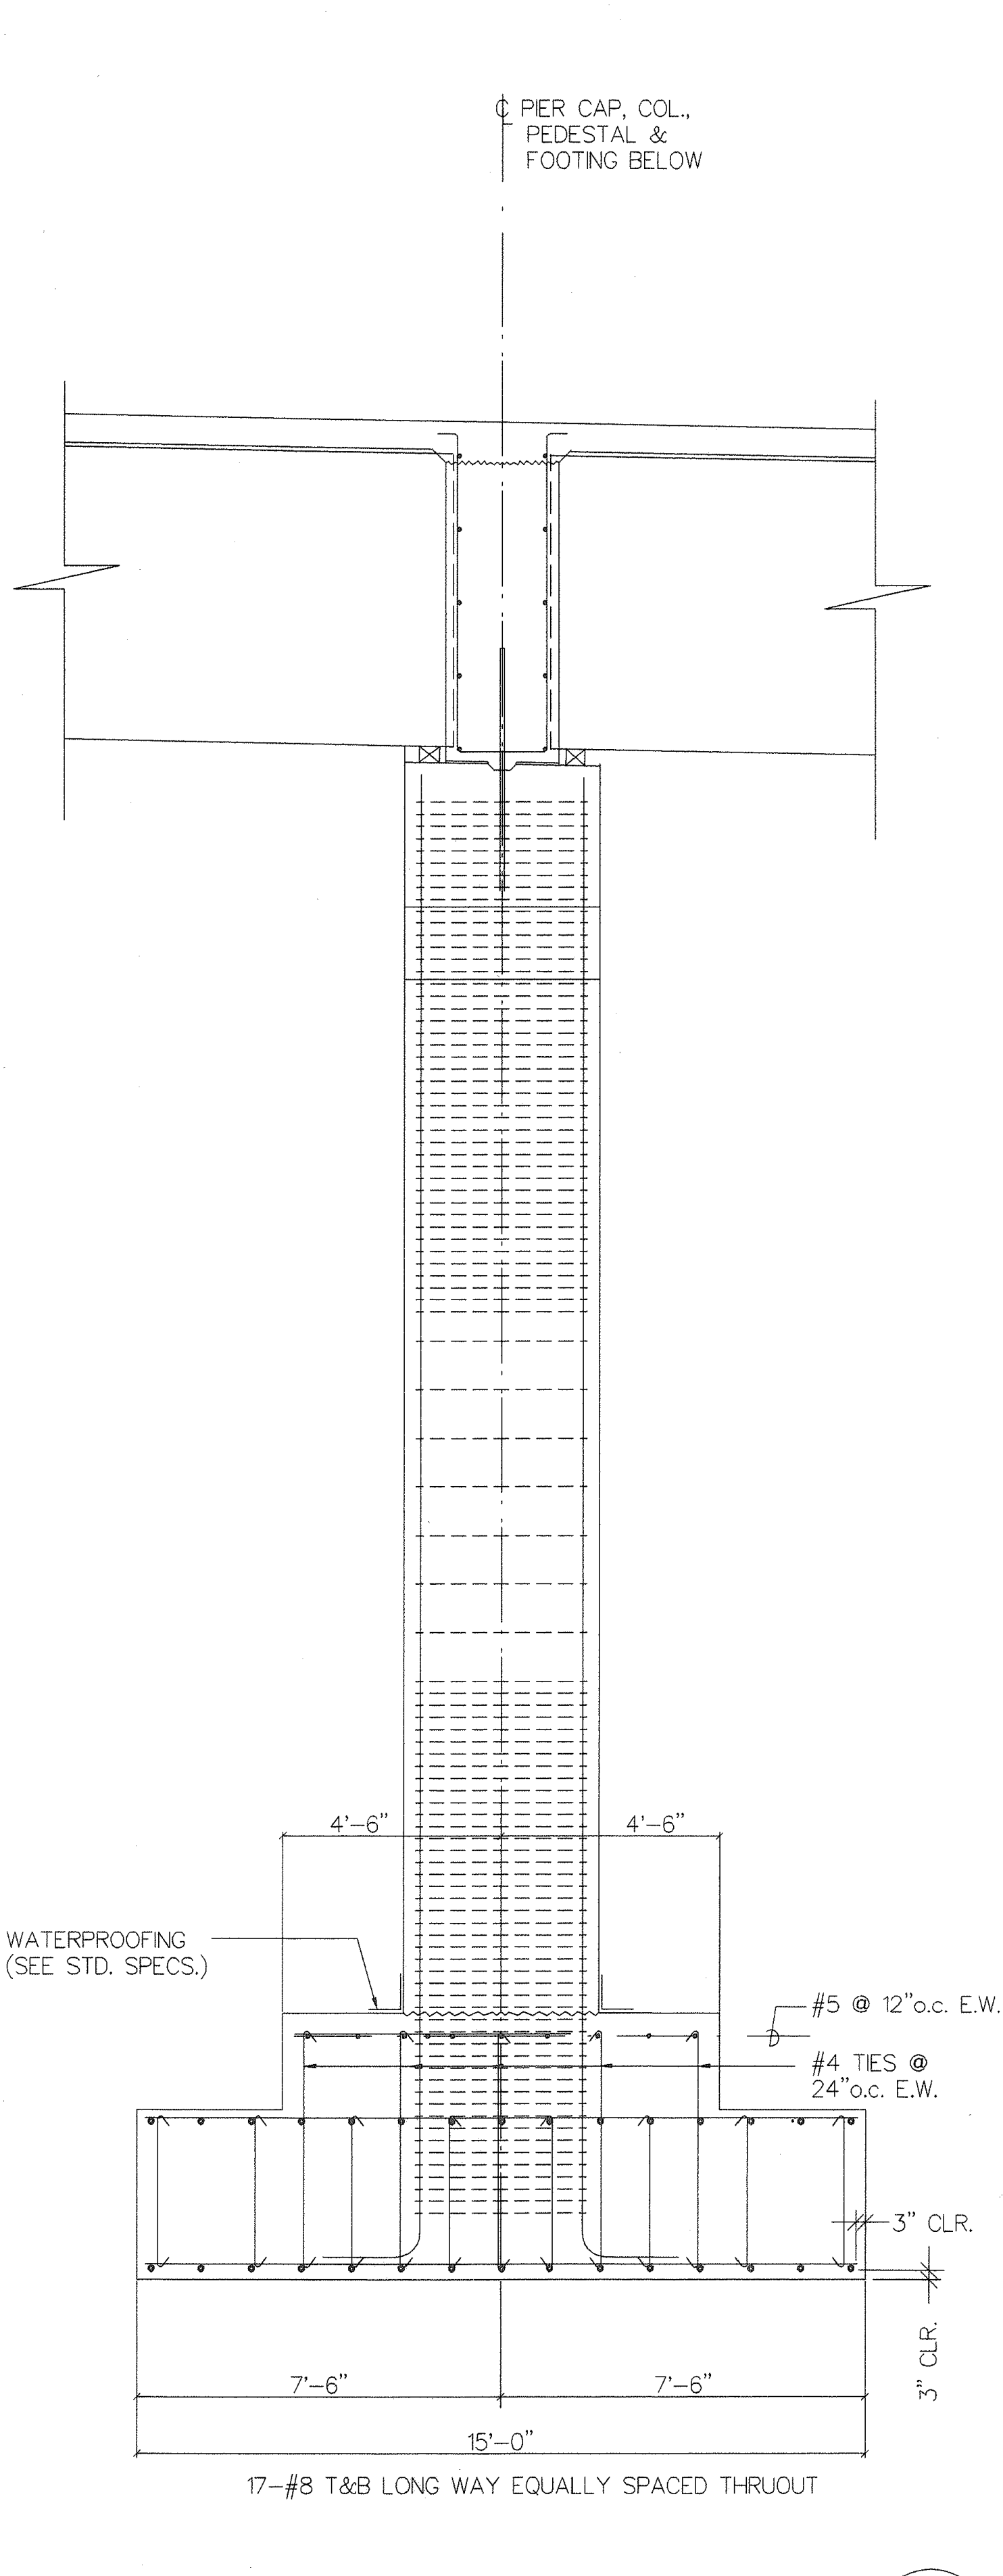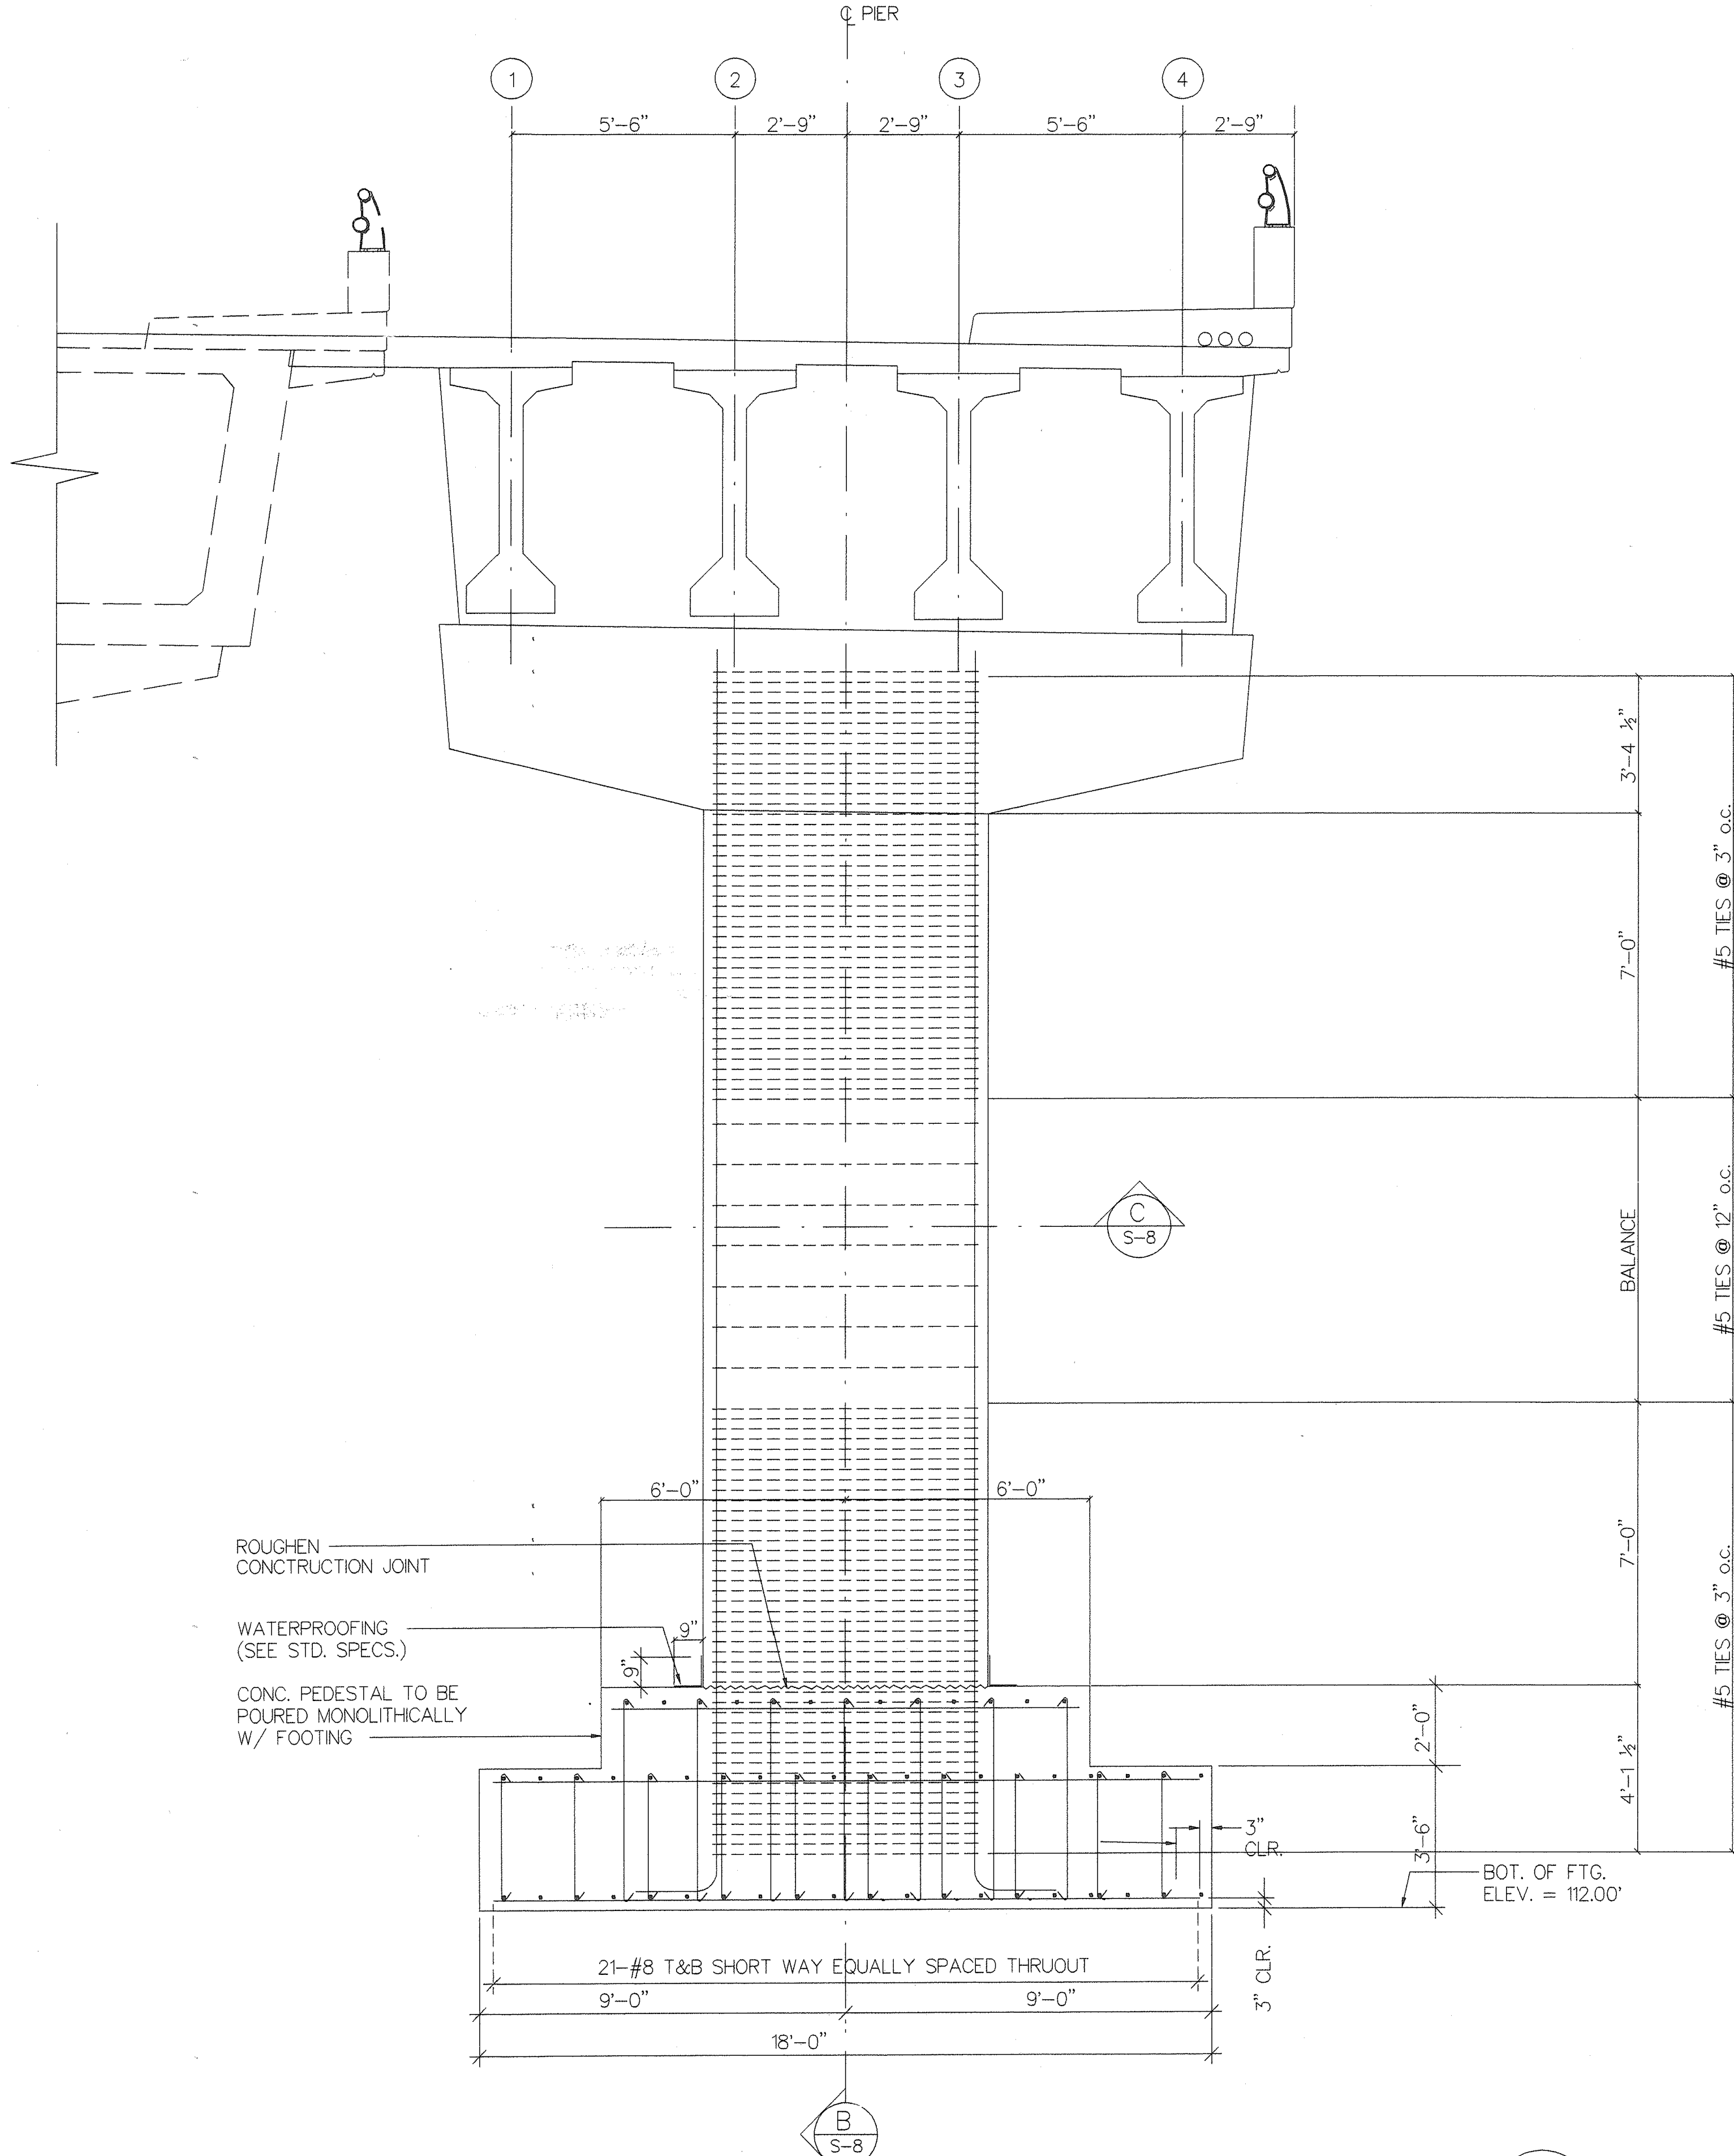


THIS WORK WAS PREPARED BY ME OR UNDER MY SUPERVISION

Signature: *Thomas Y. Taniguchi*

Professional Engineer No. 4926-S HAWAII, U.S.A.


5/4/99	Clarify Dimensions
DATE	REVISION
STATE OF HAWAII DEPARTMENT OF TRANSPORTATION HIGHWAYS DIVISION	
PIER ELEVATION/SECTION & DETAILS	
MANAGER'S DRIVE BRIDGE WIDENING INTERSTATE ROUTE H-1	
SHEET NO. S-8 OF 16 SHEETS	

FED. ROAD DIST. NO.	STATE	FED. AID PROJ. NO.	FISCAL YEAR	SHEET NO.	TOTAL SHEETS
HAWAII	HAW.	FMT-HIC-01-97			

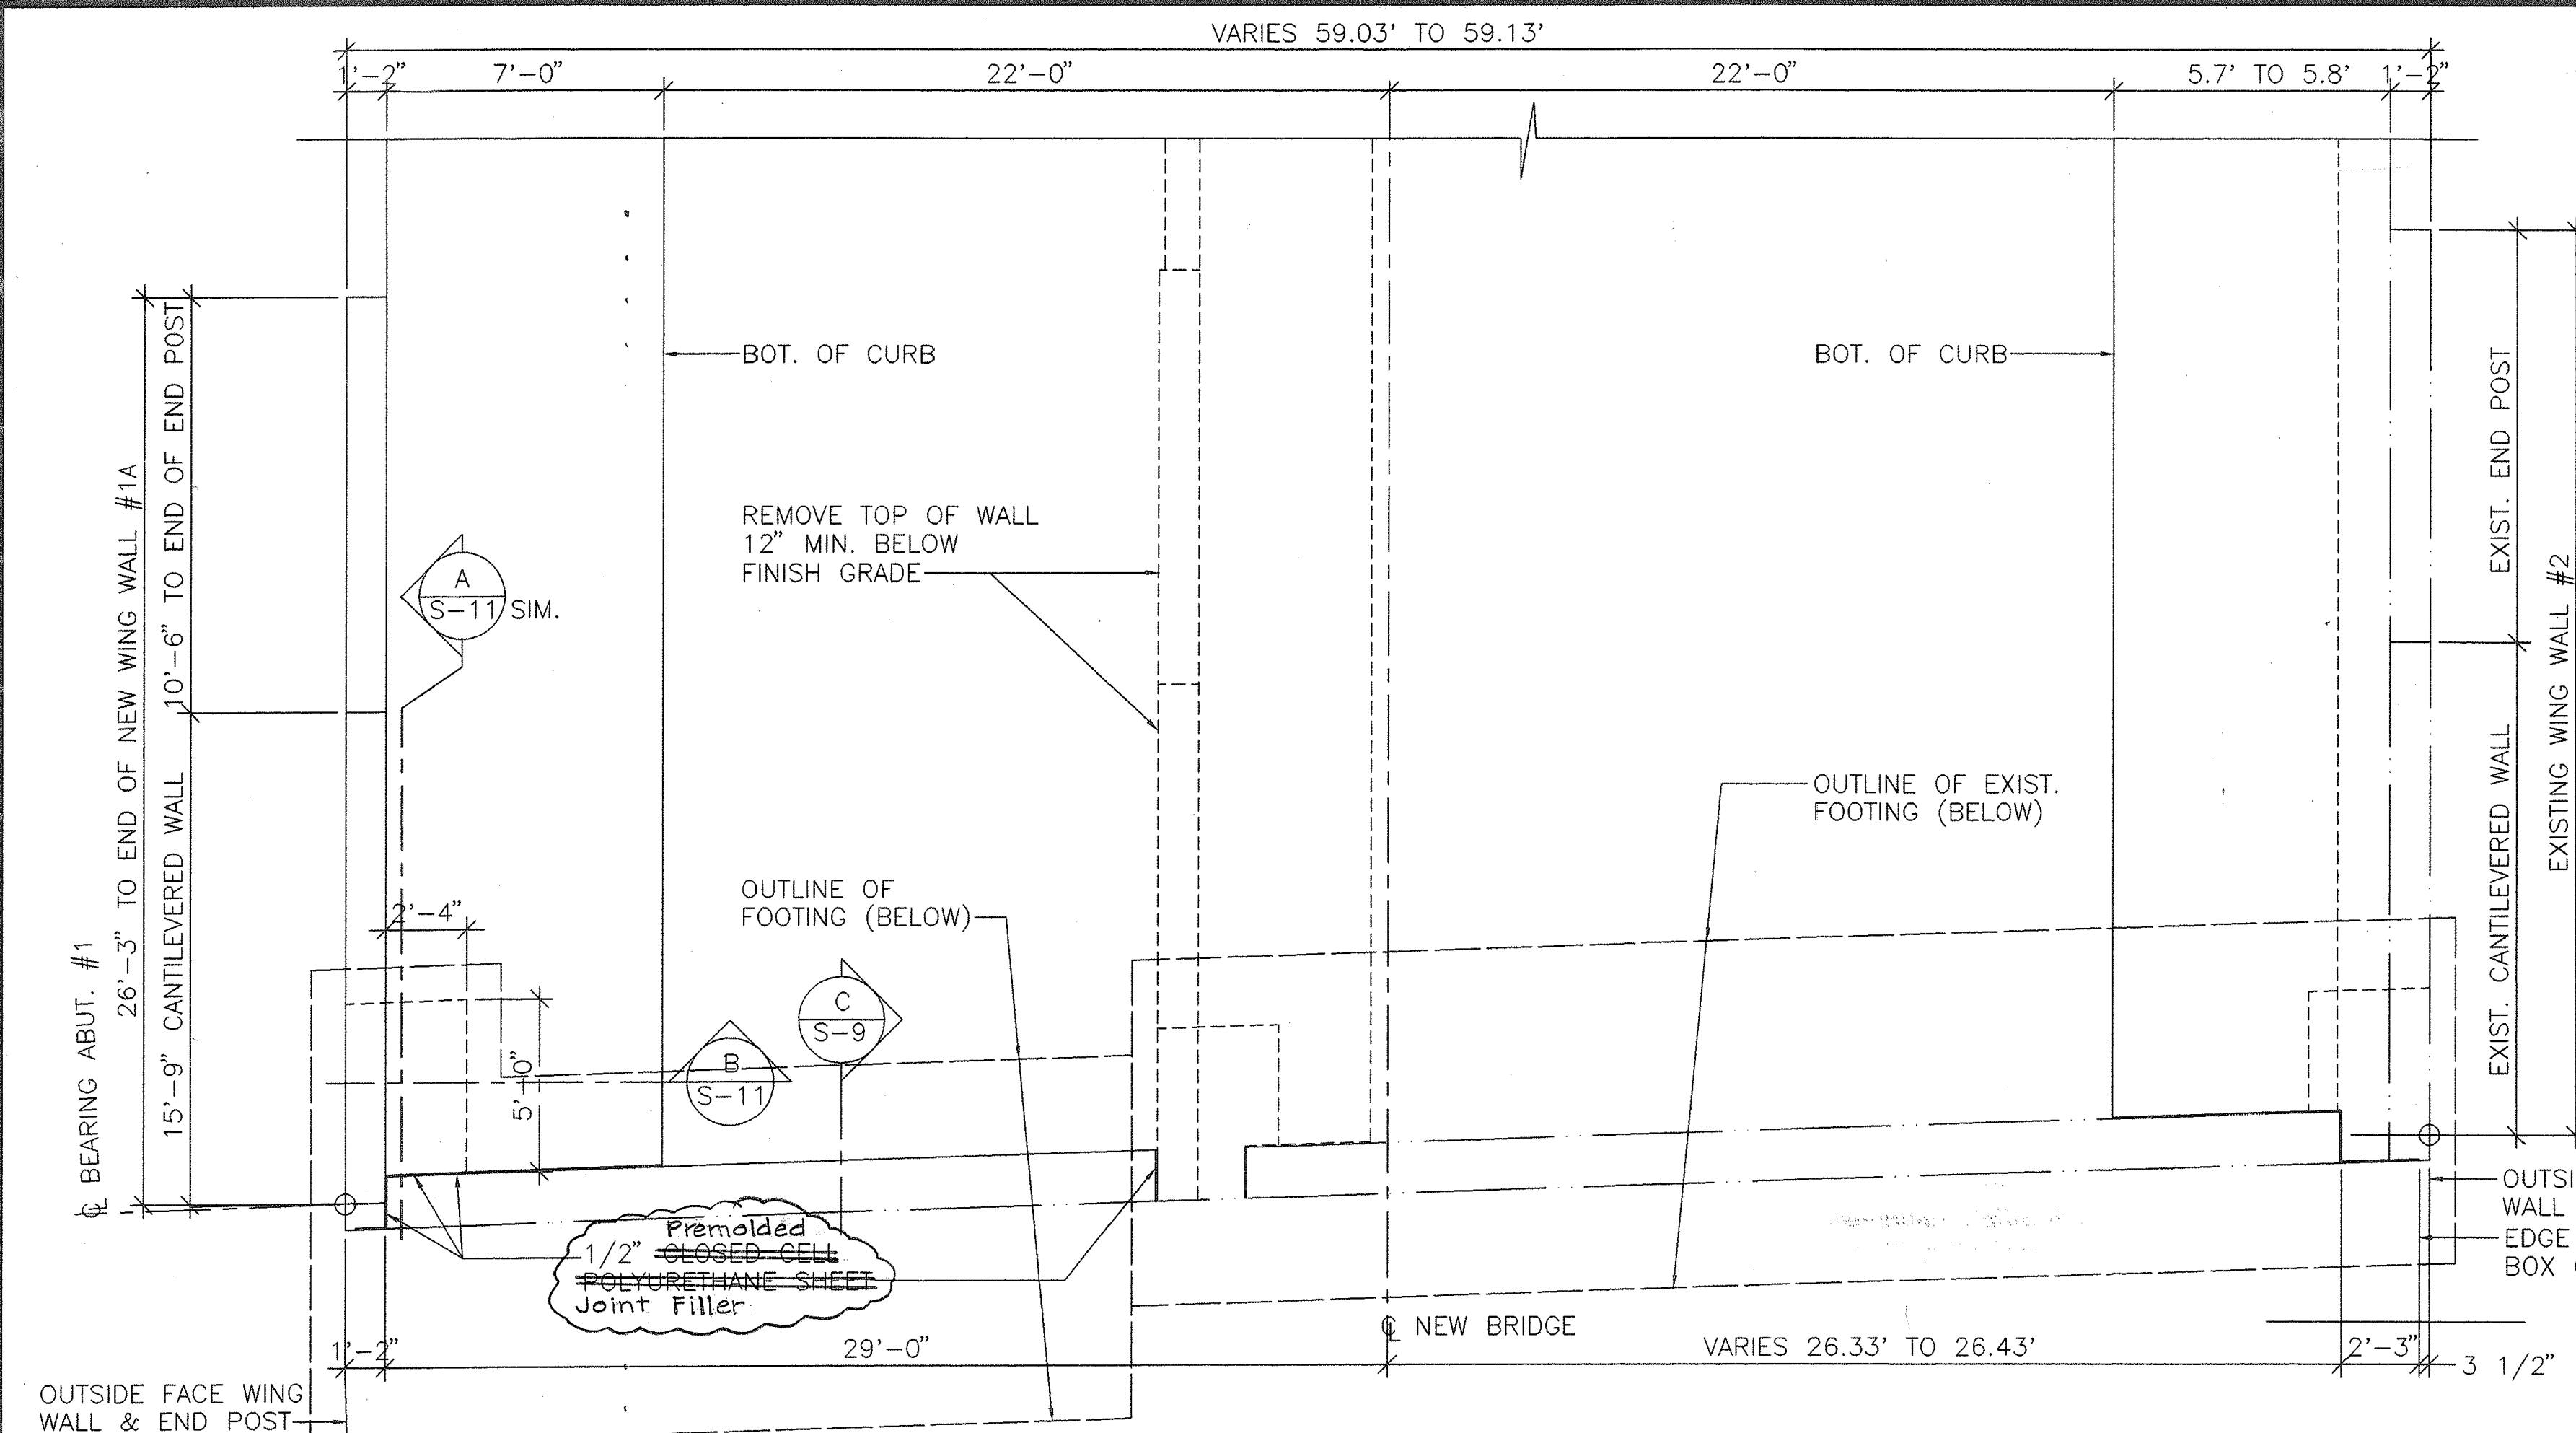


ABUTMENT #1 PLAN

SC: $1/4'' = 1'-0''$

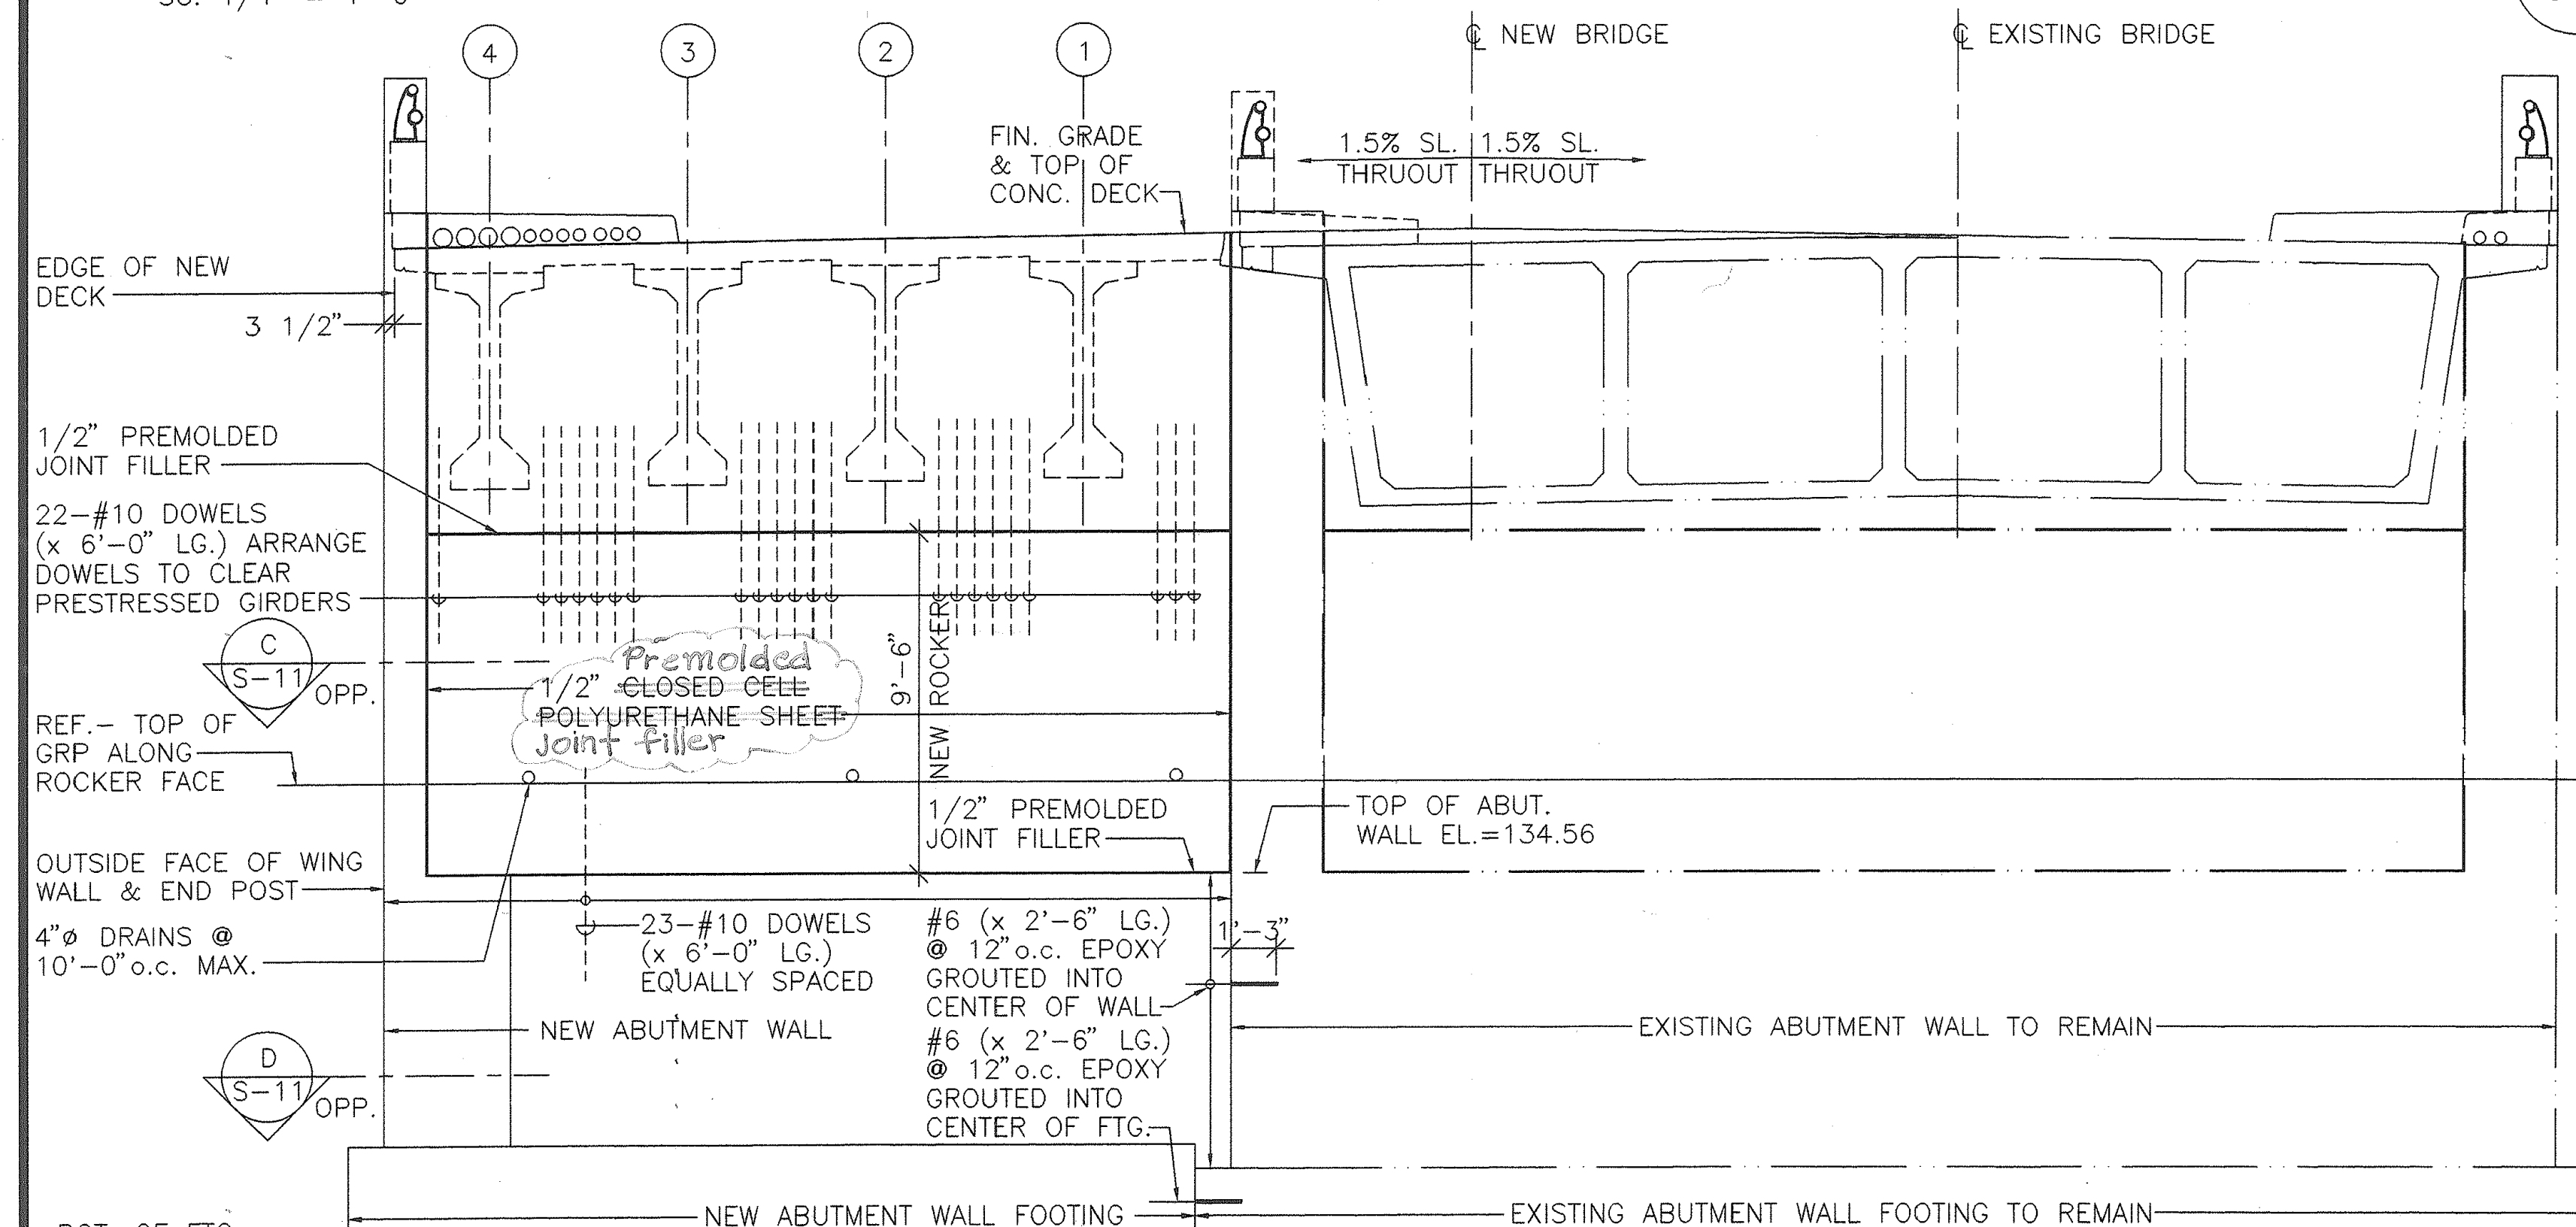

ABUTMENT #1 ELEVATION


SC: $1/4" = 1'-0"$

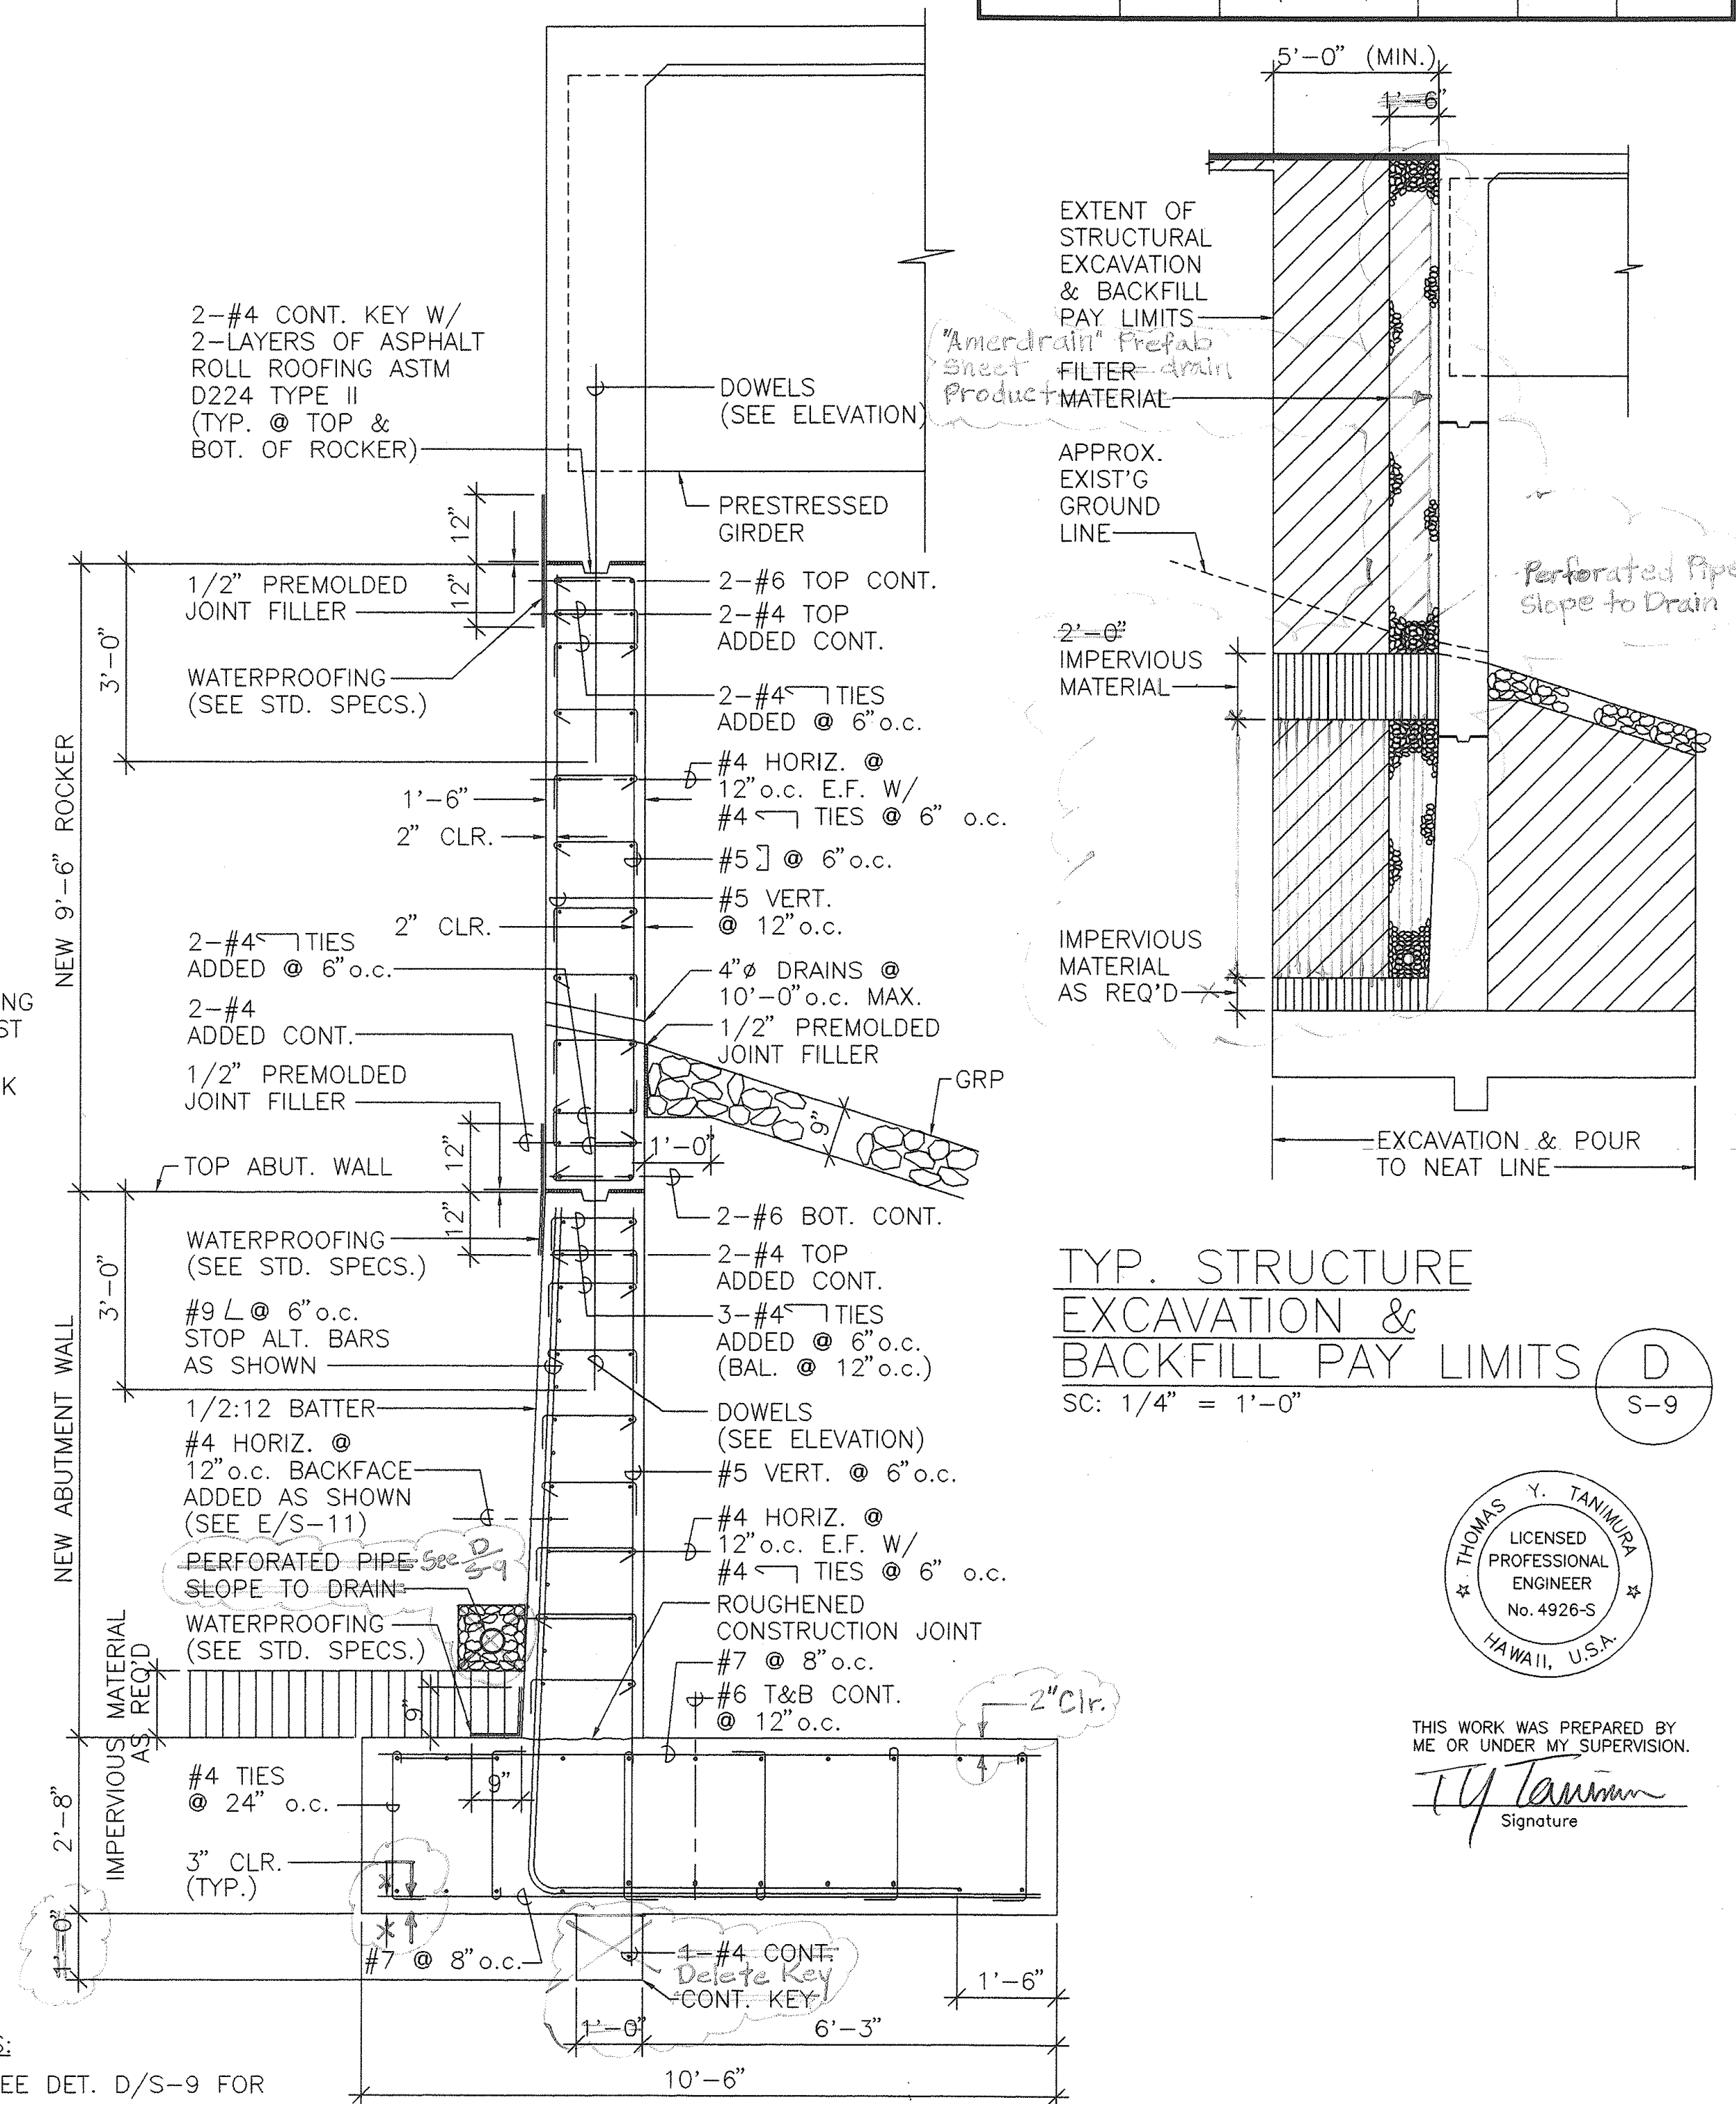

TYP. STRUCTURE
EXCAVATION &
BACKFILL PAY LIMITS/

SC: $1/4'' = 1'-0''$

S-S

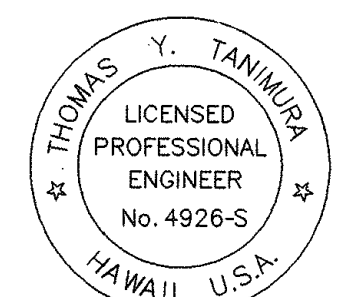

THIS WORK WAS PREPARED BY
ME OR UNDER MY SUPERVISION.


Th. Tamm
Signature

NOTES:

1. SEE DET. D/S-9 FOR
TYP. STRUCT. EXCAVATION
BACKFILL & PAY LIMITS
2. ALTERNATE HOOKS FOR
TIES.

ABUTMENT #1 SECTION

SC: $1/2'' = 1'-0''$

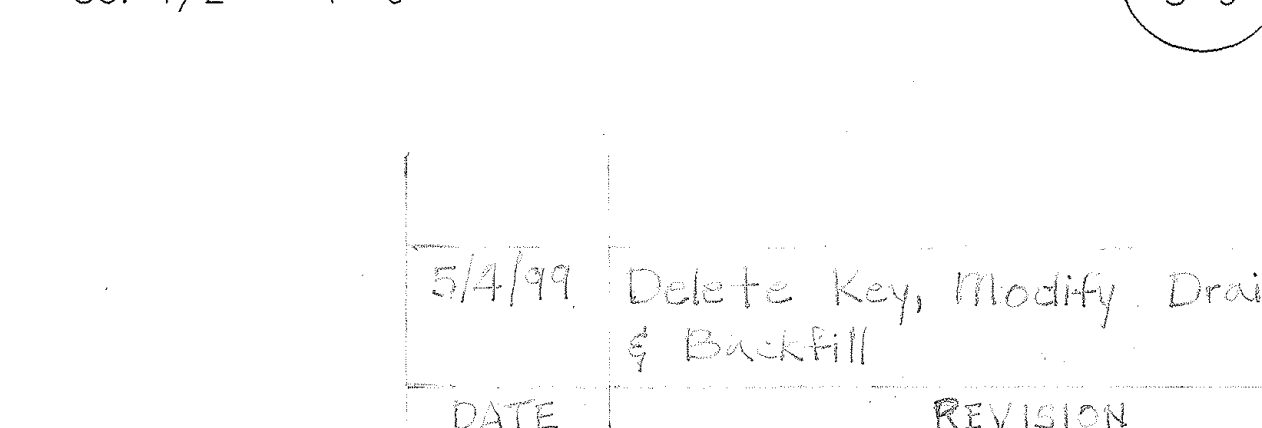


STATE OF HAWAII
DEPARTMENT OF TRANSPORTATION
HIGHWAYS DIVISION

ABUTMENT WALL #1 PLAN,
ELEVATION & SECTION

MANAGER'S DRIVE BRIDGE WIDENING
INTERSTATE ROUTE H-1


SHEET NO. S-9 OF 16 SHEETS

ORIGINAL PLAN	SURVEY PLOTTED BY _____
NOTE BOOK	DRAWN BY _____
	TRACED BY _____
	DESIGNED BY _____
	QUANTITIES BY _____
No. _____	CHECKED BY _____

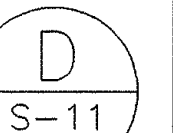

18

FED. ROAD DIST. NO.	STATE	FED. AID PROJ. NO.	FISCAL YEAR	SHEET NO.	TOTAL SHEETS
HAWAII	HAW.	PMT-H1C-01-97			

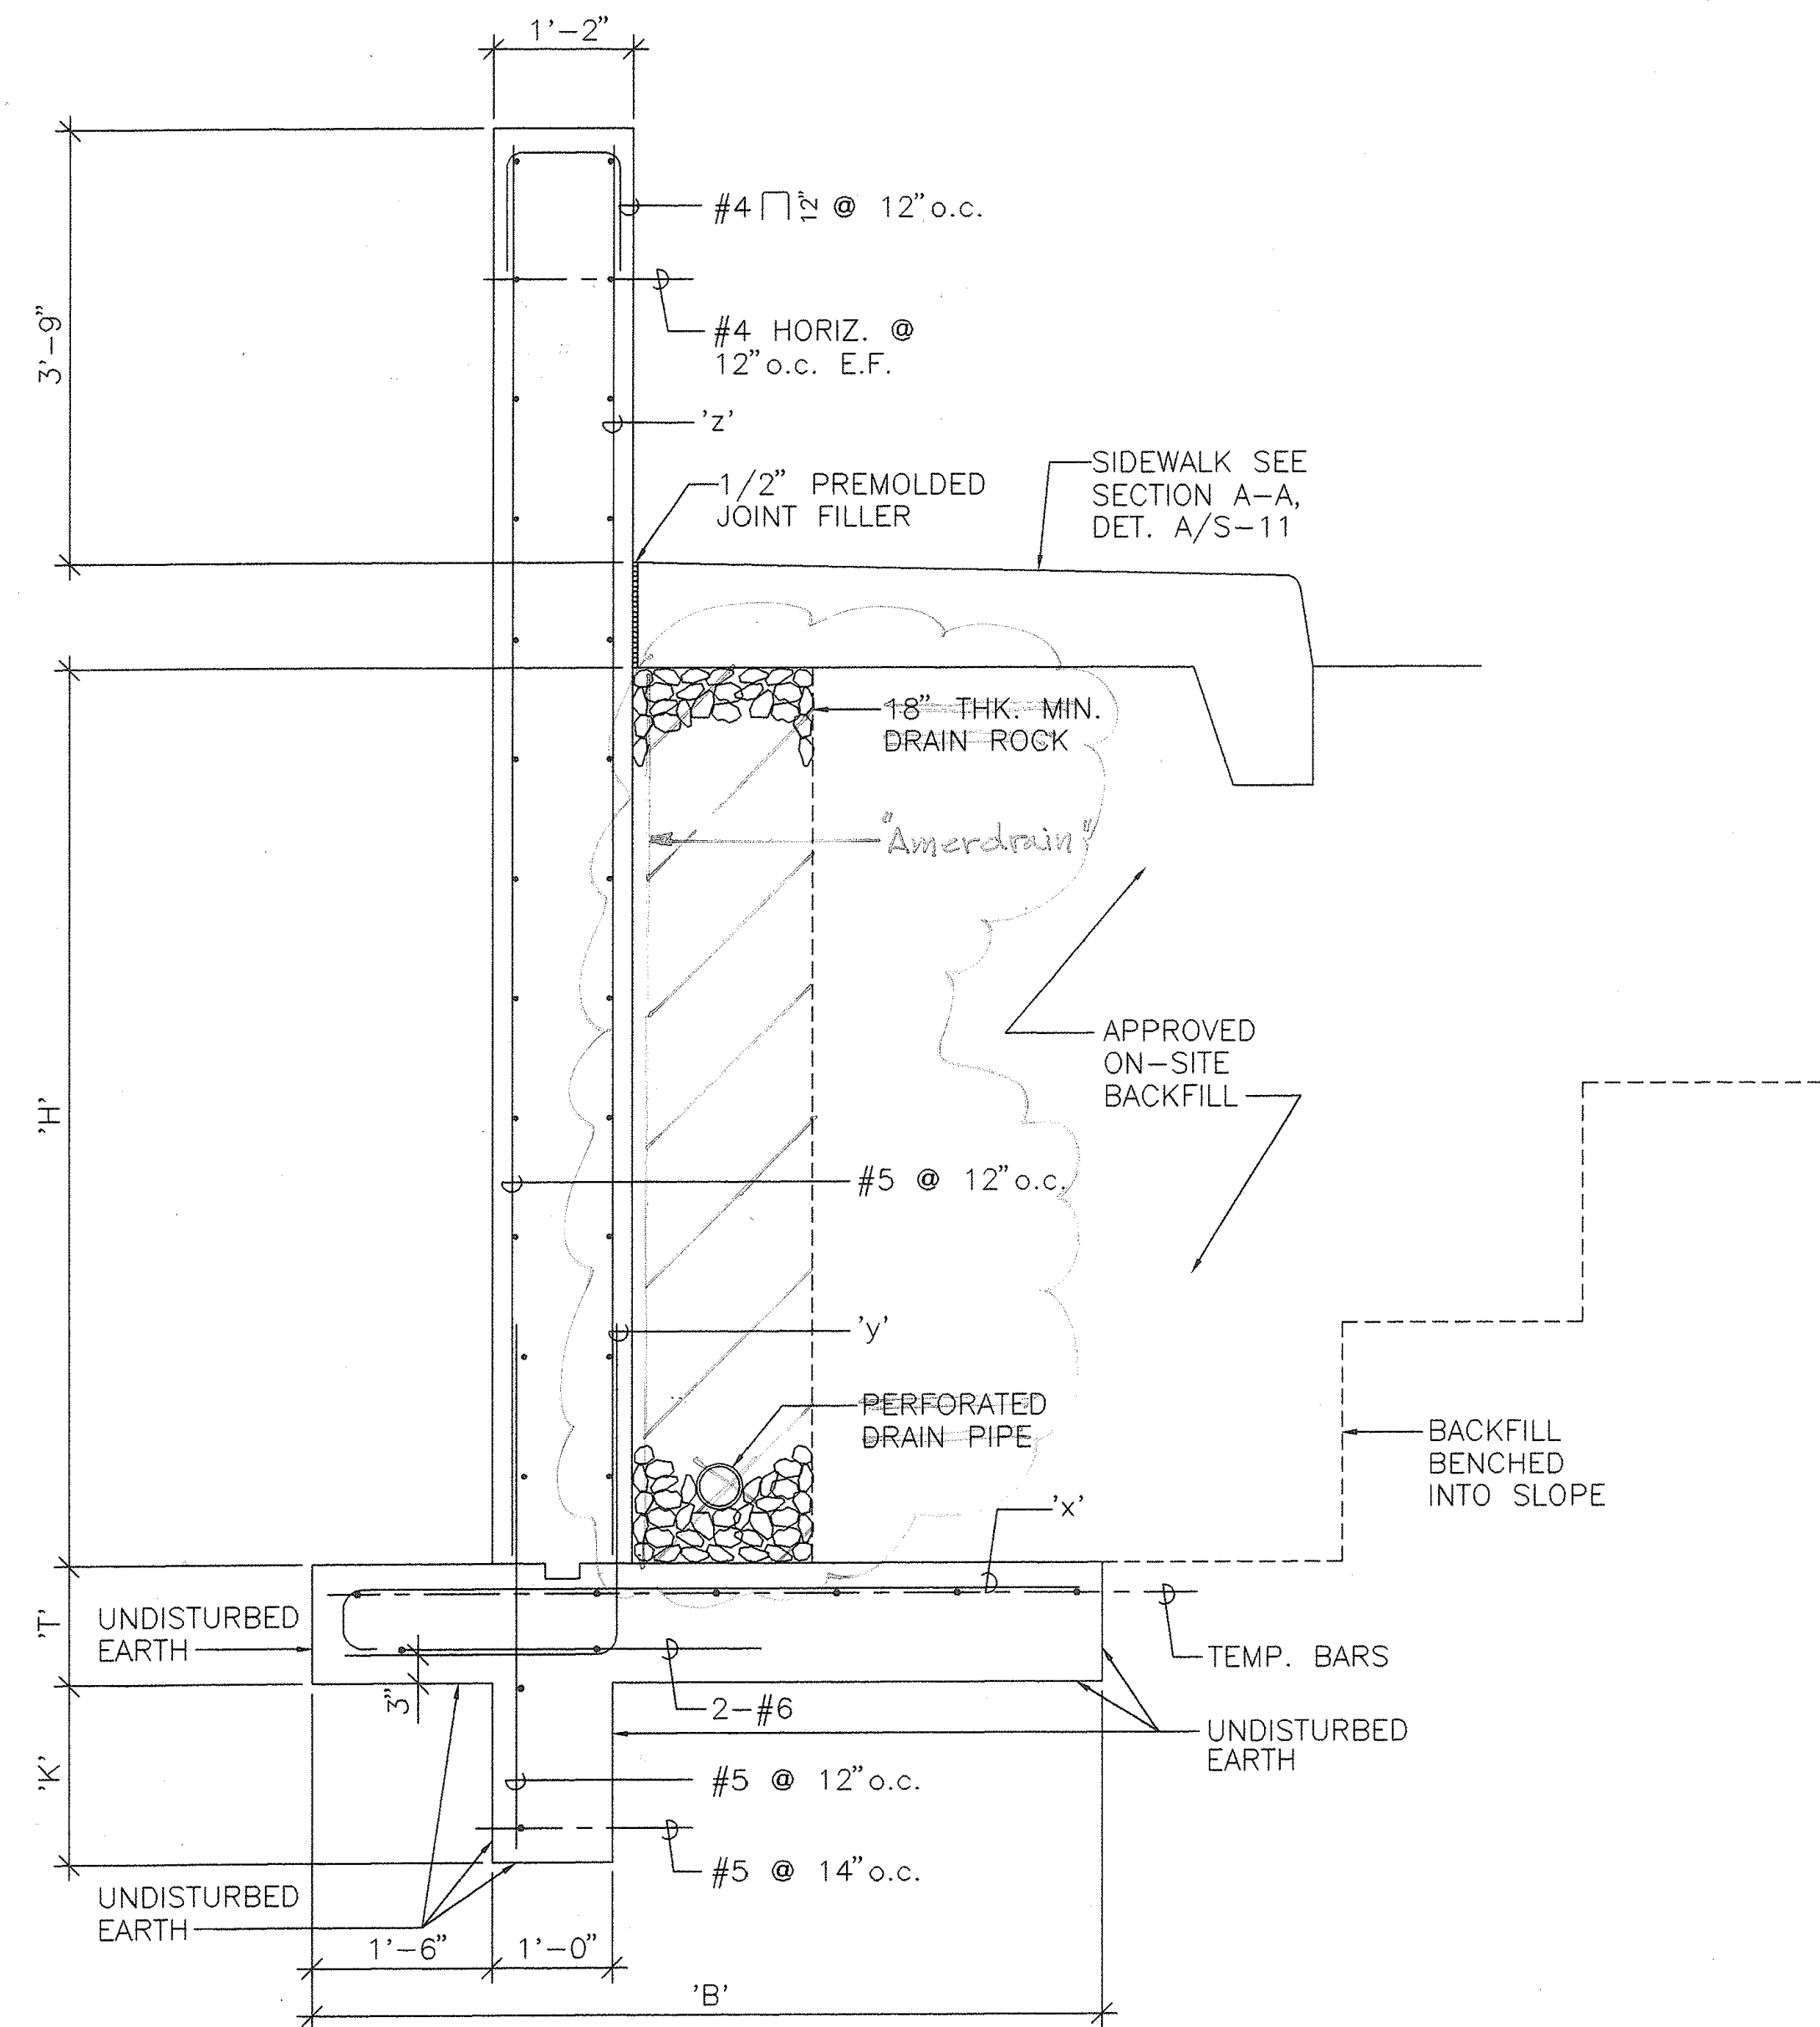


NOTE: 'y' & KEY REINF. SHALL EXTEND 48 BAR DIAMETERS MIN. INTO THE STEM

NEW WING WALLS #1A & 4A SCHEDULE							
'H'	'B'	'T'	'K'	'x'	'y'	'z'	TEMP. BARS
≤9'-0"	7'-6"	1'-2"	1'-6"	#7 @ 5" o.c.	#6 @ 5" o.c.	#6 @ 10" o.c.	#5 @ 12" o.c.
≤7'-0"	6'-6"	1'-2"	1'-0"	#6 @ 8" o.c.	#6 @ 8" o.c.	#5 @ 8" o.c.	#5 @ 12" o.c.
≤5'-0"	6'-0"	1'-2"	1'-0"	#6 @ 12" o.c.	#6 @ 12" o.c.	#5 @ 12" o.c.	#5 @ 12" o.c.


SECTION THRU NEW WING WALLS #1A & #4A
SC: 3/4" = 1'-0"

A
S-12

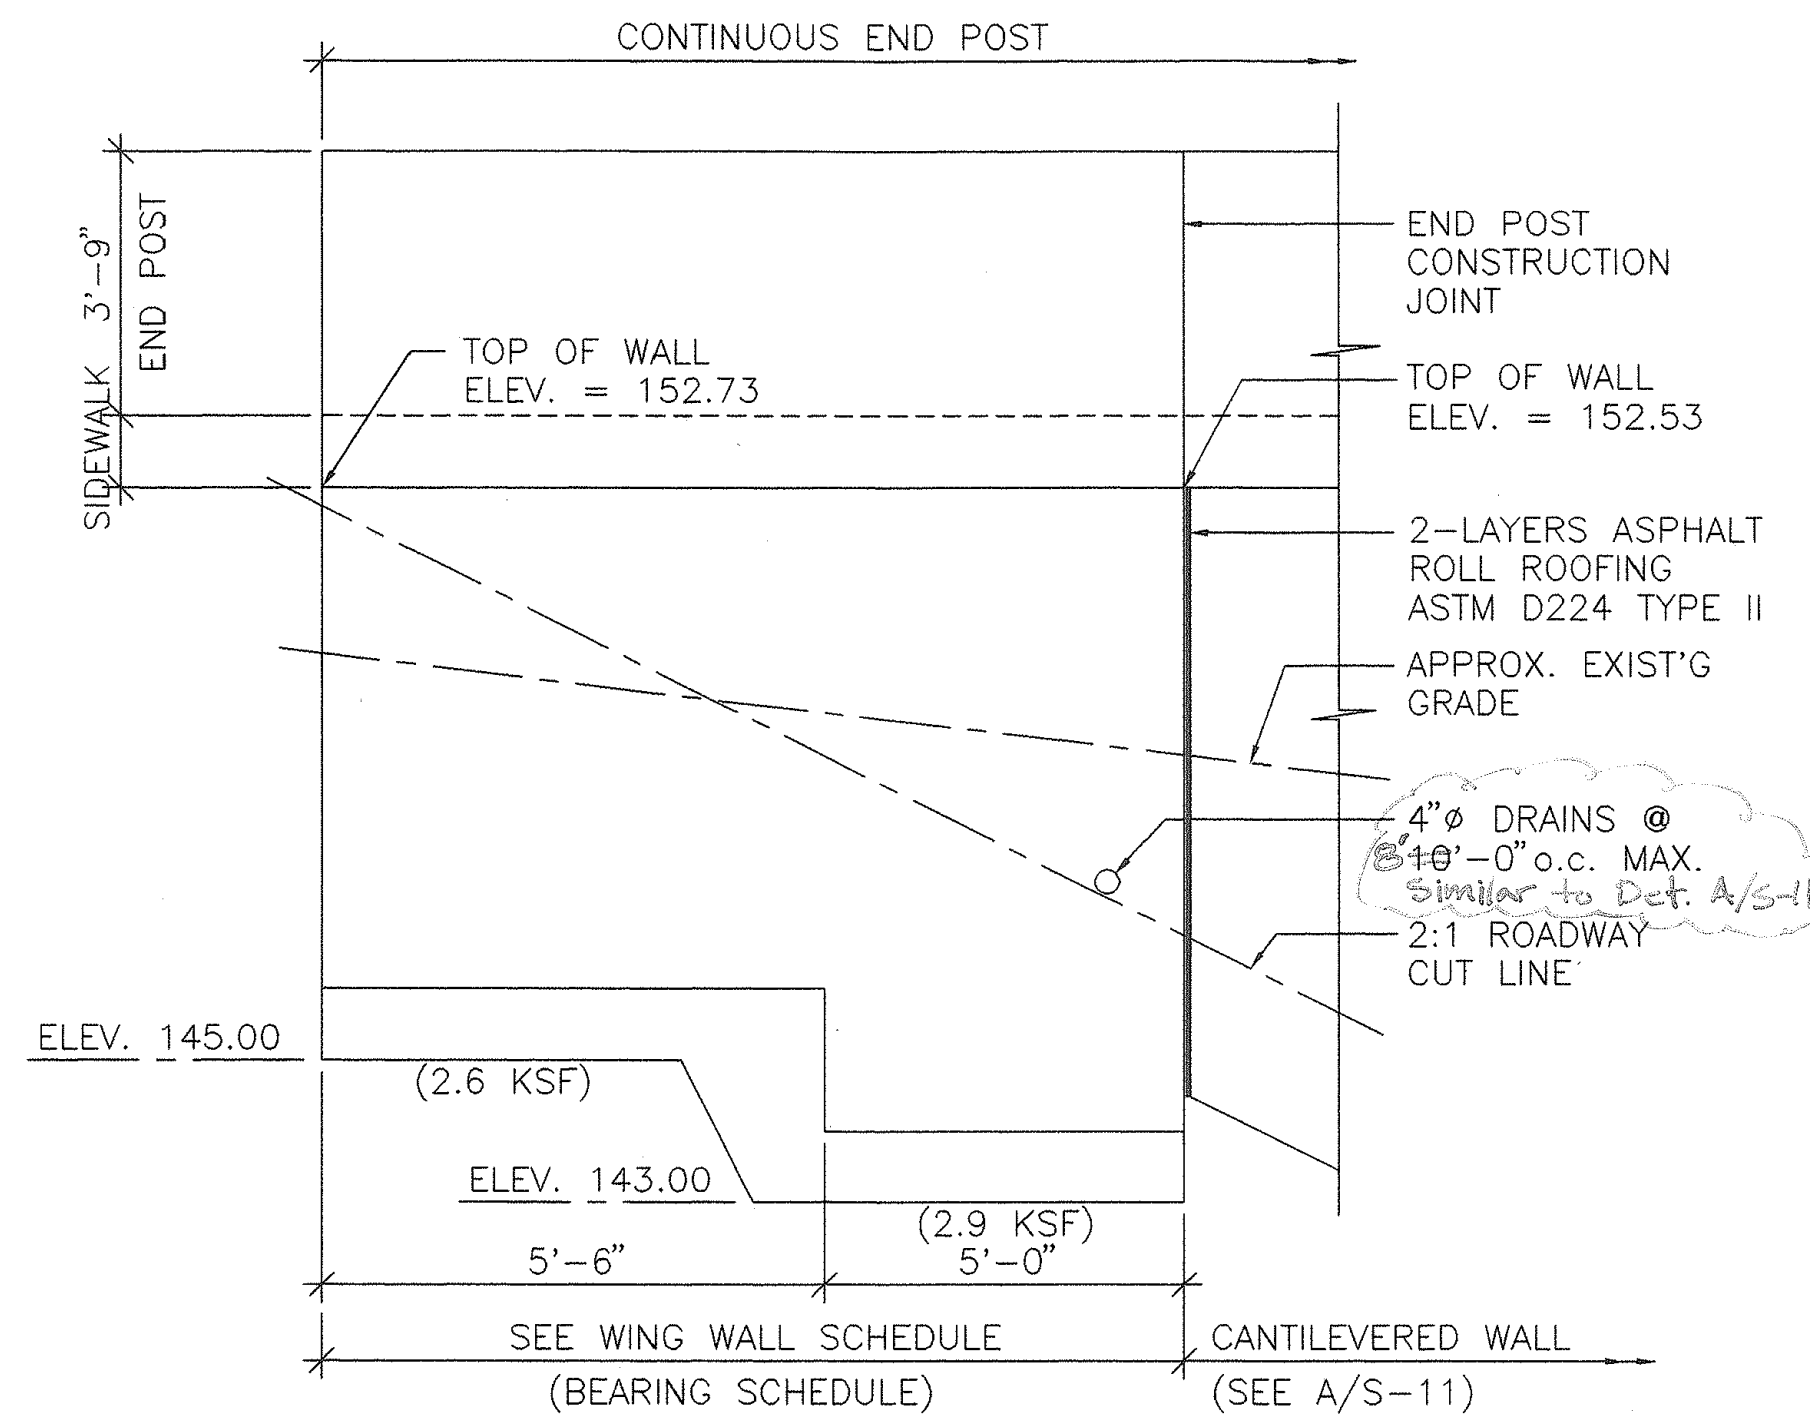


PARTIAL ELEVATION WING WALL #1A
SC: 3/8" = 1'-0"

B
S-12

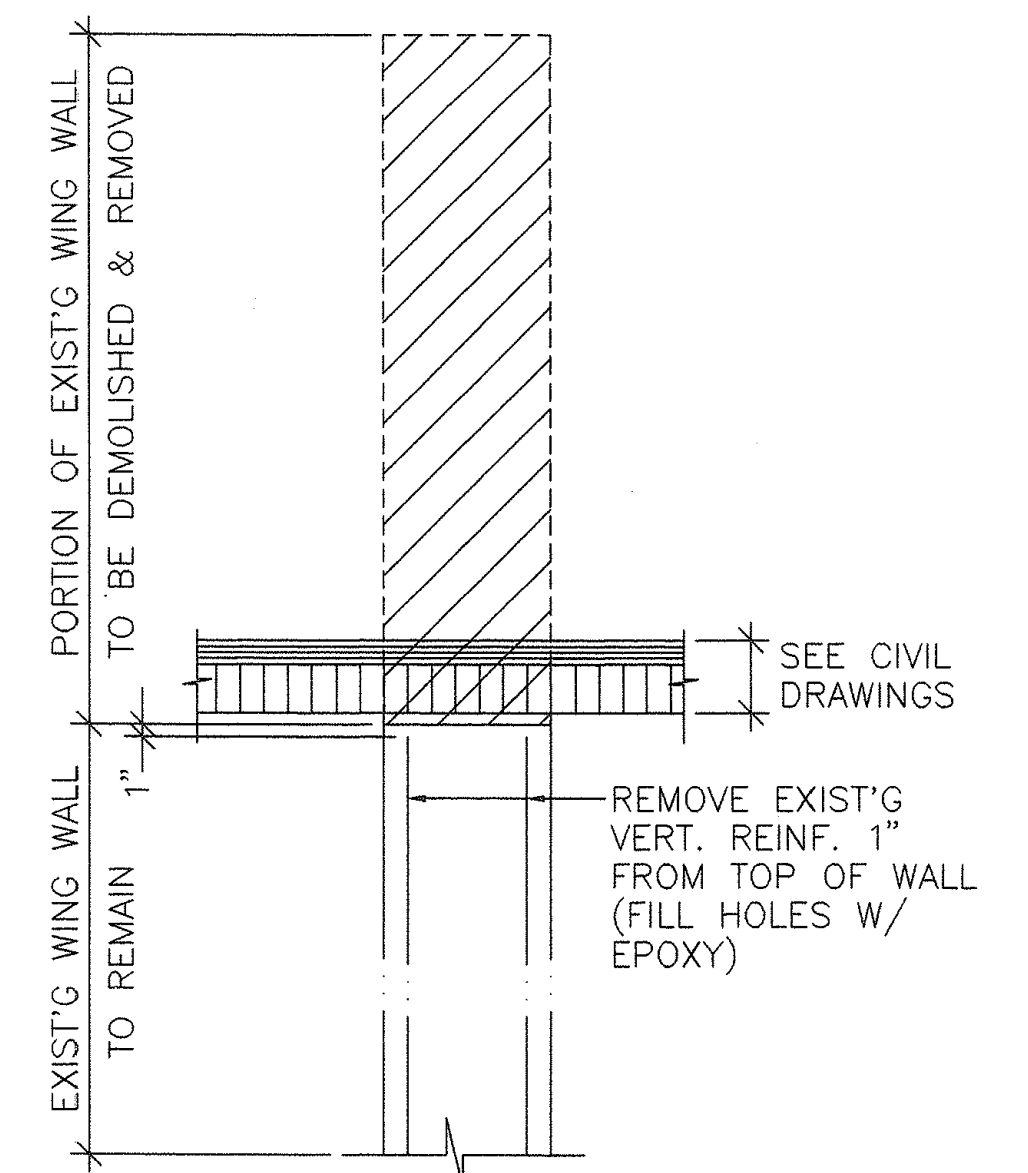


TYPICAL EXISTING WING WALL REMOVAL DETAIL
SC: 3/4" = 1'-0"

D
S-12

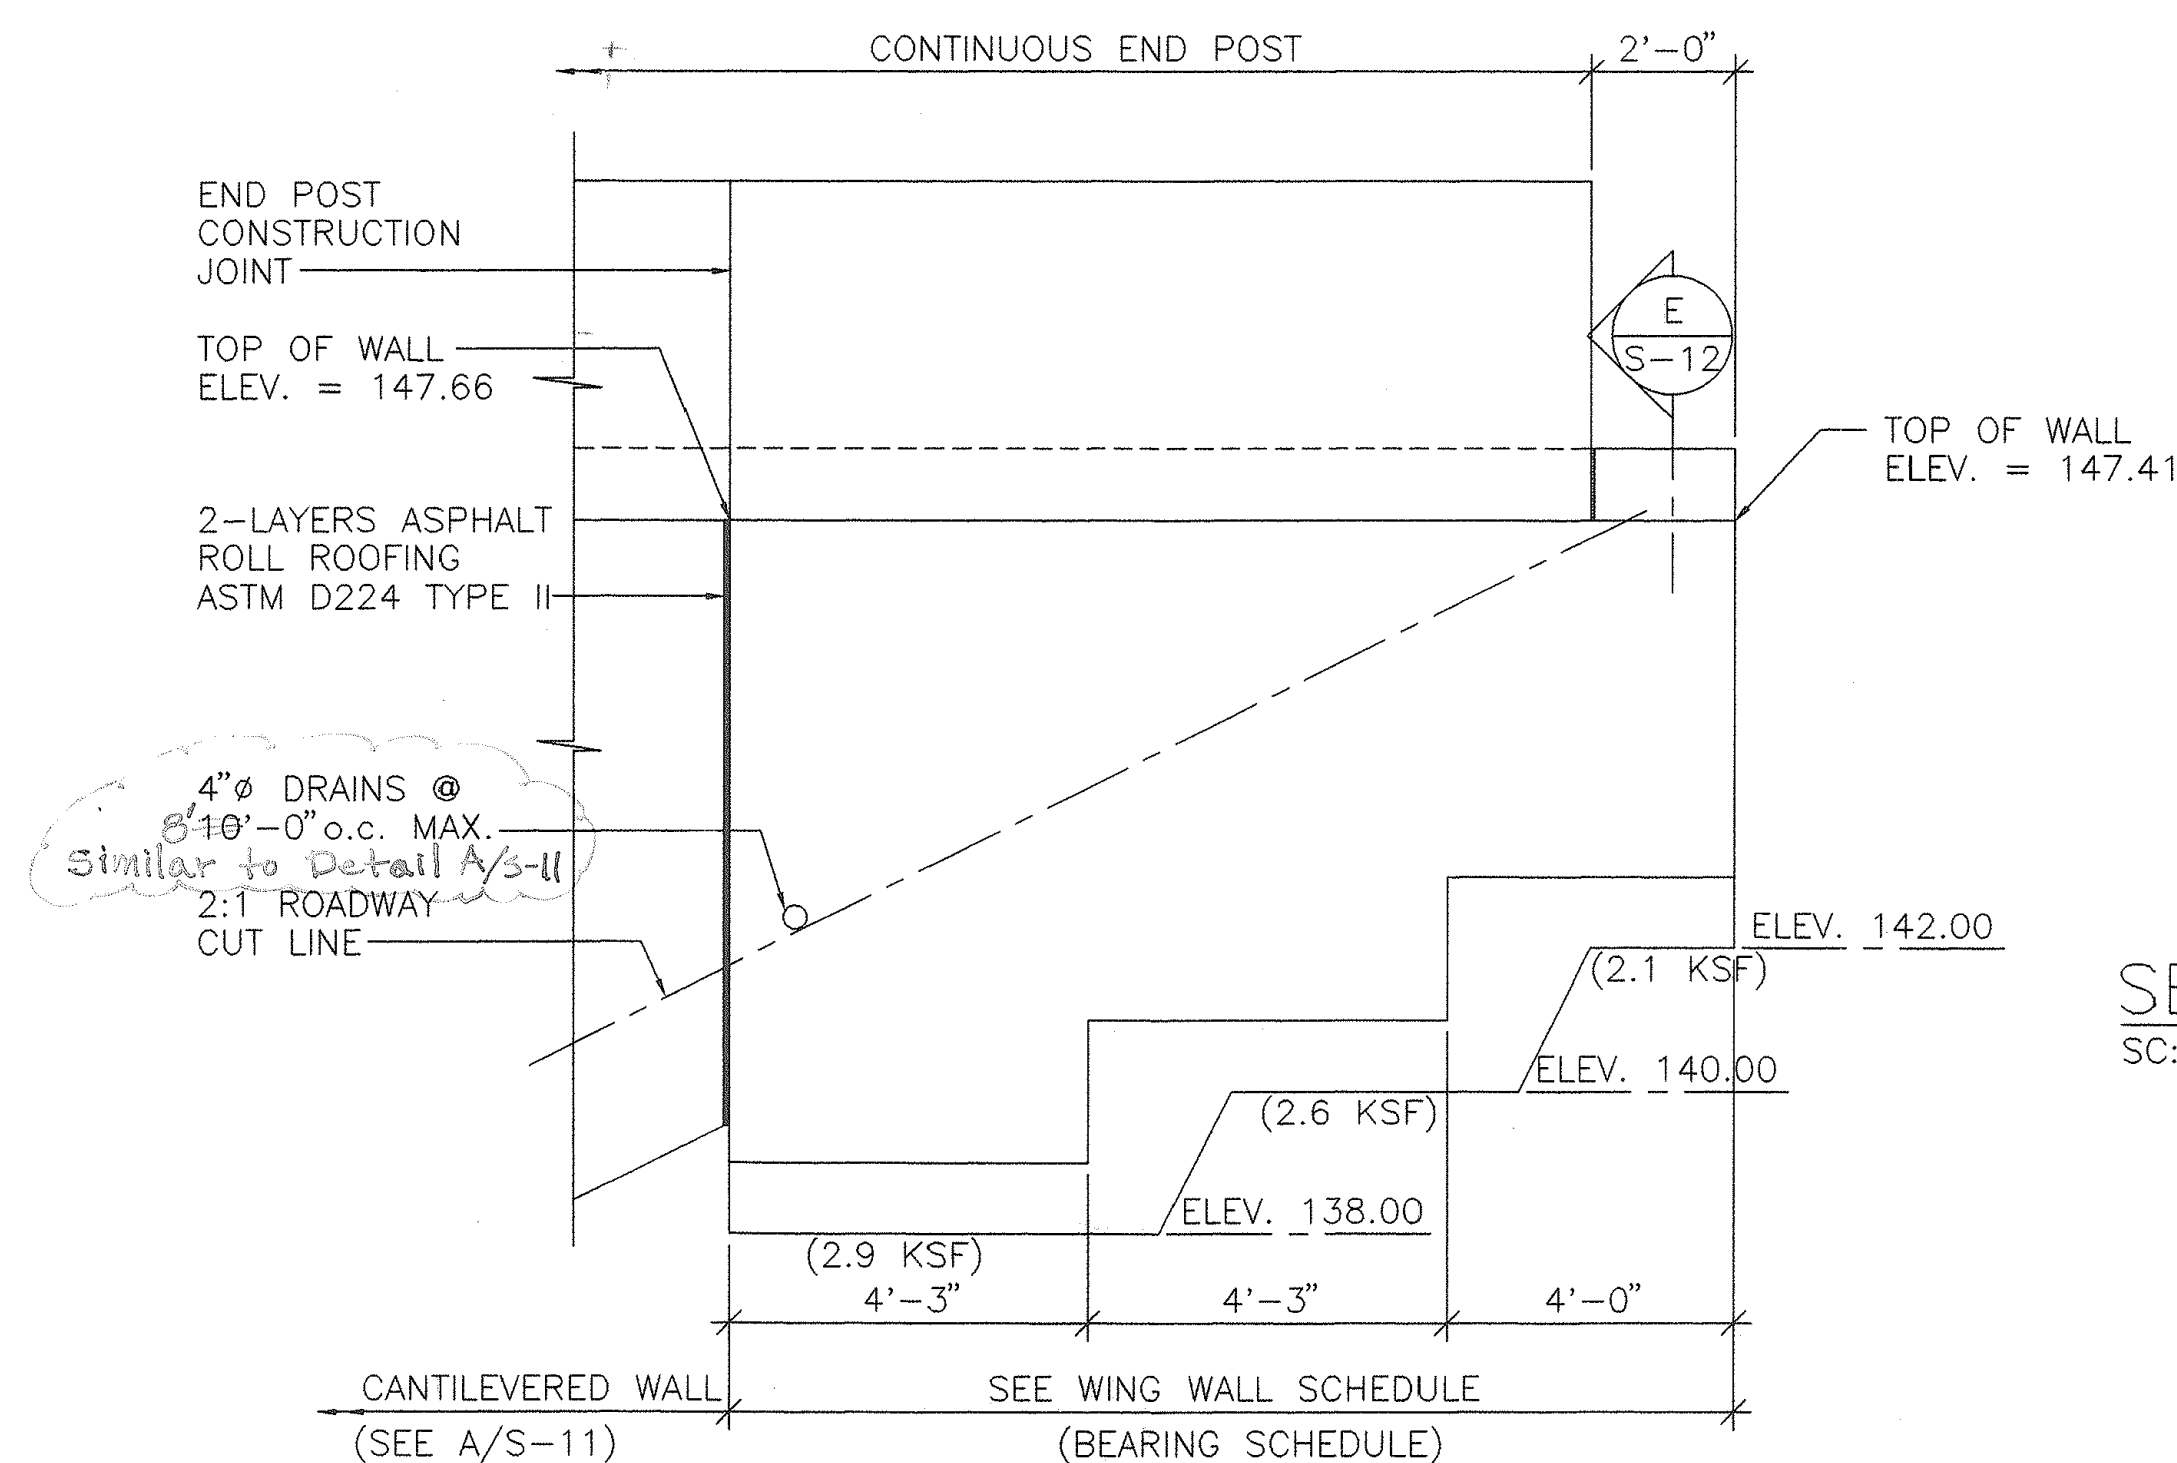


PARTIAL ELEVATION WING WALL #4A
SC: 3/8" = 1'-0"

C
S-12

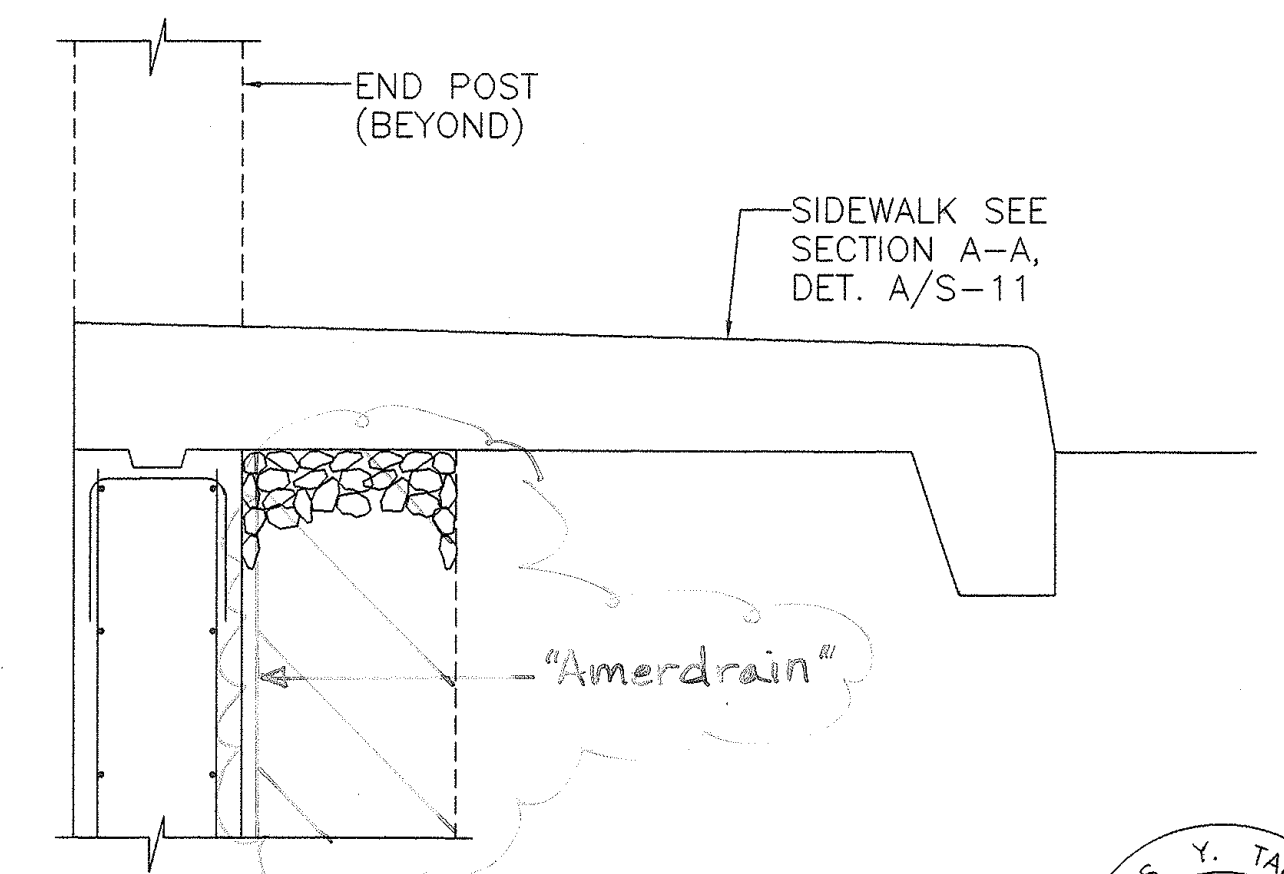

SECTION E
SC: 3/4" = 1'-0"

E
S-12

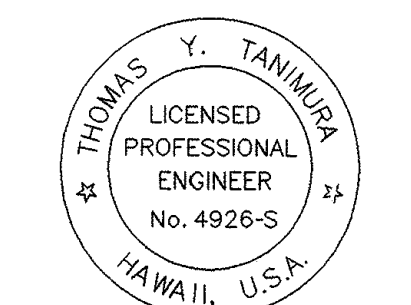

THIS WORK WAS PREPARED BY ME OR UNDER MY SUPERVISION.
Signature

STATE OF HAWAII
DEPARTMENT OF TRANSPORTATION
HIGHWAYS DIVISION

WING WALL SECTION,
ELEVATIONS & DETAIL

MANAGER'S DRIVE BRIDGE WIDENING
INTERSTATE ROUTE H-1


SHEET NO. S-12 OF 16 SHEETS

5/4/99 Revise Weephole Spacing,
Change to "Amerdrain"

DATE REVISION


SURVEY PLOTTED BY
DESIGNED BY
NOTED BY
CHECKED BY
DATE

FED. ROAD DIST. NO.	STATE	FED. AID PROJ. NO.	FISCAL YEAR	SHEET NO.	TOTAL SHEETS
HAWAII	HAW.	PMT-HIC-01-97			

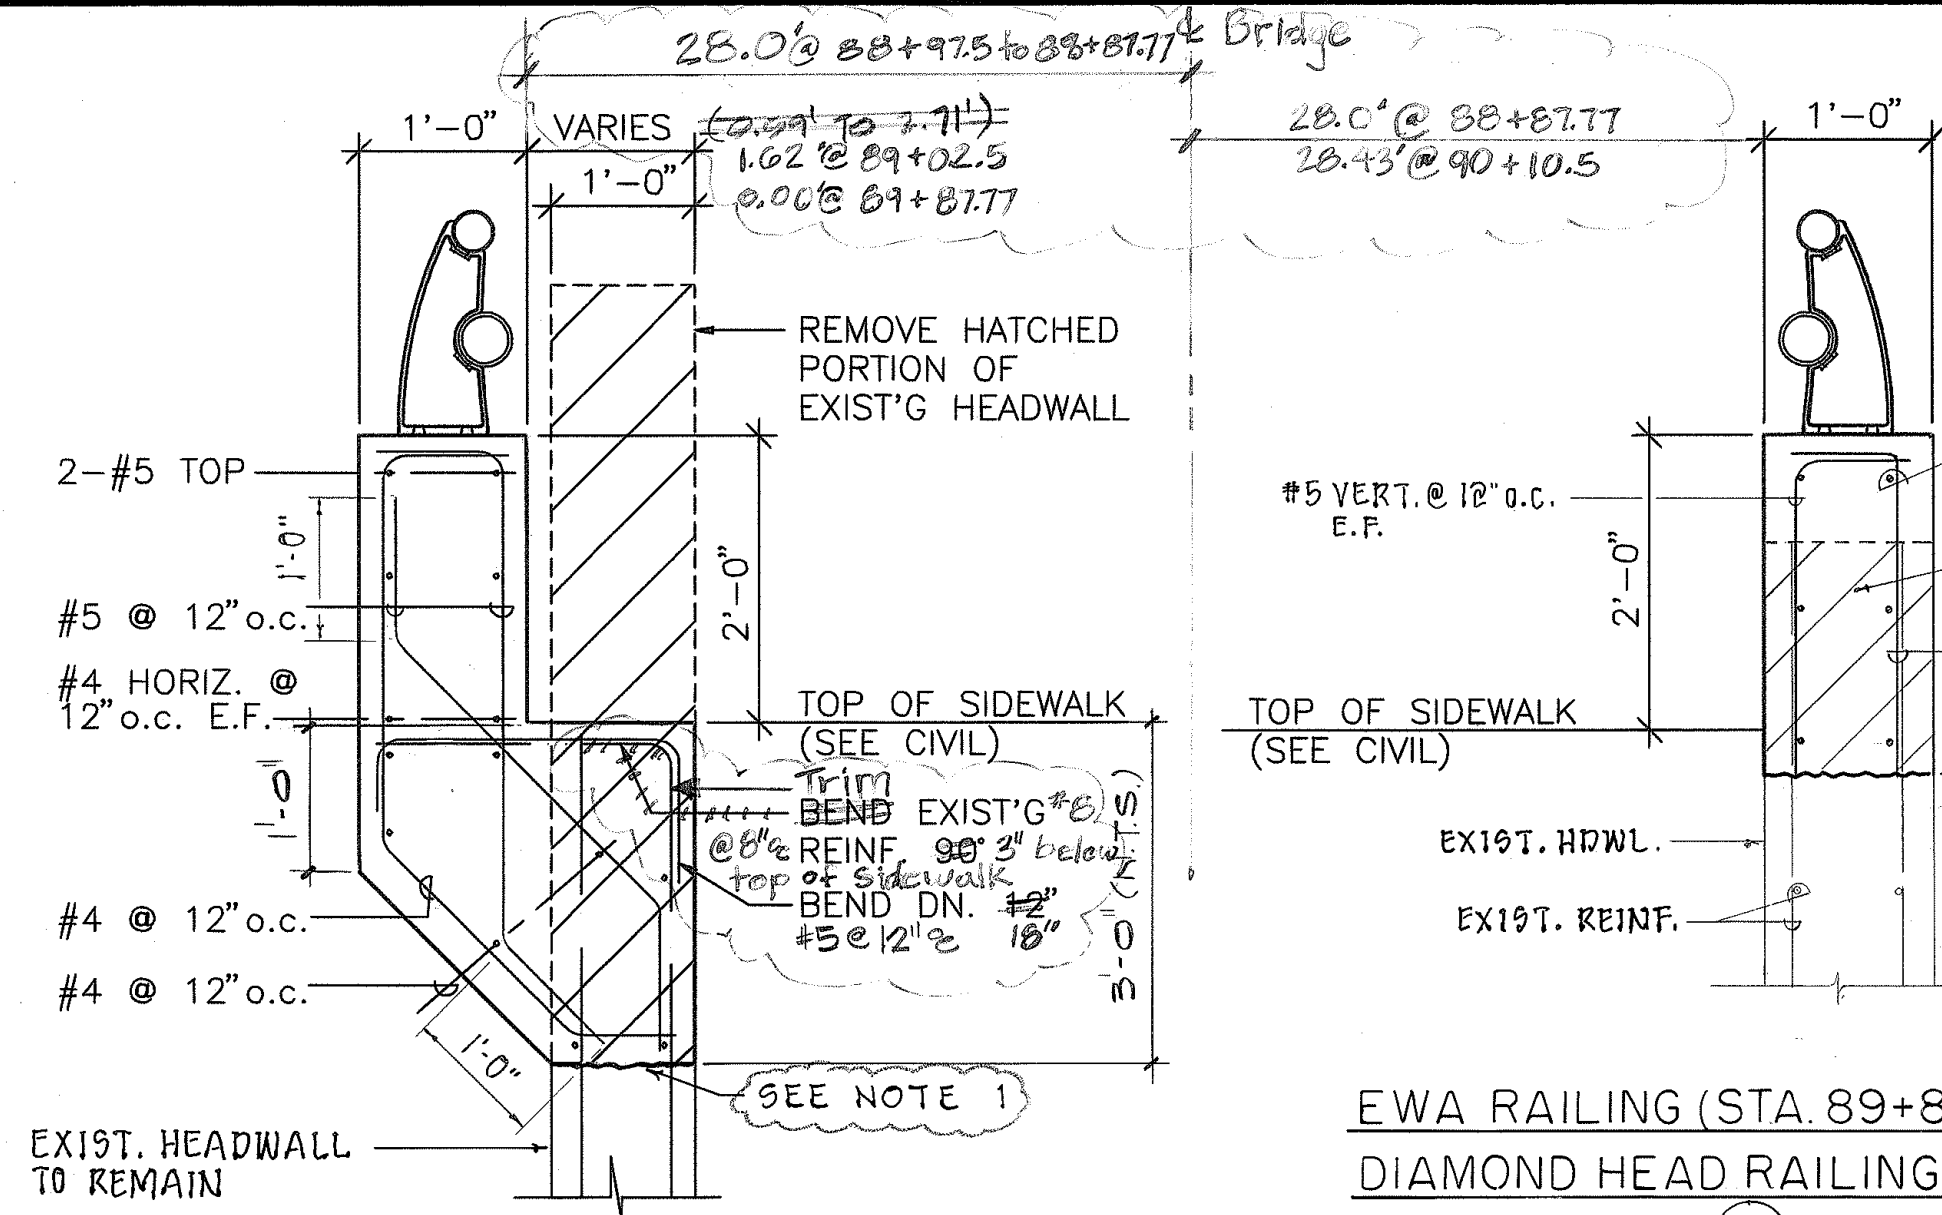


EWA RAILING (STA. 89+02.5 TO 89+88±)

TYPICAL RAILING DETAIL AT BOX CULVERT
SC: 3/4" = 1'-0"

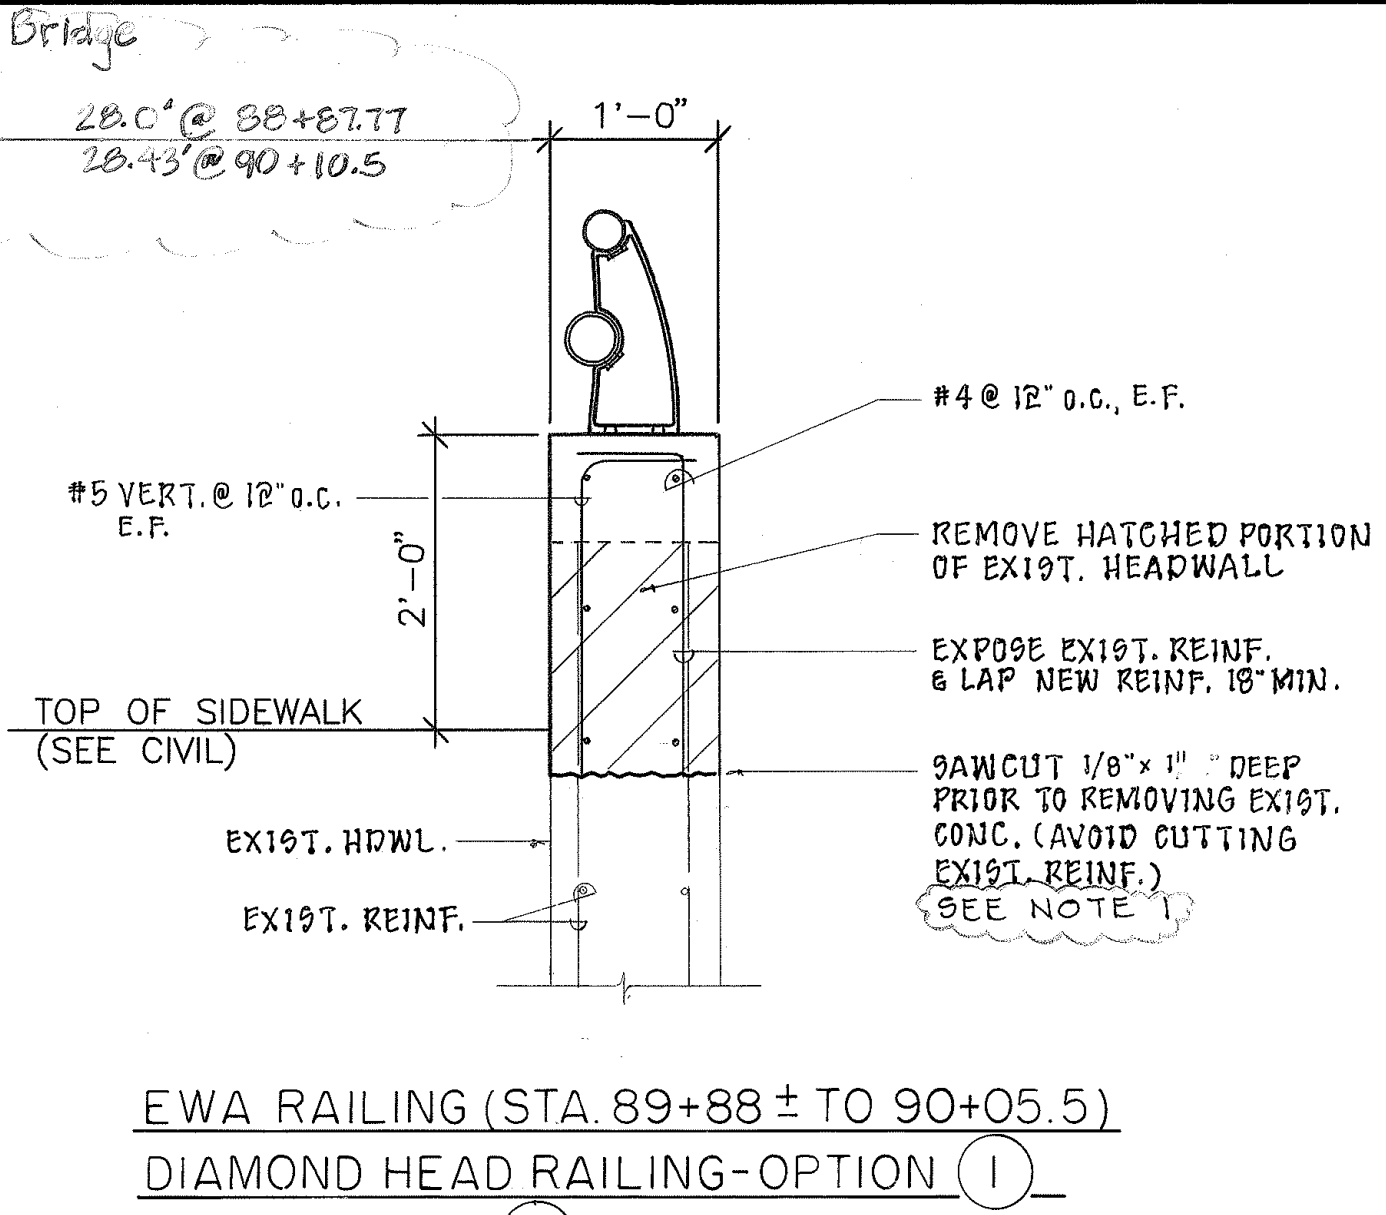


EWA RAILING (STA. 89+88± TO 90+05.5)
DIAMOND HEAD RAILING-OPTION ①
(FOR OPTION ② DET., SEE THIS SHT.)

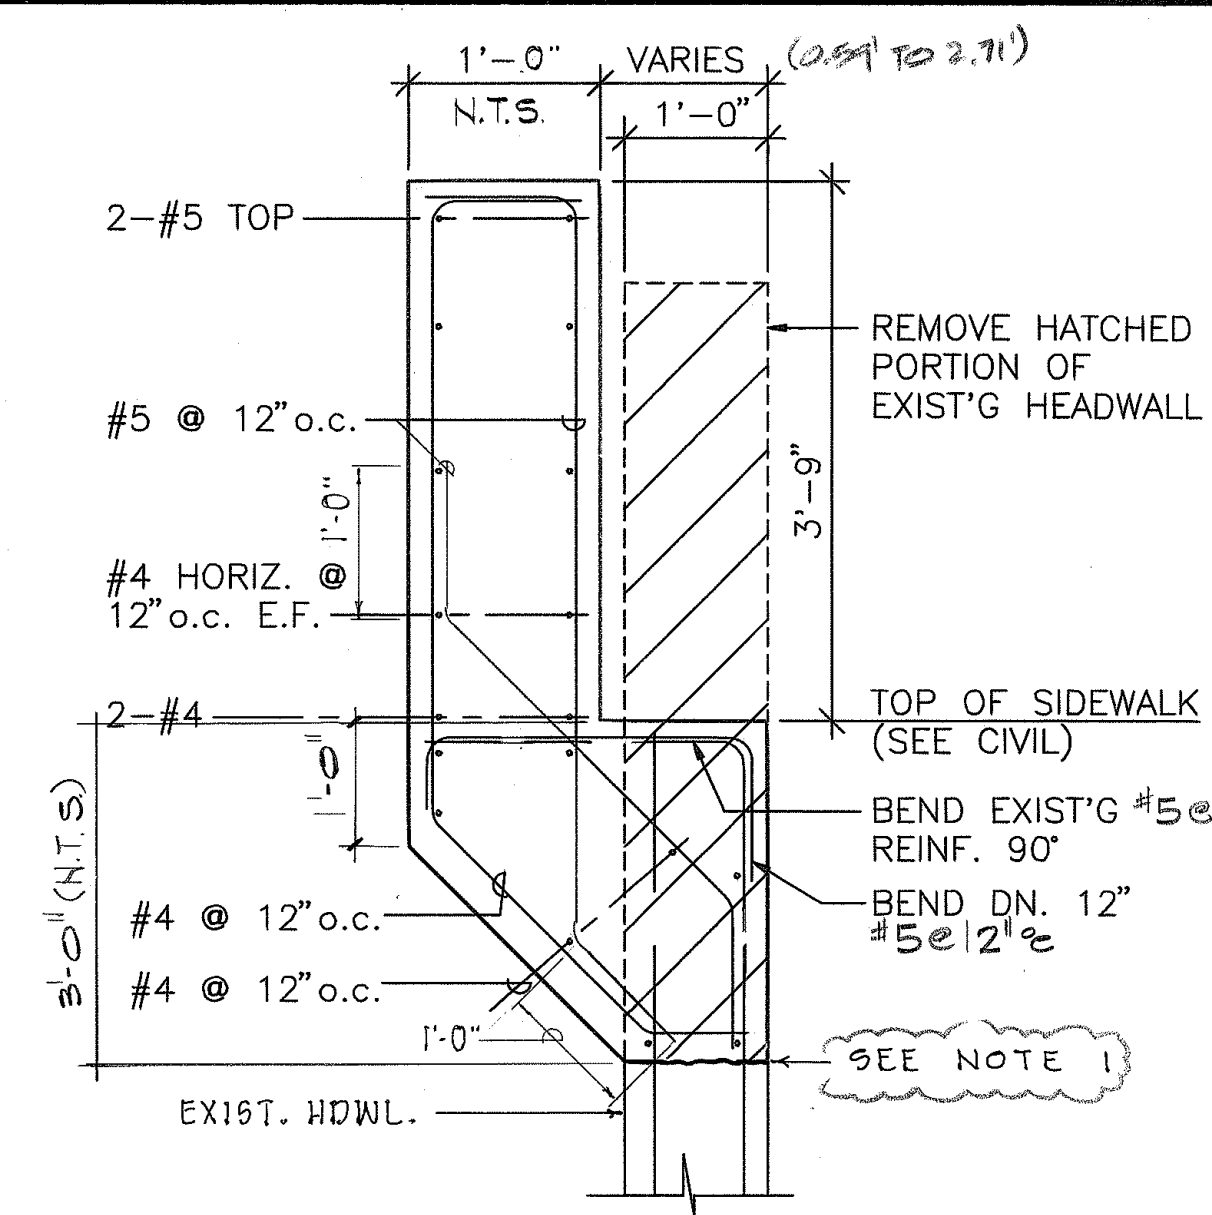


EWA END POST (STA. 88+97.5 TO 89+02.5)

TYPICAL END POST DETAIL AT BOX CULVERT
SC: 3/4" = 1'-0"

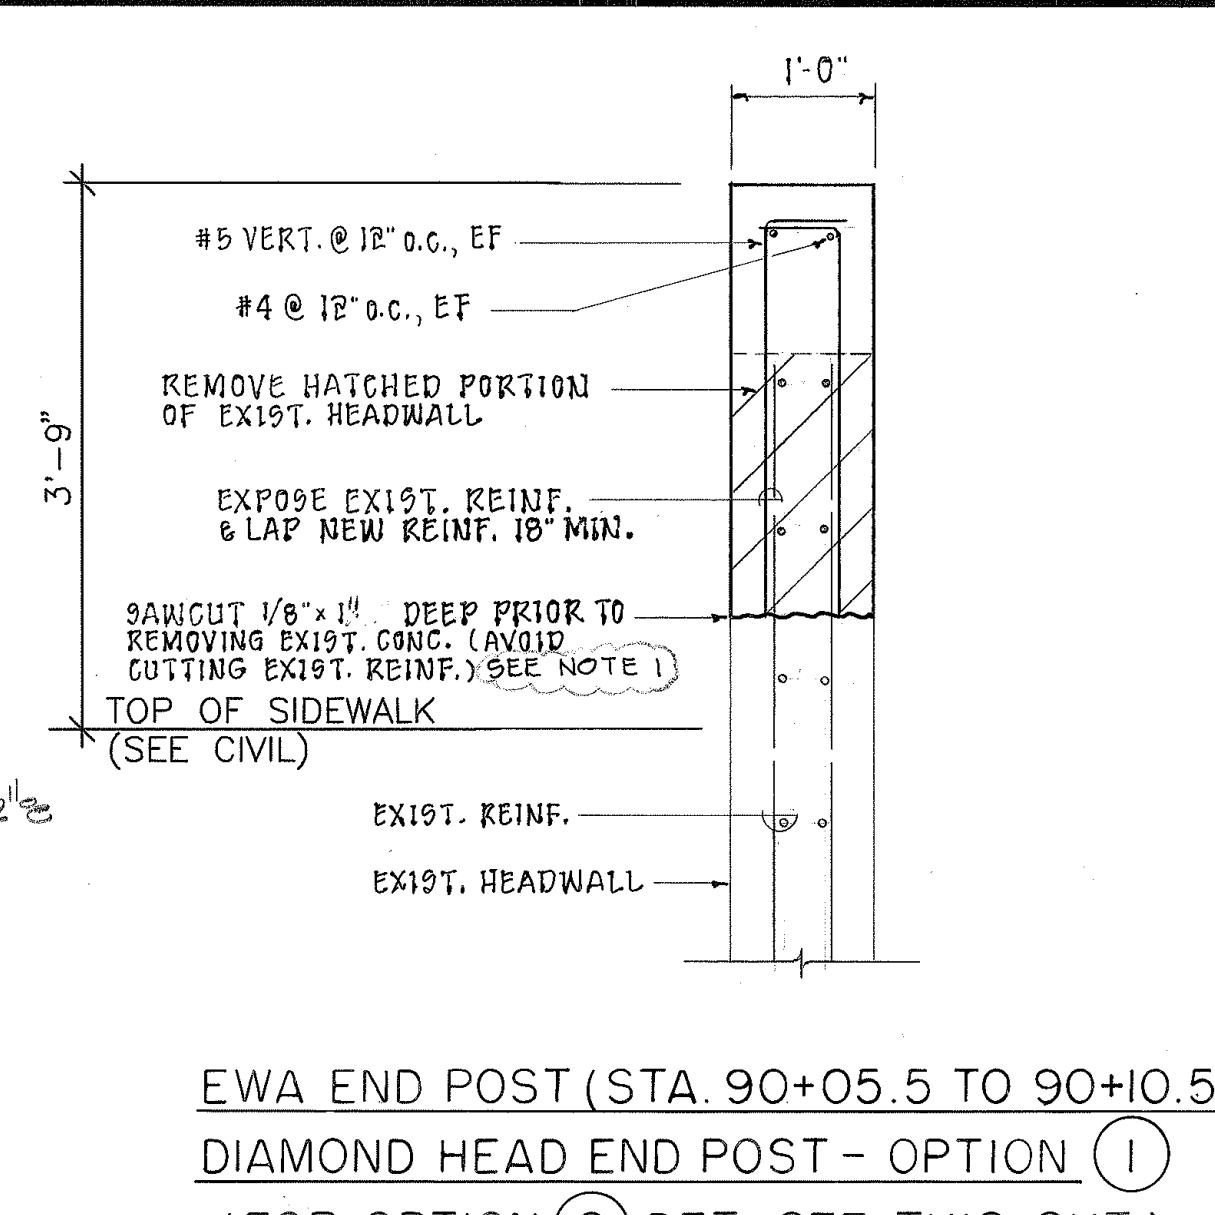


EWA END POST (STA. 90+05.5 TO 90+10.5)
DIAMOND HEAD END POST - OPTION ①
(FOR OPTION ② DET., SEE THIS SHT.)

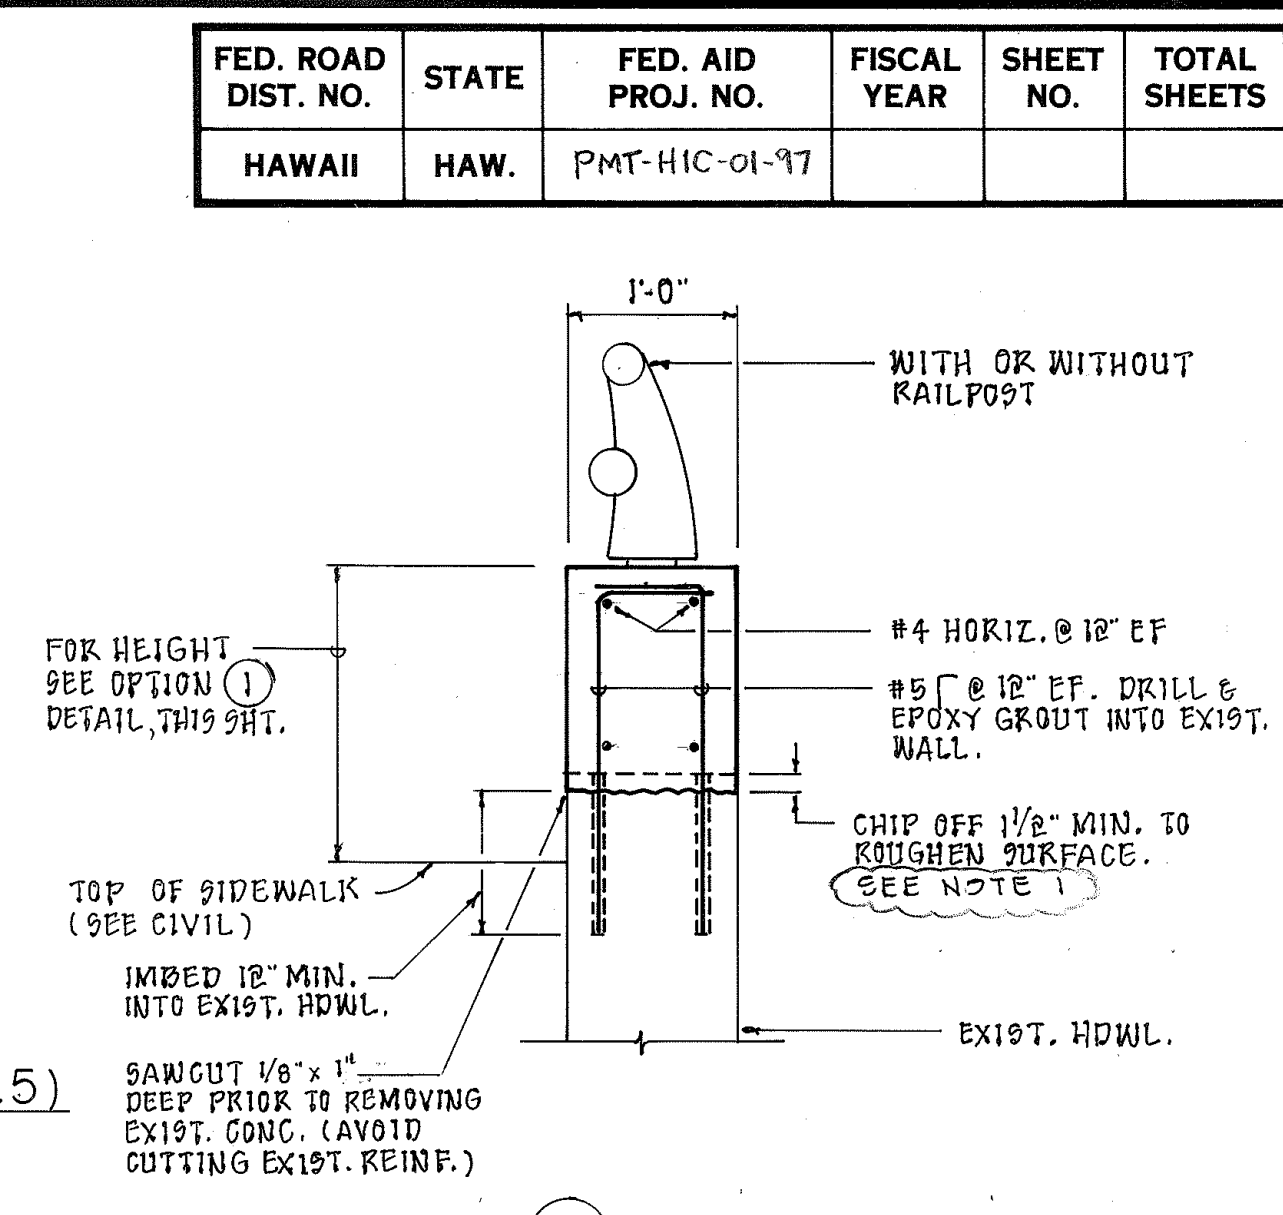


OPTION ② DETAIL
FOR DIAMOND HEAD RAILING & END POST
FOR EWA RAILING & END POST


NOTE:
1. APPLY AN APPROVED EPOXY BONDING AGENT JUST PRIOR TO POURING NEW CONC. (TYPICAL FOR ALL JOINTS)

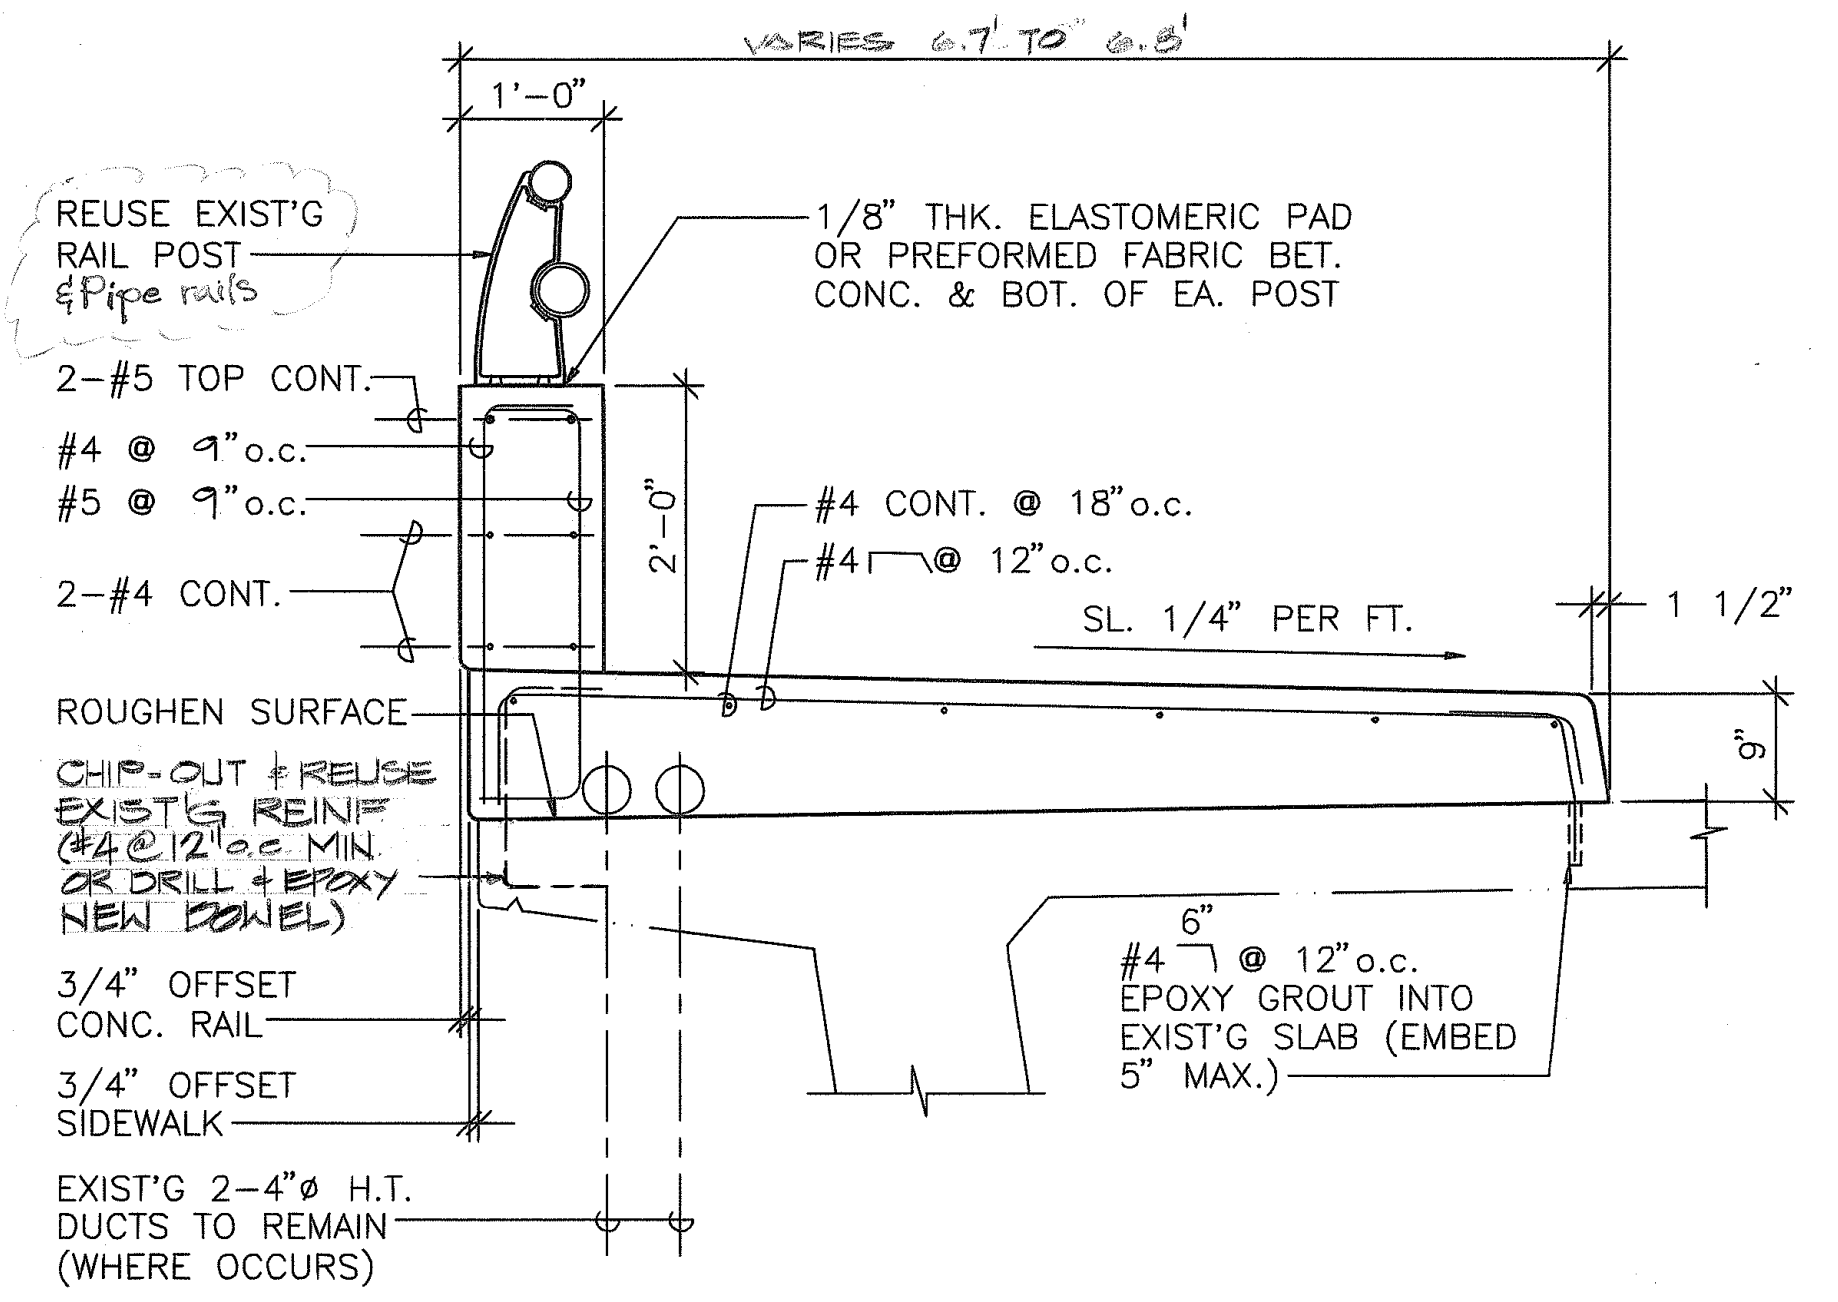

TYP. RAIL POST DETAIL AT EXISTING BRIDGE
SC: 3/4" = 1'-0"

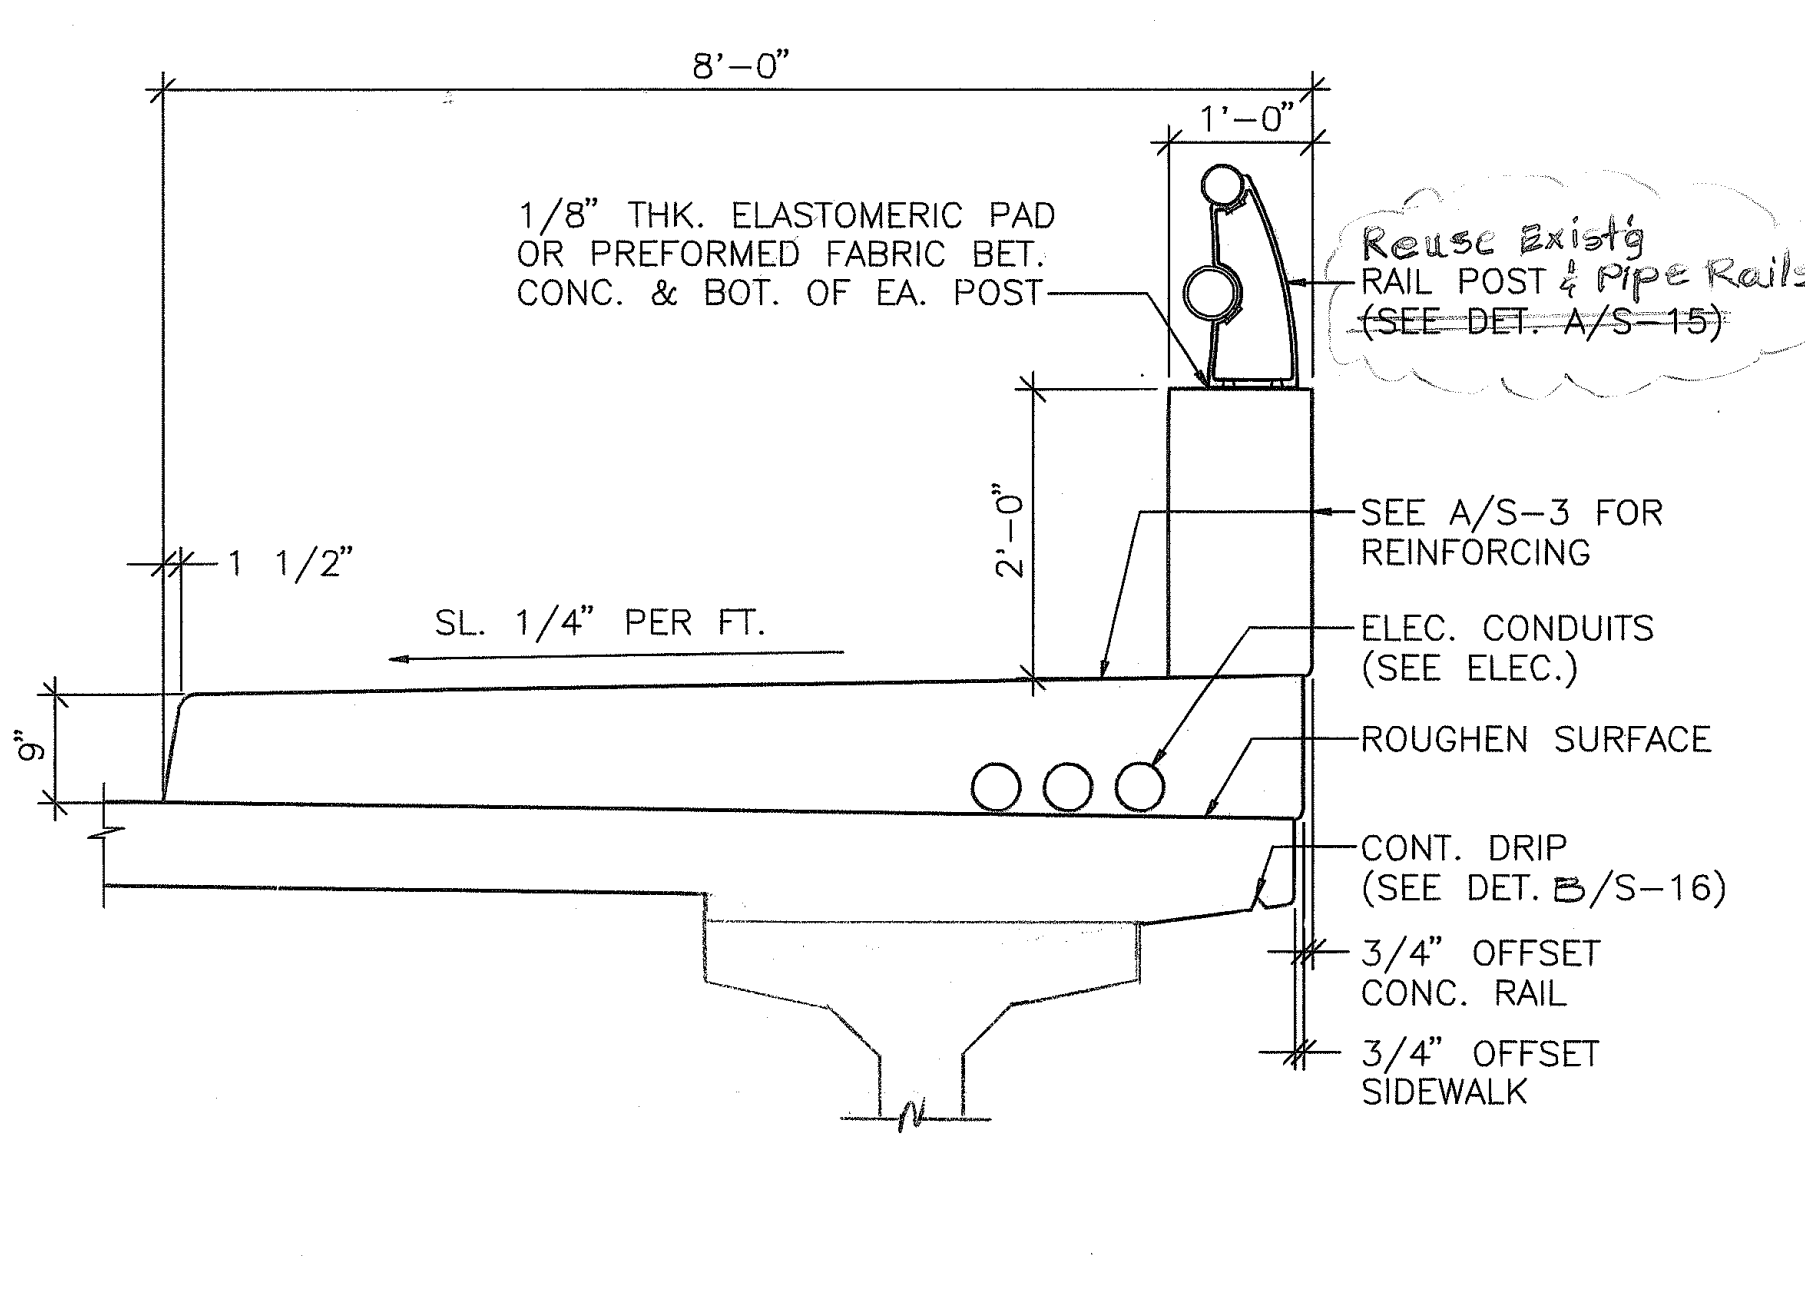


TYP. RAIL POST DETAIL AT NEW BRIDGE
SC: 3/4" = 1'-0"

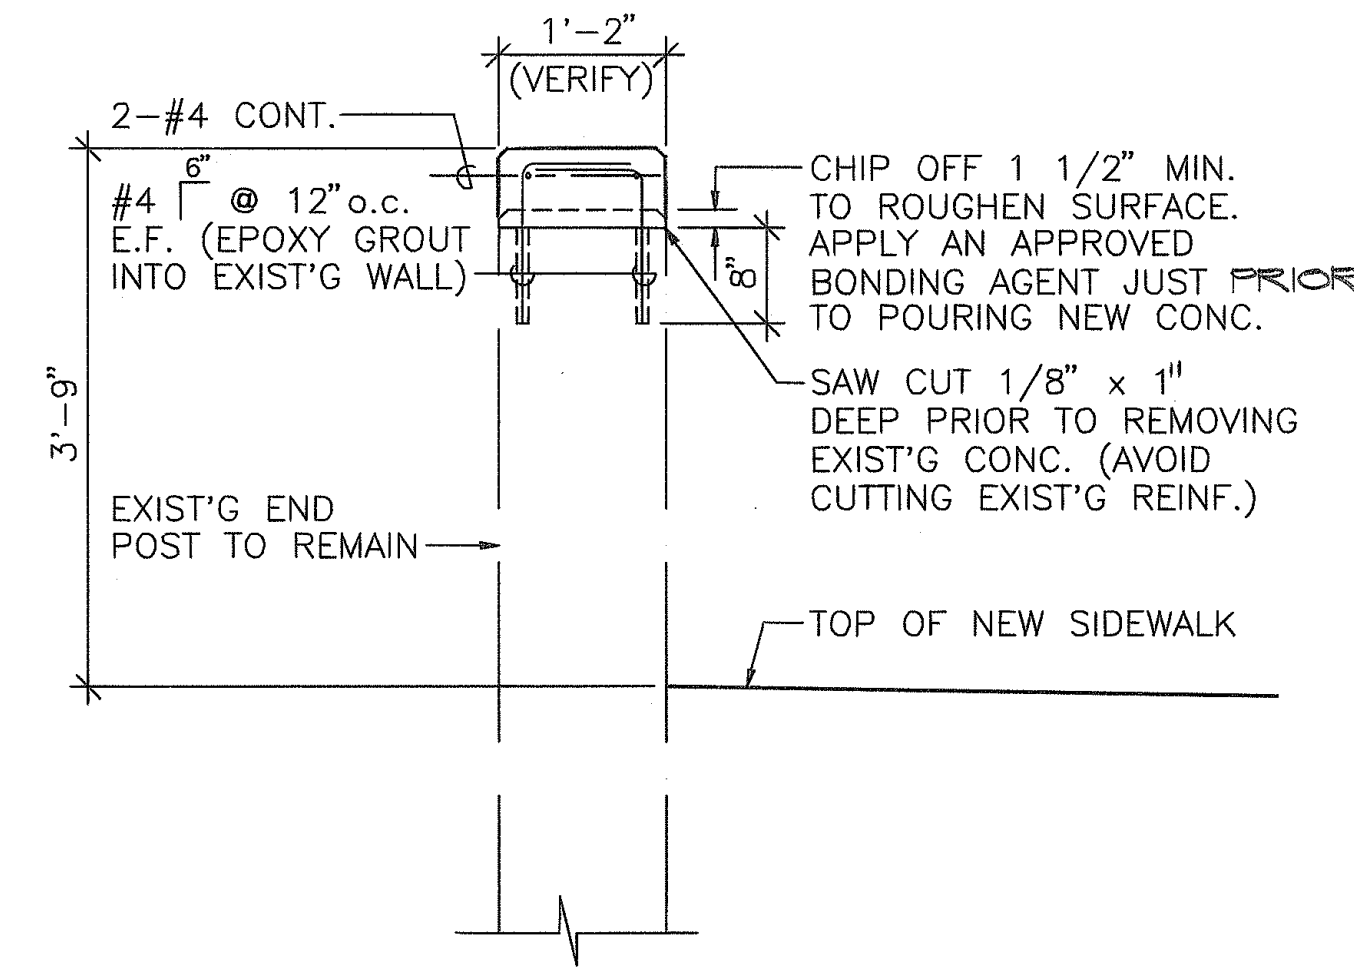


TYP. EXISTING END POST DET.
SC: 3/4" = 1'-0"

APPROVED: *[Signature]* DATE: 5/4/99
CHIEF, DIVISION OF ENGINEERING, DPW
(FOR CONSTRUCTION WITHIN CITY R/W ONLY)

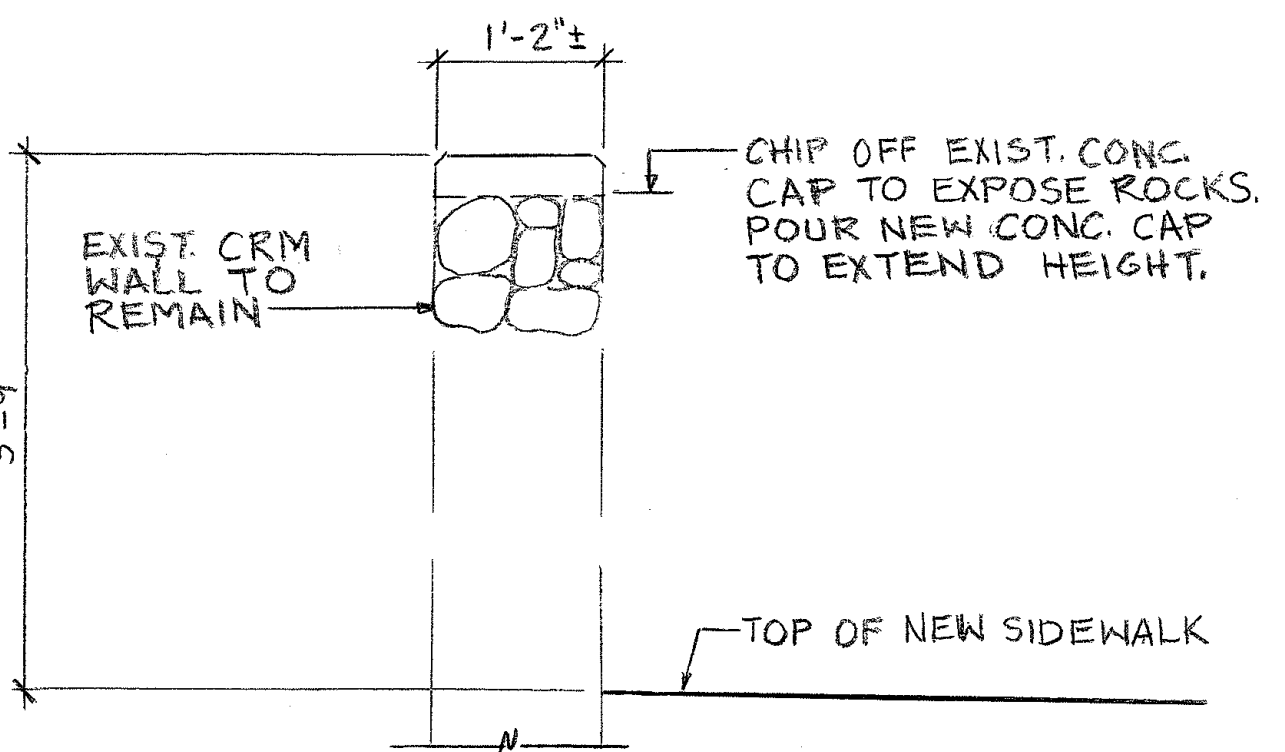




EXIST. CRM WALL DET.
SC: 3/4" = 1'-0"

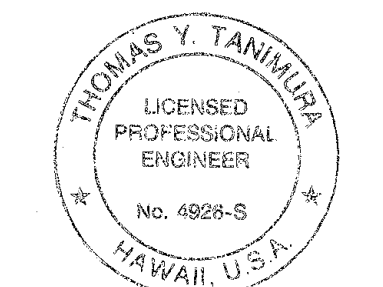

THIS WORK WAS PREPARED BY ME OR UNDER MY SUPERVISION.
[Signature]
Signature

5/4/99	Revise Dimensions & Notes
DATE	REVISION
STATE OF HAWAII DEPARTMENT OF TRANSPORTATION HIGHWAYS DIVISION	
TYPICAL RAILING & END POST DETAILS	
MANAGER'S DRIVE BRIDGE WIDENING INTERSTATE ROUTE H-1	
SHEET NO. 13 OF 16 SHEETS	

FED. ROAD DIST. NO.	STATE	FED. AID PROJ. NO.	FISCAL YEAR	SHEET NO.	TOTAL SHEETS
HAWAII	HAW.	PMT-HIC-01-97			

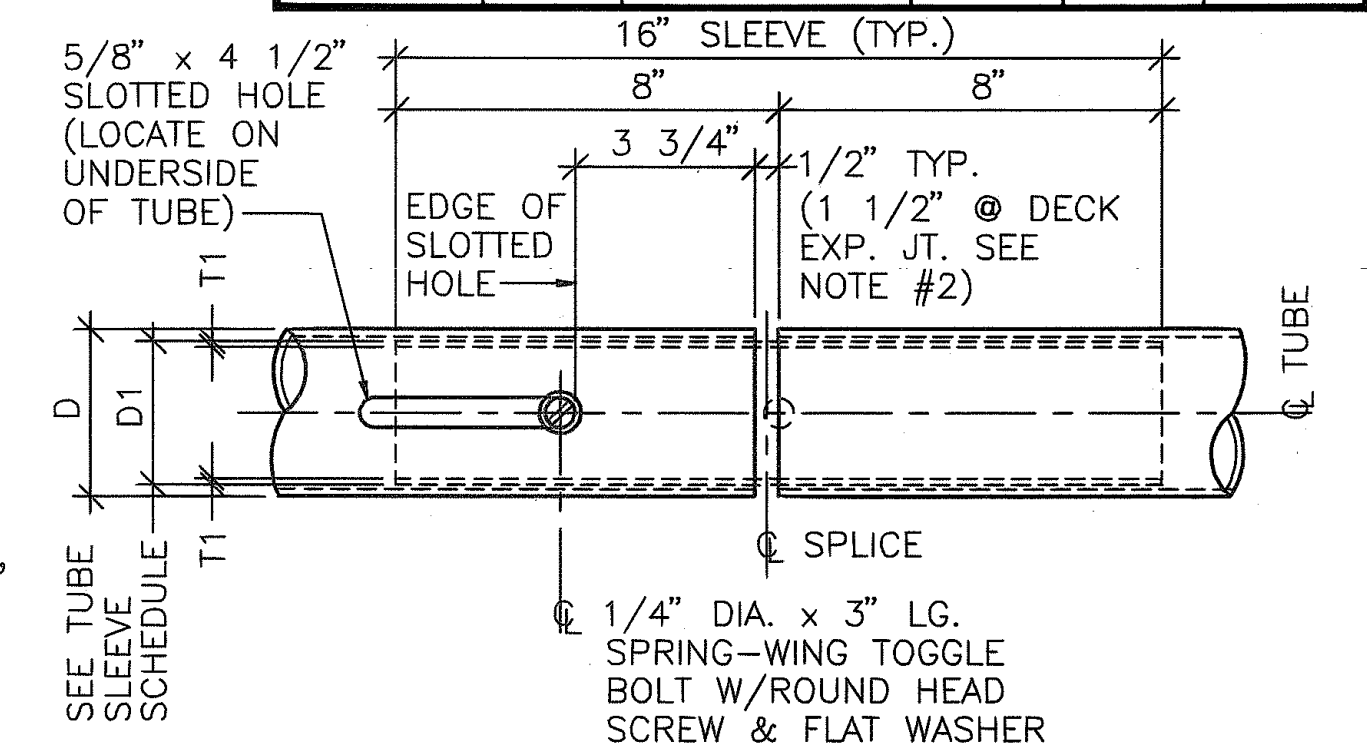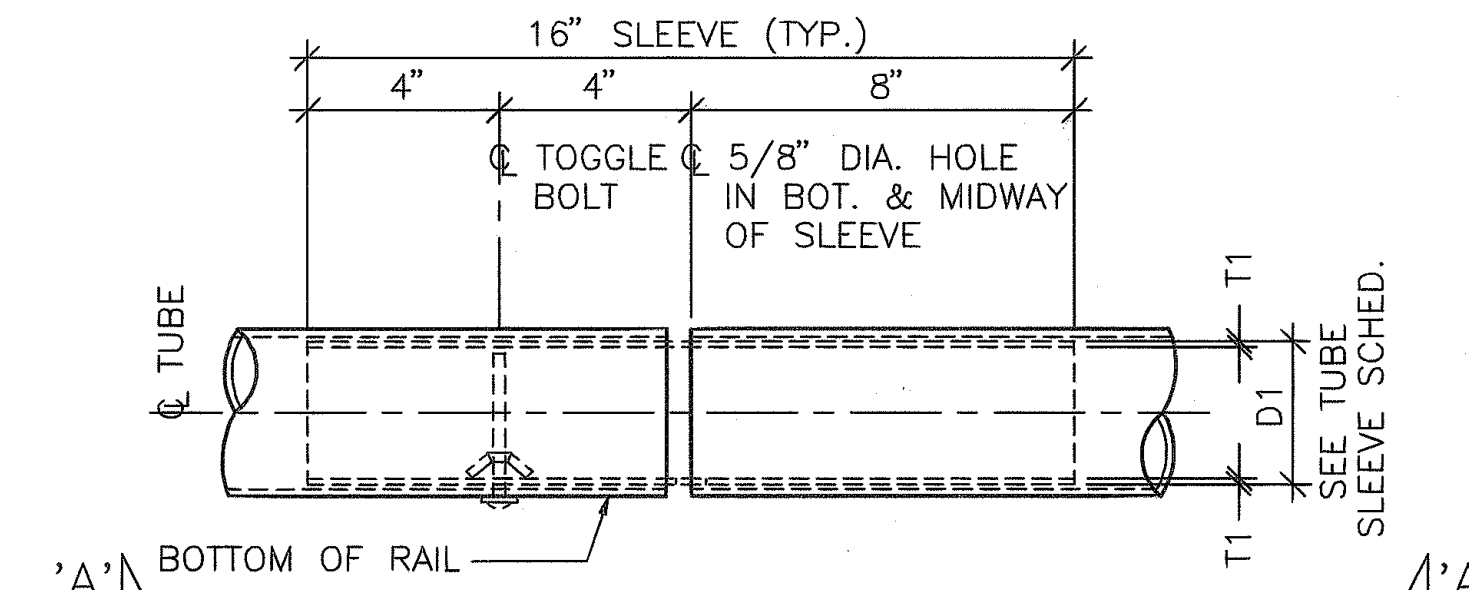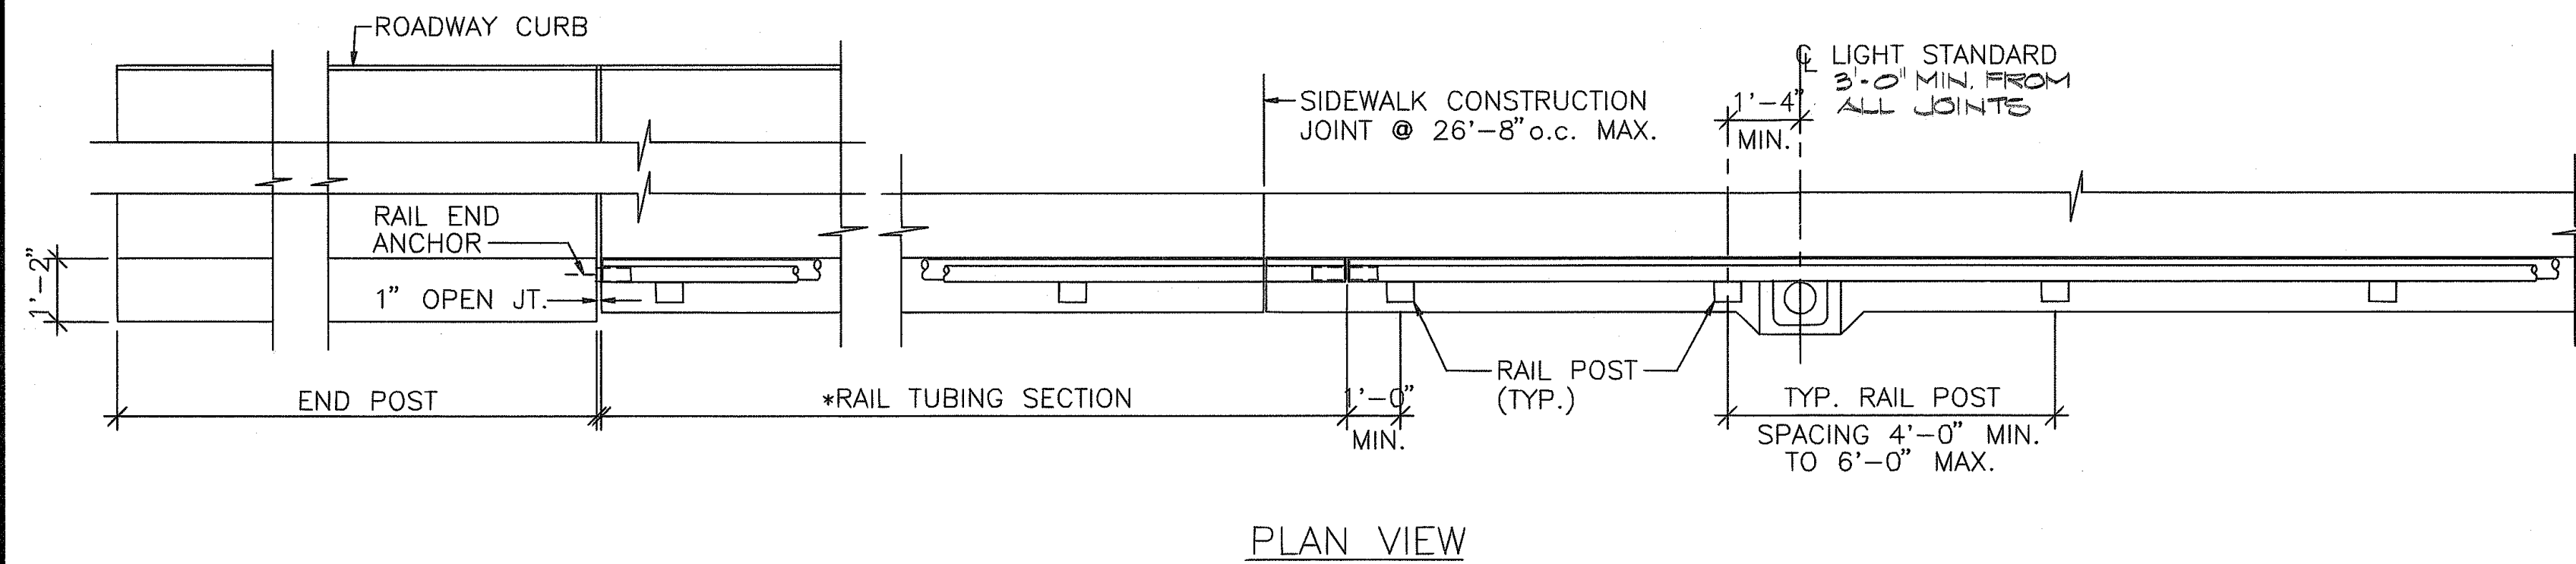

SIDE ELEVATION

UNDERSIDE VIEW 'A-A'

TUBE SLEEVE SCHEDULE		
D	D1	T1
3 1/2"	3"	1/8"
4 1/2"	3 3/4"	3/8"

TYPICAL TUBE SPLICE DETAIL (NEW)



SC: 3" = 1'-0"

C
S-14


TYPICAL RAILING LAYOUT AT BRIDGE

SC: 3/8" = 1'-0"

A
S-14

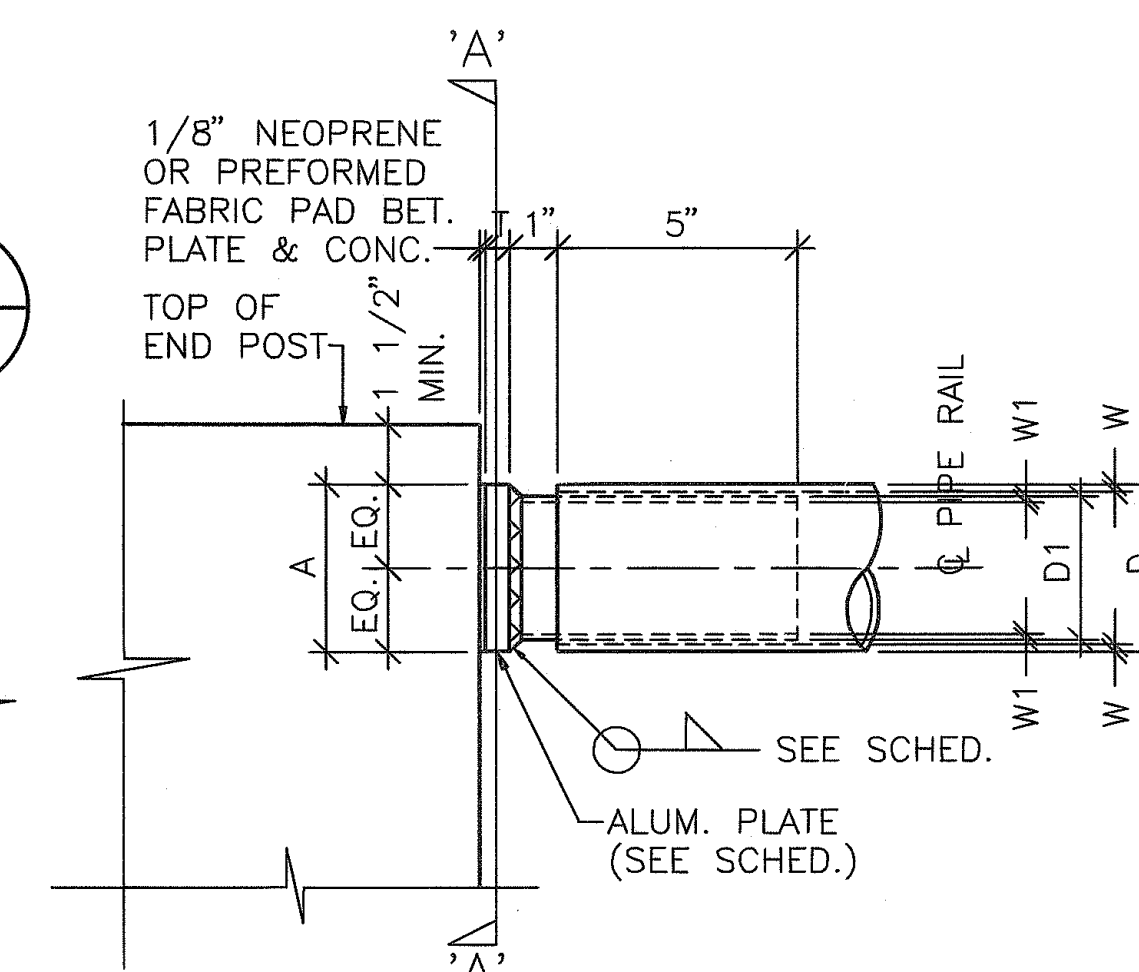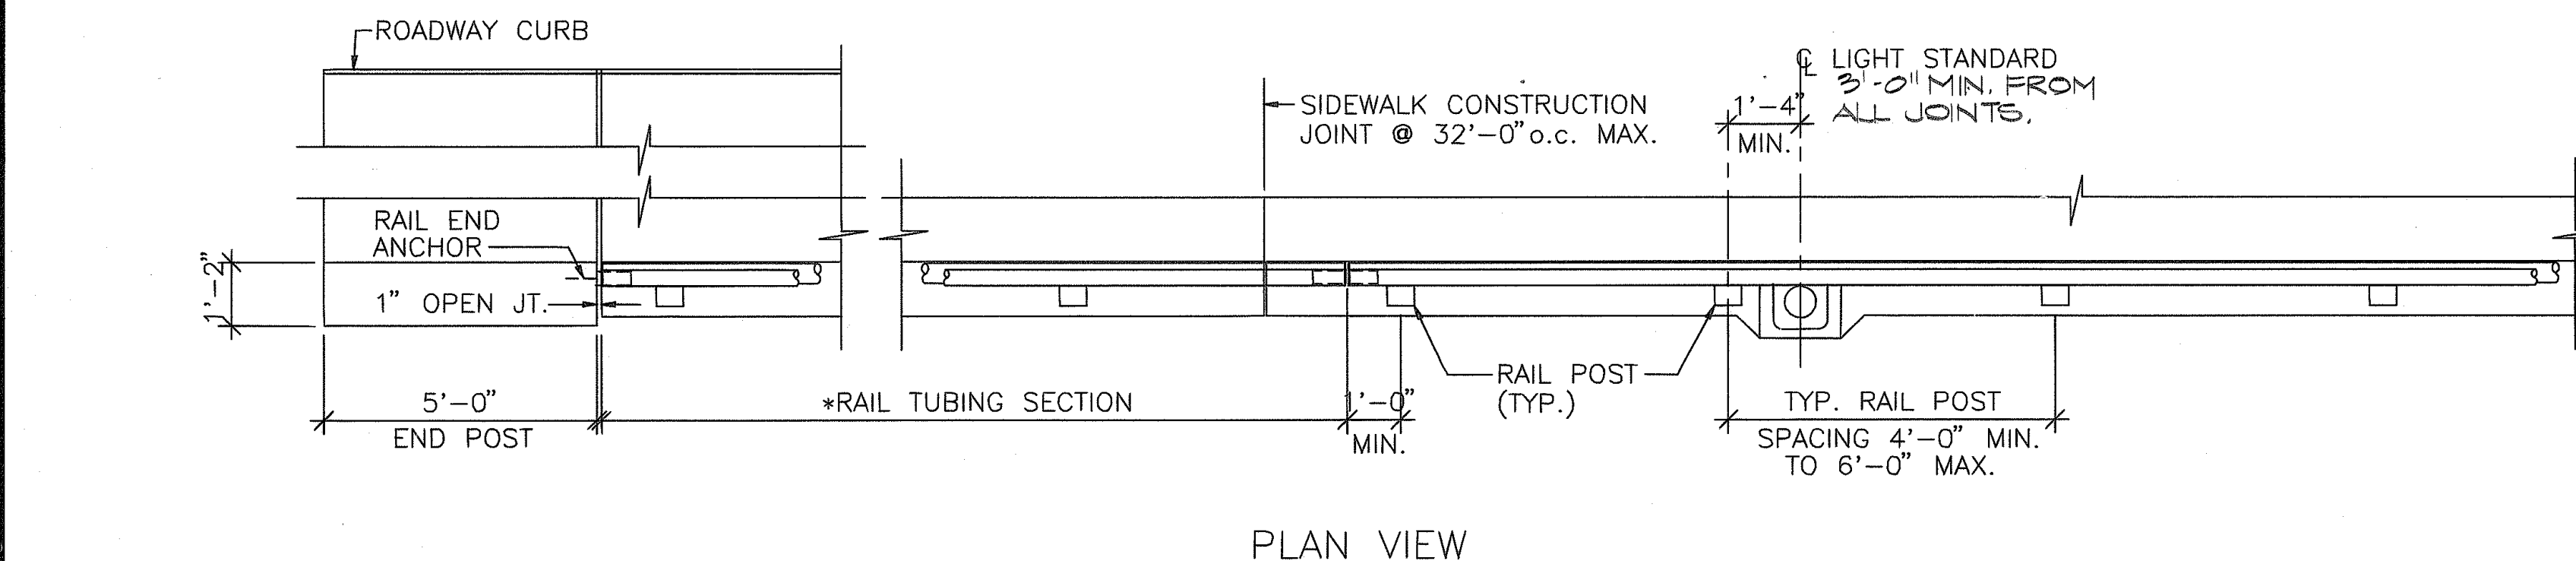

SIDE ELEVATION

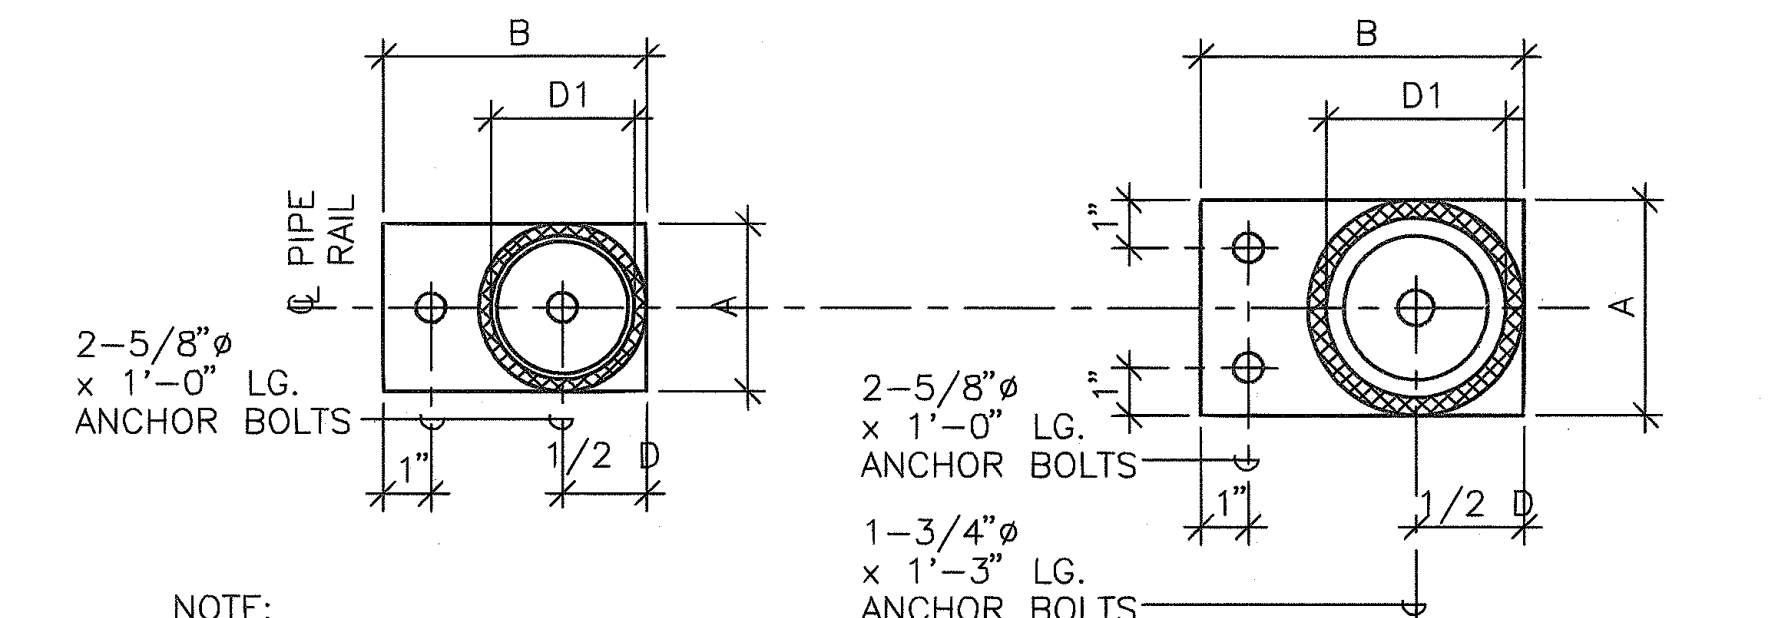

NOTE:
ALL ANCHOR BOLTS TO BE A325

SECTION 'B-B'
COND. AT 3 1/2" PIPE RAIL


SECTION 'B-B'
COND. AT 4 1/2" PIPE RAIL

RAIL END ANCHOR SCHEDULE									
6061-T6 ALUMINUM TUBE					6061-T6 ALUMINUM PLATE				
D	W	D1	W1		D	A	B	T	WELD
3 1/2"	5/32"	3"	1/8"		3 1/2"	3 1/2"	5 1/2"	1/2"	1/4"
4 1/2"	19/64"	3 1/2"	5/16"		4 1/2"	4 1/2"	6 3/4"	1 1/2"	1/2"

TYPICAL RAIL END ANCHOR DETAIL (NEW)

SC: 3" = 1'-0"

D
S-14

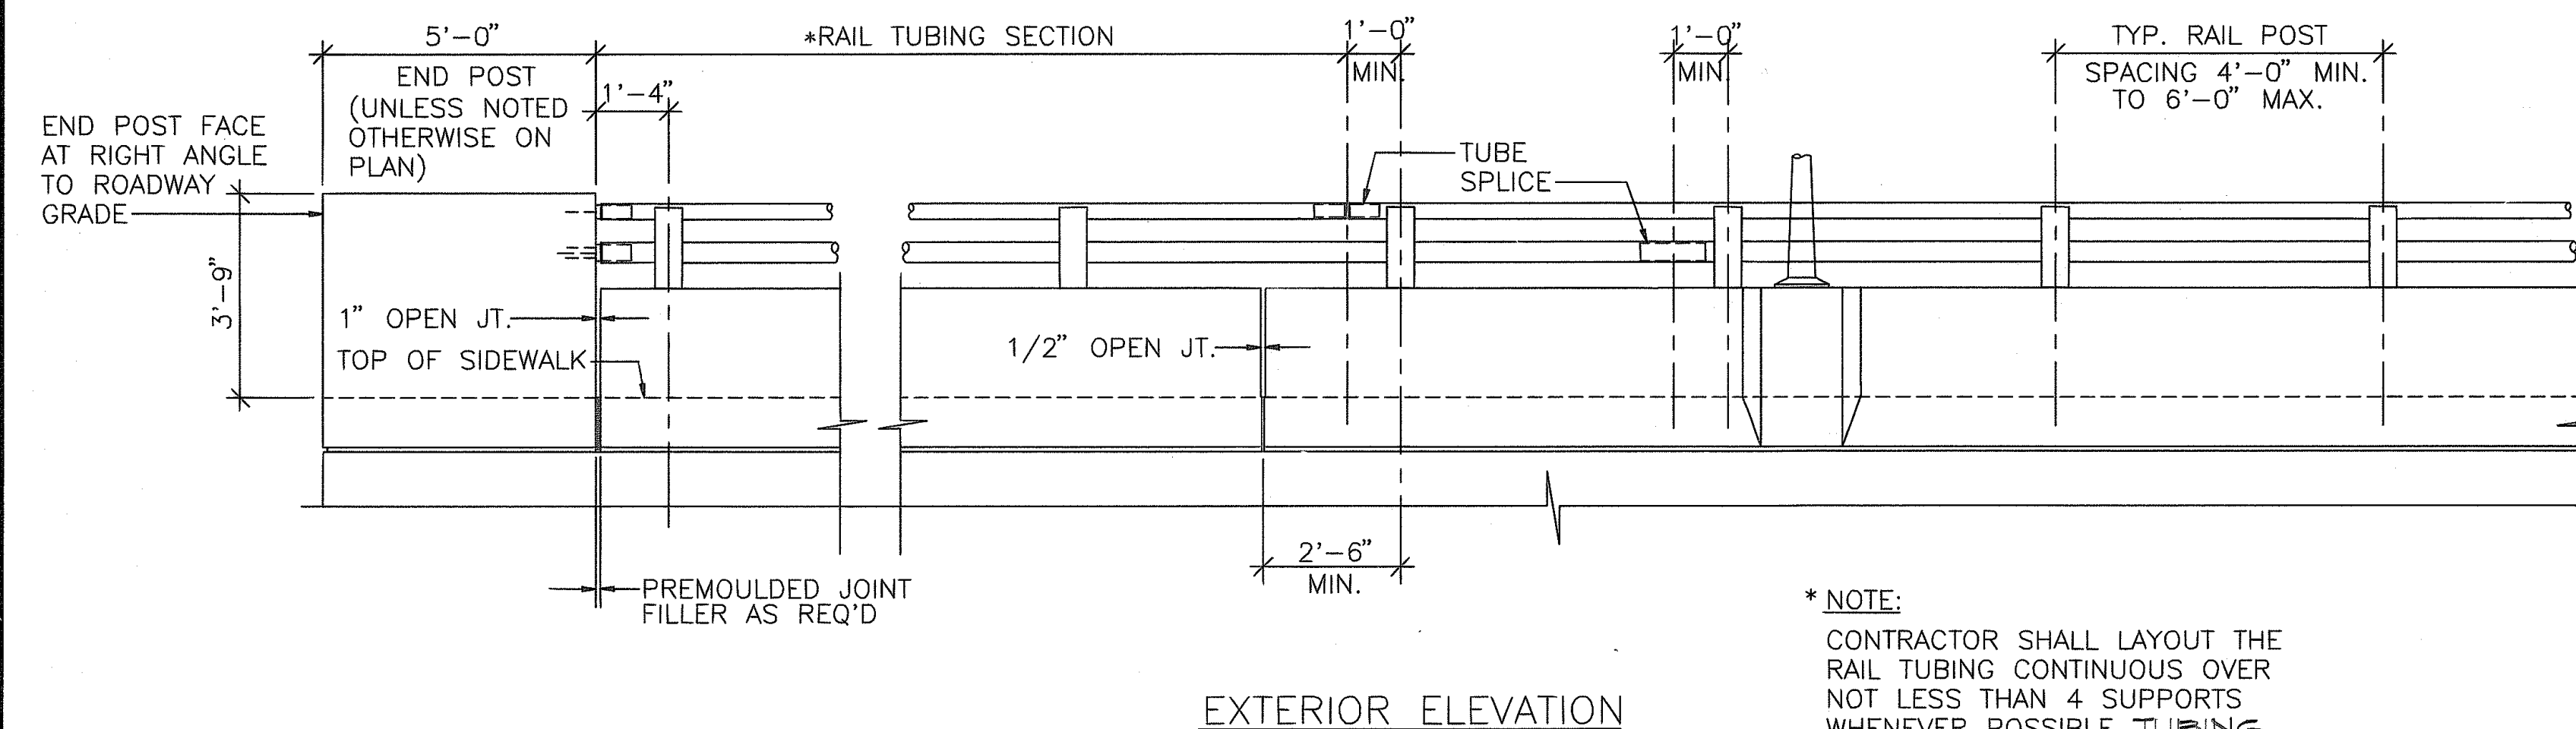


B
S-14

TYPICAL RAILING LAYOUT BEYOND BRIDGE

SC: 3/8" = 1'-0"

*NOTE:
CONTRACTOR SHALL LAYOUT THE RAIL TUBING CONTINUOUS OVER NOT LESS THAN 4 SUPPORTS WHENEVER POSSIBLE. TUBING OVER (2) SUPPORTS WILL NOT BE PERMITTED.

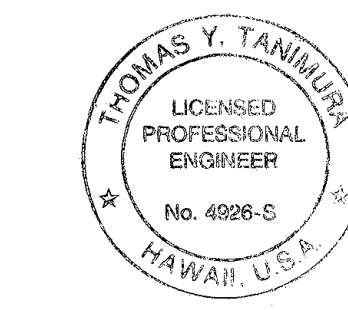

THIS WORK WAS PREPARED BY ME OR UNDER MY SUPERVISION.
Signature

STATE OF HAWAII
DEPARTMENT OF TRANSPORTATION
HIGHWAYS DIVISION

TYP. RAILING LAYOUT AT BRIDGE & BEYOND BRIDGE, TUBE SPLICE & RAIL END ANCHOR DETAILS

MANAGER'S DRIVE BRIDGE WIDENING
INTERSTATE ROUTE H-1

DATE	
SURVEY PLOTTED BY	
DRAWN BY	
DESIGNED BY	
CHECKED BY	
ORIGINAL PLAN	
NOTE BOOK	
No.	

Technical drawing of a rectangular plate with the following dimensions and specifications:

- Overall width: $6 \frac{3}{4}"$
- Overall height: $3 \frac{1}{2}"$
- Distance from top edge to center of first hole: $1 \frac{1}{2}"$
- Distance from right edge to center of second hole: $1 \frac{1}{2}"$
- Distance between centers of the two holes: $3 \frac{3}{4}"$
- Drill hole specifications: DRILL 2- $\frac{13}{16}" \phi$ HOLES AS SHOWN

1'-3"

3"

1/2"

THREAD

1 5/16" DIA. x 3/16" THK. GALV. STEEL WASHER

3/4" 10 NC GALV. STEEL ASTM 325 ANCHOR BOLT

ANCHOR PLATE

TYP. ANCHOR BOLT DET. (NEW) (C)
SC: 6" = 1'-0" (S)



SC: 6" = 1'-0"








SC: 6" = 1'-0"

A
S-15

THIS WORK WAS PREPARED BY
ME OR UNDER MY SUPERVISION
TY Tammara
Signature

SHEET No. 5 OF 16 SHEETS

FED. ROAD DIST. NO.	STATE	FED. AID PROJ. NO.	FISCAL YEAR	SHEET NO.	TOTAL SHEETS
HAWAII	HAW.	PMT-HIC-01-97			

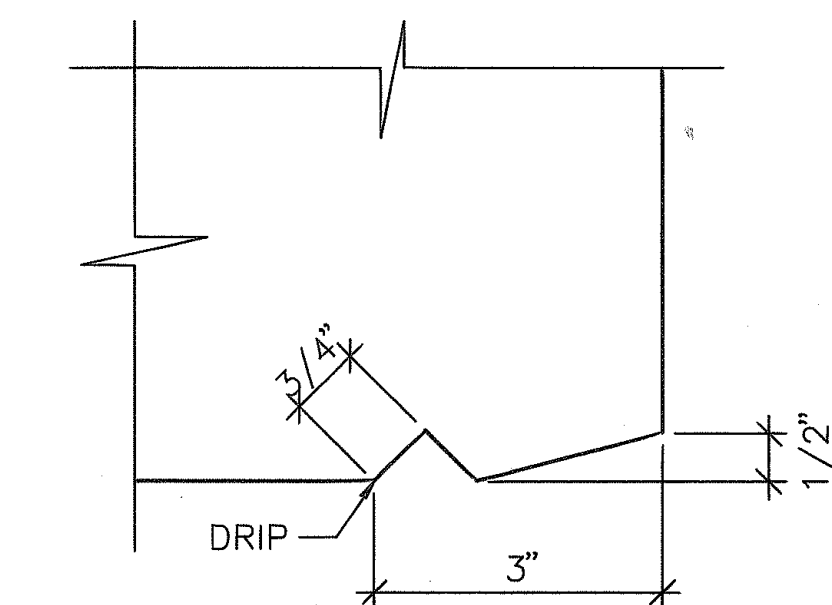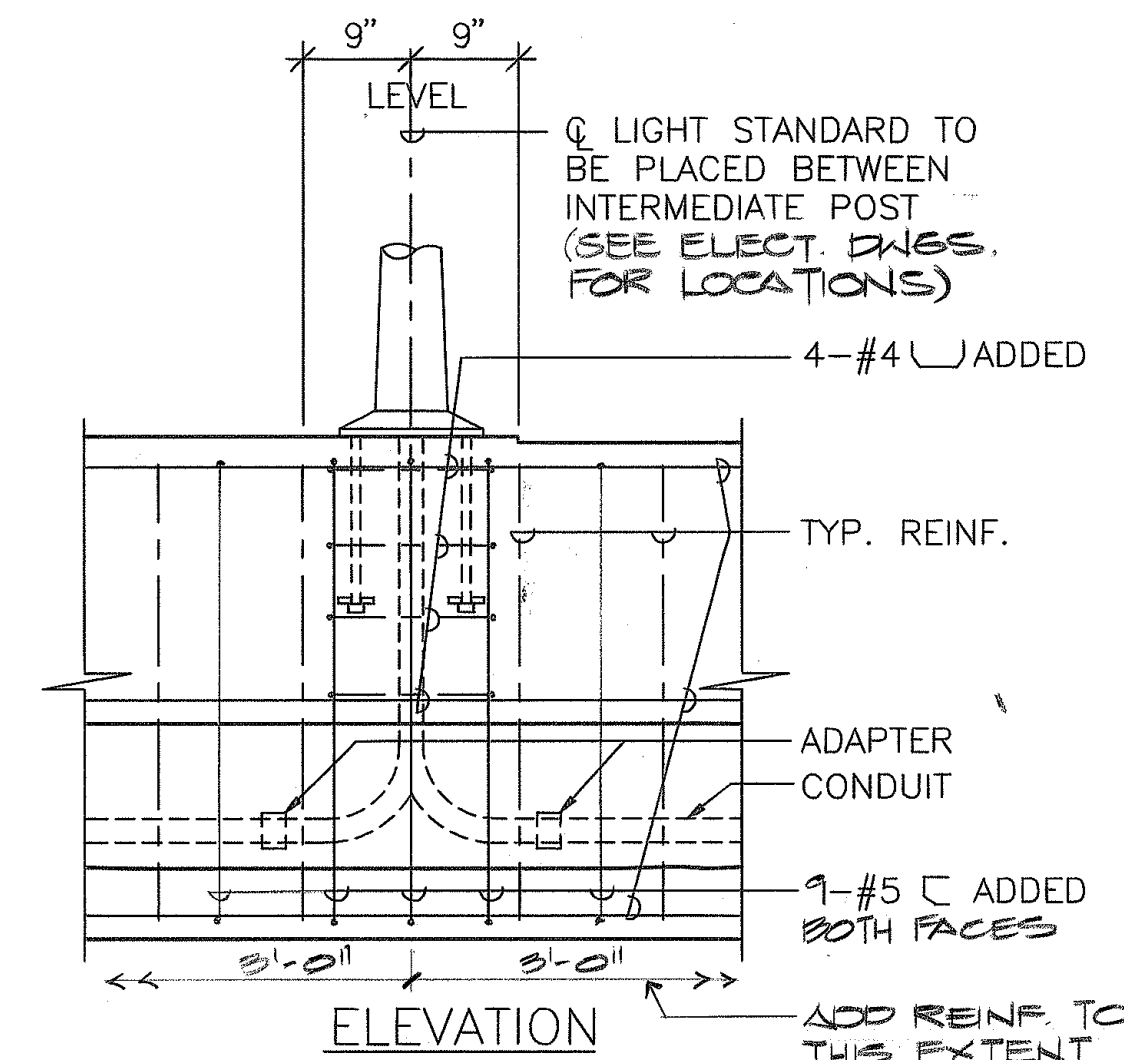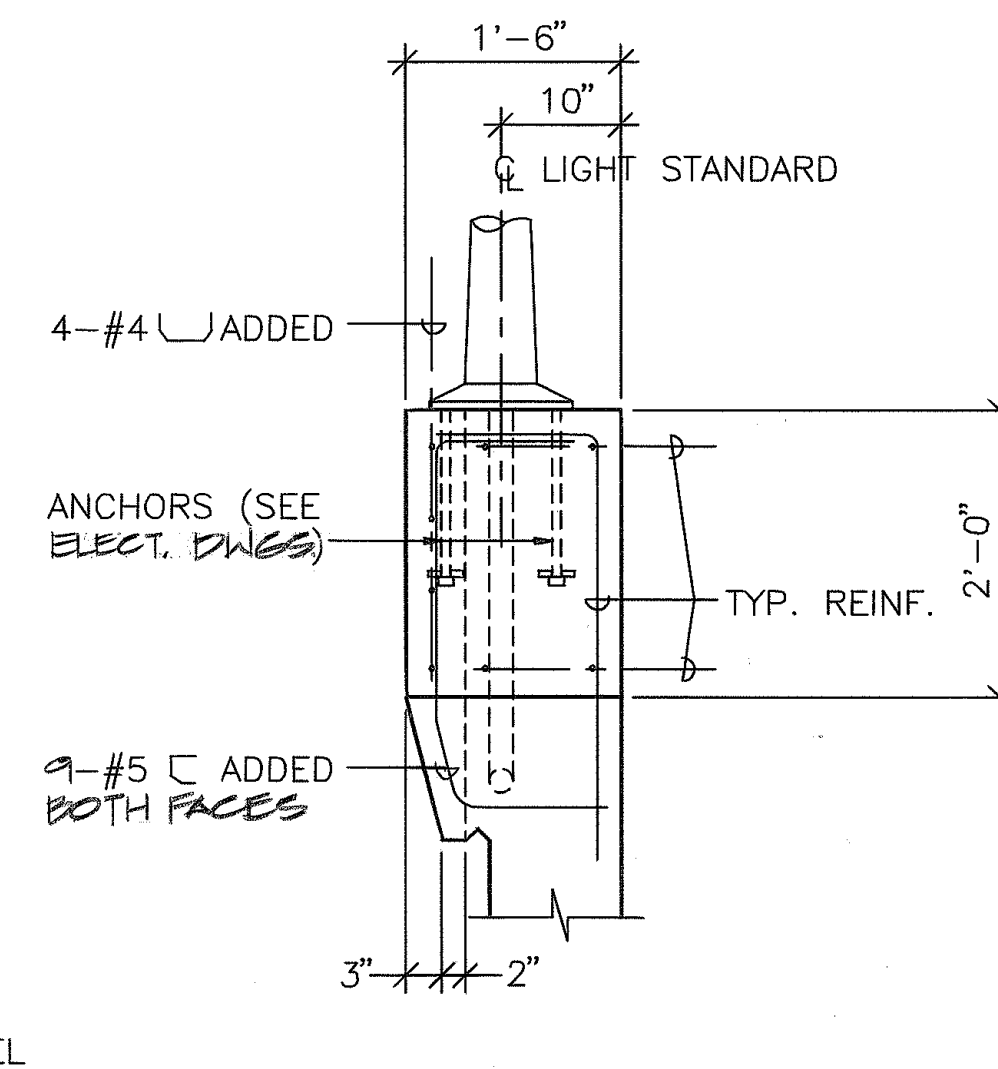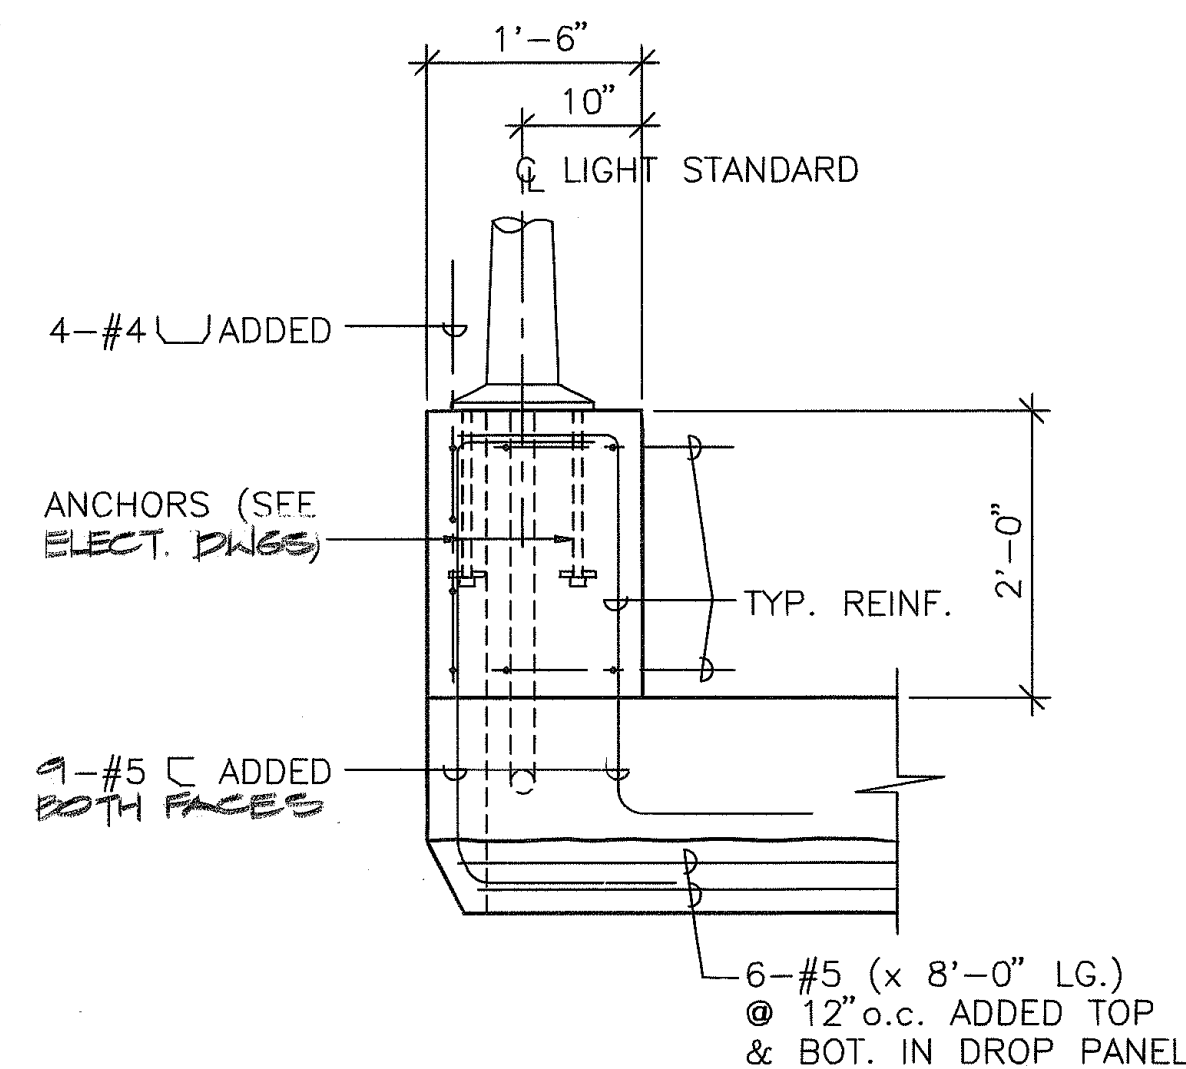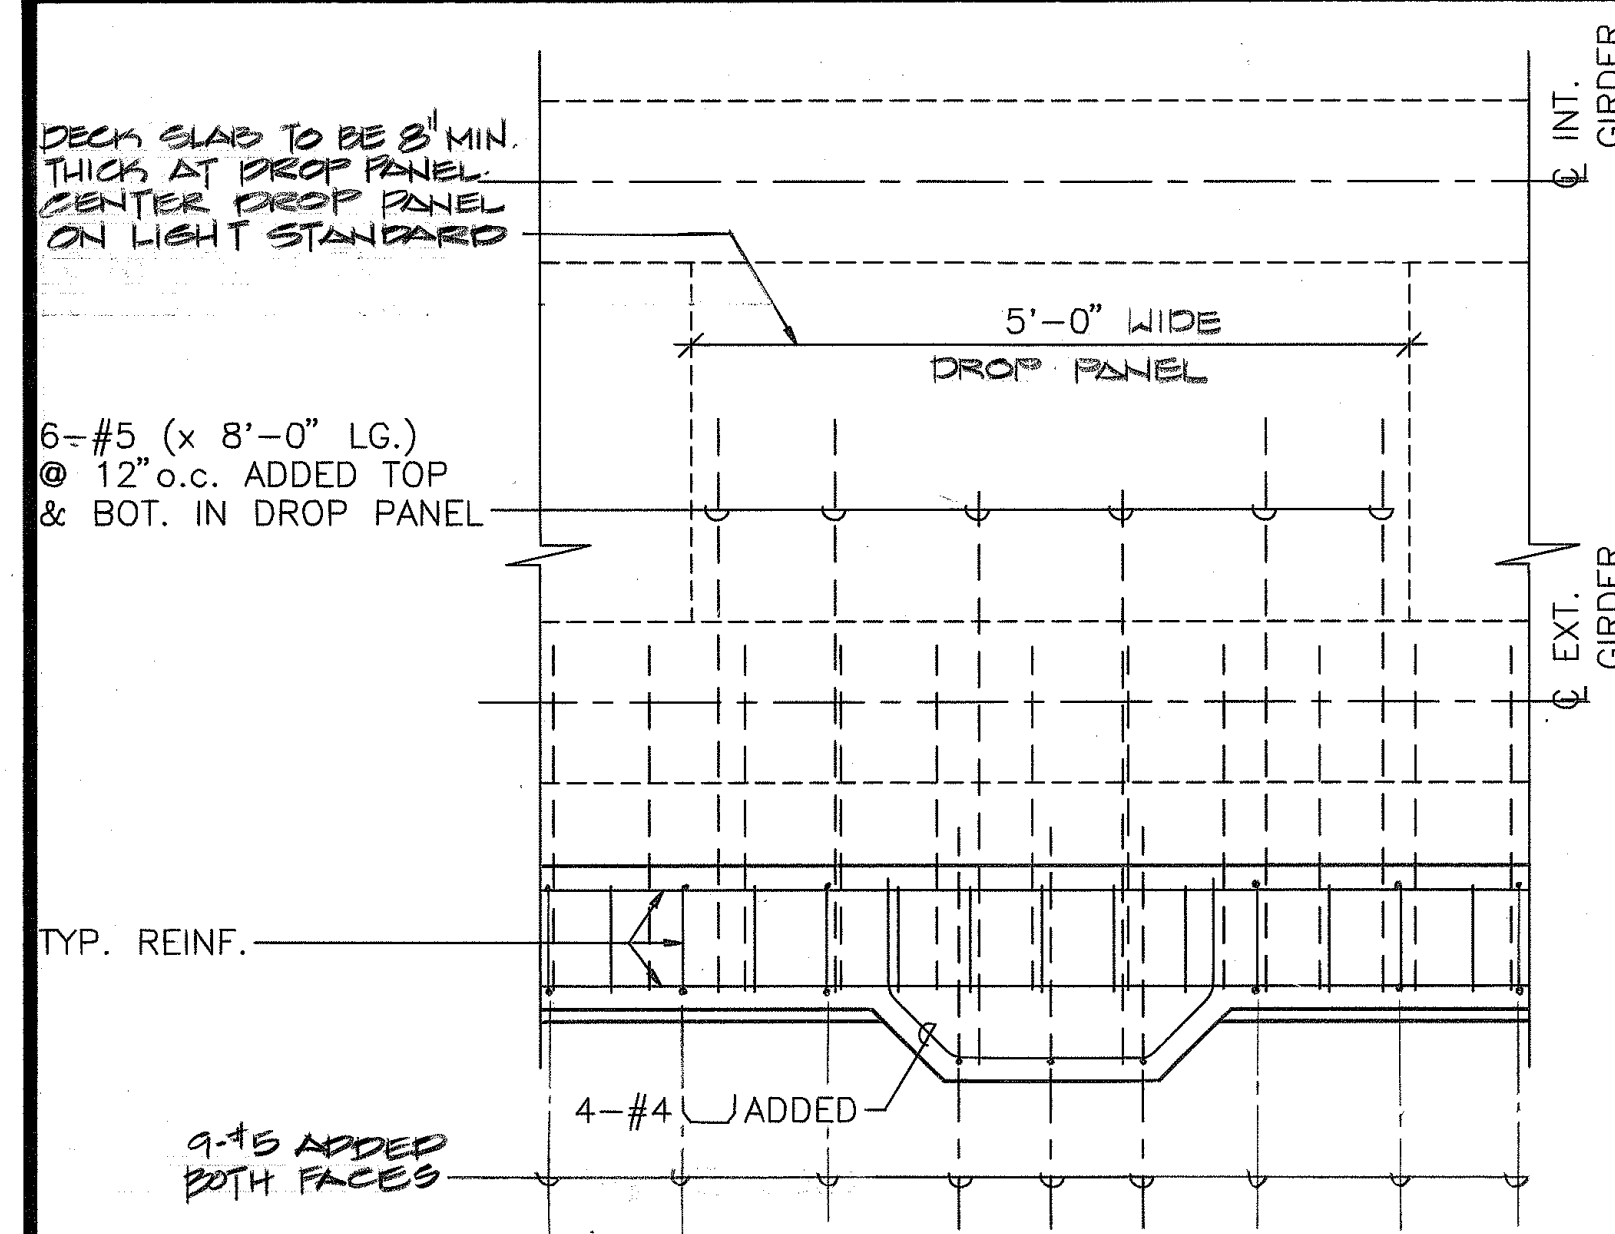

NOT TO SCALE

TYPICAL RAILING DETAIL AT LIGHT STANDARD


SC: 3/4" = 1'-0"

NAME DATE

USE CORRECT NAME OF BRIDGE

DATE OF YEAR BUILT

- NOTE:
- REFER TO CORRESPONDING DETAIL DRAWINGS FOR PLACEMENT OF SUCH NAMES & DATES AT END POST.
 - GOthic LETTERS & FIGURES APPROXIMATING DIMENSIONS SHOWN WILL BE ACCEPTABLE IF APPROVED BY THE ENGINEER OR EXACT DETAILS & SPACING OF LETTERS & FIGURES SHALL BE AS DIRECTED BY THE ENGINEER.

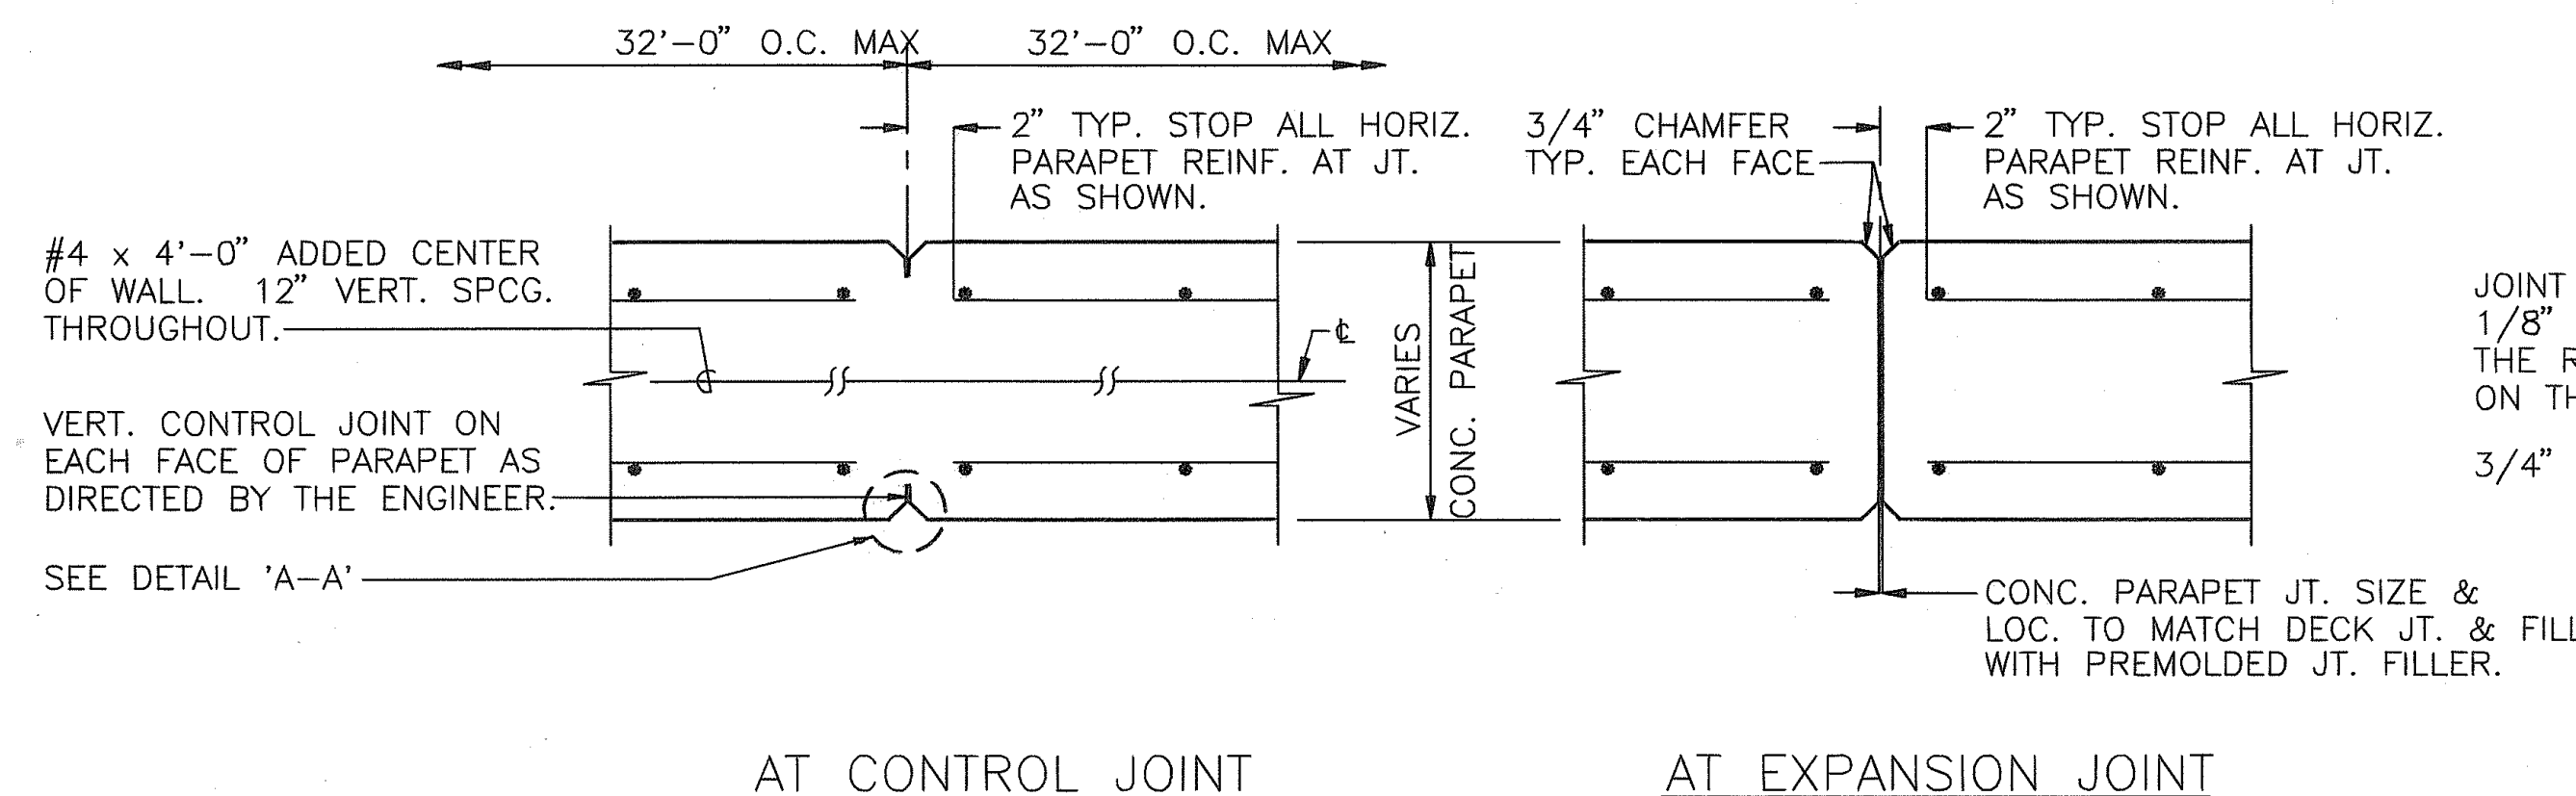

DETAIL 'A-A'

TYPICAL DETAIL OF LETTERS & FIGURES AT CONCRETE END POST

NOT TO SCALE


TYPICAL CONTROL JOINT DETAIL

SC: 1 1/2" = 1'-0"

NOTE: TO POUR NEW SIGN AT EXIST. END POST, REMOVE 4" MIN. THICKNESS OF CONCRETE FROM FACE.


TYP. SLAB CONSTRUCTION JOINT DETAIL

NOT TO SCALE

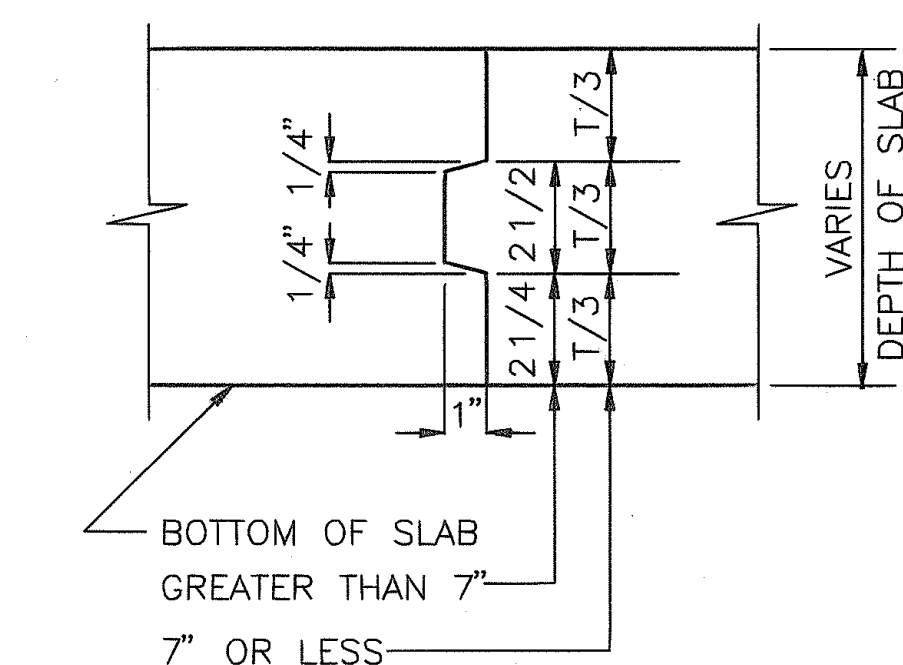

NOTE:

FORM REMOVAL OPENINGS SHALL BE OMITTED AND REPLACED BY 4" VENTS ONLY IF CONTRACTOR LEAVES TOP SLAB FORMS IN PLACE.

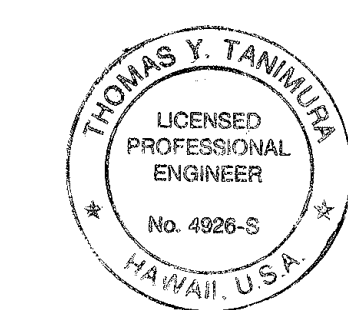

THIS WORK WAS PREPARED BY ME OR UNDER MY SUPERVISION.

Signature

STATE OF HAWAII
DEPARTMENT OF TRANSPORTATION
HIGHWAYS DIVISION

TYP. RAILING AT LIGHT STANDARD, DRIP, LETTERING, CONTROL & CONSTRUCTION JOINT DETAILS

MANAGER'S DRIVE BRIDGE WIDENING
INTERSTATE ROUTE H-1