

FED. ROAD DIST. NO.	STATE	FED. AID PROJ. NO.	FISCAL YEAR	SHEET NO.	TOTAL SHEETS
HAWAII	HAW.	PMT-H10-01-97			


PAVEMENT SECTION

State R/W (Unless Noted Otherwise)


- 4" A.C. Pavement, Mix No. IV
- 8" Aggregate Base Course
- 12" Aggregate Subbase
- (See Note 5 on Sheet 4a for Alternate Pavement Section)

City R/W

- 2 1/2" A.C. Pavement
- 6" Aggregate Base Course
- 18" Select Borrow Subbase unless Soil Test Data indicates otherwise

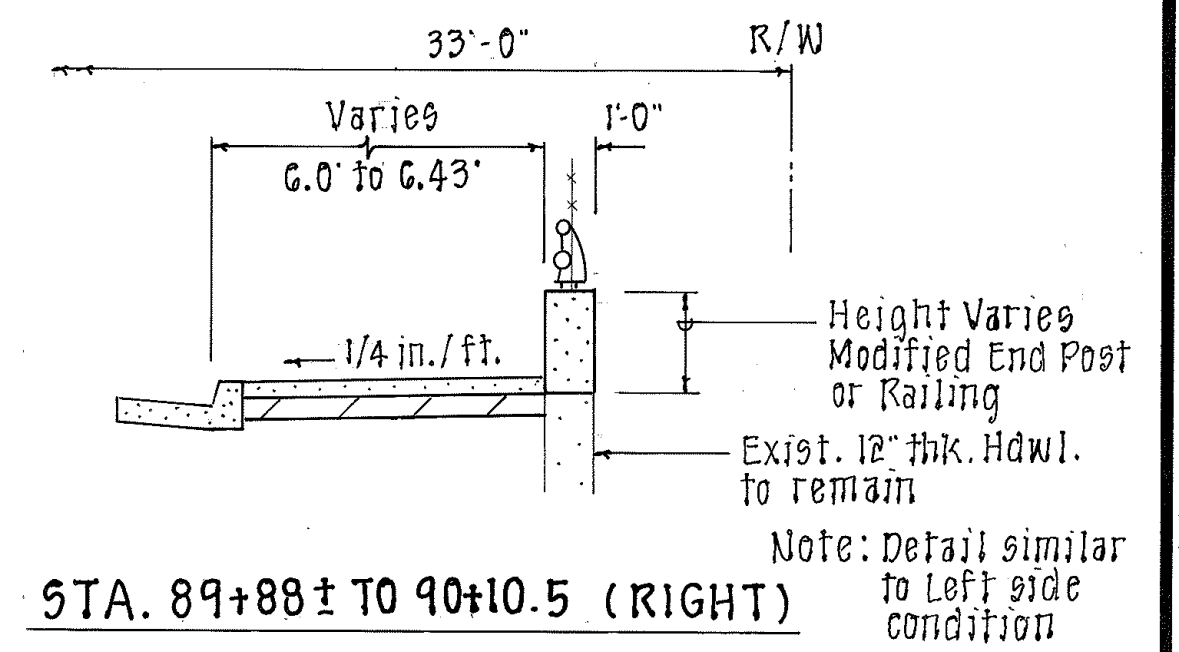


STA. 89+88± TO 90+10.5 (RIGHT)

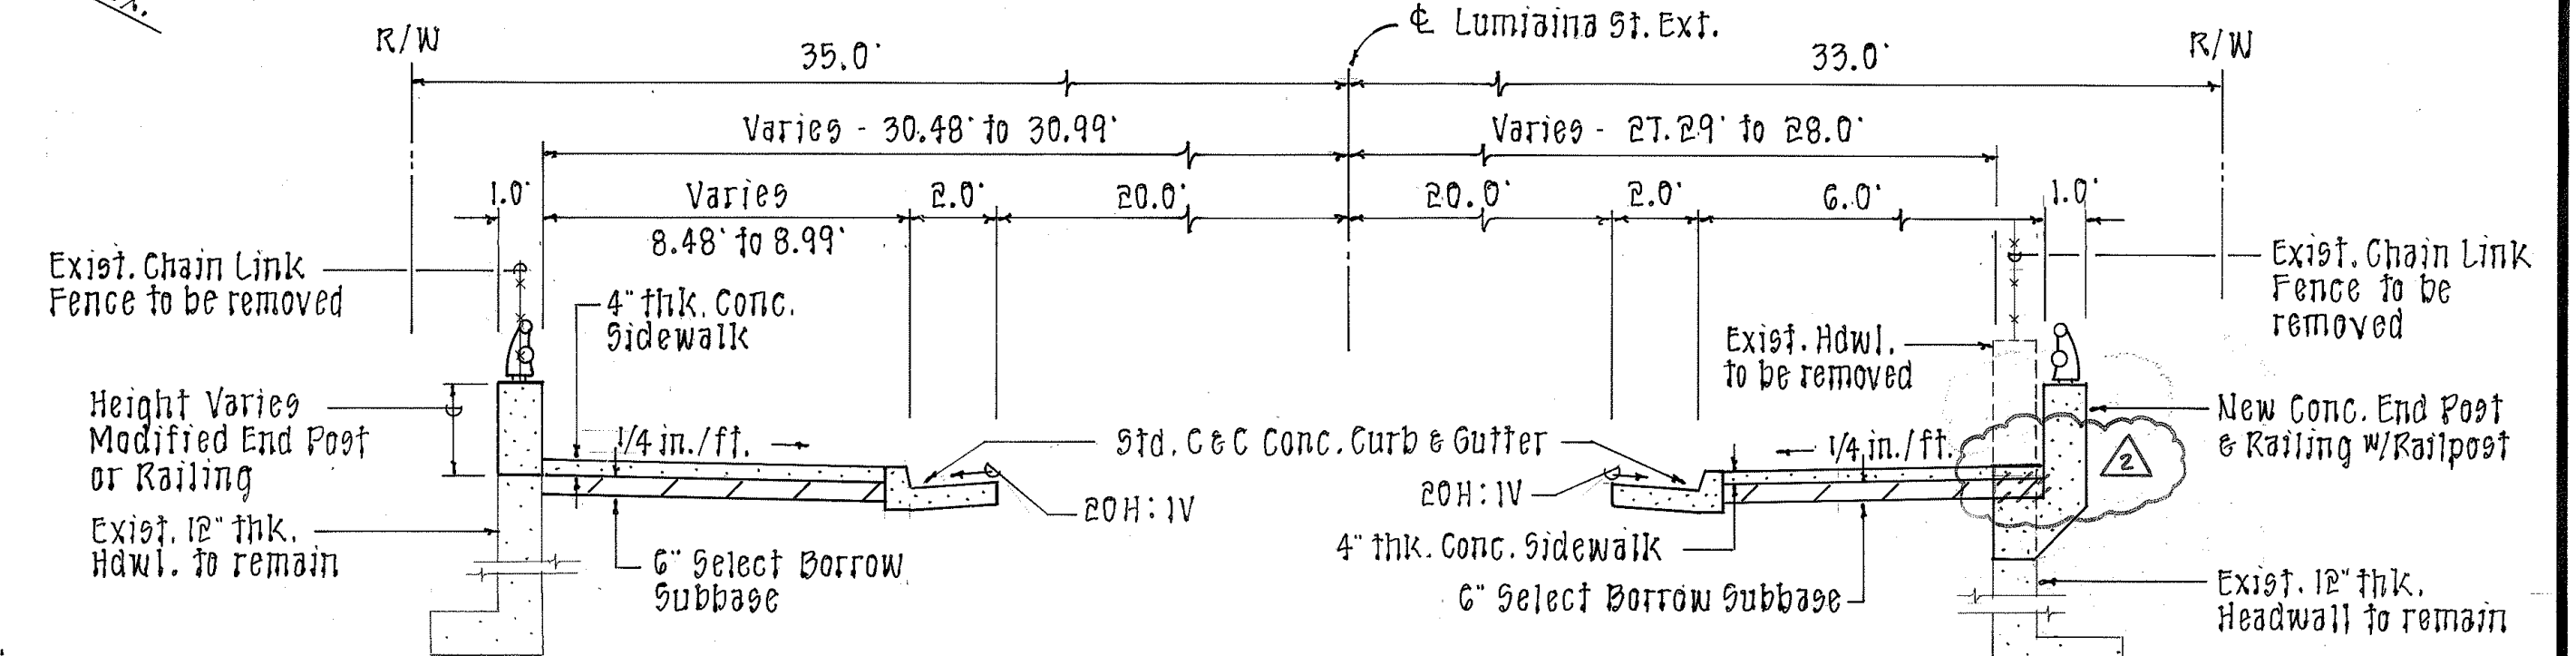


STA. 89+00 TO 90+10 (LEFT)

STA. 88+97.5 TO 89+88± (RIGHT)


TYP. SIDEWALK CONDITIONS @ BOX CULVERT (CITY R/W)

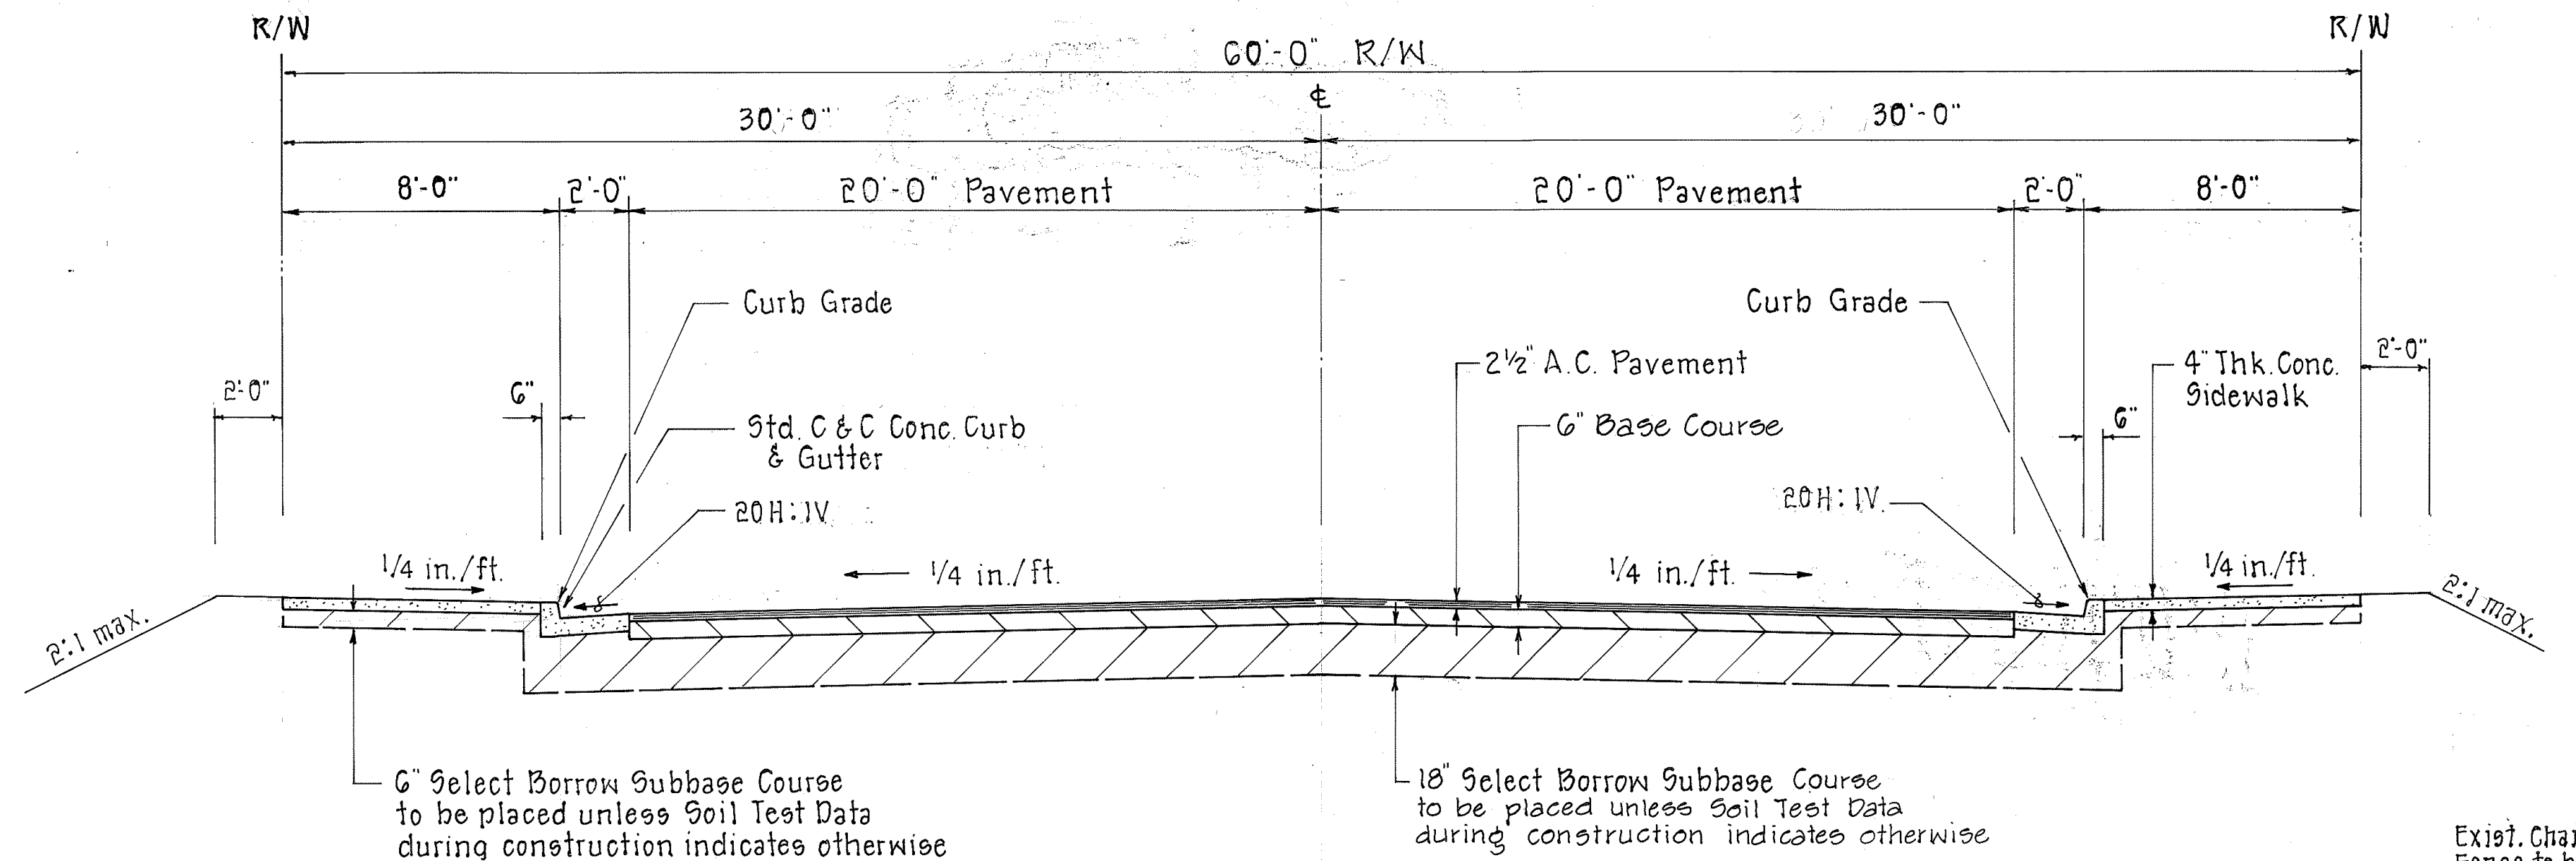


TYPICAL ROAD SECTION (CITY R/W)

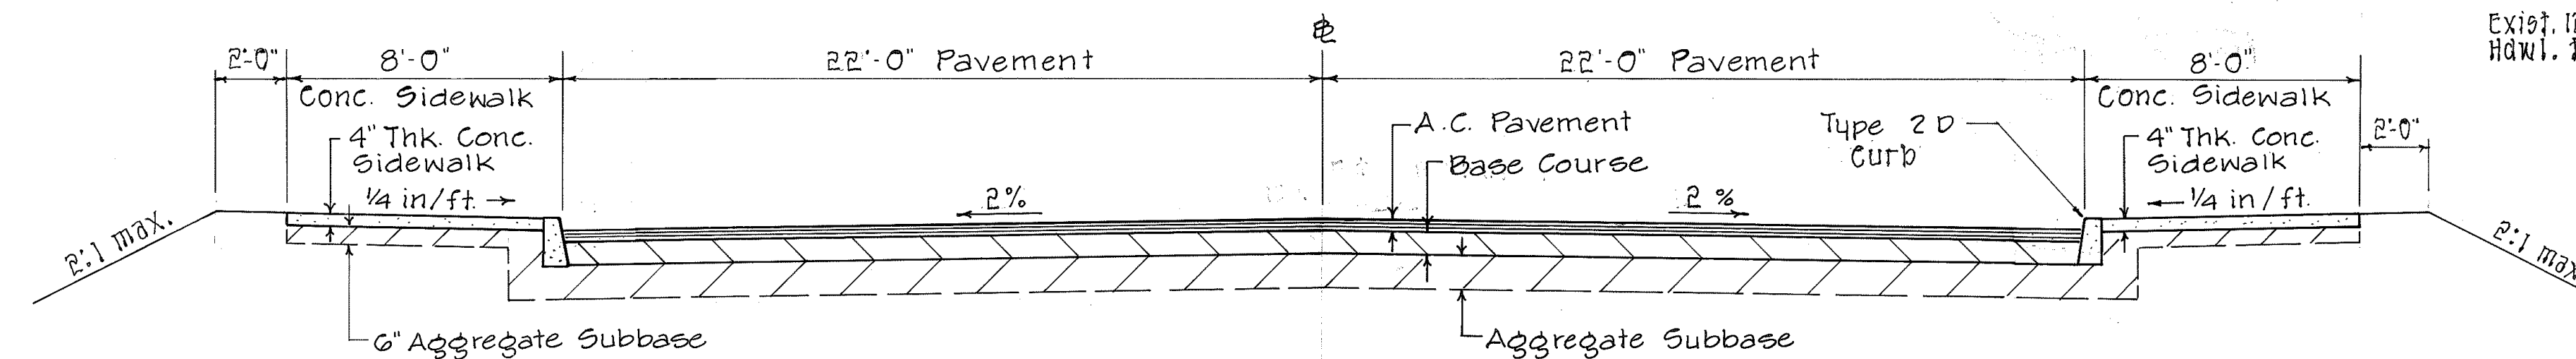

TYPICAL ROAD SECTION (STATE R/W)

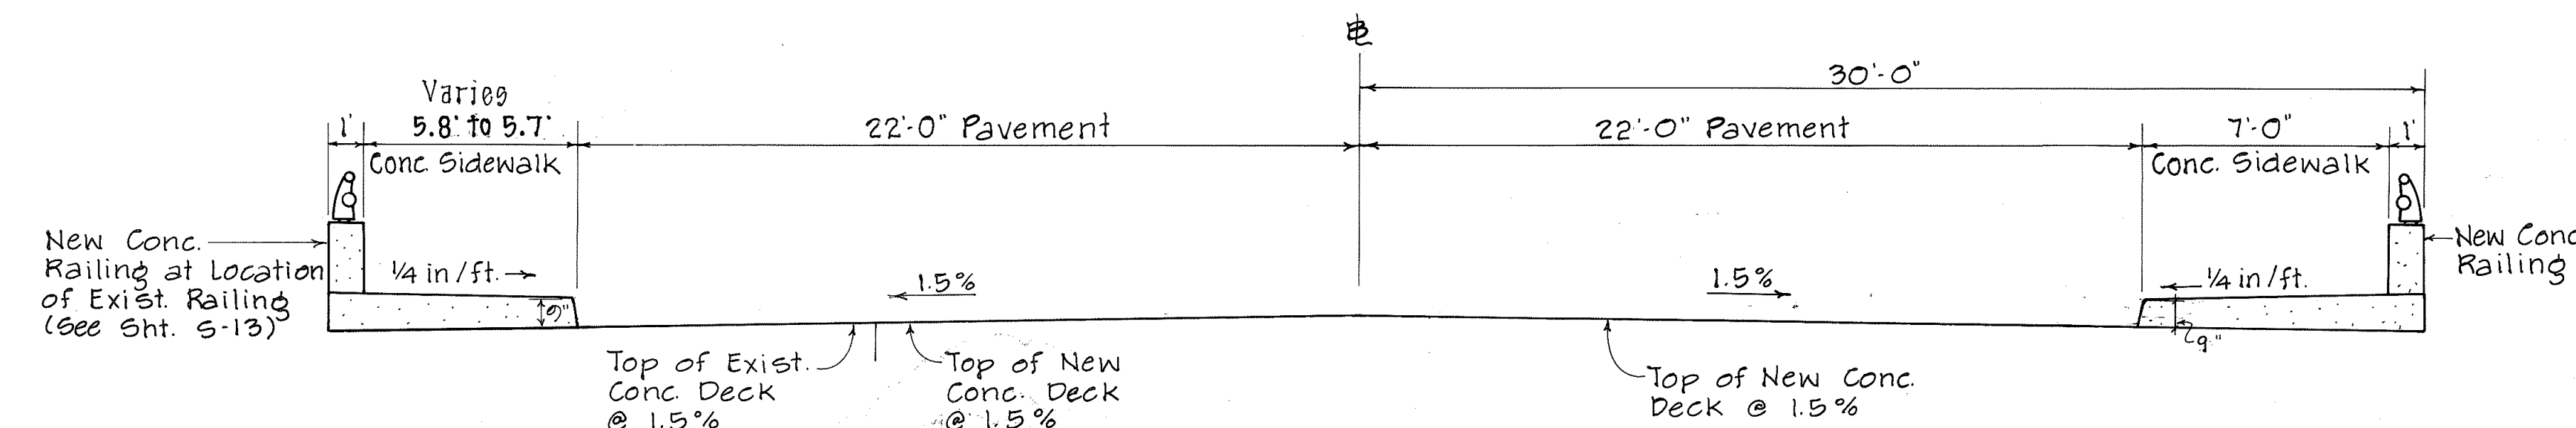

TYPICAL ROAD SECTION @ BRIDGE
(See Sheet S-7 for Structural Section)

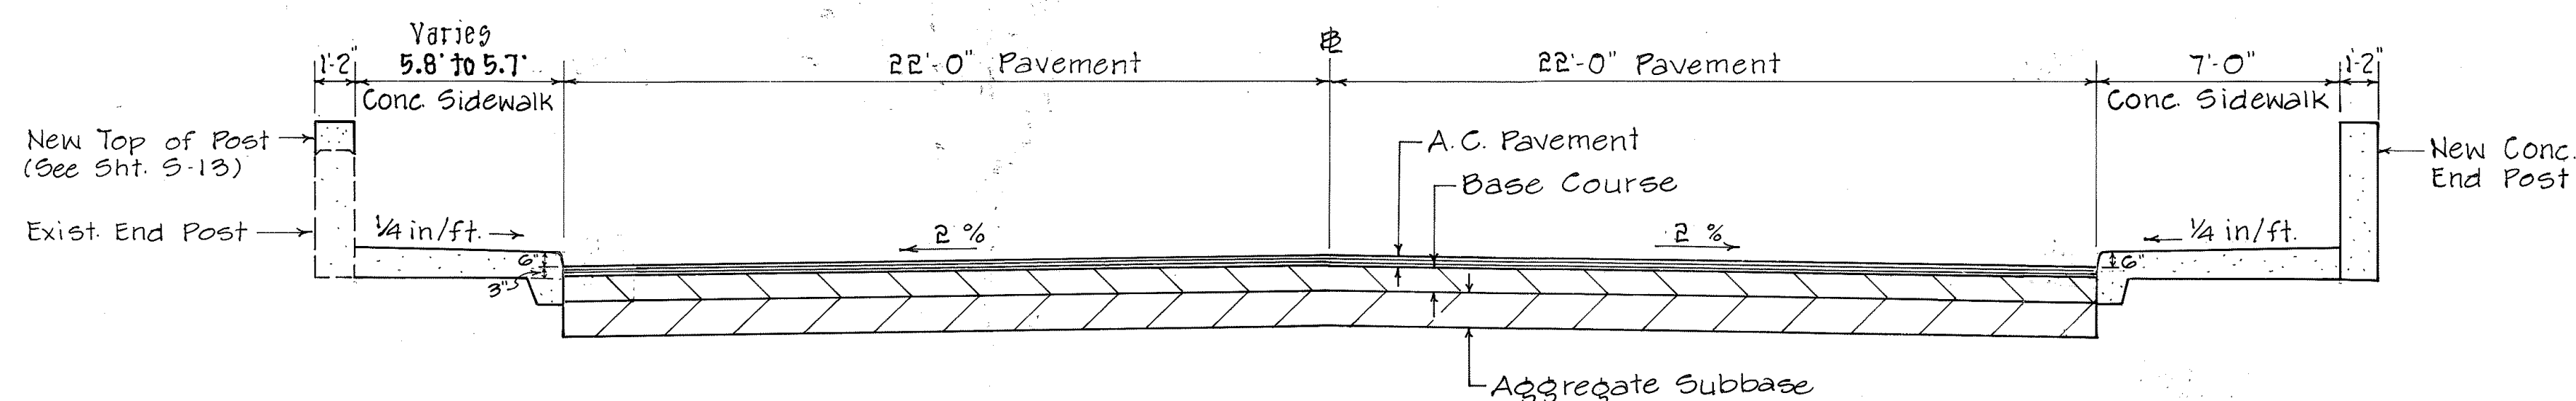

TYPICAL ROAD SECTION @ BRIDGE WING WALL (STATE R/W)

REAPPROVED DUE TO TIME LAPSE:



DATE

APPROVED:

DATE

CHIEF, DIV. OF ENGINEERING, DPW
(FOR CONST. WITHIN CITY R/W ONLY)

CHIEF, DIVISION OF ENGINEERING, DPW
(FOR CONSTRUCTION WITHIN CITY R/W ONLY)

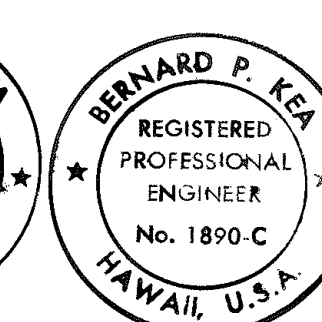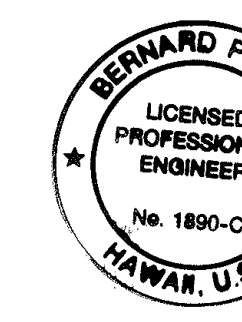

STATE OF HAWAII
DEPARTMENT OF TRANSPORTATION
HIGHWAYS DIVISION

TYPICAL SECTIONS

MANAGER'S DRIVE BRIDGE WIDENING
INTERSTATE ROUTE H-1

SCALE: 1/4" = 1'-0" DATE:

SHEET No. 1 OF 1 SHEETS