


FED. ROAD DIST. NO.	STATE	FED. AID PROJ. NO.	FISCAL YEAR	SHEET NO.	TOTAL SHEETS
HAWAII	HAW.	IM-H1-1(234)	2000	C029	557

CURVE DATA		CURVE DATA	
	LWB-1		H1-1
Δ	22° 56' 06"	Δ	52° 42' 00"
R	1300.00'	R	1200.00'
T	262.93'	T	594.38'
Ch	515.43'	Ch	1065.25'
Lc	518.87'	Lc	1103.75'

TRUE NORTH
SCALE: 1" = 40'

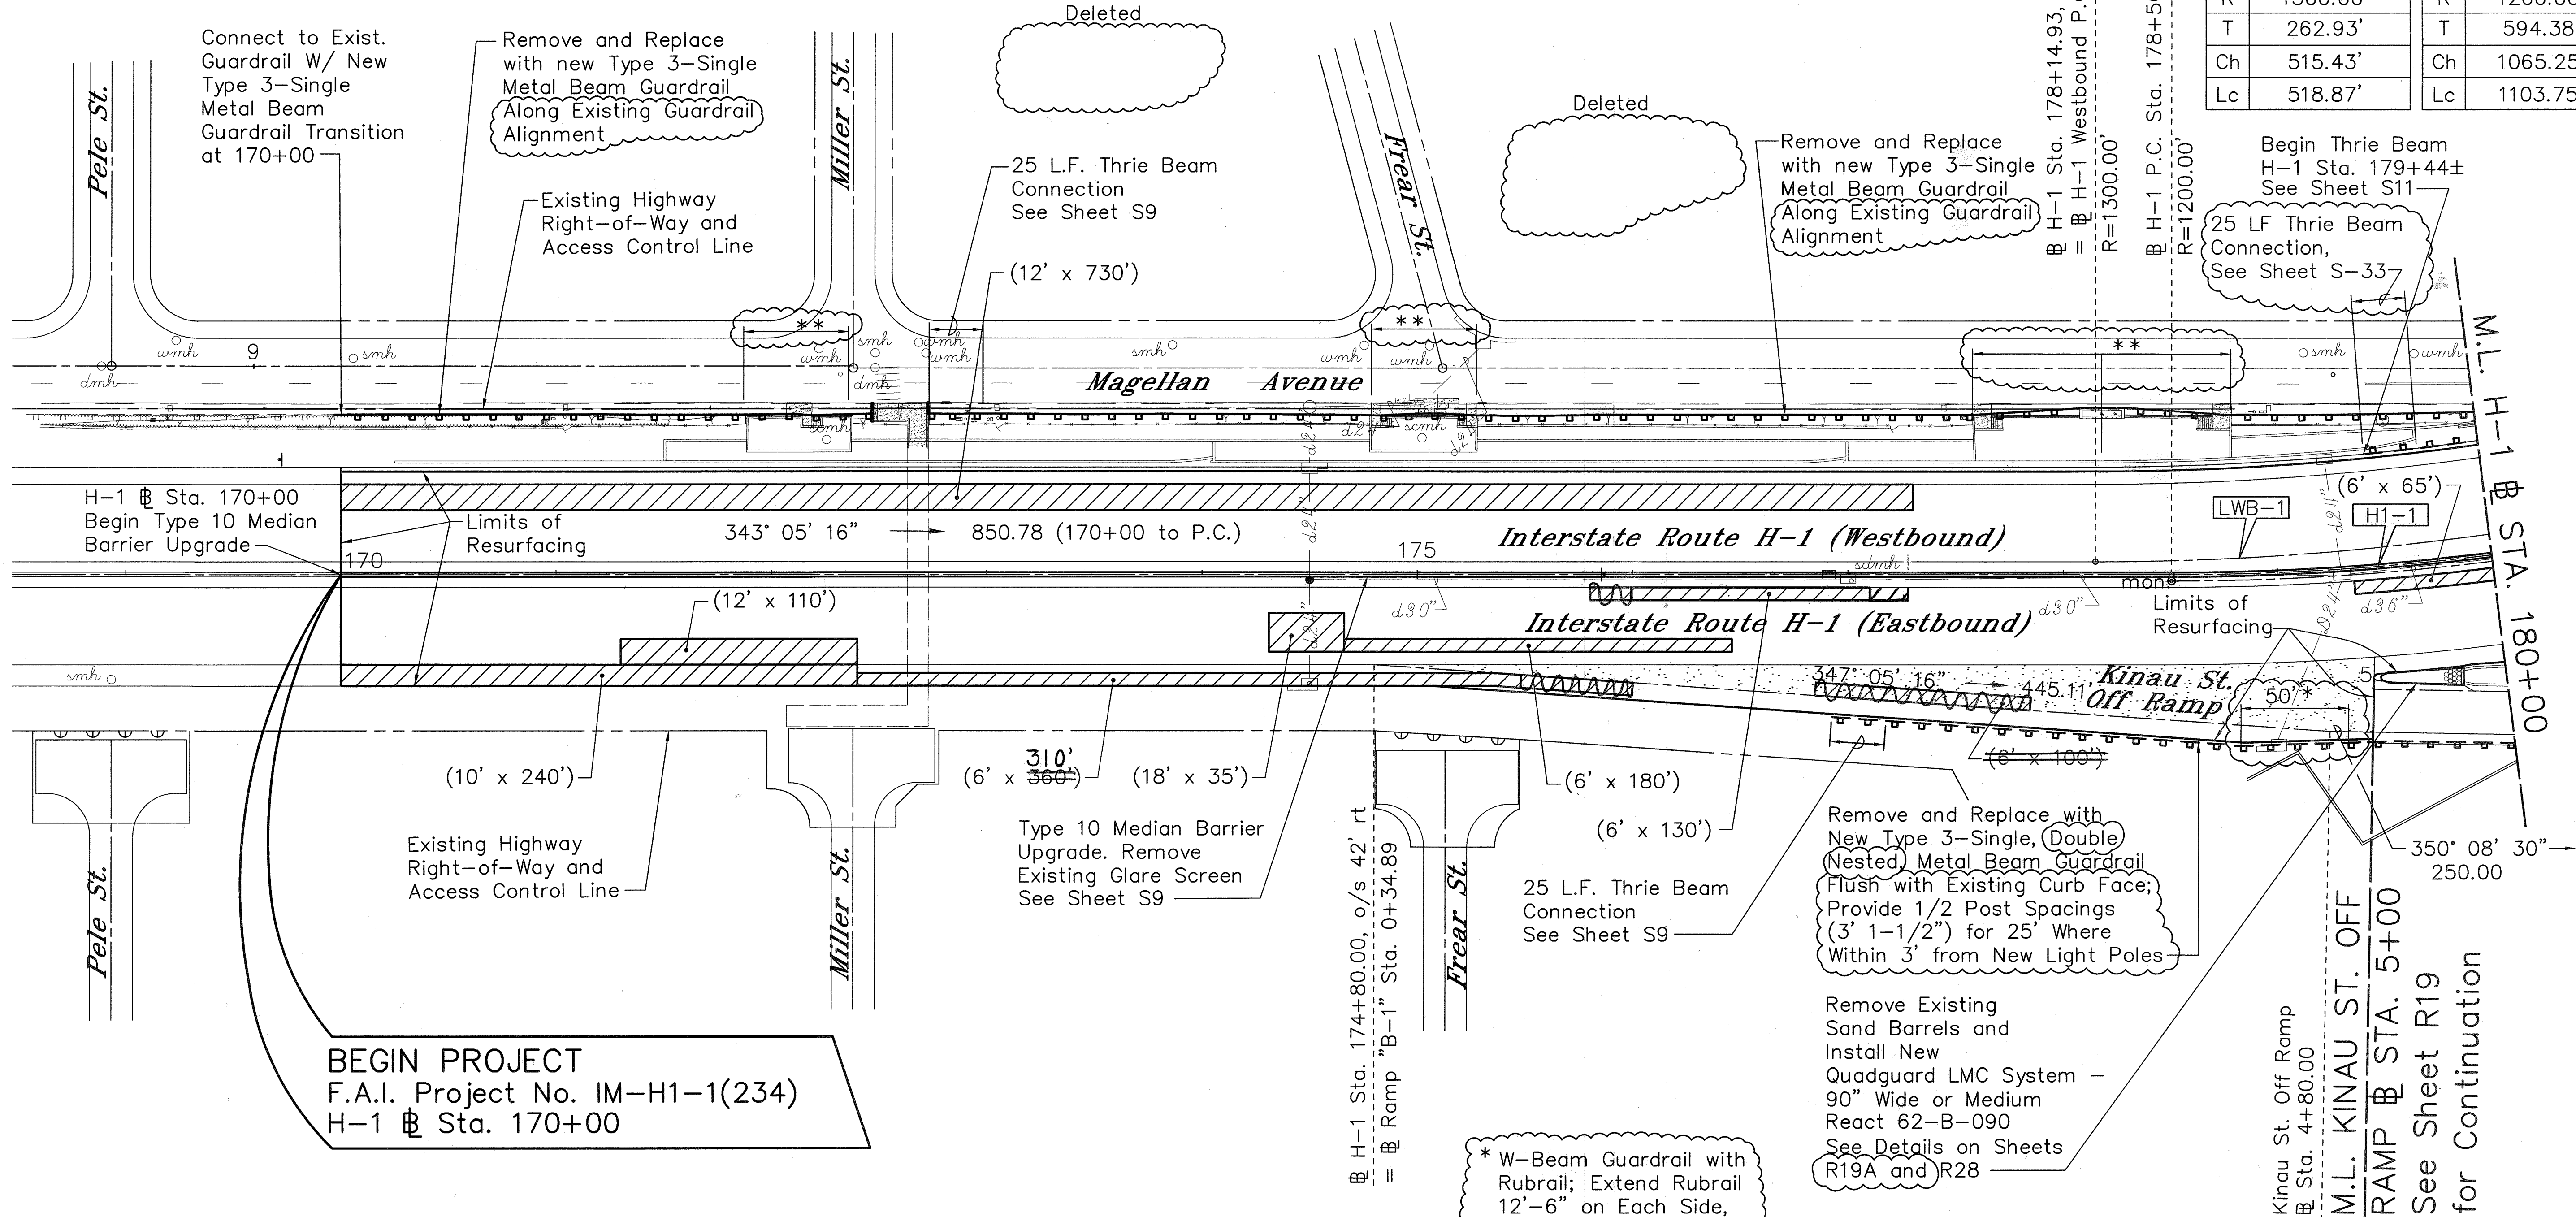

BEGIN PROJECT
F.A.I. Project No. IM-H1-1(234)
H-1 Sta. 170+00

** Locate Guardrail Posts Minimum of 18" from Face of Retaining Wall; Provide 1/2 Post Spacings (3'-1 1/2") and Double Nest as Required. Also, Provide 4' Wide by 4' High Pedestrian Gates with Fork Latches and Locks and 2 Gate Posts to Block Stairwells to Observation Decks.
Note for Maintenance: Remove Top and Bottom Male Strap Hinges to Remove Gate to Gain Access to Observation Decks, as Required.

* W-Beam Guardrail with Rubrail; Extend Rubrail 12'-6" on Each Side, All in Accordance with Details on Sheet B-6 25'-0" Double Nested W-Beam Guardrail at Catch Basin, See Detail B SD25A

Existing Utility/Drain Manhole Frames and Covers to Remain

STATE OF HAWAII
DEPARTMENT OF TRANSPORTATION
HIGHWAYS DIVISION
ROADWAY PLAN
INTERSTATE ROUTE H-1 RESURFACING
Vic. of Punchbowl Off Ramp to Kapiolani IC
F.A.I. Project No. IM-H1-1(234)
Scale: 1"=40' Date: June 1, 1999
SHEET NO. R1 OF 34 SHEETS

ROTATED: 73° 11' 04.08"
AT 0.0
DATE: 6/17/98
SCALE: 1" = 40'
FILE: 9815-08A

ORIGINAL PLAN	DATE
DRAWN BY	DATE
DESIGNED BY	DATE
CHECKED BY	DATE
NOTED BY	DATE
FILED BY	DATE


"AS-BUILT"

TRUE NORTH
SCALE: 1" = 40'

CURVE DATA			
	LWB-1		LWB-2
Δ	22° 56' 06"	Δ	29° 49' 54"
R	1300.00'	R	1200.00'
T	262.93'	T	319.65'
Ch	515.43'	Ch	617.76'
Lc	518.87'	Lc	624.81'

CURVE DATA			
	H1-1		
Δ	52° 42' 00"		
R	1,200.00'		
T	594.38'		
Ch	1065.25'		
Lc	1103.75'		

FED. ROAD DIST. NO.	STATE	FED. AID PROJ. NO.	FISCAL YEAR	SHEET NO.	TOTAL SHEETS
HAWAII	HAW.	IM-H1-1(234)	2000	30	557

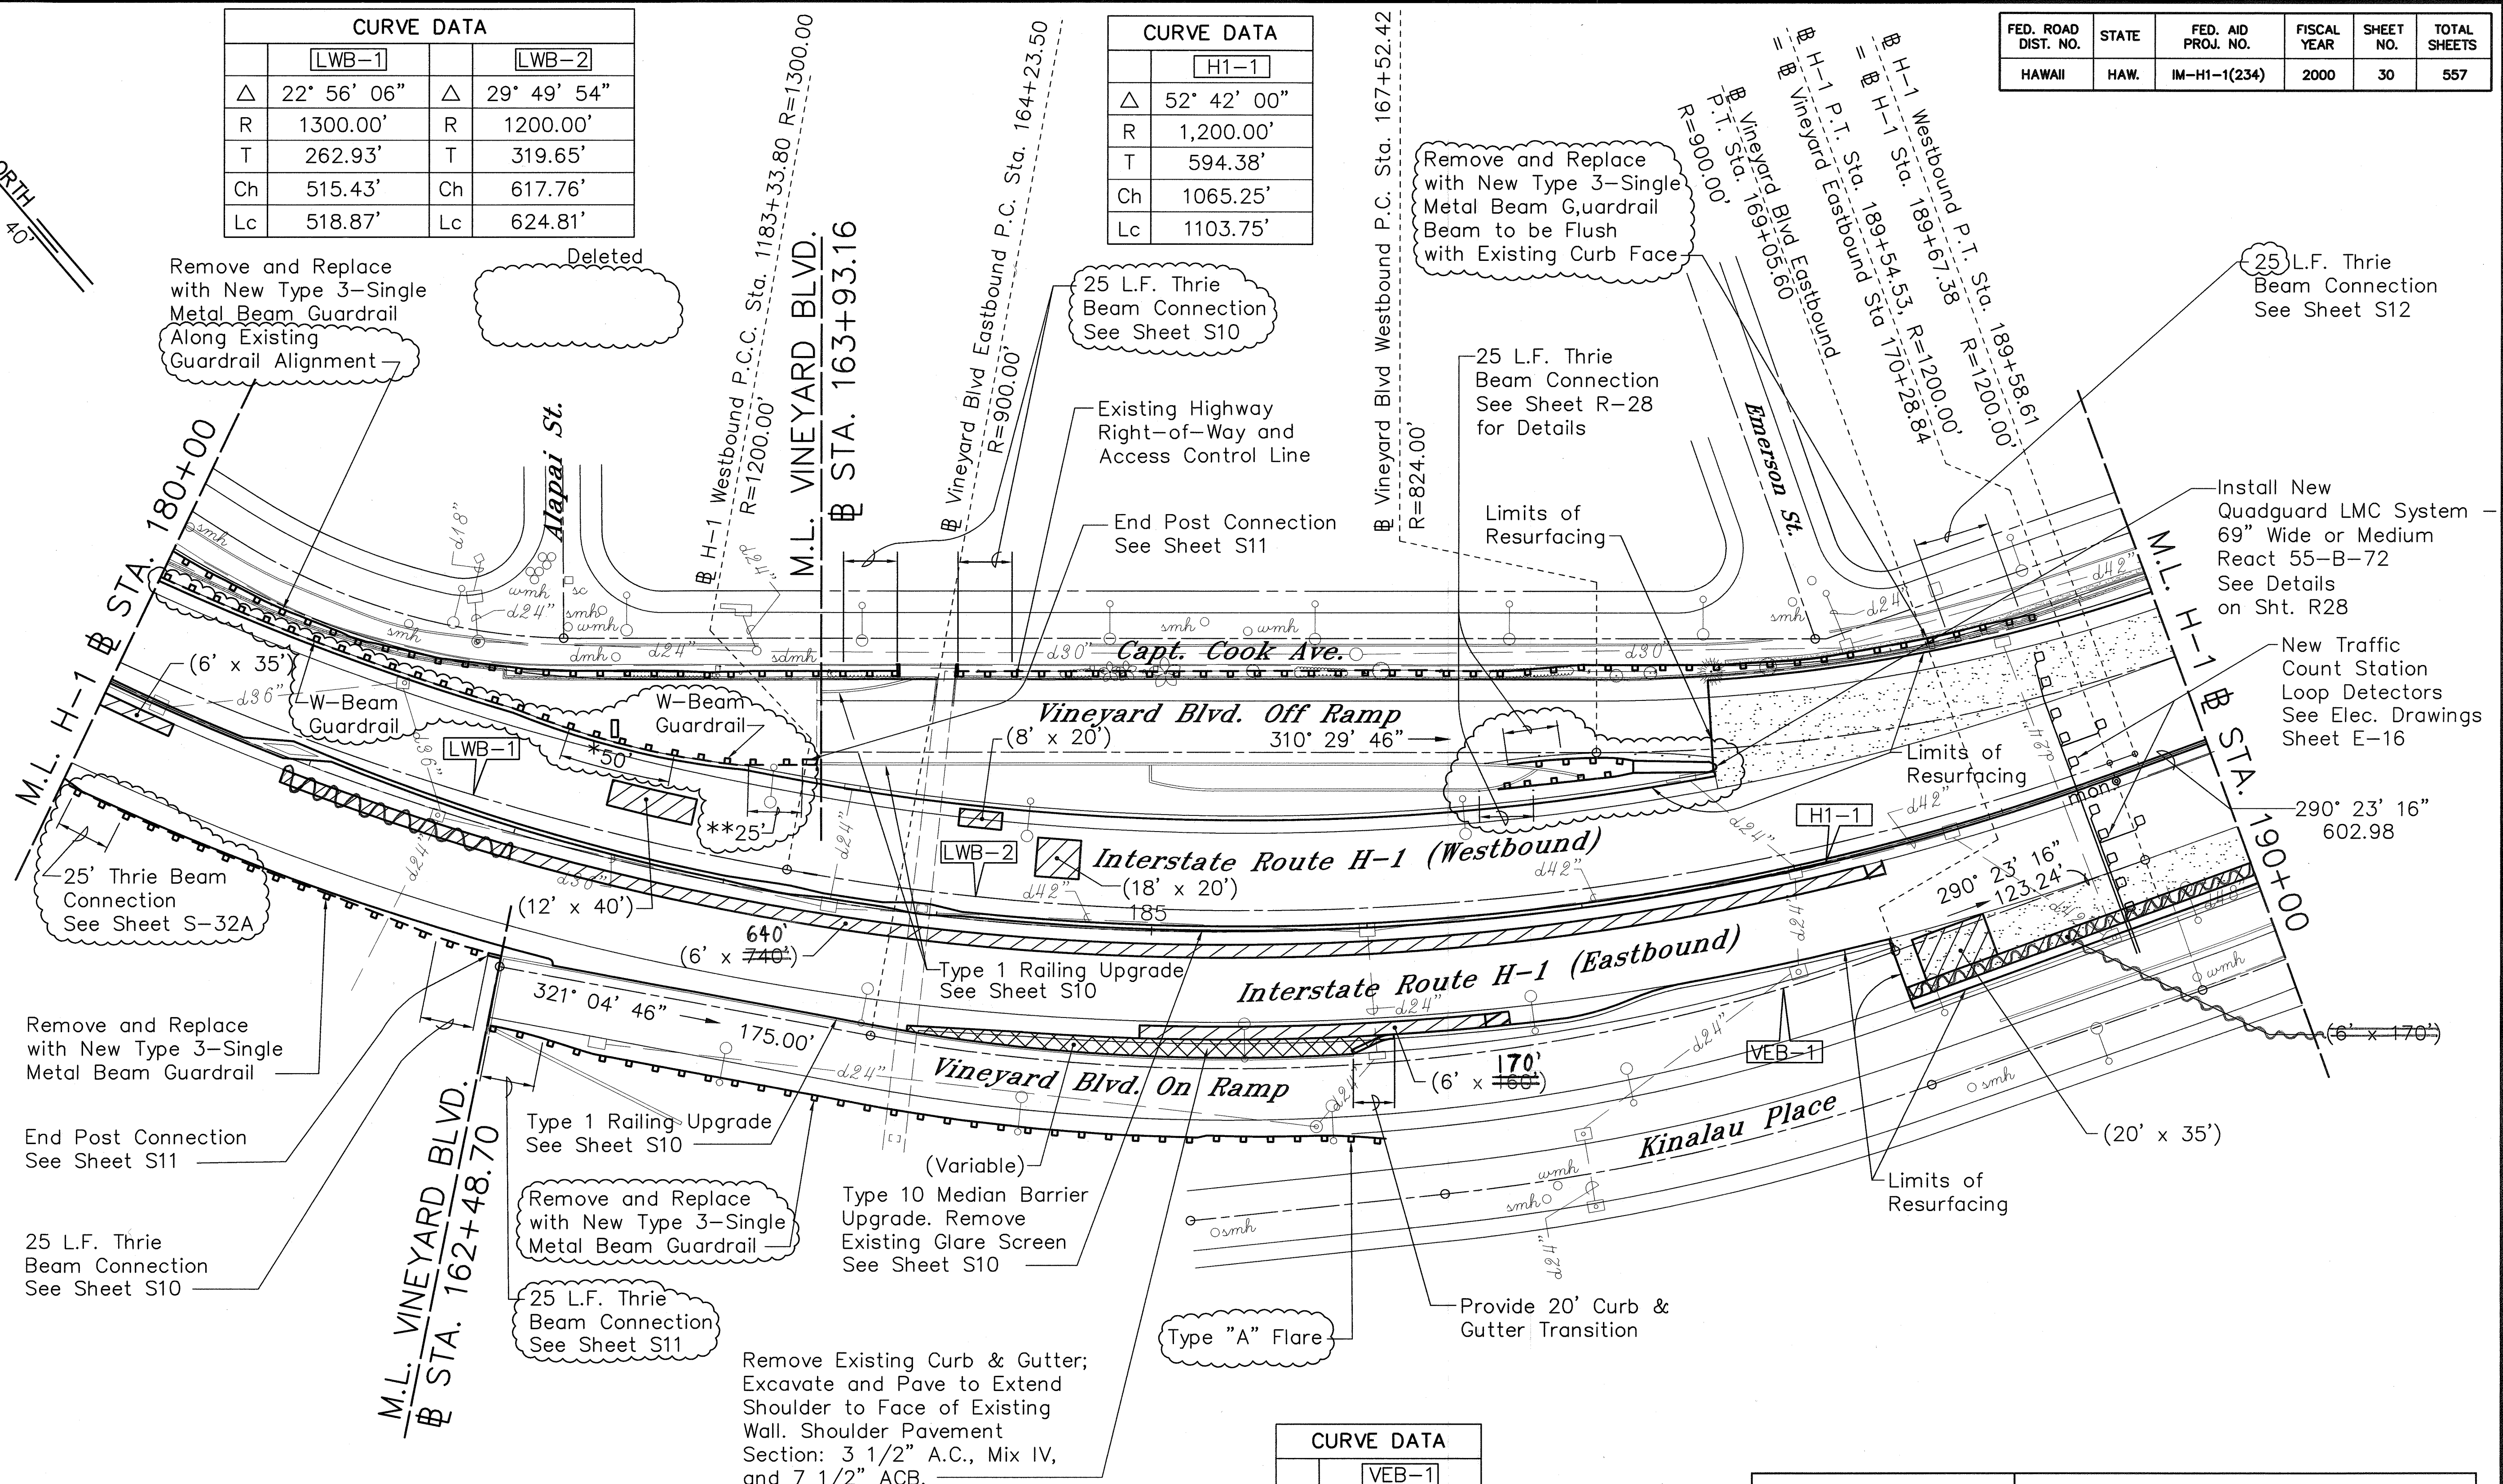

* W-Beam Guardrail with Rubrail; Extend Rubrail 12'-6" on Each Side, All in Accordance with Details on Sheet B-6

** Thrie Beam Connection, See Sheet S-33

CURVE DATA			
	VEB-1		
Δ	30° 41' 00"		
R	900.00'		
T	246.98'		
Ch	476.36'		
Lc	482.10'		

BENJAMIN S. TANAKA
LICENSED PROFESSIONAL ENGINEER
No. 2055-C
HAWAII, U.S.A.

THIS WORK WAS PREPARED BY ME OR UNDER MY SUPERVISION

Benjamin S. Tanaka

STATE OF HAWAII
DEPARTMENT OF TRANSPORTATION
HIGHWAYS DIVISION

ROADWAY PLAN

INTERSTATE ROUTE H-1 RESURFACING
Vic. of Punchbowl Off Ramp to Kapiolani IC
F.A.I. Project No. IM-H1-1(234)

Scale: 1"=40' Date: June 1, 1999

SHEET NO. R2 OF 34 SHEETS

ROTATED: 40° 35' 34.08" AT 0,0

DATE: 6/17/98
SCALE: 1" = 40'

FILE: 9815-09



SURVEY PLATTED BY: _____
DRAWN BY: _____
DESIGNED BY: _____
CHECKED BY: _____

ORIGINAL PLAN: _____
NOTED: _____
NO. _____

"AS-BUILT"

FED. ROAD DIST. NO.	STATE	FED. AID PROJ. NO.	FISCAL YEAR	SHEET NO.	TOTAL SHEETS
HAWAII	HAW.	IM-H1-1(234)	2000	31	557

CURVE DATA	
	H1-2
Δ	0° 29' 04"
R	25,000.00
T	105.69'
Ch	211.38'
Lc	211.38'

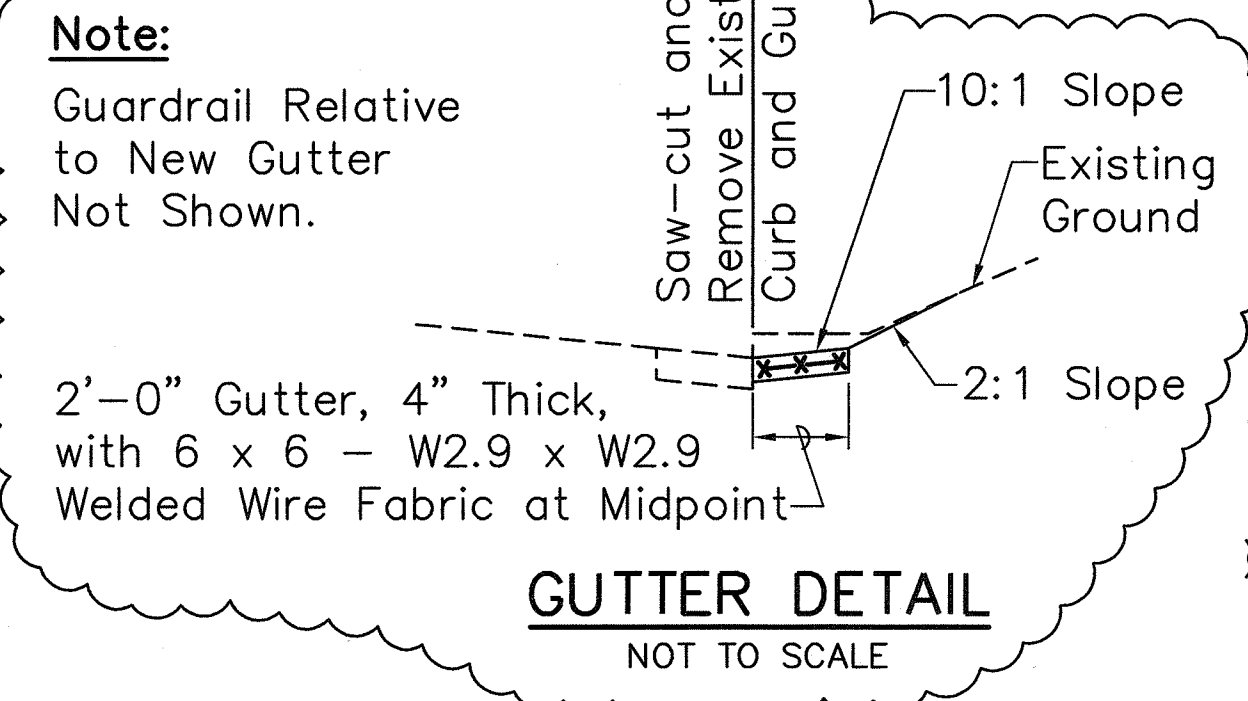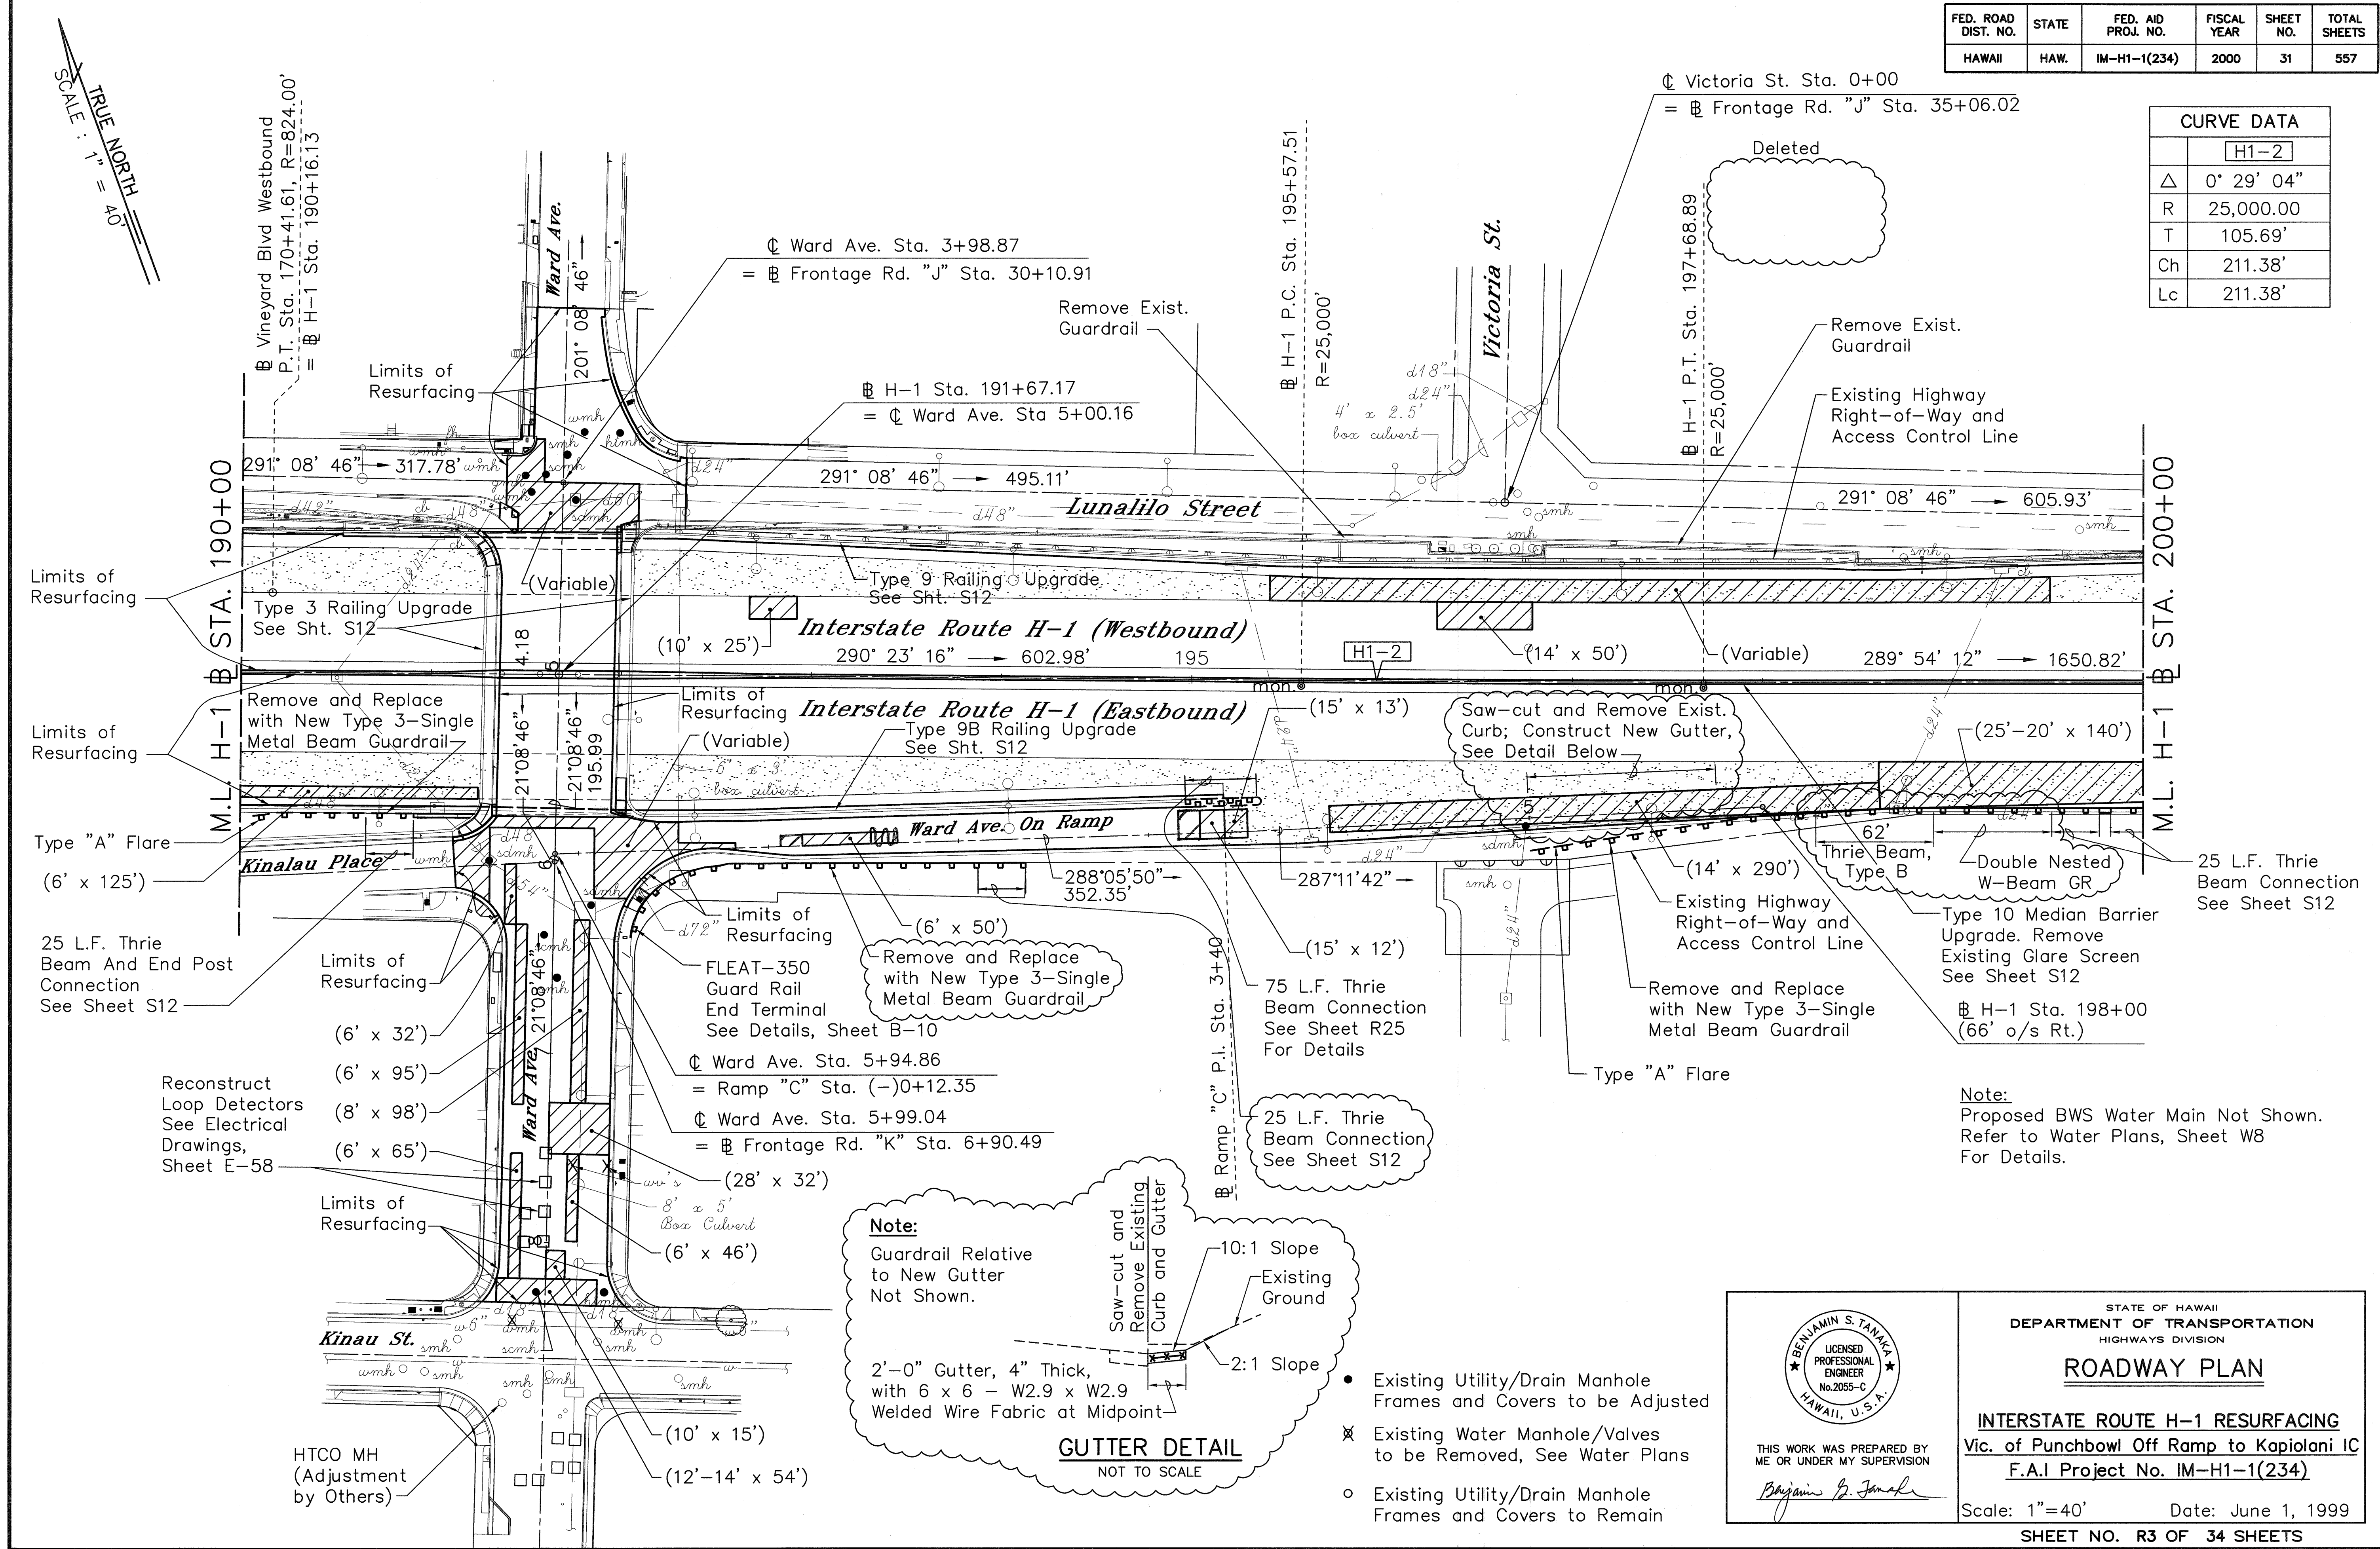

- Existing Utility/Drain Manhole Frames and Covers to be Adjusted
- Existing Water Manhole/Valves to be Removed, See Water Plans
- Existing Utility/Drain Manhole Frames and Covers to Remain

THIS WORK WAS PREPARED BY ME OR UNDER MY SUPERVISION

Benjamin S. Tanaka

STATE OF HAWAII
DEPARTMENT OF TRANSPORTATION
HIGHWAYS DIVISION


ROADWAY PLAN

INTERSTATE ROUTE H-1 RESURFACING
Vic. of Punchbowl Off Ramp to Kapiolani IC
F.A.I. Project No. IM-H1-1(234)

Scale: 1"=40' Date: June 1, 1999

SHEET NO. R3 OF 34 SHEETS

FED. ROAD DIST. NO.	STATE	FED. AID PROJ. NO.	FISCAL YEAR	SHEET NO.	TOTAL SHEETS
HAWAII	HAW.	IM-H1-1(234)	2000	32	557

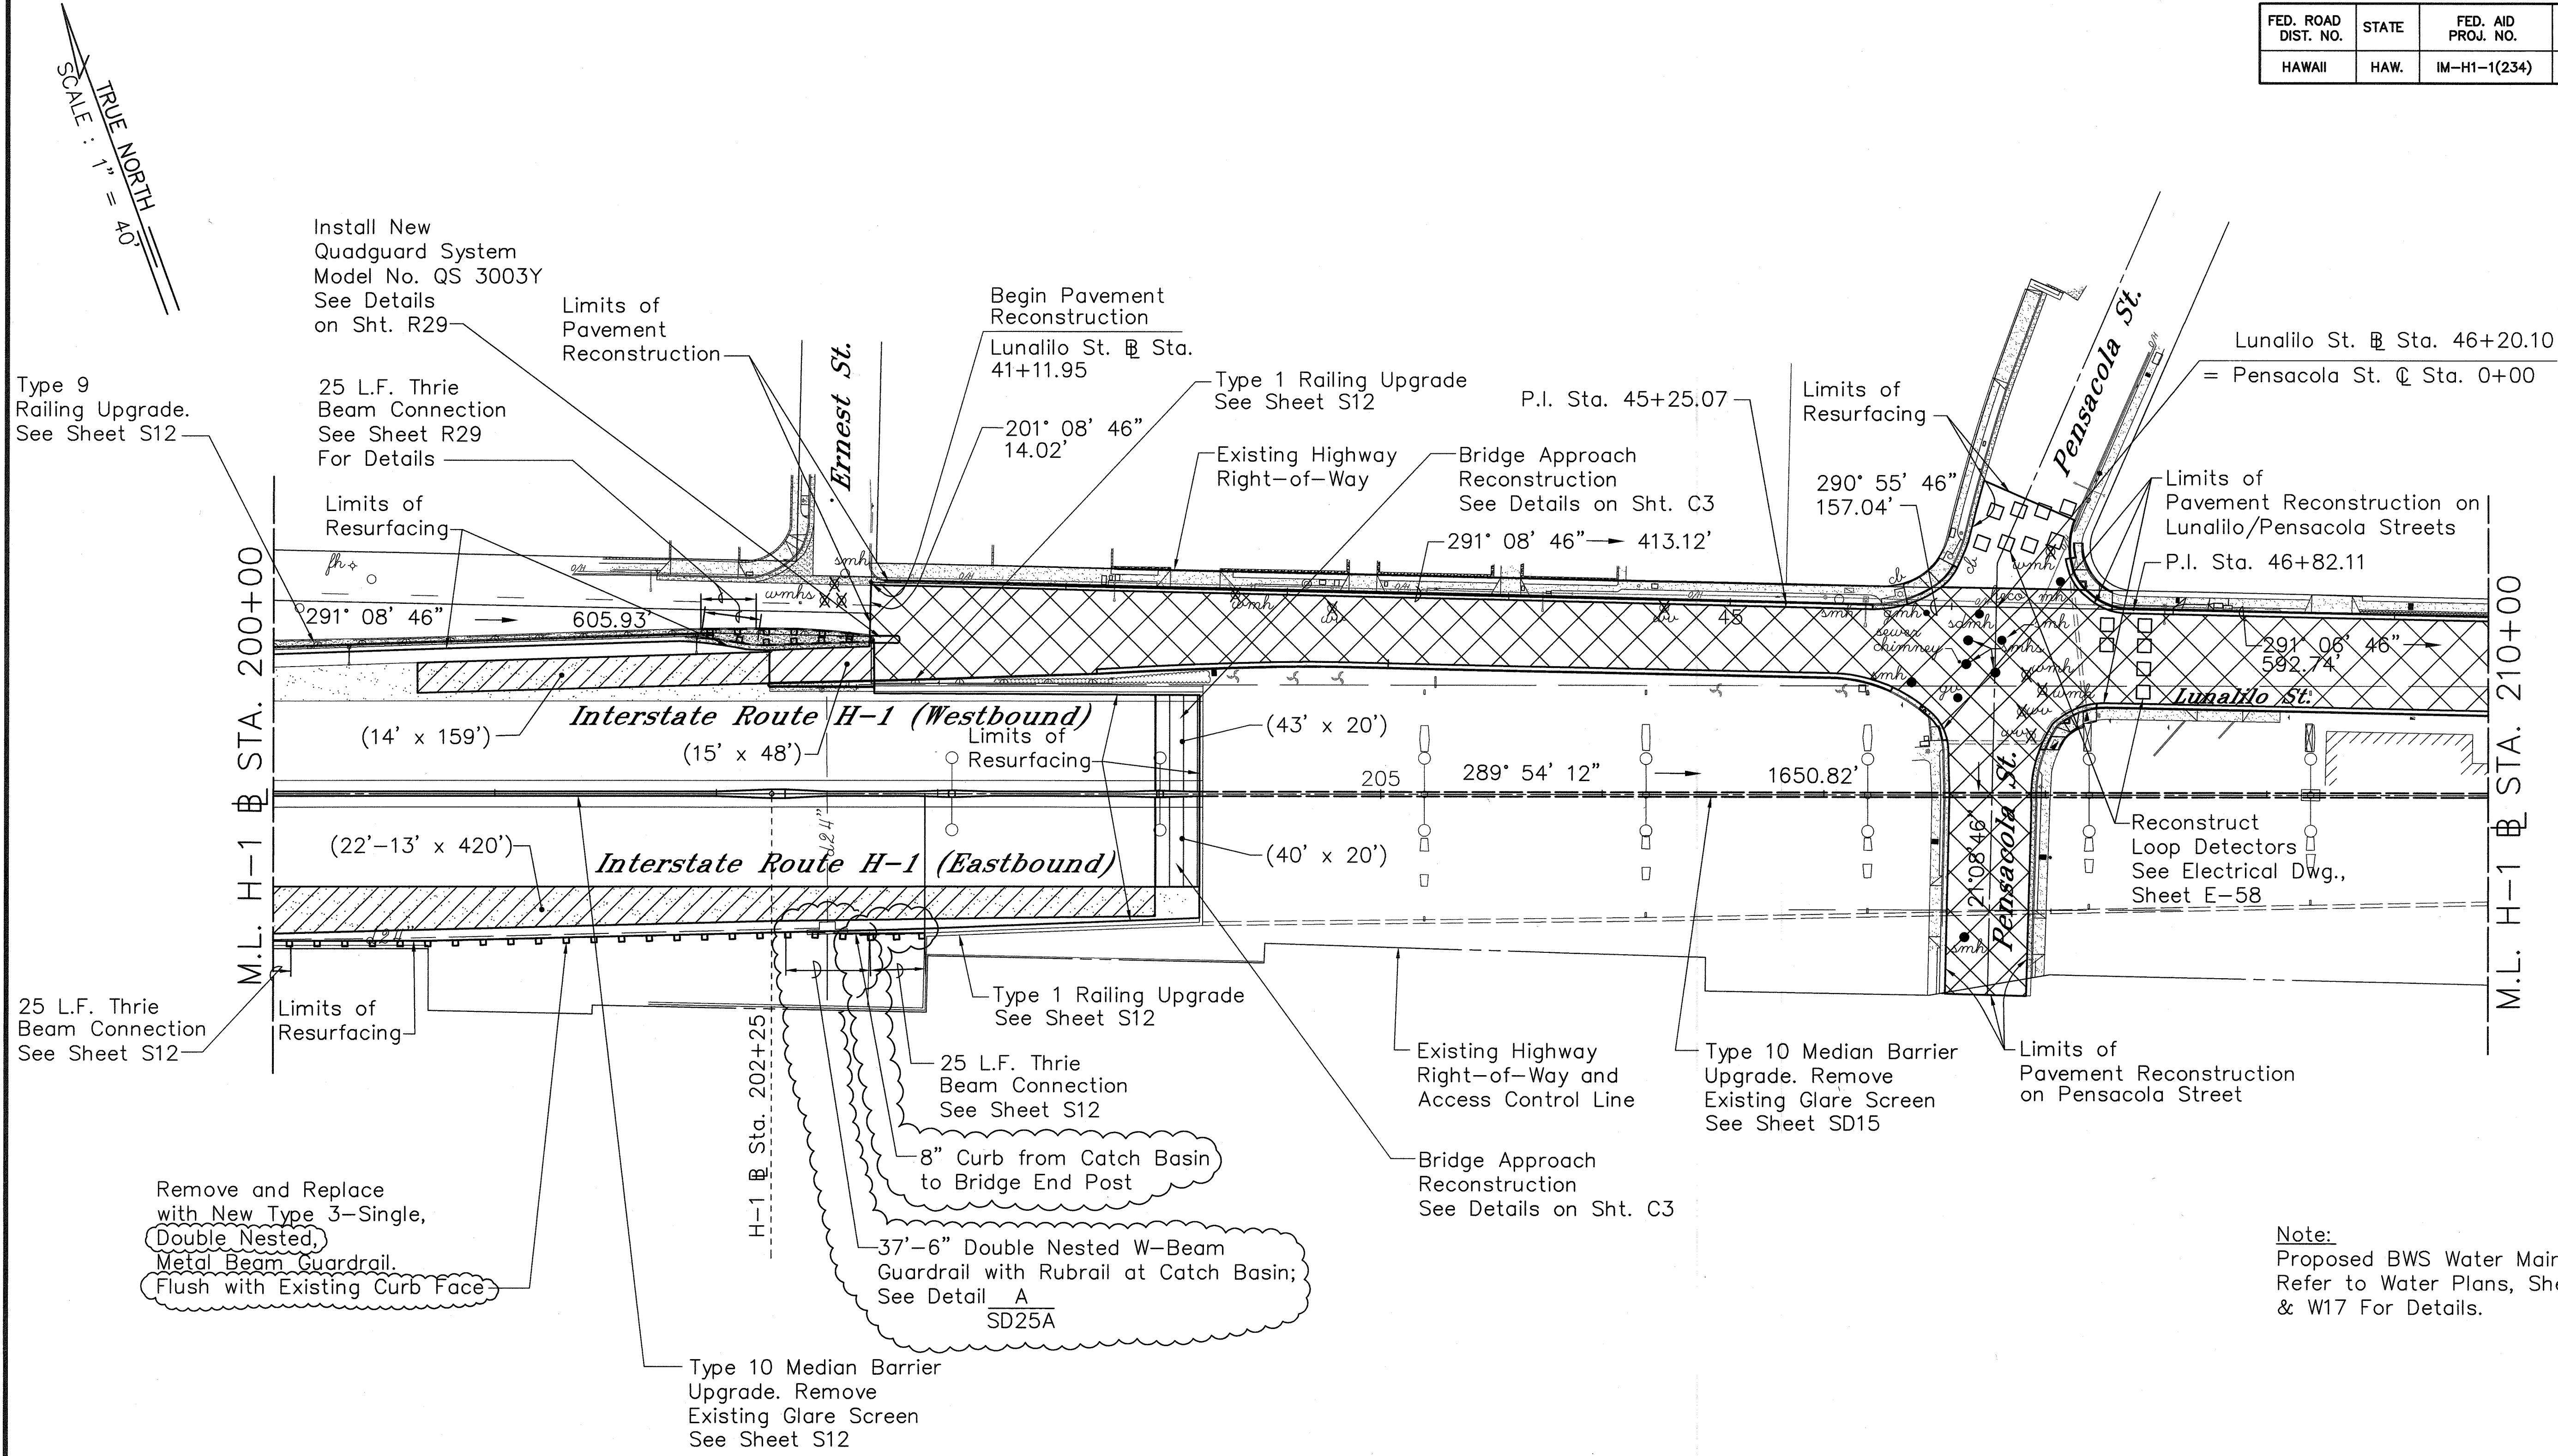

Note:
Proposed BWS Water Main(s) Not Shown.
Refer to Water Plans, Sheet(s) W9, W10
& W17 For Details.

ROTATED: 20' 00" 0.08"
AT 0.0

DATE: 6/17/98
SCALE: 1" = 40'

FILE: 9815-11

PM: BST
OPER: SHA, FAL
REVISED: 09/28/00

SURVEY PLATTED BY	DATE
DRAWN BY	
DESIGNED BY	
QUANTITIES BY	
CHECKED BY	

ORIGINAL PLAN	No.
NOTED	

- Existing Utility/Drain Manhole Frames and Covers to be Adjusted
- Existing Water Manhole/Valves to be Removed, See Water Plans
- Existing Utility/Drain Manhole Frames and Covers to Remain

THIS WORK WAS PREPARED BY ME OR UNDER MY SUPERVISION

Benjamin S. Tanaka

STATE OF HAWAII
DEPARTMENT OF TRANSPORTATION
HIGHWAYS DIVISION

ROADWAY PLAN


INTERSTATE ROUTE H-1 RESURFACING
Vic. of Punchbowl Off Ramp to Kapiolani IC
F.A.I Project No. IM-H1-1(234)

Scale: 1"=40' Date: June 1, 1999

SHEET NO. R4 OF 34 SHEETS

FED. ROAD DIST. NO.	STATE	FED. AID PROJ. NO.	FISCAL YEAR	SHEET NO.	TOTAL SHEETS
HAWAII	HAW.	IM-H1-1(234)	2000	33	557


TRUE NORTH
SCALE: 1" = 40'

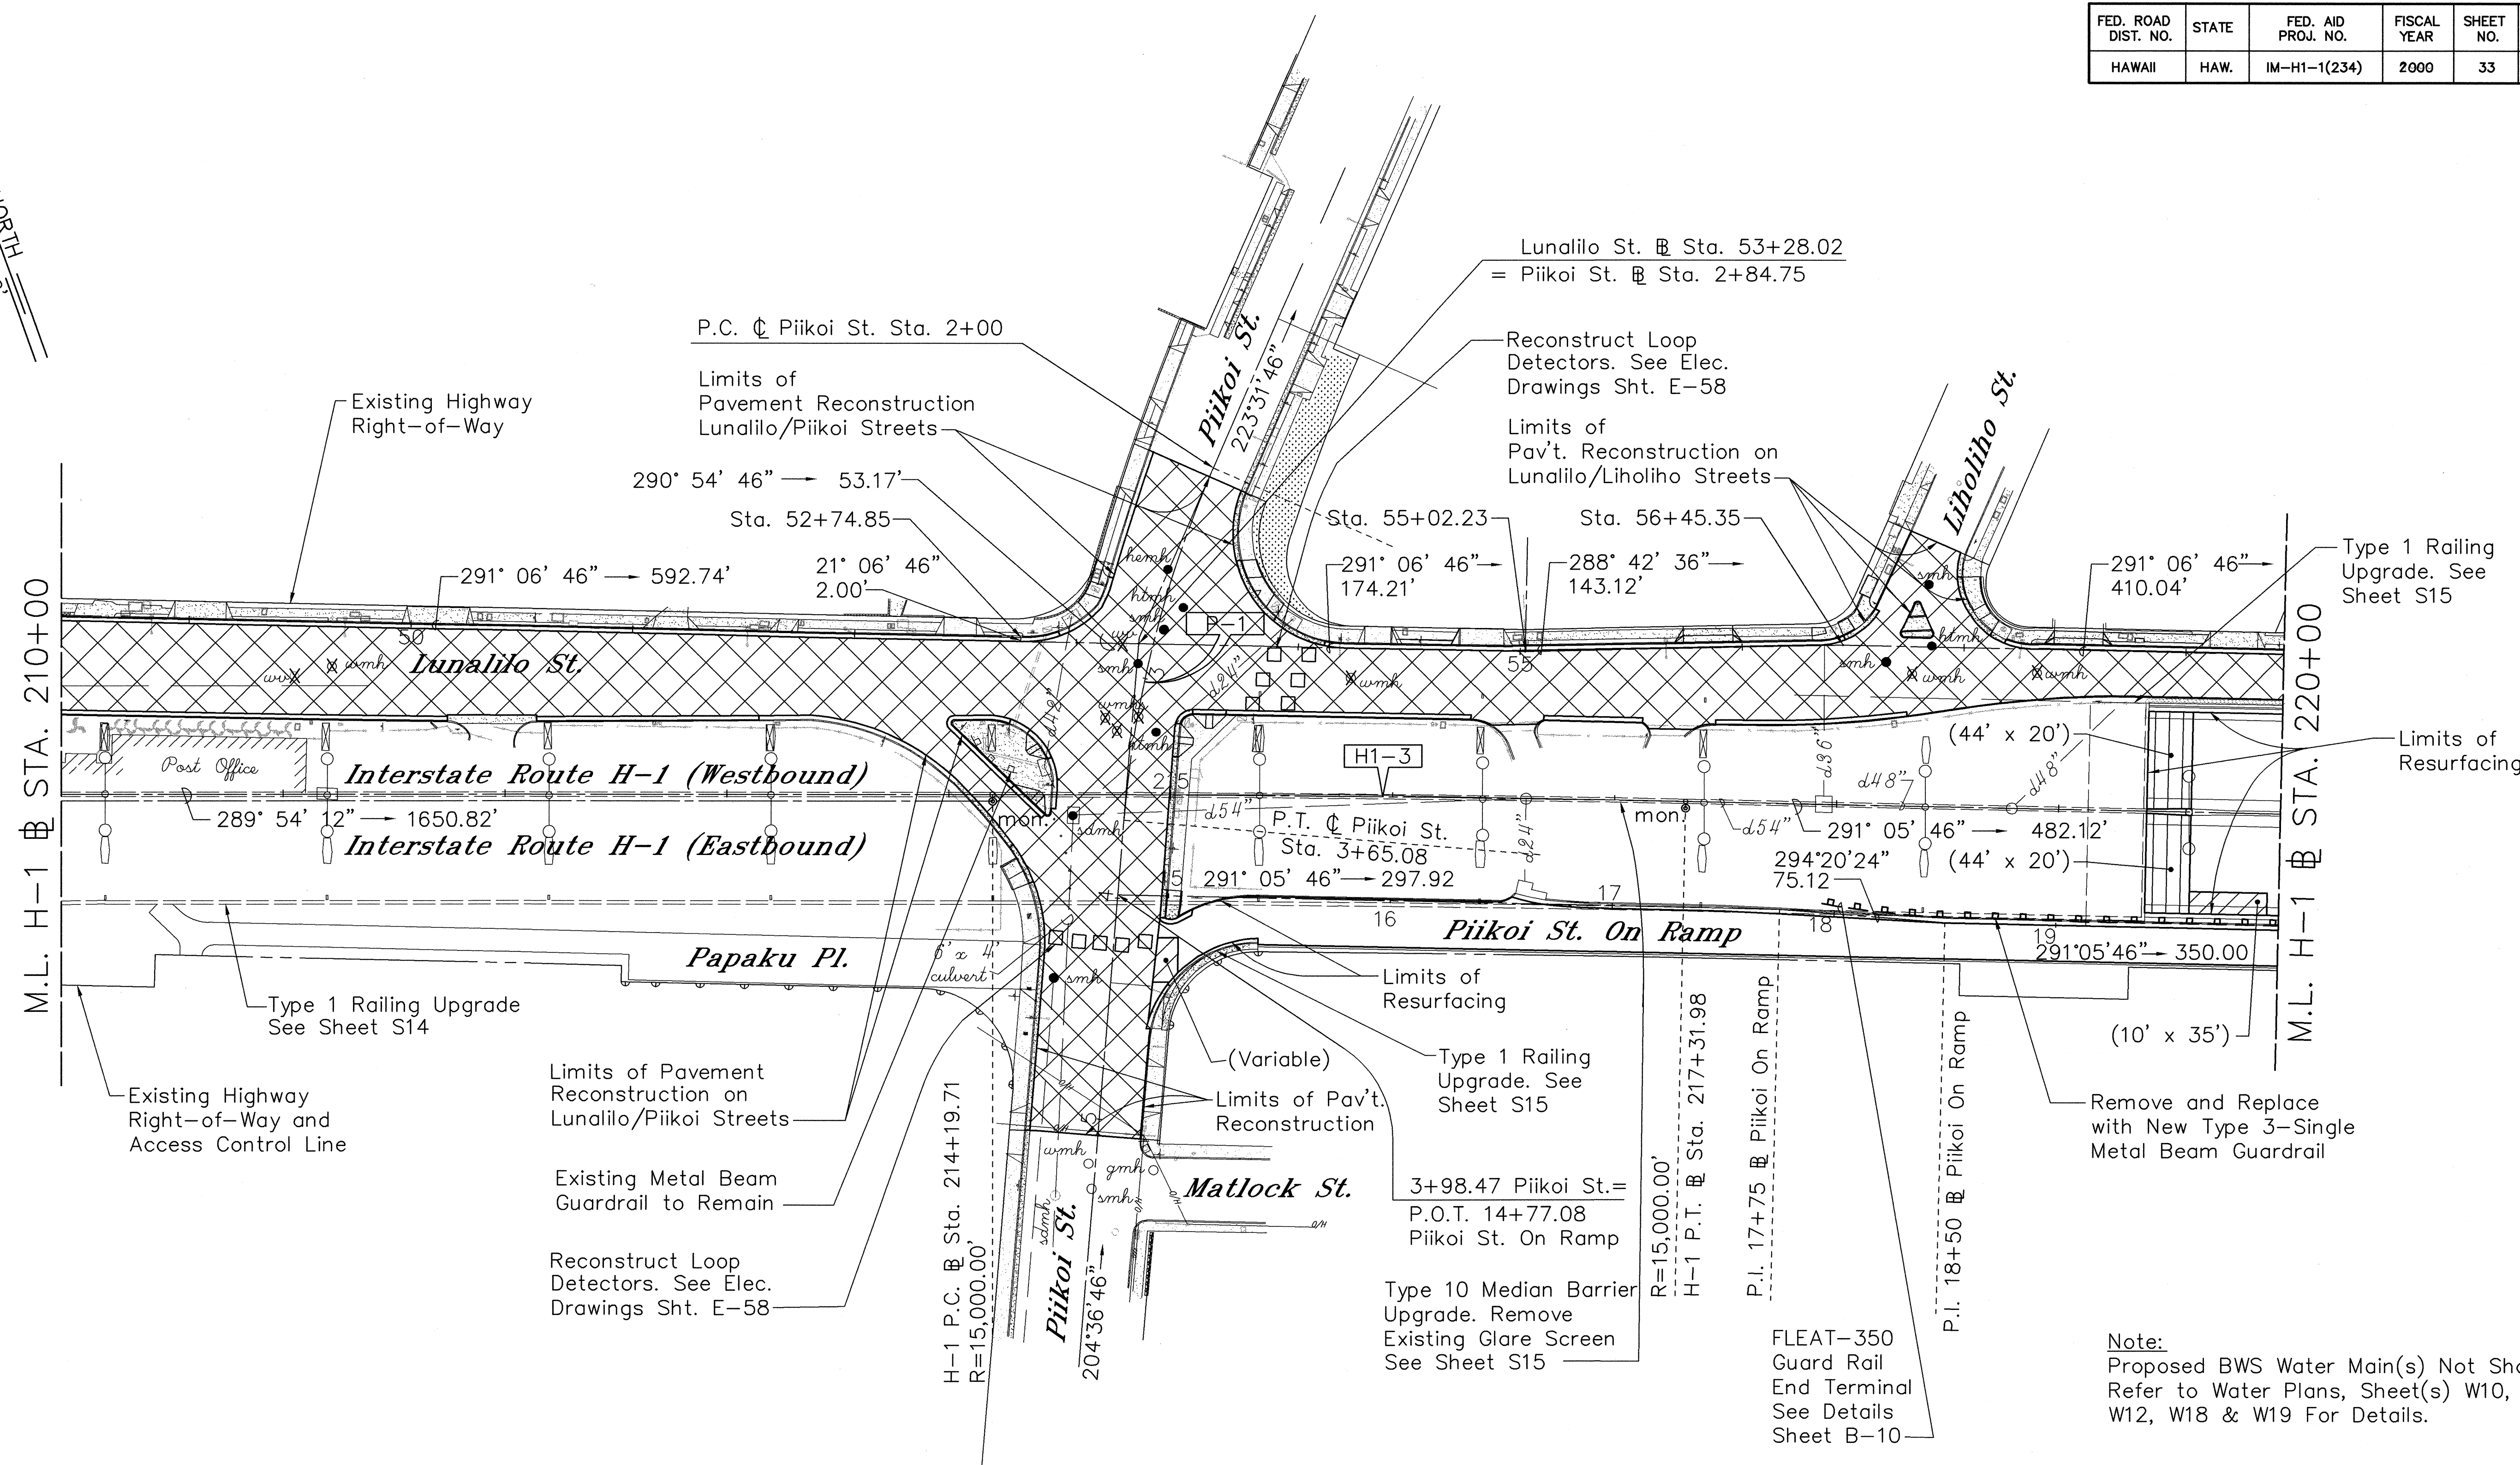

CURVE DATA	
	H1-3
Δ	1° 11' 34"
R	15,000.00'
T	156.14'
Ch	312.26'
Lc	312.27'

CURVE DATA	
	P-1
Δ	18° 55' 00"
R	500.00
T	83.30
Ch	165.08
Lc	164.33

- Existing Utility/Drain Manhole Frames and Covers to be Adjusted
- Existing Water Manhole/Valves to be Removed, See Water Plans
- Existing Utility/Drain Manhole Frames and Covers to Remain

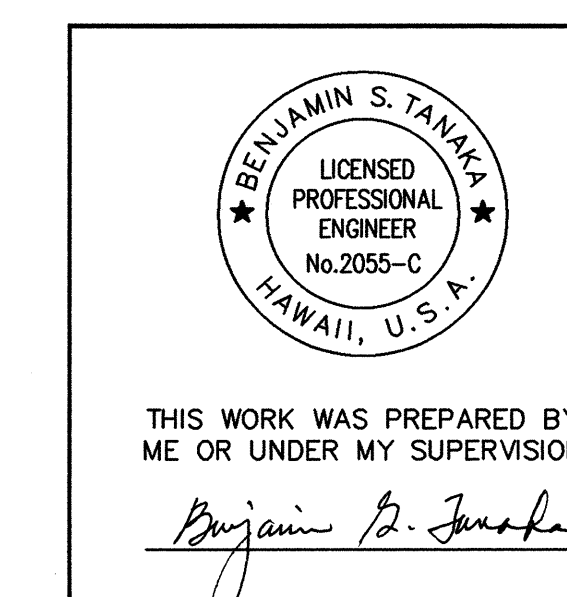

STATE OF HAWAII
DEPARTMENT OF TRANSPORTATION
HIGHWAYS DIVISION


ROADWAY PLAN

INTERSTATE ROUTE H-1 RESURFACING
Vic. of Punchbowl Off Ramp to Kapiolani IC
F.A.I. Project No. IM-H1-1(234)

Scale: 1"=40' Date: June 1, 1999

SHEET NO. R5 OF 34 SHEETS


FED. ROAD DIST. NO.	STATE	FED. AID PROJ. NO.	FISCAL YEAR	SHEET NO.	TOTAL SHEETS
HAWAII	HAW.	IM-H1-1(234)	2000	34	557

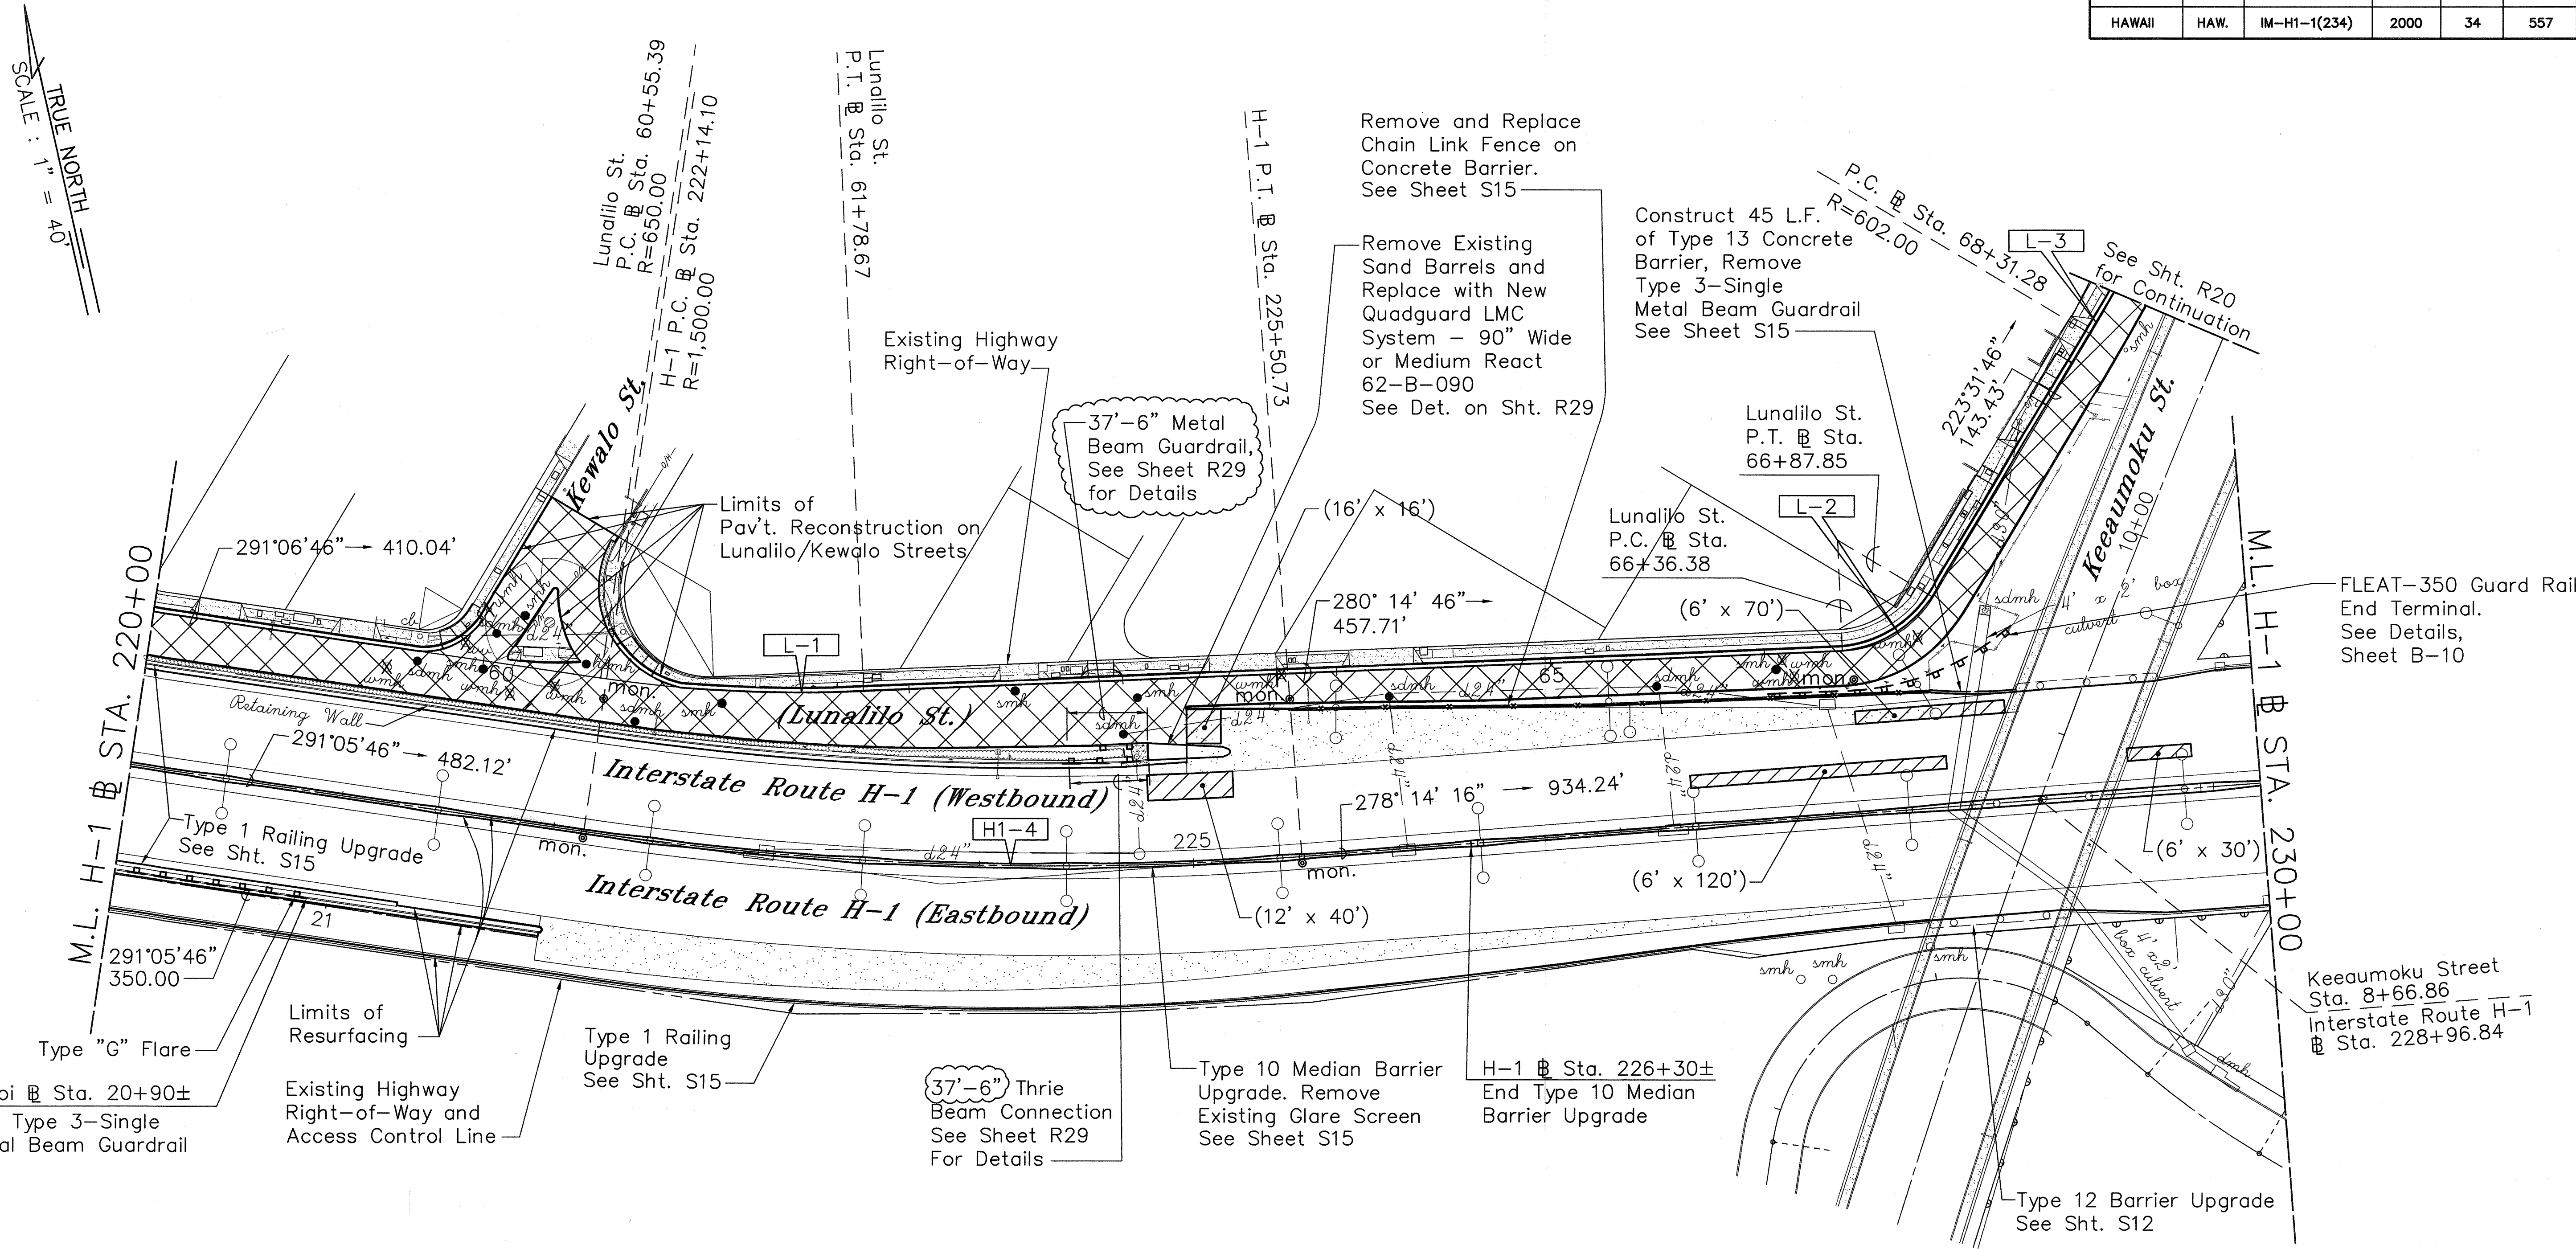

Note:
Proposed BWS Water Main(s) Not Shown.
Refer to Water Plans, Sheet(s) W12, W13
& W14 For Details.

CURVE DATA				
	H1-4	L-1	L-2	L-3
Δ	12° 51' 30"	10° 52' 00"	56° 43' 00"	7° 17' 51"
R	1,500.00'	650.00'	52.00'	602.00'
T	169.03'	61.82'	28.07'	38.39'
Ch	335.92'	123.09'	49.40'	76.62'
Lc	336.63'	123.28'	51.47'	76.67'

- Existing Utility/Drain Manhole Frames and Covers to be Adjusted
- Existing Water Manhole/Valves to be Removed, See Water Plans
- Existing Utility/Drain Manhole Frames and Covers to Remain

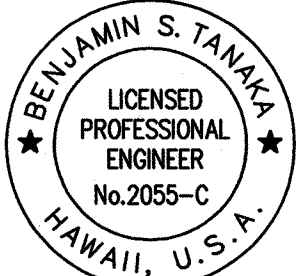

THIS WORK WAS PREPARED BY ME OR UNDER MY SUPERVISION

Benjamin S. Tanaka

STATE OF HAWAII
DEPARTMENT OF TRANSPORTATION
HIGHWAYS DIVISION

ROADWAY PLAN

INTERSTATE ROUTE H-1 RESURFACING
Vic. of Punchbowl Off Ramp to Kapiolani IC
F.A.I Project No. IM-H1-1(234)

Scale: 1"=40' Date: June 1, 1999

SHEET NO. R6 OF 34 SHEETS


ROTATED: 12° 47' 55.1"
 AT 0.0
 DATE: 6/17/98
 SCALE: 1" = 40'
 FILE: 9815-13

ORIGINAL PLAN	DATE
SURVEY PLATTED BY	
DRAWN BY	
DESIGNED BY	
QUANTITIES BY	
CHECKED BY	
NOTED BY	
NO.	

"AS-BUILT"

FED. ROAD DIST. NO.	STATE	FED. AID PROJ. NO.	FISCAL YEAR	SHEET NO.	TOTAL SHEETS
HAWAII	HAW.	IM-H1-1(234)	2000	35	557

TRUE NORTH
SCALE: 1" = 40'

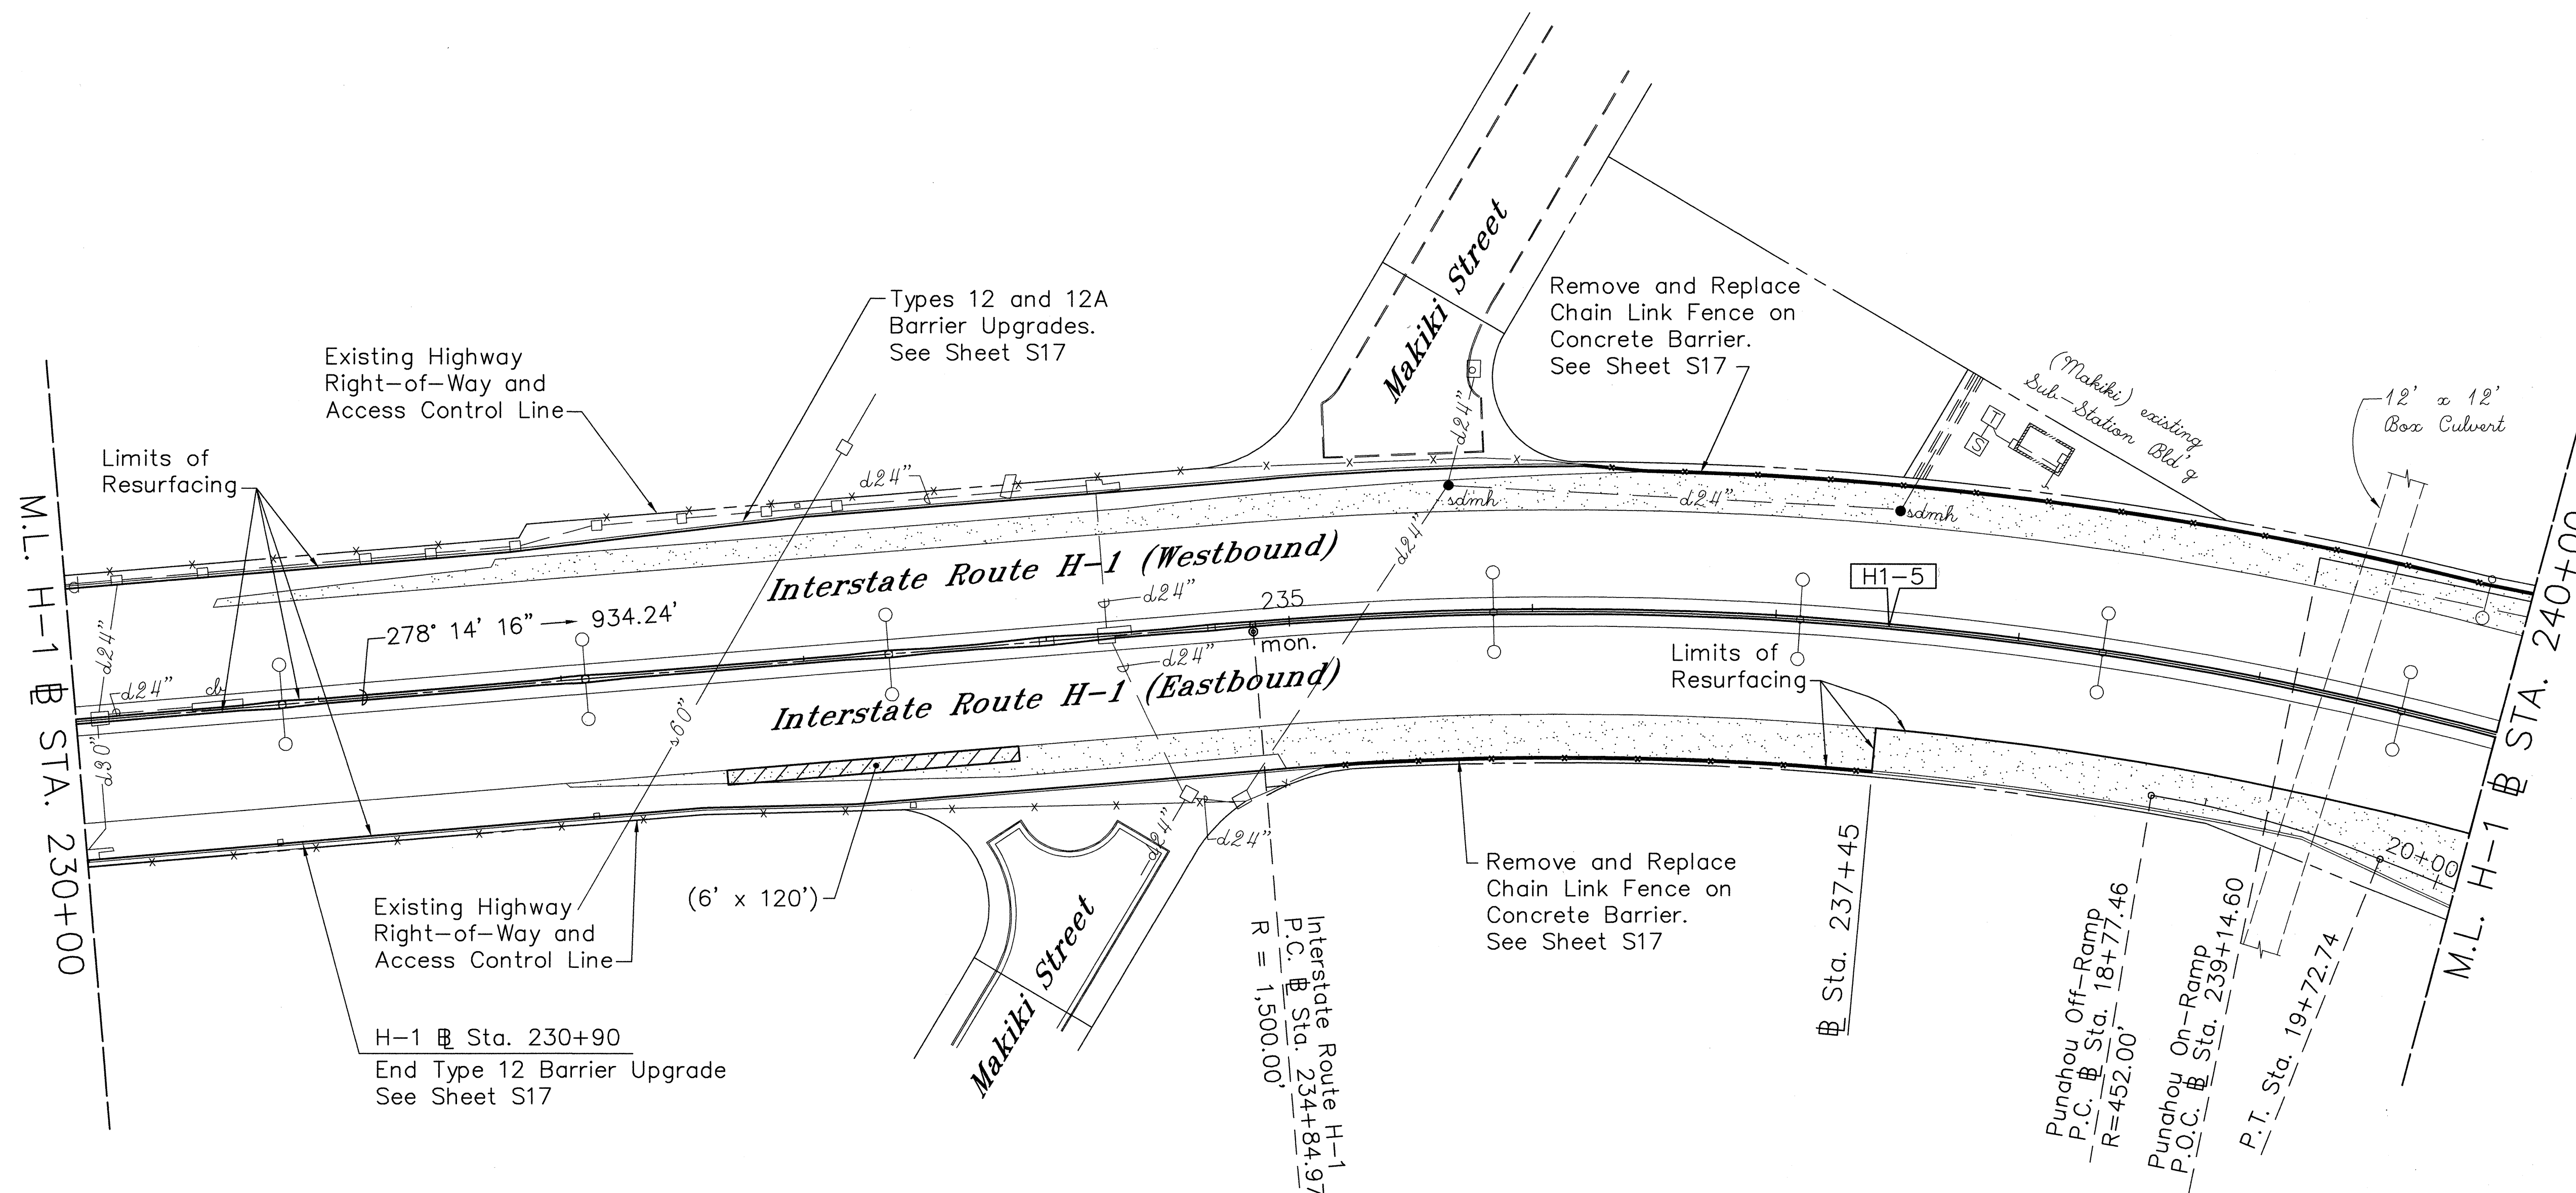

CURVE DATA	
	H1-5
Δ	26° 34' 30"
R	1,500.00'
T	354.24'
Ch	689.51'
Lc	695.73'

- Existing Utility/Drain Manhole Frames and Covers to be Adjusted
- Existing Water Manhole/Valves to be Removed, See Water Plans
- Existing Utility/Drain Manhole Frames and Covers to Remain

BENJAMIN S. TANAKA
LICENSED PROFESSIONAL ENGINEER
No. 2055-C
HAWAII, U.S.A.

THIS WORK WAS PREPARED BY
ME OR UNDER MY SUPERVISION

Benjamin S. Tanaka

STATE OF HAWAII
DEPARTMENT OF TRANSPORTATION
HIGHWAYS DIVISION

ROADWAY PLAN

INTERSTATE ROUTE H-1 RESURFACING
Vic. of Punchbowl Off Ramp to Kapiolani IC
F.A.I Project No. IM-H1-1(234)

Scale: 1"=40' Date: June 1, 1999

SHEET NO. R7 OF 34 SHEETS

ROTATED: 13° 04' 48.97"
AT 0.0


DATE: 6/17/98
SCALE: 1" = 40'
FILE: 9815-14

PM: BST
OPER: SHA, *FAI
REVISED: 05/03/99

ORIGINAL PLAN	DATE
DRAWN BY	
TRACED BY	
QUANTITIES BY	
CHECKED BY	

FED. ROAD DIST. NO.	STATE	FED. AID PROJ. NO.	FISCAL YEAR	SHEET NO.	TOTAL SHEETS
HAWAII	HAW.	IM-H1-1(234)	2000	36	557

TRUE NORTH
SCALE: 1" = 40'

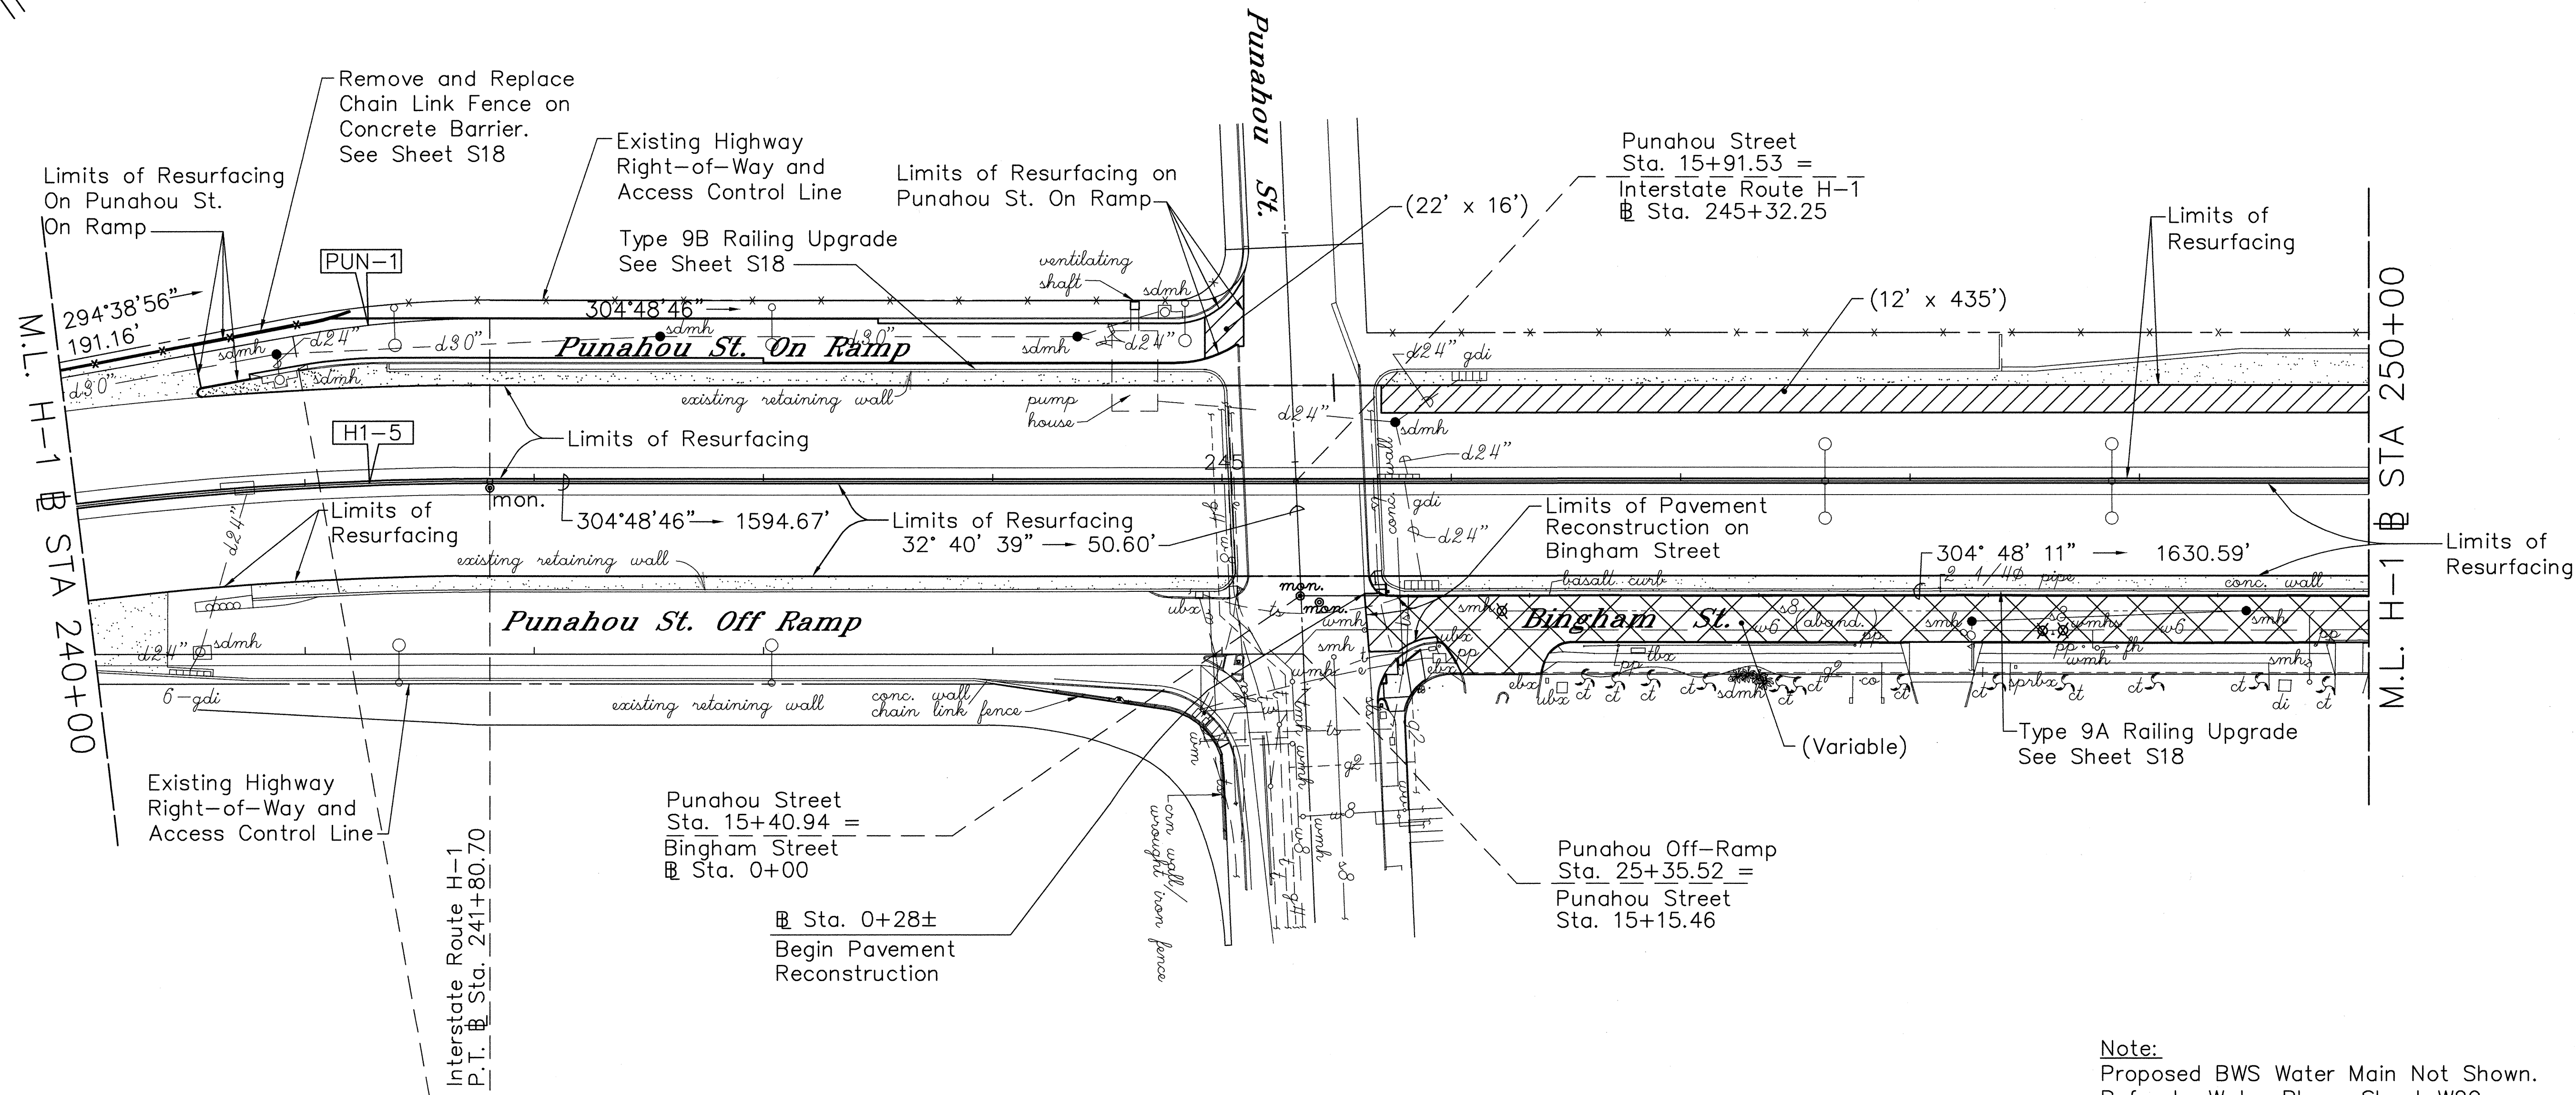

ROTATED: 34° 52' 0.08"
AT 0.0


DATE: 6/17/98
SCALE: 1" = 40'
FILE: 9815-15

ORIGINAL PLAN	DATE
SURVEY PLOTTED BY	
DRAWN BY	
DESIGNED BY	
QUANTITIES BY	
CHECKED BY	
NO.	

CURVE DATA	
	[H1-5]
Δ	26° 34' 30"
R	1,500.00'
T	354.24'
Ch	689.51'
Lc	695.73'

CURVE DATA	
	[PUN-1]
Δ	10° 09' 50"
R	487.82'
T	43.38'
Ch	86.42'
Lc	86.54'

- Existing Utility/Drain Manhole Frames and Covers to be Adjusted
- Existing Water Manhole/Valves to be Removed, See Water Plans
- Existing Utility/Drain Manhole Frames and Covers to Remain

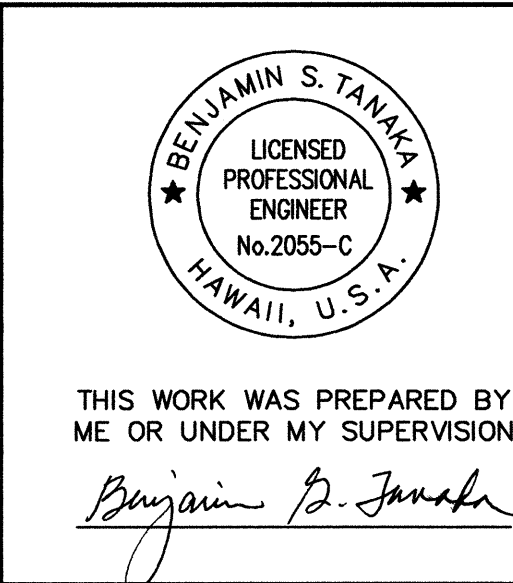

STATE OF HAWAII
DEPARTMENT OF TRANSPORTATION
HIGHWAYS DIVISION

ROADWAY PLAN

INTERSTATE ROUTE H-1 RESURFACING
Vic. of Punchbowl Off Ramp to Kapiolani IC
F.A.I Project No. IM-H1-1(234)


Scale: 1"=40' Date: June 1, 1999

SHEET NO. R8 OF 34 SHEETS

Note:
Proposed BWS Water Main Not Shown.
Refer to Water Plans, Sheet W20
For Details.

FED. ROAD DIST. NO.	STATE	FED. AID PROJ. NO.	FISCAL YEAR	SHEET NO.	TOTAL SHEETS
HAWAII	HAW.	IM-H1-1(234)	2000	38	557

TRUE NORTH
SCALE: 1" = 40'

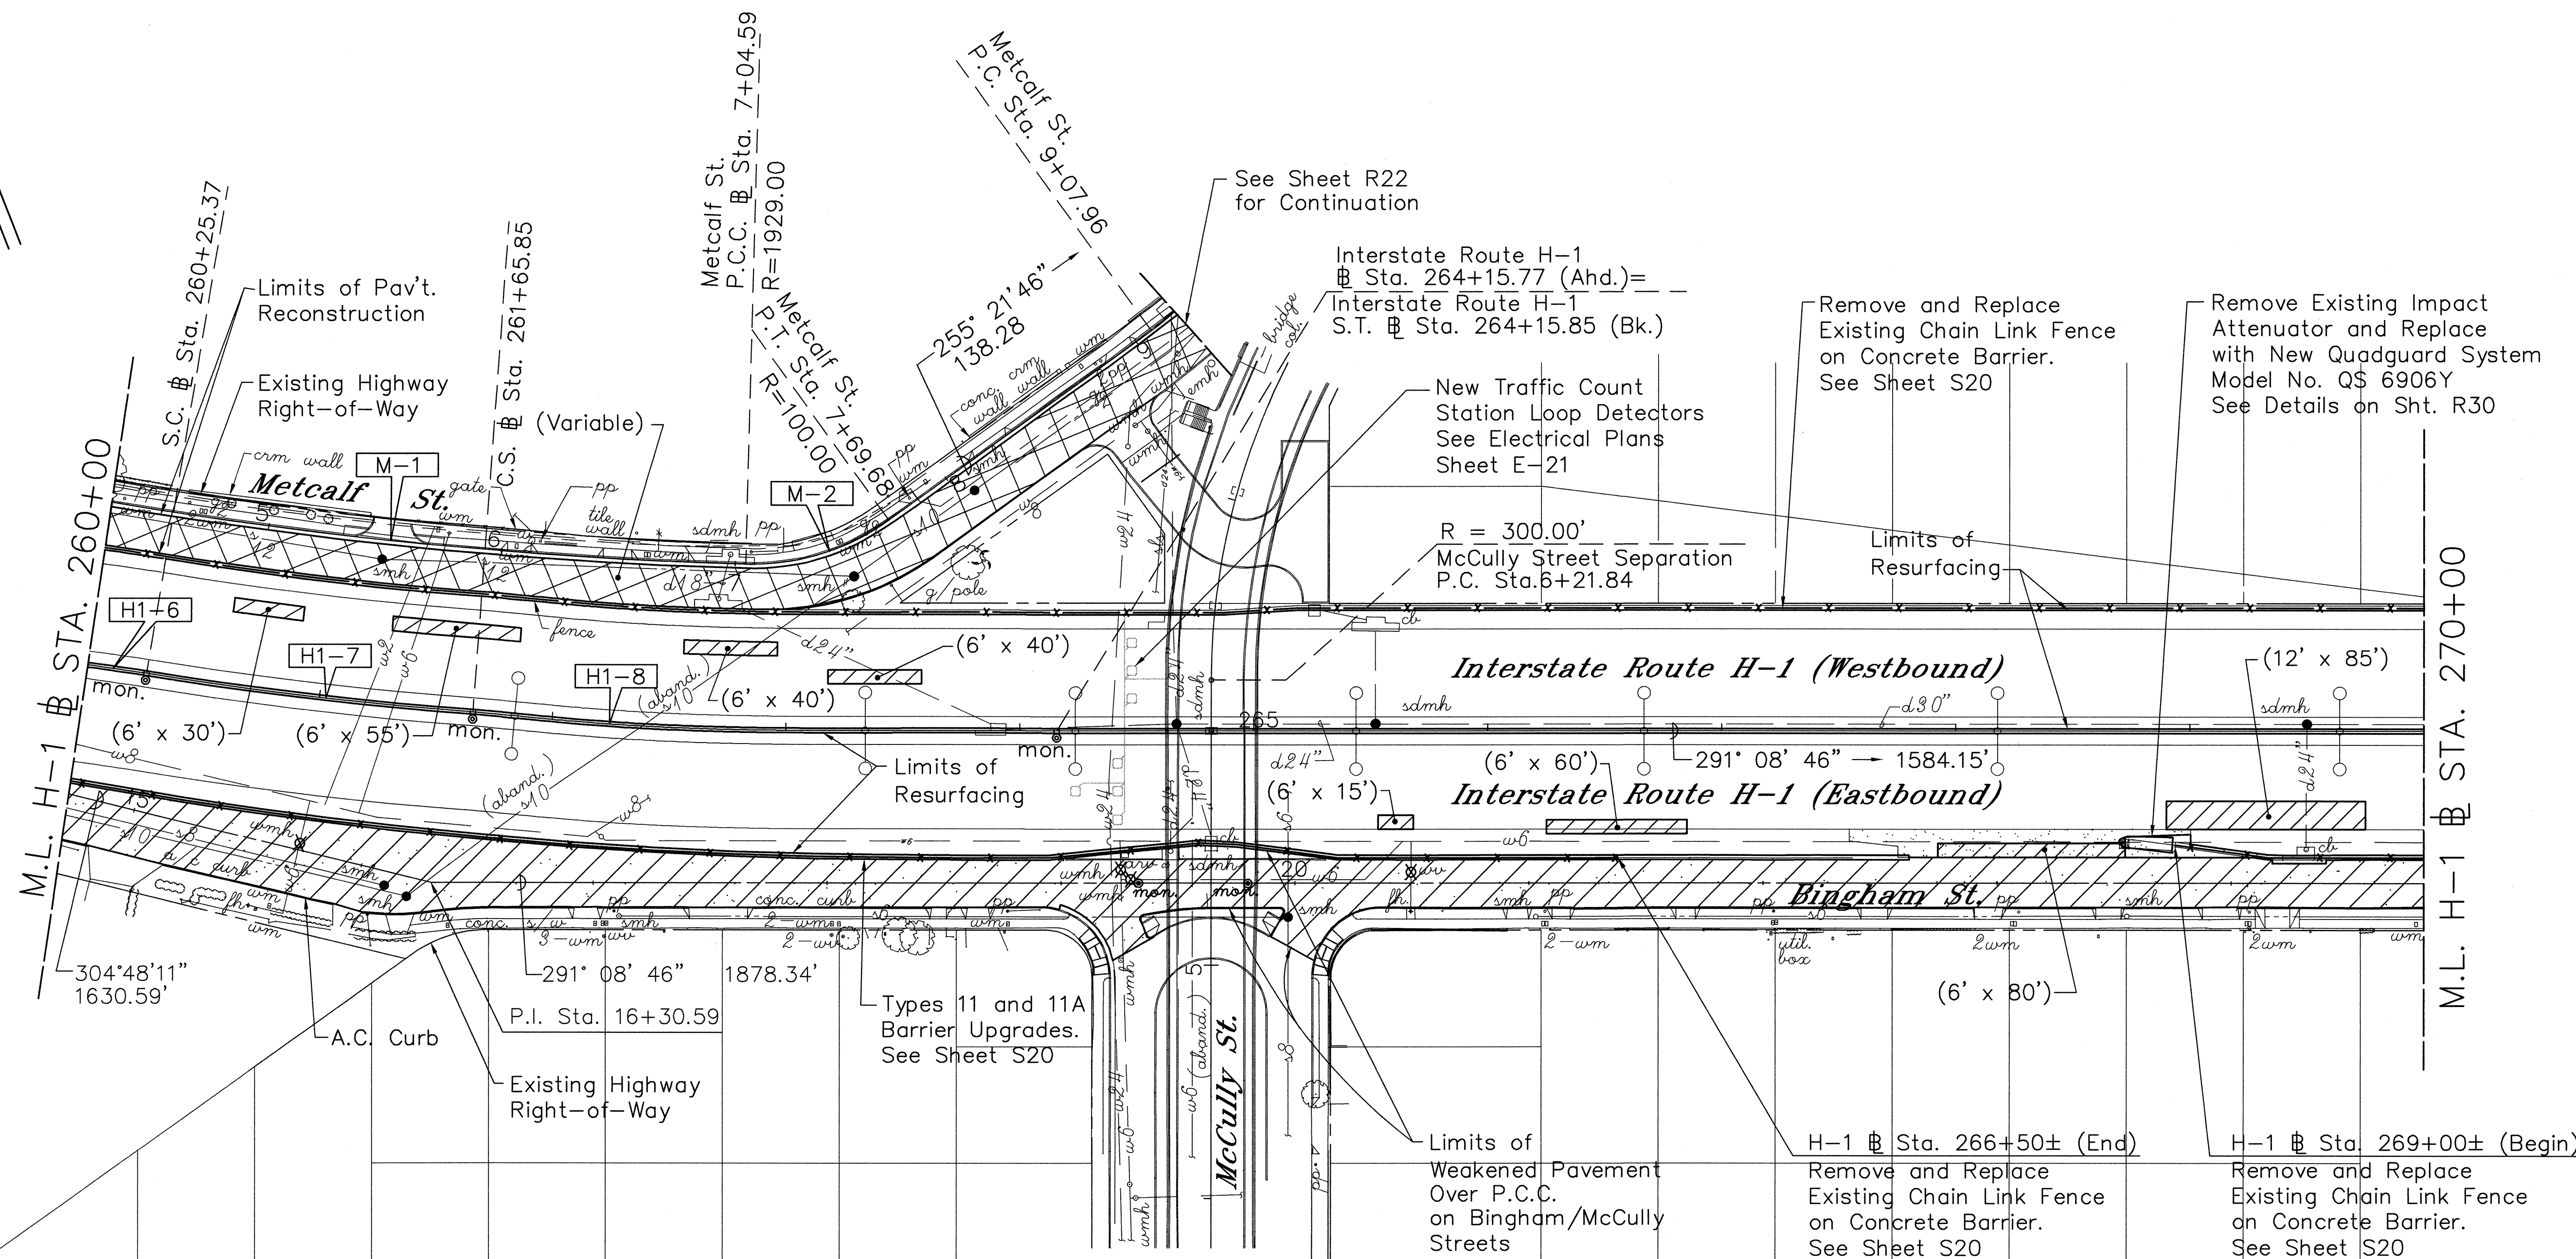

ROTATED: 21° 12' 00"
AT 0.0
DATE: 6/17/98
SCALE: 1" = 40'
FILE: 9815-17

ORIGINAL PLAN	DATE
DESIGNED BY	
DRAWN BY	
CHECKED BY	
NOTED BY	
QUANTITIES BY	
FILED BY	


CURVE DATA	
	H1-7
Δ	4° 55' 00"
Dc	3' 30' 00"
Tc	70.28'
Lc	140.48'
Ch	140.48'

SPIRAL CURVE DATA		
	H1-6	H1-8
θ	4° 22' 30"	4° 22' 30"
Ls	250.00'	250.00'
Ts	321.34'	321.84'
LT	166.72'	166.72'
ST	83.38'	83.38'
LC	249.94'	249.94'

CURVE DATA	
	M-1
Δ	12° 09' 15"
R	1929.00'
T	205.37'
Ch	408.43'
Lc	409.20'

CURVE DATA	
	M-2
Δ	37° 17' 45"
R	100.00'
T	33.75'
Ch	63.95'
Lc	65.09'

- Existing Utility/Drain Manhole Frames and Covers to be Adjusted
- Existing Water Manhole/Valves to be Removed, See Water Plans
- Existing Utility/Drain Manhole Frames and Covers to Remain

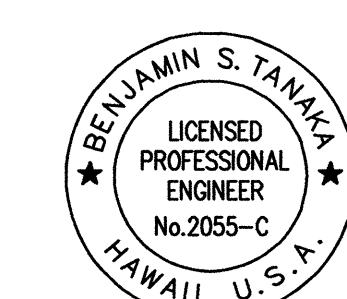

THIS WORK WAS PREPARED BY ME OR UNDER MY SUPERVISION

Benjamin S. Tanaka

STATE OF HAWAII
DEPARTMENT OF TRANSPORTATION
HIGHWAYS DIVISION

ROADWAY PLAN

INTERSTATE ROUTE H-1 RESURFACING
Vic. of Punchbowl Off Ramp to Kapiolani IC
F.A.I Project No. IM-H1-1(234)

Scale: 1"=40' Date: June 1, 1999

Note:
Proposed BWS Water Main(s) Not Shown.
Refer to Water Plans, Sheet(s) W22, W23,
W24, W25, W28, W29 & W30 For Details.

FED. ROAD DIST. NO.	STATE	FED. AID PROJ. NO.	FISCAL YEAR	SHEET NO.	TOTAL SHEETS
HAWAII	HAW.	IM-H1-1(234)	2000	39	557


TRUE NORTH
SCALE : 1" = 40'

ROTATED: 21° 12' 00"
AT 0.0


DATE: 6/17/98
SCALE: 1" = 40'
FILE: 9815-18

PM: BST
OPER: SHA*FAI
REVISED: 05/03/99

ORIGINAL PLAN	DATE
SURVEY PLOTTED BY	
DRAWN BY	
DESIGNED BY	
QUANTITIES BY	
CHECKED BY	
NOTED BY	
No.	

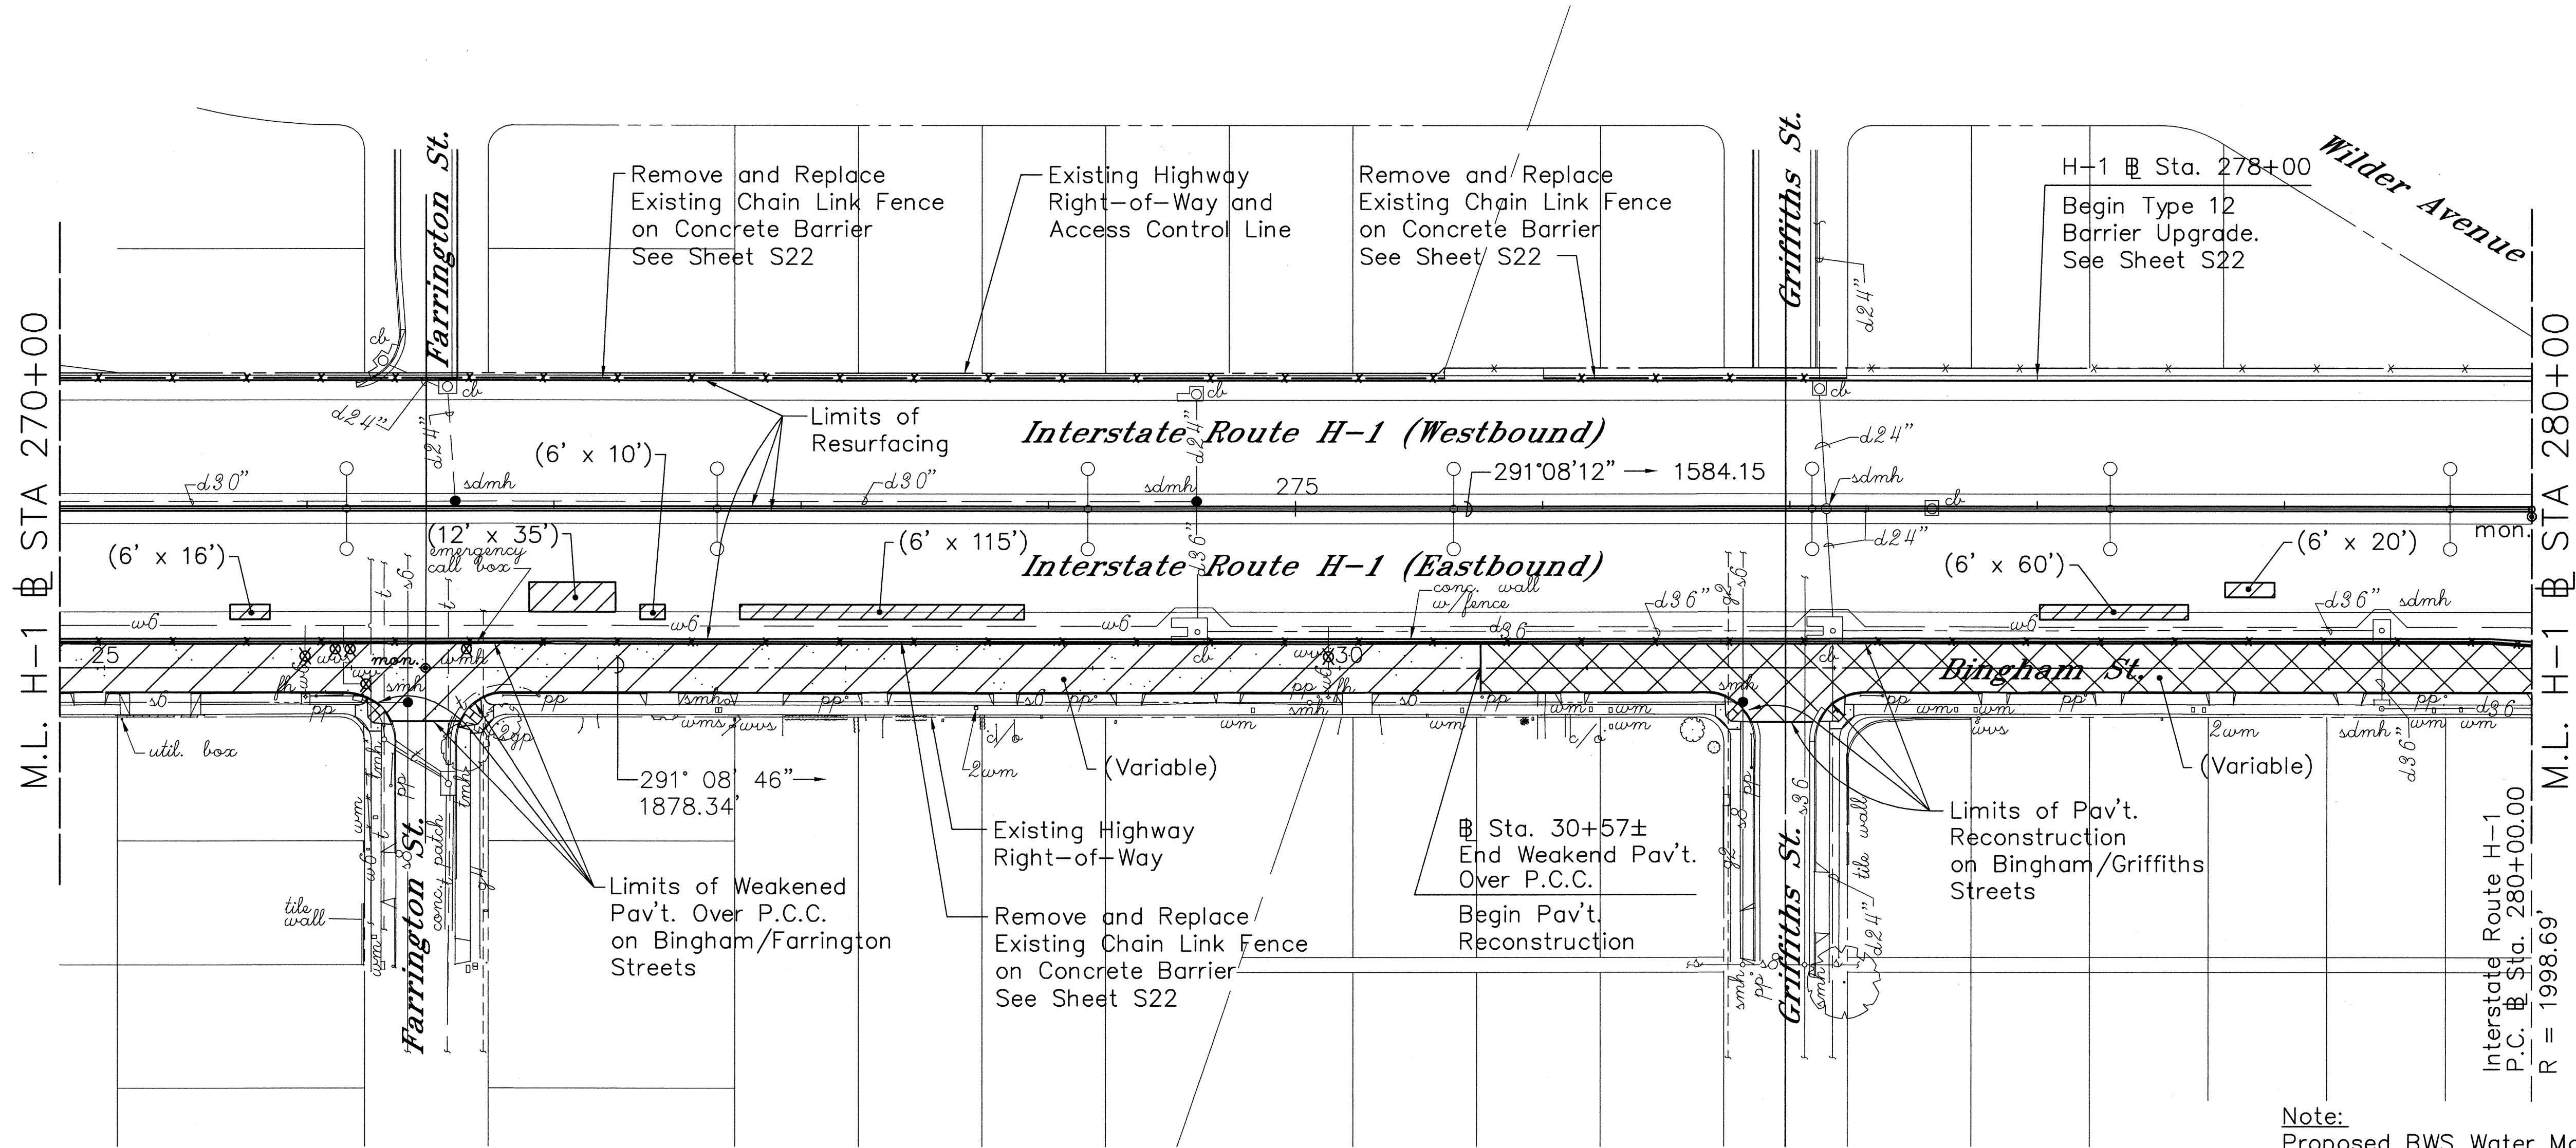

- Existing Utility/Drain Manhole Frames and Covers to be Adjusted
- ✗ Existing Water Manhole/Valves to be Removed, See Water Plans
- Existing Utility/Drain Manhole Frames and Covers to Remain

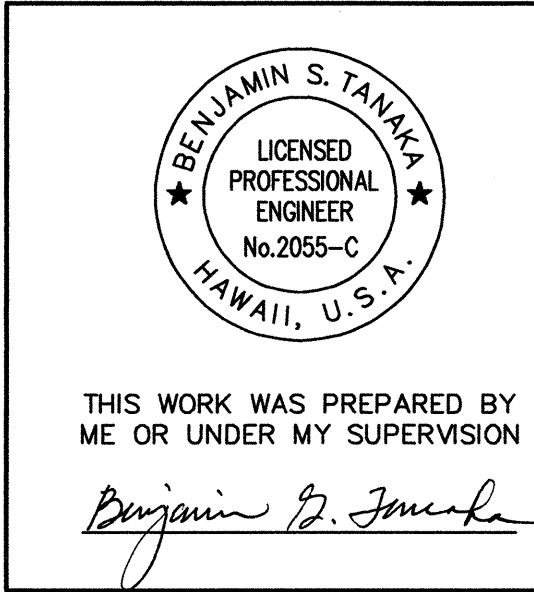

STATE OF HAWAII
DEPARTMENT OF TRANSPORTATION
HIGHWAYS DIVISION

ROADWAY PLAN

INTERSTATE ROUTE H-1 RESURFACING
Vic. of Punchbowl Off Ramp to Kapiolani IC
F.A.I Project No. IM-H1-1(234)

Scale: 1"=40' Date: June 1, 1999


SHEET NO. R11 OF 34 SHEETS

FED. ROAD DIST. NO.	STATE	FED. AID PROJ. NO.	FISCAL YEAR	SHEET NO.	TOTAL SHEETS
HAWAII	HAW.	IM-H1-1(234)	2000	40	557

CURVE DATA		
	H1-9	W-1
Δ	9° 10' 00"	22° 42' 00"
R	1,998.69'	75.00
T	160.23'	15.06
Ch	319.43'	29.52
Lc	319.77'	29.71

CURVE DATA		
	B-1	B-2
Δ	9° 10'	22° 42'
R	1597.00	435.35
T	128.02	87.39
Ch	255.23	171.36
Lc	255.50	172.48


Note:
Proposed BWS Water Main(s) Not Shown.
Refer to Water Plans, Sheet(s) W27, W33,
W34 & W35 For Details.

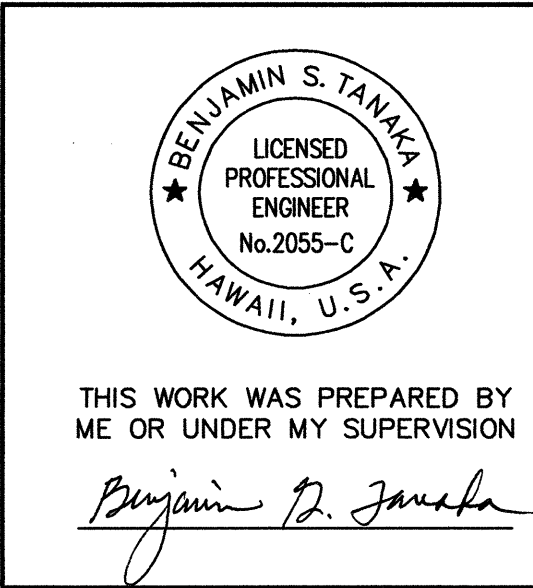

STATE OF HAWAII
DEPARTMENT OF TRANSPORTATION
HIGHWAYS DIVISION
ROADWAY PLAN
INTERSTATE ROUTE H-1 RESURFACING
Vic. of Punchbowl Off Ramp to Kapiolani IC
F.A.I Project No. IM-H1-1(234)
Scale: 1"=40' Date: June 1, 1999
SHEET NO. R12 OF 34 SHEETS

40

- Existing Utility/Drain Manhole Frames and Covers to be Adjusted
- Existing Water Manhole/Valves to be Removed, See Water Plans
- Existing Utility/Drain Manhole Frames and Covers to Remain

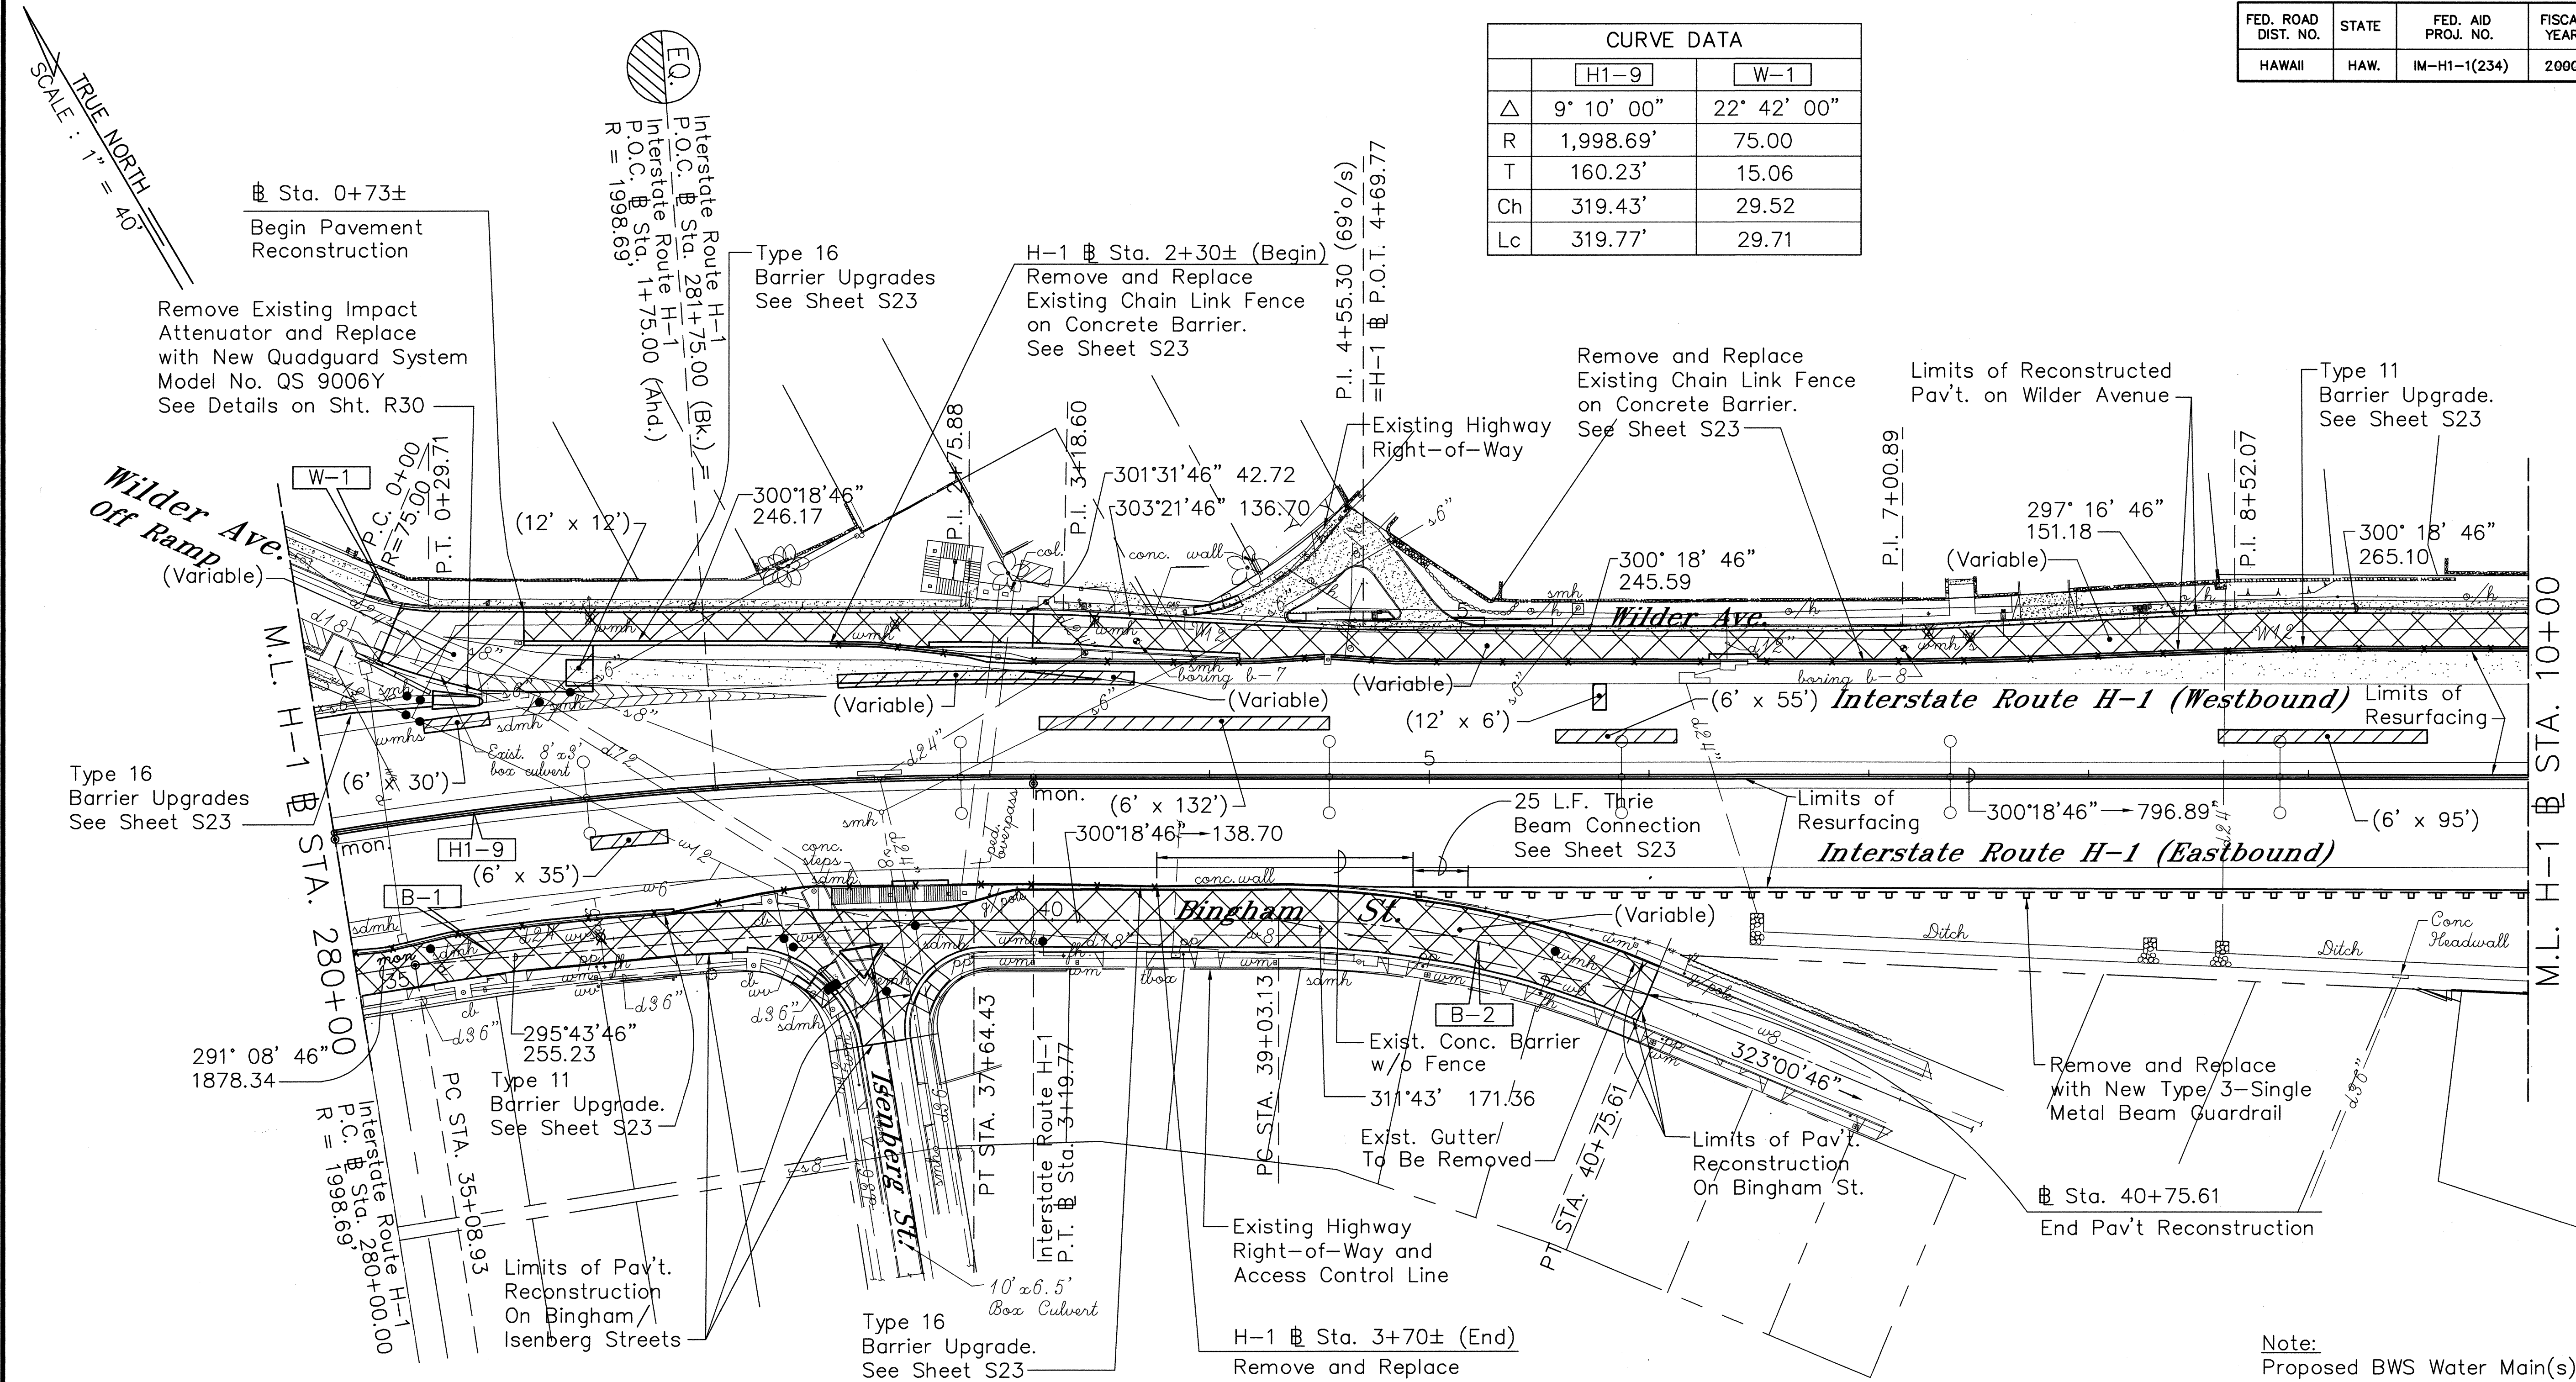

ORIGINAL PLAN	DATE
DESIGNED BY	
NOTED BY	
QUANTITIES BY	
CHECKED BY	



ROTATED: 30° 21' 59.98"
AT 0,0

DATE: 6/17/98
SCALE: 1" = 40'
FILE: 9815-19


PM: BST

OPER: SHA *FAI
REVISED: 05/03/99

TRUE NORTH
SCALE: 1" = 20'

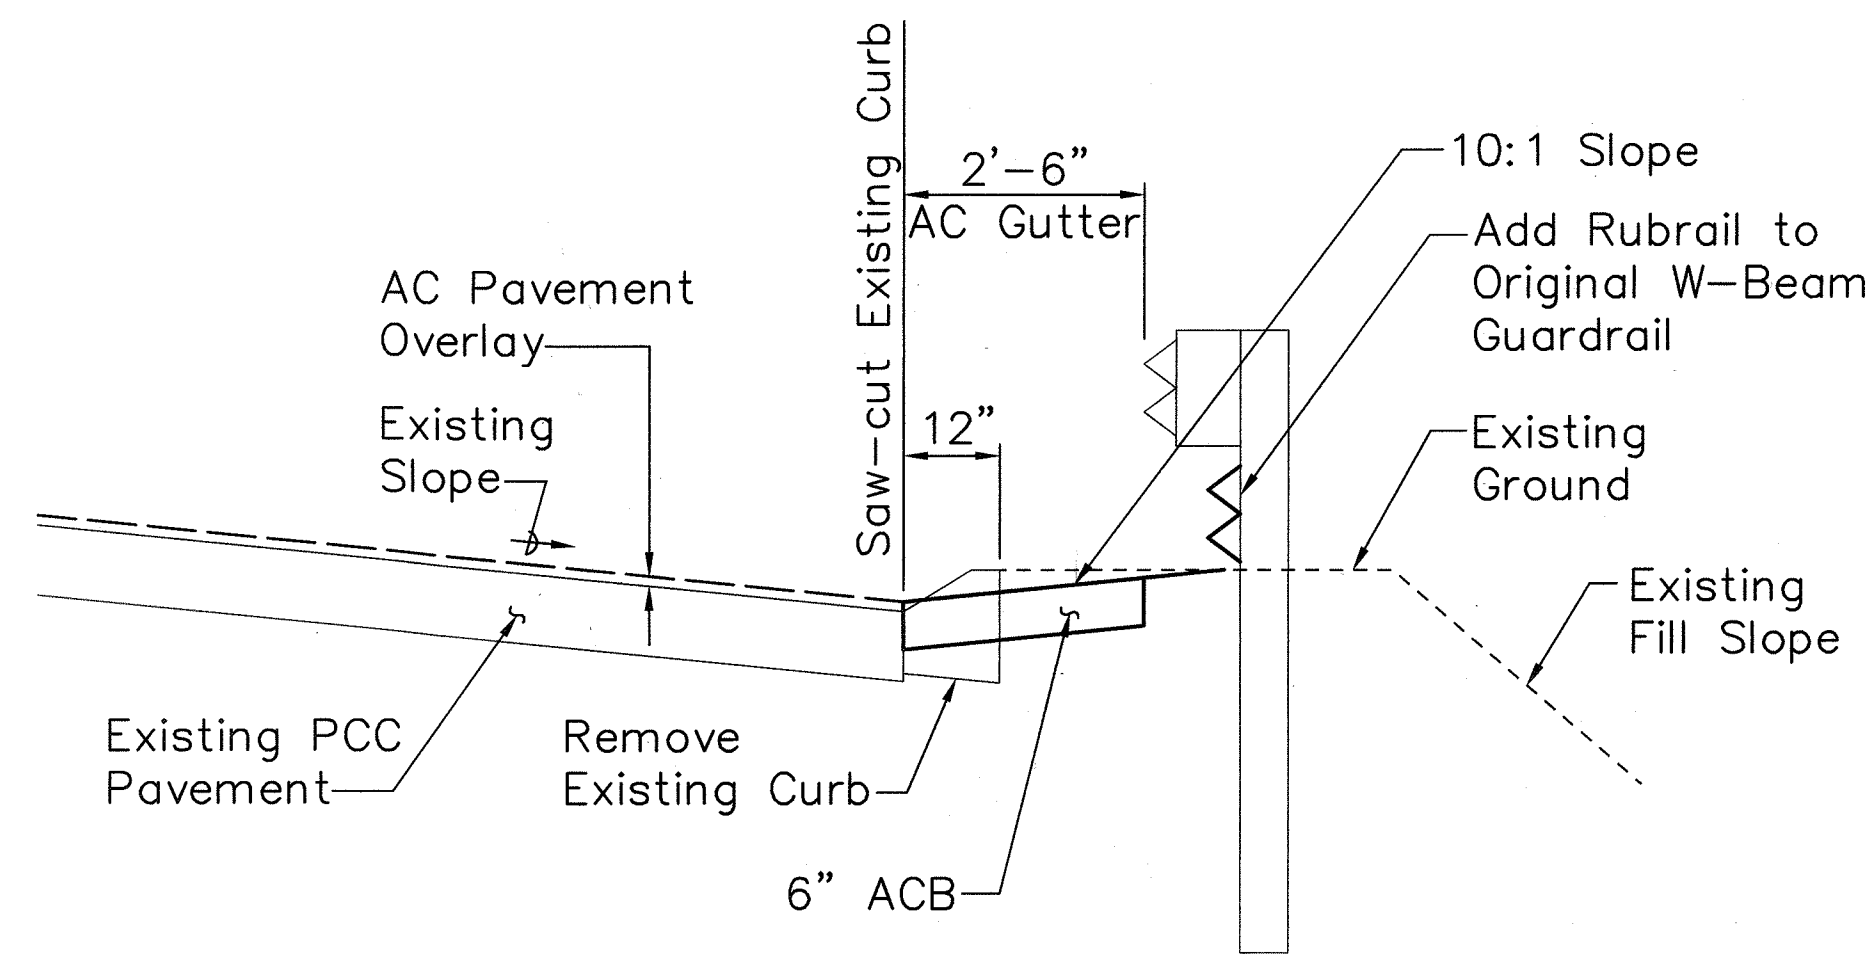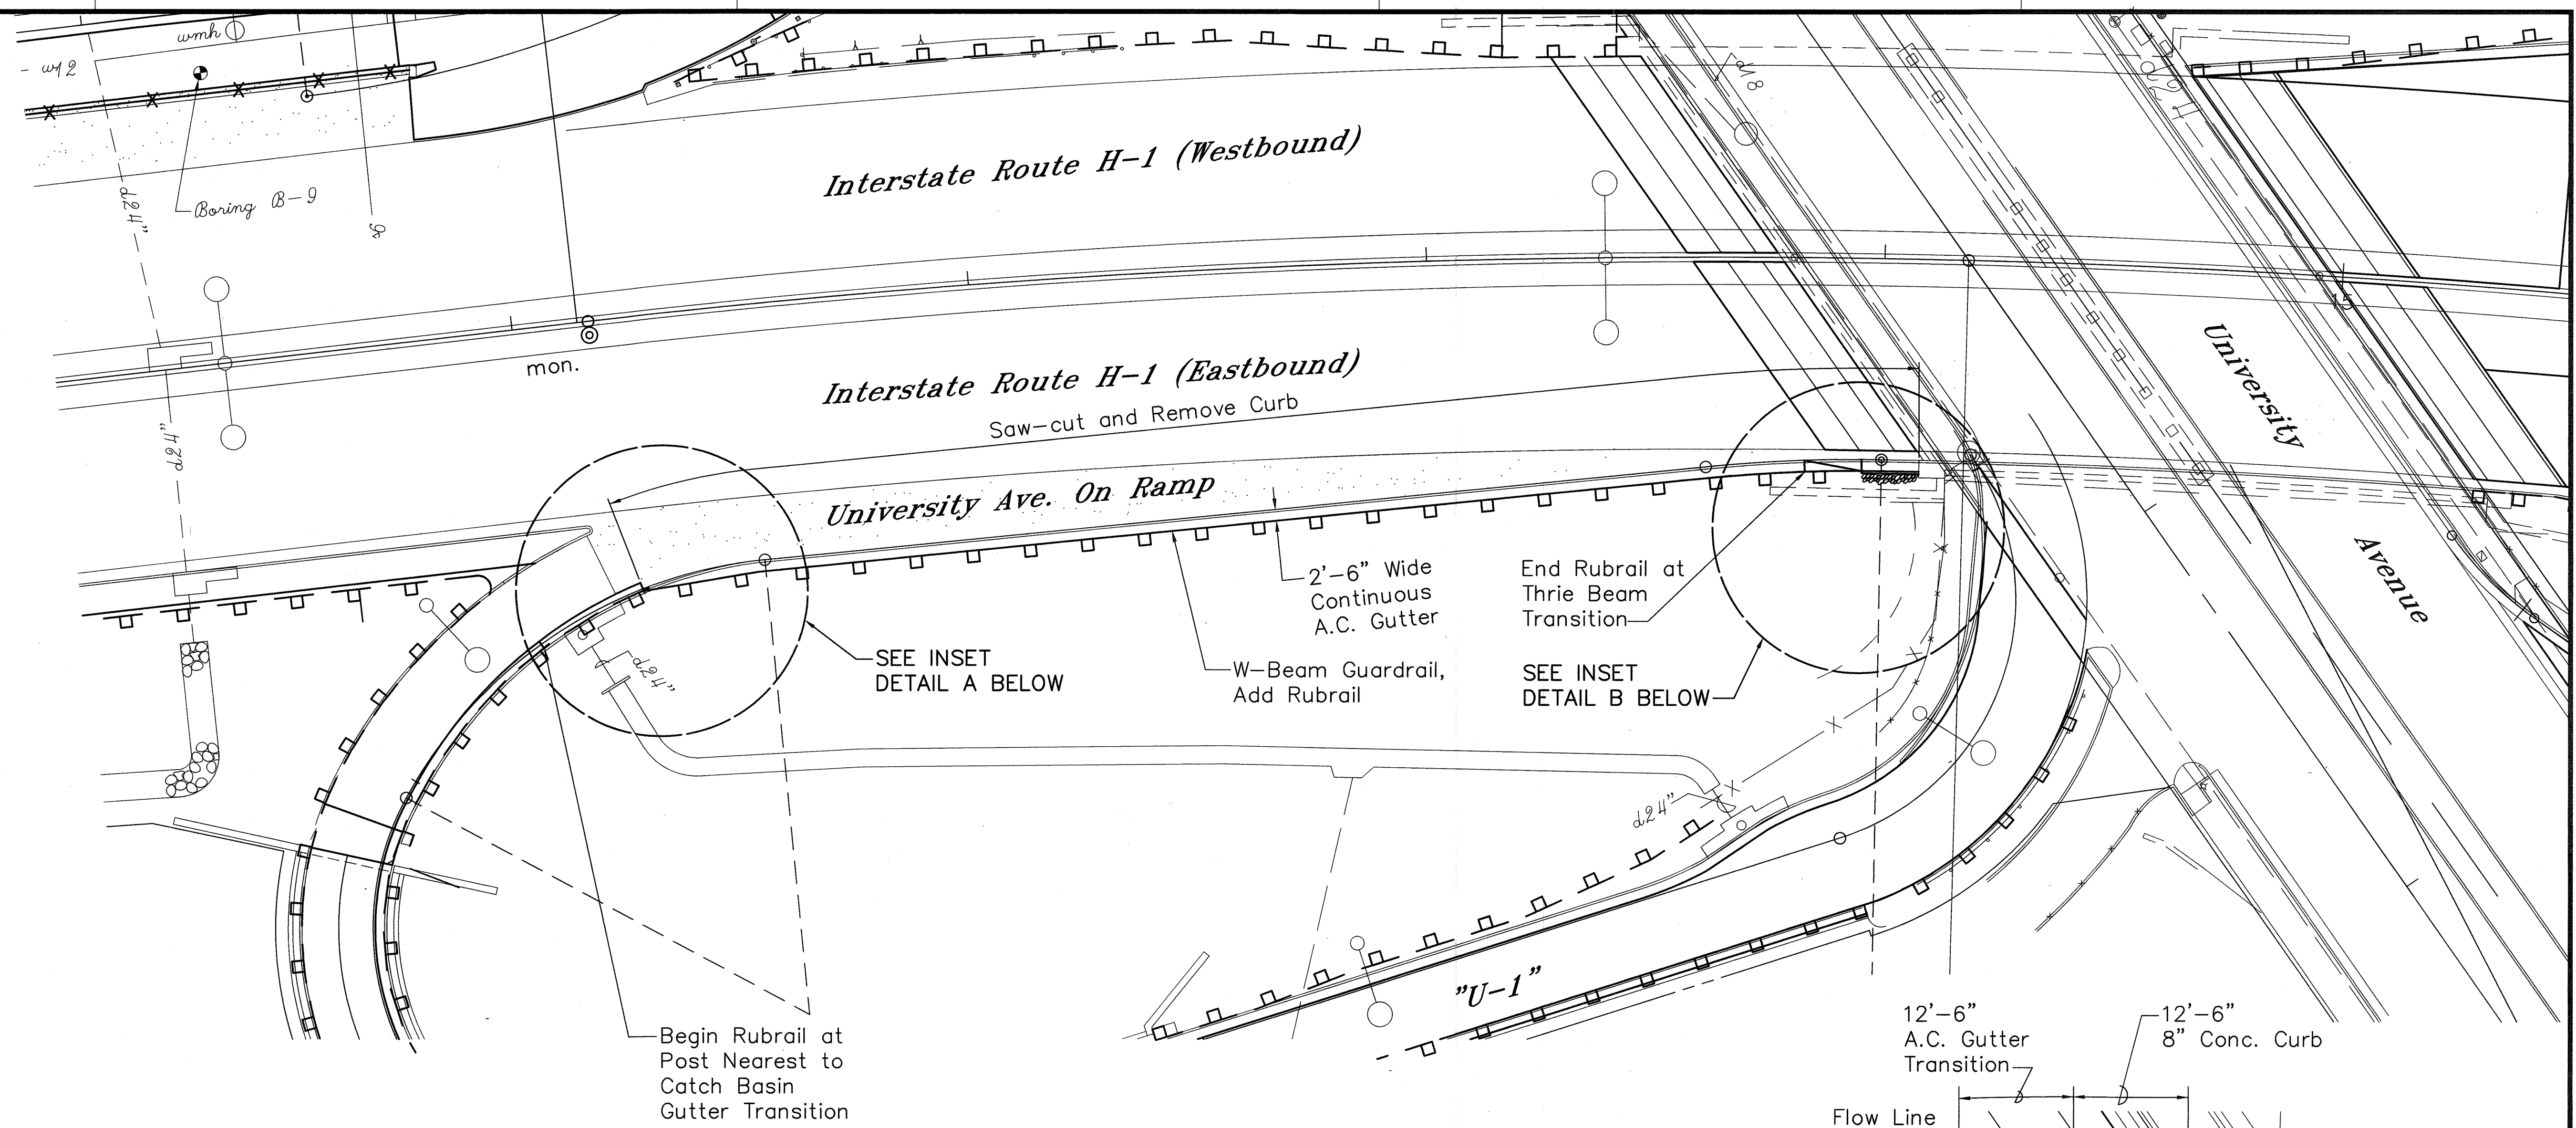


**TYPICAL SECTION AT
ACCELERATION LANE FOR RAMP U-1**
SCALE: 1/2" = 1'-0"

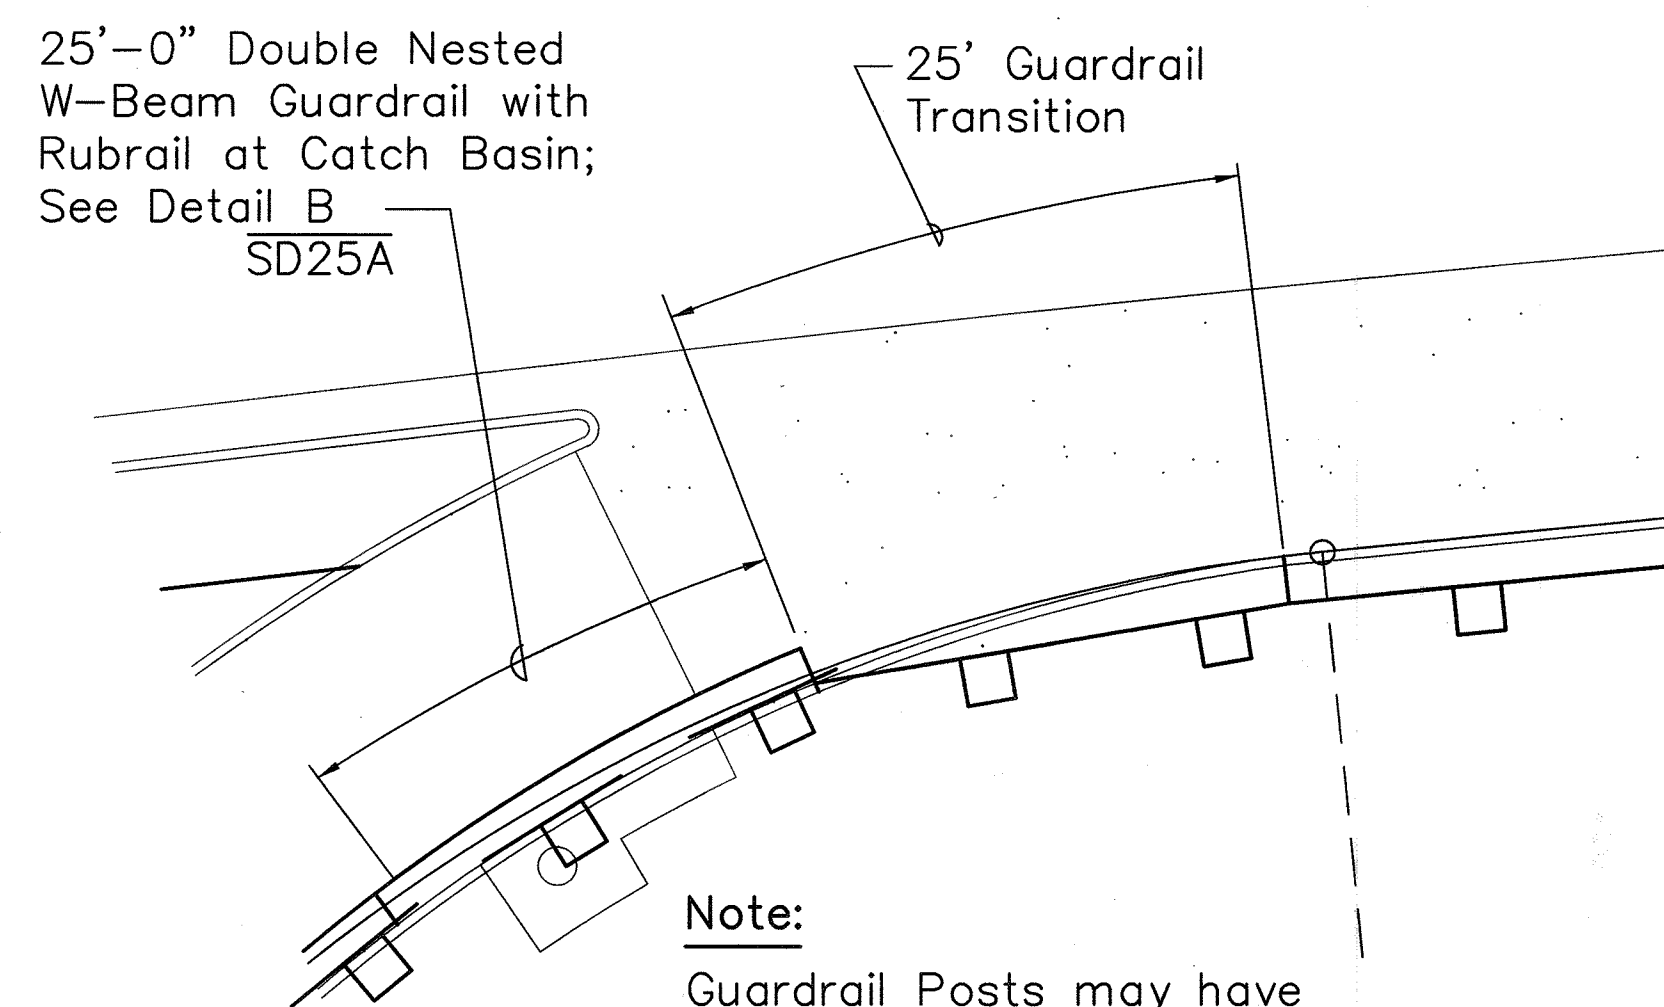

Note:
Guardrail Posts may have to be predrilled through A.C. Gutter in transition area.

INSET DETAIL A
SCALE: 1" = 10'

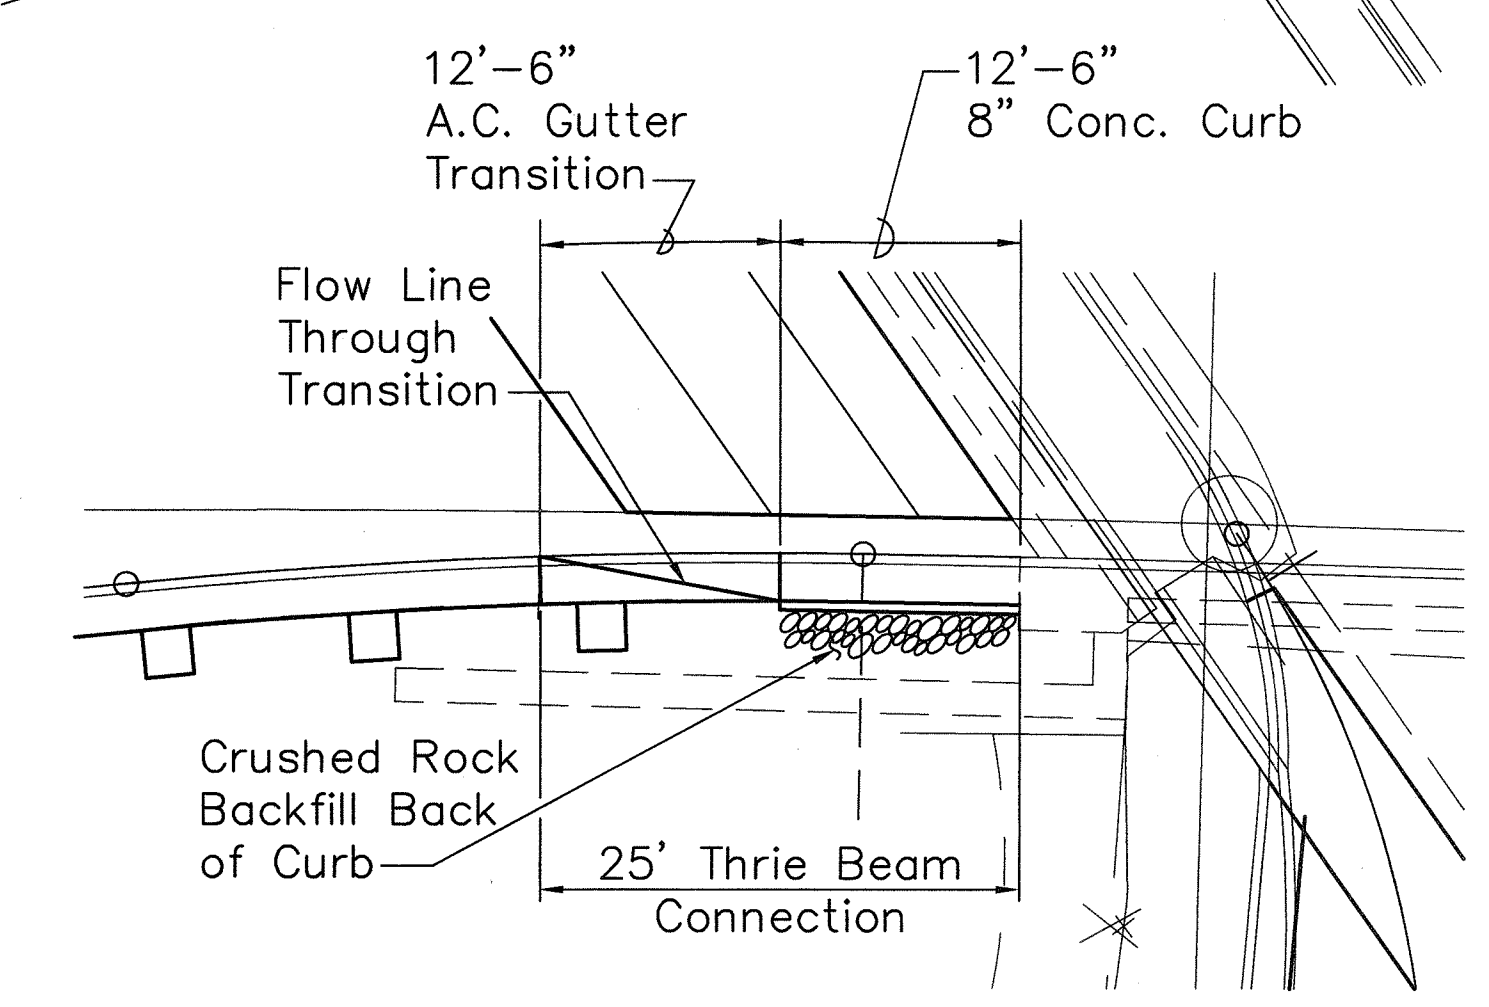



INSET DETAIL B
SCALE: 1" = 10'

SURVEY PLOTTED BY	DATE
DESIGNED BY	
QUANTITIES BY	
CHECKED BY	
ORIGINAL PLAN	
NO.	





DATE: 08/10/00
SCALE: 1" = 20'
FILE: 9815-20B

PM: BST
OPER: BTY, FAL
REVISED: 08/29/00

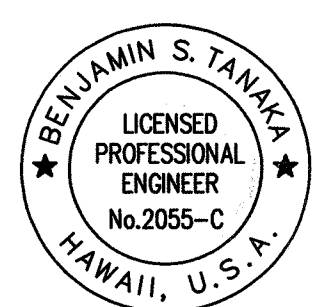 THIS WORK WAS PREPARED BY ME OR UNDER MY SUPERVISION <i>Benjamin S. Tanaka</i>	STATE OF HAWAII DEPARTMENT OF TRANSPORTATION HIGHWAYS DIVISION ROADWAY PLAN INTERSTATE ROUTE H-1 RESURFACING Vic. of Punchbowl Off Ramp to Kapiolani IC F.A.I. Project No. IM-H1-1(234) Scale: 1"=20' Date: Aug. 10, 2000 SHEET NO. R13A OF 34 SHEETS
--	---

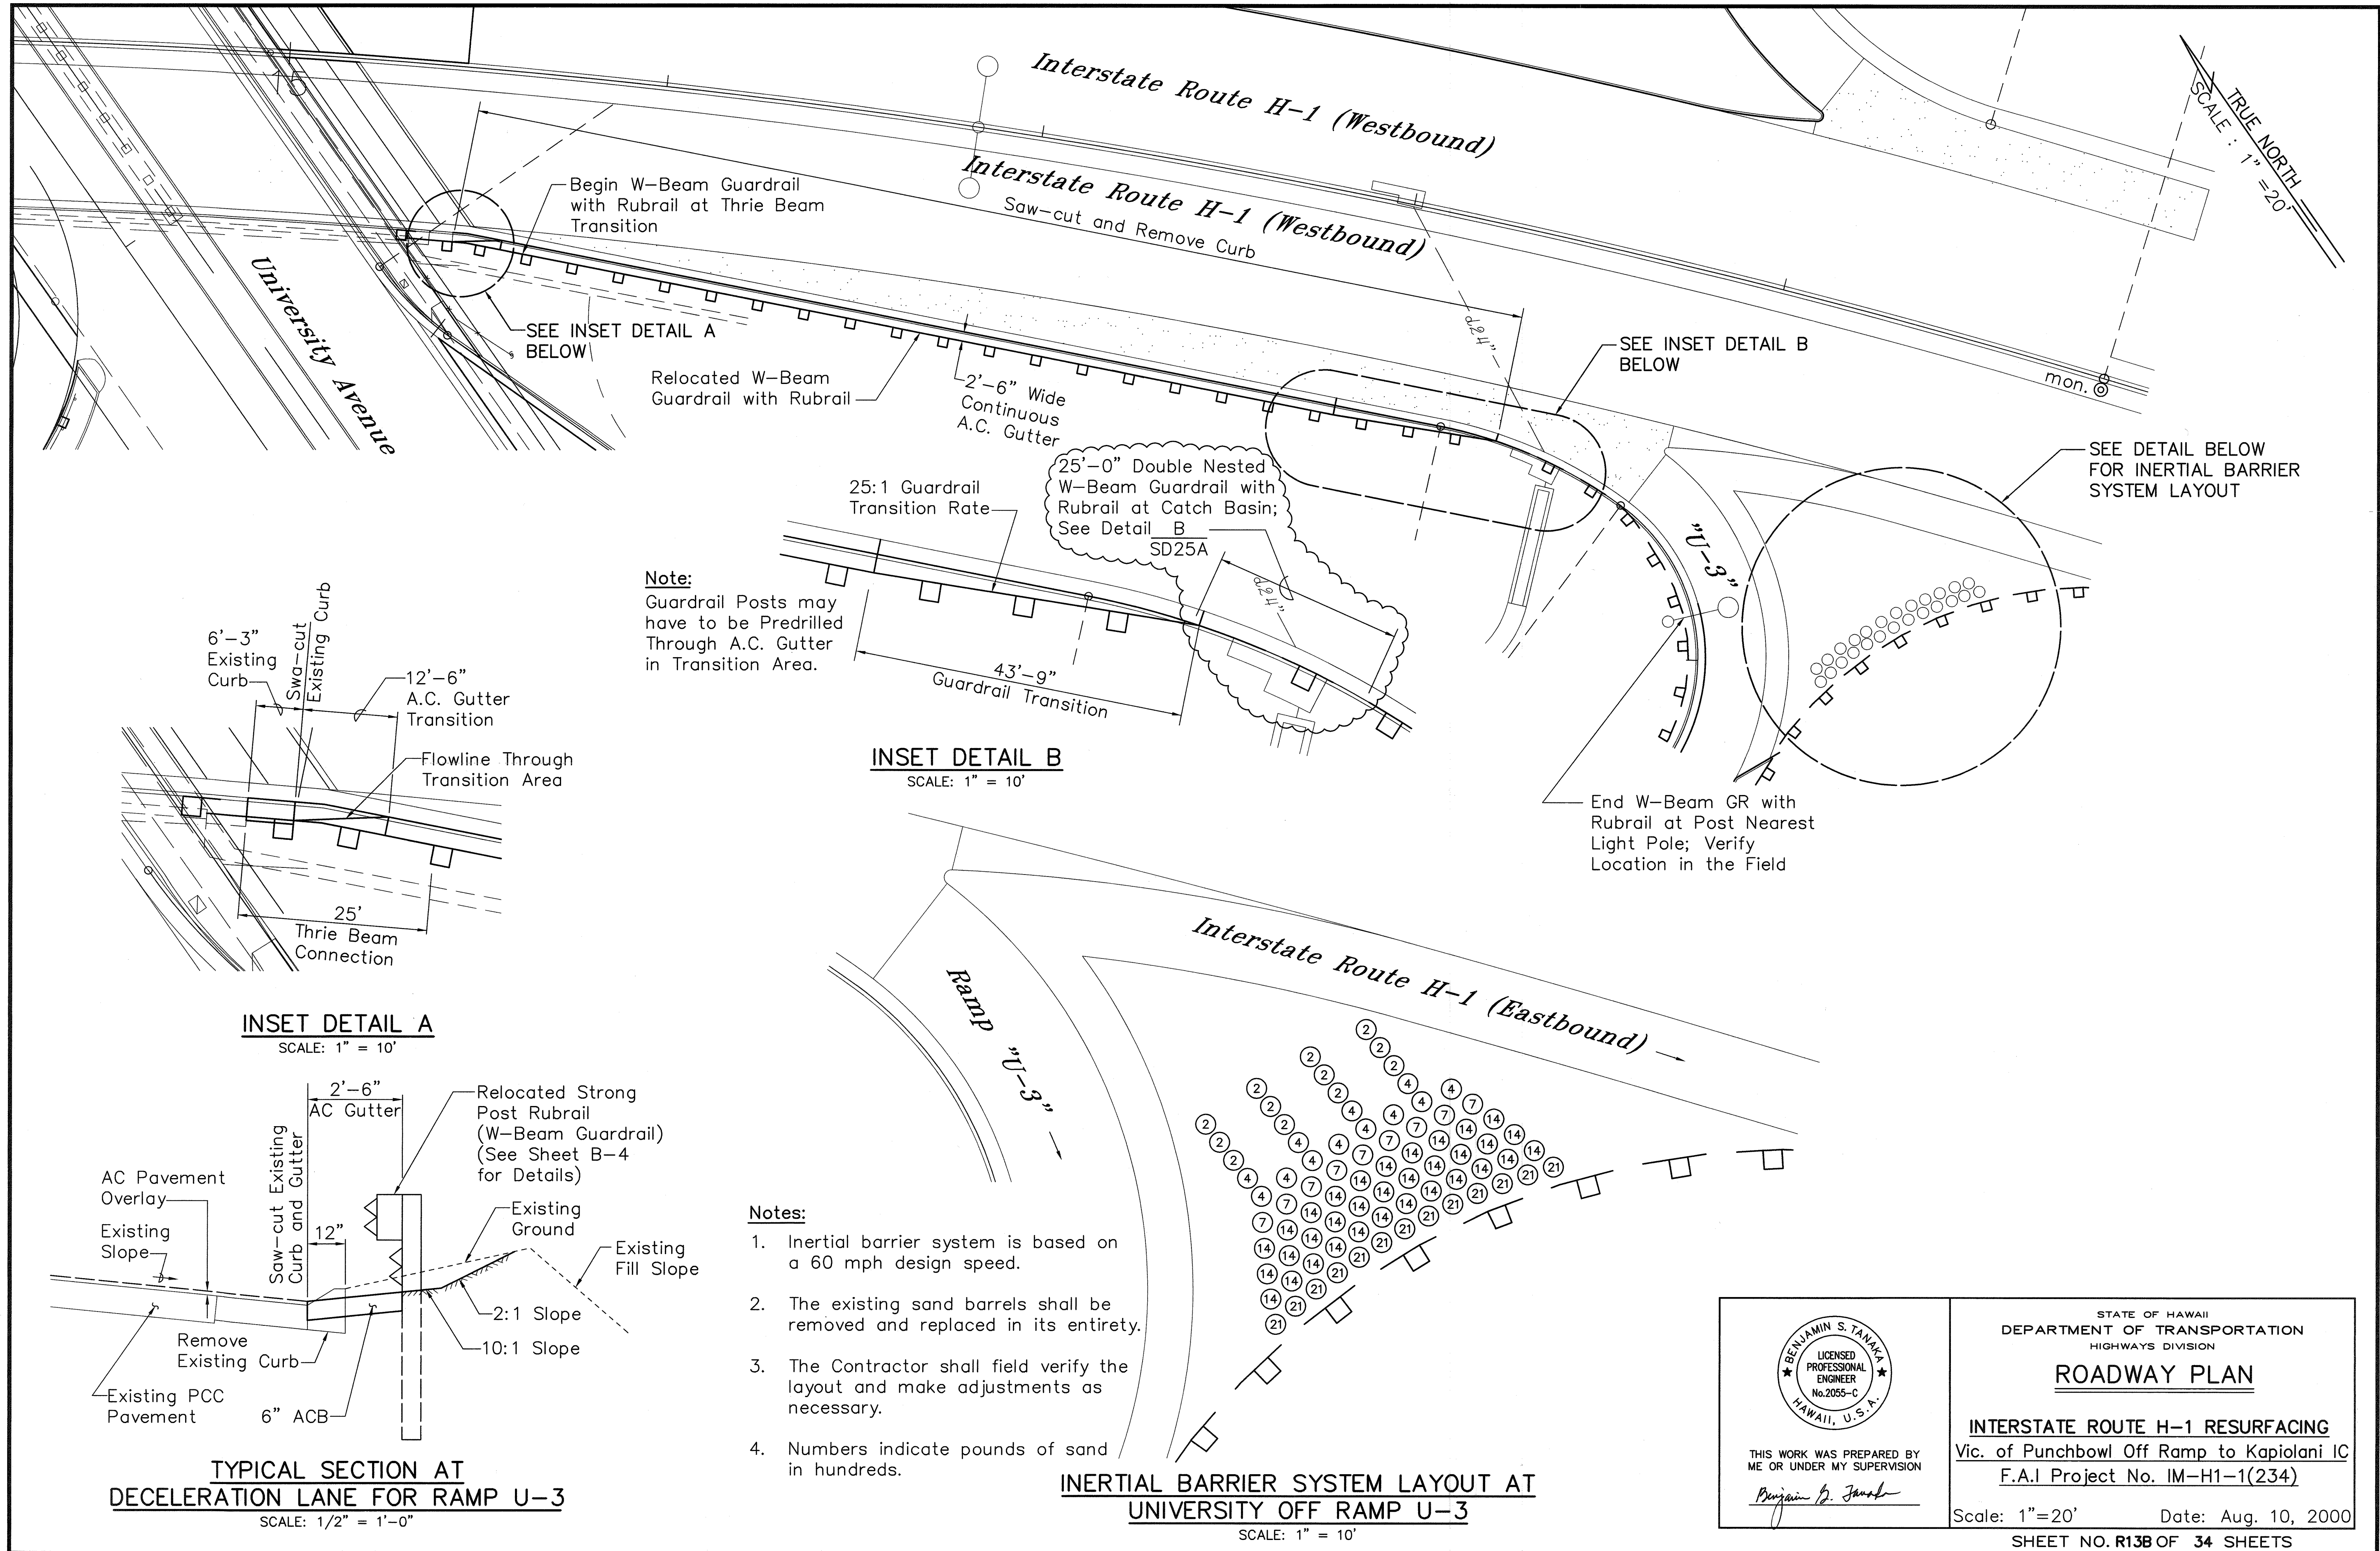

FED. ROAD DIST. NO.	STATE	FED. AID PROJ. NO.	FISCAL YEAR	SHEET NO.	TOTAL SHEETS
HAWAII	HAW.	IM-H1-1(234)	2000	41	557

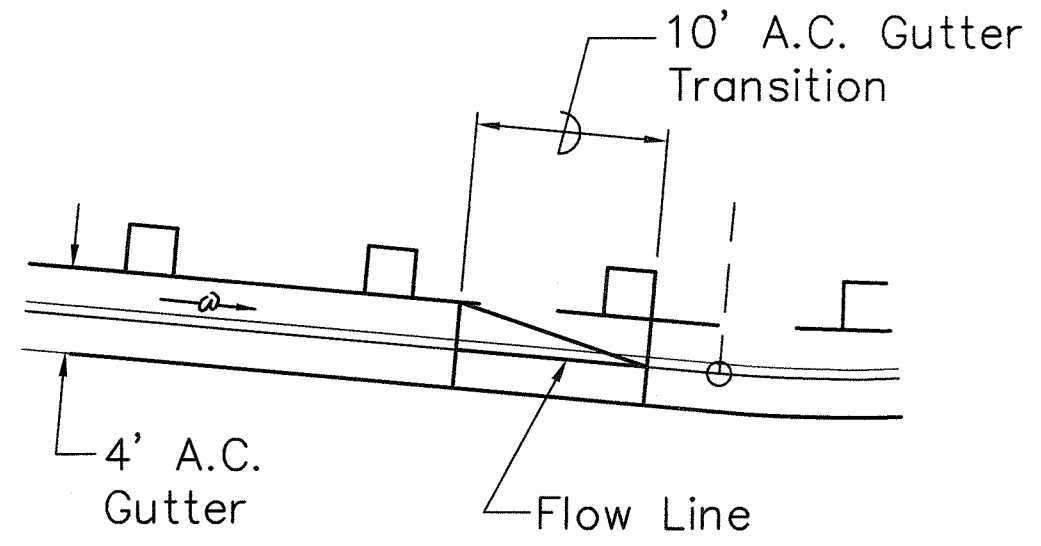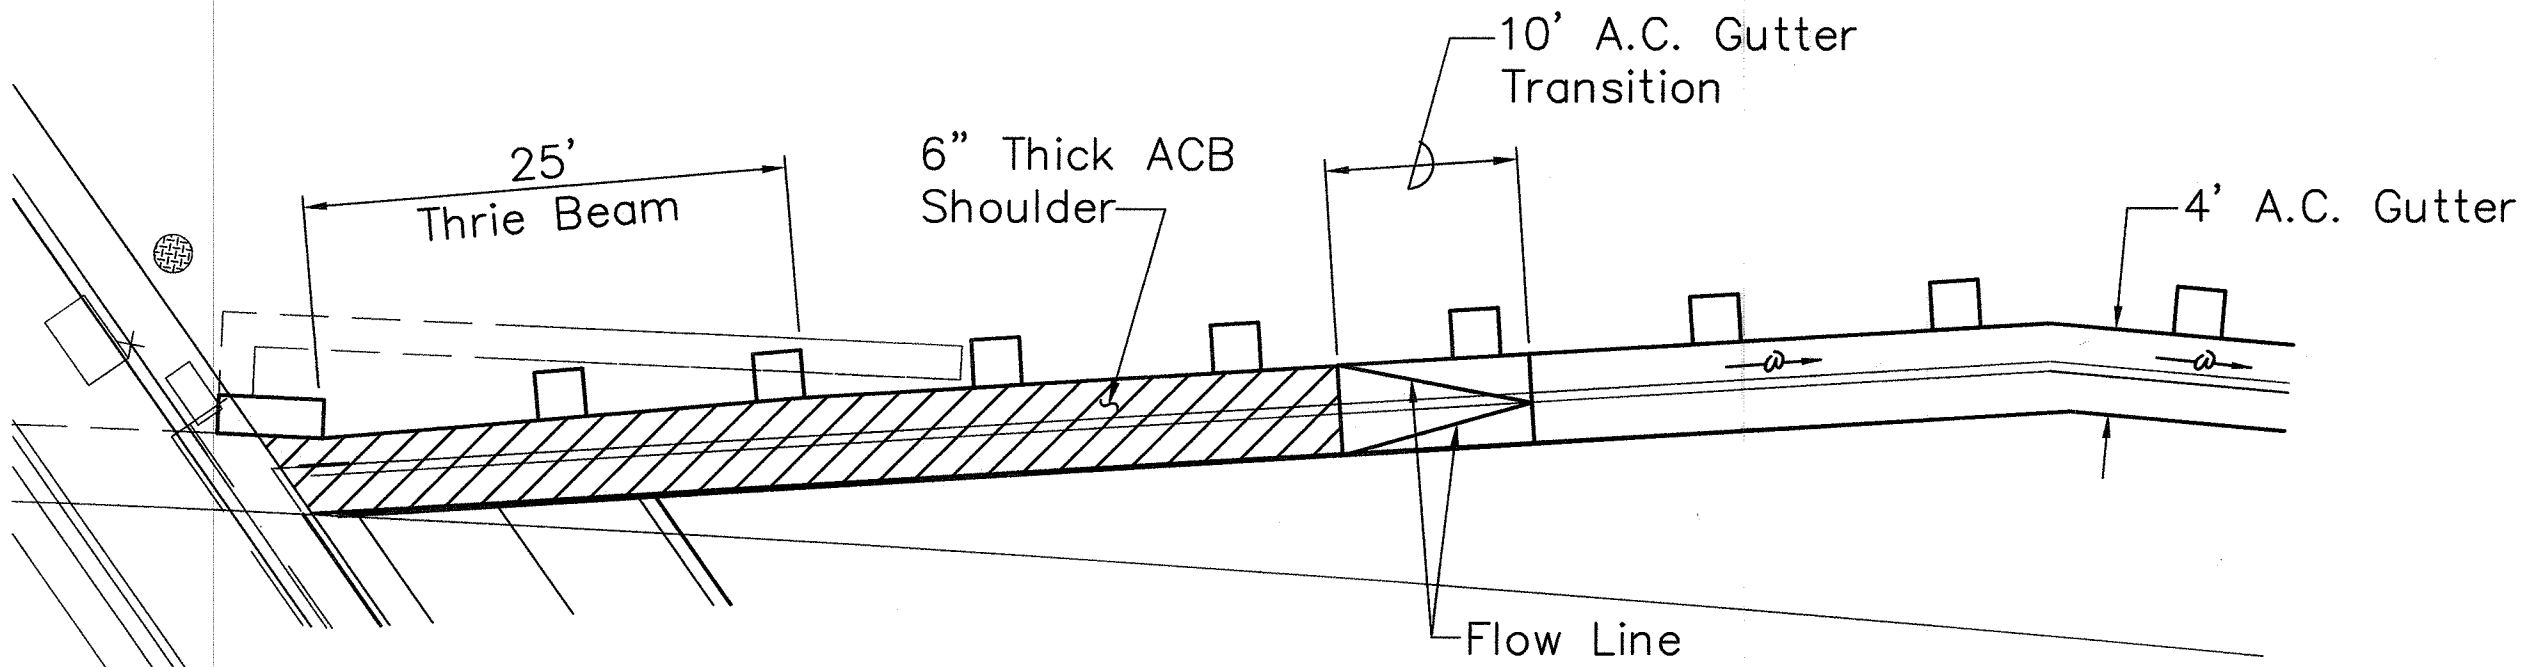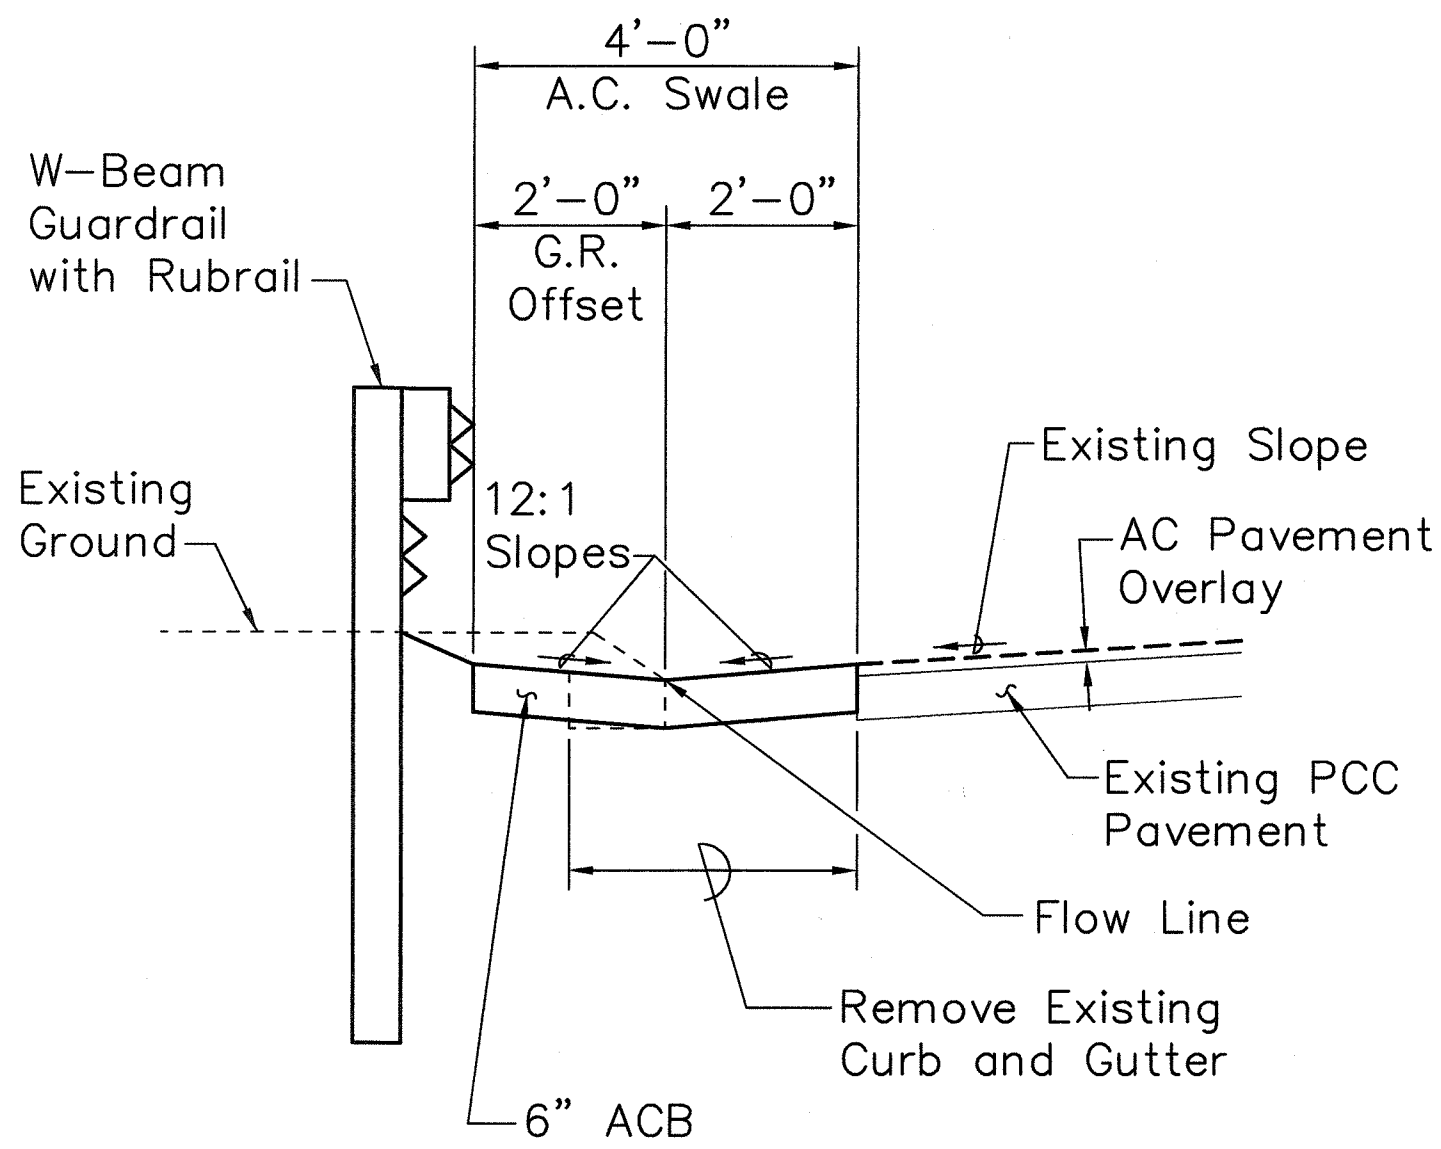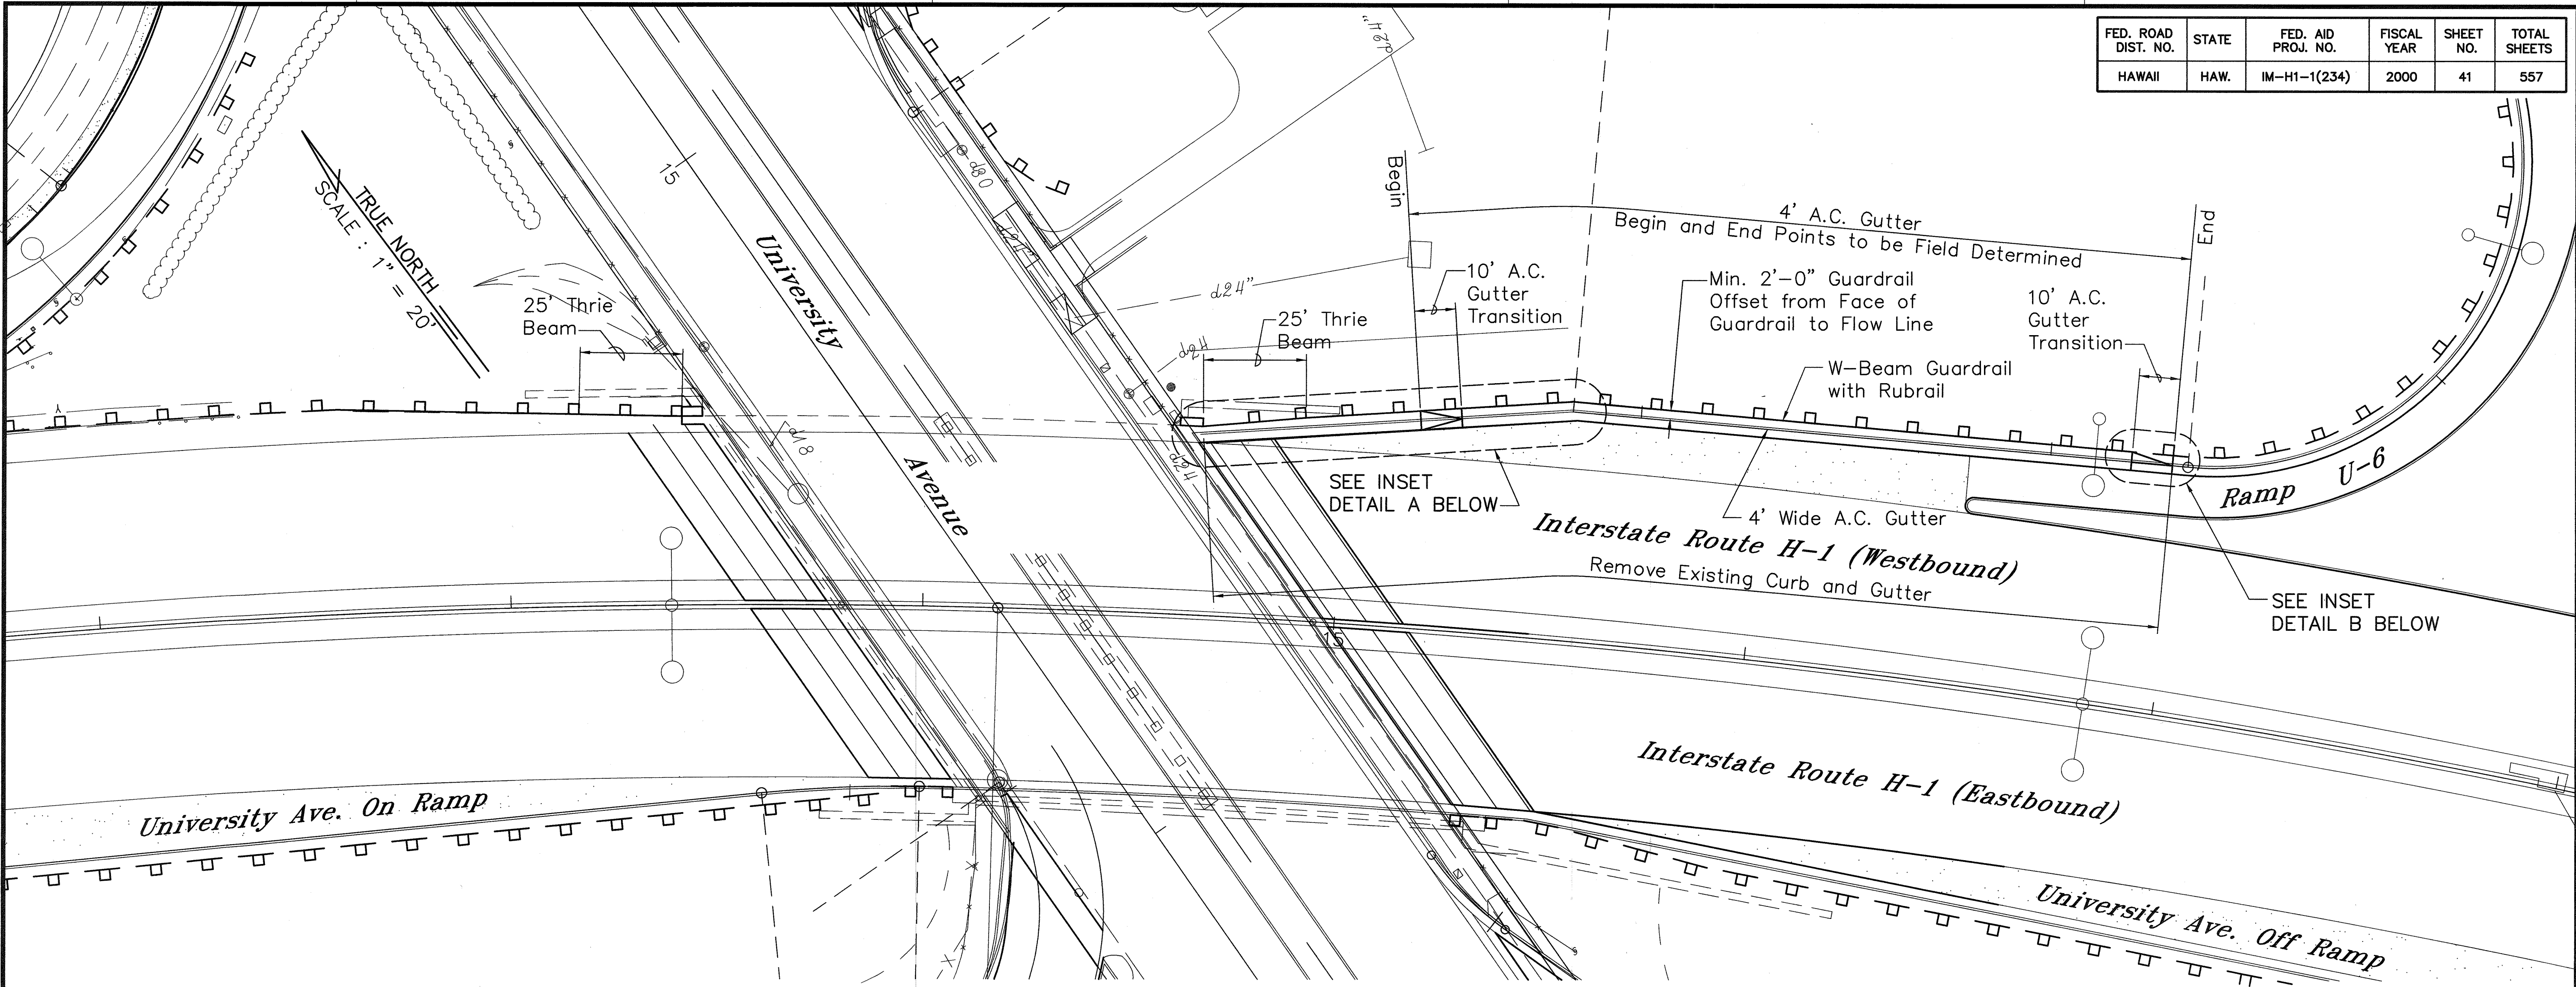

THIS WORK WAS PREPARED BY ME OR UNDER MY SUPERVISION

Benjamin S. Tanaka

STATE OF HAWAII
DEPARTMENT OF TRANSPORTATION
HIGHWAYS DIVISION

ROADWAY PLAN

INTERSTATE ROUTE H-1 RESURFACING
Vic. of Punchbowl Off Ramp to Kapiolani IC
F.A.I Project No. IM-H1-1(234)

Scale: 1"=40' Date: June 1, 1999

SHEET NO. R13C OF 34 SHEETS

ROTATED: 36° 56' 26.61" AT 0,0

DATE: 08/28/00
SCALE: 1" = 20'
FILE: 9815-200

PM: BST
OPER: FAI
REVISED: 08/29/00

SURVEY PLOTTED BY _____ DATE _____

DRAWN BY _____

DESIGNED BY _____

QUANTITIES BY _____

CHECKED BY _____

ORIGINAL PLAN _____

NOTEBOOK _____

No. _____


FED. ROAD DIST. NO.	STATE	FED. AID PROJ. NO.	FISCAL YEAR	SHEET NO.	TOTAL SHEETS
HAWAII	HAW.	IM-H1-1(234)	2000	42	557

I.B. CURVE DATA	
	H1-11
Δ	20° 58' 00"
R	1909.86'
T	353.40'
Ch	695.00'
Lc	698.89'

Note:
 For Guardrail Installations at Existing Drop Intake Structures, Locate Guardrail Posts Clear of Drop Intake Structures. Space Guardrail Posts 6'-3" Apart, Center to Center. If Spacing Exceeds 6'-3" But is Less or Equal to 12'-6", Double Nest W-Beam Section with Splice at Mid-Span. Described Work is Incidental to Guardrail Type 3-Single with Steel Posts.

* Half Post Spacings for 25' for Protection of Nearby Sign Post

TRUE NORTH
 SCALE: 1" = 40'

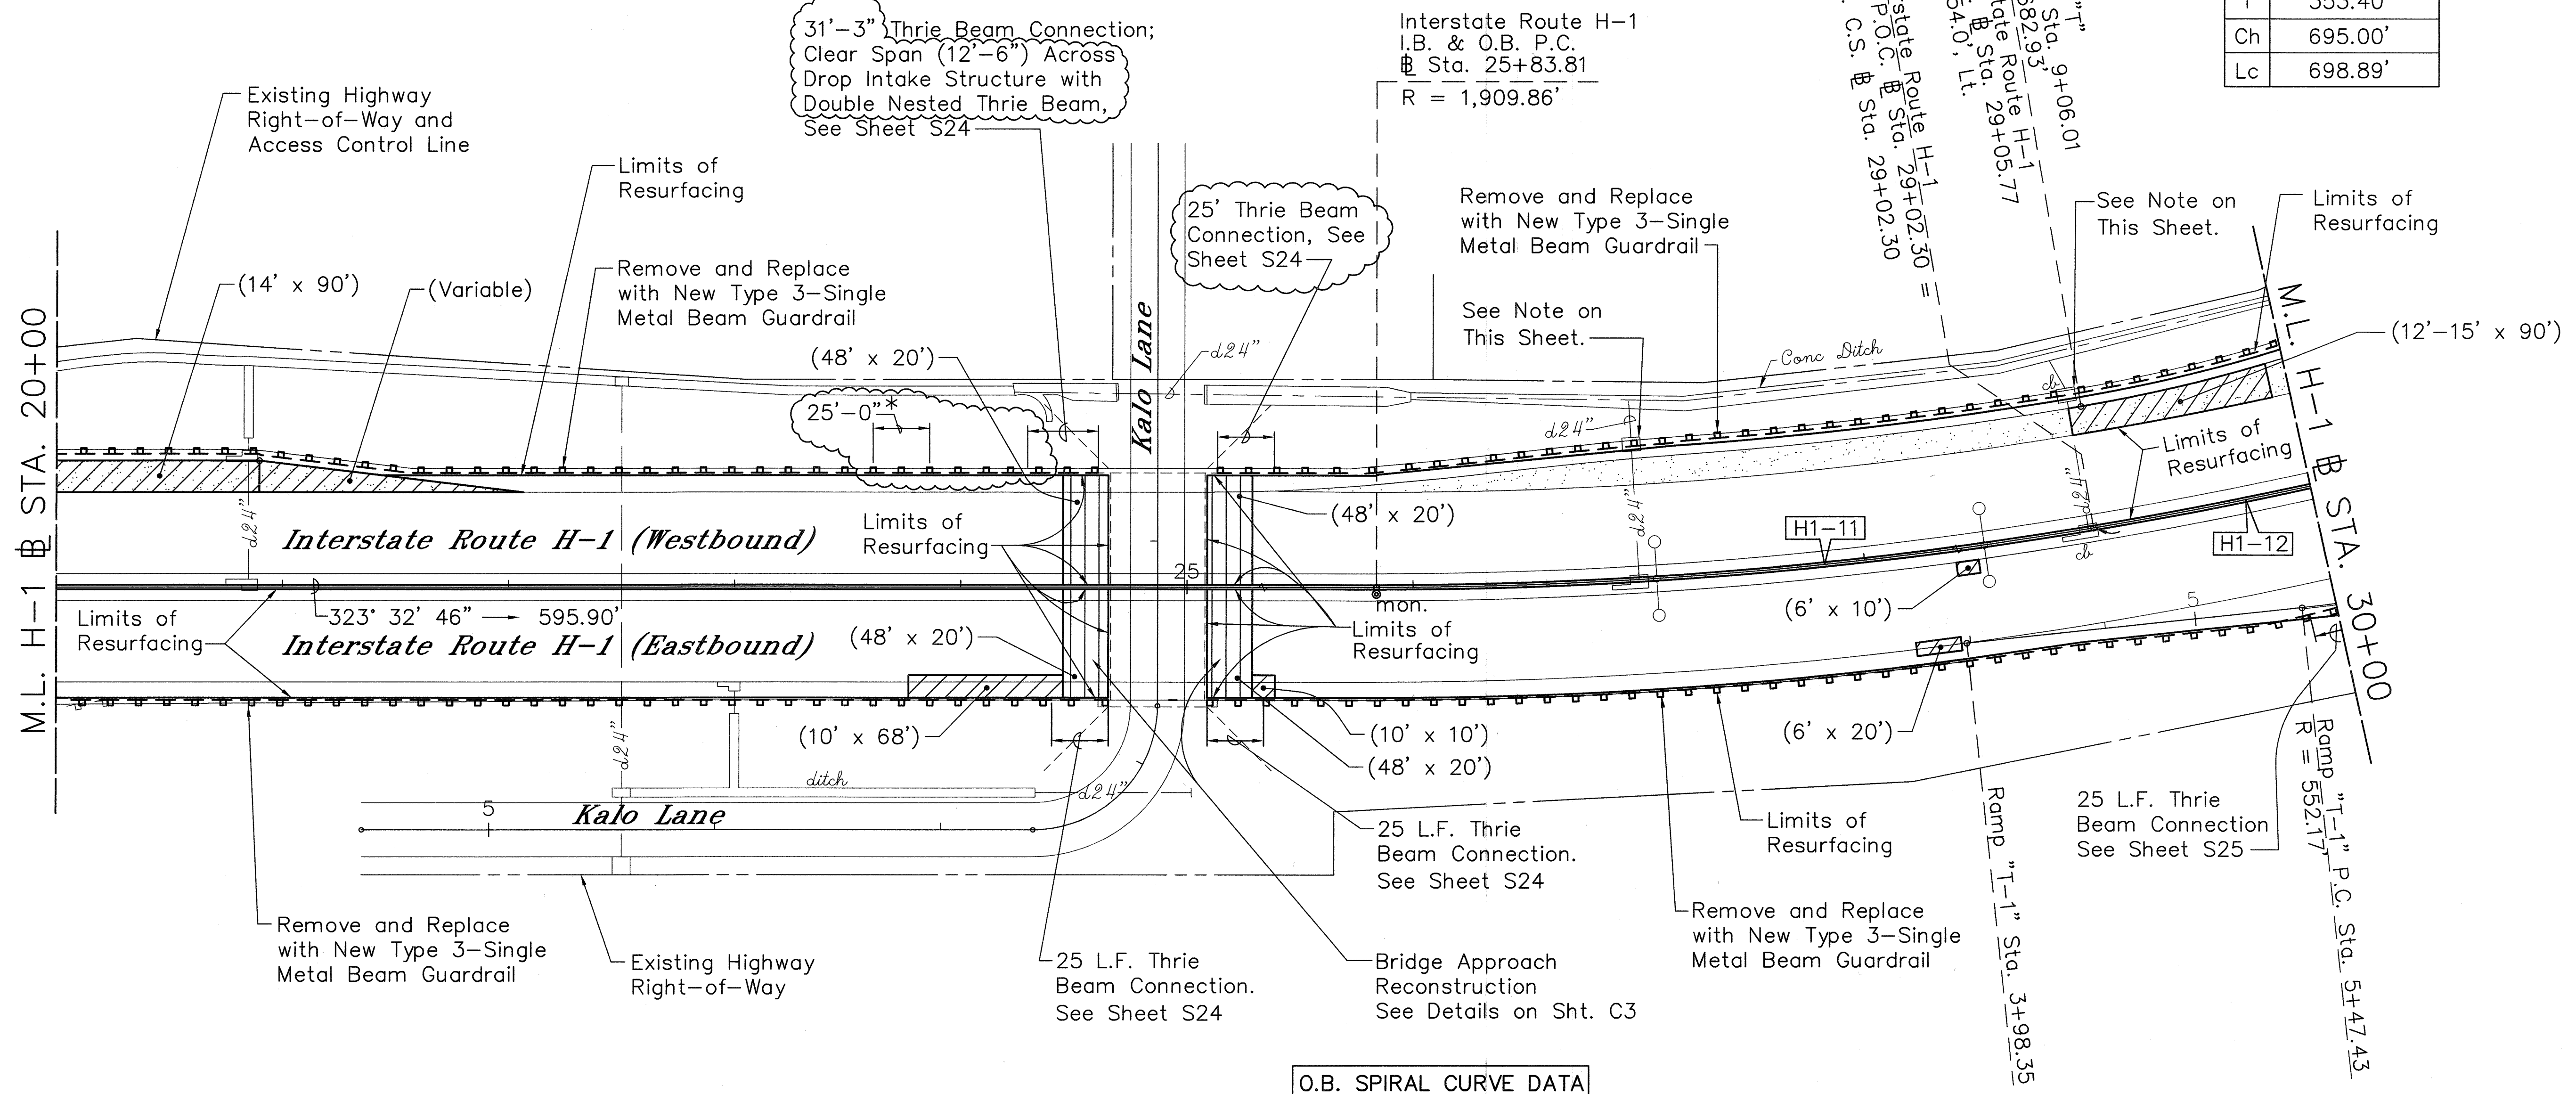

O.B. SPIRAL CURVE DATA	
	H1-12
Ls	800.00
Dc	3.00
Θs	12° 00' 00"
P	13.94
L.C.	798.44
L.T.	534.57
S.T.	267.78
Yc	55.67
Xc	796.50

THIS WORK WAS PREPARED BY ME OR UNDER MY SUPERVISION

Benjamin S. Tanaka

STATE OF HAWAII
 DEPARTMENT OF TRANSPORTATION
 HIGHWAYS DIVISION

ROADWAY PLAN

INTERSTATE ROUTE H-1 RESURFACING
 Vic. of Punchbowl Off Ramp to Kapiolani IC
 F.A.I Project No. IM-H1-1(234)

Scale: 1"=40' Date: June 1, 1999

SHEET NO. R14 OF 34 SHEETS

ROTATED: 53° 36' 00" AT 0,0

DATE: 6/17/98
 SCALE: 1" = 40'
 FILE: 9815-21

PM: BST
 OPER: SHA*FAIBTY
 REVISED: 09/01/00

SURVEY PLOTTED BY: _____ DRAWN BY: _____ DESIGNED BY: _____ QUANTITIES BY: _____ CHECKED BY: _____	ORIGINAL PLAN: _____ NO. _____ NOTEBOOK: _____ NO. _____
--	---

For Guardrail Installations at Existing Drop Intake Structures,
Locate Guardrail Posts Clear of Drop Intake Structures.
Space Guardrail Posts 6'-3" Apart, Center to Center.
If Spacing Exceeds 6'-3" But is Less Than or Equal to
12'-6", Double Nest W-Beam Section with Splice at
Mid-Span. Described Work is Incidental to
Guardrail Type 3-Single with Steel Posts.

Remove and Replace with New Type 3 Single Metal Beam Guardrail; Align Guardrail to have 2' Offset from Face of the Curb where Curb Appears and Flare Guardrail to Provide 3' Clearances from Back of Guardrail Posts to Light Poles.

Remove and Replace
with New Type 3—Single
Metal Beam Guardrail—
Existing Highway
Right-of-Way and
Access Control Line


	[H1-12]
Ls	800.00
Dc	3.00
Θs	12° 00' 00"
P	13.94
L.C.	798.44
L.T.	534.57
S.T.	267.78
Yc	55.67
Xc	796.50

FLEAT-350 Guard Rail
End Terminal
See Details,
Sheet B-10

FED. ROAD DIST. NO.	STATE	FED. AID PROJ. NO.	FISCAL YEAR	SHEET NO.	TOTAL SHEETS
HAWAII	HAW.	IM-H1-1(234)	2000	43	557

I.B. CURVE DATA		
	[H1-11]	[H1-13]
Δ	20° 58' 00"	0° 35' 17"
R	1909.86'	20,000'
T	353.40'	102.64'
Ch	695.00'	205.27'
Lc	698.89'	205.27'

- Remove and Replace with New Type 3—Single Metal Beam Guardrail

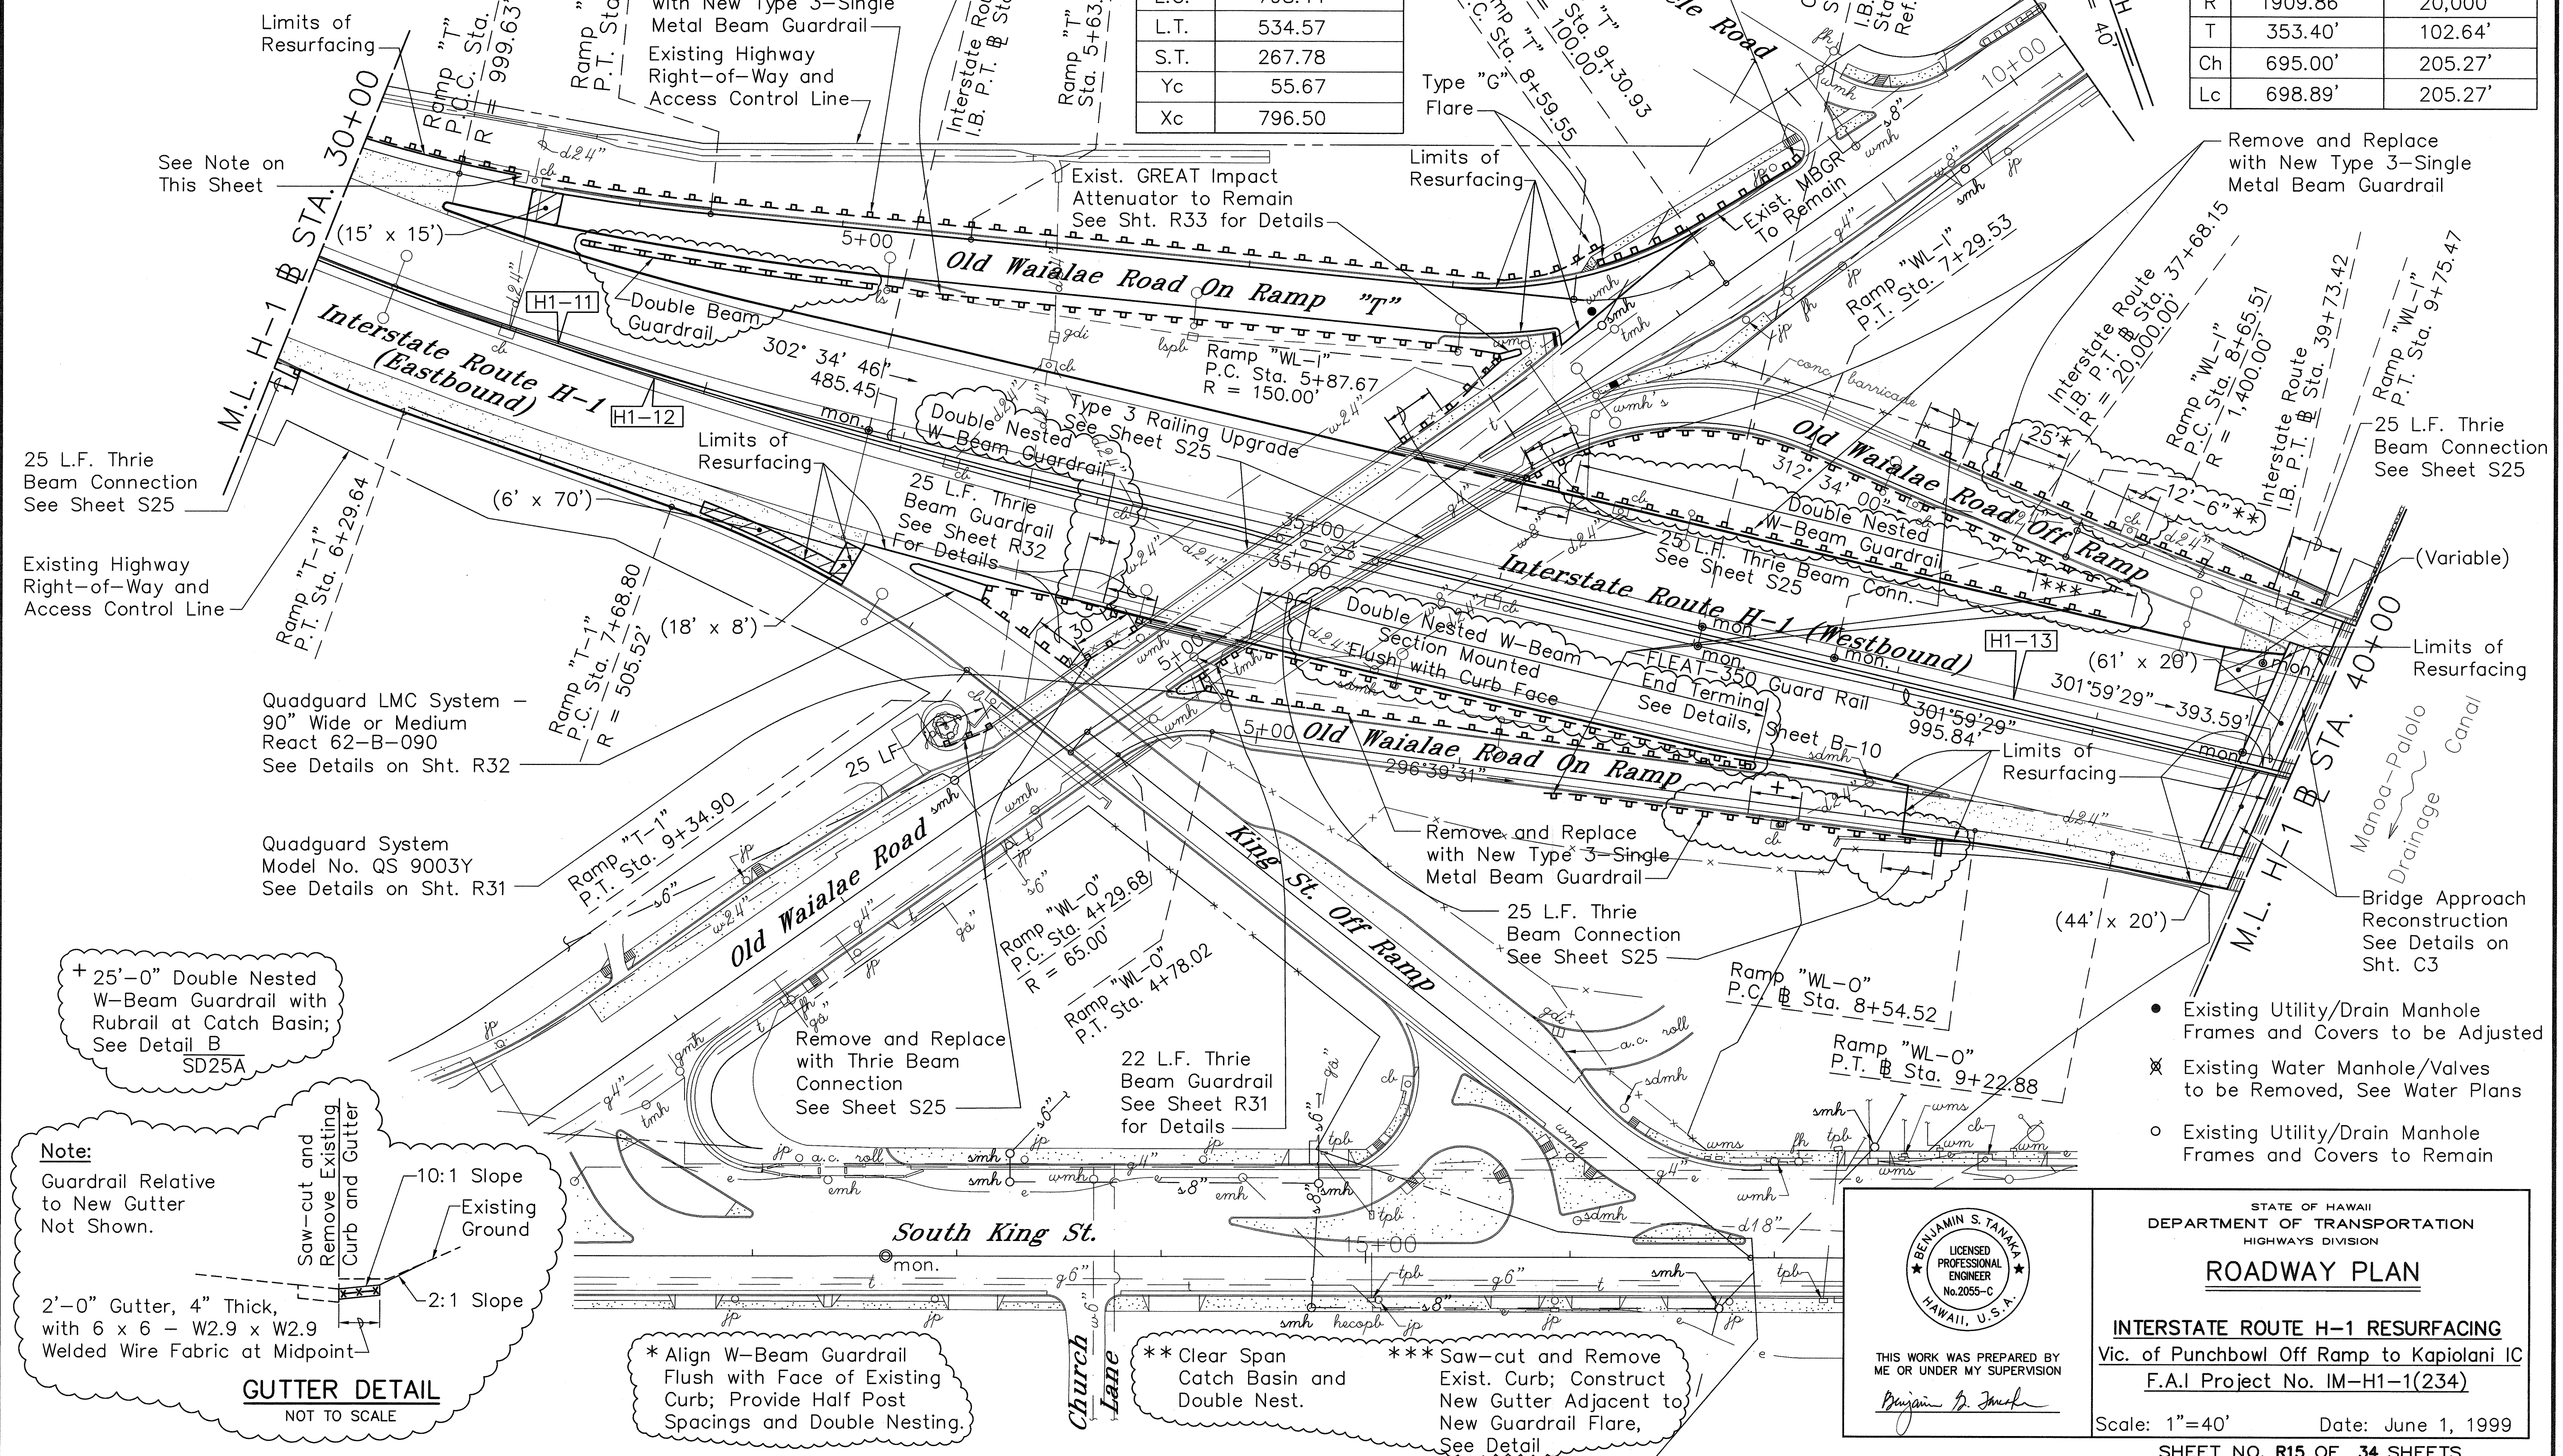

- Existing Utility/Drain Manhole Frames and Covers to be Adjusted
- ✗ Existing Water Manhole/Valves to be Removed, See Water Plans
- Existing Utility/Drain Manhole Frames and Covers to Remain

STATE OF HAWAII
DEPARTMENT OF TRANSPORTATION
HIGHWAYS DIVISION

ROADWAY PLAN


INTERSTATE ROUTE H-1 RESURFACING
Vic. of Punchbowl Off Ramp to Kapiolani IC
 F.A.I Project No. IM-H1-1(234)

Scale: 1"=40' Date: June 1, 1999


SHEET NO. R15 OF 34 SHEETS

CO 43

FED. ROAD DIST. NO.	STATE	FED. AID PROJ. NO.	FISCAL YEAR	SHEET NO.	TOTAL SHEETS
HAWAII	HAW.	IM-H1-1(234)	2000	44	557

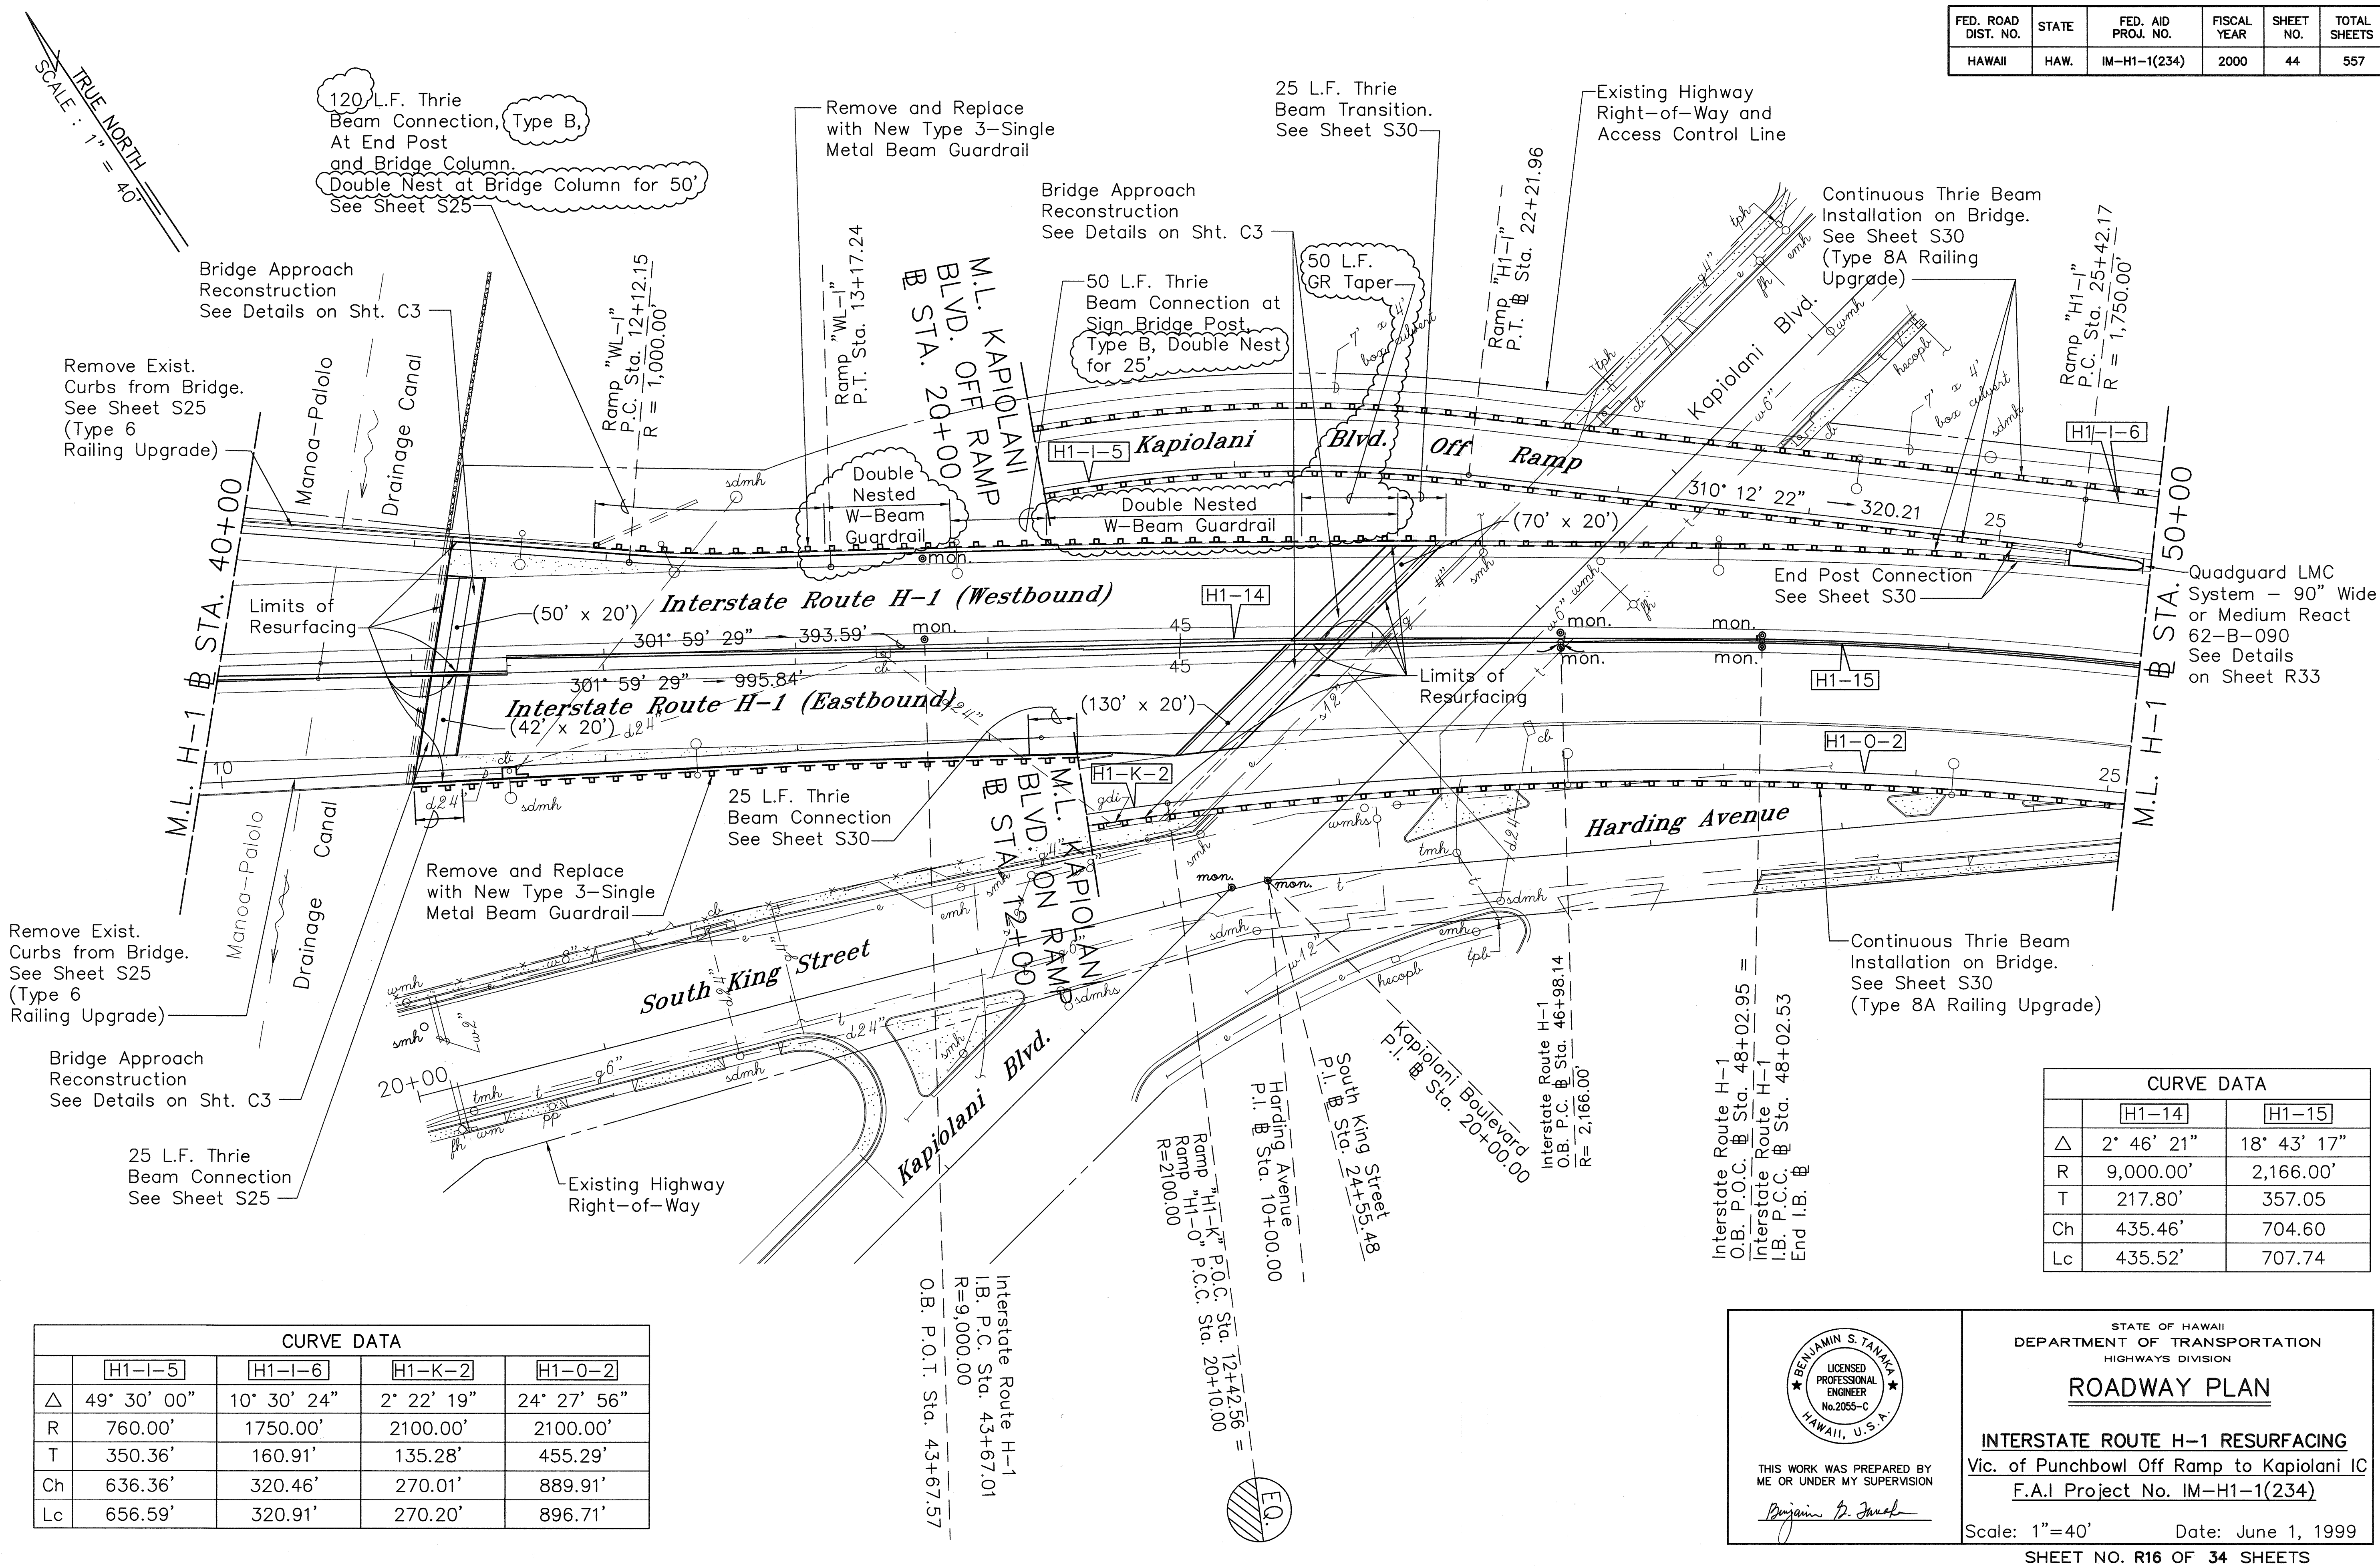

FED. ROAD DIST. NO.	STATE	FED. AID PROJ. NO.	FISCAL YEAR	SHEET NO.	TOTAL SHEETS
HAWAII	HAW.	IM-H1-1(234)	2000	45	557

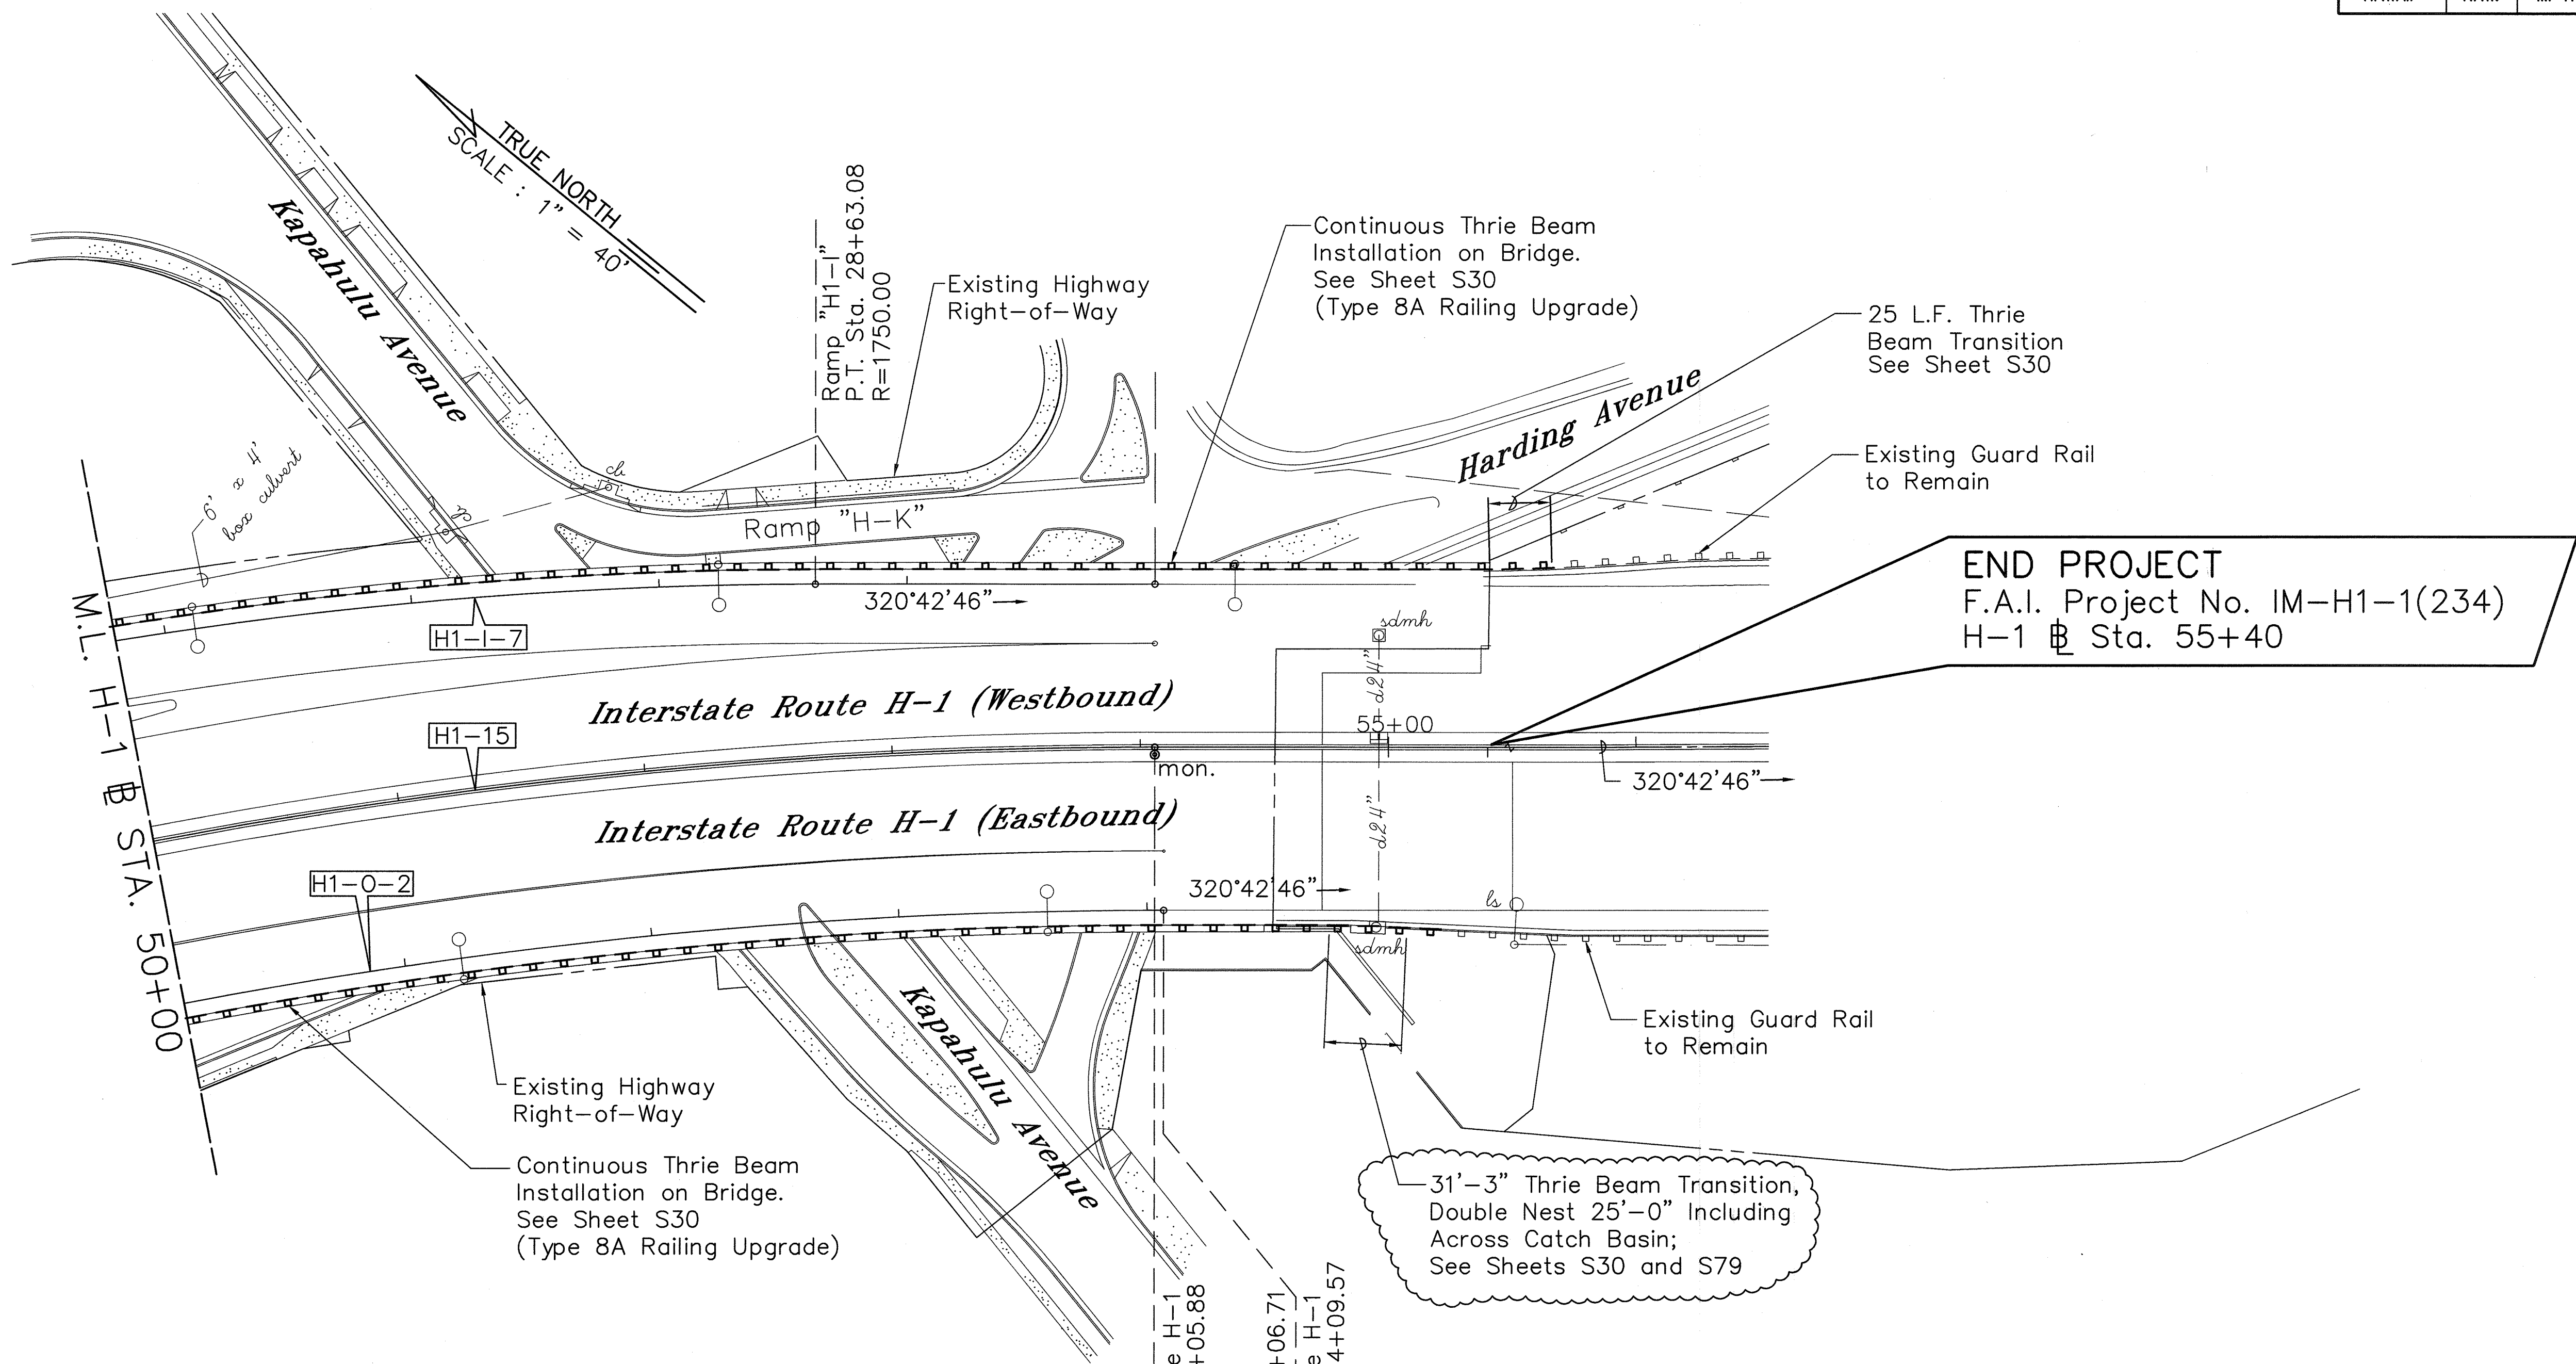

CURVE DATA			
	H1-15	H1-I-7	H1-O-2
Δ	18° 43' 17"	10° 30' 24"	24° 27' 56"
R	2,166.00'	1750.00'	2100.00'
T	357.05'	160.91'	455.29'
Ch	704.60'	320.46'	889.91'
Lc	707.74'	320.91'	896.71'

ROTATED: 50° 45' 59.96"
AT 0.0

DATE: 6/17/98
SCALE: 1" = 40'
FILE: 9815-24

ORIGINAL PLAN	DATE
SURVEY PLOTTED BY	
DRAWN BY	
DESIGNED BY	
QUANTITIES BY	
CHECKED BY	

THIS WORK WAS PREPARED BY ME OR UNDER MY SUPERVISION

Benjamin S. Tanaka

STATE OF HAWAII
DEPARTMENT OF TRANSPORTATION
HIGHWAYS DIVISION

ROADWAY PLAN


INTERSTATE ROUTE H-1 RESURFACING
Vic. of Punchbowl Off Ramp to Kapiolani IC
F.A.I. Project No. IM-H1-1(234)

Scale: 1"=40' Date: June 1, 1999

SHEET NO. R17 OF 34 SHEETS

FED. ROAD DIST. NO.	STATE	FED. AID PROJ. NO.	FISCAL YEAR	SHEET NO.	TOTAL SHEETS
HAWAII	HAW.	IM-H1-1(234)	2000	46	557

TRUE NORTH
SCALE : 1" = 40'

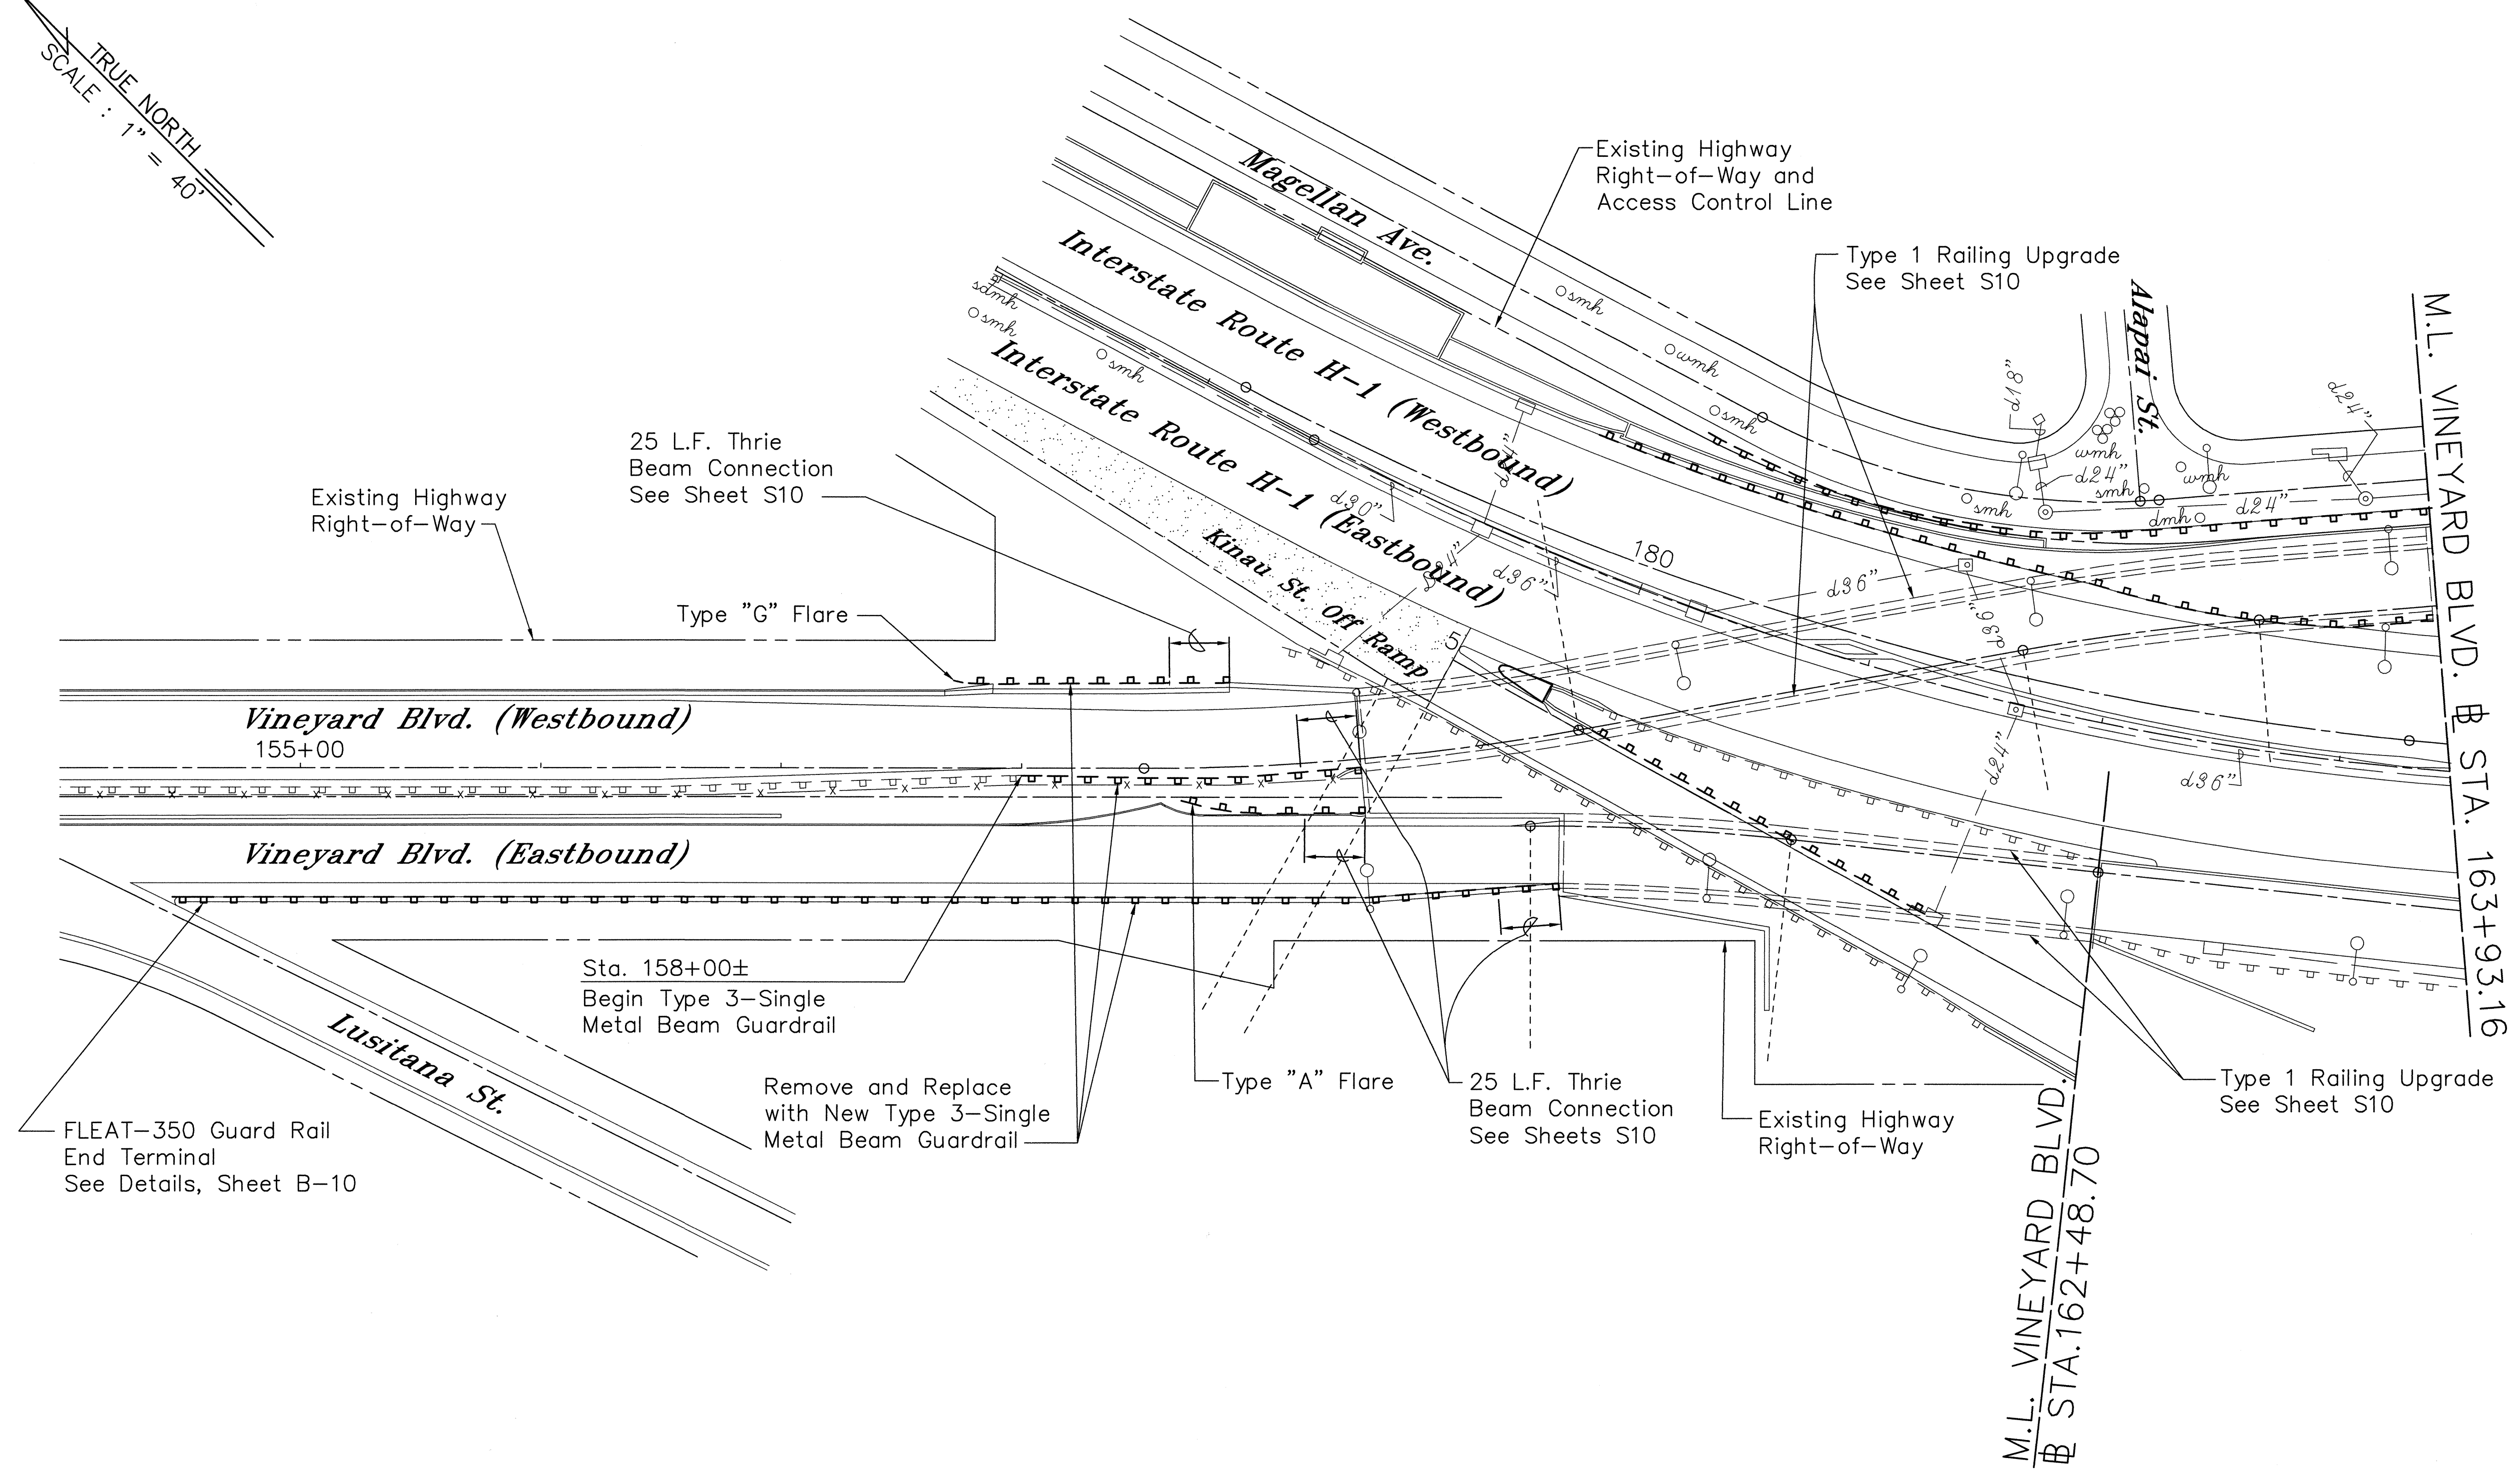

ROTATED: 45° 05' 34.4"
AT 0.0

DATE: 6/17/98
SCALE: 1" = 40'
FILE: 9815-26

ORIGINAL PLAN	DATE
DRAWN BY	
CHECKED BY	
DESIGNED BY	
QUANTITIES BY	
CHECKED BY	

BENJAMIN S. TANAKA
LICENSED PROFESSIONAL ENGINEER
No. 2055-C
HAWAII, U.S.A.

THIS WORK WAS PREPARED BY
ME OR UNDER MY SUPERVISION

Benjamin S. Tanaka

STATE OF HAWAII
DEPARTMENT OF TRANSPORTATION
HIGHWAYS DIVISION


ROADWAY PLAN

INTERSTATE ROUTE H-1 RESURFACING
Vic. of Punchbowl Off Ramp to Kapiolani IC
F.A.I. Project No. IM-H1-1(234)


Scale: 1"=40' Date: June 1, 1999

SHEET NO. R18 OF 34 SHEETS


FED. ROAD DIST. NO.	STATE	FED. AID PROJ. NO.	FISCAL YEAR	SHEET NO.	TOTAL SHEETS
HAWAII	HAW.	IM-H1-1(234)	2000	47S-1	557

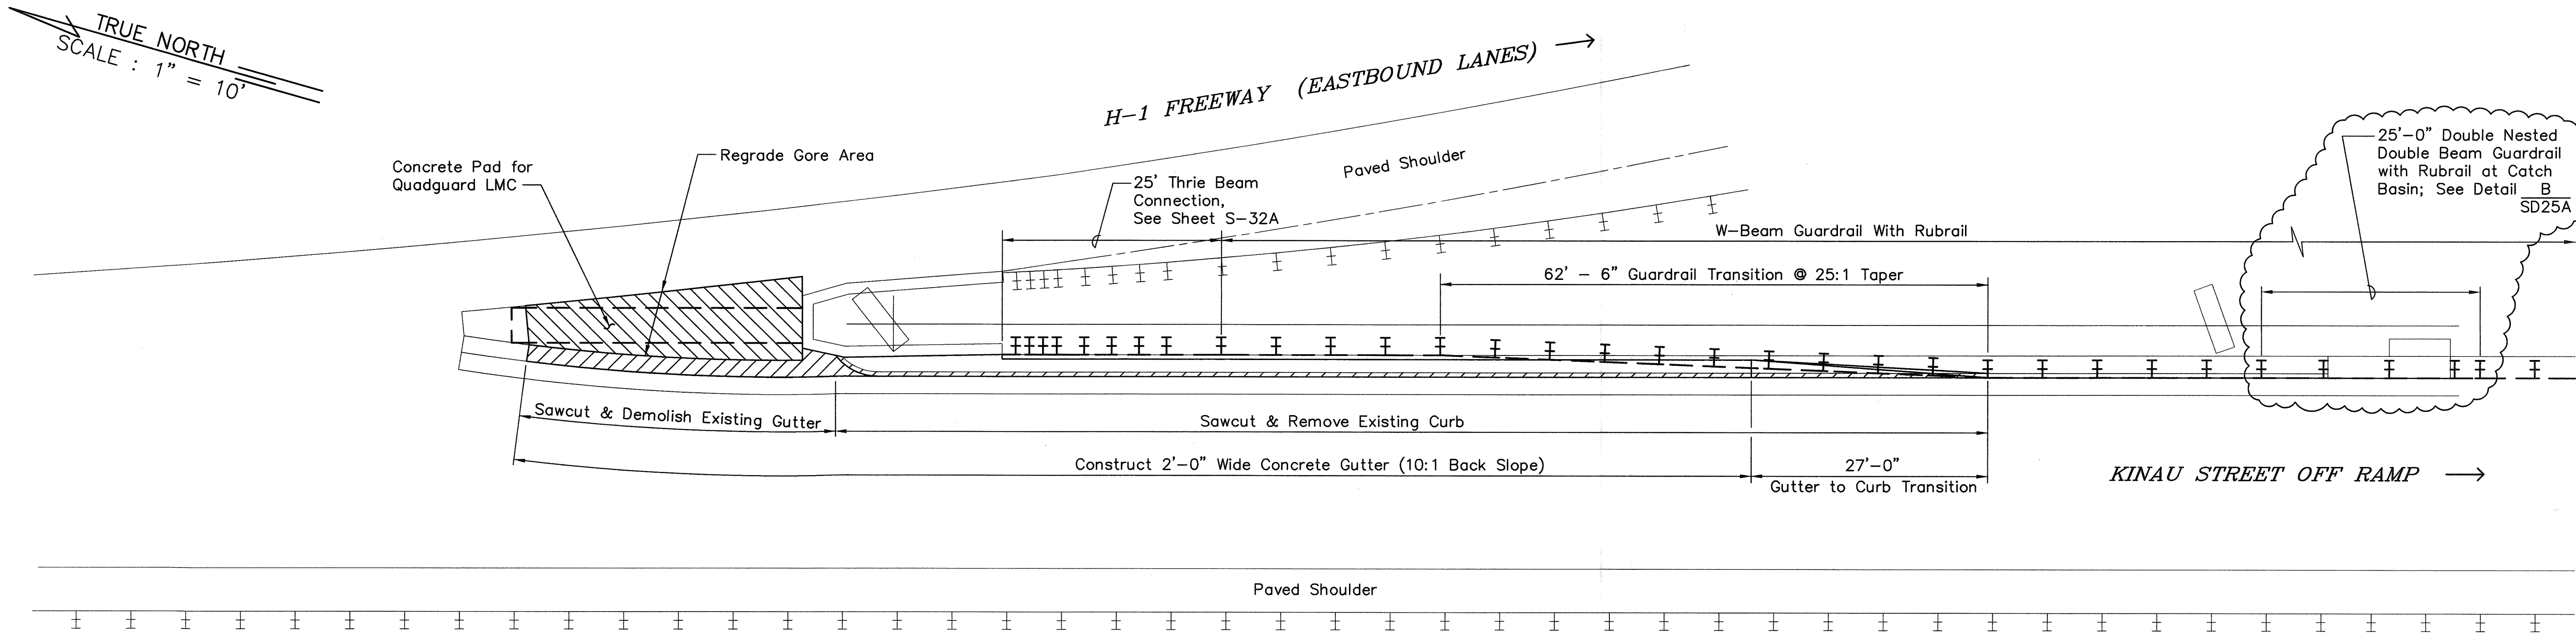

ENLARGED PLAN
SCALE: 1" = 10'

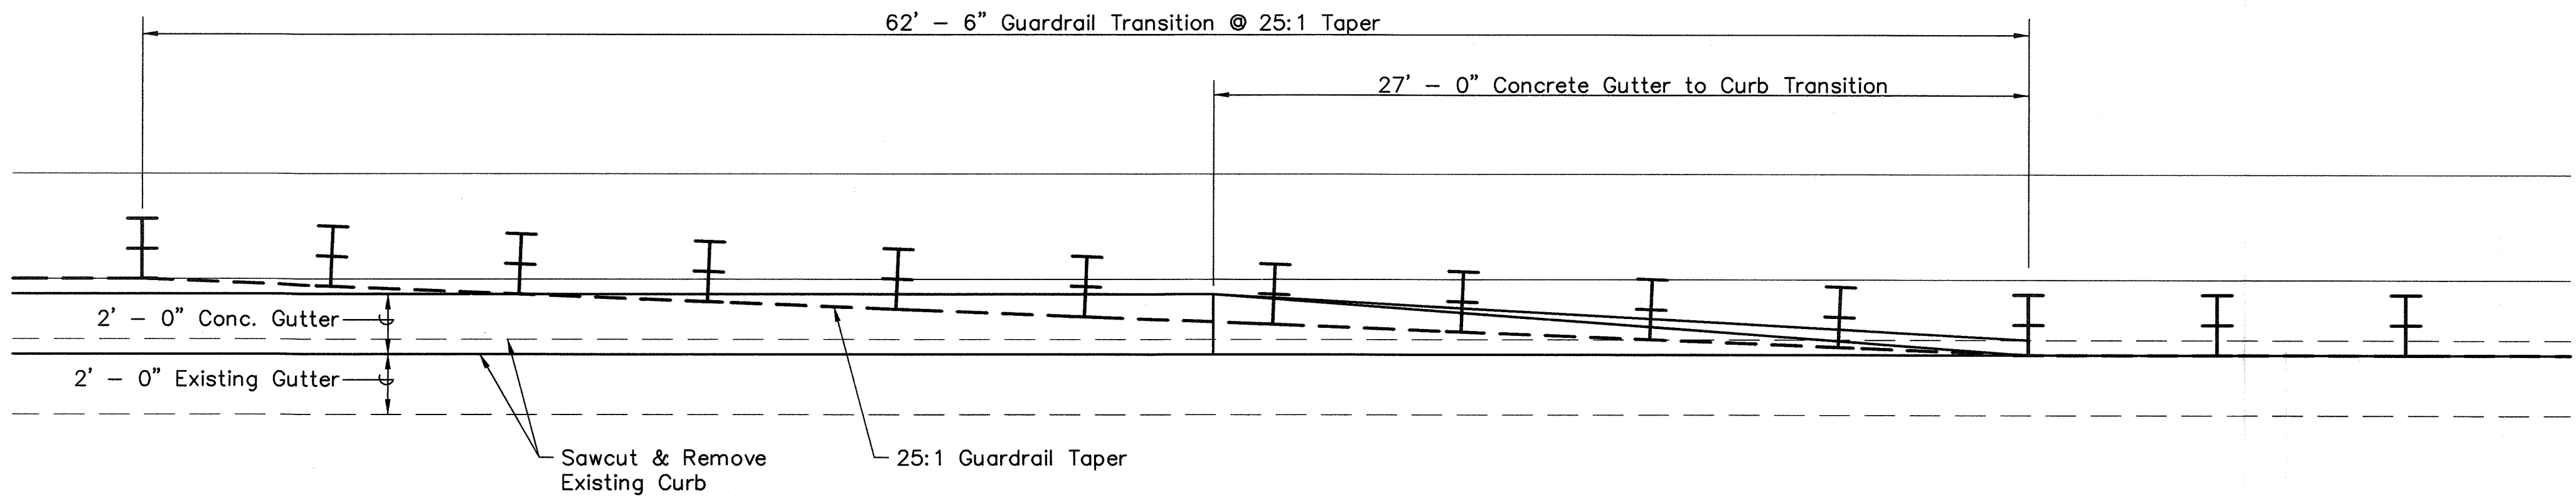


GUTTER/GUARDRAIL TRANSITION DETAIL
SCALE: 1/4" = 1' - 0"

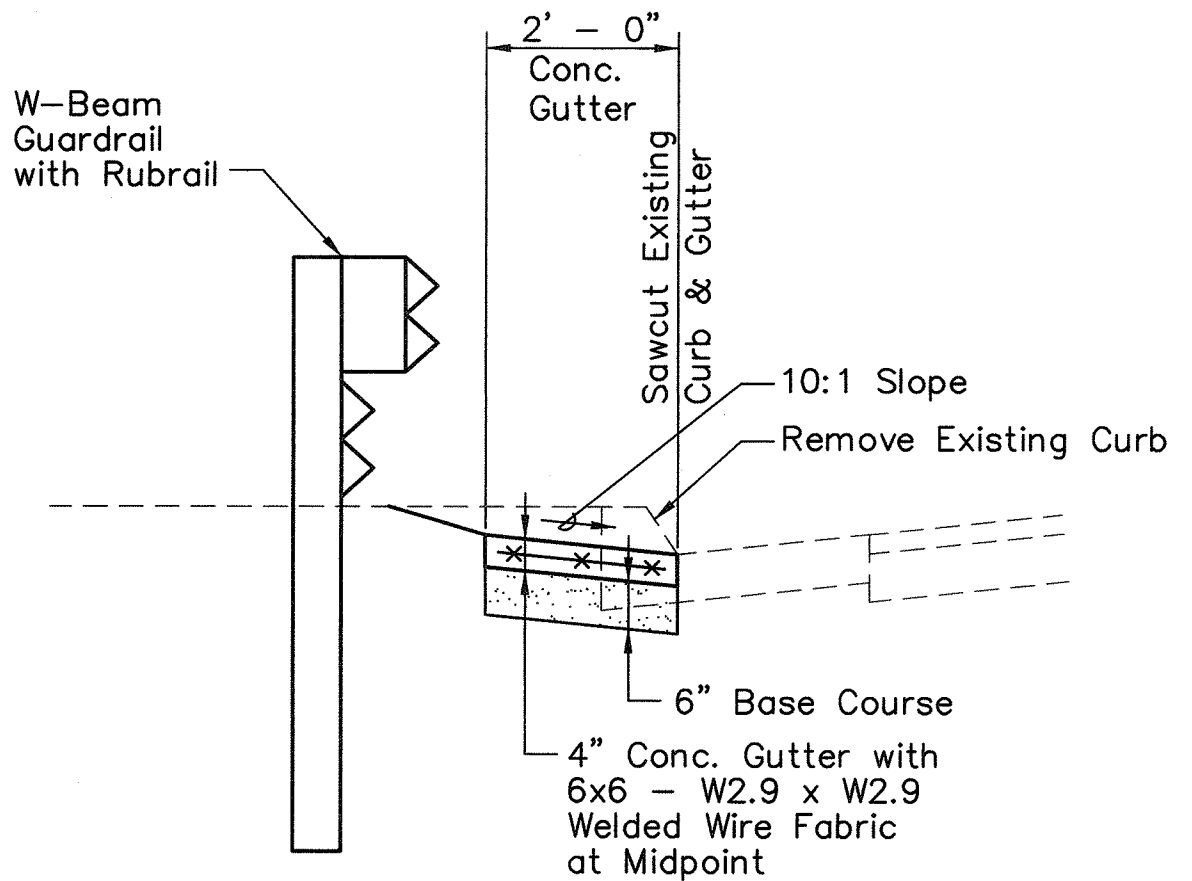

TYPICAL SECTION AT KINAU ST. OFF RAMP
SCALE: 1/2" = 1' - 0"

GRAPHIC SCALES:

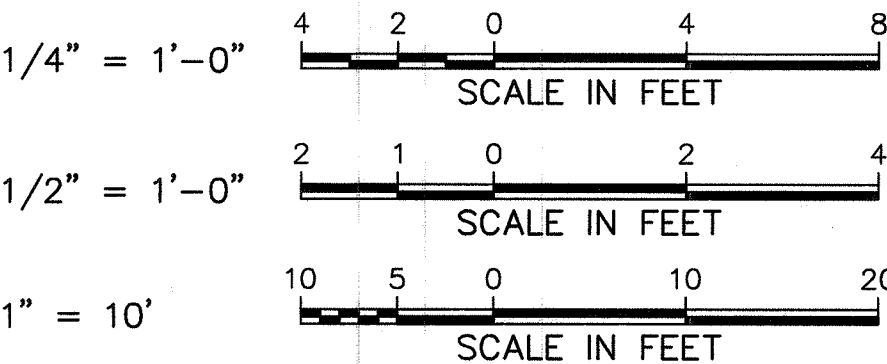

THIS WORK WAS PREPARED BY
ME OR UNDER MY SUPERVISION

Benjamin S. Tanaka

STATE OF HAWAII
DEPARTMENT OF TRANSPORTATION
HIGHWAYS DIVISION

ROADWAY PLAN

INTERSTATE ROUTE H-1 RESURFACING
Vic. of Punchbowl Off Ramp to Kapiolani IC
F.A.I Project No. IM-H1-1(234)


Scale: 1" = 10'-0" Date: June 1, 1999

SHEET NO. **19A** OF **34** SHEETS

ORIGINAL PLAN	SURVEY PLOTTED BY	DATE
NOTED	DRAWN BY	
DESIGNED BY	TRACED BY	
QUANTITIES BY	CHECKED BY	
FILE: 9815-247	DATE: 08/16/00	PM: BST/TCL
SCALE: 1" = 10'	OPER: *FAIBTY	REVIS: 09/28/00

FED. ROAD DIST. NO.	STATE	FED. AID PROJ. NO.	FISCAL YEAR	SHEET NO.	TOTAL SHEETS
HAWAII	HAW.	IM-H1-1(234)	2000	48	557

TRUE NORTH
SCALE : 1" = 40'

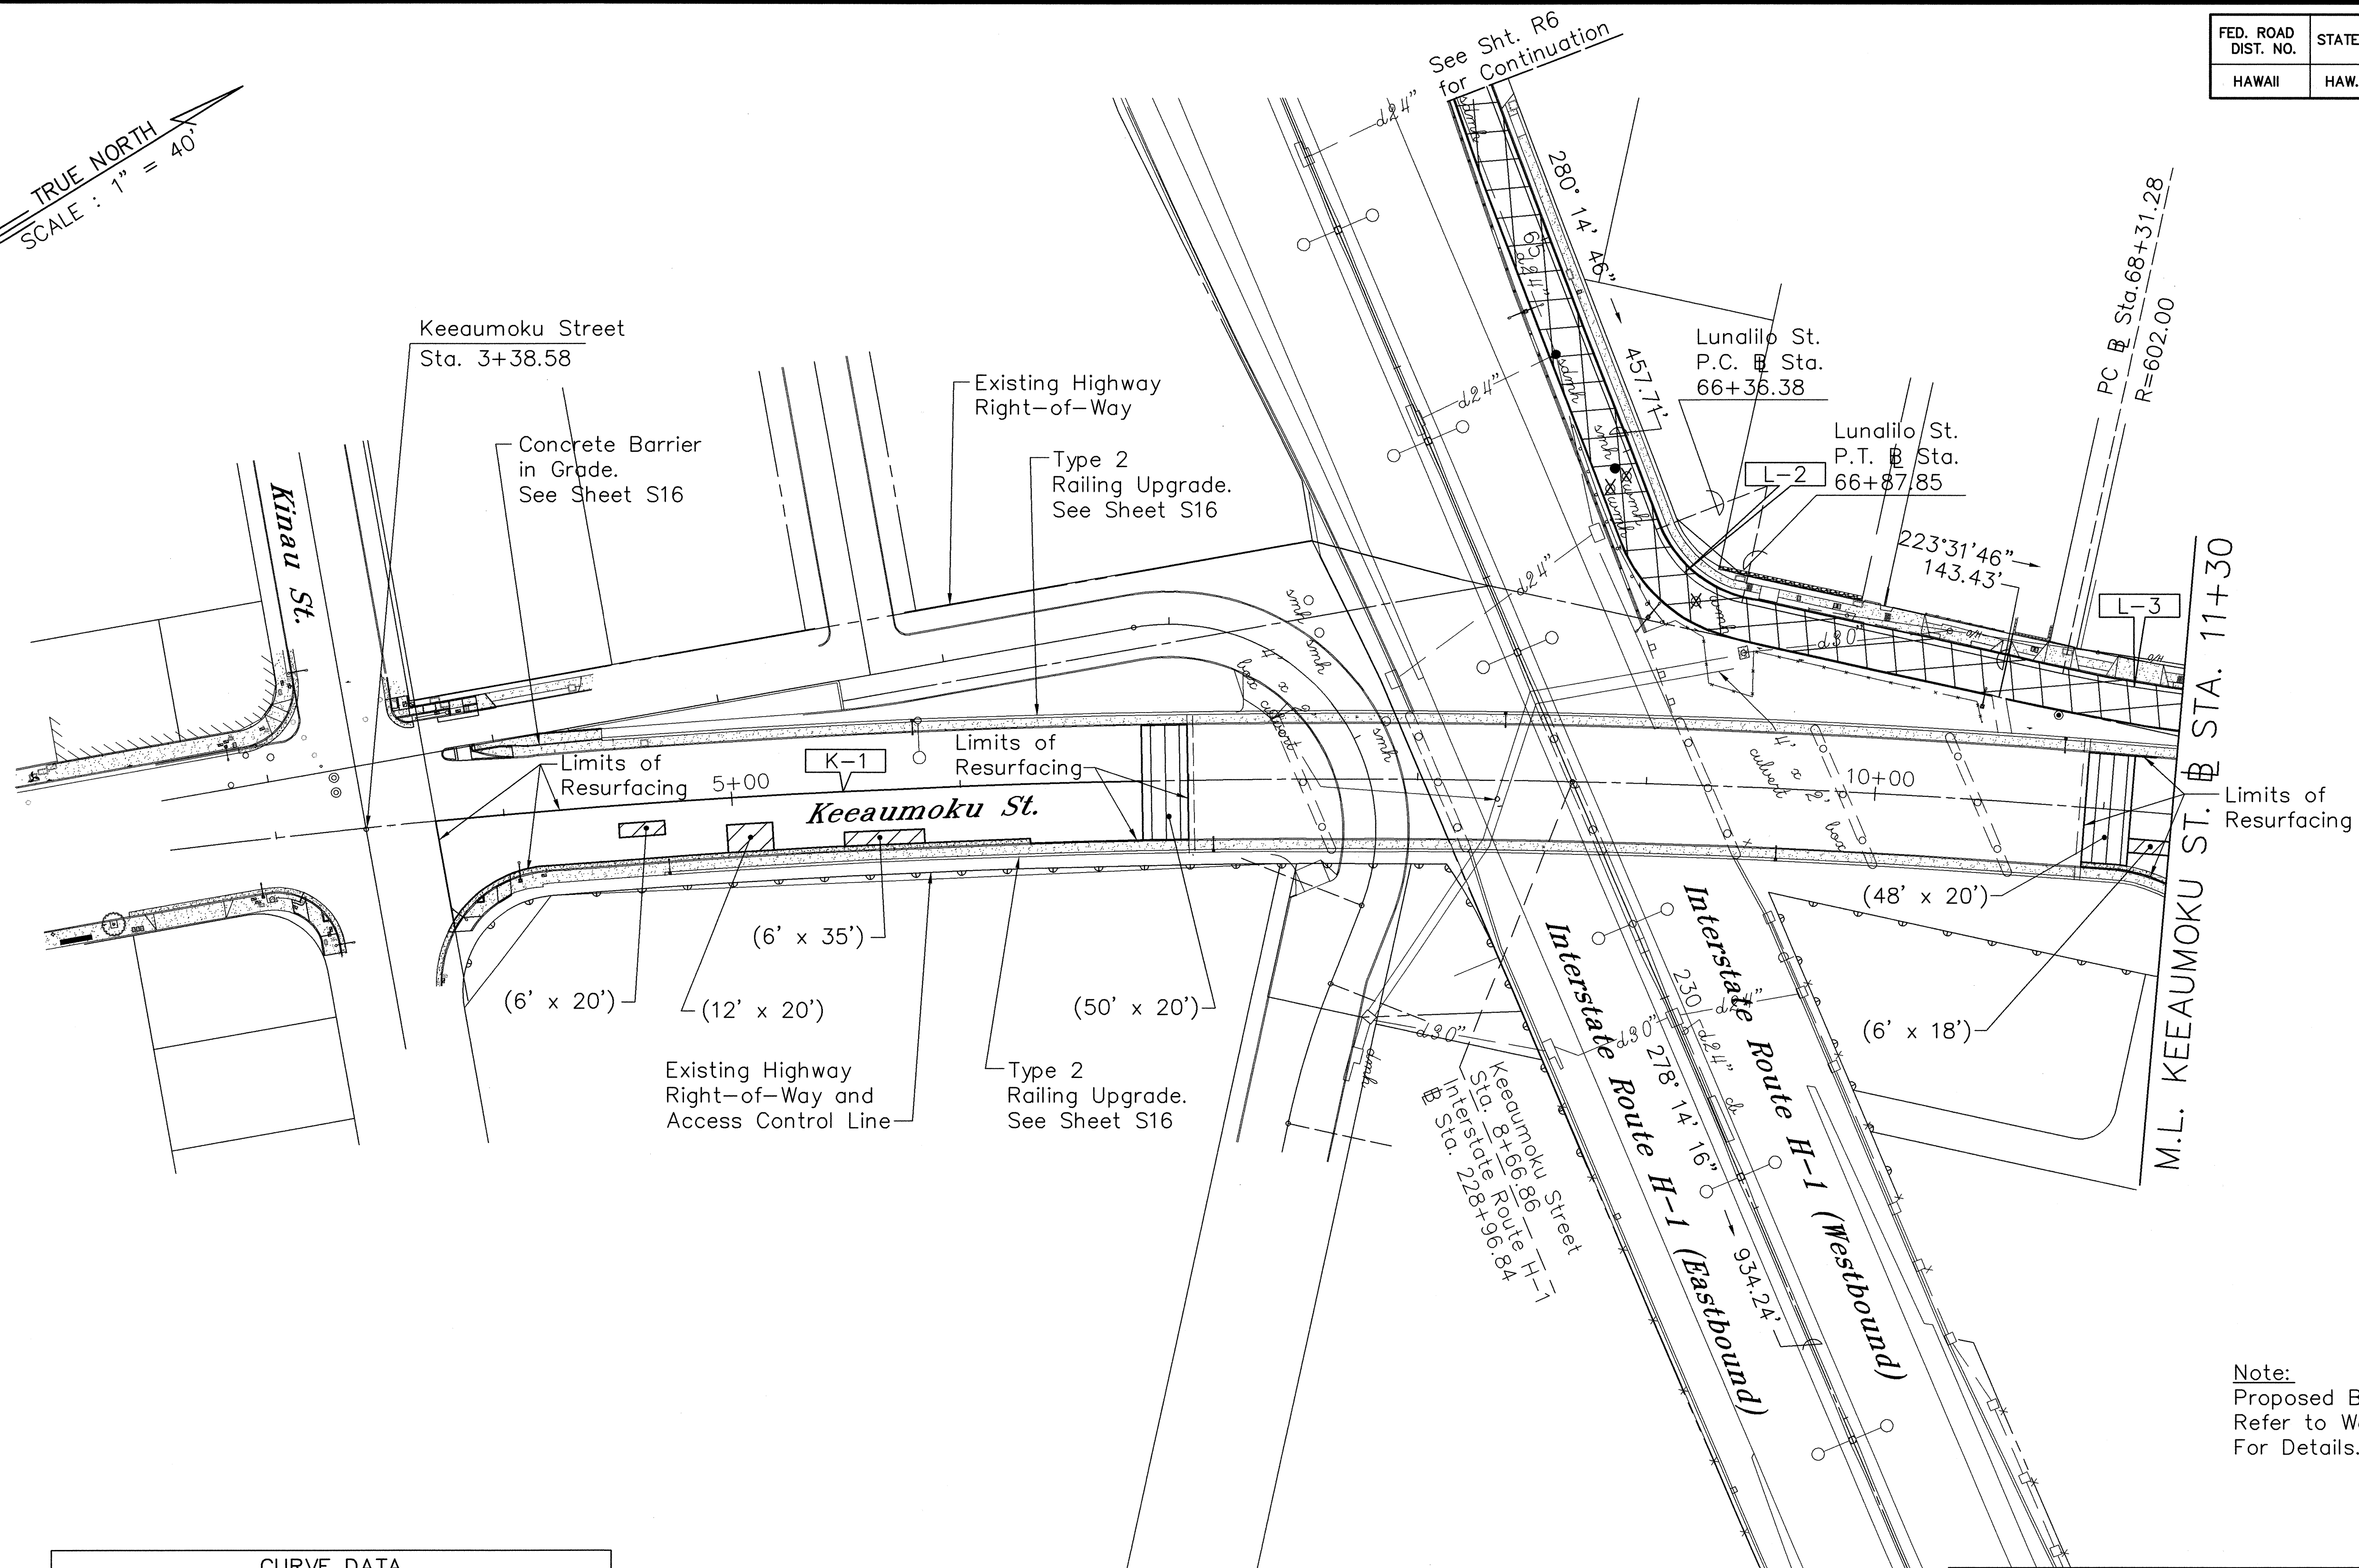

ROTATED: (-)58° 39' 47.46"
AT 0.0

ORIGINAL PLAN	DATE
DRAWN BY	
CHECKED BY	
NOTED BY	
FILED BY	
DATE	

DATE: 6/17/98
SCALE: 1" = 40'
FILE: 9815-28
REVISED: 05/03/99
PM: BST
OPER: SHA, FAL

CURVE DATA			
	K-1	L-2	L-3
Δ	16° 41' 00"	56° 43' 00"	7° 17' 51"
R	4200.00'	52.00'	602.00'
T	615.83'	28.07'	38.39'
Ch	1218.64'	39.40'	76.62'
Lc	1222.95'	51.47'	76.67'

- Existing Utility/Drain Manhole Frames and Covers to be Adjusted
- Existing Water Manhole/Valves to be Removed, See Water Plans
- Existing Utility/Drain Manhole Frames and Covers to Remain



THIS WORK WAS PREPARED BY
ME OR UNDER MY SUPERVISION

Benjamin S. Tanaka

STATE OF HAWAII
DEPARTMENT OF TRANSPORTATION
HIGHWAYS DIVISION


ROADWAY PLAN

INTERSTATE ROUTE H-1 RESURFACING
Vic. of Punchbowl Off Ramp to Kapiolani IC
F.A.I Project No. IM-H1-1(234)

Scale: 1"=40' Date: June 1, 1999

SHEET NO. R20 OF 34 SHEETS

FED. ROAD DIST. NO.	STATE	FED. AID PROJ. NO.	FISCAL YEAR	SHEET NO.	TOTAL SHEETS
HAWAII	HAW.	IM-H1-1(234)	2000	52	557

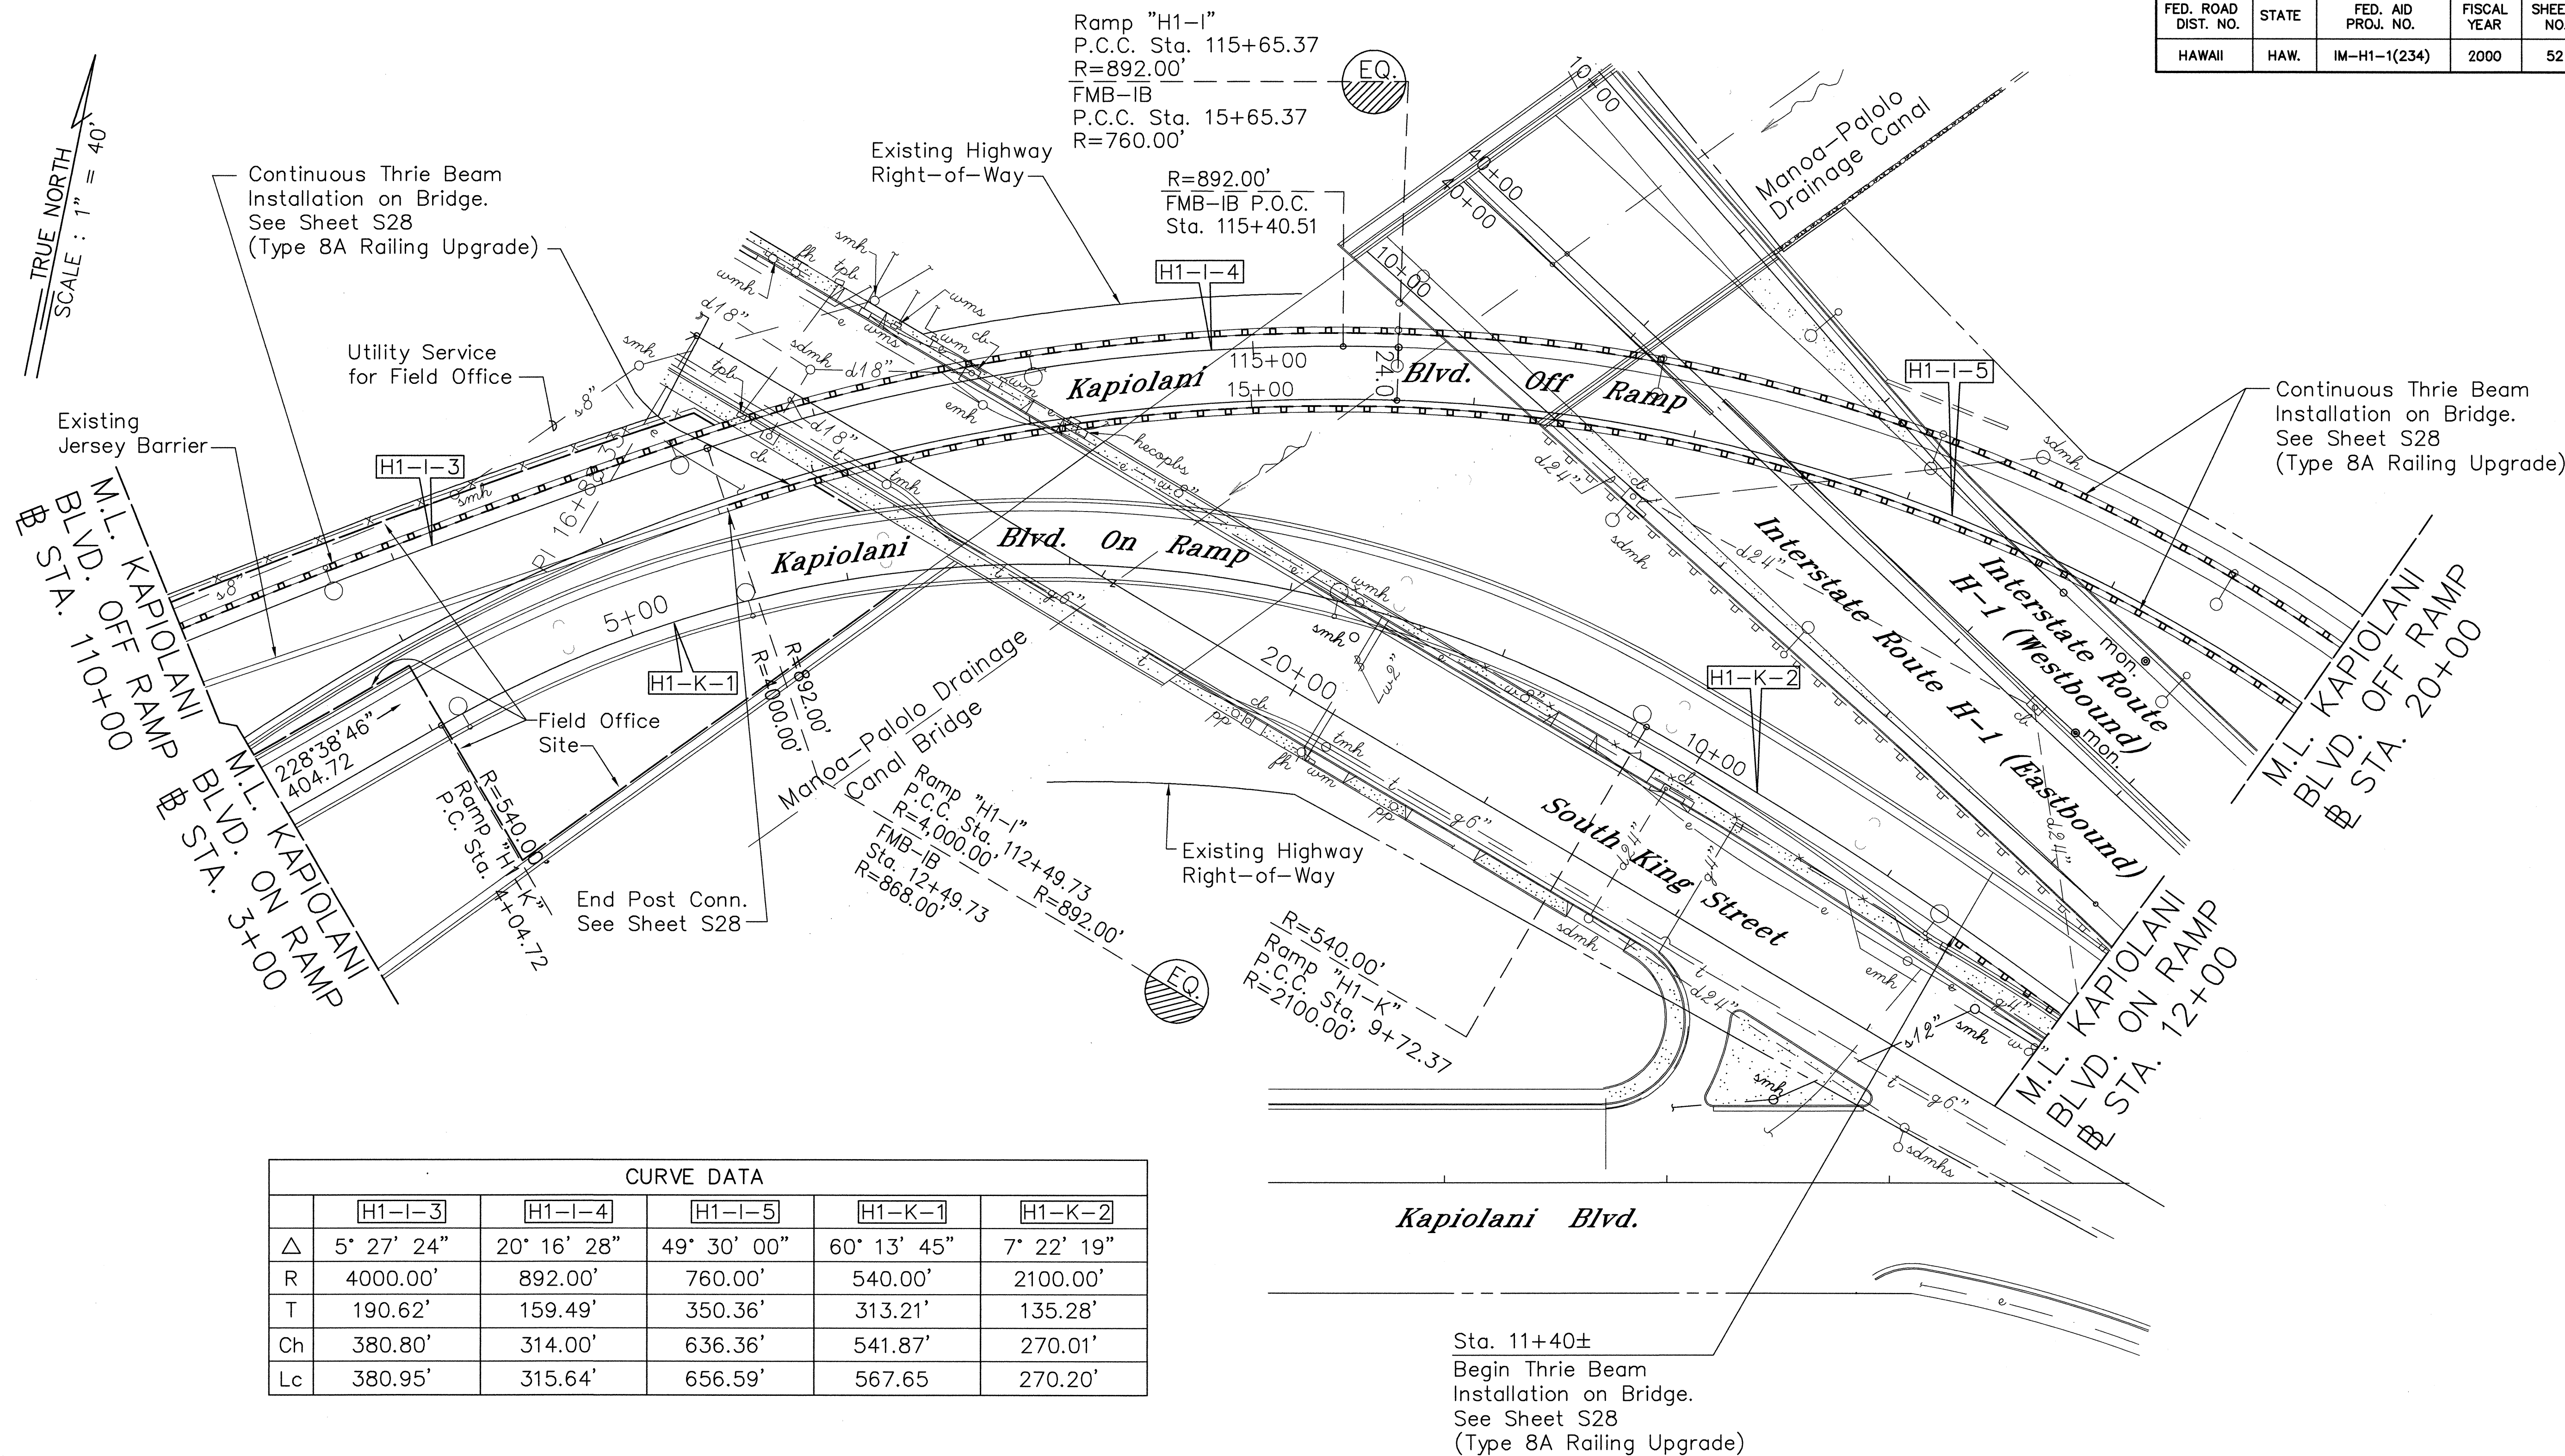

CURVE DATA					
	H1-I-3	H1-I-4	H1-I-5	H1-K-1	H1-K-2
Δ	5° 27' 24"	20° 16' 28"	49° 30' 00"	60° 13' 45"	7° 22' 19"
R	4000.00'	892.00'	760.00'	540.00'	2100.00'
T	190.62'	159.49'	350.36'	313.21'	135.28'
Ch	380.80'	314.00'	636.36'	541.87'	270.01'
Lc	380.95'	315.64'	656.59'	567.65'	270.20'

ROTATED: (-)11° 14' 0.27"
 AT 0.0

DATE	DATE
SURVEY PLOTTED BY	
DRAWN BY	
CHECKED BY	
NOTED BY	
NO.	

PM: BST
 OPER: SHA,FAI
 REVISED: 05/03/99

DATE: 6/17/98
 SCALE: 1" = 40'
 FILE: 9815-32

THIS WORK WAS PREPARED BY
 ME OR UNDER MY SUPERVISION
Benjamin S. Tanaka

STATE OF HAWAII
DEPARTMENT OF TRANSPORTATION
HIGHWAYS DIVISION

ROADWAY PLAN

INTERSTATE ROUTE H-1 RESURFACING
 Vic. of Punchbowl Off Ramp to Kapiolani IC
 F.A.I Project No. IM-H1-1(234)

Scale: 1"=40' Date: June 1, 1999