




INDEX TO DRAWINGS	
SHEET NO.	DESCRIPTION
1	TITLE SHEET
2	STANDARD PLANS SUMMARY
3	GENERAL NOTES AND LEGEND
4	NPDES GENERAL NOTES
5 - 14	TYPICAL SECTIONS
15 - 18	CURB RAMPS DETAILS
19 - 21	GUARDRAIL DETAILS
22	QUADGUARD DETAIL
23 - 30	REINFORCING PLAN AND DETAILS
31 - 35	ROADWAY PLANS
36	DETAIL ROADWAY PLAN
37 - 38	DETOUR PLANS
39 - 41	GRADE CONTROL PLANS
42	PAVEMENT MARKING LEGEND, DETAILS AND NOTES
43 - 47	PAVEMENT MARKING AND SIGNING PLANS
48 - 49	SIGN DETAILS
50 - 51	TRAFFIC SUMMARIES
52 - 53	TRAFFIC SIGNAL PLANS
54	LOOP DETECTOR PLAN

Sheet Nos. 17S-1, 36S-1 and 41S-1 are Supplementary sheets to this project. Total sheet count after "AS-BUILT" posting 57 sheets.

STATE OF HAWAII
DEPARTMENT OF TRANSPORTATION
HIGHWAYS DIVISION
HONOLULU, HAWAII
"AS-BUILT"
PLANS FOR
INTERSTATE ROUTE H-1 RESURFACING
ON RAMPS AT 5TH AND 11TH AVENUES AND
OFF RAMPS AT 6TH, KOKO HEAD AND WAIALAE AVENUES
FEDERAL-AID INTERSTATE PROJECT NO. NH-H1-1(236)

DISTRICT OF HONOLULU
ISLAND OF OAHU


FED. ROAD DIST. NO.	STATE	FED. AID PROJ. NO.	FISCAL YEAR	SHEET NO.	TOTAL SHEETS
HAWAII	HAW.	NH-H1-1(236)	1999	1	54

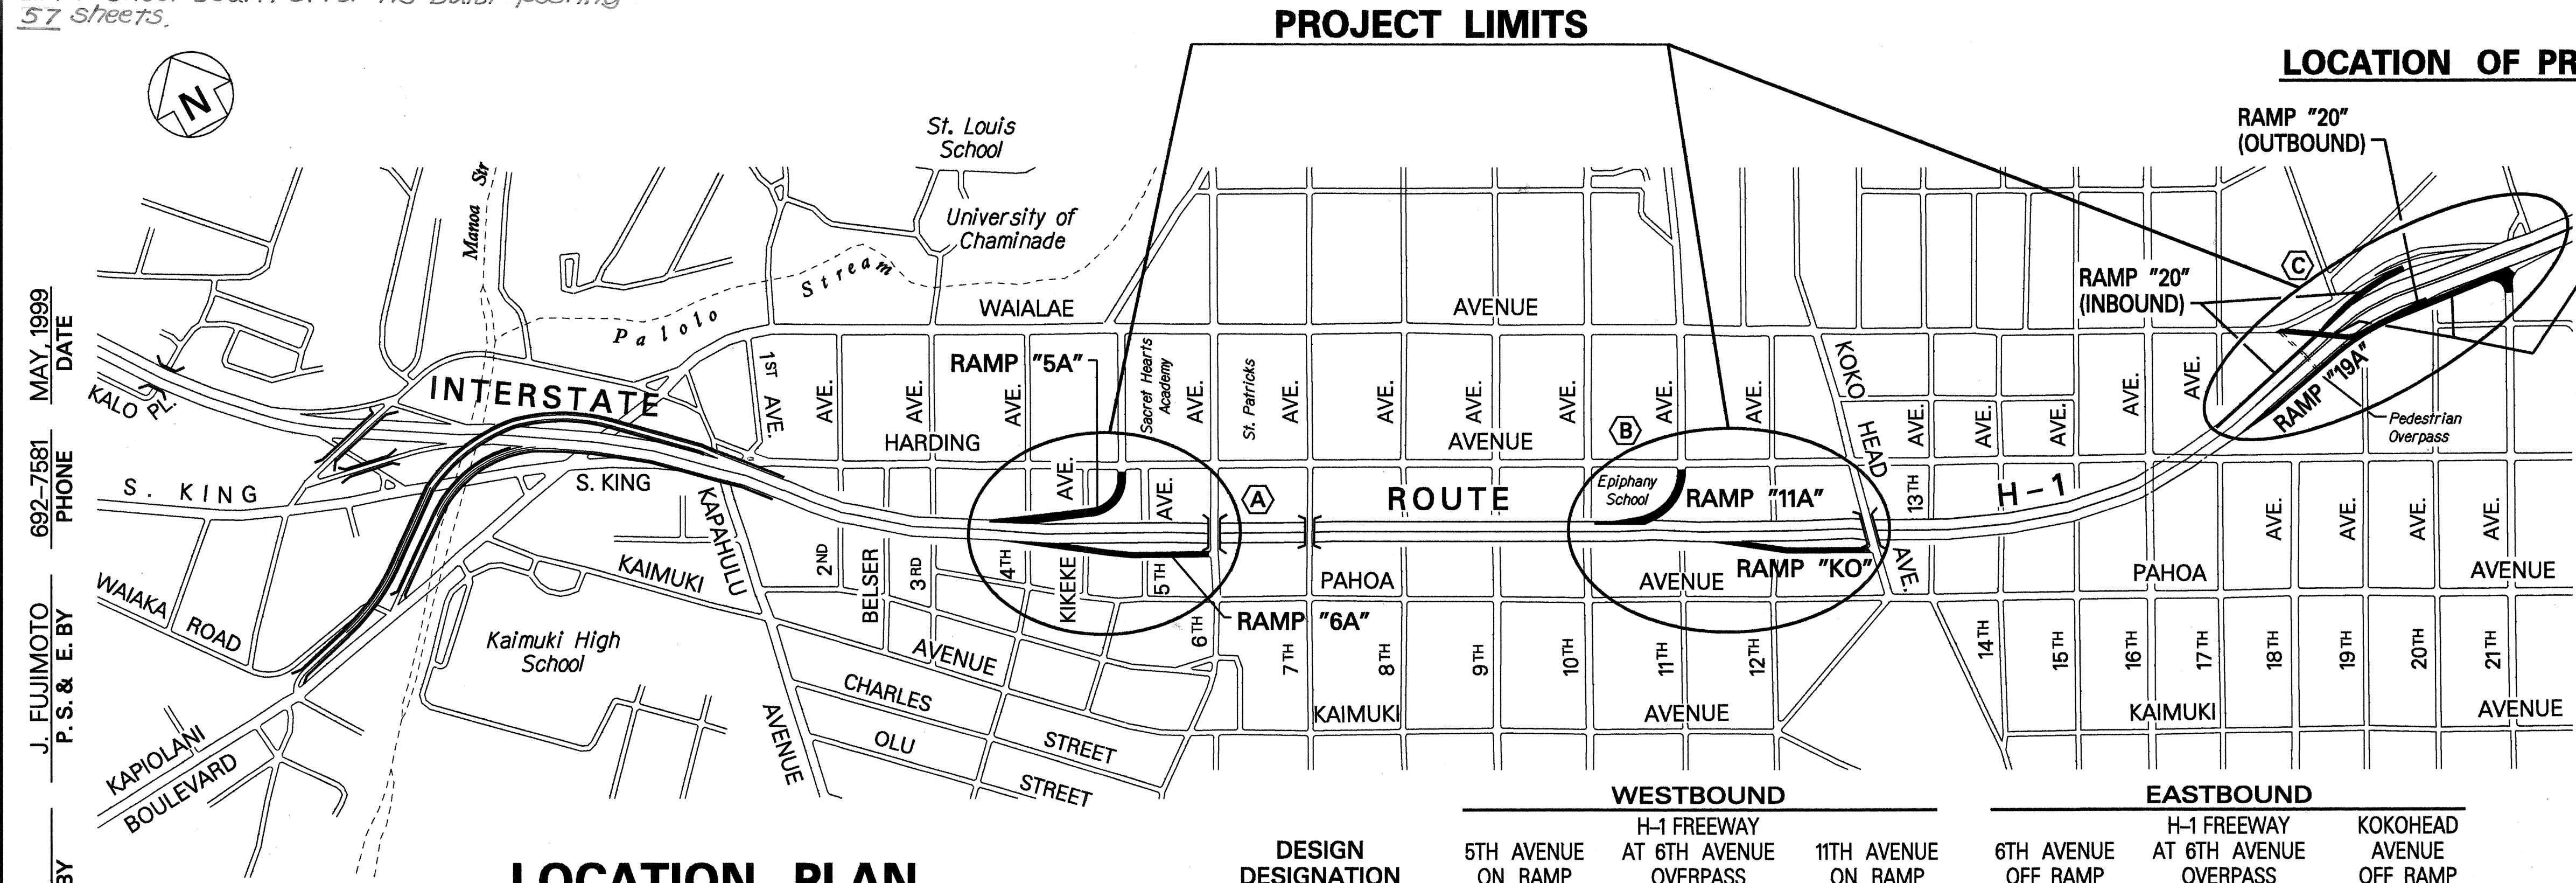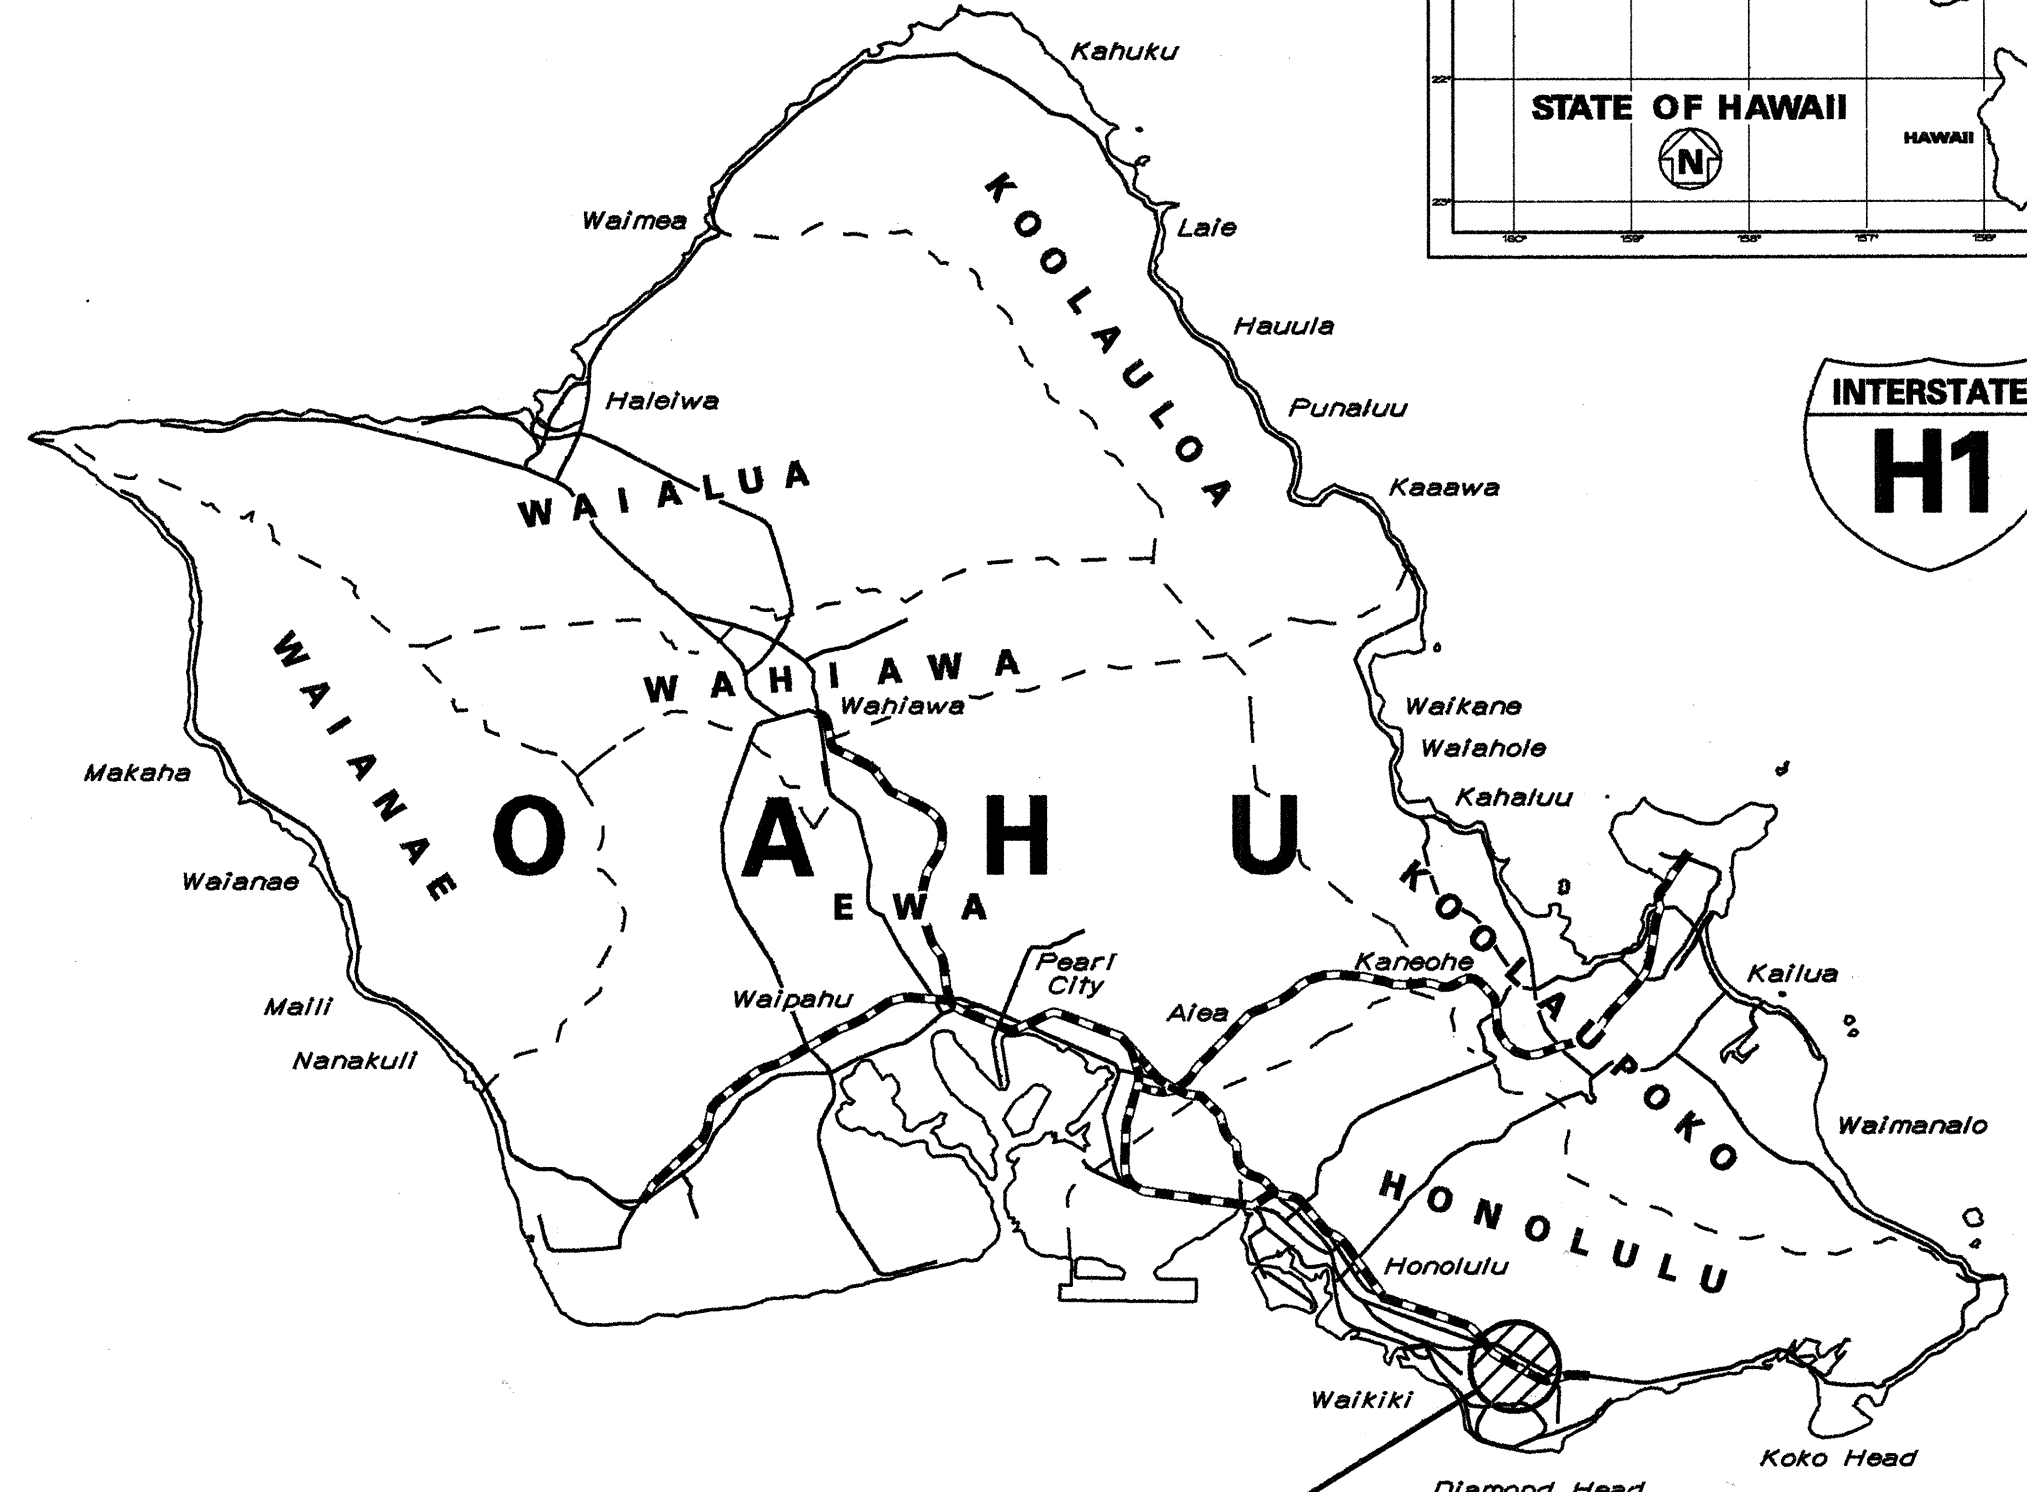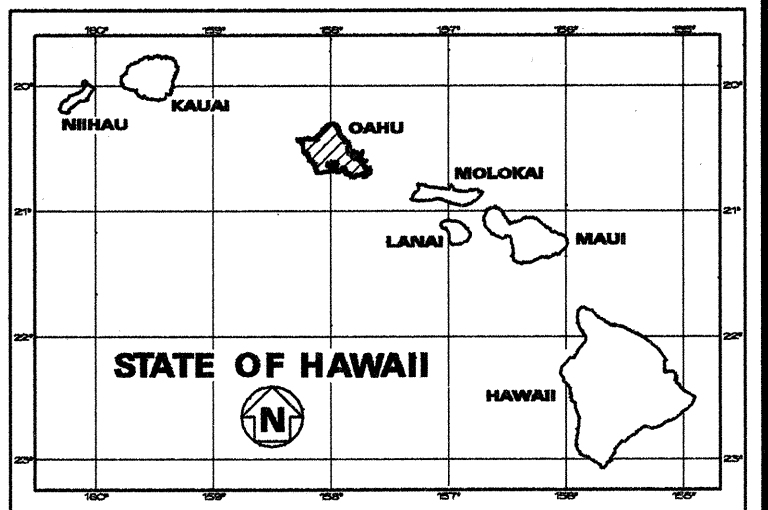

LOCATION OF PROJECT

LOCATION PLAN

GROSS LENGTH OF PROJECT..... 0.66 MILES
NET LENGTH OF PROJECT..... 0.66 MILES

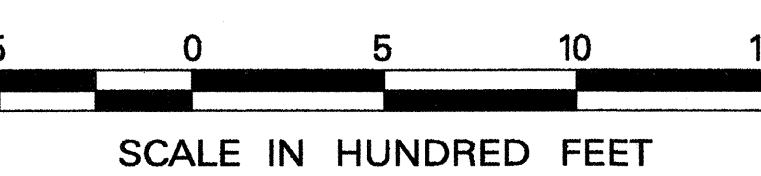

DESIGN DESIGNATION	WESTBOUND			EASTBOUND		
	5TH AVENUE ON RAMP	H-1 FREEWAY AT 6TH AVENUE OVERPASS	11TH AVENUE ON RAMP	6TH AVENUE OFF RAMP	H-1 FREEWAY AT 6TH AVENUE OVERPASS	KOKOHEAD AVENUE OFF RAMP
ADT (1998)	8,240	55,200	8,240	8,240	55,200	8,240
ADT (2008)	9,070	60,770	9,070	9,070	60,770	9,070
DHV	730	6,990	730	730	6,990	730
K	8.0	11.5	8.0	8.0	11.5	8.0
T	0.5	—	—	0.5	—	—
T ₂₄	1.5	—	—	1.5	—	—

- (A) MILE POST 25.71 TO MILE POST 25.83
- (B) MILE POST 26.18 TO MILE POST 26.43
- (C) MILE POST 26.81 TO MILE POST 27.10

CHANGES MADE DURING CONSTRUCTION HAVE BEEN INCORPORATED ON THESE PLANS EXCEPT CHANGES IN THE ORIGINAL THEORETICAL QUANTITIES. FOR ACTUAL QUANTITIES, REFER TO PROJECT LEDGER AND/OR COMPUTATION BOOK.

7/8/02
RESIDENT ENGINEER

DEPARTMENT OF TRANSPORTATION
STATE OF HAWAII
APPROVED: *Kay D. Jayashita* 5/8/03
DIR. OF TRANSPORTATION DATE

UNIT "E"
DESIGNED BY
J. FUJIMOTO
P.S. & E. BY
692-7581
PHONE
MAY 1999
DATE