

STRUCTURAL NOTES

CONCRETE

1.

Concrete shall be Class A (3,000 psi), unless otherwise noted
2.

Minimum clear coverage of concrete over outer reinforcing bars shall be as follows, unless otherwise noted.

Concrete poured directly against earth

3" clear

All others

2" clear
3.

Concrete admixtures containing chloride salts shall not be used.
4.

All roughened surfaces in concrete shall be made with a minimum amplitude of 1/4"
5.

Except as otherwise noted on drawings, all exterior corners and re-entrant angles 90 degrees or less in concrete work shall be chamfered 3/4"x3/4".

REINFORCING STEEL

1.

Reinforcing bars shall be ASTM A-615 Grade 40 for #3 and #4 and Grade 60 for #5 and larger. Contractor option to use all Grade 60 bars providing the same number, size and spacing is provided.
2.

All reinforcing bars, anchor bolts, dowels and other embedded items are to be securely tied in place before concrete pour.
3.

All reinforcing bar bends shall be made cold.

STRUCTURAL STEEL AND GUARDRAILS

1.

All structural steel shall conform to ASTM A-36.
2.

All structural steel for guardrail shall be hot dip galvanized after fabrication. All holes shall be prepunched before galvanizing. See Standard Specifications and Special Provisions.
3.

All anchor bolts and other hardware including nuts and washers which connect steel to concrete shall conform to AASHTO M 164 and be hot dip galvanized in accordance with ASTM A153. Tighten M164 bolts snug tight condition.
4.

All welds shall be in conformity with the ANSI/AASHTO/AWS D1.5 Bridge Welding Code. Electrodes for A36 and A500 shall be E70.
5.

W-beam guardrail and splices shall confirm to Class A AASHTO M180, (12 GAGE) Type II. For guardrail on bridge deck, see notes on sheets Q-1 through Q-3.
6.

All existing guardrails, posts, terminal ends, etc associated with the existing guardrails shall be removed. Removal work considered incidental.
8.

New guardrails shall generally replace the existing in terms of locations, and lengths, extend as indicated on guardrail schedule on Sheet S-2.

CONCRETE DECK REPAIRS

1.

Crack and spall repairs shall conform to details as shown, and according to special provisions.

INDEX TO DRAWINGS		
SHEET NO.		TITLE
S-1	36	NOTES AND INDEX TO DRAWINGS
S-2	37	GUARDRAIL SCHEDULE
S-3	38	STRONG POST GUARDRAIL DETAILS & NOTES
S-4	39	STRONG POST W-BEAM GUARDRAIL
S-5	40	DETAIL OF GUARDRAIL AT OBSTRUCTION
S-6	41	STRONG POST RUBRAIL (W-BEAM) GUARDRAIL
S-7	42	TYPE "G" FLARE END TERMINAL
S-8	43	FLEAT-350 FLARED ENERGY ABSORBING TERMINAL
S-9	44	SPECIAL GUARDRAIL DETAILS
S-10	45	QUADGUARD SYSTEM LOCATIONS
S-11	46	QUADGUARD SYSTEM DETAILS
S-12	47	CONCRETE BRIDGE DECK REPAIR PLAN, SECTION AND DETAILS

FED. ROAD DIST. NO.	STATE	FED. AID PROJ. NO.	FISCAL YEAR	SHEET NO.	TOTAL SHEETS
HAWAII	HAW.	IM-NH-H1-1(239)	2001	36	103

ORIGINAL PLAN	SURVEY PLOTTED BY	DATE
	DRAWN BY	
	DESIGNED BY	
	CHECKED BY	
NOTES	NOTED BY	
	QUANTITIES BY	
	CHECKED BY	

NORMAN K. NAGAMINE

LICENSED PROFESSIONAL ENGINEER

NO. 5479-S

HAWAII, U.S.A.

THIS WORK WAS PREPARED BY ME OR UNDER MY SUPERVISION

Norman K. Nagamine

STATE OF HAWAII

DEPARTMENT OF TRANSPORTATION

HIGHWAYS DIVISION

NOTES AND INDEX TO DRAWINGS

INTERSTATE ROUTE H-1

Palailai Interchange Reconstruction

F.A.I. Project No. IM-NH-H1-1(239)

Scale: As Shown

Date: 4/1/01

SHEET NO. S-1 OF 12 SHEETS

36

FED. ROAD DIST. NO.	STATE	FED. AID PROJ. NO.	FISCAL YEAR	SHEET NO.	TOTAL SHEETS
HAWAII	HAW.	IM-NH-H1-1(239)	2001	37	103

GUARDRAIL SCHEDULE								
SHEET NO.	LOCATION	STATION		EXISTING GUARDRAIL TO BE REMOVED * (Lin. Ft.)	NEW STRONG POST (W-BEAM) GUARDRAIL* * (Lin. Ft.)	NEW GUARDRAIL END TREATMENTS		REMARKS
		FROM	TO			LEAD	TRAIL	
13, 15	Ramp "A" (Left side)	Ramp "A" Sta 2+20L (Ramp "C" Sta 3+05R)	Ramp "A" Sta 9+45L	750	700	3 Bay Quadguard System (See S-10)	Type G End Treatment (See S-7) w/Buffer End	Strong Post (W-Beam) Double Guardrail at Trail End; See (S-9)
13	Ramp "A" (Right side)	Ramp "A" Sta 0+35R	Ramp "A" Sta 2+30R	150	200	Connect to exist guardrail post to remain	Type G Flare (See S-7) Flare 25-Foot Trail End 12:1	
13	Ramp "B" (Left side)	Ramp "B" Sta 5+70L	Ramp "B" Sta 9+00L (Kalaeloa Blvd. Sta 2+10R)	330	295	Connect to exist guardrail post approx 100' from end of exist SRT-350	Connect to guardrail from Kalaeloa Blvd	
13, 15	H-1 Inbound, Ramp "B" and Kalaeloa Blvd. (Right side)	H-1 Sta 187+00R	Kalaeloa Blvd Sta 4+30R	2,200	2,225	FLEAT 350 - (See S-8)	Type G Flare (See S-7) Flare 25-Foot Trail End 12:1	
13	Ramp "C" (West side)	Ramp "C" Sta 6+50R	Ramp "C" Sta 3+05R (Ramp "A" Sta 2+20L)	445	445 * * *	Construct Concrete End Post with Terminal Connection (See Sheet Q5)	3 Bay Quadguard at Ramp "A" Left side (See S-10)	
13	Ramp "C" and Kalaeloa Blvd North of Palailai I.C. Bridge (West side)	Ramp "C" Sta 2+80L	Kalaeloa Blvd Sta (-) 1+10R	490	460	FLEAT 350 - (See S-8)	Connect to Palailai I.C. Bridge West Railing (See Sheet Q2)	
13	Kalaeloa Blvd South of Palailai I.C. Bridge (West side)	Kalaeloa Blvd Sta 1+08R	Kalaeloa Blvd Sta 2+10R (Ramp "B" Sta 9+00L)	100	150	Connect to Palailai I.C. Bridge West Railing (See Sheet Q2)	Extend guardrail 70' + connect to Ramp "B" (Left side)	
13	Kalaeloa Blvd South of Palailai Interchange Bridge (East side)	Kalaeloa Blvd Sta 1+19L	Kalaeloa Blvd Sta 5+05L O/S 30'± L	210	360	3-Bay Quadguard System (See S-10)	Connect to Palailai I.C. Bridge East Railing (See Sheet Q3)	
13	Kalaeloa Blvd North of Palailai I.C. Bridge (East side)	Kalaeloa Blvd Sta (-) 5+05 (Farrington Hwy Sta 4+50R)	Kalaeloa Blvd Sta (-) 1+10L	425	425	Connect to Palailai I.C. Bridge East Railing (See Sheet Q3)	Connect to exist guardrail post at junction of Farrington Hwy	
9, 10, 11, 12	Ramp "CI", Palailai Weaving Lanes and Ramp "IF" (Right side)	Ramp "CI" Sta 1+40R	Ramp "IF" Sta 16+70R O/S 20'R	2,805	3,625	FLEAT 350 - (See S-8)	FLEAT 350 - (See S-8)	Strong Post Rubrail (W-Beam) Guardrail for Light Post at Ramp CI Sta 6+05L (See S-5)
11	Ramp "IF" (Left side)	Ramp "IF" Sta 4+85L	Ramp "IF" Sta 7+45L	275	225	FLEAT 350 - (See S-8)	Type G Flare (See S-7) Flare 25-Foot Trail End 12:1	See Sheet S-9 for Culvert Crossing at Sta 6+52L
9	Ramp "C1" (Left side)	Ramp "C1" Sta 4+20L O/S 30'± L	Ramp "C1" Sta 6+72L	0	235	3-Bay Quadguard System (See S-10)	Type G Flare (See S-7) Flare 25-Foot Trail End 15:1	
10	On Ramp (Left Side)	On Ramp Sta 1+10L O/S 18'± L	On Ramp Sta 2+44L O/S 18'± L	25	100	9-Bay Quadguard System (See S-10)	Type G End Treatment (See Sheet S-7) w/Buffer End	Strong post (W-Beam) Guardrail
10	H-1 Inbound (Right Side)	H-1 Inbound Sta 57+22R O/S 58'± R	H-1 Inbound Sta 58+56 R O/S 58'± R	25	100	9-Bay Quadguard System (See S-10)	Type G End Treatment (See Sheet S-7) w/Buffer End	Strong Post Rubrail (W-Beam) Guardrail (See Sheet S-5)

Notes:

- * Includes End Treatment
- * * Excludes End Lead Treatment
- * * * Includes Concrete End Post

NORMAN K. NAGAMIE
LICENSED PROFESSIONAL ENGINEER
NO. 5479-S
HAWAII, U.S.A.

THIS WORK WAS PREPARED BY ME OR UNDER MY SUPERVISION


STATE OF HAWAII
DEPARTMENT OF TRANSPORTATION
HIGHWAYS DIVISION
GUARDRAIL SCHEDULE

INTERSTATE ROUTE H-1
Palailai Interchange Reconstruction
F.A.I. Project No. IM-NH-H1-1(239)


Scale: As Shown Date: 4/1/01

SHEET NO. S-2 OF 12 SHEETS


FED. ROAD DIST. NO.	STATE	FED. AID PROJ. NO.	FISCAL YEAR	SHEET NO.	TOTAL SHEETS
HAWAII	HAW.	IM-NH-H1-1(239)	2001	ADD38	103

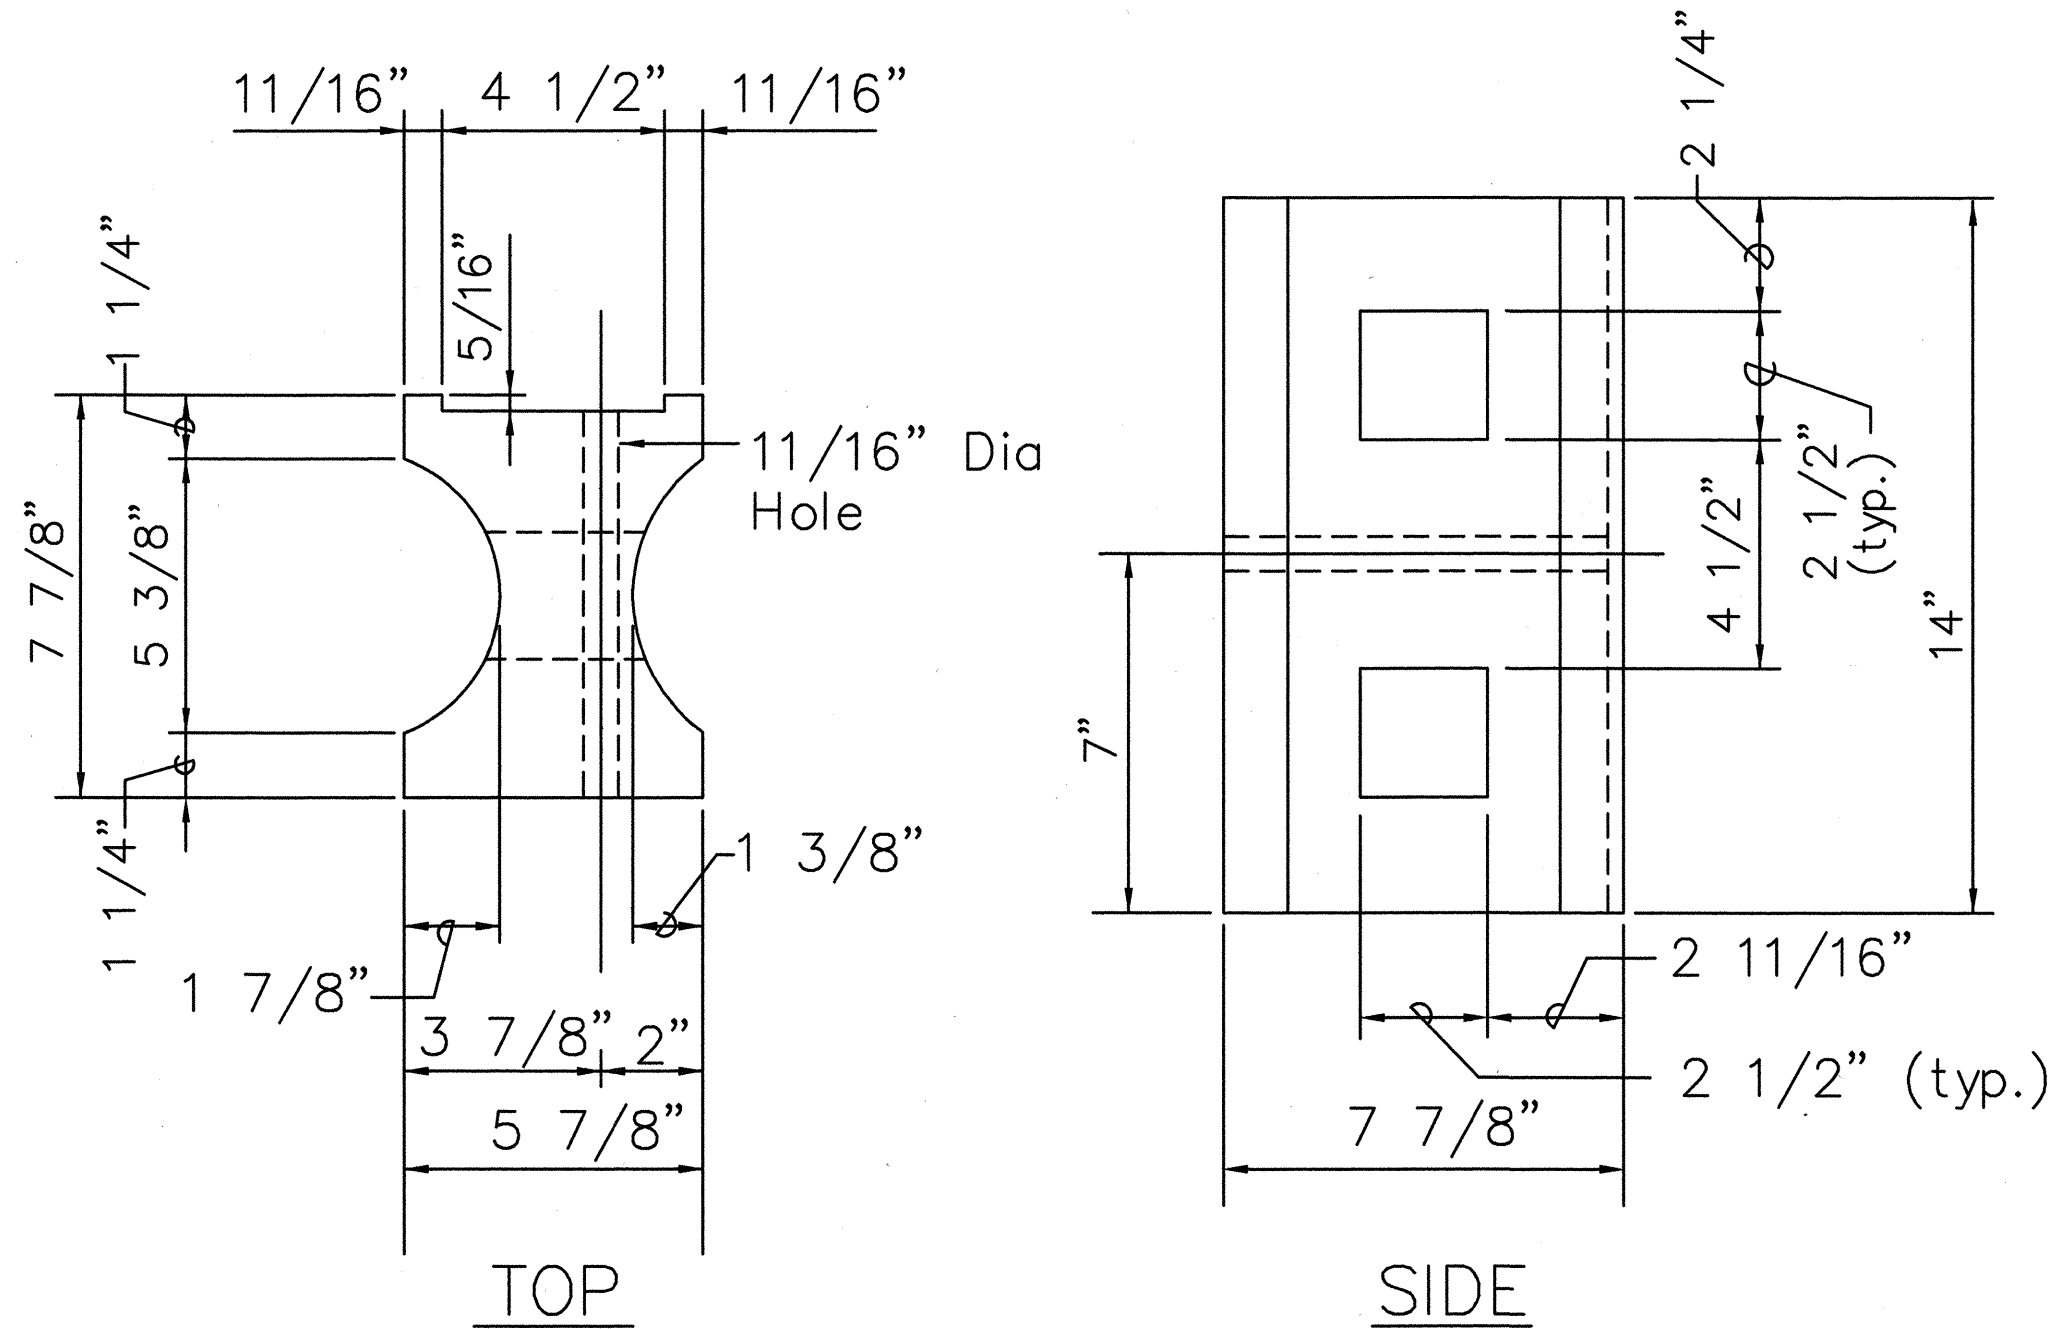


RECYCLED PLASTIC BLOCKOUT (TYPE I)

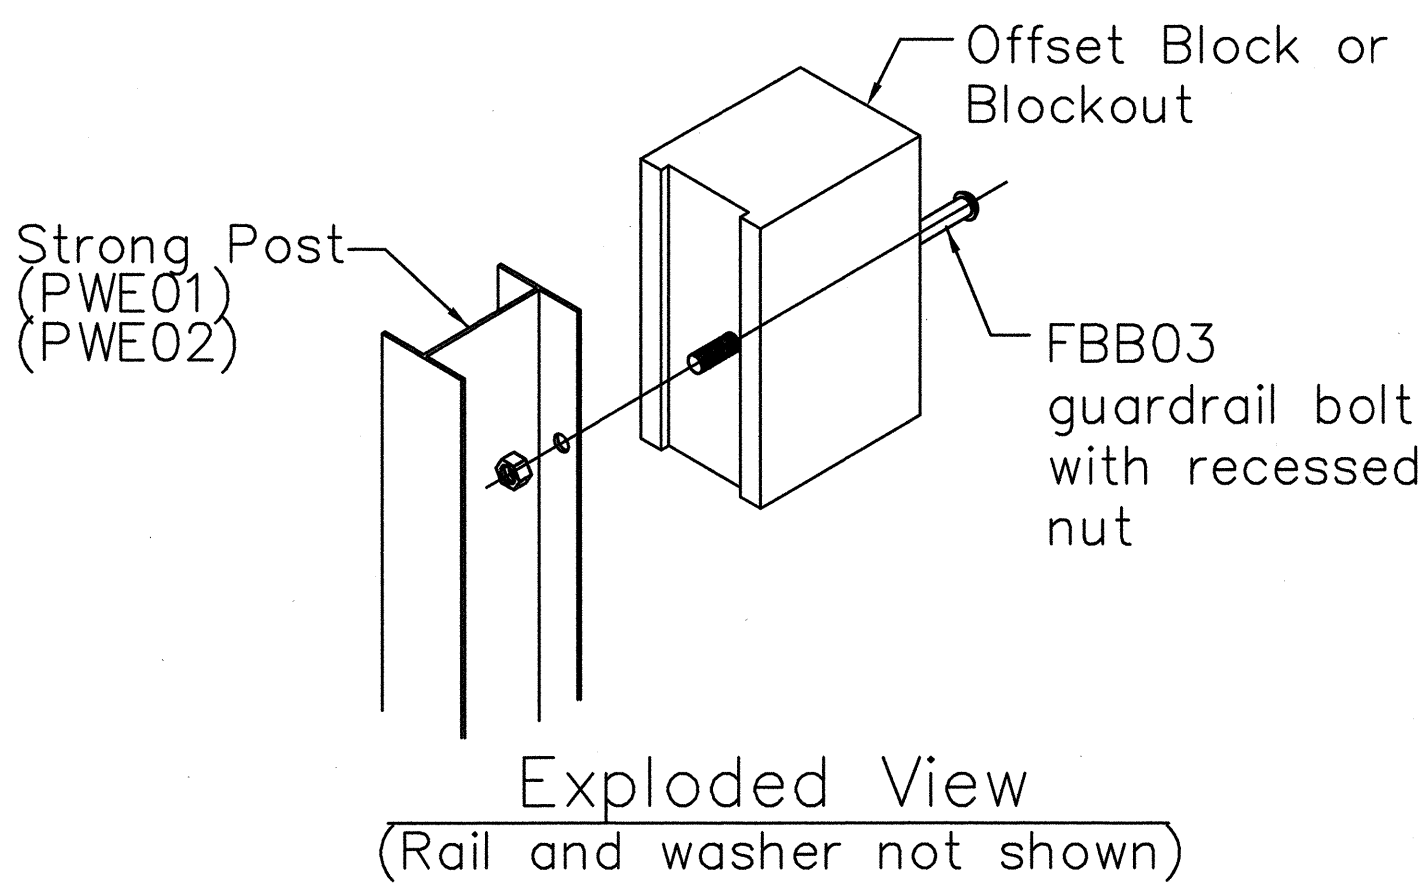



STEEL POST AND BLOCK DETAIL

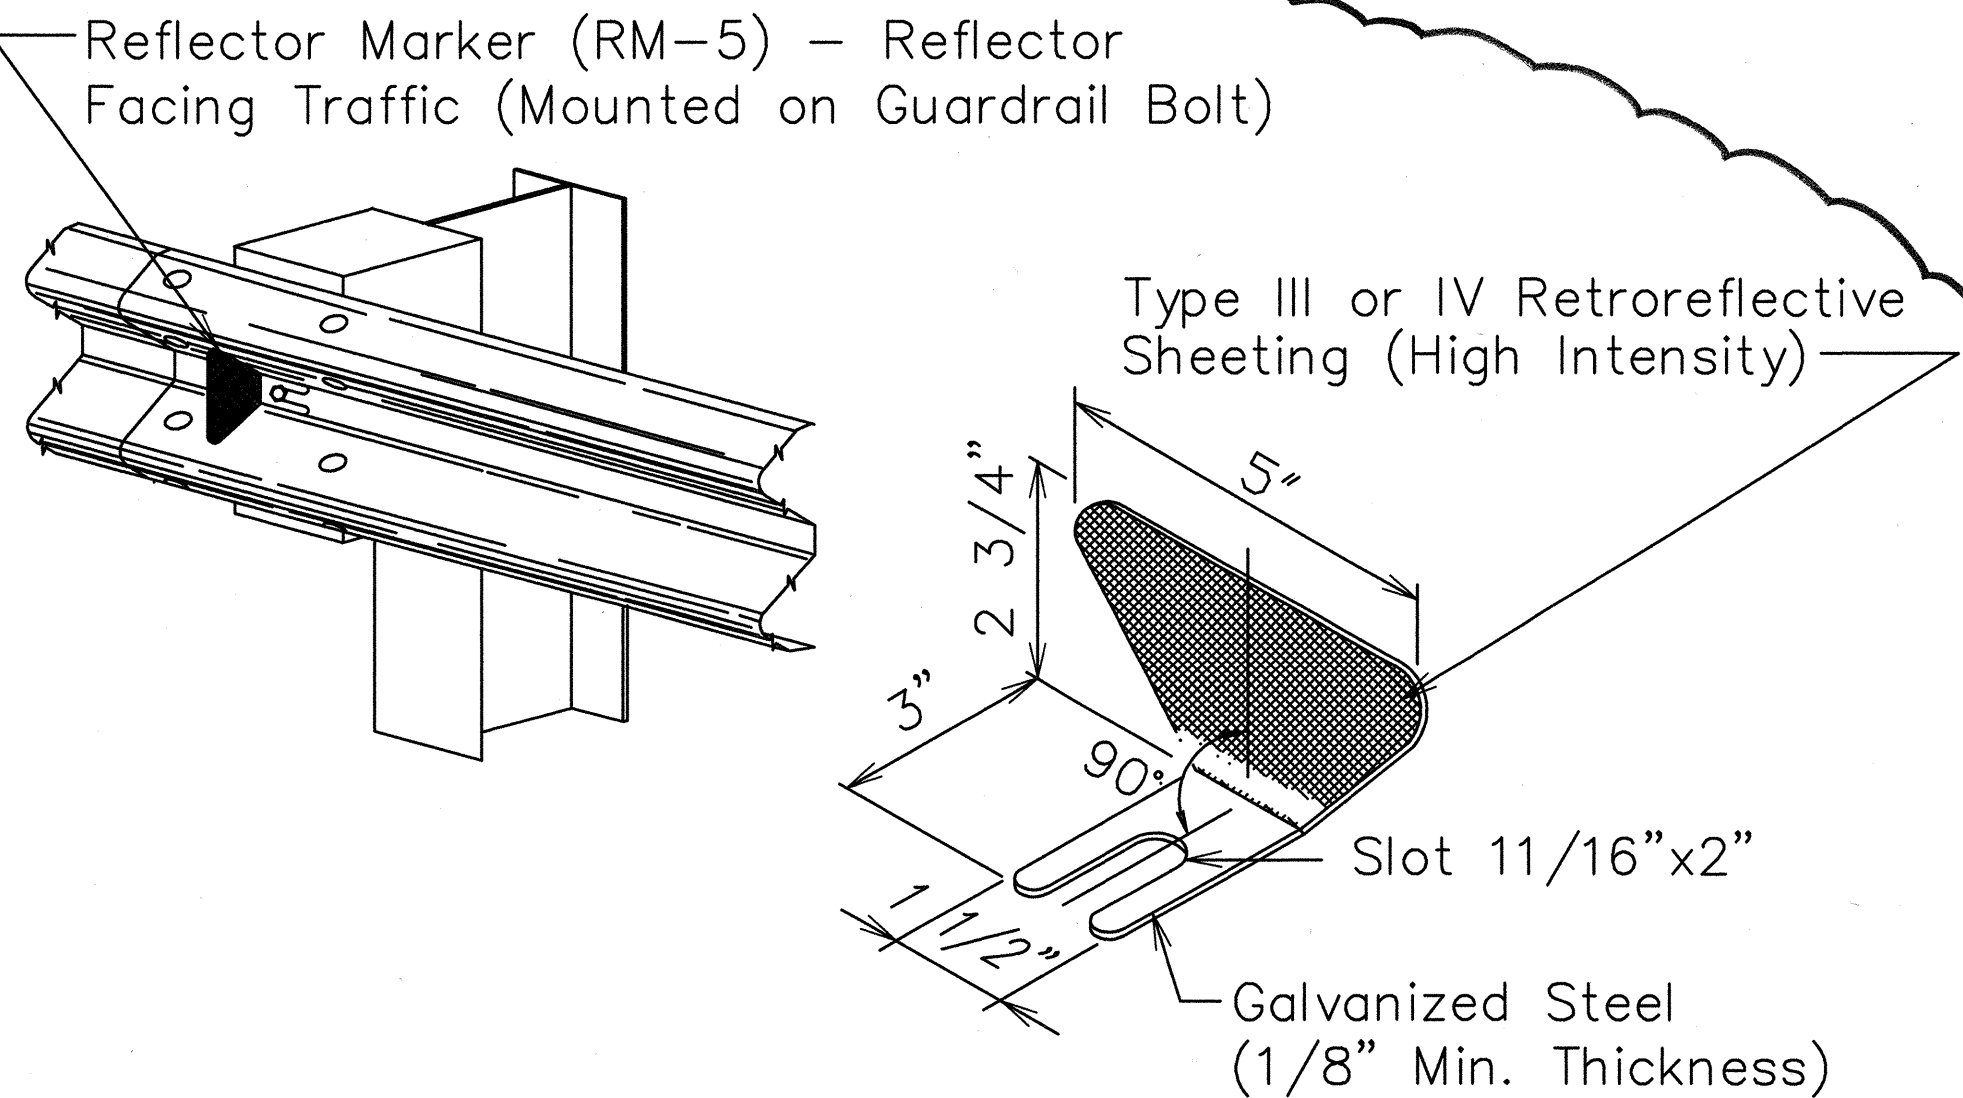

REFLECTOR MARKER (RM-5) DETAIL AND TYPICAL INSTALLATION

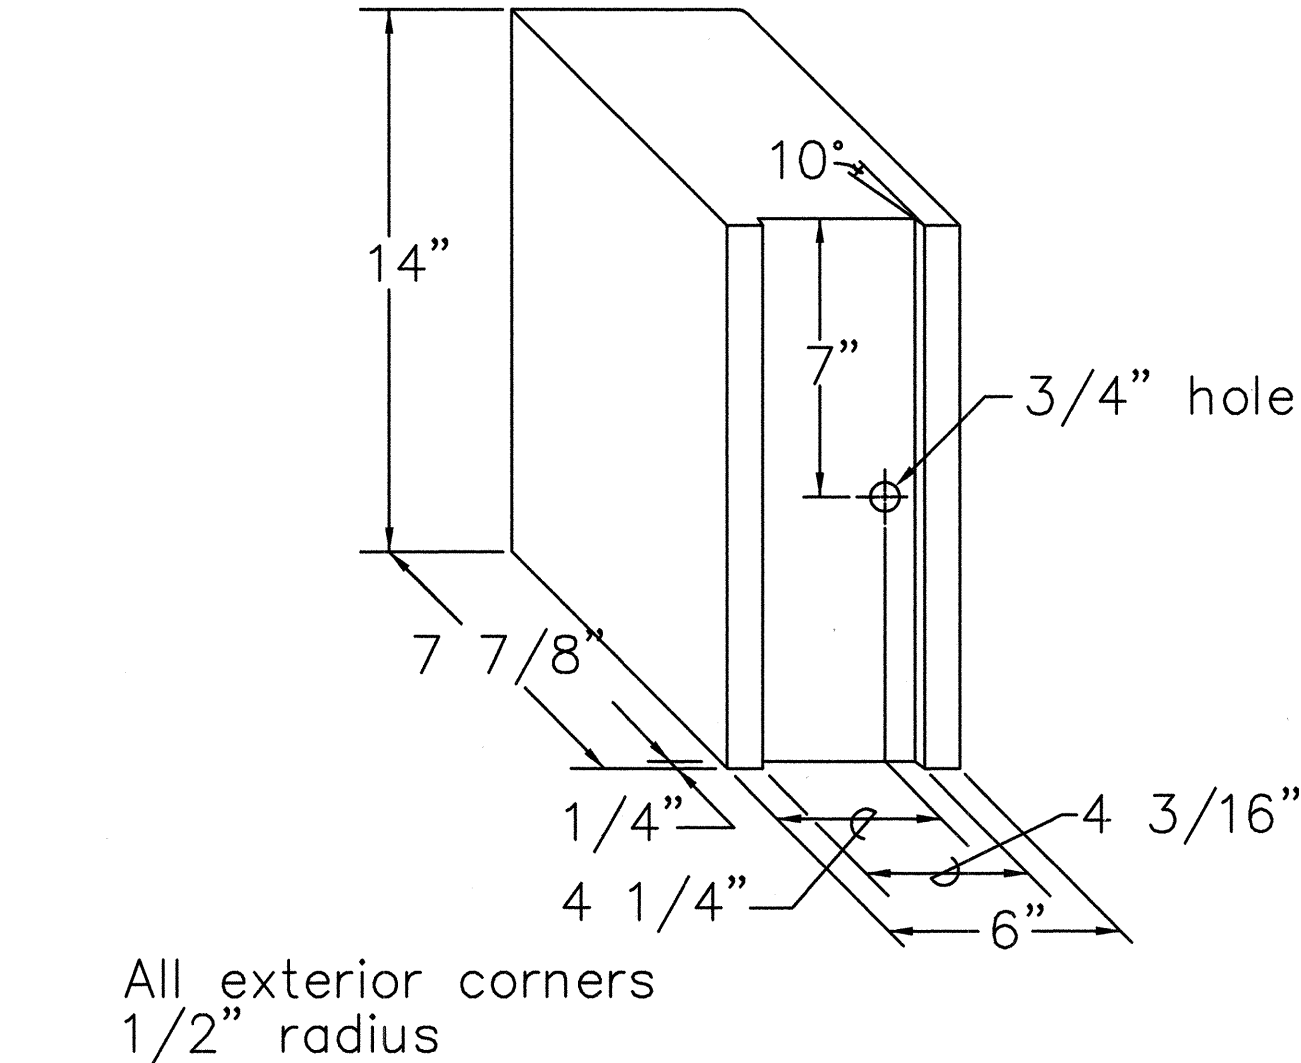

RECYCLED POLYETHELENE
OFFSET BLOCK (TYPE II)

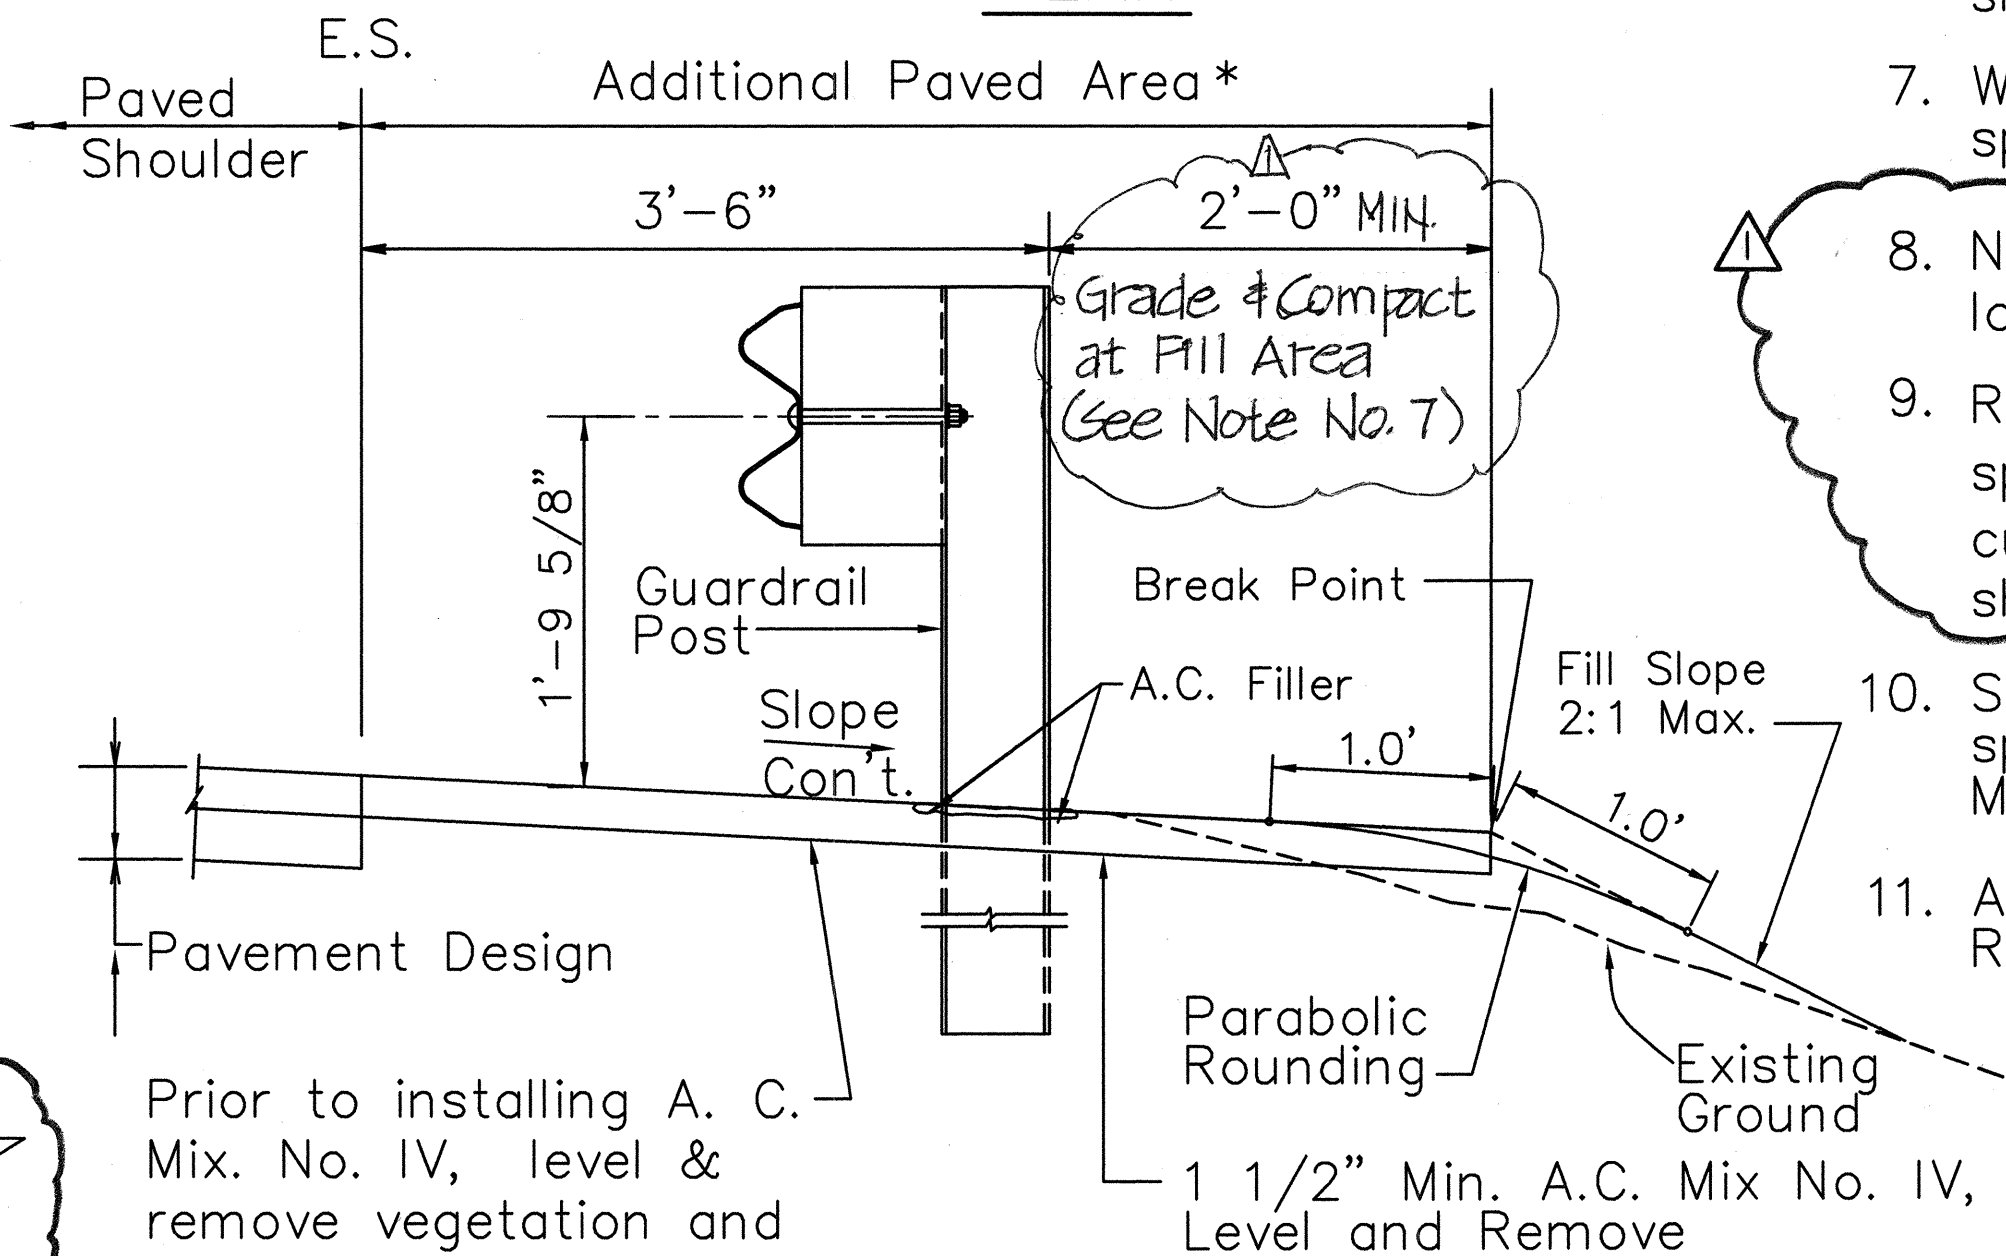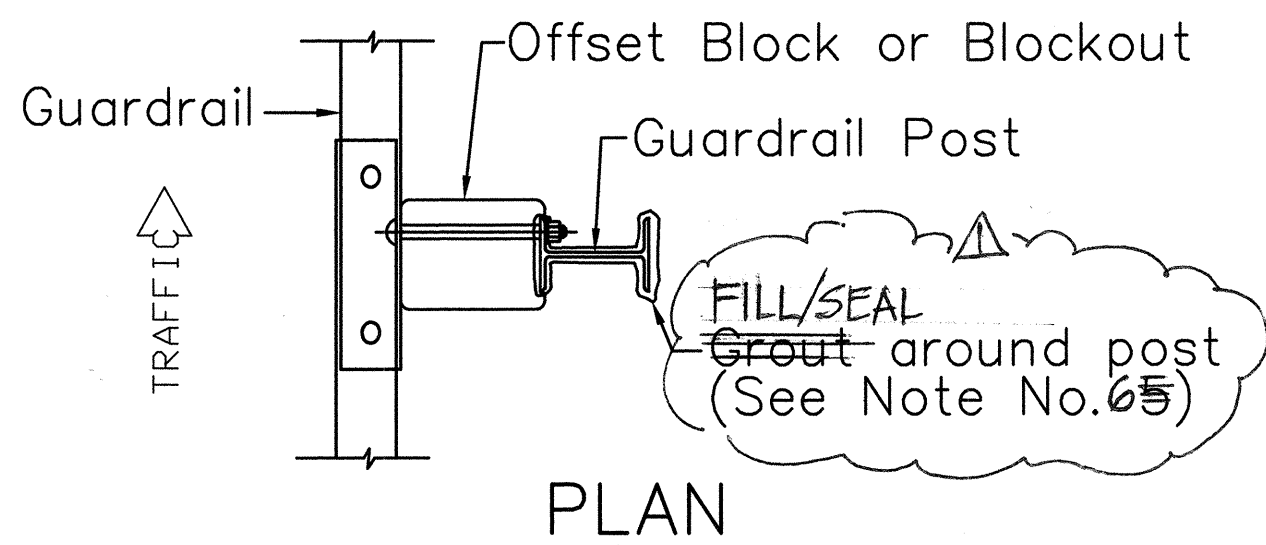

TYPICAL GUARDRAIL INSTALLATION

GENERAL NOTES

1. All hardware, posts and fasteners shall be hot-dip zinc coated galvanized after fabrication. No punching, drilling or cutting will be permitted after galvanizing.
2. Where conditions require, special post lengths in increments of 6 inches may be specified.
3. All fasteners, posts, and rail elements (i.e. FBB03, PWE01, RWM02b, etc.) shall conform to the latest edition and amendments of "A Guide to Standardized Highway Barrier Rail Hardware," a report prepared and approved by the AASHTO-AGC-ARTBA Joint Cooperative Committee, Subcommittee On New Highway Materials, Task Force 13 Report. Dimensions of fasteners, posts and rail elements have been converted from metric units into their present form.
4. The Recycled Plastic Block or Offset Block shall be approved by the State.
5. All new guardrail systems (system consist of total length of guardrail including both end treatments) shall include the additional paved area.
6. After the guardrail posts are installed in the paved area, the Contractor shall fill/seal around each guardrail post and all cracks in the paved area caused during the guardrail post installation. If required by the inspector/ engineer, the Contractor shall tamper the paved area around the guardrail post prior to filling/sealing. All costs associated with this work shall not be paid for separately, but shall be considered incidental to the various guardrail items.
7. When standards for the fill slope area cannot be met, a site specific, engineer approved design may be used.
8. New A.C. pavement at guardrails shall extend 6 feet longitudinally beyond terminal ends.
9. Reflector Markers (RM-5) mounted on guardrails shall be spaced every 200 feet. Spacing of RM-5's on horizontal curves shall comply with Table III-1 of the MUTCD. RM-5's shall not be installed on terminal sections.
10. Strong Post with W Beam Guardrail is referred to on the plans, specifications and proposal schedule as Type 3 - Single Metal Beam Guardrail.
11. All guardrail flare rates shall be in accordance with AASHTO Roadway Design Guide, January 1996.

6/20/01	UPDATED NOTES AND DETAILS AND ADDED REFLECTOR MARKER PER ADDENDUM NO. 1
DATE	REVISION



STATE OF HAWAII
DEPARTMENT OF TRANSPORTATION
HIGHWAYS DIVISION

STRONG POST GUARDRAIL DETAILS

AND NOTES

INTERSTATE ROUTE H-1

Palailai Interchange Reconstruction

F.A.I. Project No. IM-NH-H1-1(239)

Scale: As Shown Date: 4/1/01

SHEET NO. S-3 OF 12 SHEETS

W-BEAM STRONG POST (PWE01)

PLAN

TRAFFIC

Guardrail

Offset Block or Blockout

PWE01

4"

5 7/8"

7 5/8"

NOTE:
All Holes are 3/4" Dia.

W6x8.5 Structural Shape

4"

SIDE

PWE01

5 7/8"

Ground Line

3'-6"

FRONT

6'-0"

1'-9 5/8"

2 3/8"

3/4"

5"

5"

Ground Line

2'-4 5/8"

Offset Block or Blockout

RWM02a

FBB01 Splice Bolts

FBB03

PWE01

Ground Line

1'-9 5/8"

7"

6'-0"

The diagram is an elevation view of a bridge deck. It shows a horizontal section with a central span of 6'-3" between two vertical centerlines of rail bolt holes. The total width of the deck is 1'-9 5/8". Reinforcement bars are labeled: 8-FBB01 (top), FBB02 (middle), and RWM02a (bottom). Splice bolts are shown at the ends of the bars. A ground line is indicated by a horizontal line with a break symbol. A lap in the direction of traffic is shown for the bottom bars. A vertical dimension of 1'-9 5/8" is shown on the left. A label PWE01 points to a vertical bar at the left end.

Technical drawing showing the dimensions of a hex nut and washer assembly. The drawing includes a side view of the nut and washer, a top view of the nut, and a table of dimensions.

Dimensions shown in the drawing:

- Washer thickness: $5/16"$
- Washer outer diameter: $7/32"$
- Nut thickness: $5/8"$
- Nut outer diameter: $1 1/8"$
- Nut inner diameter: $1 3/8"$
- Washer inner diameter: $5/8"$
- Washer hole diameter: $1 1/8"$
- Washer hole depth: $1 3/8"$
- Washer hole diameter (top view): $1 1/4"$
- Washer hole depth (top view): $1 1/8"$

DESIGNATOR	L
FBB01	$1 3/8"$
FBB02	$2"$
FBB03	$10"$

Labels in the drawing:

- Mod. Heavy Hex Nut
- $1" \text{ Dia.} \times 1/16"$ Recess both sides

9/16" (2 5/16")

6 1/8" (2 1/4")

1 1/16" (2 1/4")

15/16" R (typ.)

3/8" R

1 1/16"

10°±1°

55° (typ.)

55°


3/4" x 2 1/2" Post Bolt Slot (typ.)

6"

6"

1'-0"




DESIGNATOR	BASE METAL THICKNESS
RWB01a	12 Gauge

[illegible]

STRONG POST W-BEAM
GUARDRAIL

Scale: As Shown Date: 4/1/01
SHEET NO. S-4 OF 12 SHEETS

FED. ROAD DIST. NO.	STATE	FED. AID PROJ. NO.	FISCAL YEAR	SHEET NO.	TOTAL SHEETS
HAWAII	HAW.	IM-NH-H1-1(239)	2001	40	103

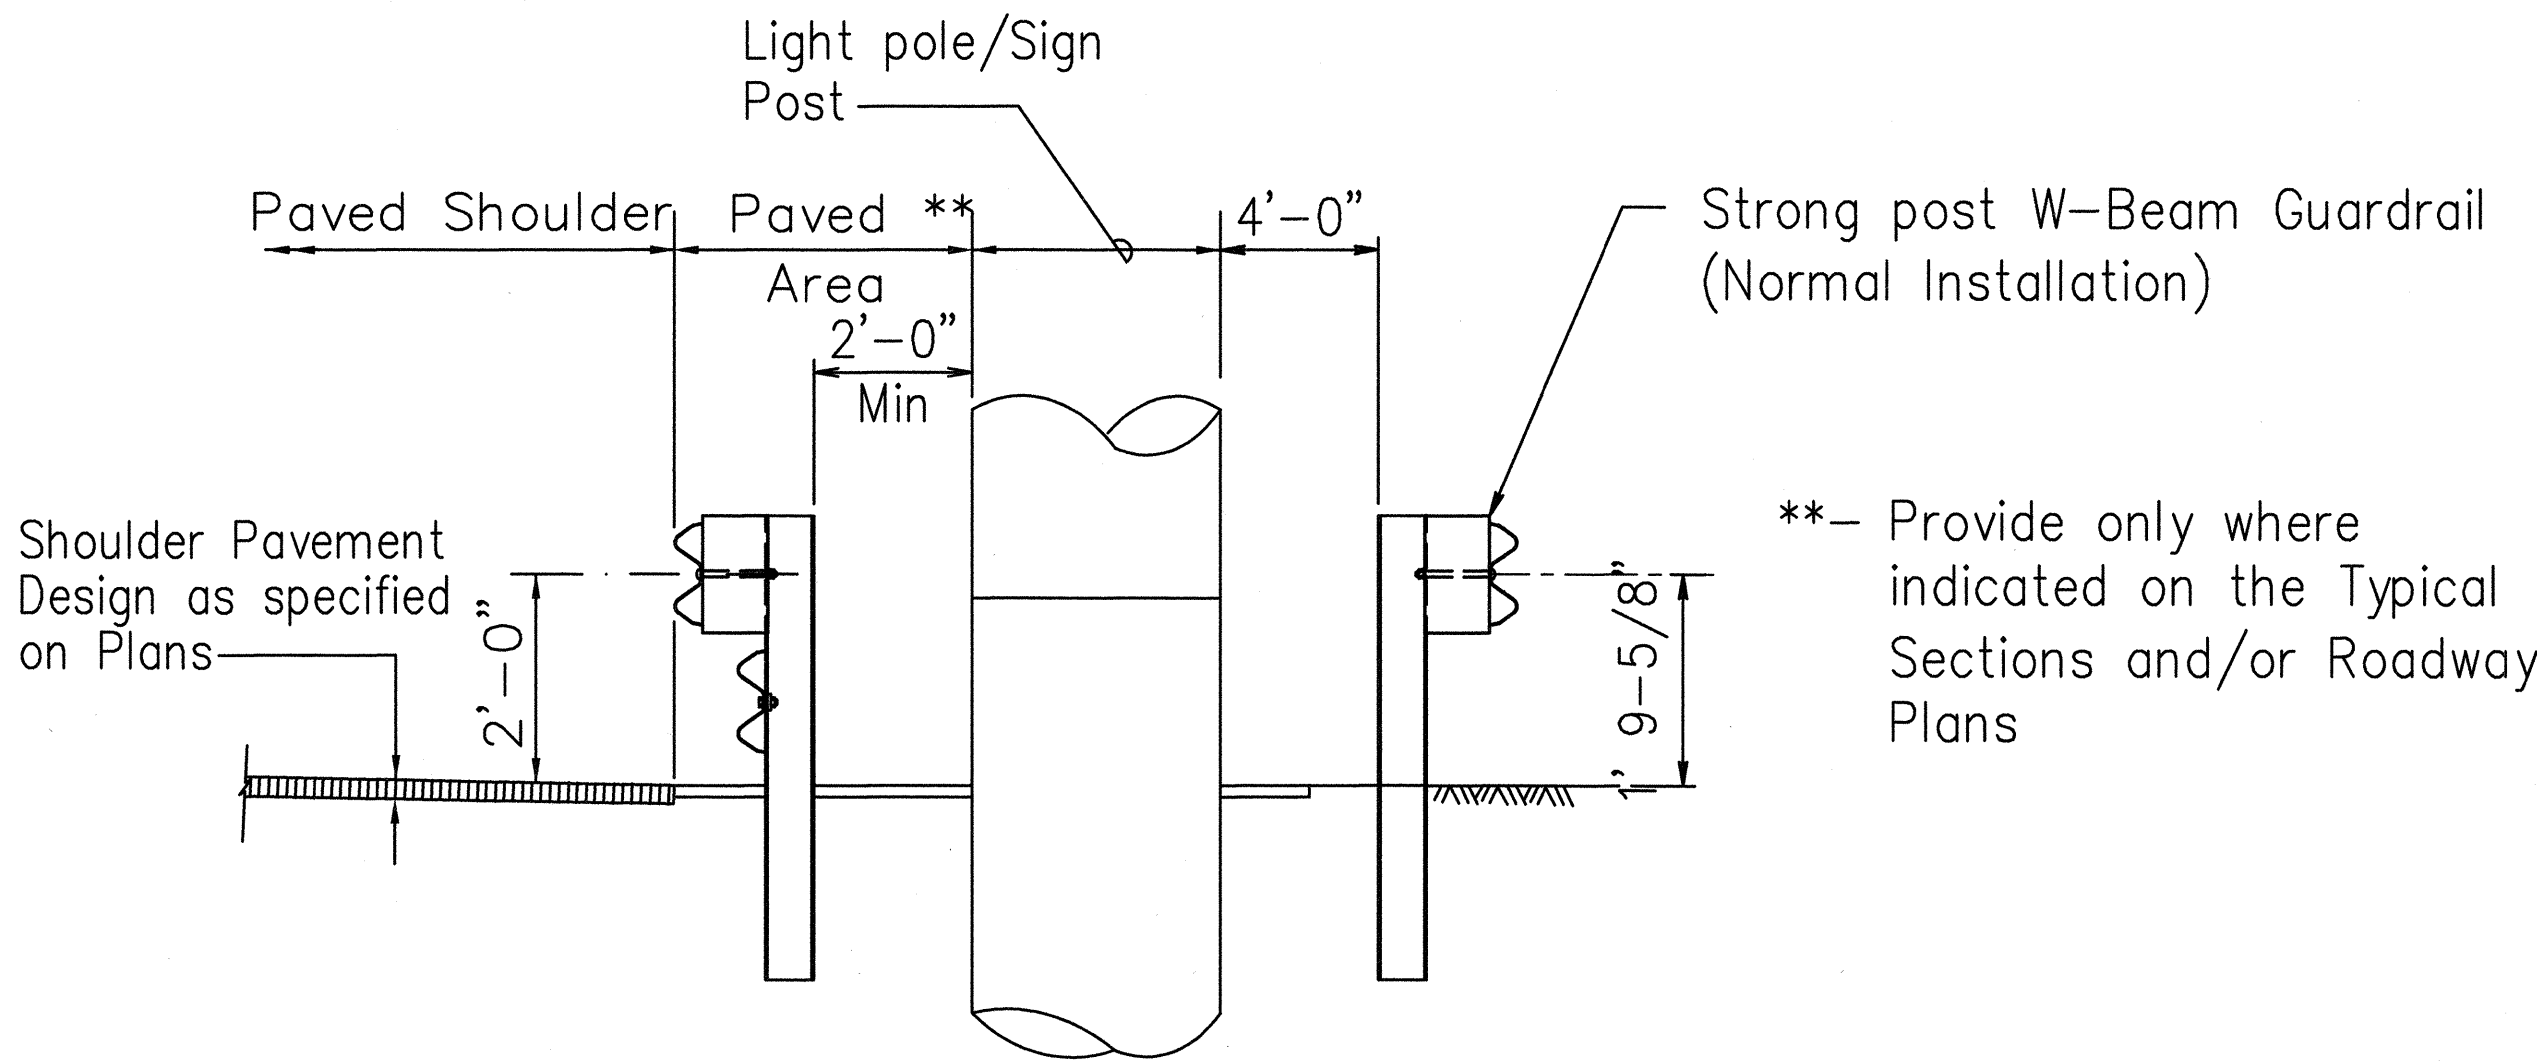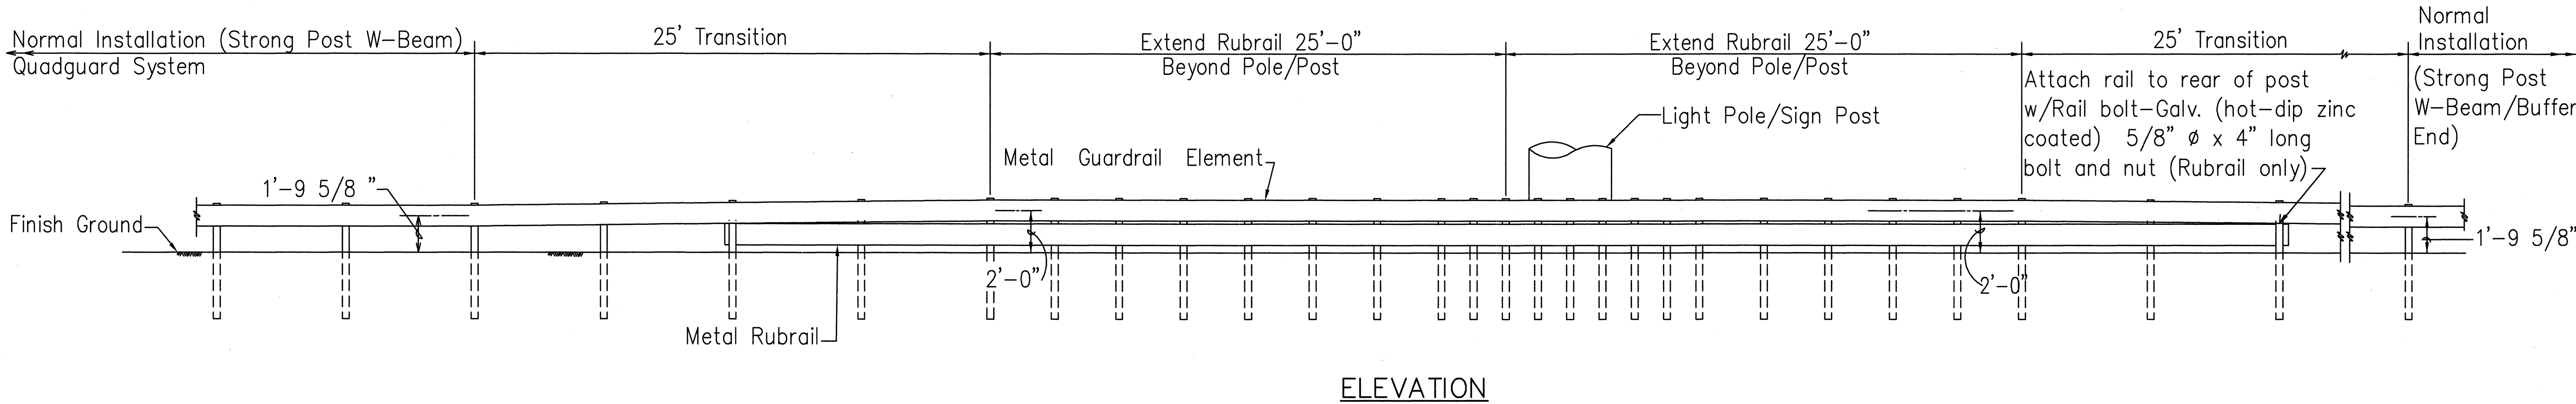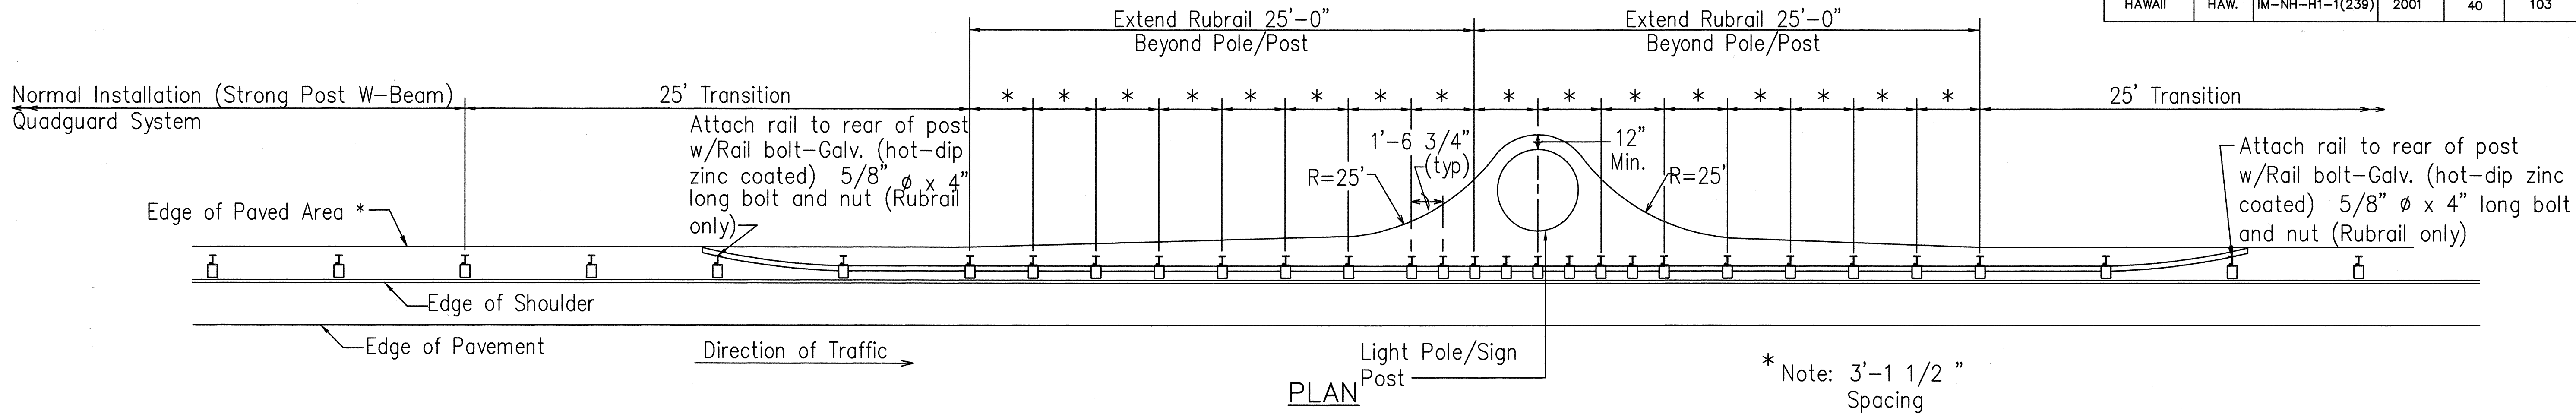

TYPICAL SECTION AT OBSTRUCTION

DETAIL OF GUARDRAIL INSTALLATION AT OBSTRUCTION

DATE	_____
SURVEY PLOTTED BY	_____
DESIGNED BY	_____
TRACED BY	_____
NOTED BY	_____
CHECKED BY	_____
ORIGINAL PLAN	_____
NO.	_____

NORMAN K. NAGAMINE
LICENSED PROFESSIONAL ENGINEER
NO. 5479-S
HAWAII, U.S.A.

THIS WORK WAS PREPARED BY ME OR UNDER MY SUPERVISION

STATE OF HAWAII
DEPARTMENT OF TRANSPORTATION
HIGHWAYS DIVISION


**DETAIL OF GUARDRAIL
AT OBSTRUCTION**

INTERSTATE ROUTE H-1
Palailai Interchange Reconstruction
F.A.I. Project No. IM-NH-H1-1(239)







Scale: As Shown Date: 4/1/01

SHEET NO. S-5 OF 12 SHEETS

FED. ROAD DIST. NO.	STATE	FED. AID PROJ. NO.	FISCAL YEAR	SHEET NO.	TOTAL SHEETS
HAWAII	HAW.	IM-NH-H1-1(239)	2001	41	103

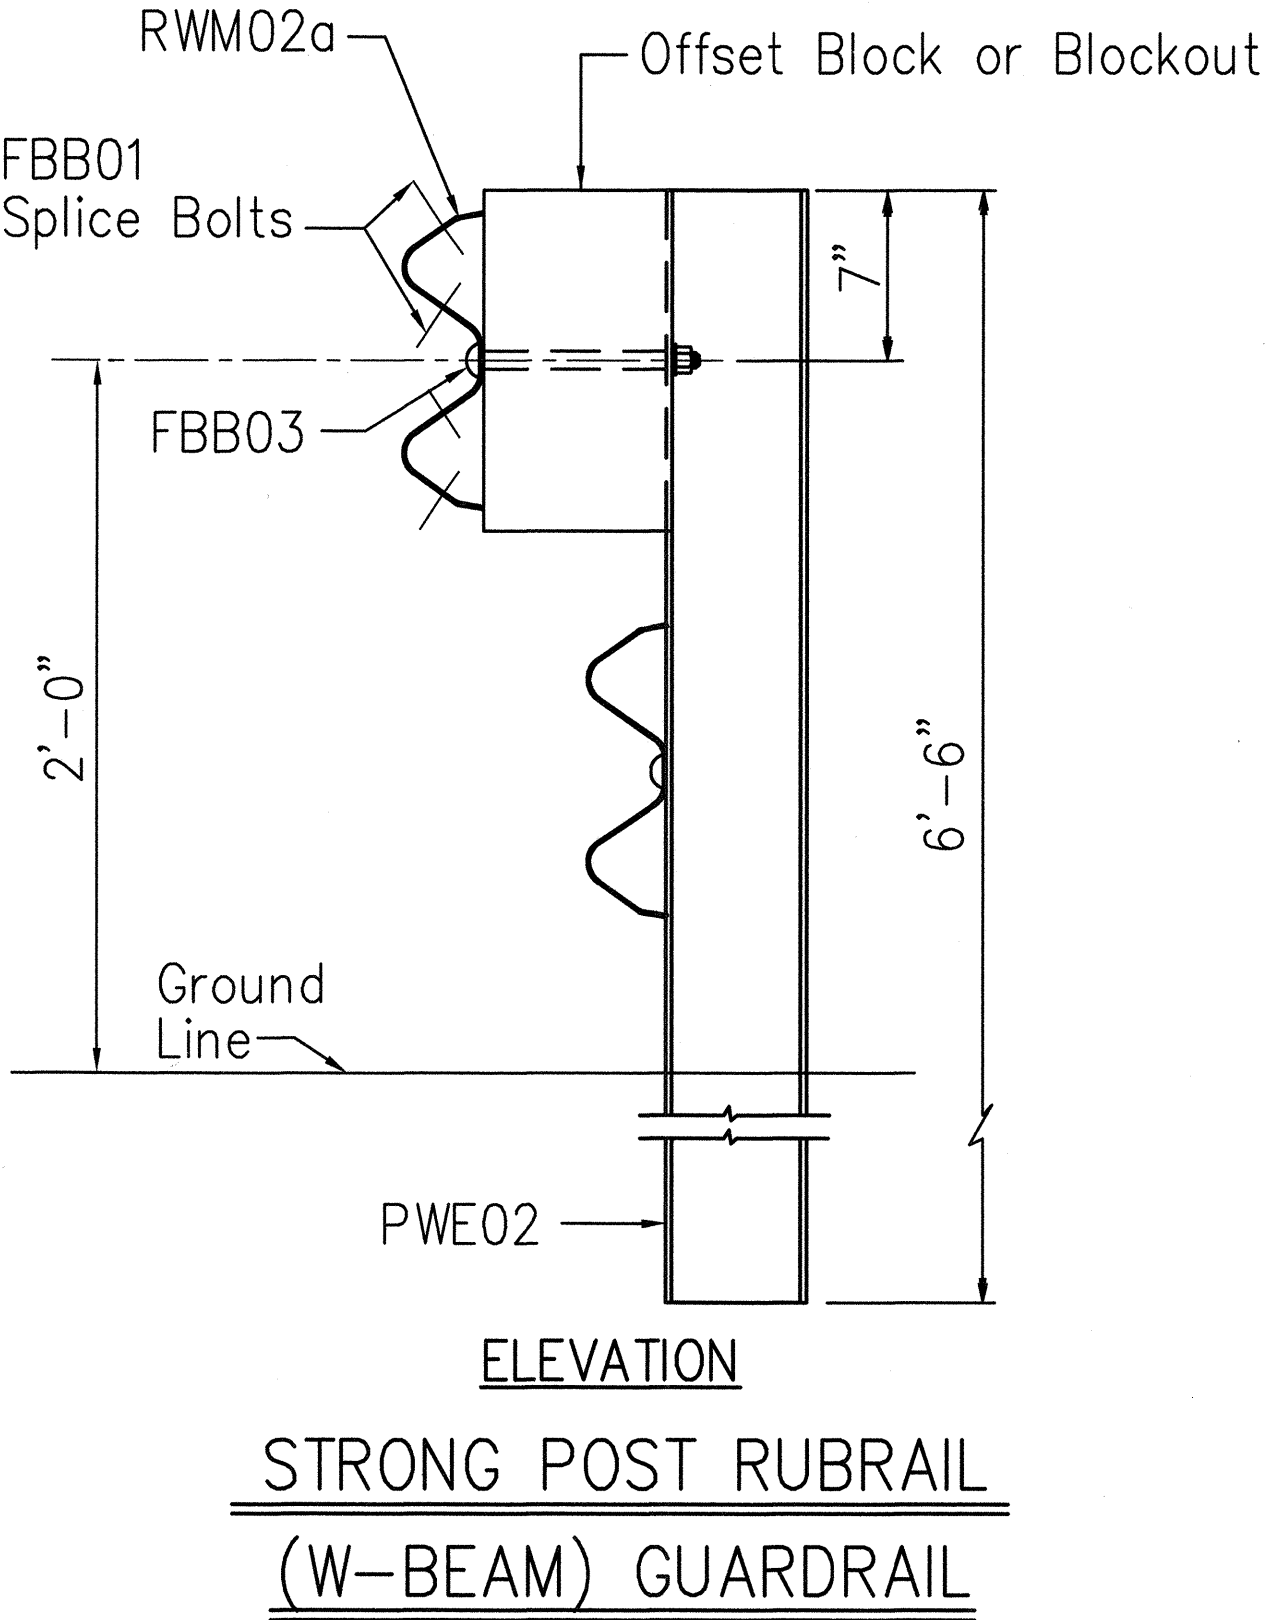

NOTE:
All Holes are
3/4" Dia.

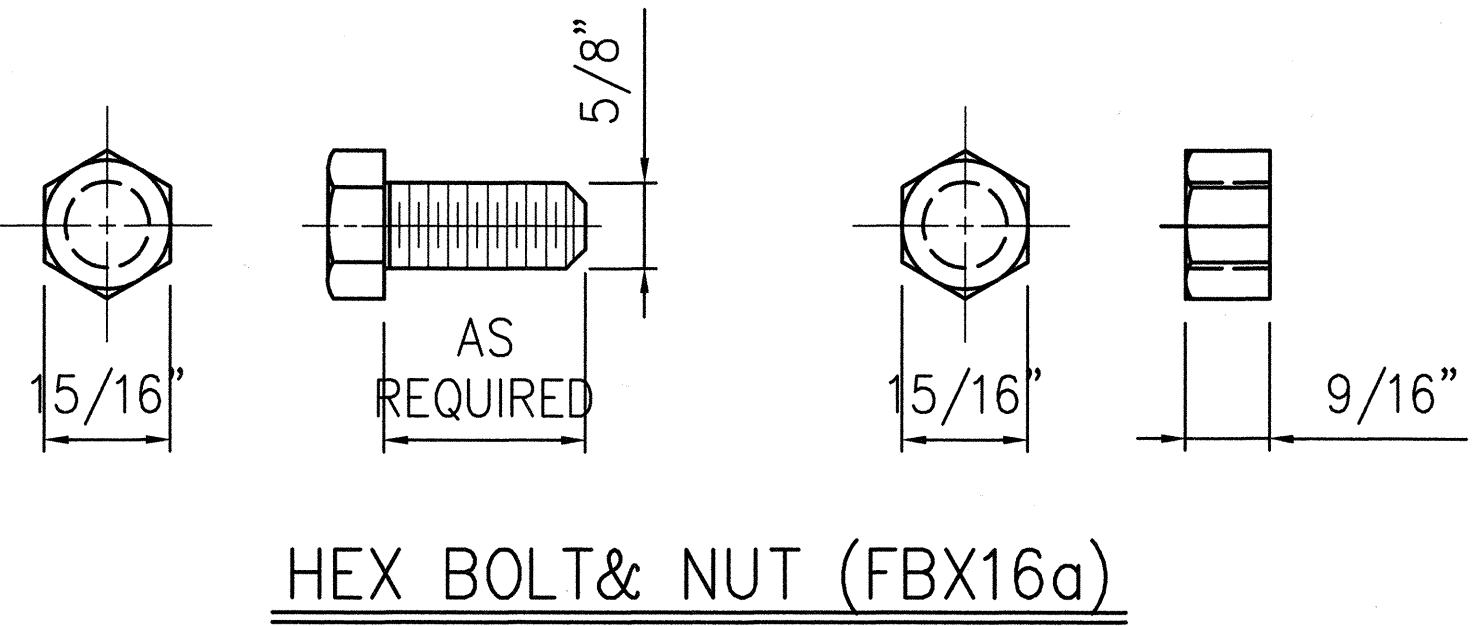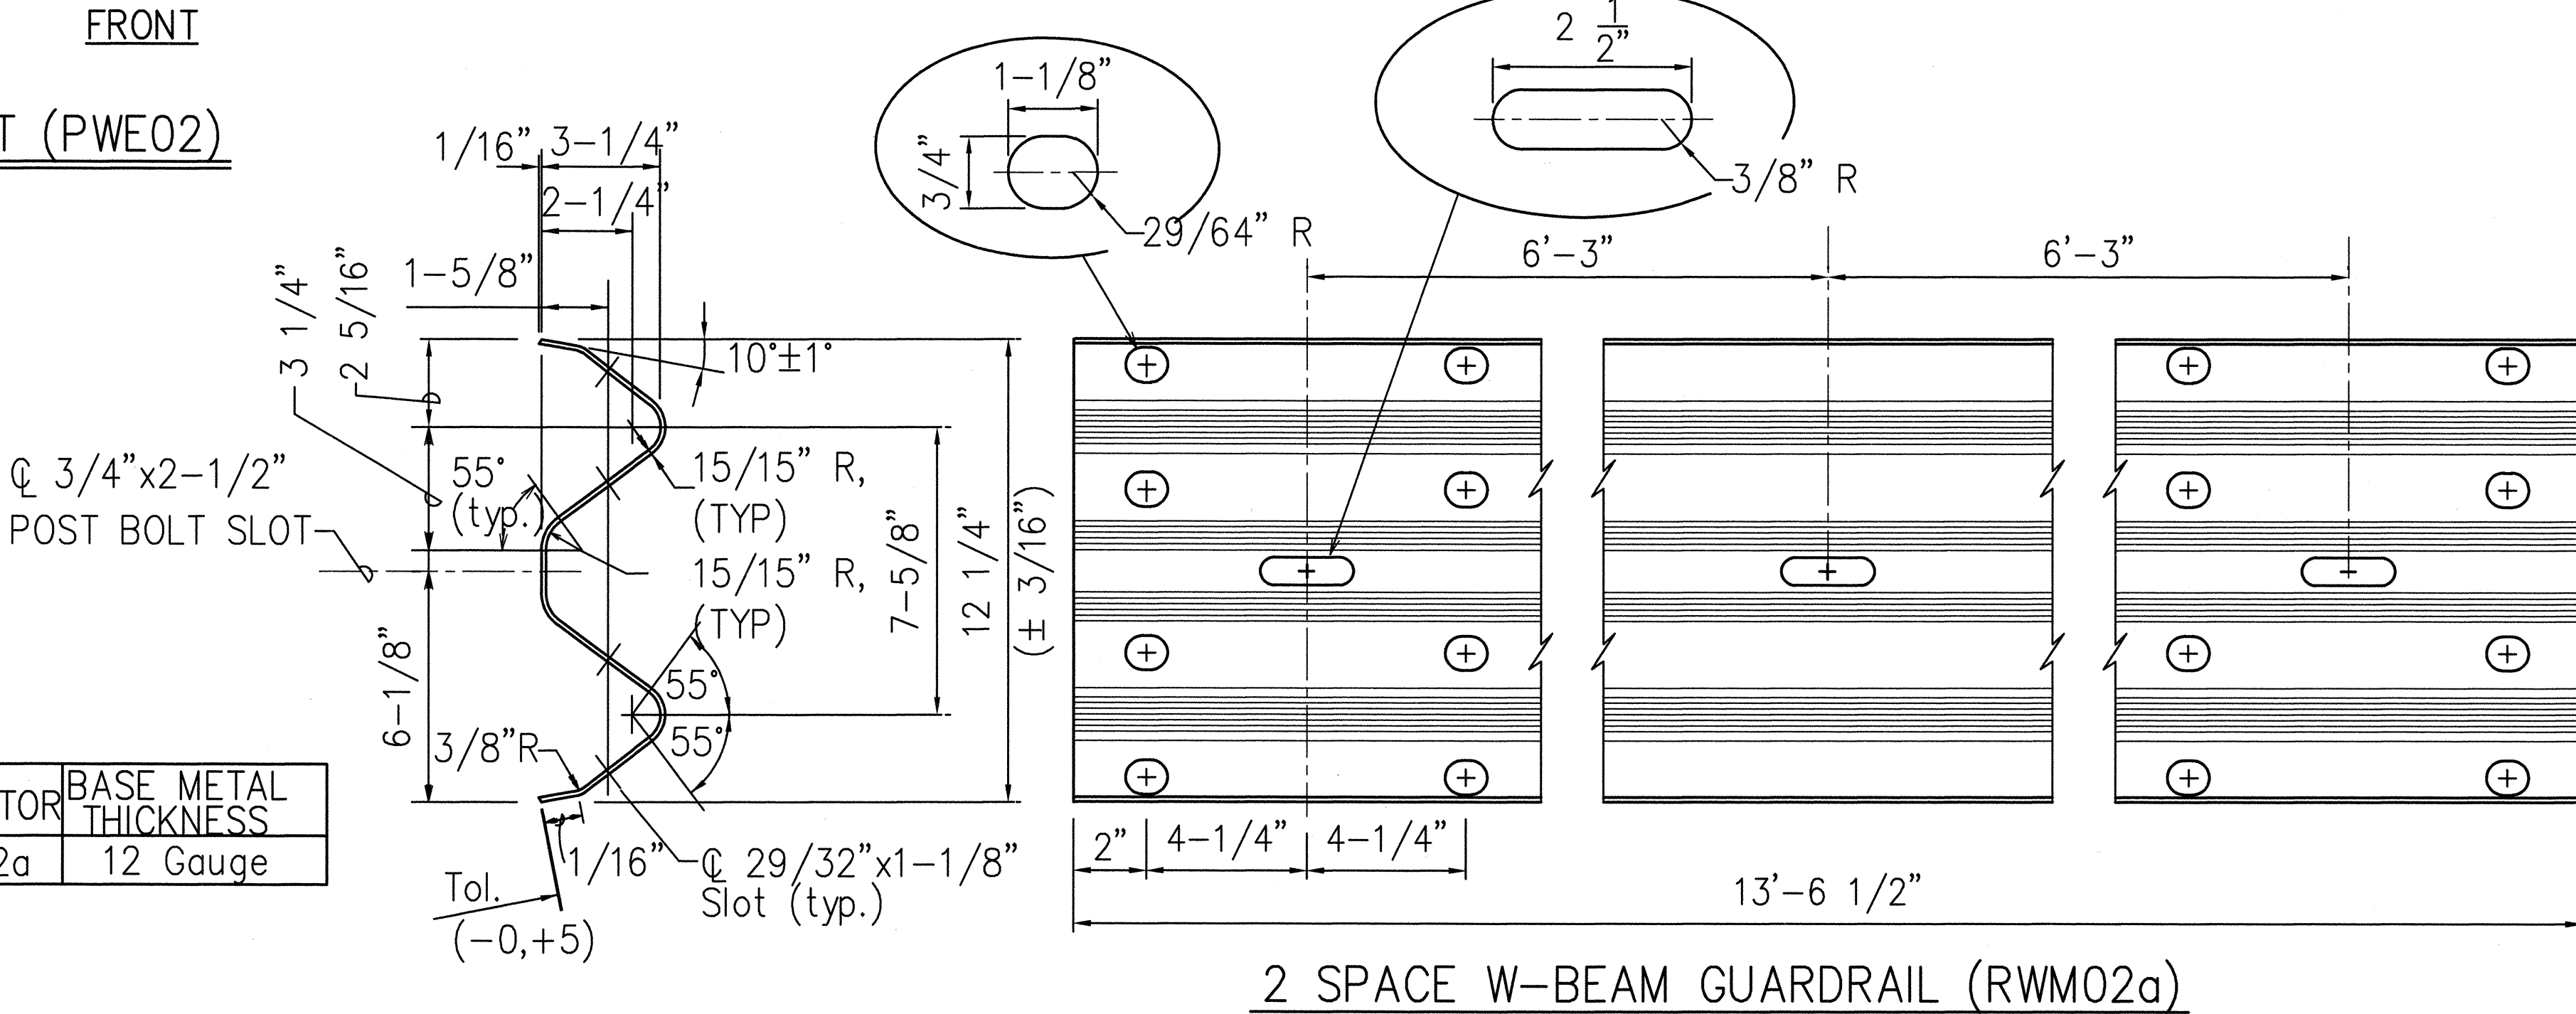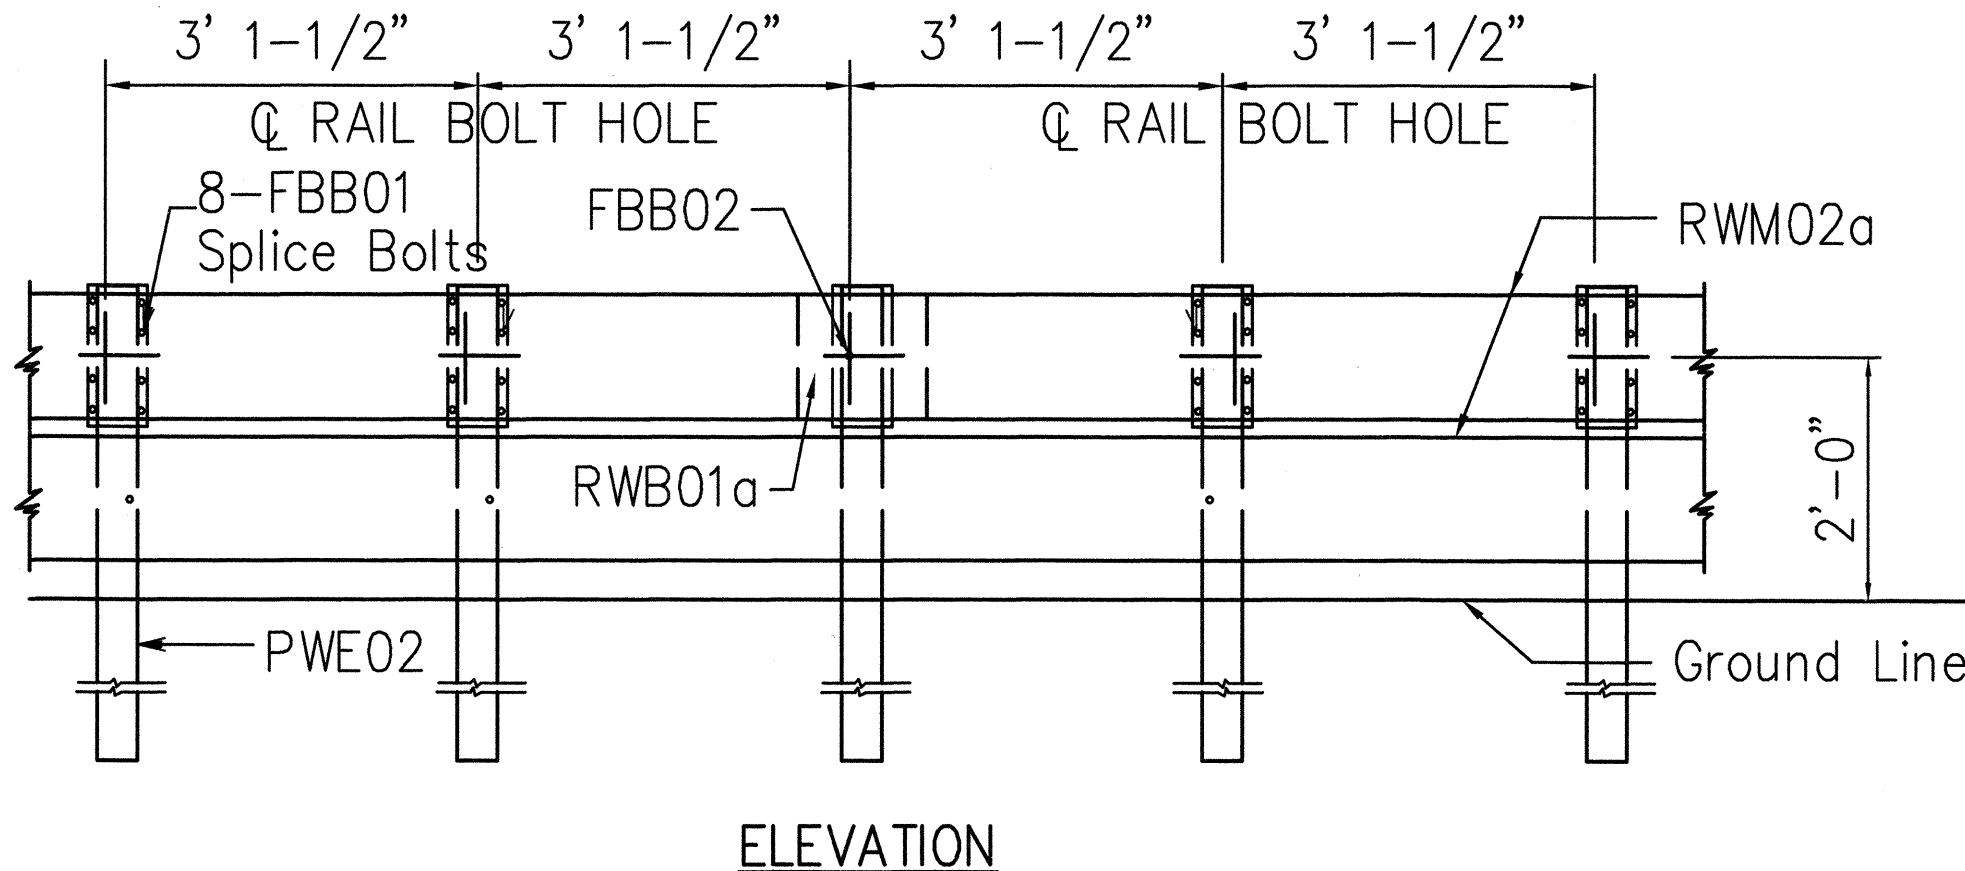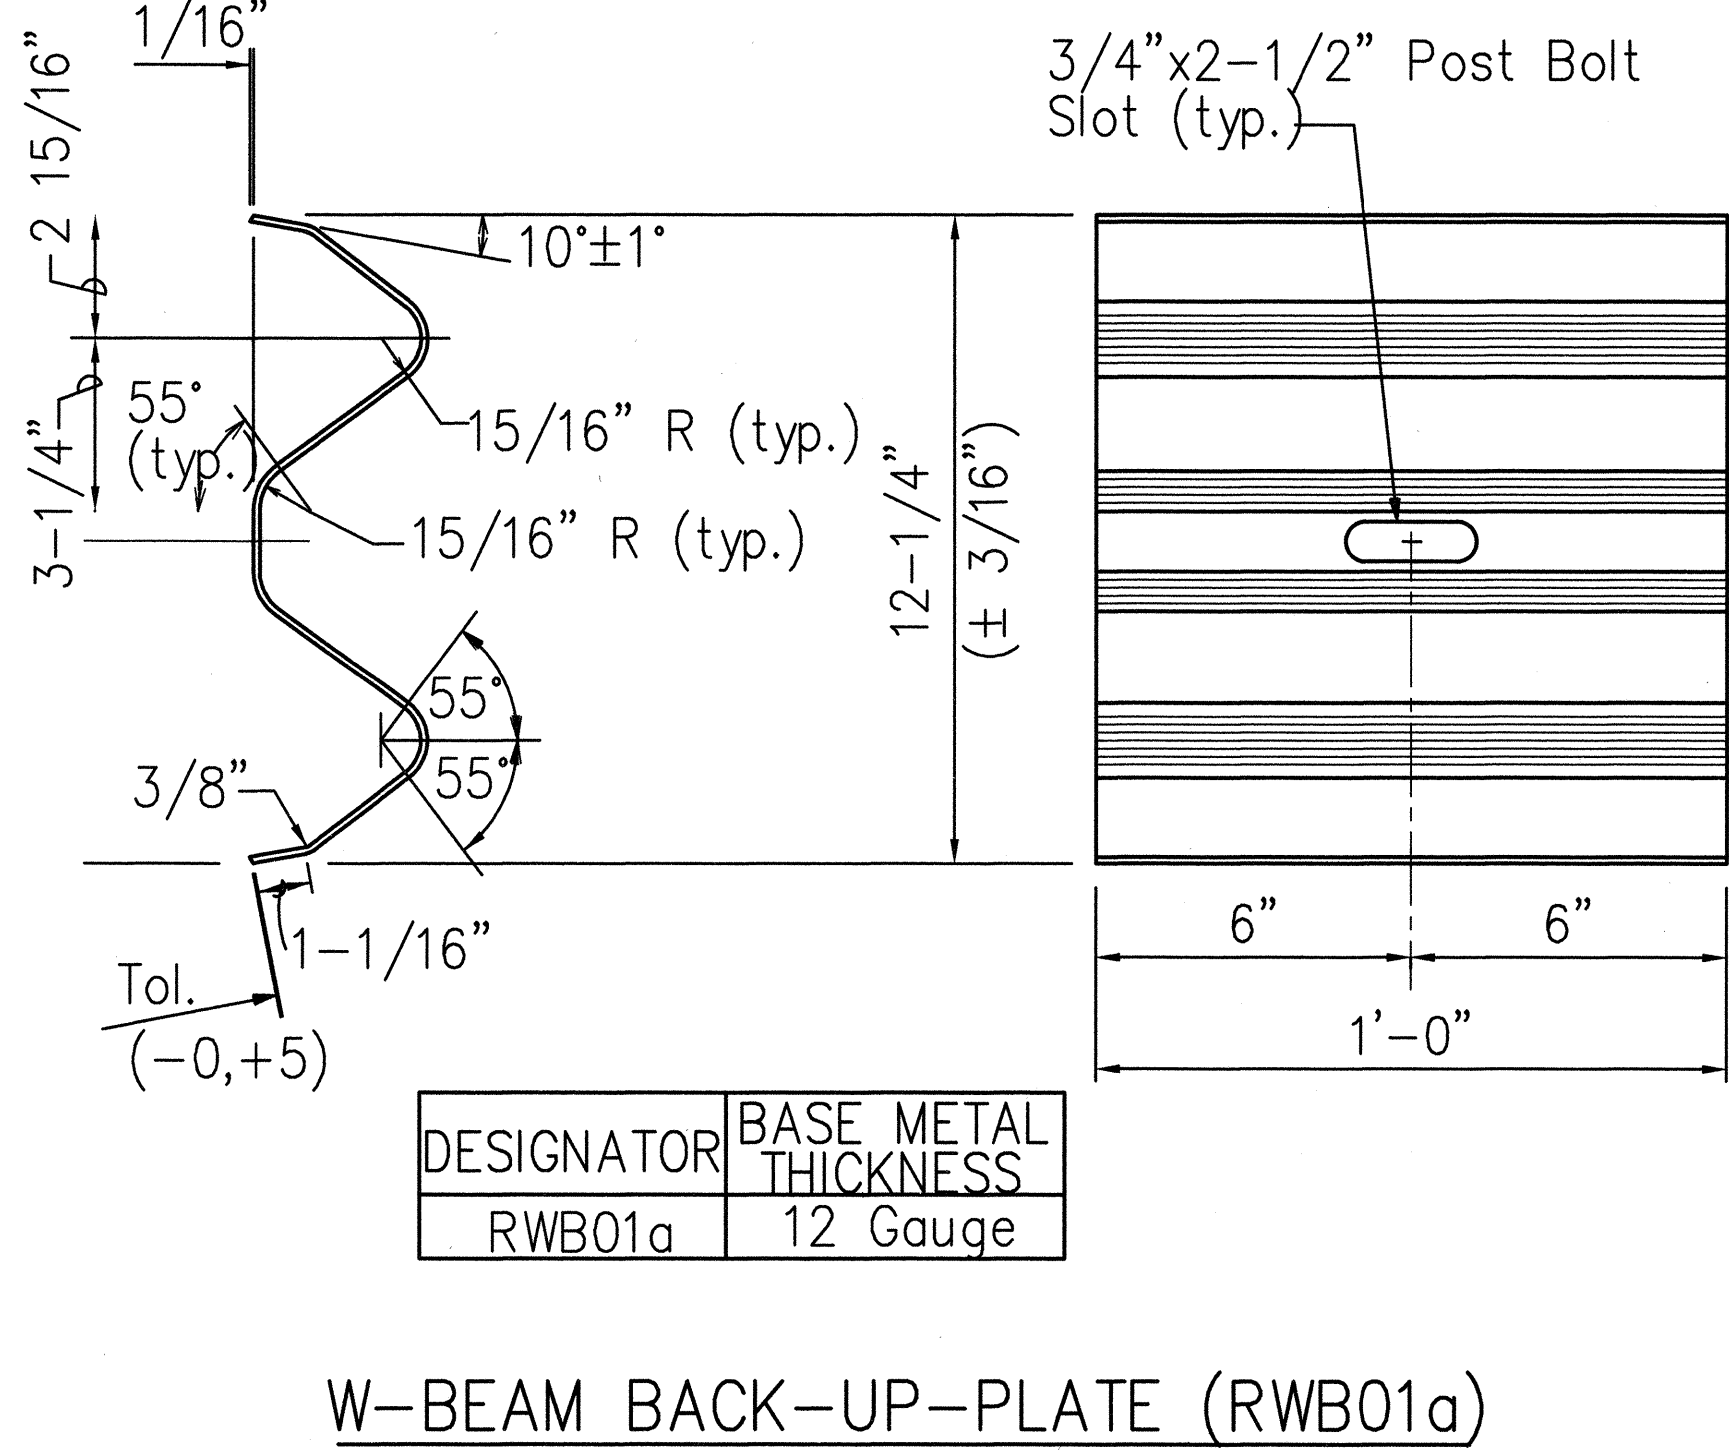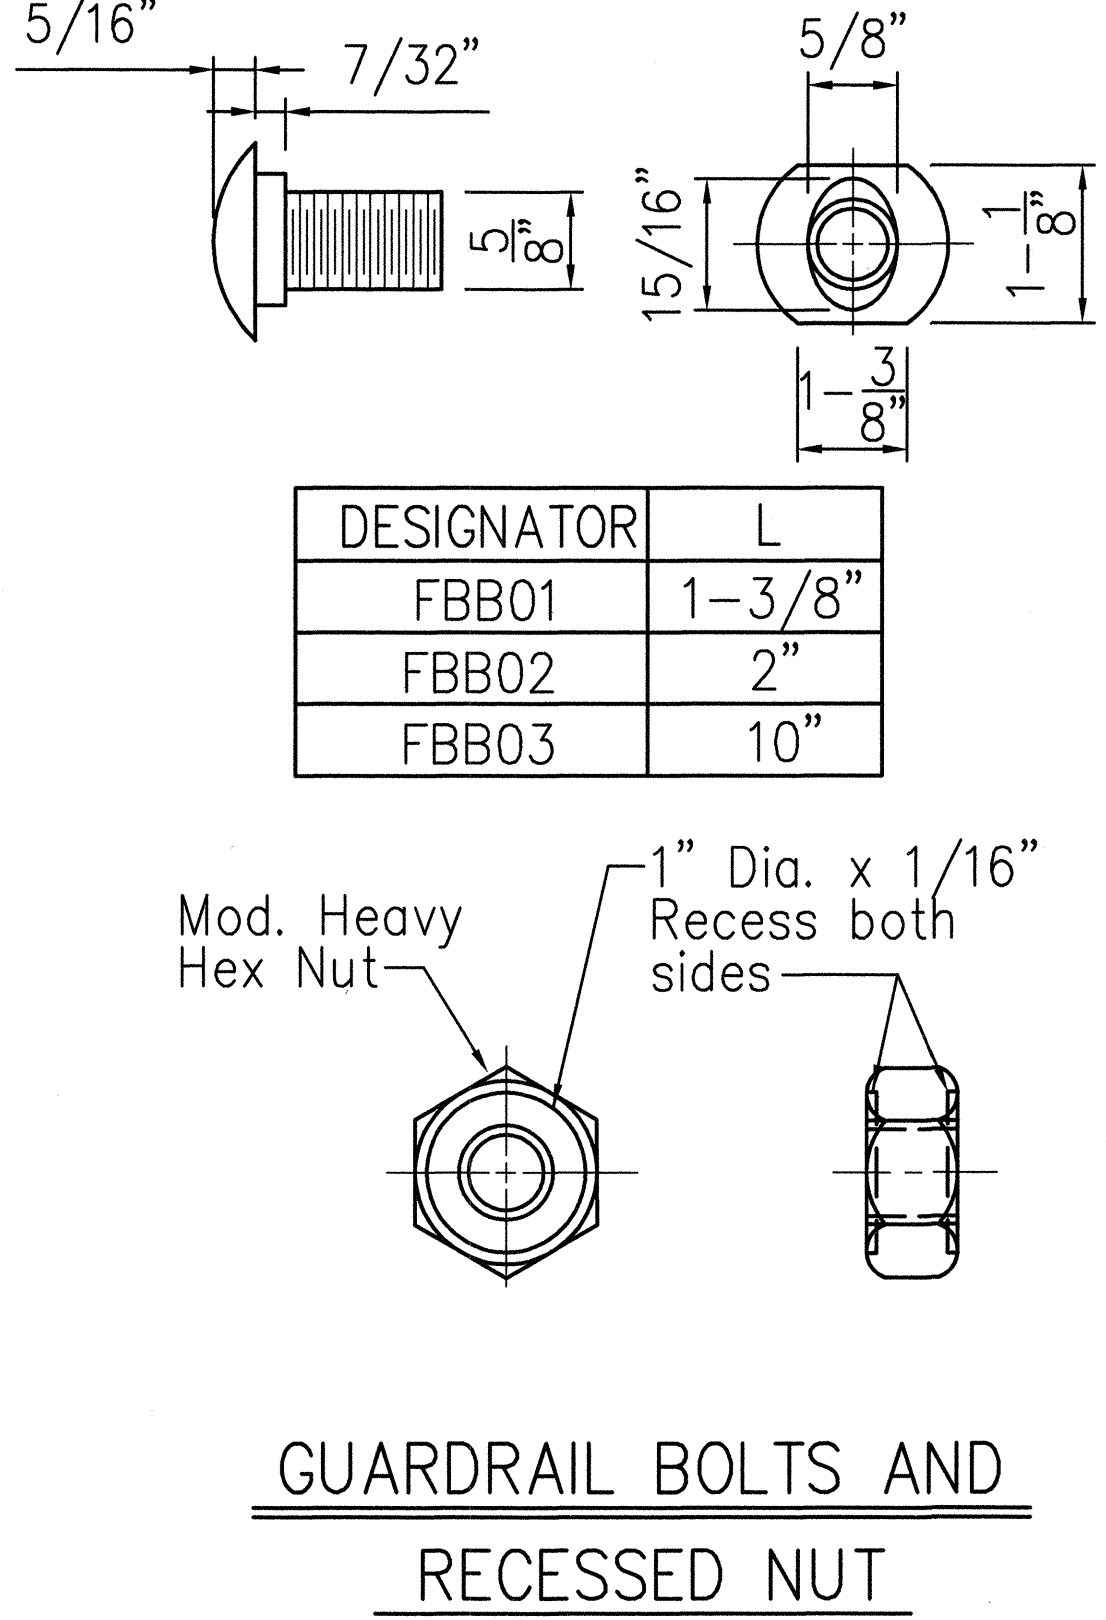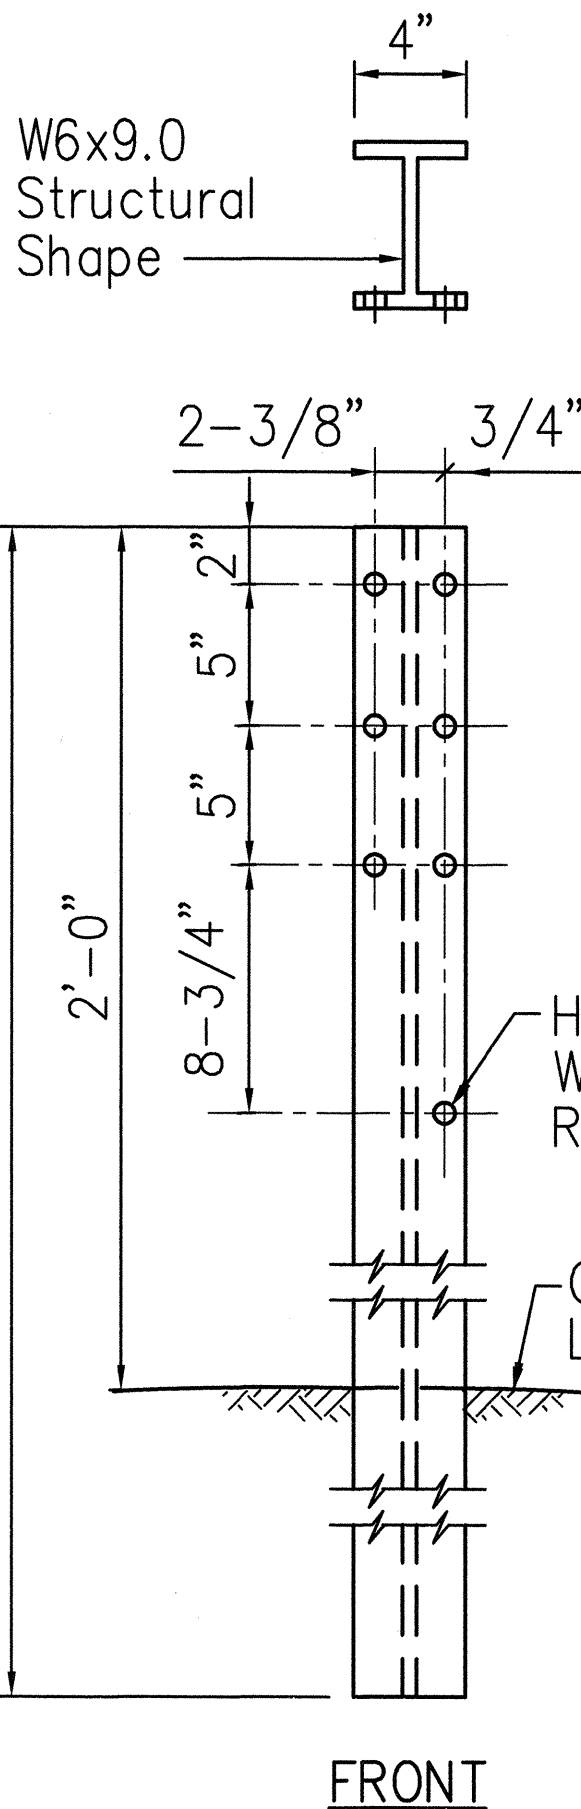

STATE OF HAWAII
DEPARTMENT OF TRANSPORTATION
HIGHWAYS DIVISION


**STRONG POST RUBRAIL
(W-BEAM) GUARDRAIL**

INTERSTATE ROUTE H-1
Palailai Interchange Reconstruction
F.A.I. Project No. IM-NH-H1-1(239)


Scale: As Shown Date: 4/1/01

SHEET NO. 5-6 OF 12 SHEETS

FED. ROAD DIST. NO.	STATE	FED. AID PROJ. NO.	FISCAL YEAR	SHEET NO.	TOTAL SHEETS
HAWAII	HAW.	IM-NH-H1-1(239)	2001	42	103

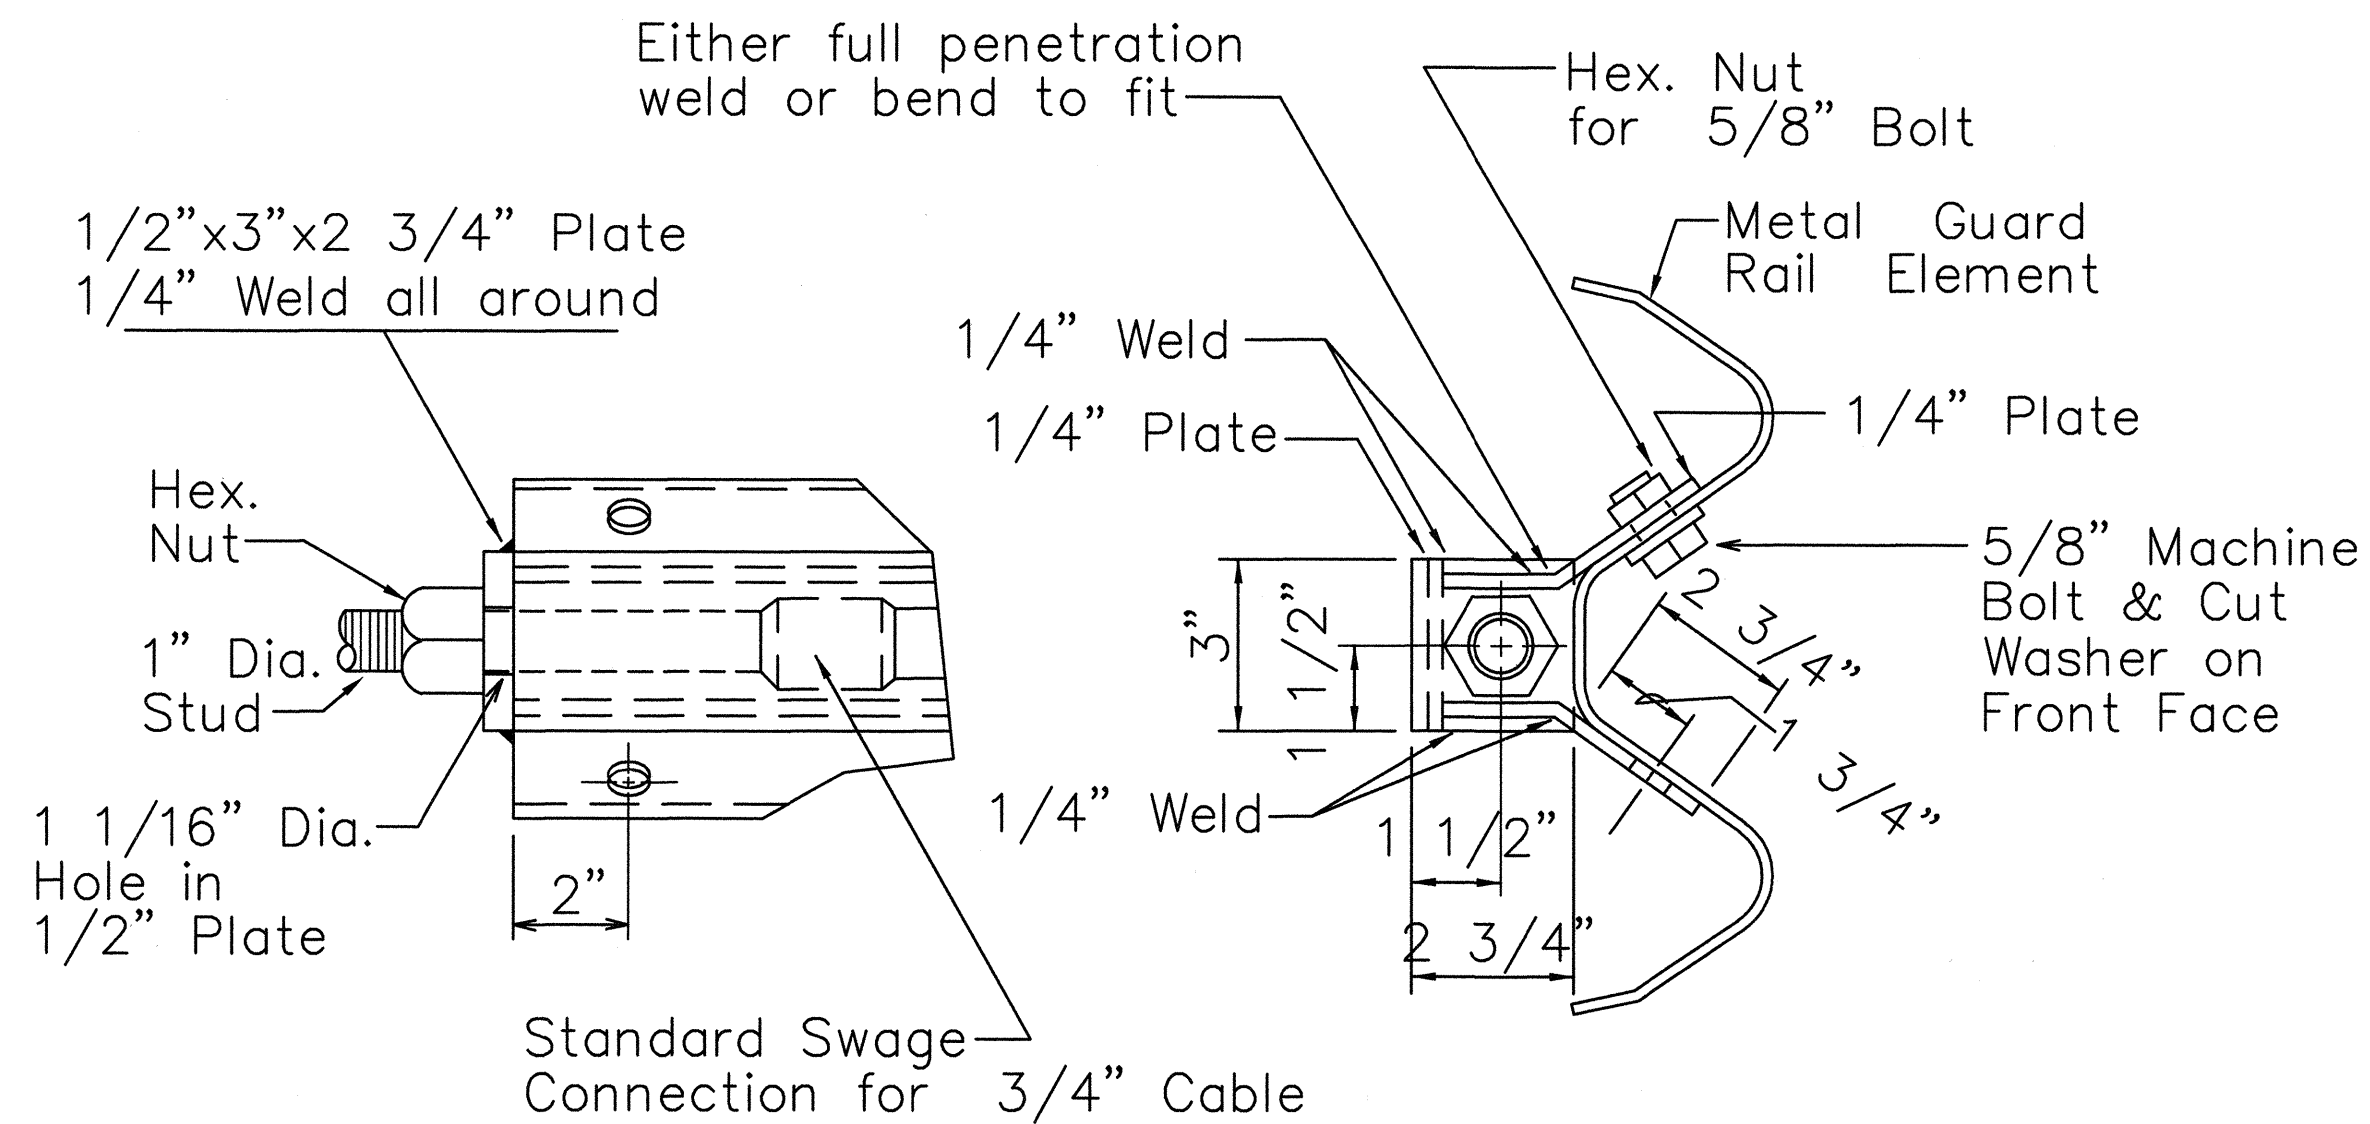


ANCHOR PLATE DETAILS

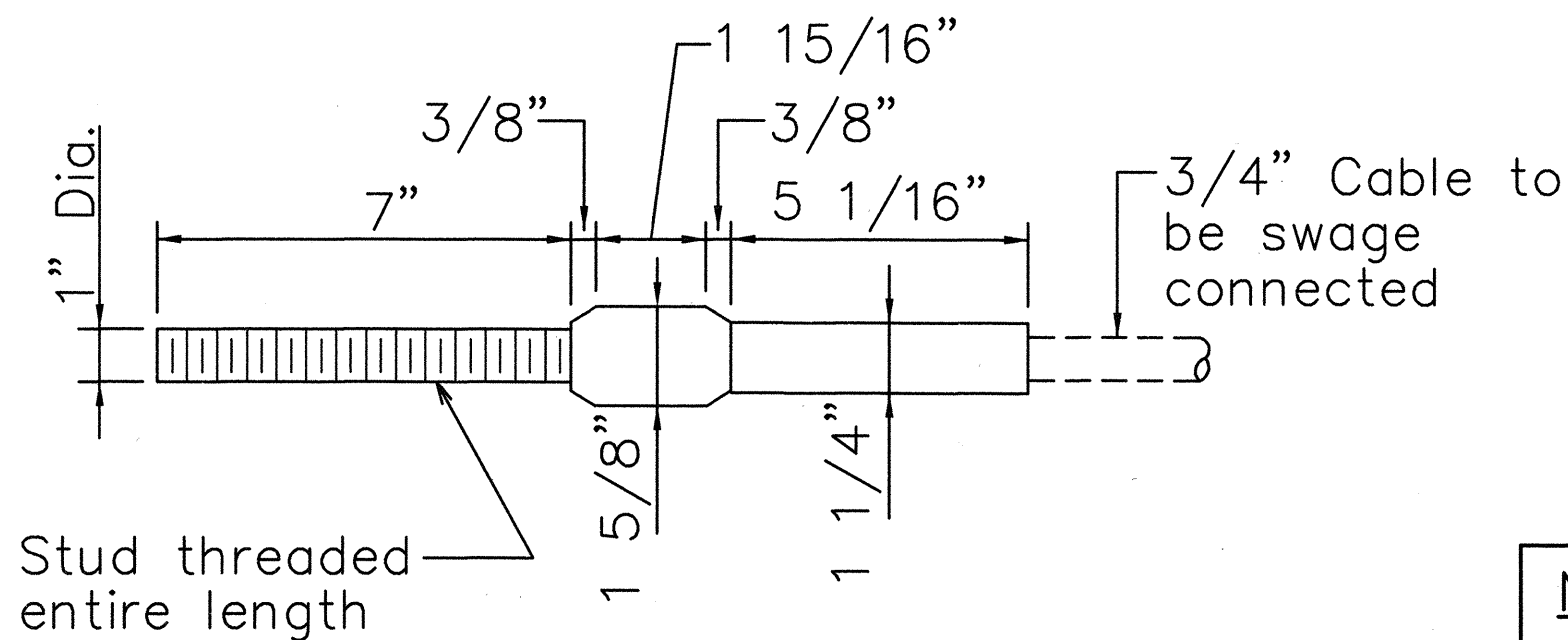

STANDARD SWAGED FITTING AND STUD

NOTE:


During construction, the Contractor shall layout the proposed Type "G" Modified End Terminal and receive approval from the Engineer prior to installation.

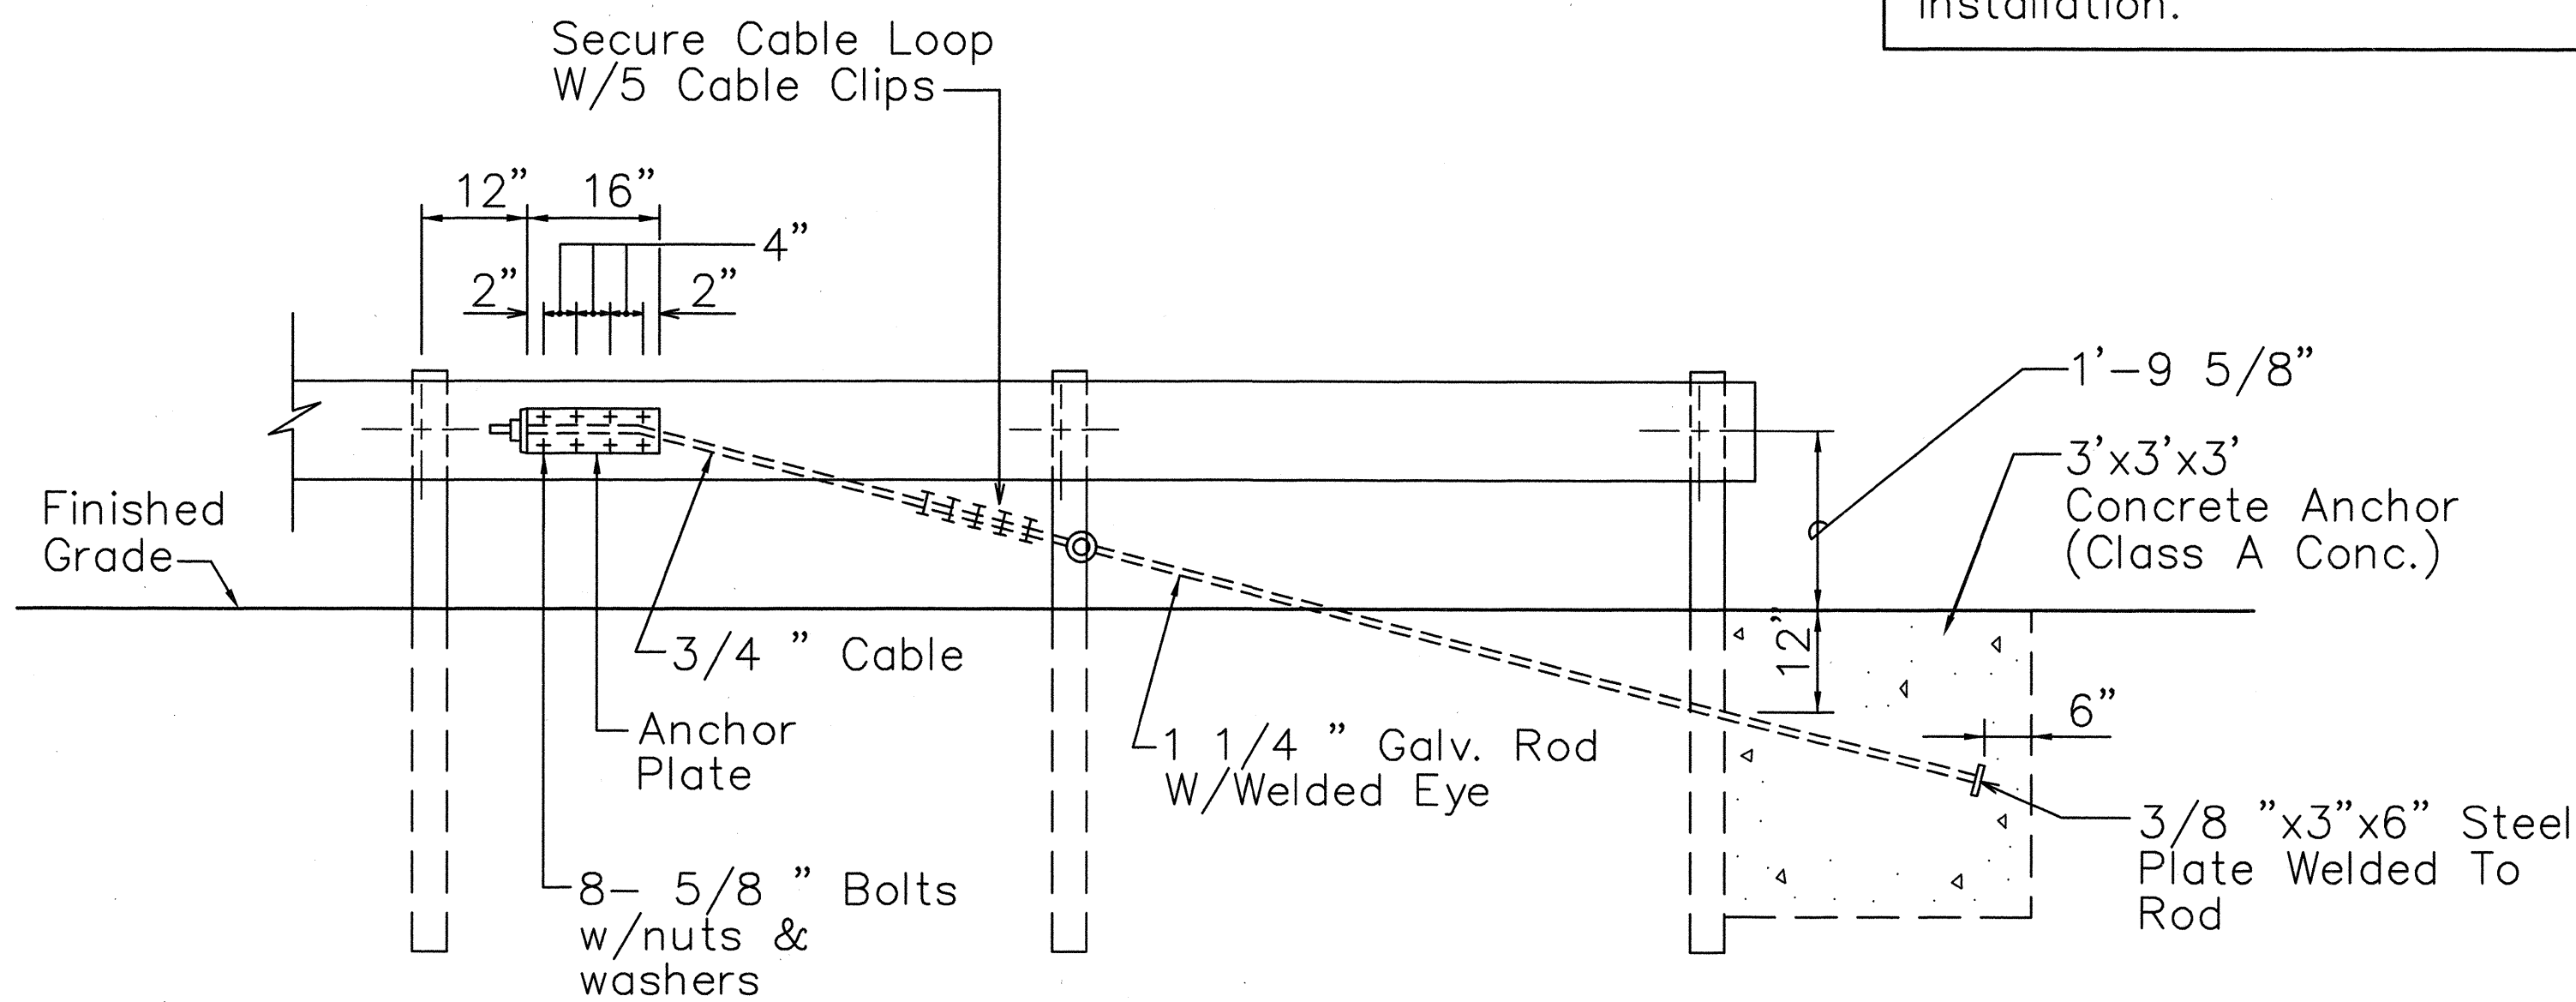

ANCHOR BLOCK DETAIL

- Concrete, excavation, anchor rod and miscellaneous appurtenances necessary to anchor the guardrail ends shall be incidental to metal guardrail.

For Details of Concrete Anchor Block in Ground See Det. below.

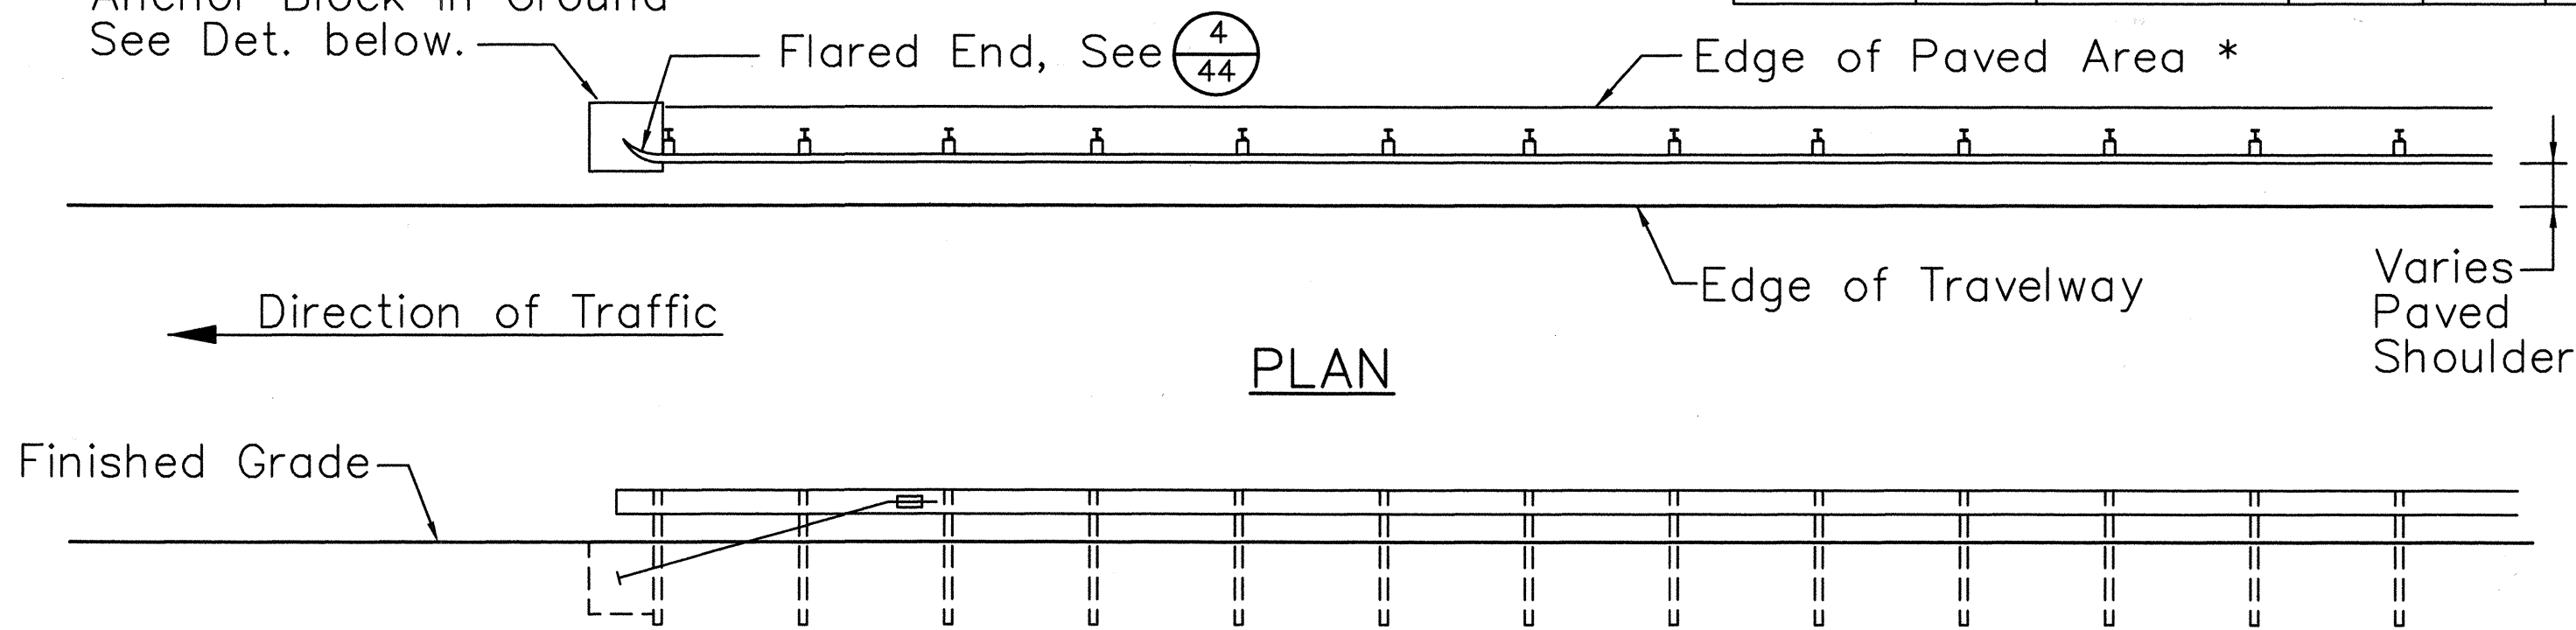

PLAN

ELEVATION

TYPE "G" FLARE END TERMINAL

* Note:

Provide only where indicated on the Typical Sections and/or Roadway Plans

DATE	SURVEY LOCATED BY	DATE
ORIGINAL PLAN	DESIGNED BY	NOTED BY
NO.	QUANTITIES BY	CHECKED BY










THIS WORK WAS PREPARED BY ME OR UNDER MY SUPERVISION

STATE OF HAWAII
DEPARTMENT OF TRANSPORTATION
HIGHWAYS DIVISION
TYPE "G" FLARE END TERMINAL

INTERSTATE ROUTE H-1
Palailai Interchange Reconstruction
F.A.I. Project No. IM-NH-H1-1(239)

Scale: As Shown Date: 4/1/01

SHEET NO. S-7 OF 12 SHEETS

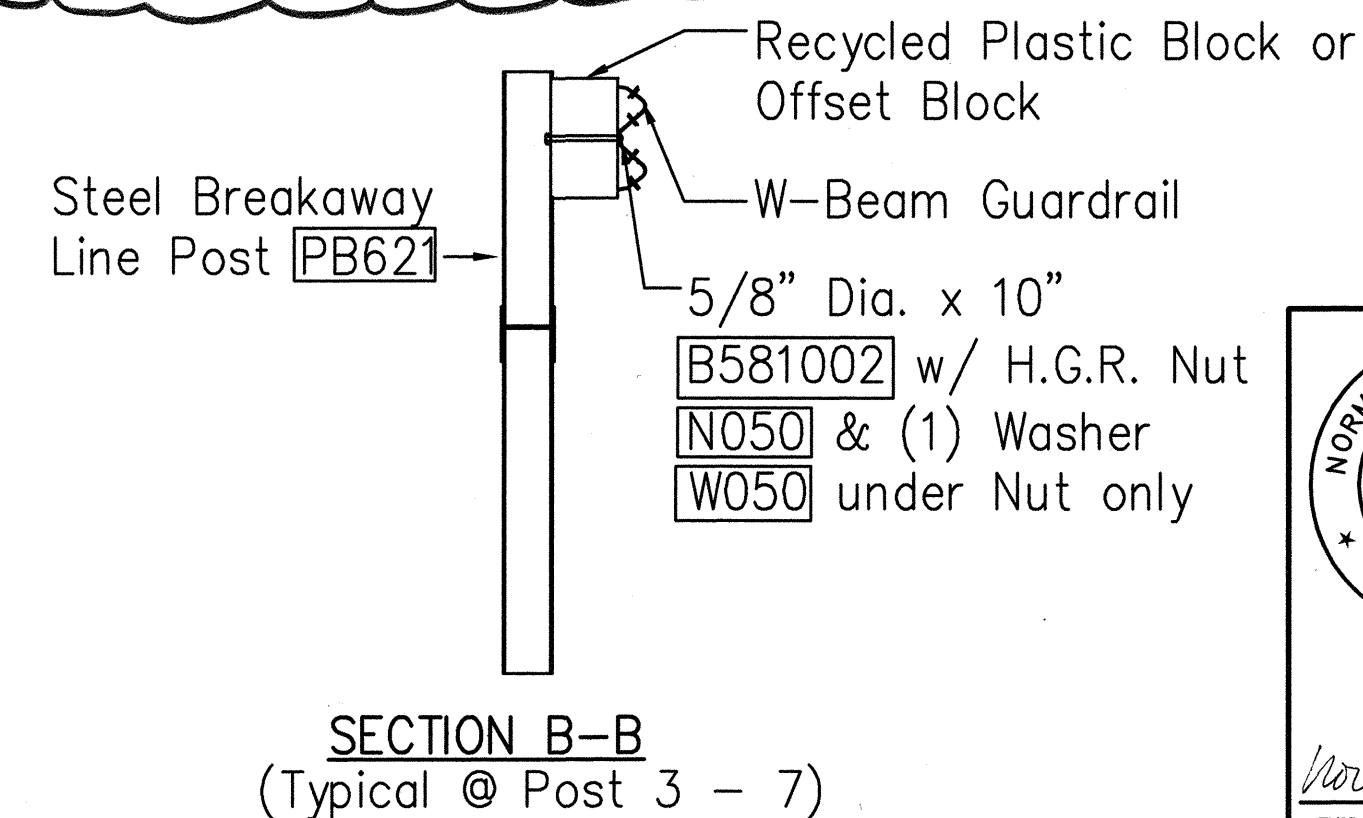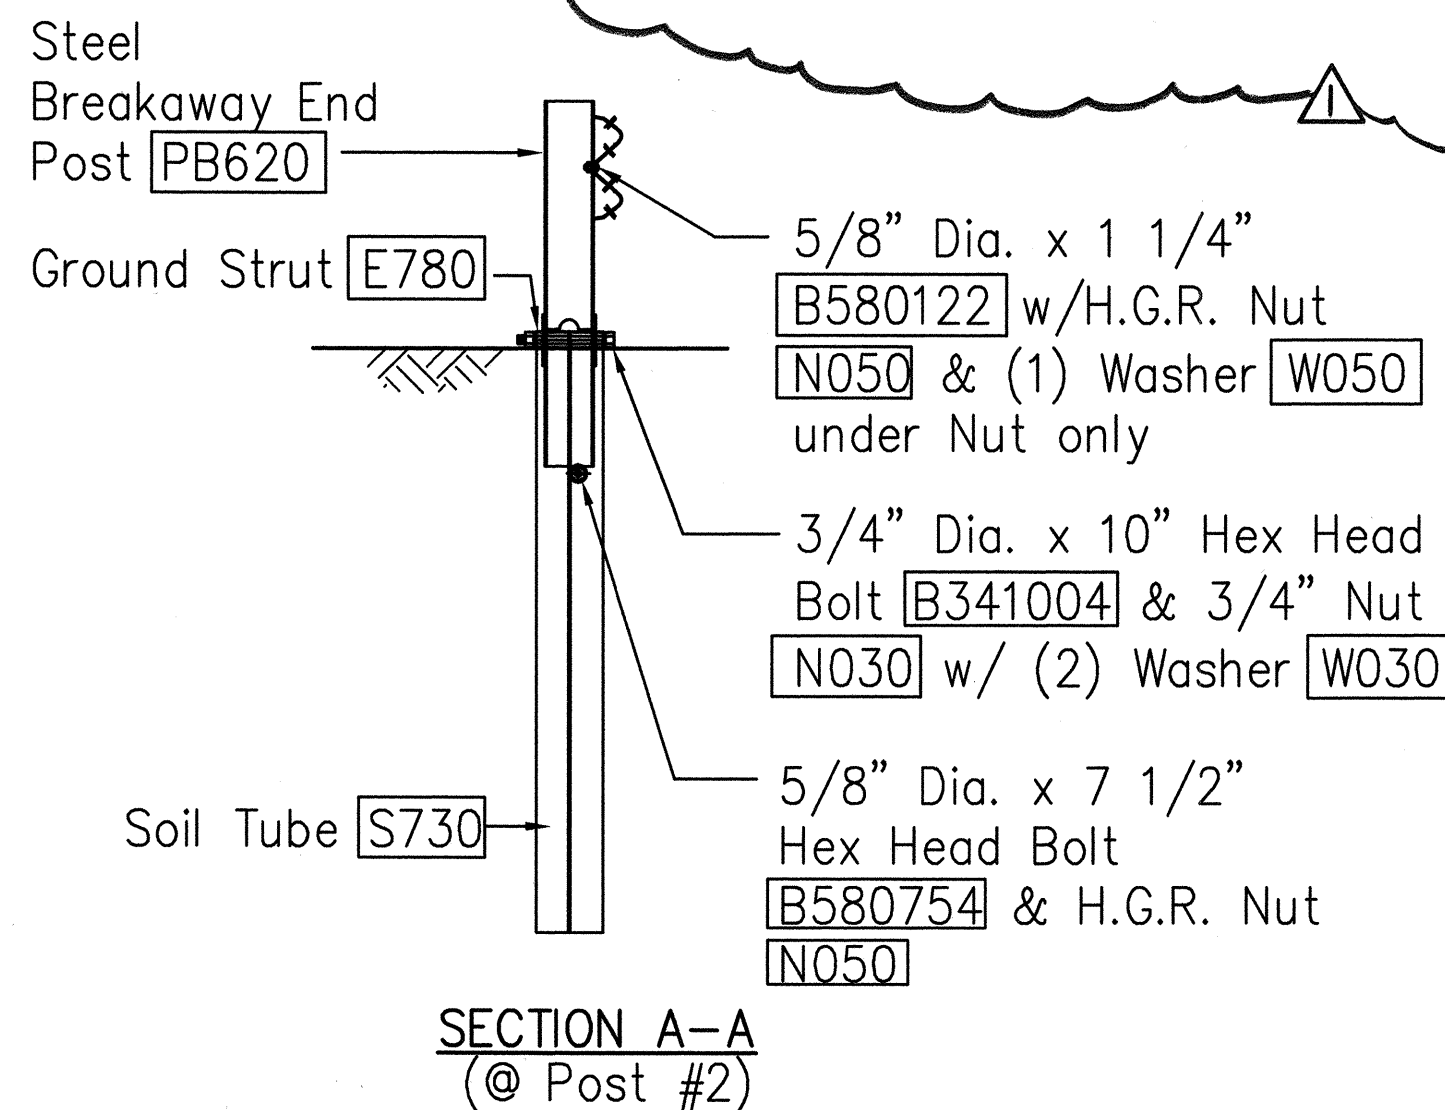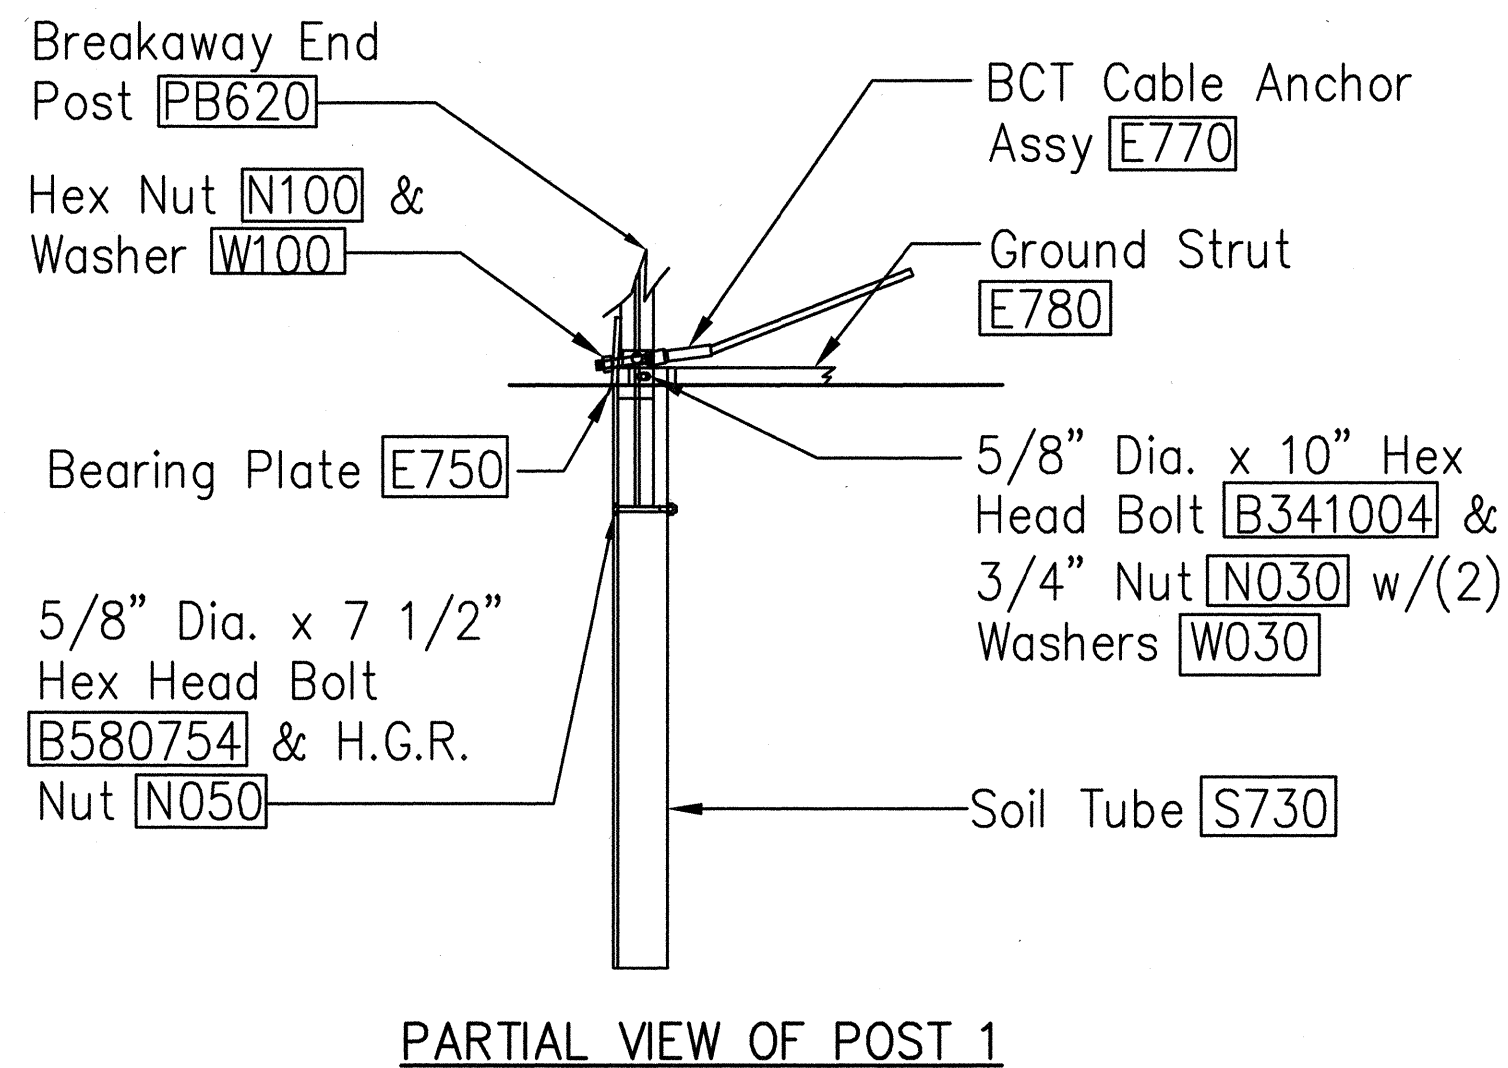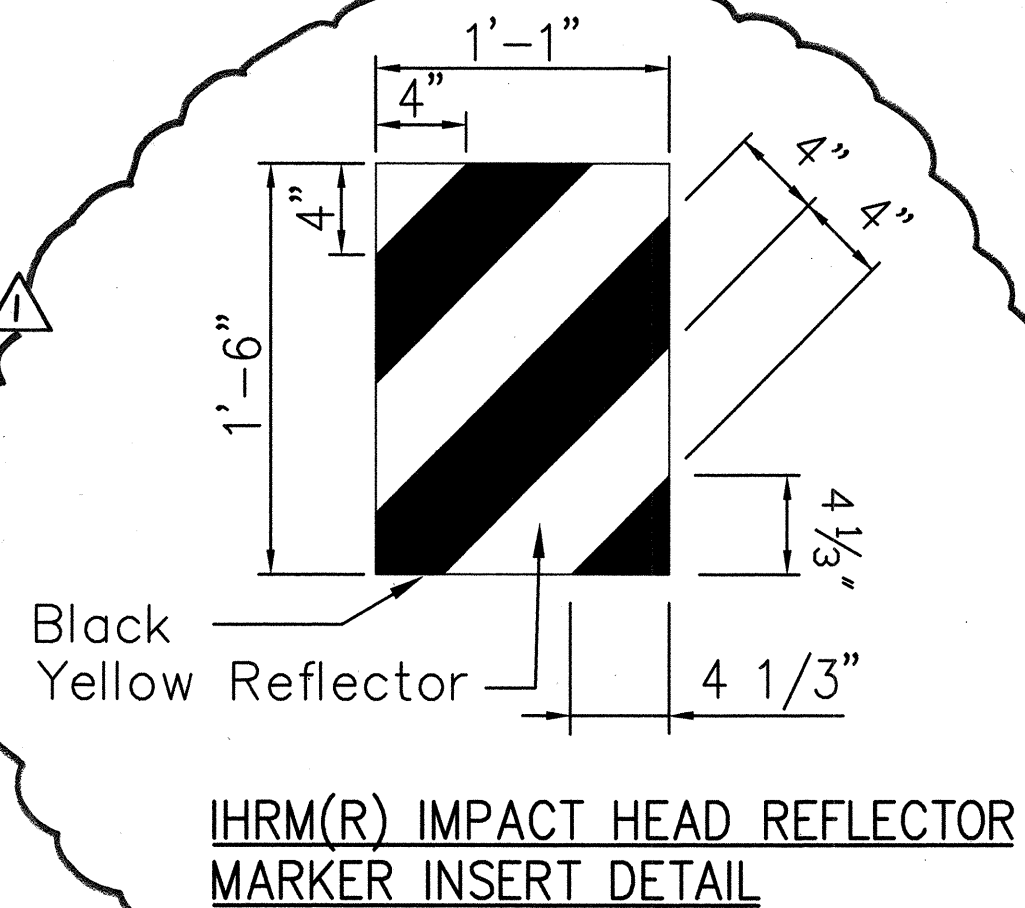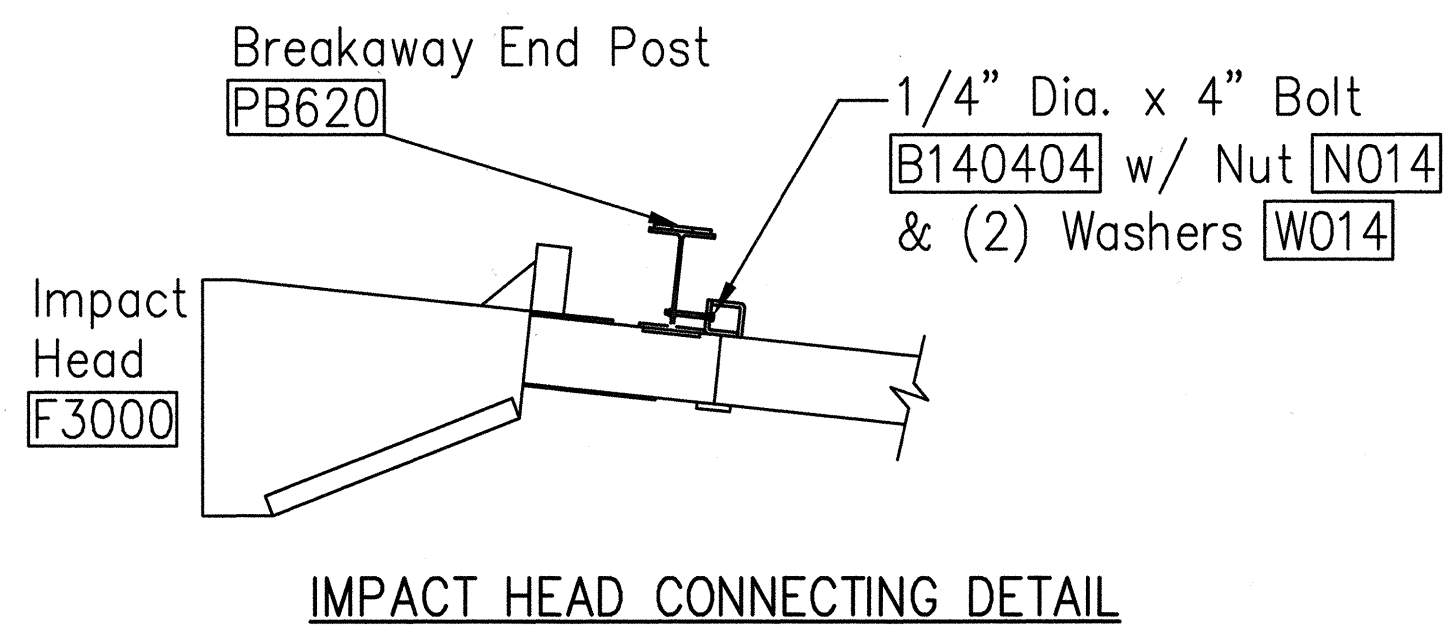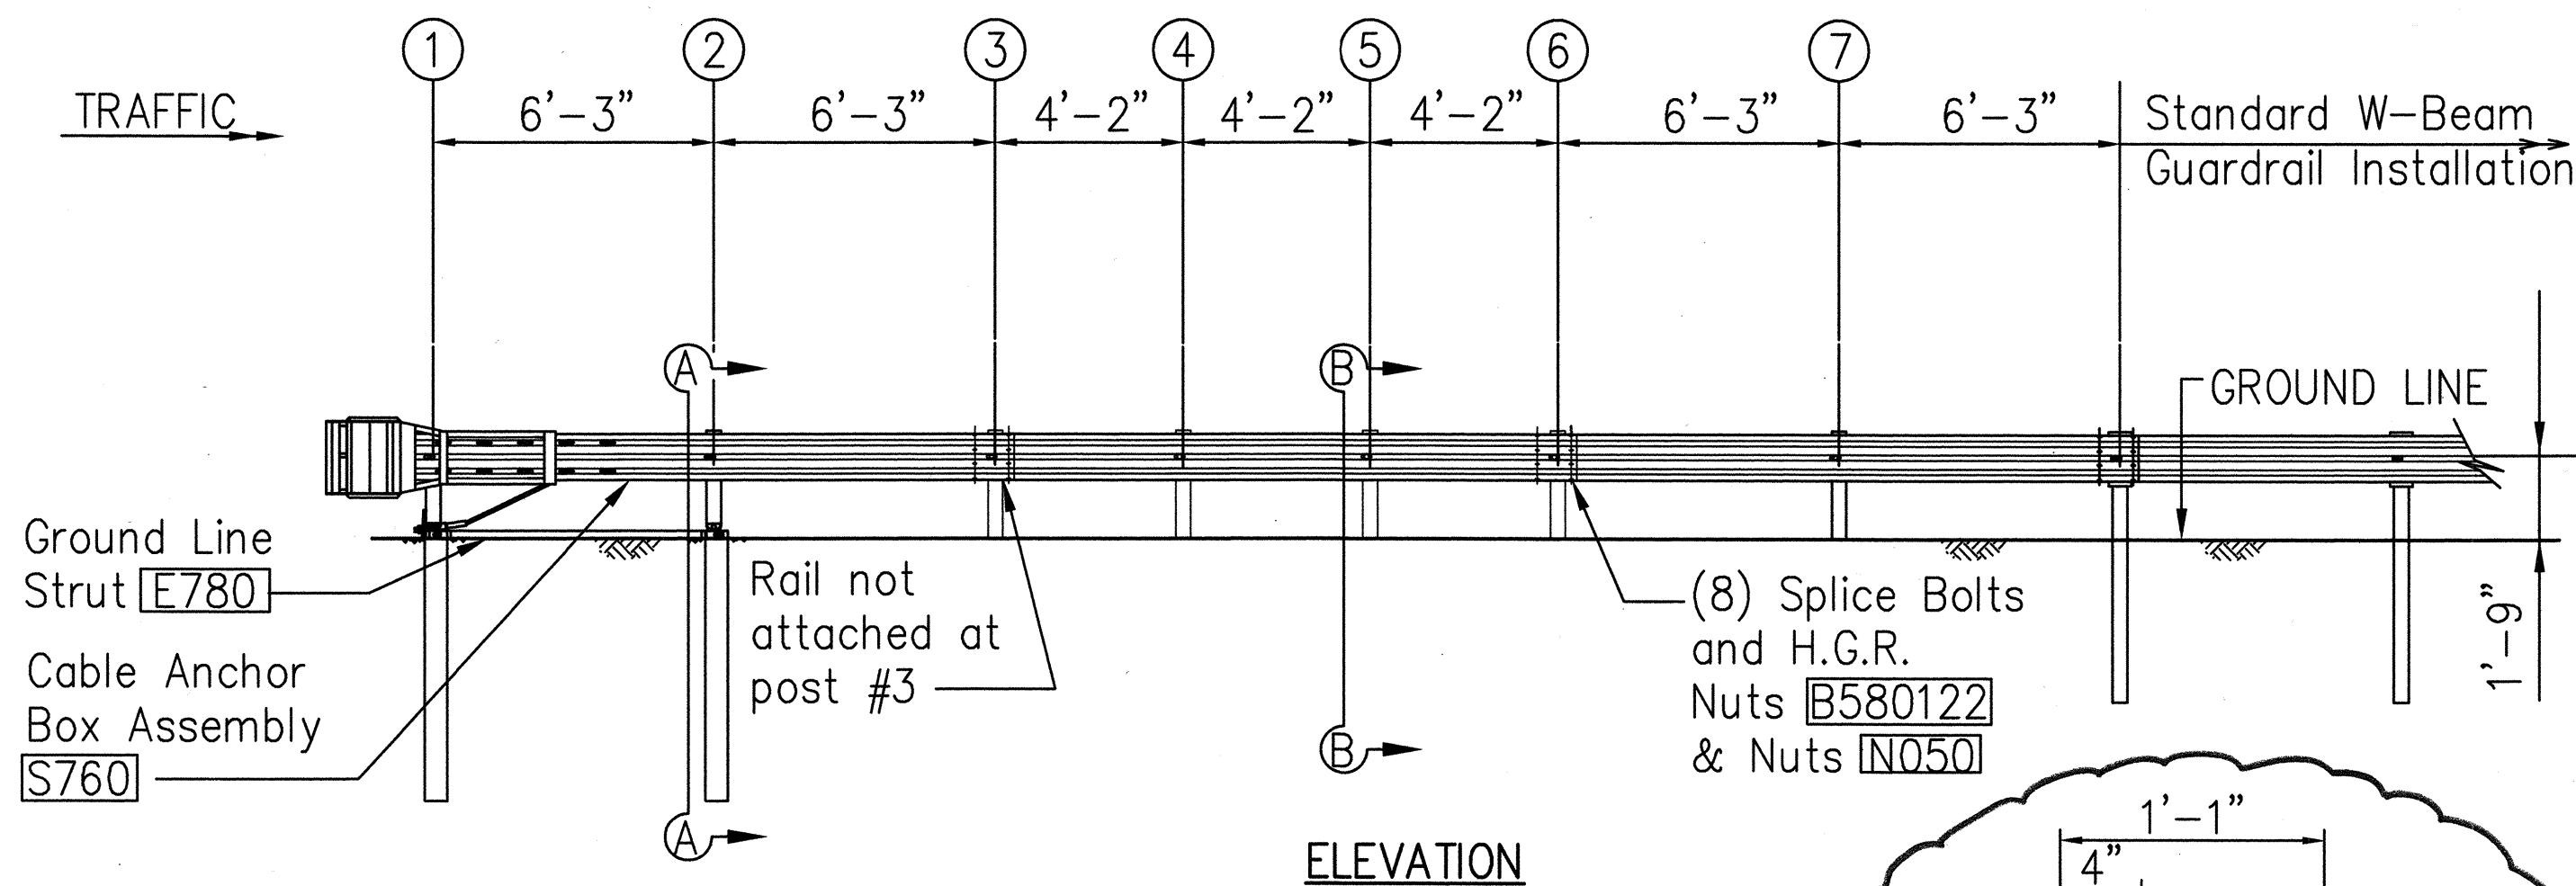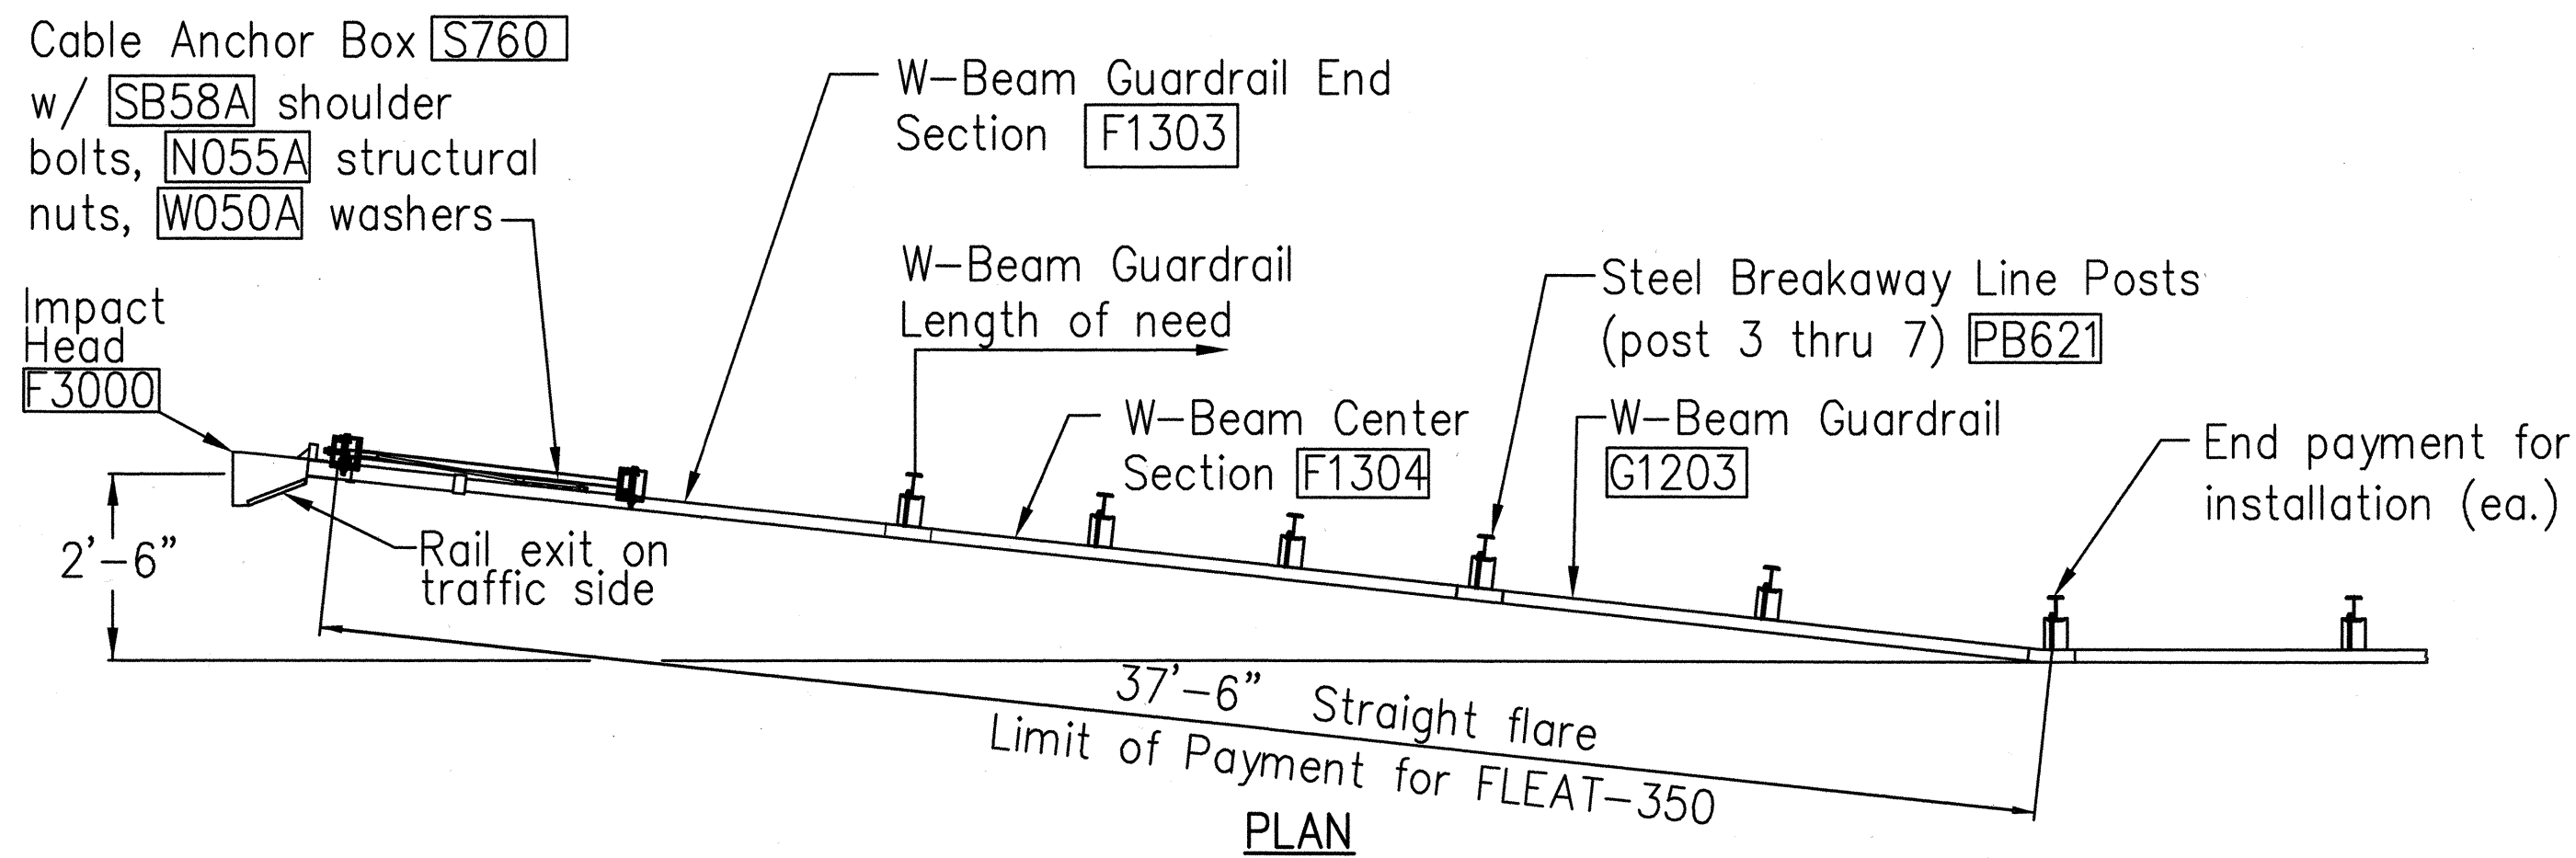

NOTE: RAIL NOT BOLTED @ POST #3

GENERAL NOTES

1. Breakaway posts are required with the FLEAT Terminal.
2. All bolts, nuts, cable assemblies, cable anchors and bearing plates shall be galvanized.
3. The soil tubes shall not protrude more than 4" above ground (measured along a 5' cord). Site grading may be necessary to meet this requirement.
4. The soil tubes may be driven with an approved driving head. Soil tubes shall not be driven with the post in the tube. If the tubes are placed in drilled holes, the backfill material must be satisfactorily compacted to prevent settlement.
5. When rock is encountered during excavation, a 12" Dia. post hole, 20" deep may be used if approved by the engineer. Granular material will be placed in the bottom of the hole approx. 2-1/2" deep to provide drainage. The soil tubes will be field cut to length, placed in the hole and backfilled with adequately compacted material excavated from the hole.
6. The breakaway cable assembly must be taut. A locking device, (vice grips or channel lock pliers) should be used to prevent the cable from twisting when tightening nuts.
7. (R) or (L) indicates right or left Impact Head Reflector Marker (IHRM). Providing and installing of IHRM shall be considered incidental to end treatment.
8. The stripes for IHRM shall slope downward at an angle of 45° towards the side of the end treatment that traffic is to pass.


FED. ROAD DIST. NO.	STATE	FED. AID PROJ. NO.	FISCAL YEAR	SHEET NO.	TOTAL SHEETS
HAWAII	HAW.	IM-NH-H1-1(239)	2001	ADD43	103

ITEM NO.	QTY	BILL OF MATERIALS
F3000	1	IMPACT HEAD
F1303	1	W-BEAM GUARDRAIL END SECTION, 12 GA.
F1304	1	W-BEAM GUARDRAIL CENTER SECTION, 12 GA.
G1203	1	W-BEAM GUARDRAIL, 12 GA.
S730	2	*FOUNDATION SOIL TUBE, 6" x 8" x 72"
E750	1	BEARING PLATE
S760	1	CABLE ANCHOR BOX
E770	1	BCT CABLE ANCHOR ASSEMBLY
E780	1	GROUND STRUT
PB620	2	STEEL BREAKAWAY END POST
PB621	5	STEEL BREAKAWAY LINE POST
	5	RECYCLED PLASTIC BLOCKOUT OR OFFSET BLOCK
	1	IMPACT HEAD REFLECTOR MARKER-IHRM(R) OR (L)
HARDWARE		
B580122	25	5/8" Dia. x 1 1/4" SPLICE BOLT, POST #2
B580754	2	5/8" Dia. x 7 1/2" HEX BOLT
B341004	2	3/4" Dia. x 10" HEX BOLT
B581002	5	5/8" Dia. x 10" H.G.R. BOLT (POST 3 THRU 7)
N050	32	5/8" Dia. H.G.R. NUT (SPLICE 24, SOIL TUBES 2, POST 2 THRU 7, 6)
N030	2	3/4" Dia. HEX NUT
W050	6	H.G.R. WASHER
W030	4	3/4" ID WASHER
N100	2	1" ANCHOR CABLE HEX NUT
W100	2	1" ANCHOR CABLE WASHER
B140404	2	1/4" x 4" HEX BOLT
N014	2	1/4" HEX NUT
W014	4	1/4" WASHER
SB58A	8	CABLE ANCHOR BOX SHOULDER BOLT
N055A	8	1/2" A325 STRUCTURAL NUT
W050A	16	1 1/16" OD x 9/16" ID A325 STR. WASHER

Foundation Tube Options For Posts 1 & 2

*6'-0" Split Foundation Tubes S730
*6'-0" Solid Foundation Tubes E731
*5'-0" Foundation Tubes S735 W/Soil Plates SP600
*4'-6" Foundation Tubes E735 W/Soil Plates SP600


DATE
SURVEY PLOTTED BY
DRAWN BY
CHECKED BY
QUANTITIES BY
ORIGINAL PLAN
NO.

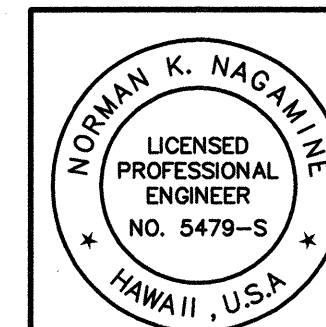


THIS WORK WAS PREPARED BY ME OR UNDER MY SUPERVISION

6/20/01	UPDATED NOTES AND DETAILS AND ADDED REFLECTOR MARKER PER ADDENDUM NO. 1
DATE	REVISION
STATE OF HAWAII DEPARTMENT OF TRANSPORTATION HIGHWAYS DIVISION FLEAT-350 FLARED ENERGY ABSORBING TERMINAL INTERSTATE ROUTE H-1 Palailai Interchange Reconstruction F.A.I. Project No. IM-NH-H1-1(239) Scale: As Shown Date: 4/1/01 SHEET NO. S-8 OF 12 SHEETS	


FED. ROAD DIST. NO.	STATE	FED. AID PROJ. NO.	FISCAL YEAR	SHEET NO.	TOTAL SHEETS
HAWAII	HAW.	IM-NH-H1-1(239)	2001	44	103

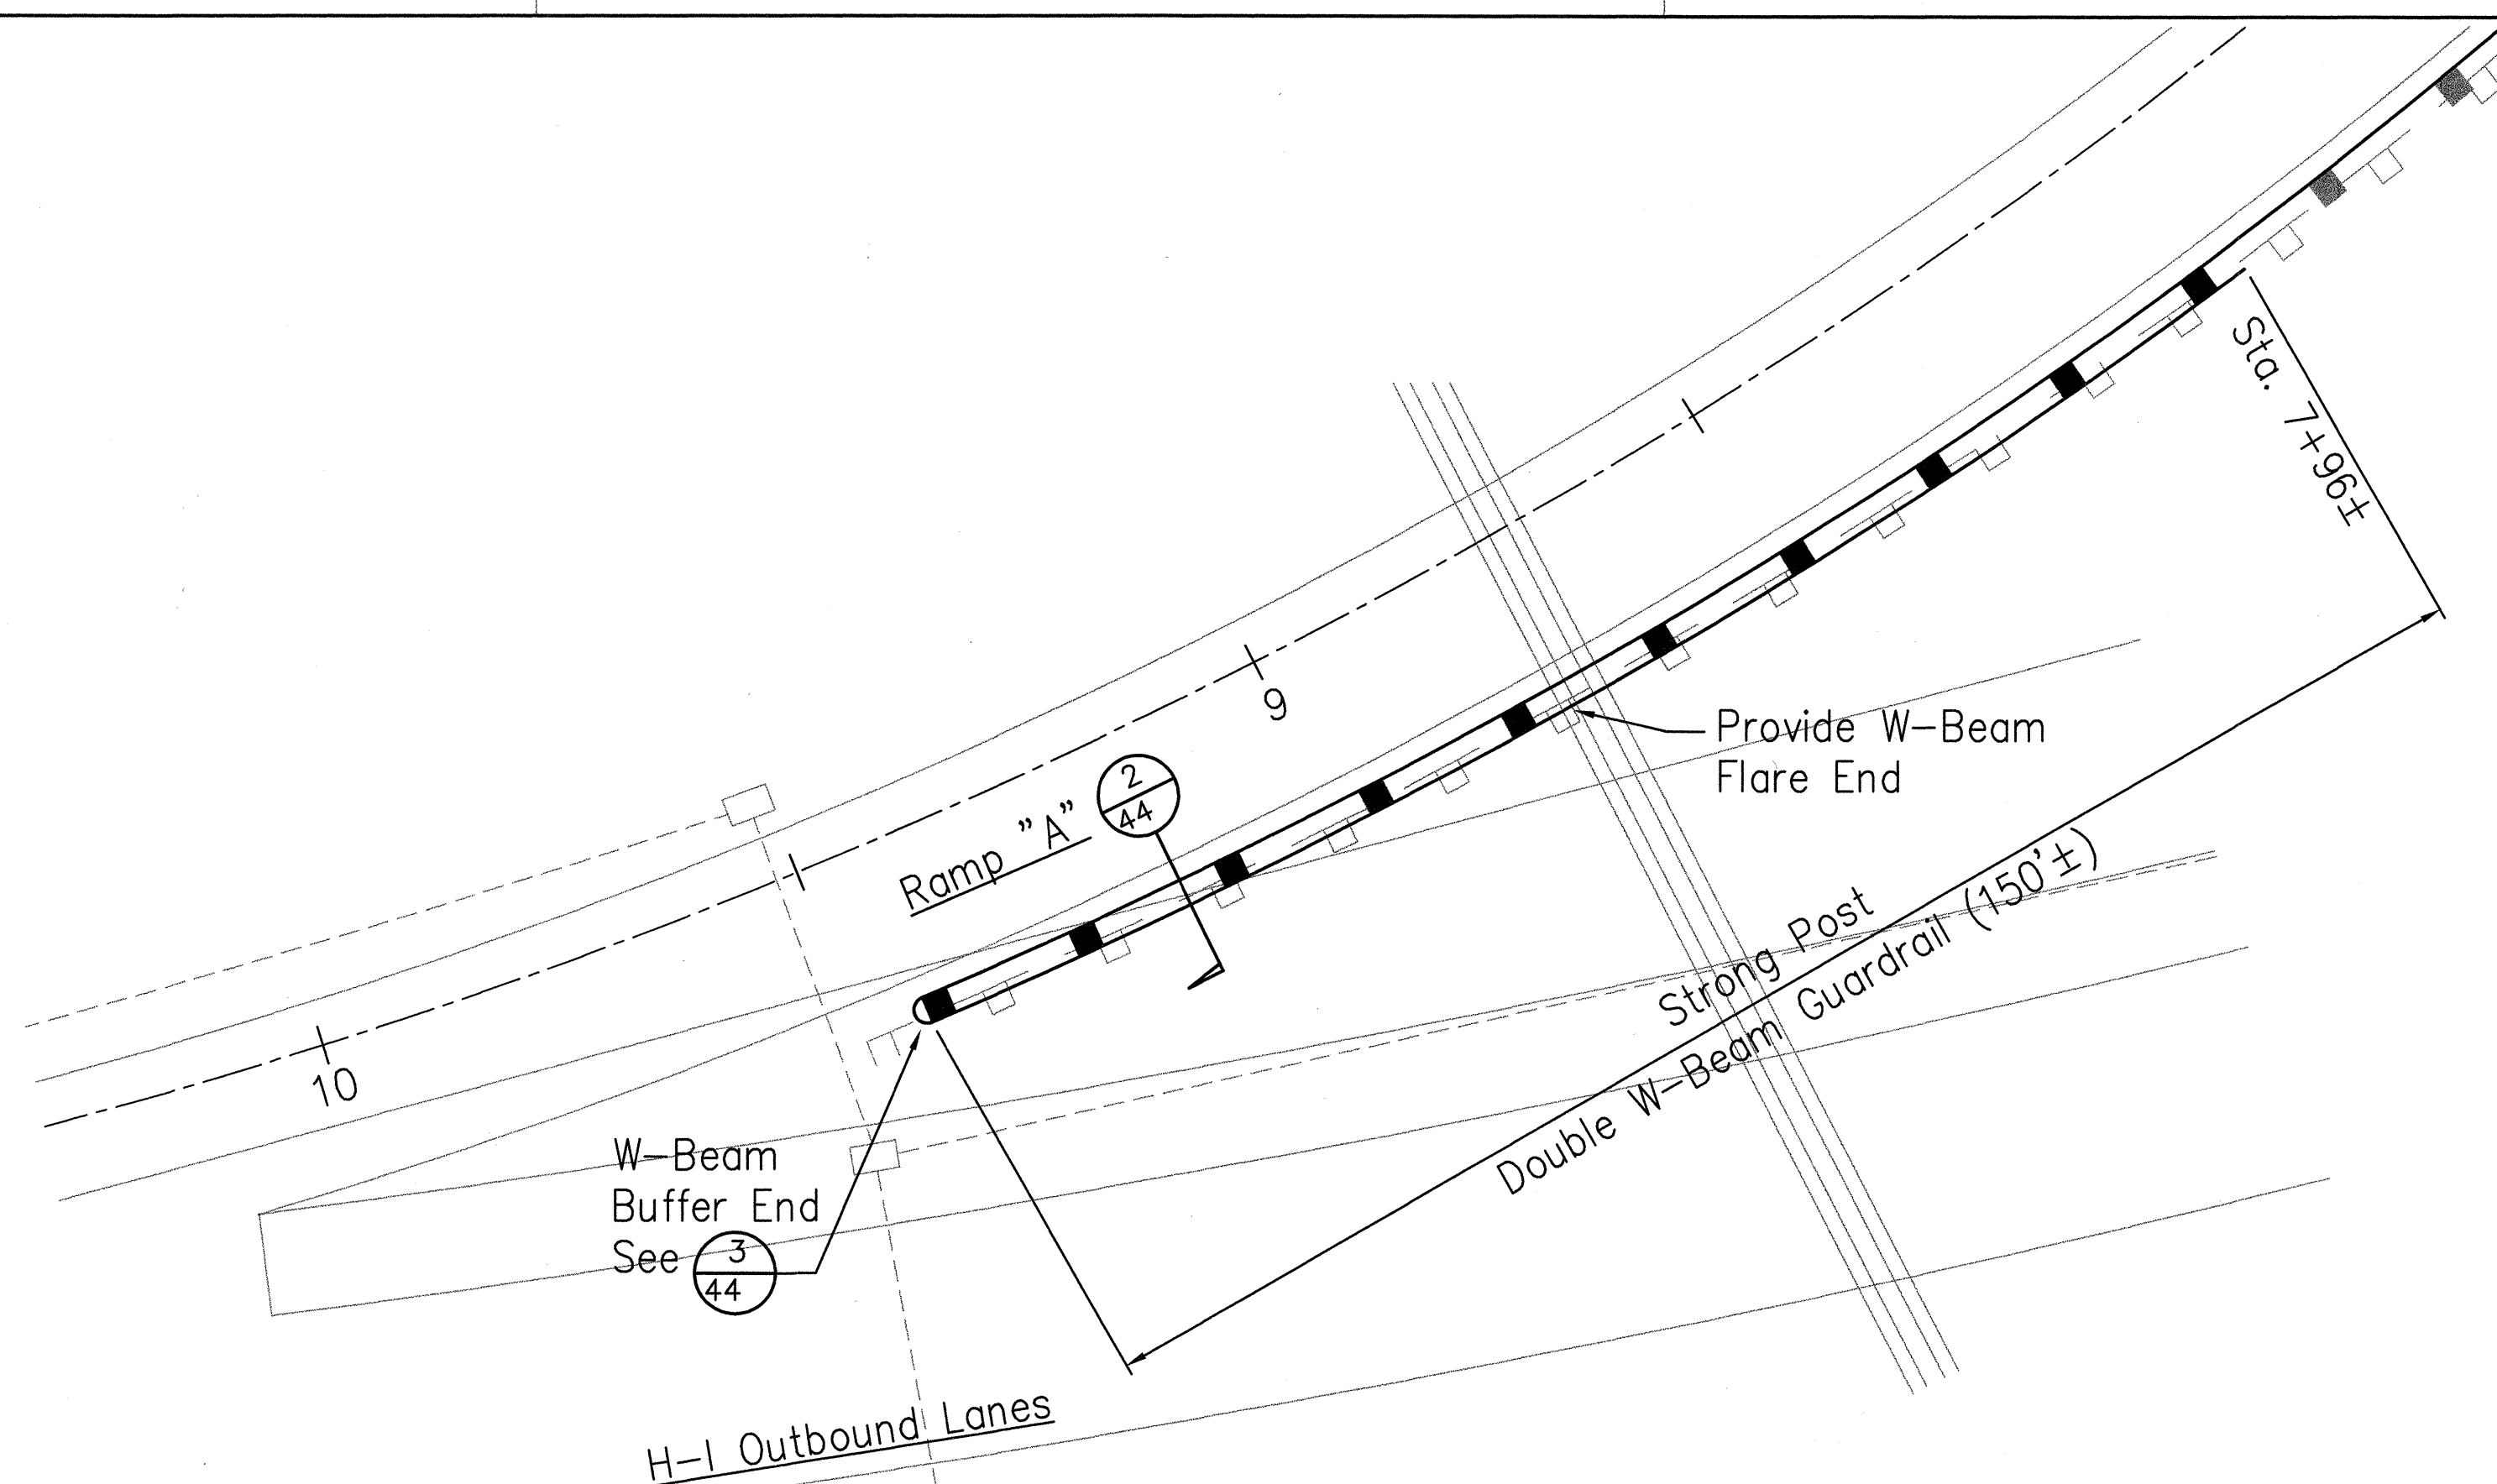


END TREATMENT
 1 (RAMP "A" - H-I OUTBOUND JUNCTION)
 SCALE: 1/16"=1'-0"

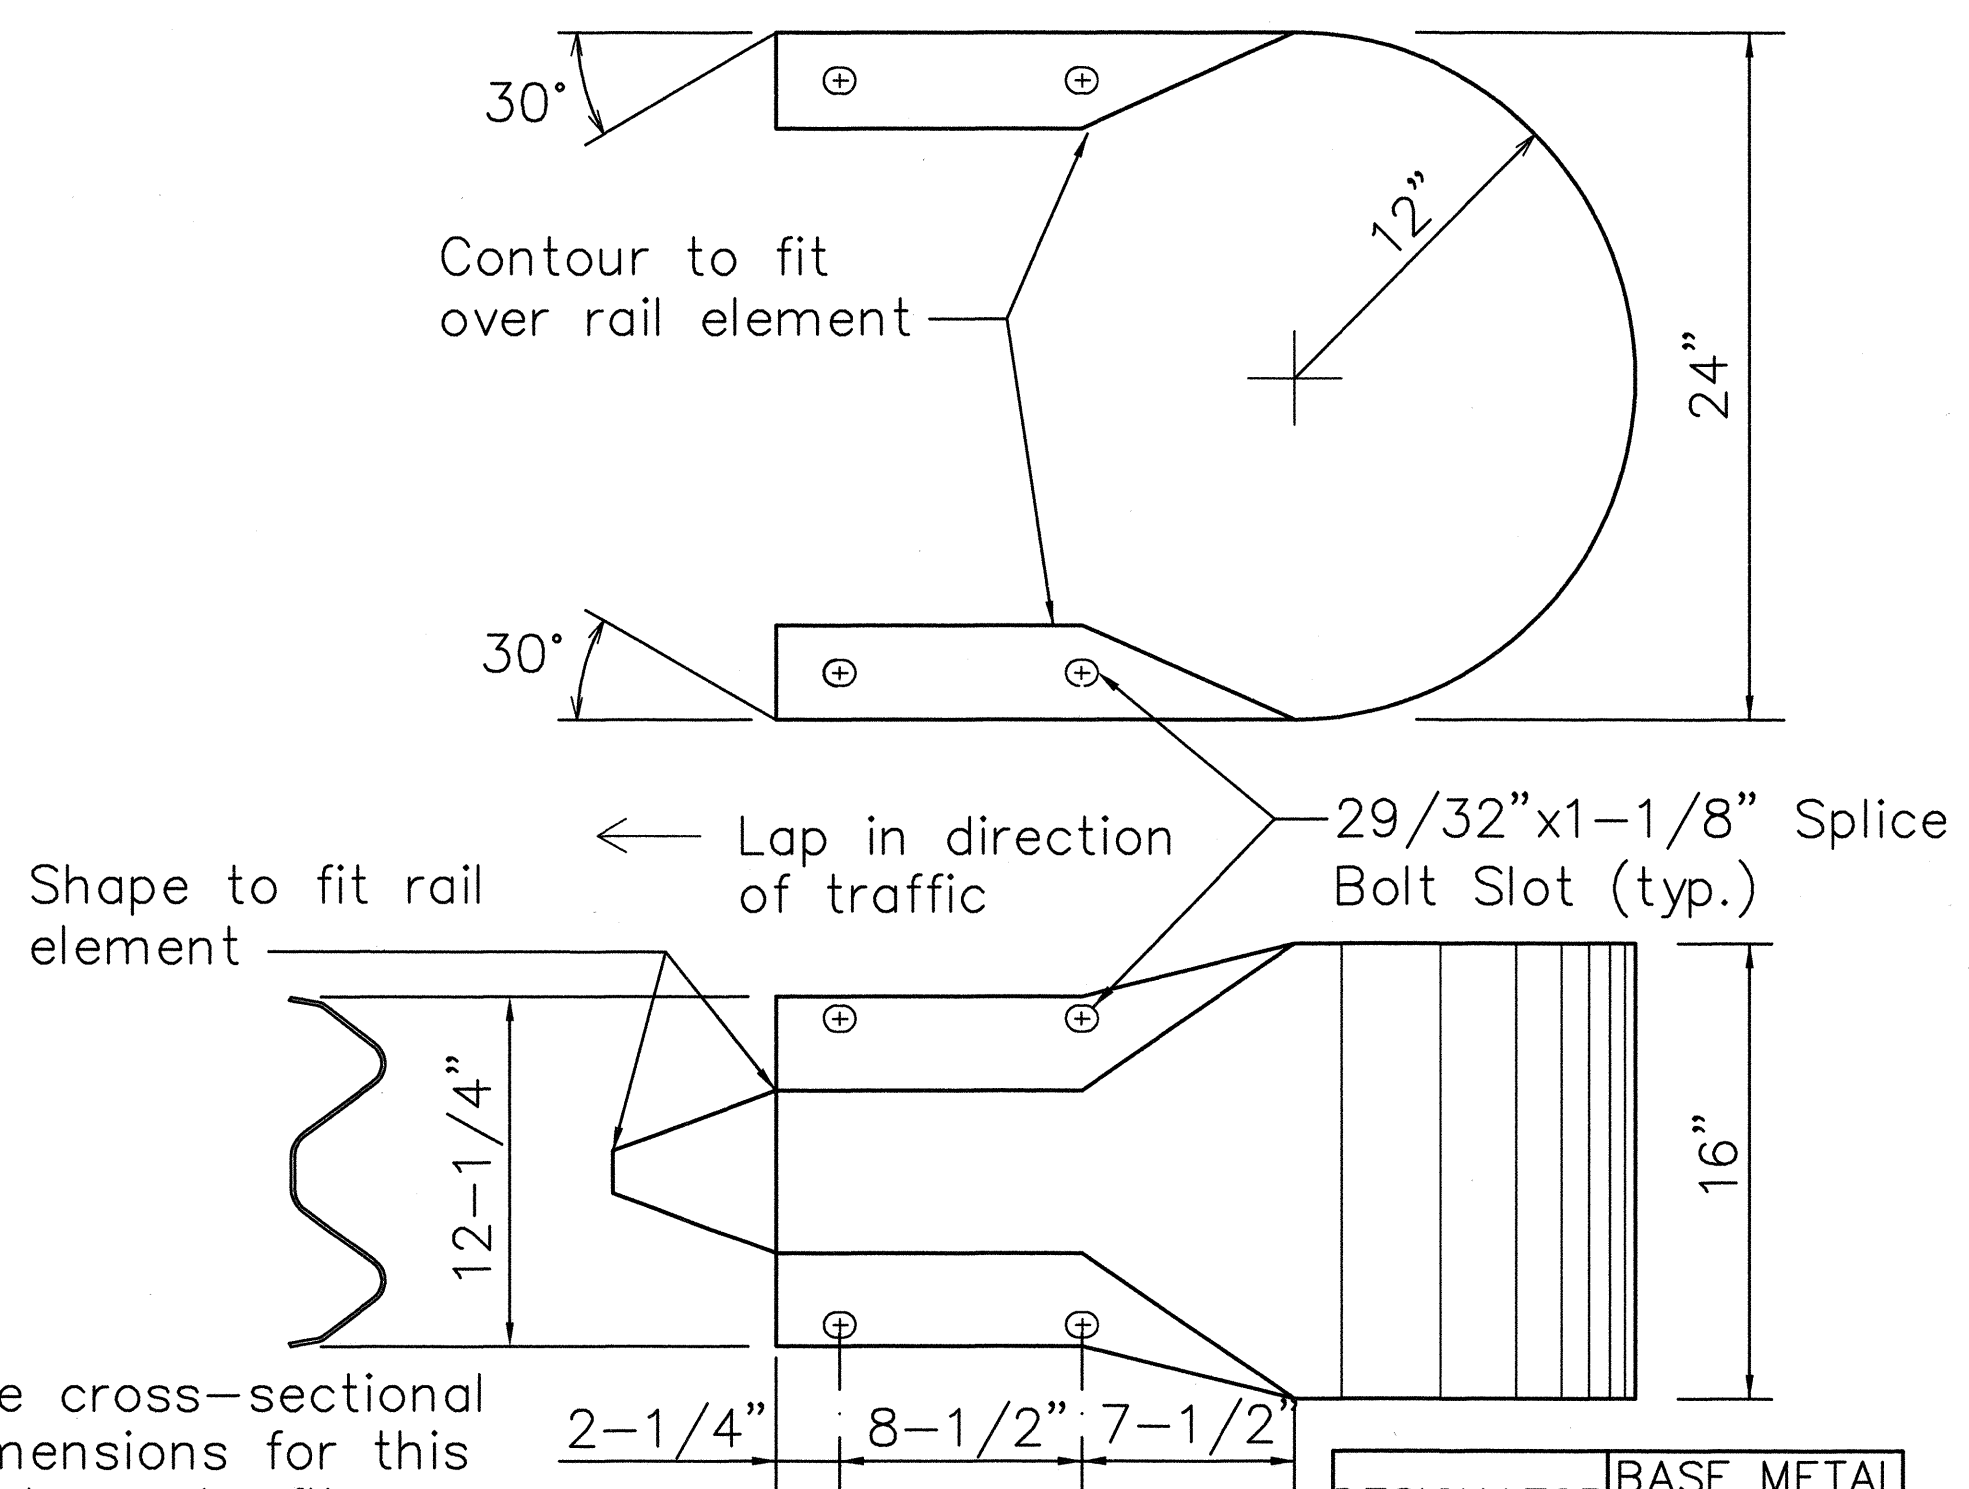


3 W-BEAM END SECTION (BUFFER RWE06a)
 44

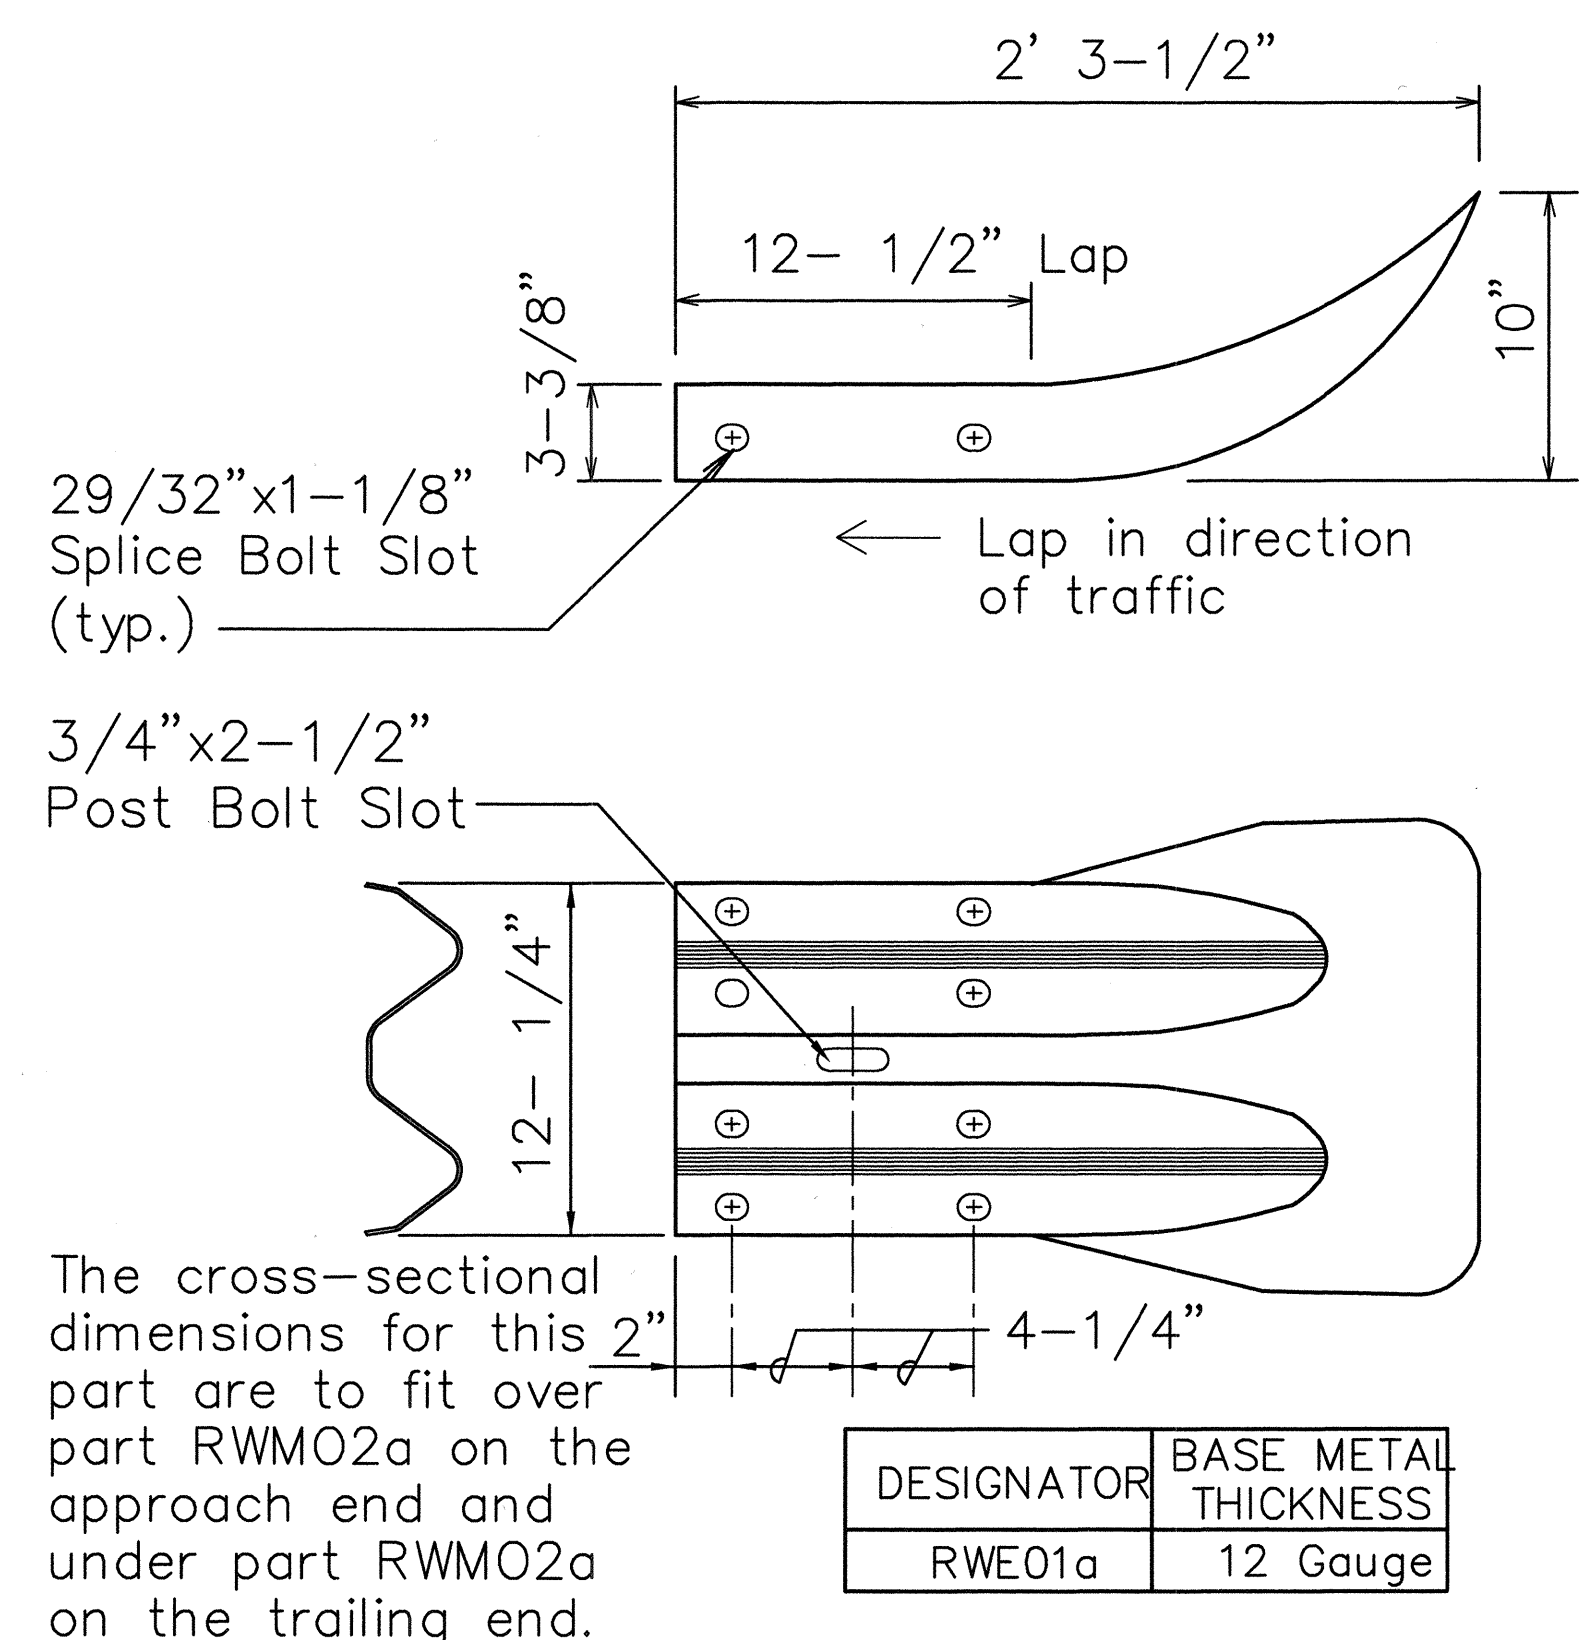


4 W-BEAM END SECTION (FLARED RWE01a)
 44

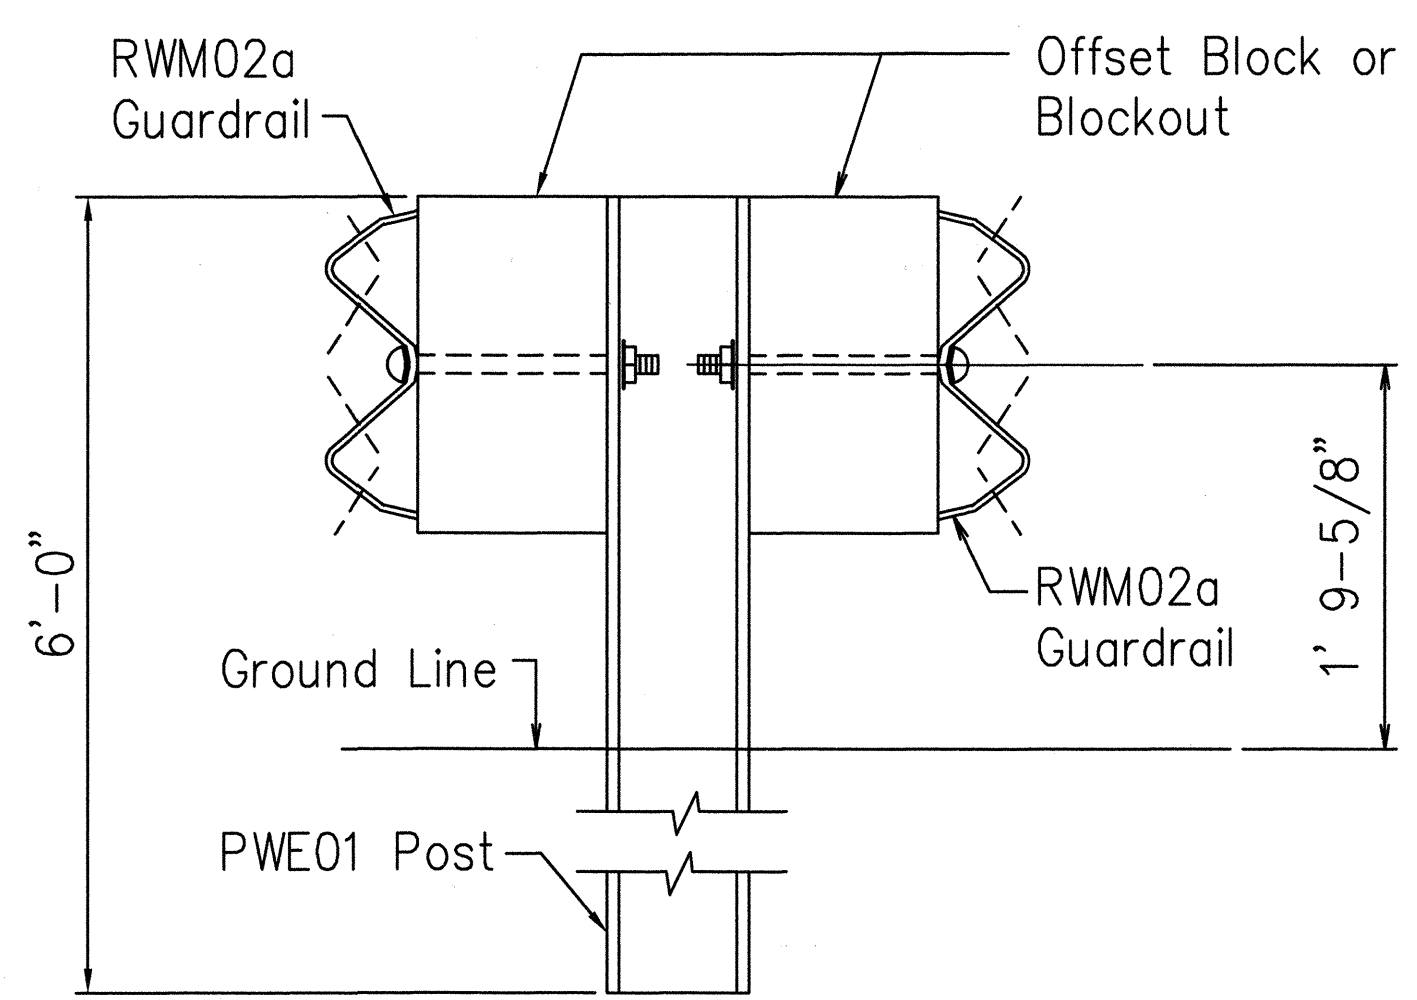

2 STRONG POST DOUBLE
 W-BEAM GUARDRAIL
 SCALE: 1-1/2"=1'-0"

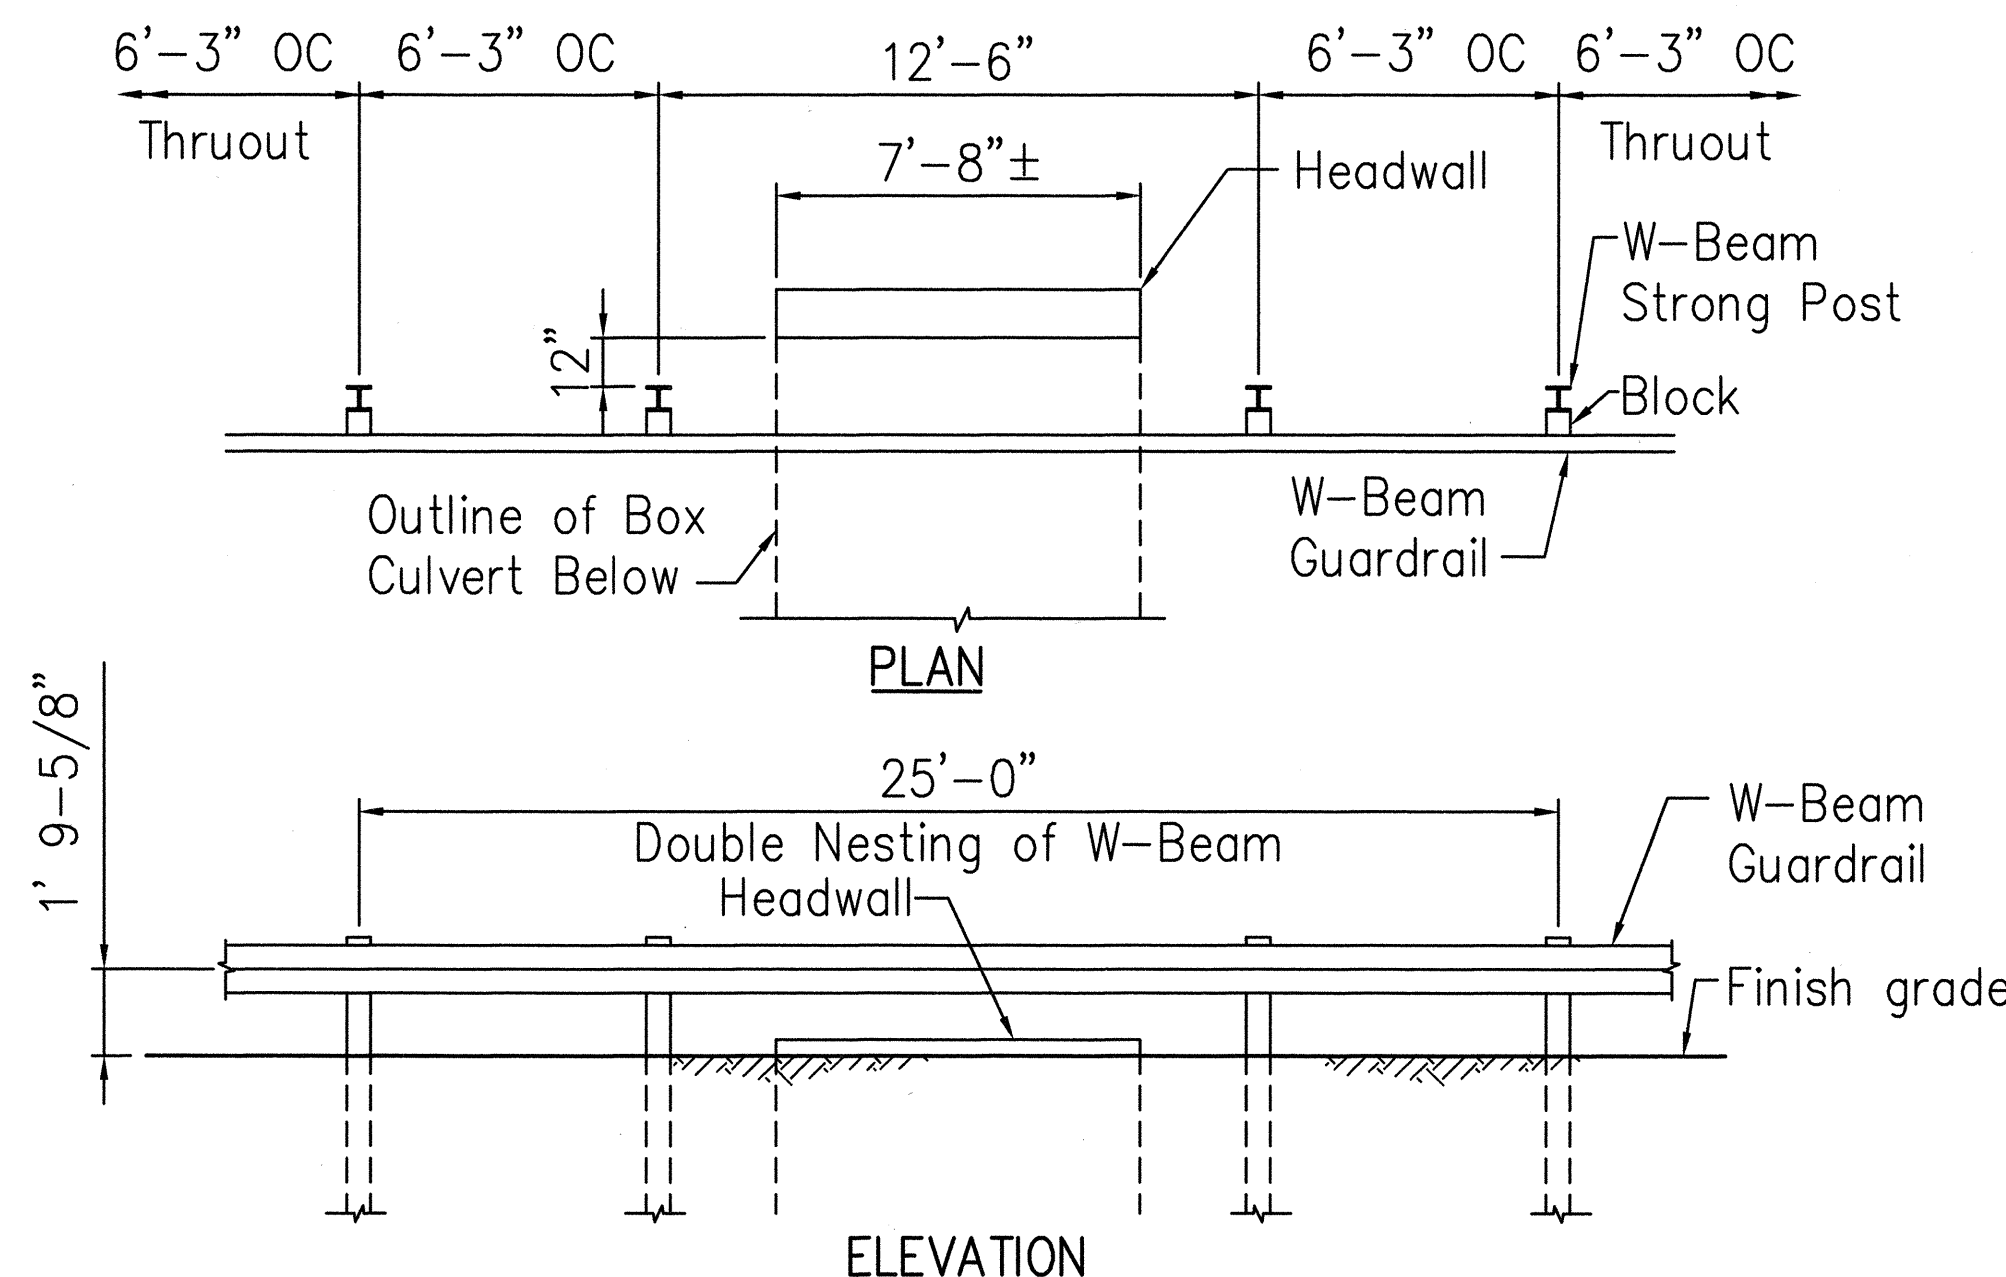

5 GUARDRAIL AT BOX CULVERT
 (RAMP IF STA. 6+52L)
 44

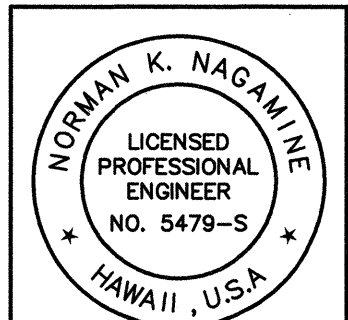


STATE OF HAWAII
 DEPARTMENT OF TRANSPORTATION
 HIGHWAYS DIVISION
SPECIAL GUARDRAIL DETAILS


 INTERSTATE ROUTE H-1
 Palailai Interchange Reconstruction
 F.A.I. Project No. IM-NH-H1-1(239)
 Scale: As Shown Date: 4/1/01
 SHEET NO. S-9 OF 12 SHEETS

SURVEY PLOTTED BY	DATE
DRAWN BY	
DESIGNED BY	
QUANTITIES BY	
CHECKED BY	
ORIGINAL PLAN	
NO.	


FED. ROAD DIST. NO.	STATE	FED. AID PROJ. NO.	FISCAL YEAR	SHEET NO.	TOTAL SHEETS
HAWAII	HAW.	IM-NH-H1-1(239)	2001	45	103

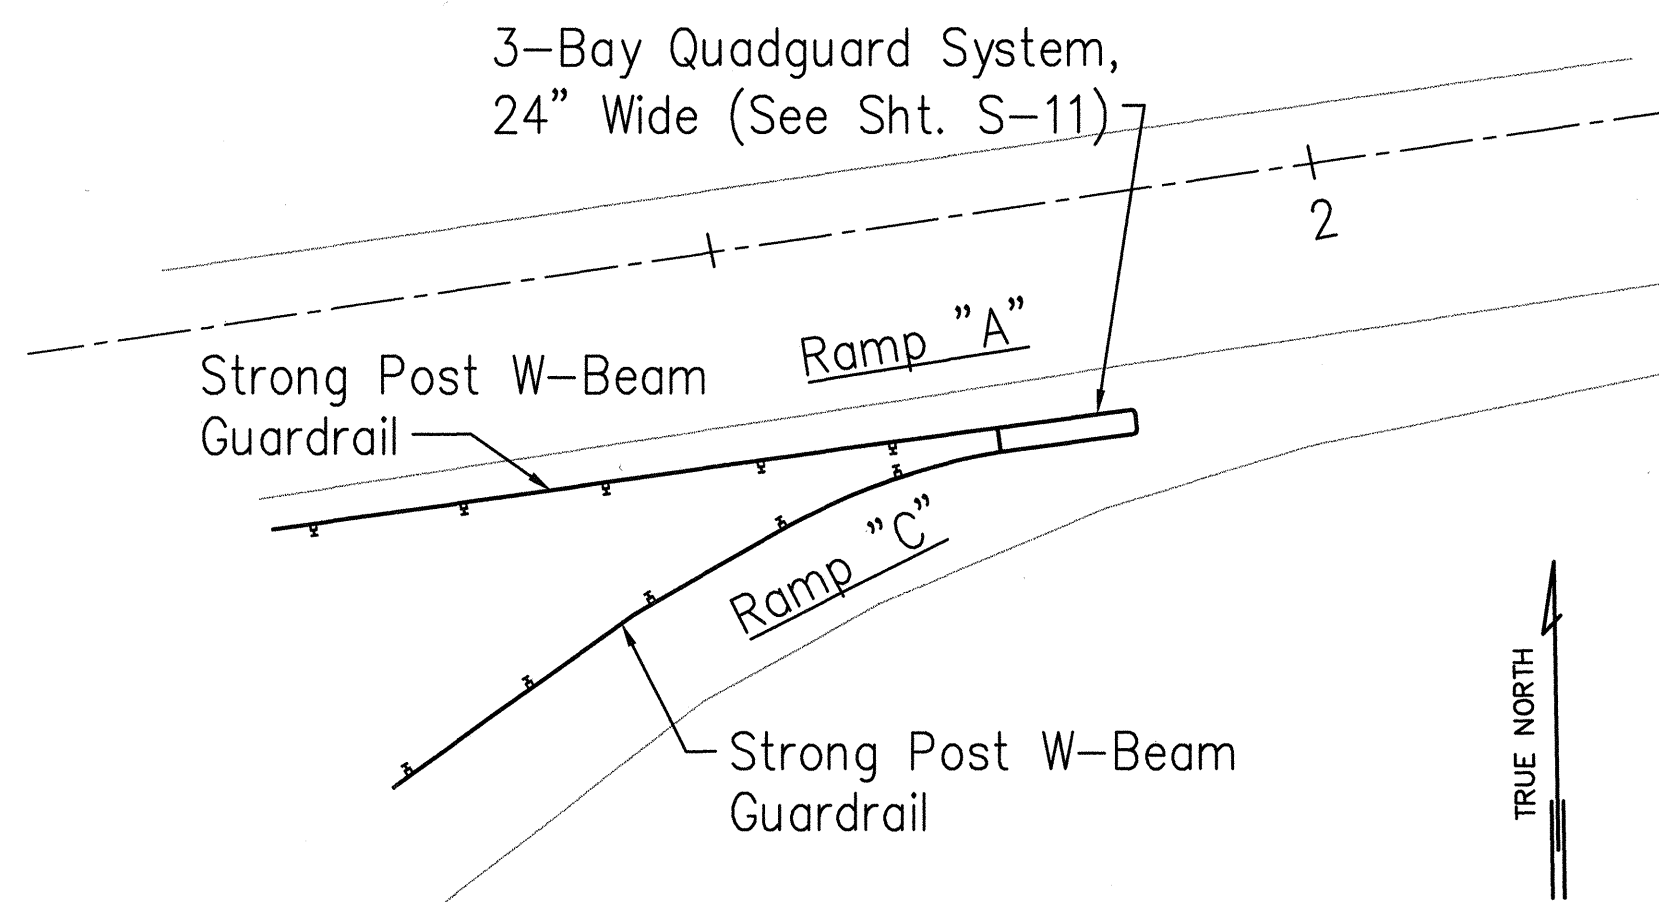

1
45 QUADGUARD LOCATION
RAMP "A" AND "C" JUNCTION
SCALE: 1/16"=1'-0"

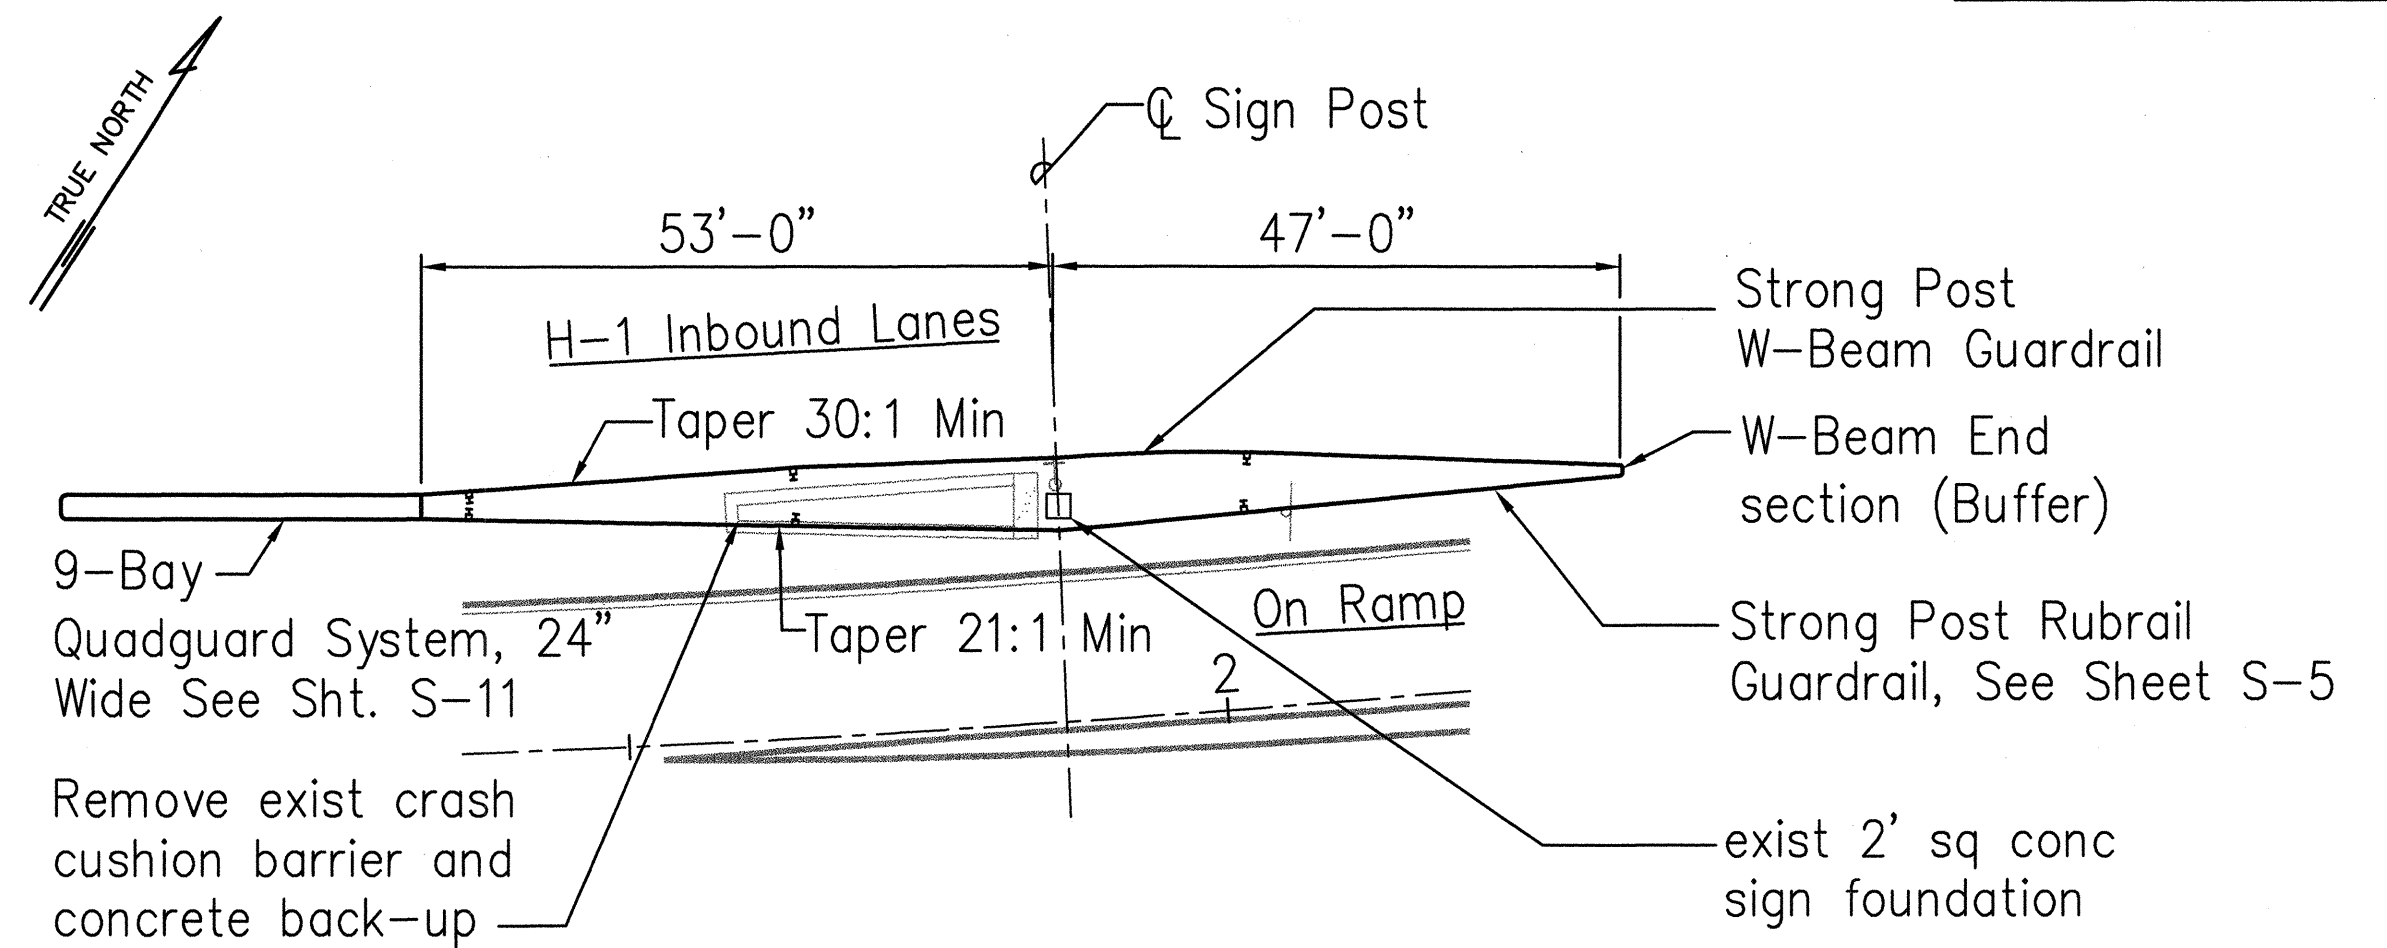

2
45 GUARDRAIL PLAN AT H-1 INBOUND
(SIGN POST FOUNDATION OBSTRUCTION)
SCALE: 1/16"=1'-0"

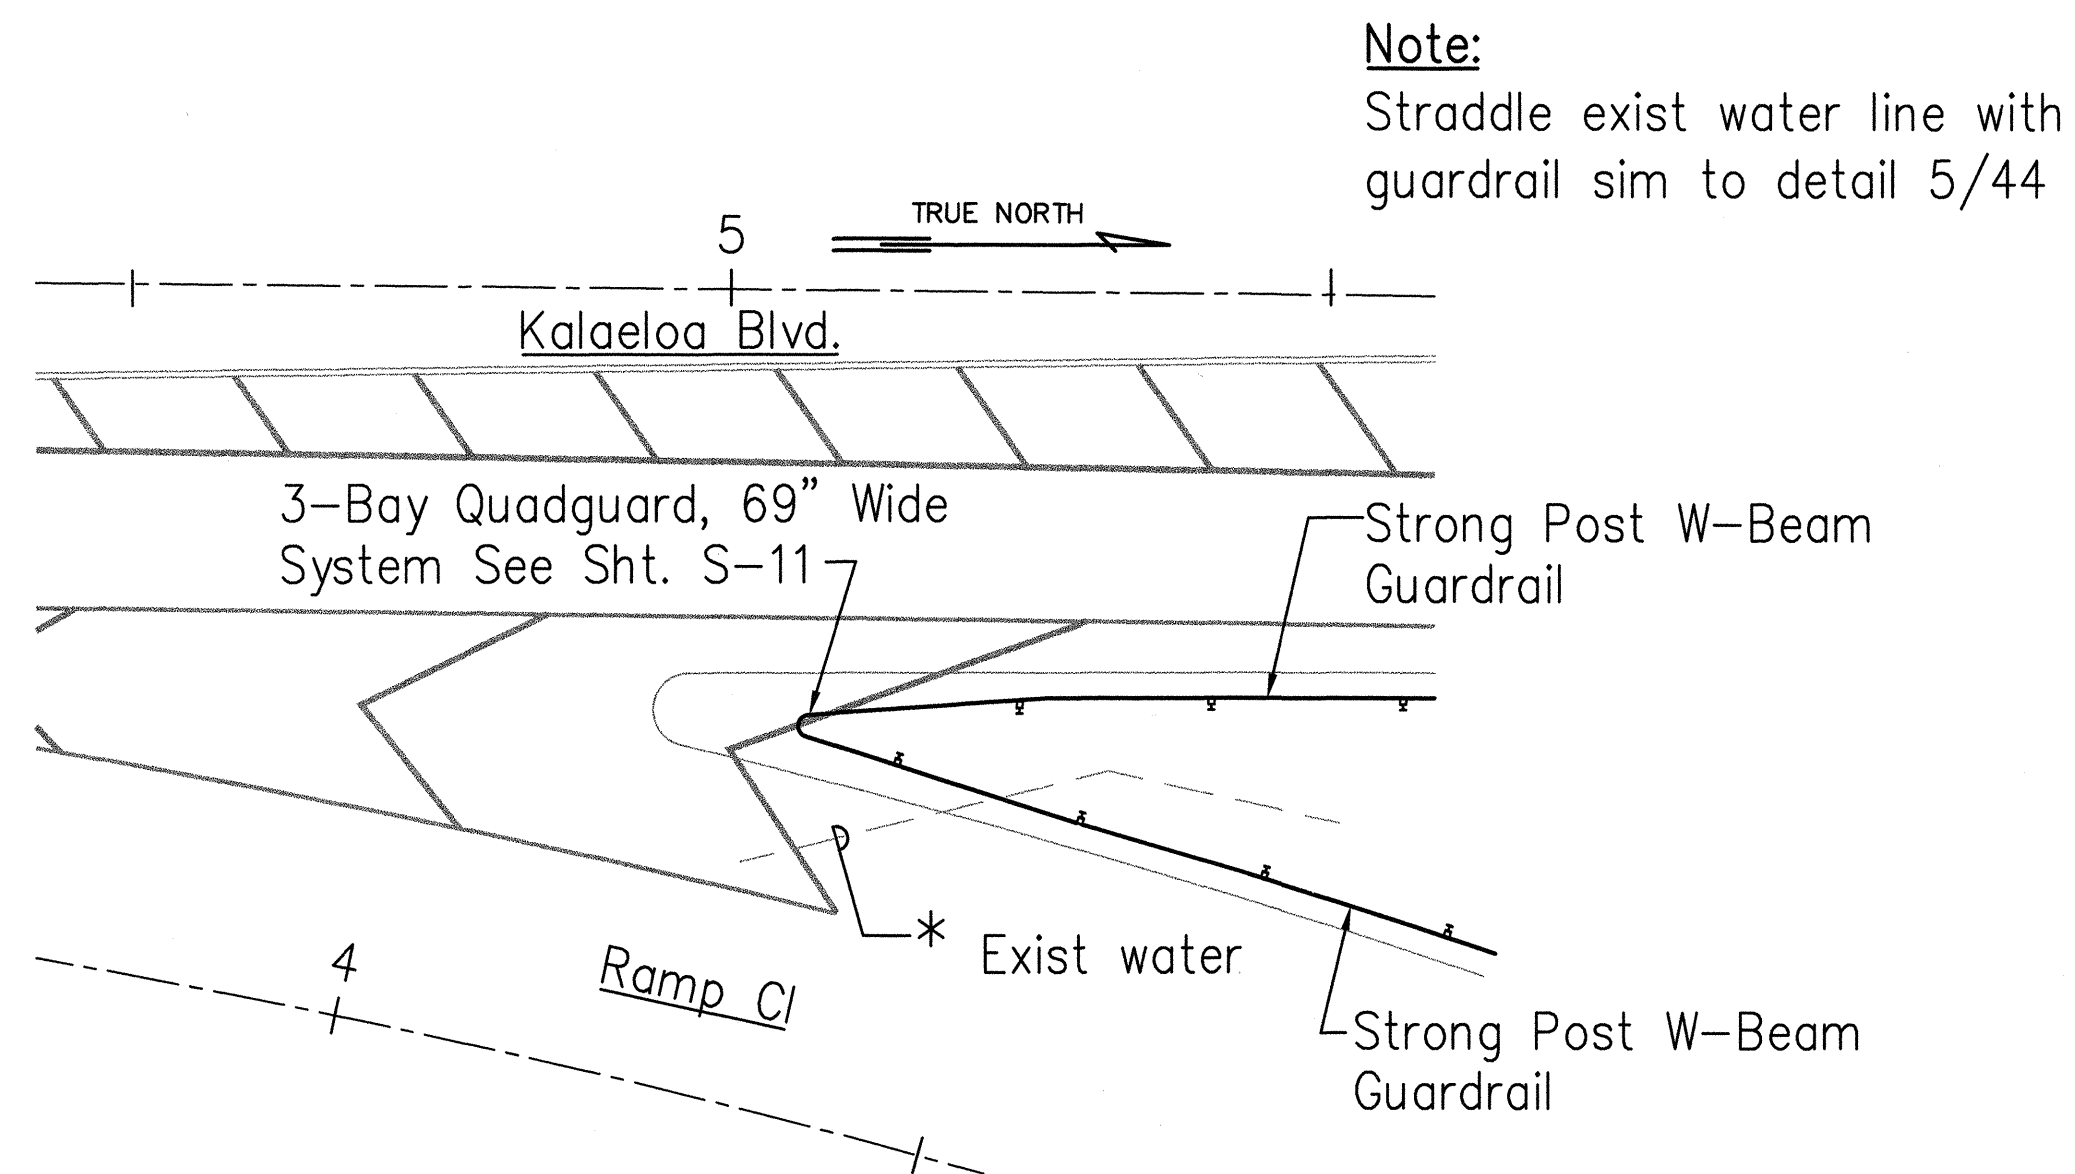

3
45 QUADGUARD PLAN
JUNCTION OF KALAELOA BLVD. RAMP CI)
SCALE: 1/16"=1'-0"

SURVEY PLOTTED BY	DATE
DRAWN BY
TRACED BY
DESIGNED BY
QUANTITIES BY
CHECKED BY
ORIGINAL PLAN
NOTEBOOK
No.

STATE OF HAWAII
DEPARTMENT OF TRANSPORTATION
HIGHWAYS DIVISION

SPECIAL GUARDRAIL DETAILS


INTERSTATE ROUTE H-1
Palailai Interchange Reconstruction
F.A.I. Project No. IM-NH-H1-1(239)

Scale: As Shown Date: 4/1/01


SHEET NO. S-10 OF 12 SHEETS

FED. ROAD DIST. NO.	STATE	FED. AID PROJ. NO.	FISCAL YEAR	SHEET NO.	TOTAL SHEETS
HAWAII	HAW.	IM-NH-H1-1(239)	2001	46	103

Note:
For 69" (5'-9") wide Quadguard, adjust concrete width accordingly per manufacturer's instructions

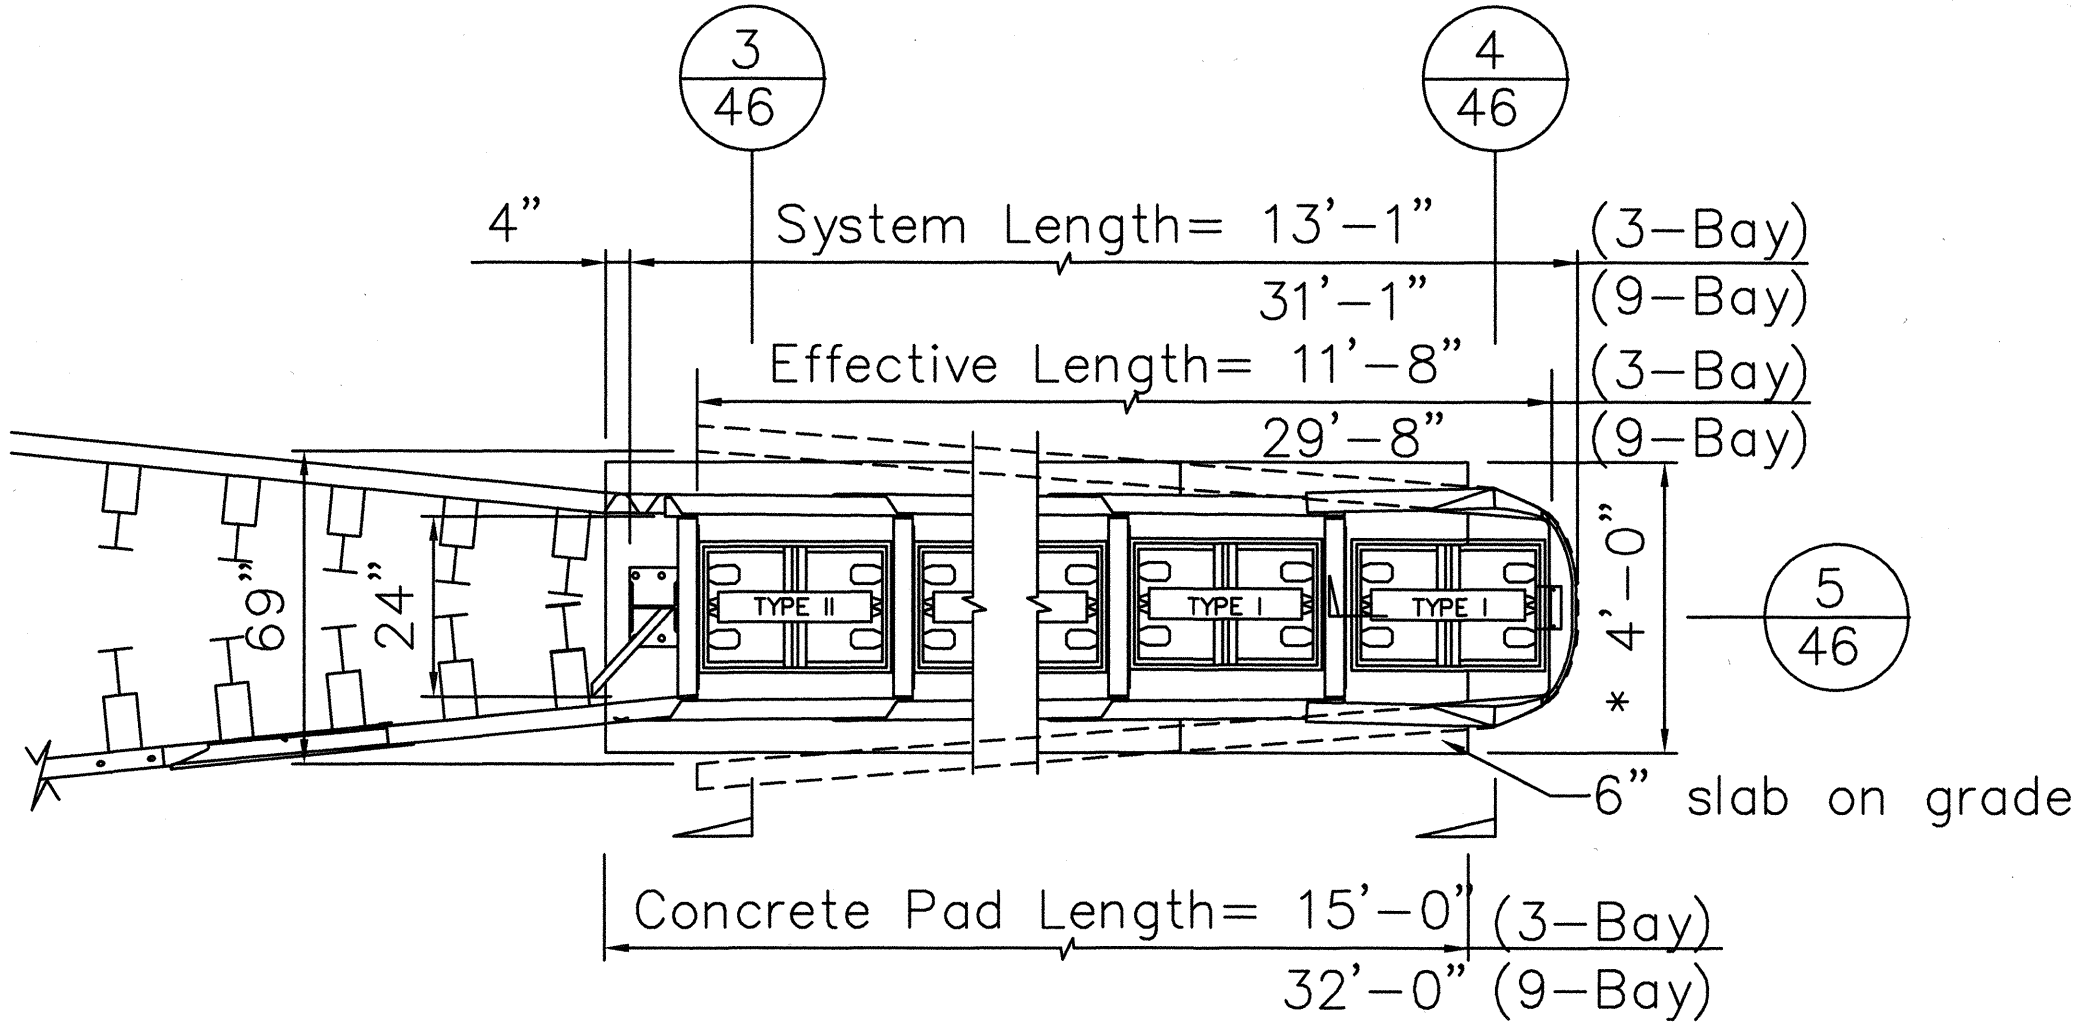


1 PLAN OF QUADGUARD SYSTEM
46 Scale: 3/8"=1'-0"

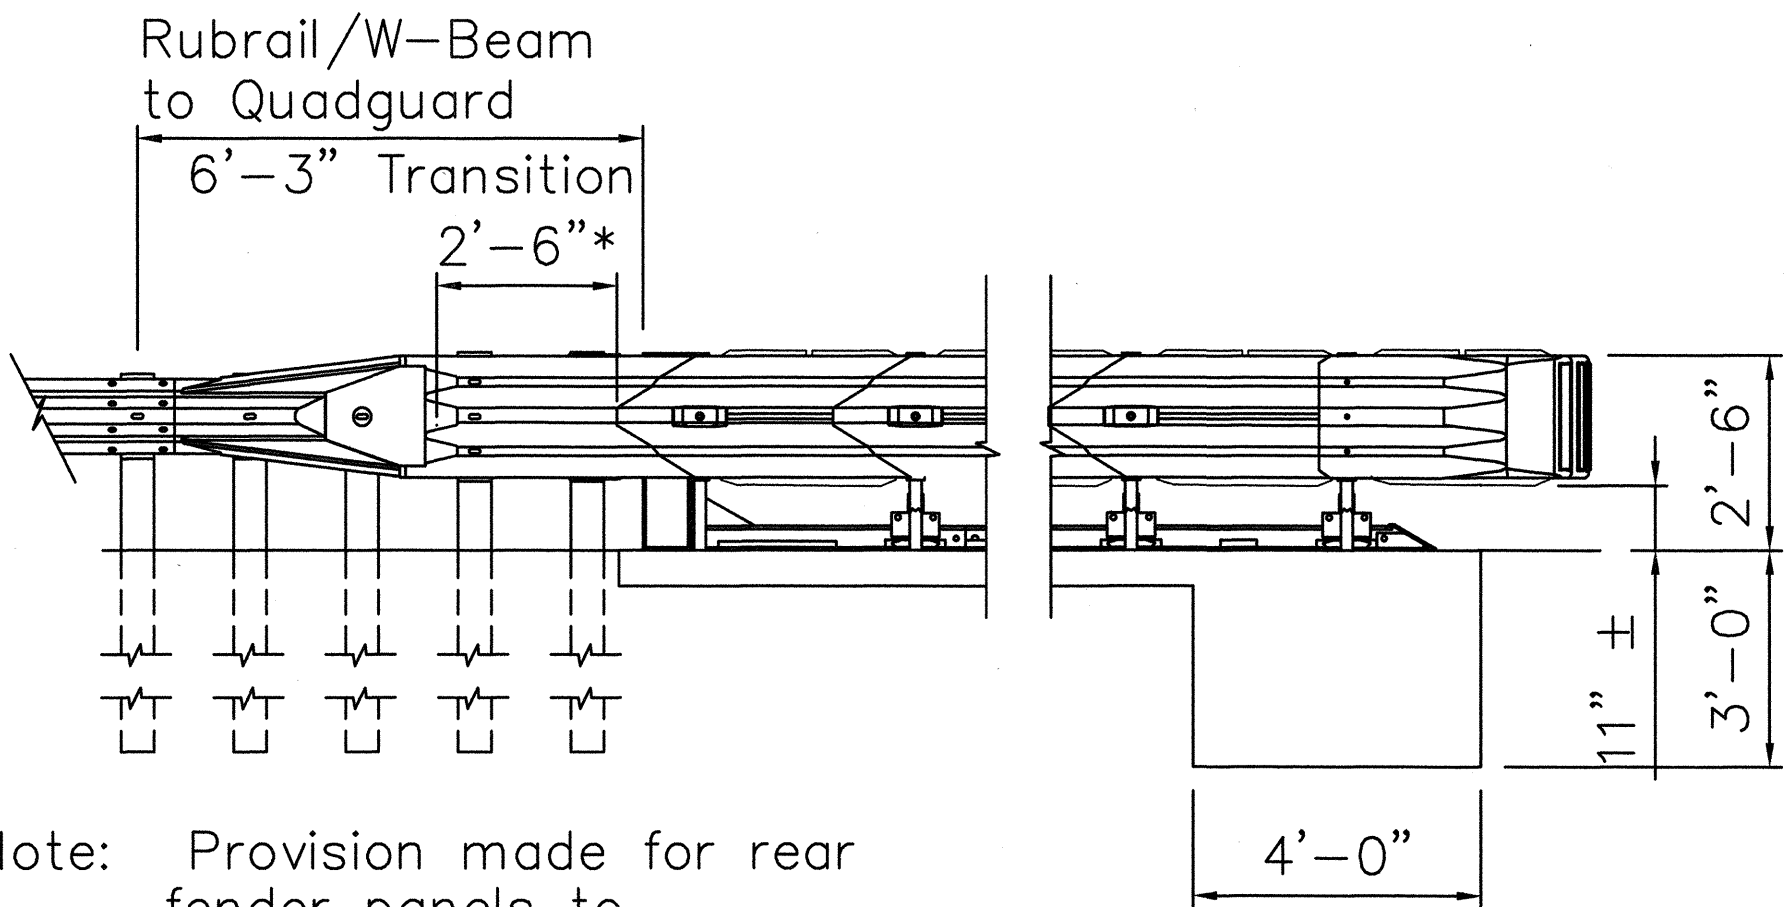


*Note: Provision made for rear fender panels to slide rearward


2 ELEVATION OF QUADGUARD SYSTEM
46 Scale: 3/8"=1'-0"

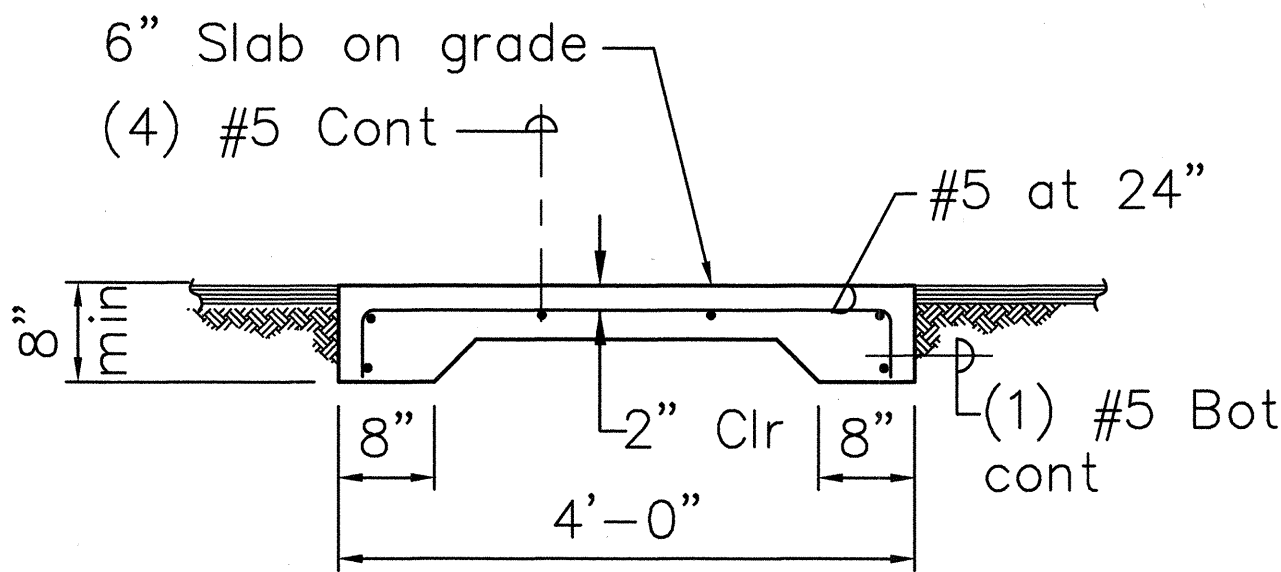

3 SECTION
46 Scale: 3/4"=1'-0"

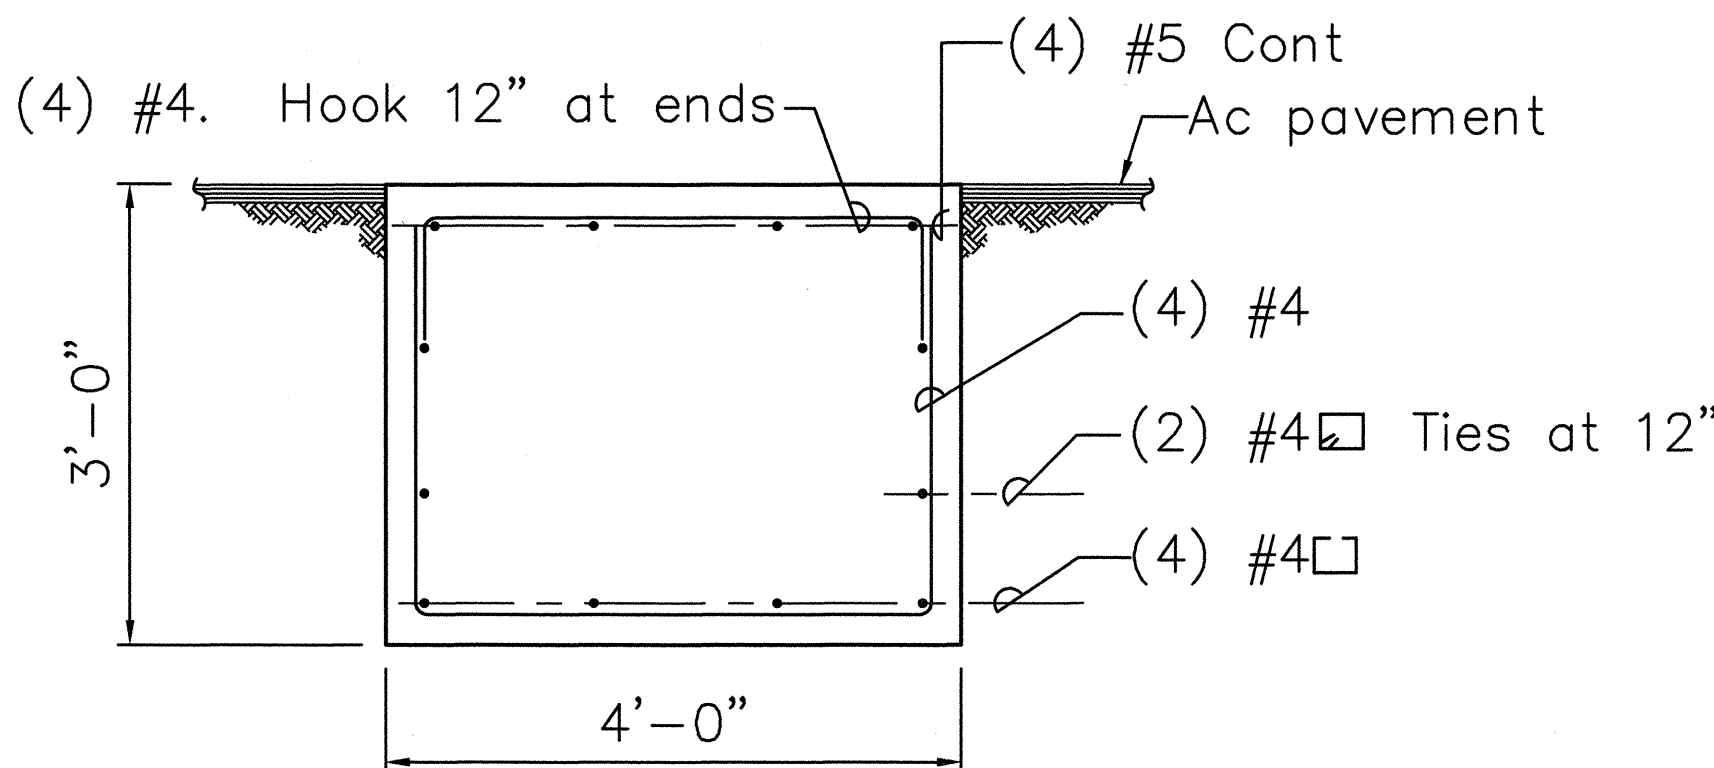

4 SECTION
46 Scale: 3/4"=1'-0"

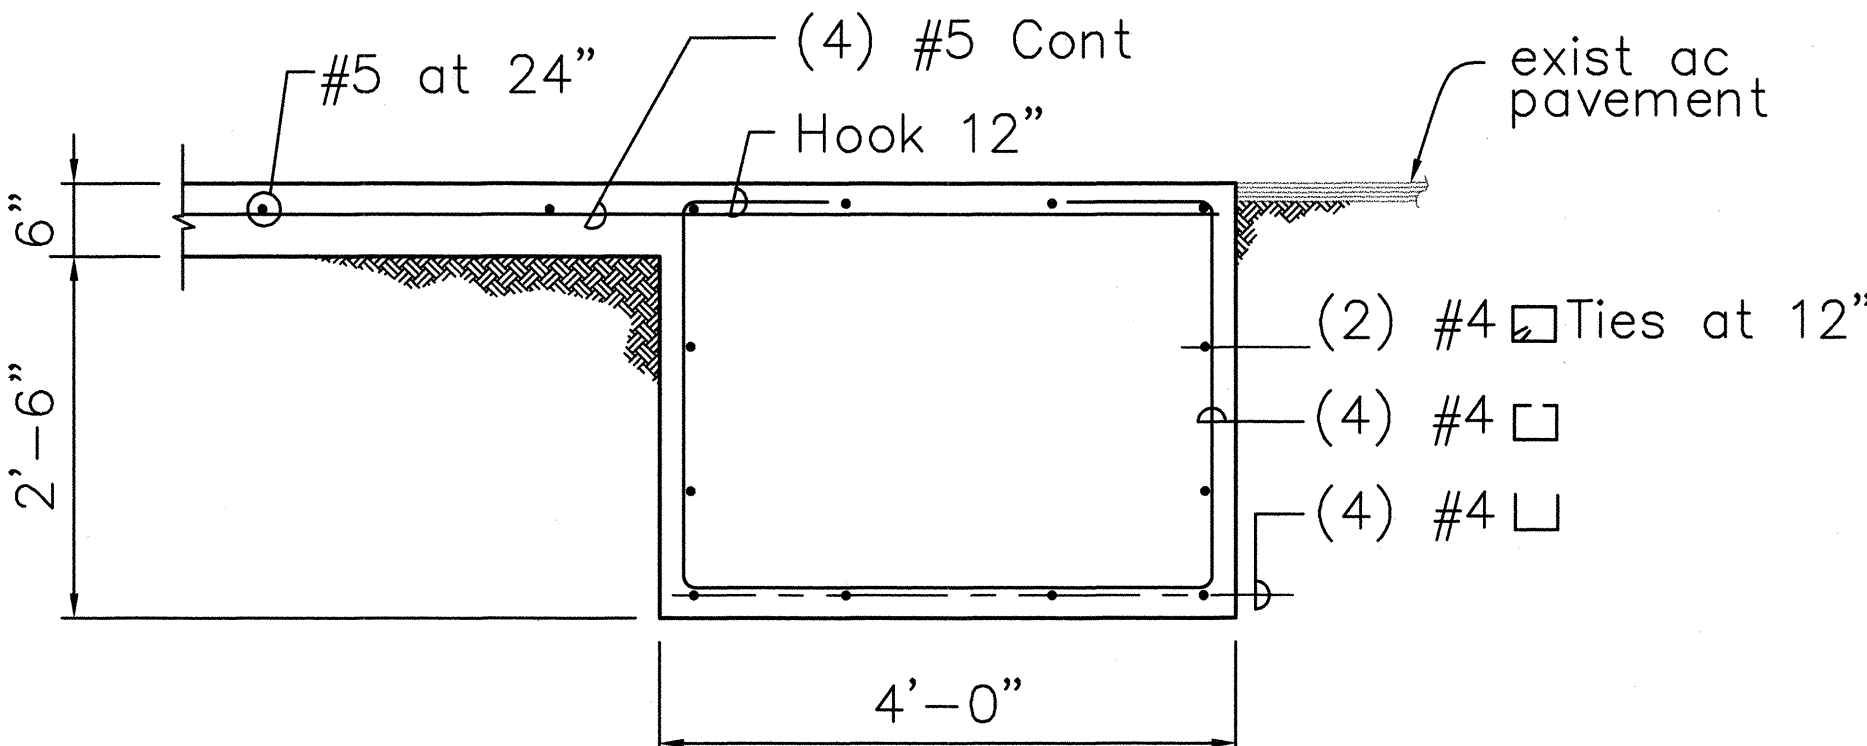


5 SECTION
46 Scale: 3/4"=1'-0"

Notes:

- Concrete strength at 28 days (4,000 PSI)
- Reinforcing steel shall be ASTM A615 Grade 60.
- Cross slope of concrete pad shall not exceed 8% and vary not more than 2% from front to back.
- Install in accordance with manufacturer's recommendations.

SURVEY PLOTTED BY	DATE
DRAWN BY	
DESIGNED BY	
QUANTITIES BY	
CHECKED BY	
ORIGINAL PLAN	
NO.	

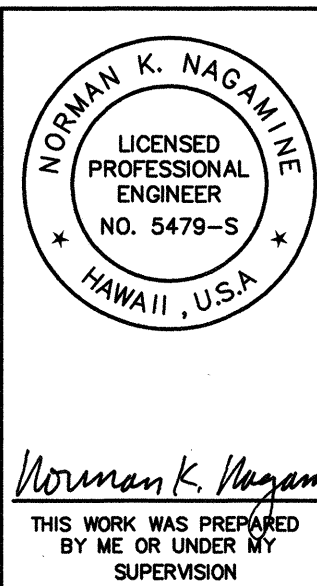


STATE OF HAWAII
DEPARTMENT OF TRANSPORTATION
HIGHWAYS DIVISION
QUADGUARD SYSTEM DETAILS

INTERSTATE ROUTE H-1
Palailai Interchange Reconstruction
F.A.I. Project No. IM-NH-H1-1(239)


Scale: As Shown Date: 4/1/01

SHEET NO. S-11 OF 12 SHEETS


FED. ROAD DIST. NO.	STATE	FED. AID PROJ. NO.	FISCAL YEAR	SHEET NO.	TOTAL SHEETS
HAWAII	HAW.	IM-NH-H1-1(239)	2001	47	103

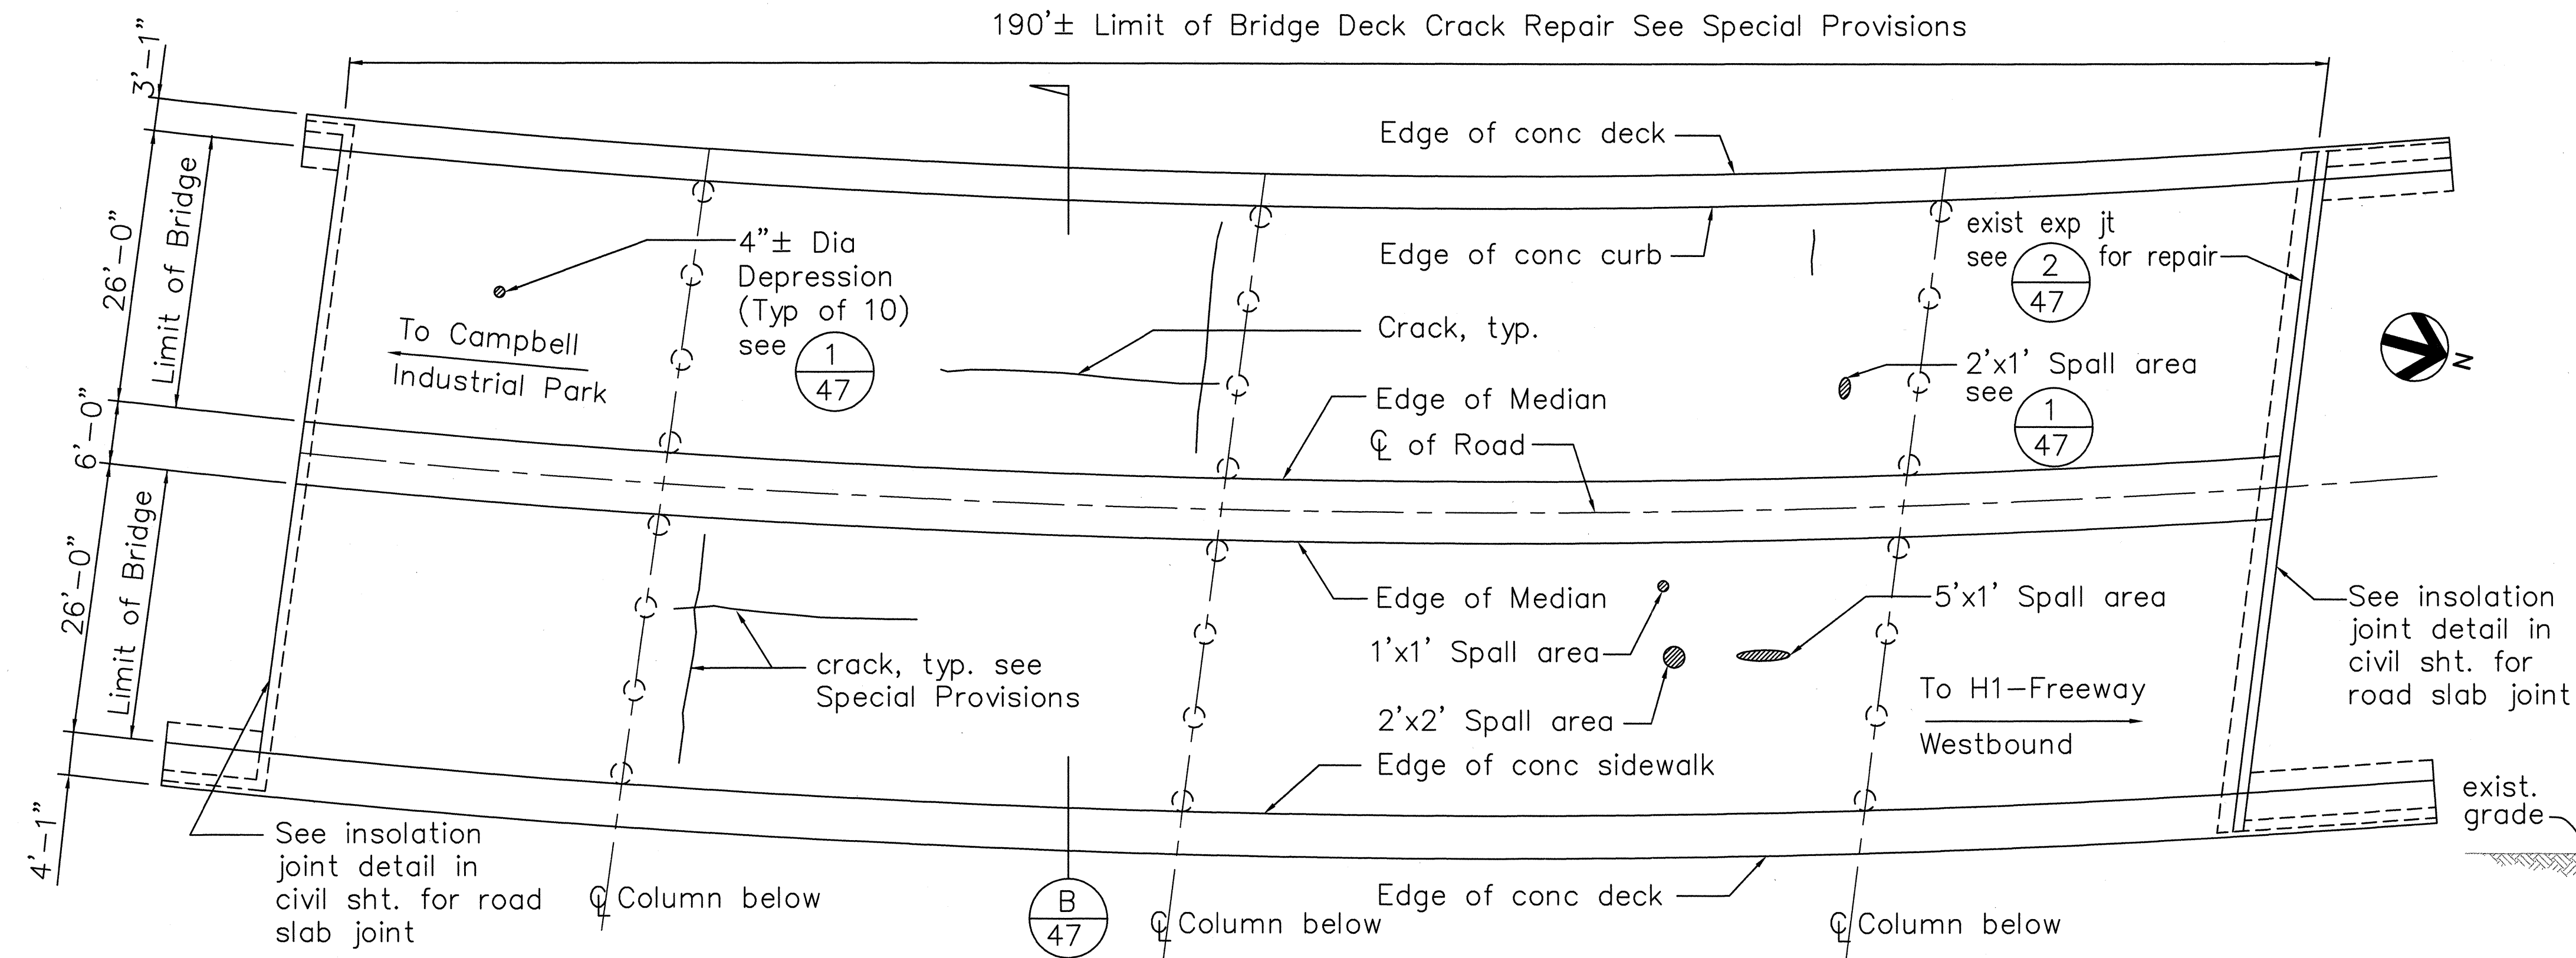

A
47
PALAILAI INTERCHANGE BRIDGE DECK REPAIR PLAN
Scale: 1"=10'-0"

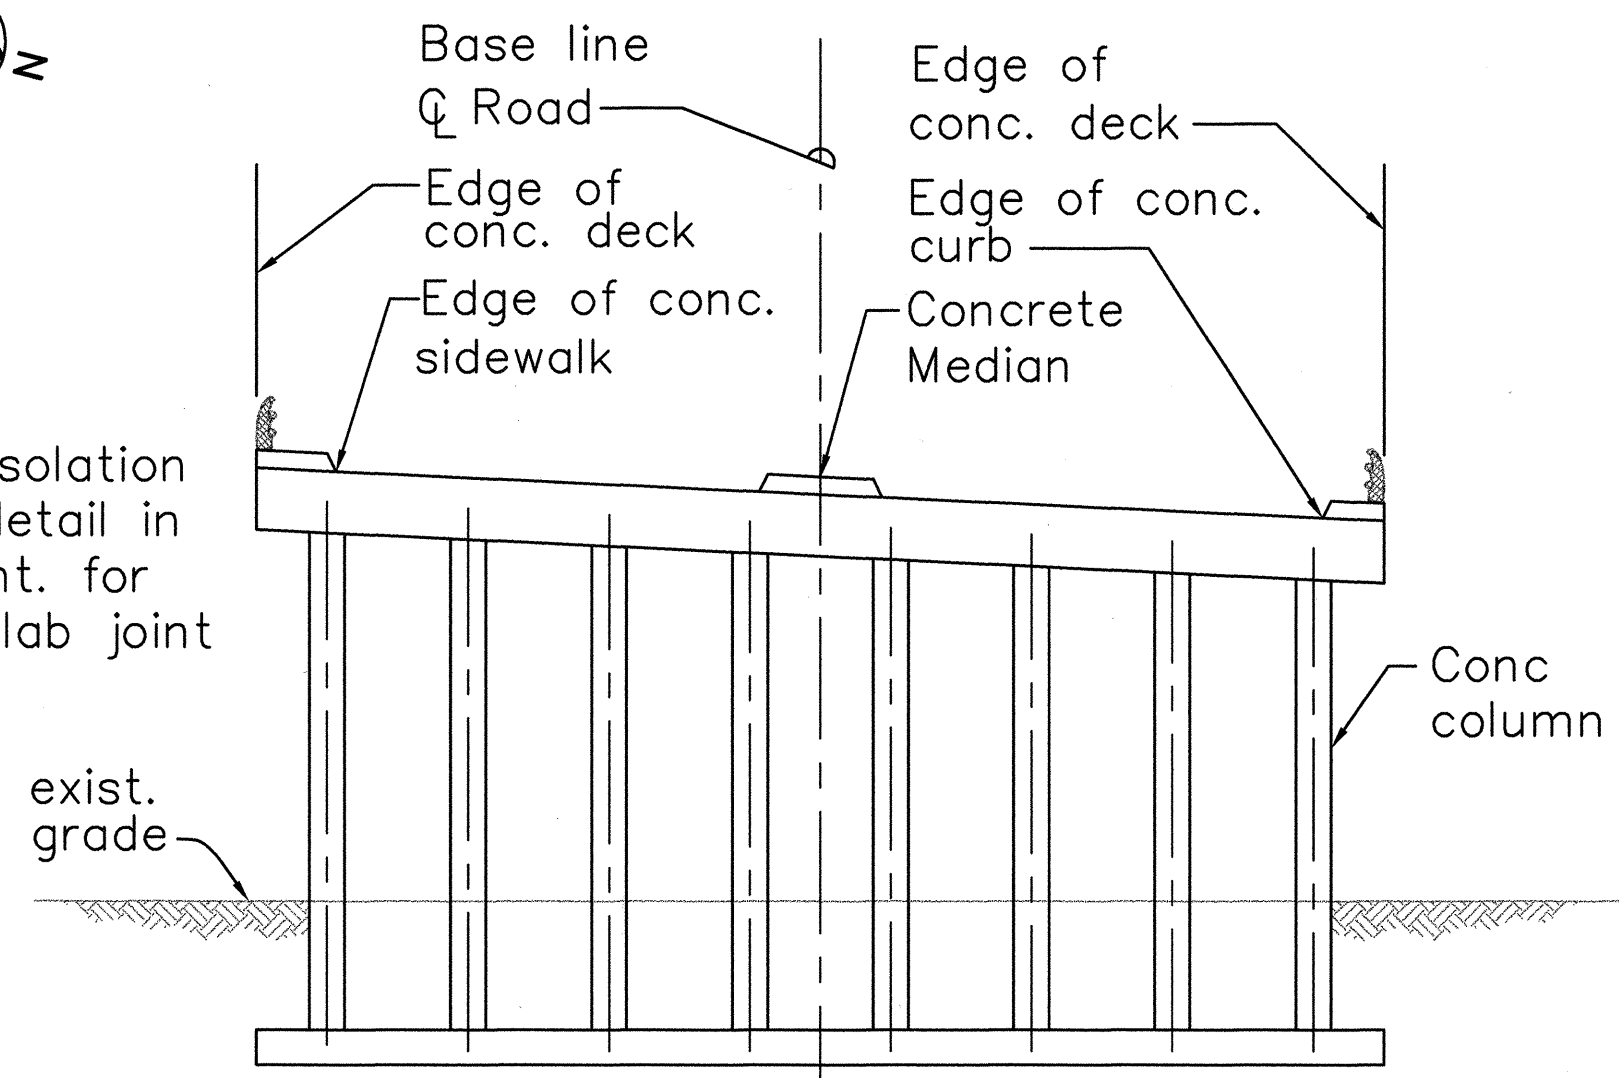


B
47
BRIDGE CROSS SECTION
Scale: 1"=10'-0"

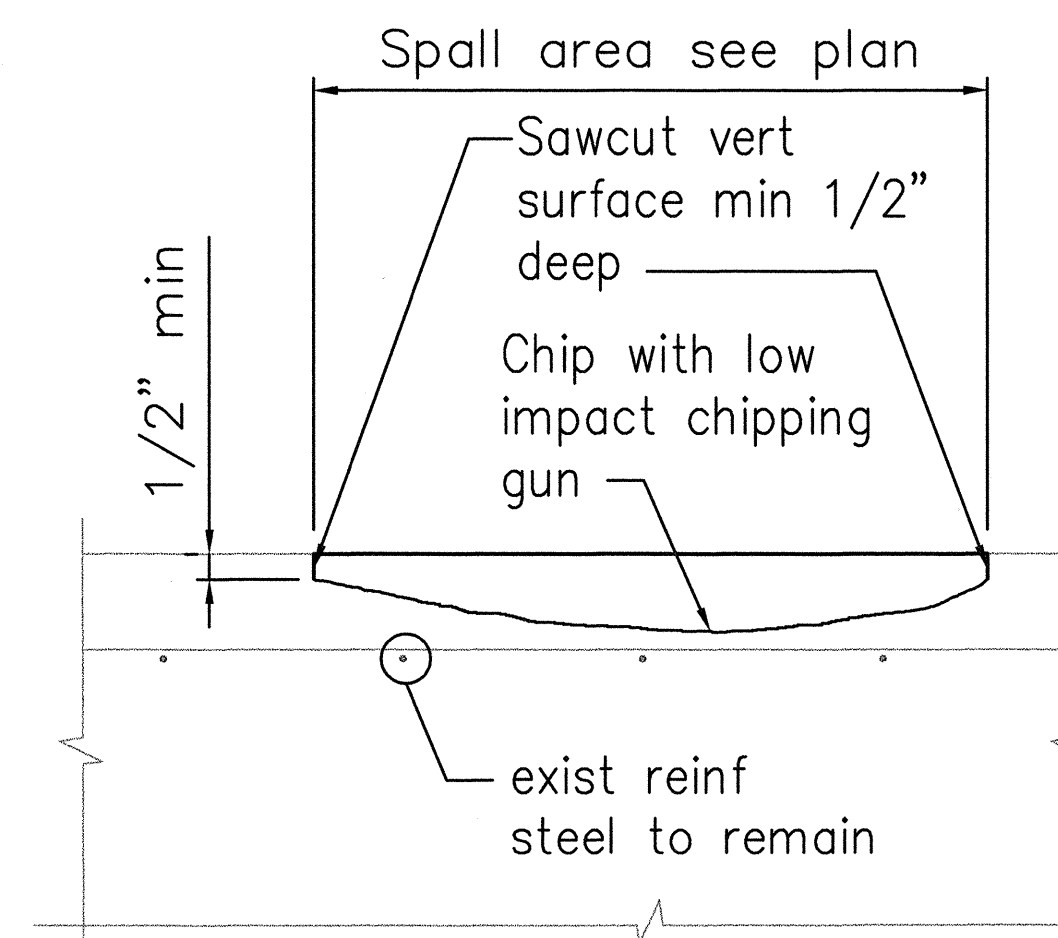

1
47
TYP CONCRETE DECK SPALL REPAIR Not to Scale


NOTES FOR SPALL REPAIR

- ① Clean concrete and roughen surface
- ② Apply concrete repair product in accordance with manufacture's recommendations. Concrete shall be worked into the surface of the existing deck, especially at the corners and edges.
- ③ Concrete deck temperature shall not exceed 85°F at any time during application of repair concrete.

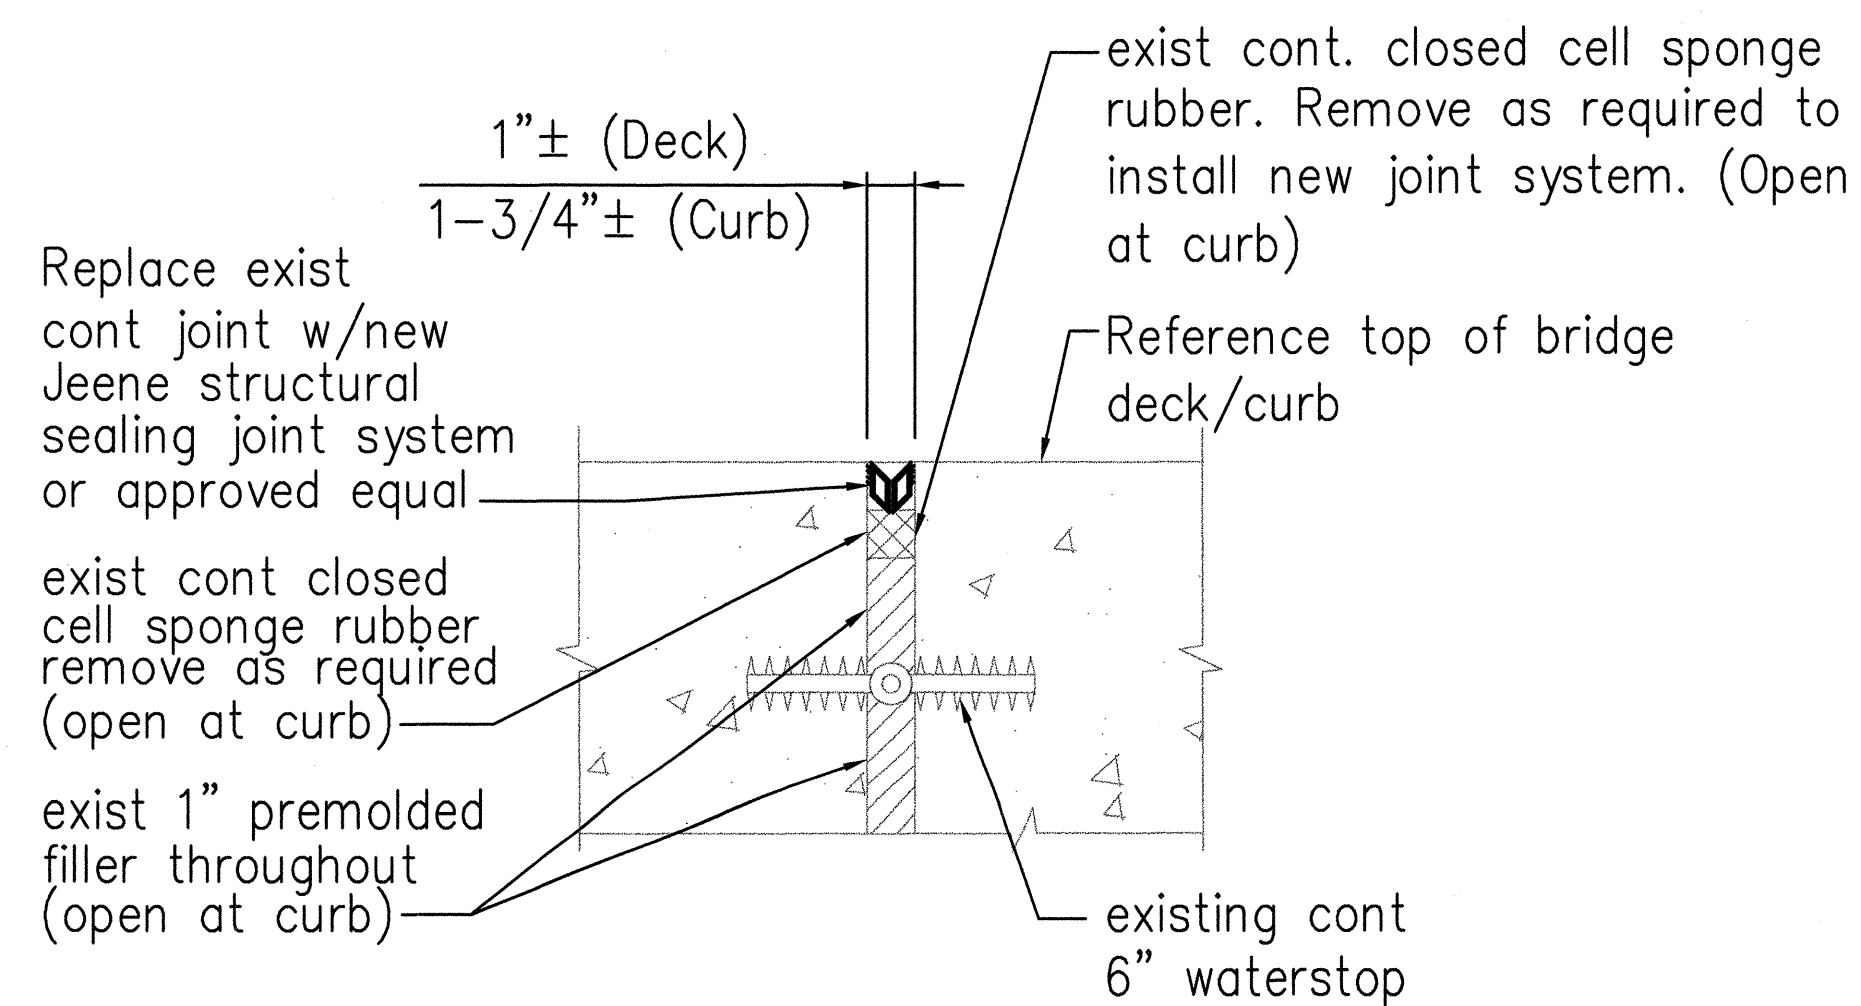

2
47
TYPICAL BRIDGE DECK EXPANSION JOINT REPAIR DETAIL Not to Scale

SURVEY PLOTTED BY	DATE
DRAWN BY	
CHECKED BY	
QUANTITIES BY	
CHECKED BY	
ORIGINAL PLAN	
NO.	

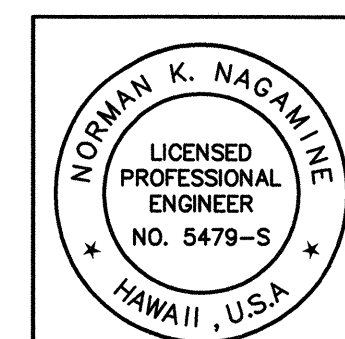

Norman K. Nagamine
THIS WORK WAS PREPARED
BY ME OR UNDER MY
SUPERVISION

STATE OF HAWAII
DEPARTMENT OF TRANSPORTATION
HIGHWAYS DIVISION
**CONC BRIDGE DECK REPAIR
PLAN, SECTION AND DETAILS**
INTERSTATE ROUTE H-1
Palailai Interchange Reconstruction
F.A.I. Project No. IM-NH-H1-1(239)

Scale: As Shown Date: 4/1/01

SHEET NO. S-12 OF 12 SHEETS

INDEX TO DRAWINGS	
SHEET	DESCRIPTION
Q1	Index, General Notes, Abbreviations, Layout Plan and Estimated Quantities
Q2	West Side Railing; Typical Section, Typical Thrie Beam and Post Detail; Plan - Base Plate
Q3	East Side Railing
Q4	Typical 25' Guardrail Transition, Thrie Beam Expansion Section and Sections
Q5	End Post and 25' Metal Guardrail Transition (Ramp "C")
Q6	End Post Details (Ramp "C")
Q7	Metal Guardrail Type 3 Thrie Beam and Appurtenances Details

ABBREVIATIONS

Alum.	Aluminum	Jt.	Joint
Approx.	Approximate	Lg.	Long
		Lin. Ft., L.F.	Linear Feet
Bal.	Balance	Max.	Maximum
BF	Back face	Min.	Minimum
Ⓟ	Baseline	No.	Number
Cl.	Clear	PL	Plate
Conc.	Concrete	Ref.	Reference
Def.	Detail	Reinf.	Reinforcing
∅	Diameter	Sect.	Section
Ea.	Each	Sht.	Sheet
EF	Each face	Spes.	Spaces
Exist.	Existing	Sta.	Station
Exp.	Expansion	Typ.	Typical
FF	Front face		
Fin.	Finish		

GENERAL NOTES

DESIGN SPECIFICATIONS - AASHTO:

1. AASHTO LRFD Bridge Design Specifications, 1994 with 1997 Interims.

MATERIALS:

1. Shapes and plates shall conform to ASTM A 36 and be hot-dip galvanized after fabrication, unless noted otherwise.
2. All welding shall be in accordance with the current edition of ANSI/AASHTO/AWS D1.5 Bridge Welding Code.

CONSTRUCTION METHODS:

1. Refer to Hawaii Standard Specifications for Road, Bridge and Public Works Construction, 1994 Edition and Special Provisions.
2. Except as noted otherwise, all dimensions are measured plumb.
3. Removal of part of existing structure shall be done in such a manner as to preclude any damage to the existing structures. Large vibratory type of equipment will not be permitted in the removal operation, nor for drilling of holes. Only small vibratory hand tools approved by the Engineer will be allowed. Any damage to the existing structure due to the Contractor's operation or negligence shall be repaired at his expense with no additional cost to the State, and to the satisfaction of the Engineer.

REFERENCE:

1. Refer to Standard Plans for additional details and notes not covered by details and typical drawings.

GENERAL:


1. All items noted incidental will not be paid for separately.
2. The Contractor shall verify the locations of all existing utility lines and notify their respective owners before commencing with any work.
3. The Contractor shall verify all grades and dimensions. The Engineer shall be informed of all discrepancies before commencing with any work.
4. The Contractor shall be solely responsible for the protection of adjacent property, utilities and existing and new structures from damage due to construction. Repairing any damage shall be at the Contractor's own expense, with no additional cost to the State. The Contractor shall conduct his work in such a manner and provide such temporary shoring or other measures as may be necessary to insure the safety of all concerned and to protect existing structures.

FED. ROAD DIST. NO.	STATE	FED. AID PROJ. NO.	FISCAL YEAR	SHEET NO.	TOTAL SHEETS
HAWAII	HAW.	IM-NH-HI-1(239)	2001	48	103


ESTIMATED QUANTITIES

ITEM NO.	ITEM	UNIT	TOTAL
507.7600	12' End Post With Terminal Connector	Ea.	1 Ea.
606.3350	Guardrail, Type 3 - Thrie Beam with Steel Post on Concrete Structure	Lin. Ft.	419 L.F.
606.3360	Guardrail, 25' Transition - Double Thrie Beam to Single W-Beam	Lin. Ft.	125 L.F.

SYMBOLS

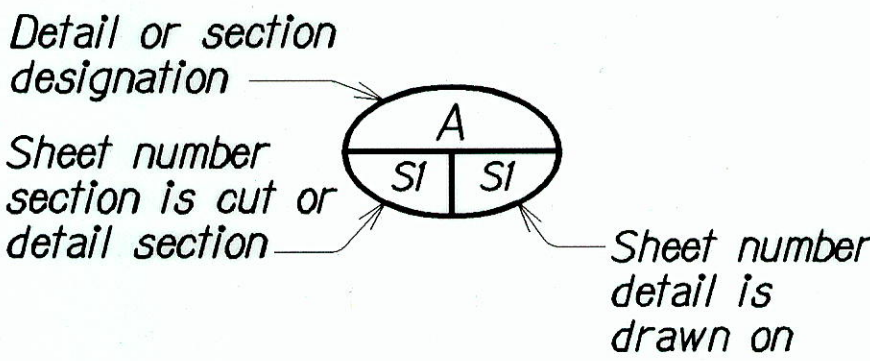

SURVEY PLOTTED BY	DATE
DRWN BY	1/1/01
DESIGNED BY	1/1/01
QUANTITIES BY	1/1/01
CHECKED BY	1/1/01

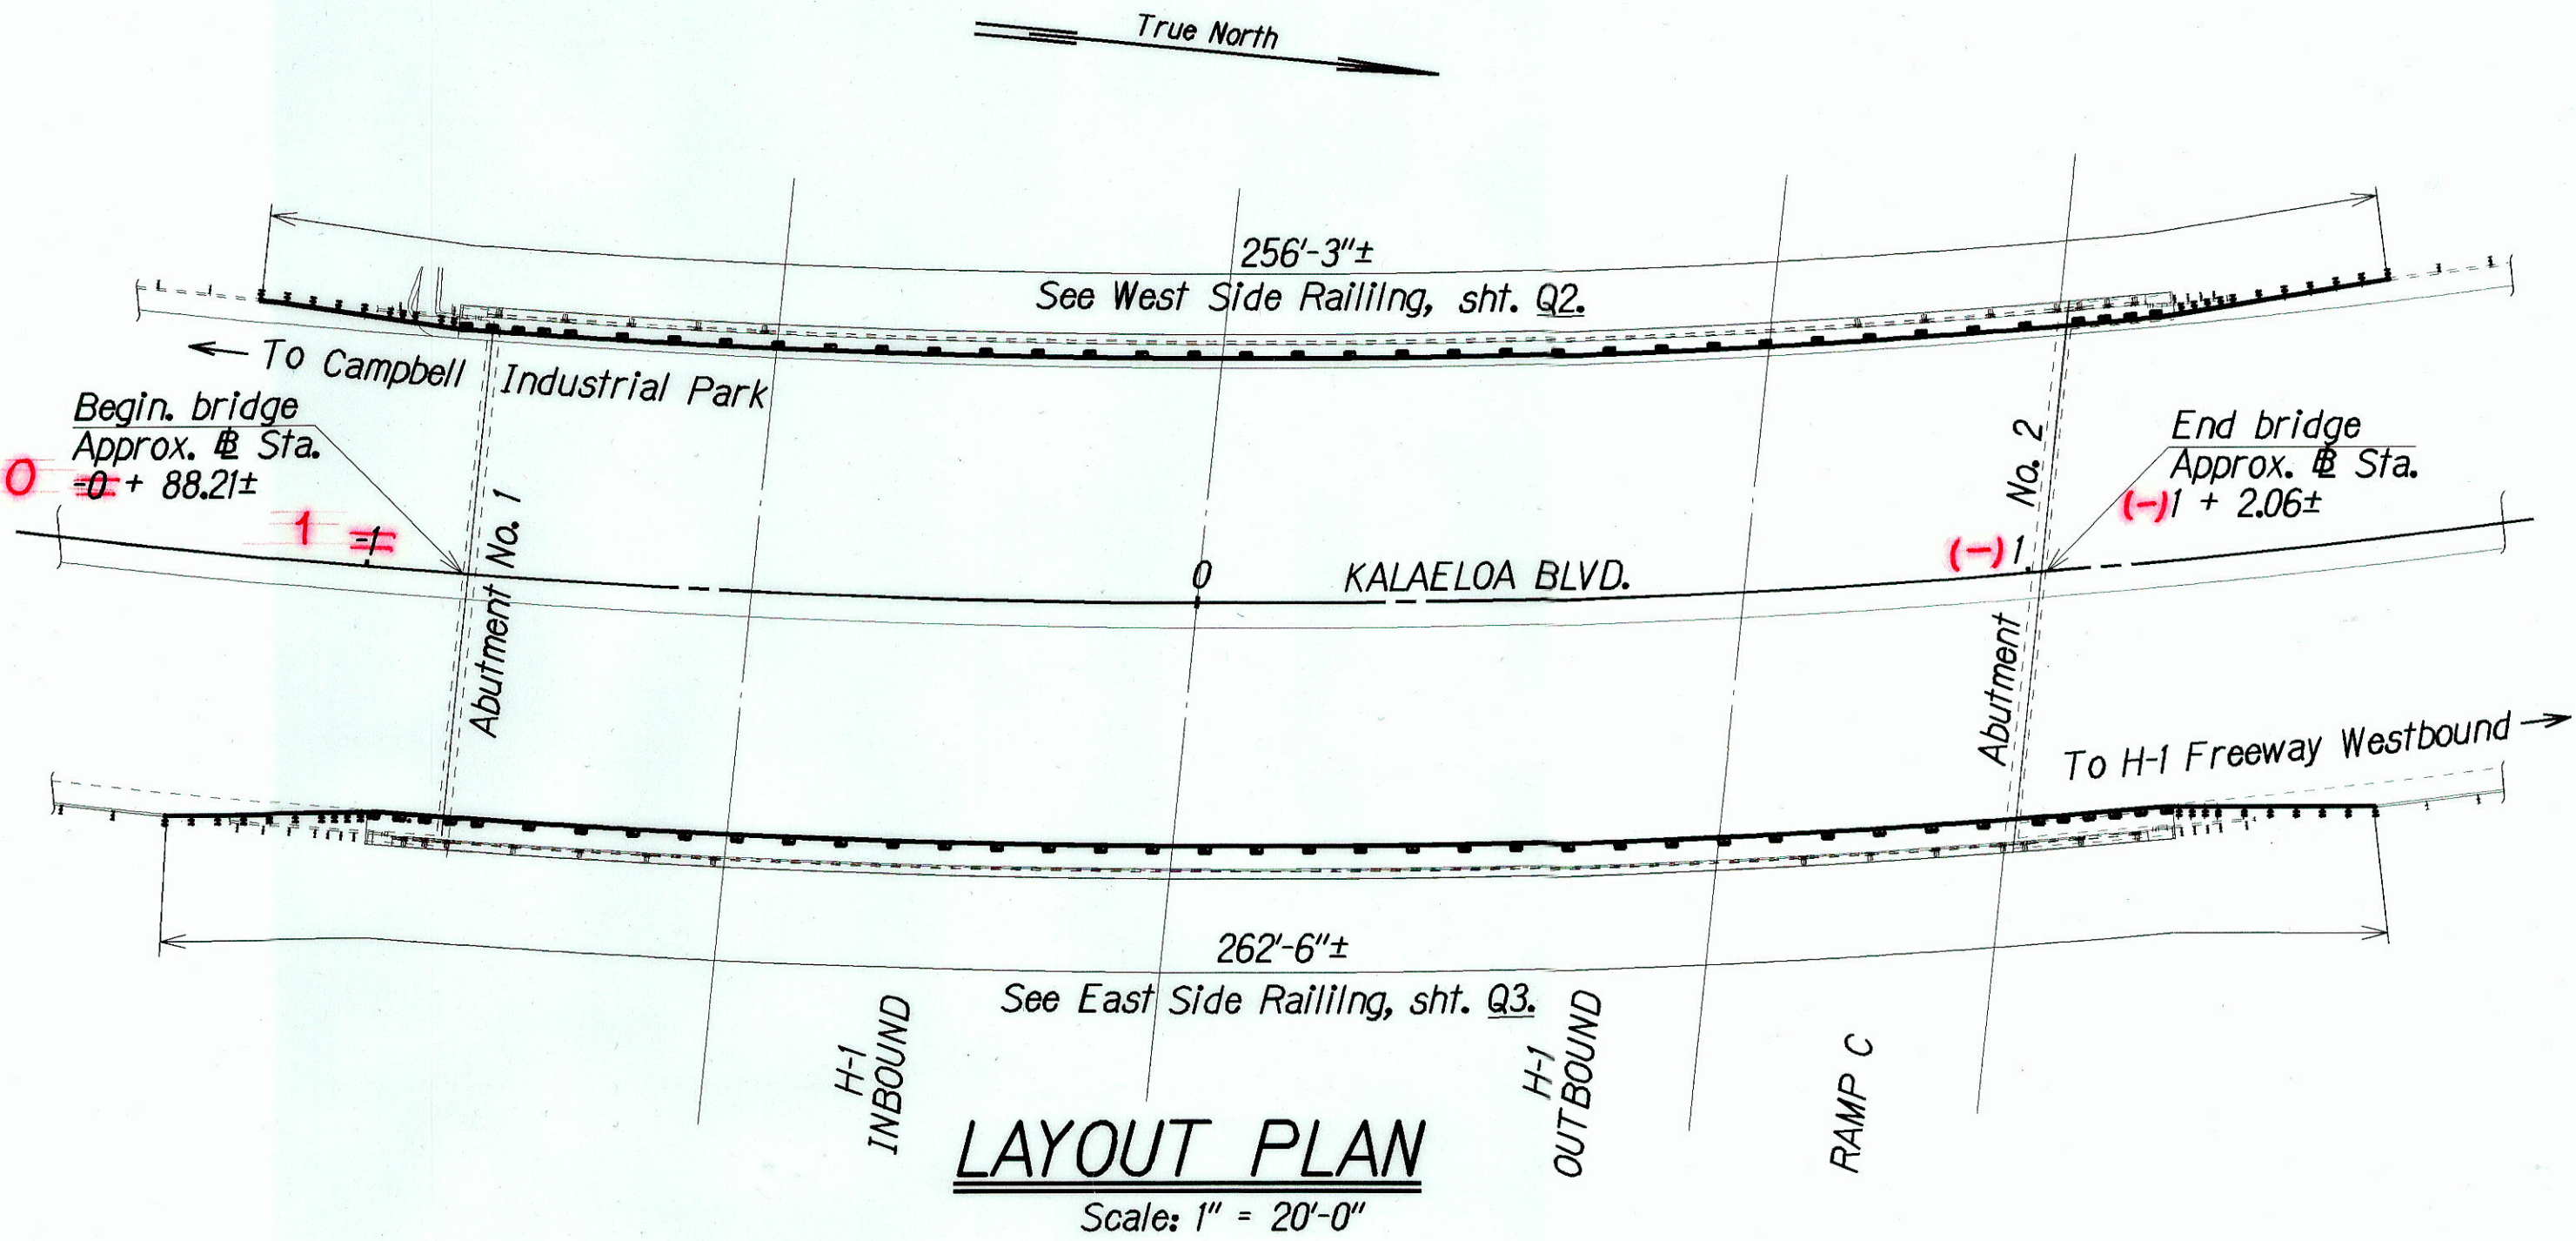

STATE OF HAWAII
DEPARTMENT OF TRANSPORTATION
HIGHWAYS DIVISION

PALAILAI INTERCHANGE STRUCTURE
INDEX, GENERAL NOTES, ABBREVIATIONS
LAYOUT PLAN & ESTIMATED QUANTITIES

INTERSTATE ROUTE H-1
PALAILAI INTERCHANGE RECONSTRUCTION
Fed. Aid Project No. IM-NH-HI-1(239)



Scale: As Noted Date: Apr. 2001

SHEET No. Q1 OF 7 SHEETS

"AS-BUILT"

FED. ROAD DIST. NO.	STATE	FED. AID PROJ. NO.	FISCAL YEAR	SHEET NO.	TOTAL SHEETS
HAWAII	HAW.	IM-NH-HI-1239	2001	C.O. 49	103

Sta. (-) 1+20± =

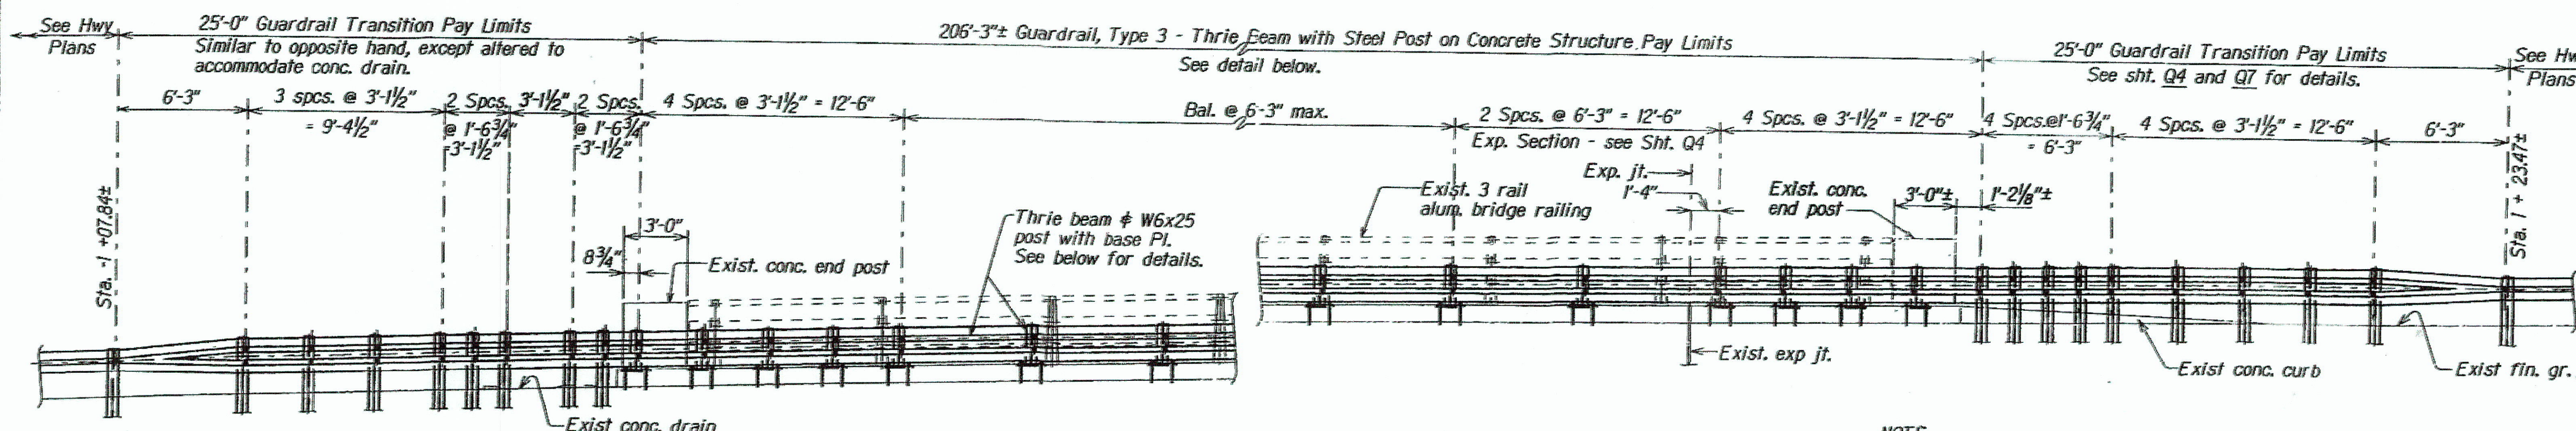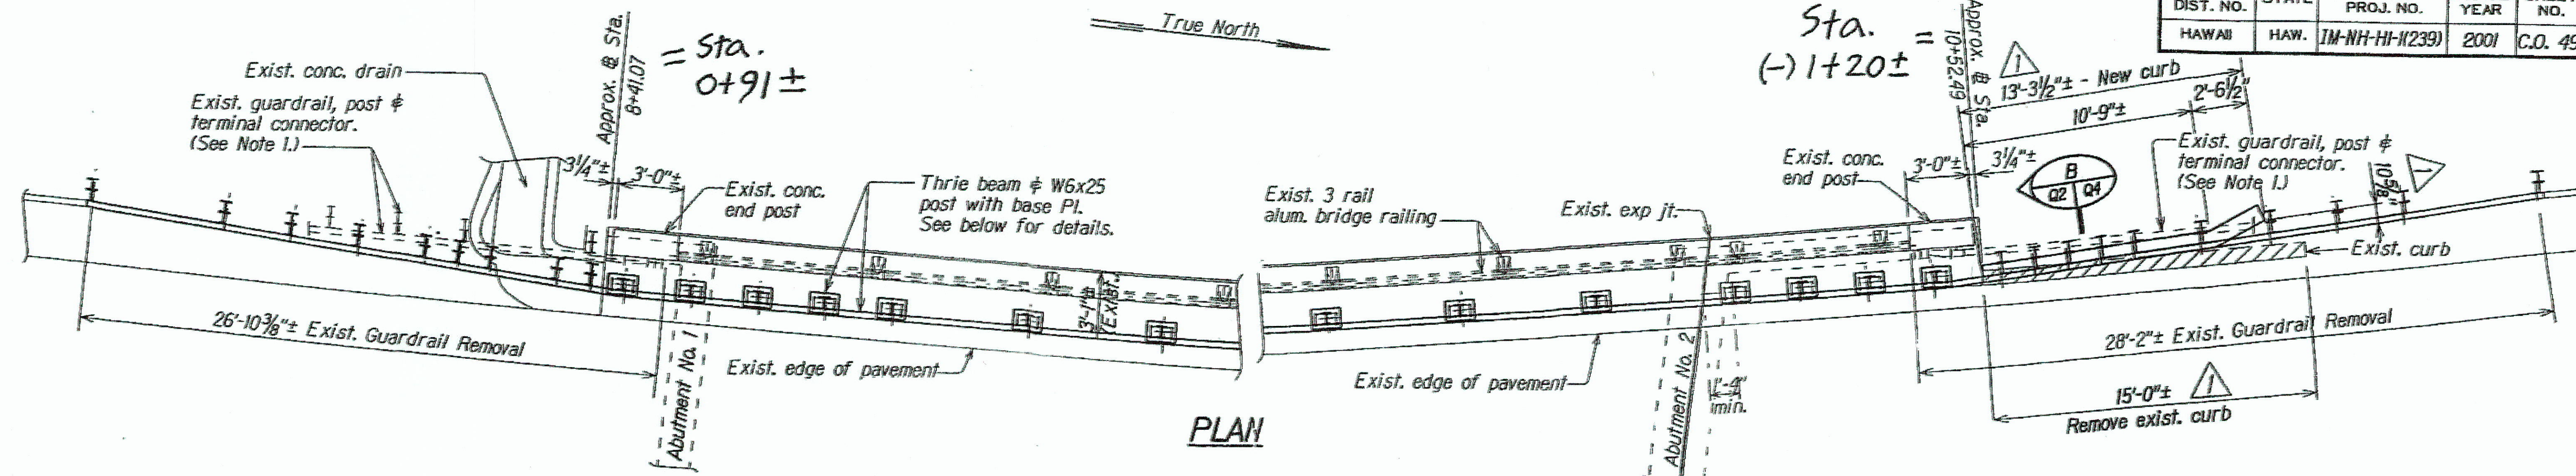


DEVELOPED ELEVATION WEST SIDE RAILING


Scale: 1/4" = 1'-0"

NOTE:


1. Removal of existing guardrail, posts and terminal connectors shall be incidental to contract. Bolt holes for the terminal connectors shall be patched with grout and painted to match existing color.
2. Anchor bolts for the base plate shown on this sheet shall be high strength full length threaded rods (studs) conforming to ASTM A 449 and hot dip galvanized.
3. Anchor bolts shall be embedded in a two-component self-mixing epoxy-resin system with minimum ultimate bond strength of 55,000 lbs. for 1/4" bolts and 15,000 lbs. for 3/8" bolts.

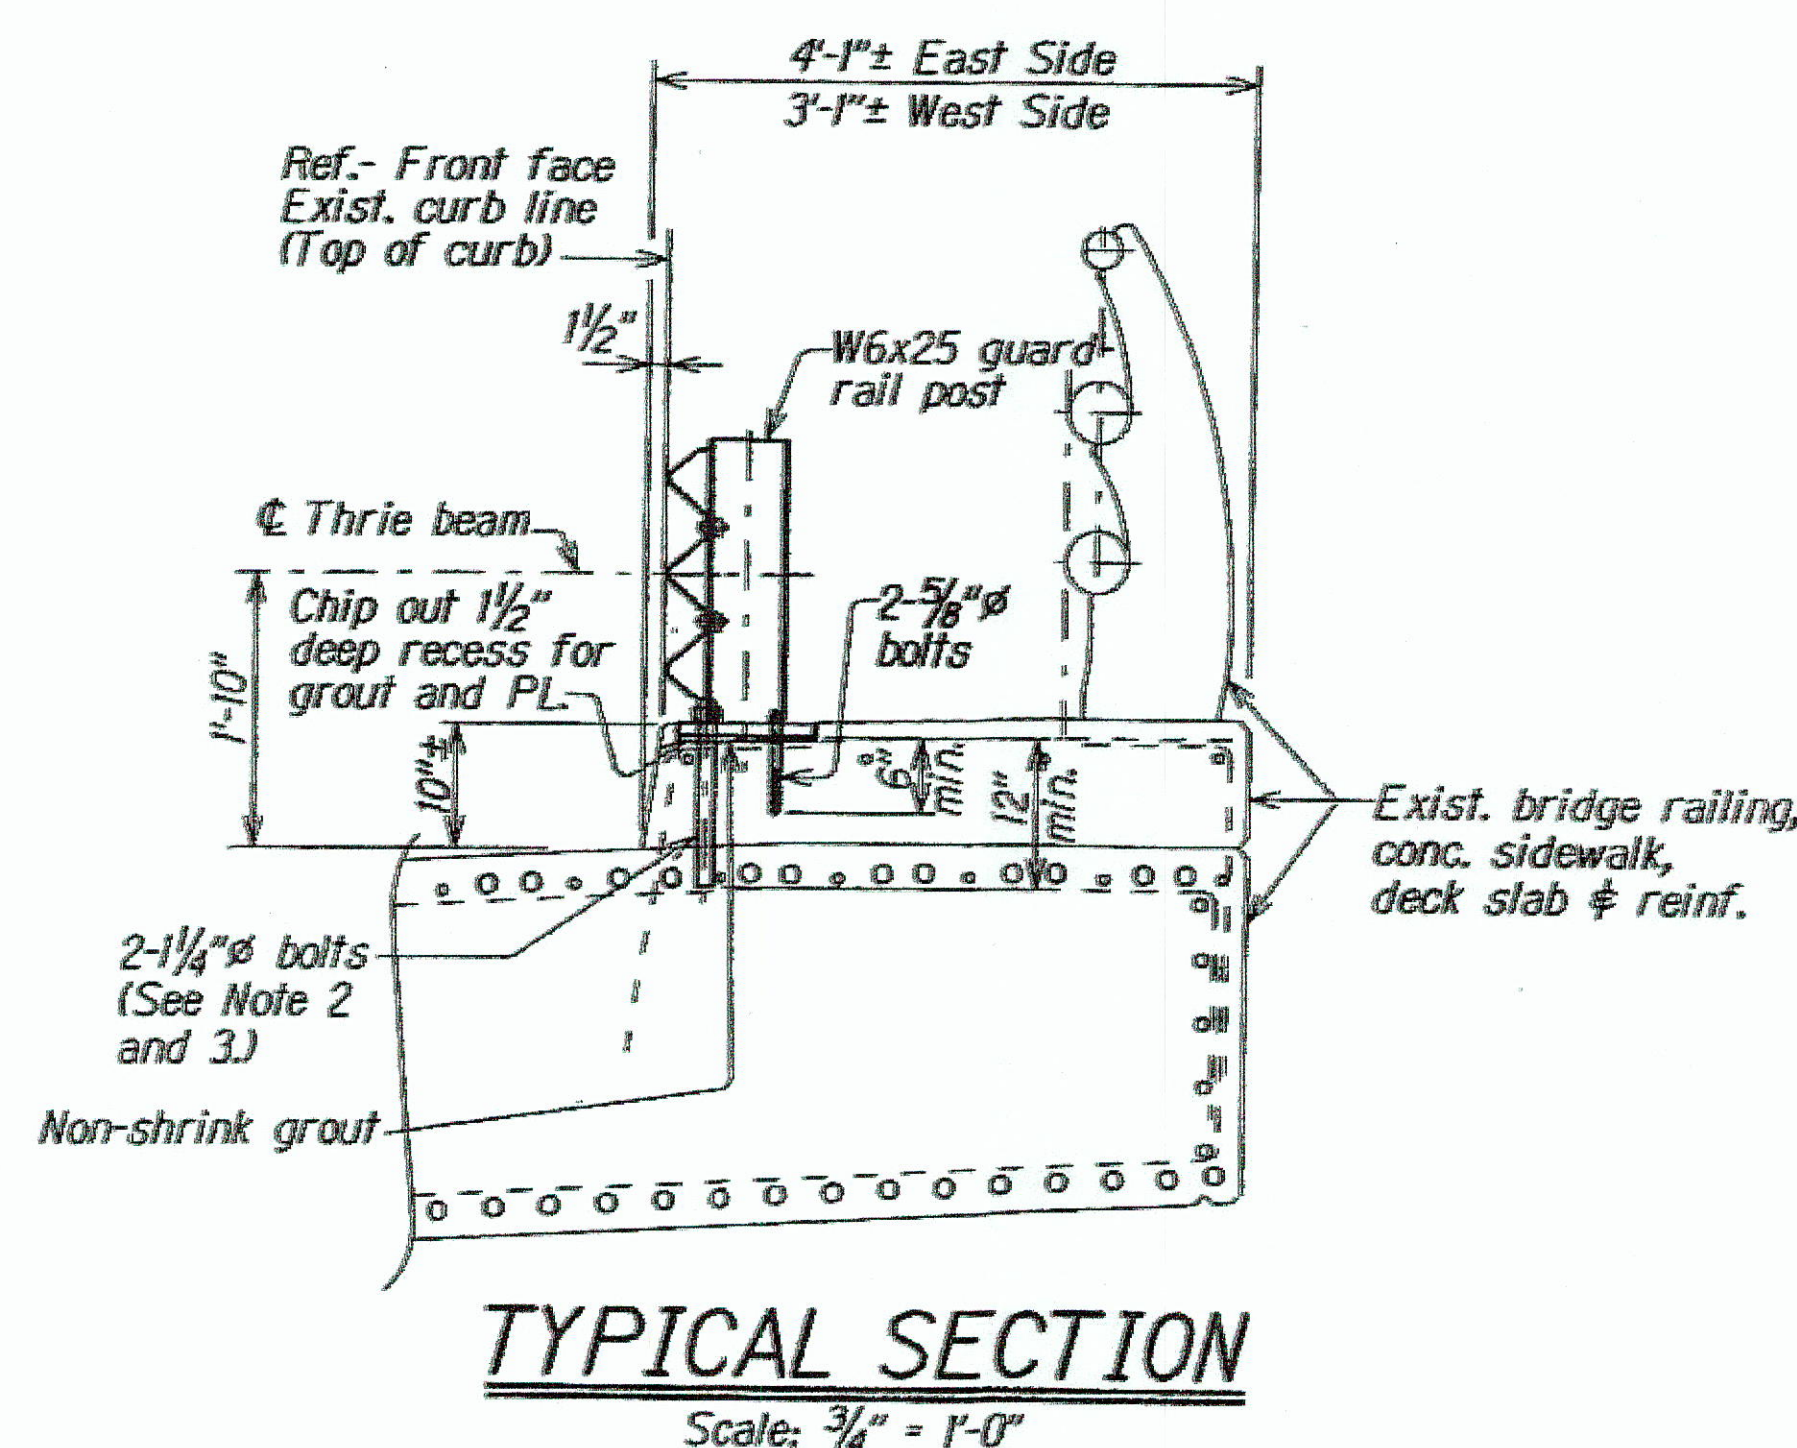

TYPICAL SECTION
Scale: 3/4" = 1'-0"

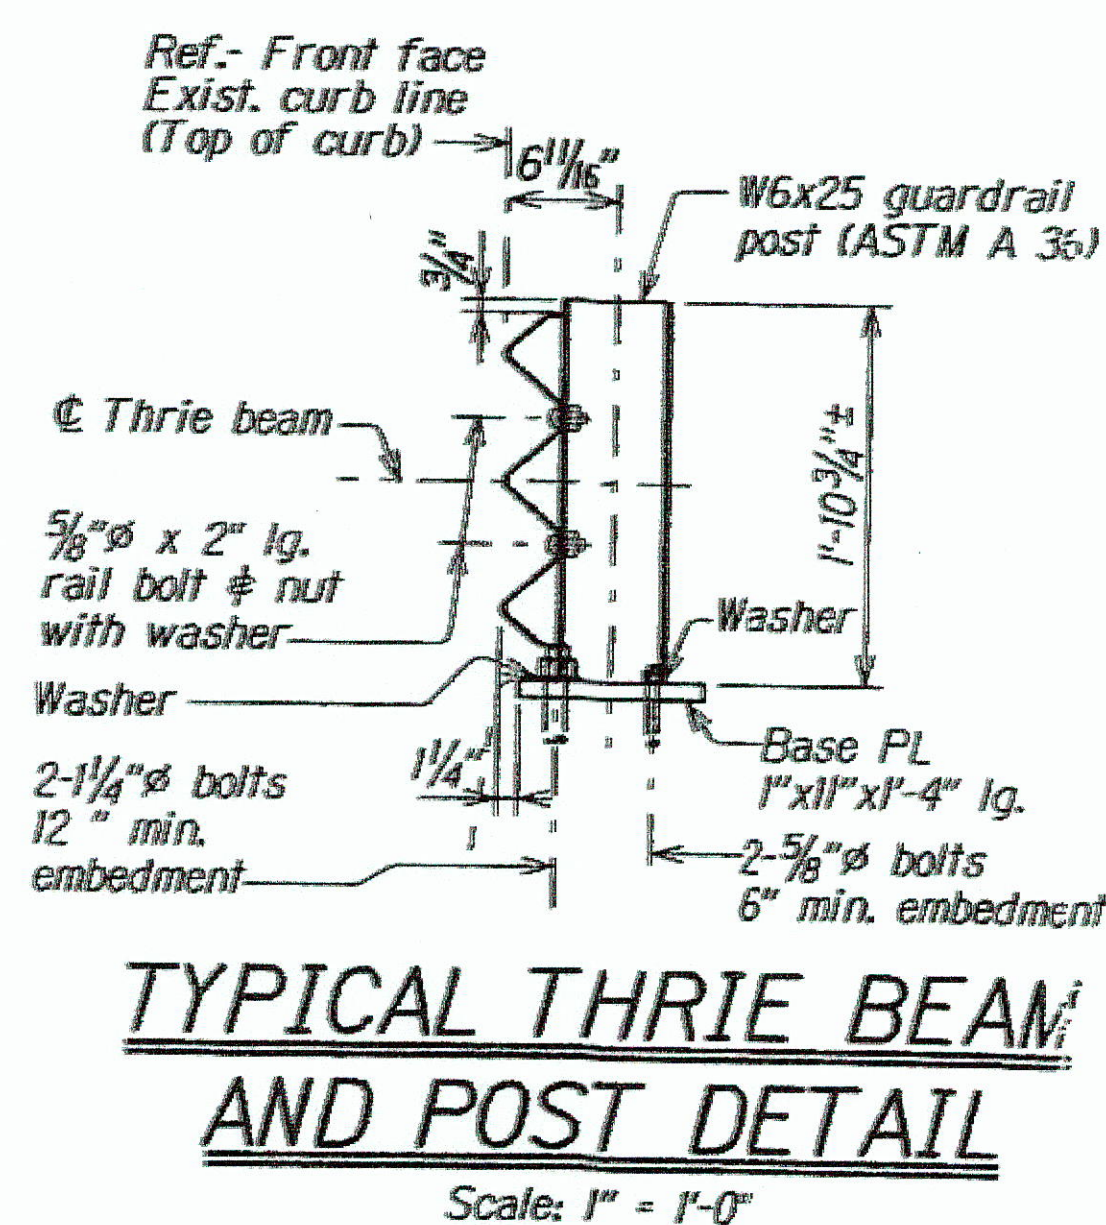

TYPICAL THRIE BEAM
AND POST DETAIL
Scale: 1" = 1'-0"

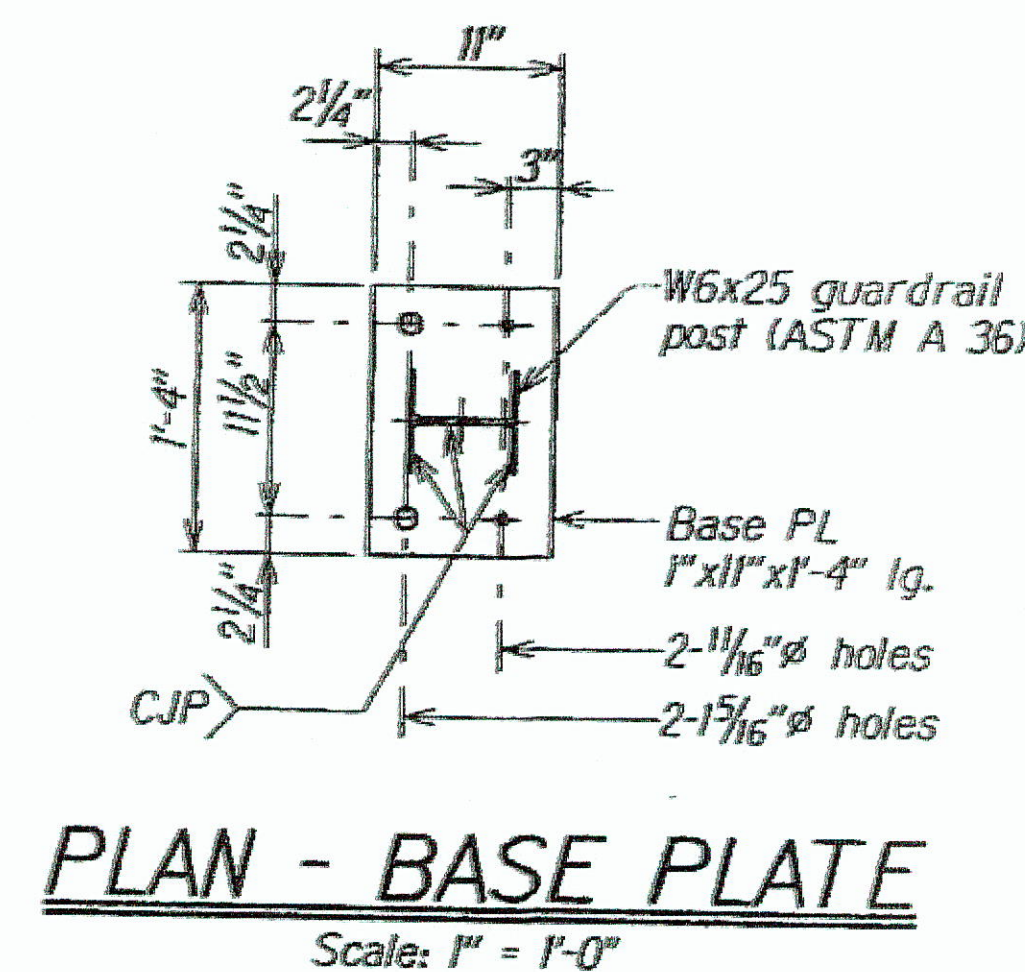

PLAN - BASE PLATE
Scale: 1" = 1'-0"

C.C.O. NO. 11

6/17/03	Change made to remove exist. curb and to add new curb as indicated.
DATE	REVISIONS
STATE OF HAWAII DEPARTMENT OF TRANSPORTATION HIGHWAYS DIVISION PALAILAI INTERCHANGE STRUCTURE WEST SIDE RAILING; TYPICAL SECTION TYPICAL THRIE BEAM & POST DETAIL; PLAN-BASE PLATE INTERSTATE ROUTE HI-1 PALAILAI INTERCHANGE RECONSTRUCTION Fed. Aid Project No. IM-NH-HI-1239	
Scale: As Noted	Date: Apr. 2001

SHEET No. Q2 OF 7 SHEETS

"AS-BUILT"



JUN 20 2003 C.O. 49

FED. ROAD DIST. NO.	STATE	FED. AID PROJ. NO.	FISCAL YEAR	SHEET NO.	TOTAL SHEETS
HAWAII	HAW.	1M-NH-HI-1(239)	2001	C.O. 50	103

True North

Sta.
(-)1+15± =

Sta.
0+97± =

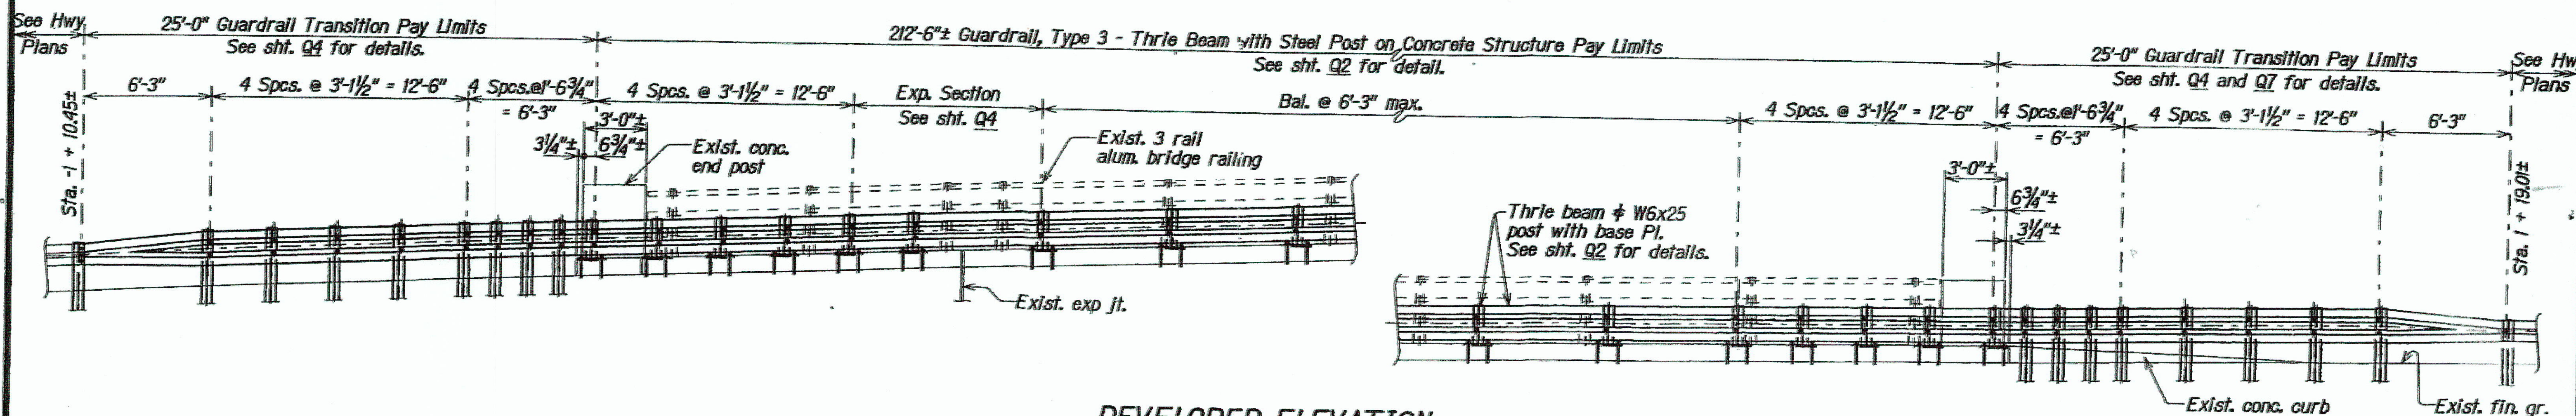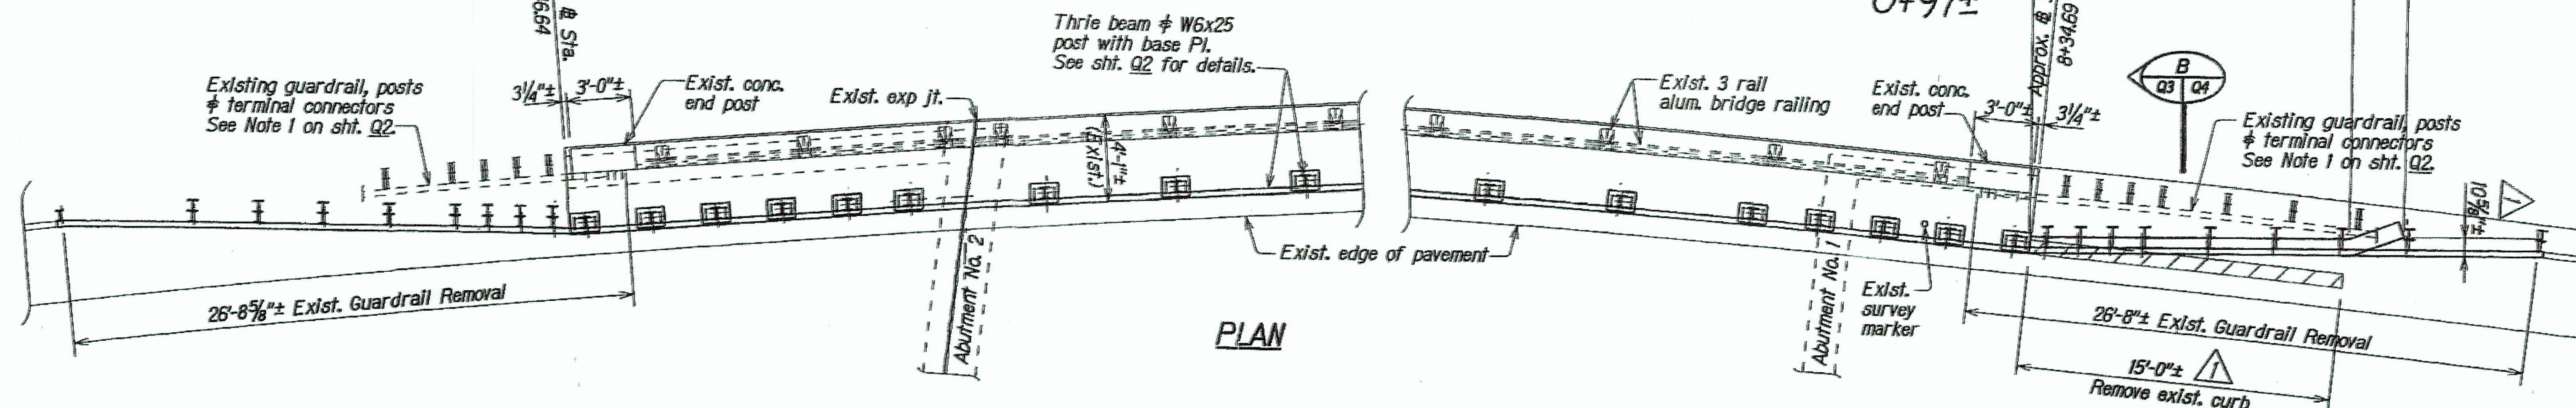

DEVELOPED ELEVATION

EAST SIDE RAILING

Scale: 1/4" = 1'-0"

C.C.O. NO. 11

Change made to remove exist. curb and to add new curb as indicated.

DATE	REVISIONS
6/17/03	Change made to remove exist. curb and to add new curb as indicated.
STATE OF HAWAII DEPARTMENT OF TRANSPORTATION HIGHWAYS DIVISION	
PALAILAI INTERCHANGE STRUCTURE EAST SIDE RAILING INTERSTATE ROUTE HI-1 PALAILAI INTERCHANGE RECONSTRUCTION Fed. Aid Project No. 1M-NH-HI-1(239)	
Scale: As Noted	Date: Apr. 2001


SHEET No. Q3 OF 7 SHEETS

"AS-BUILT"


JUN 20 2003 C.O. 50

NOTED BY: [Signature]
CHECKED BY: [Signature]
DATE: [Date]

FED. ROAD DIST. NO.	STATE	FED. AID PROJ. NO.	FISCAL YEAR	SHEET NO.	TOTAL SHEETS
HAWAII	HAW.	1M-NH-HI-1(239)	2001	C.O. 51	103

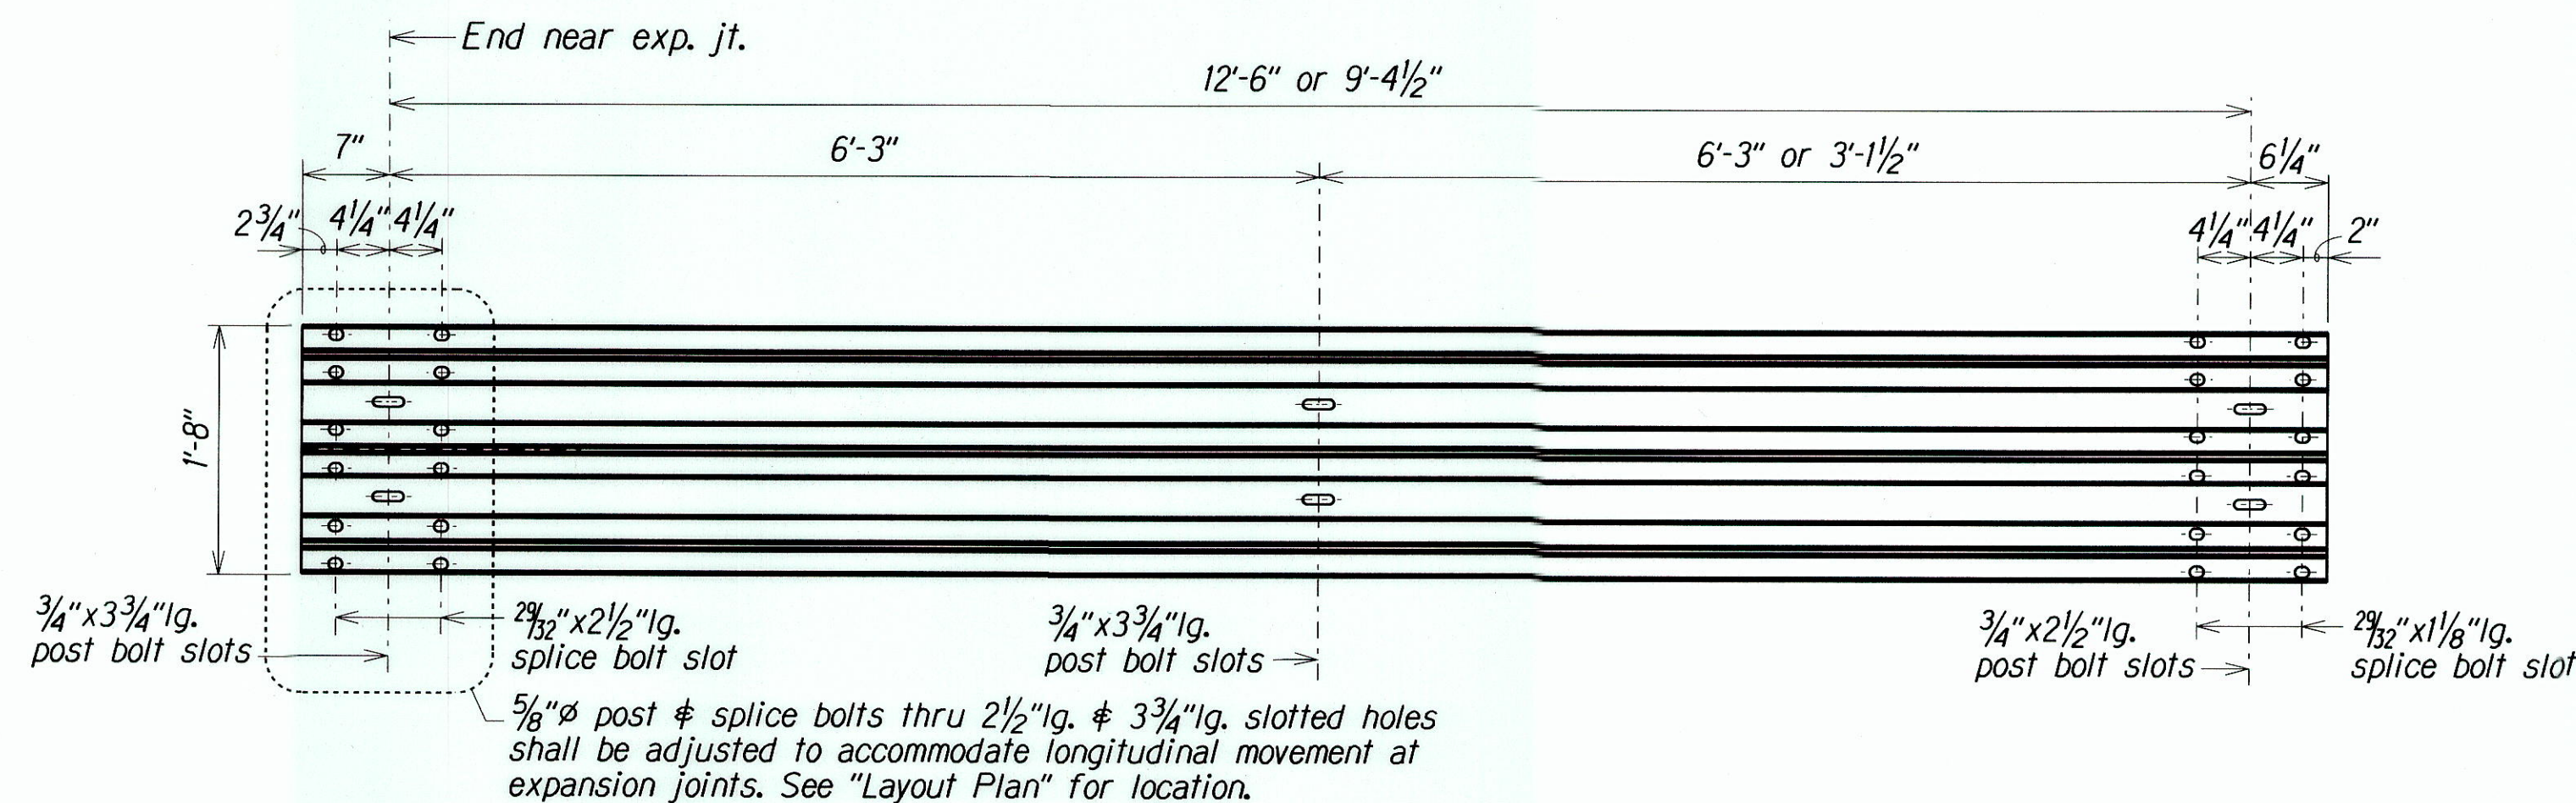


THRIE BEAM EXPANSION SECTION
Scale: 1" = 1'-0"

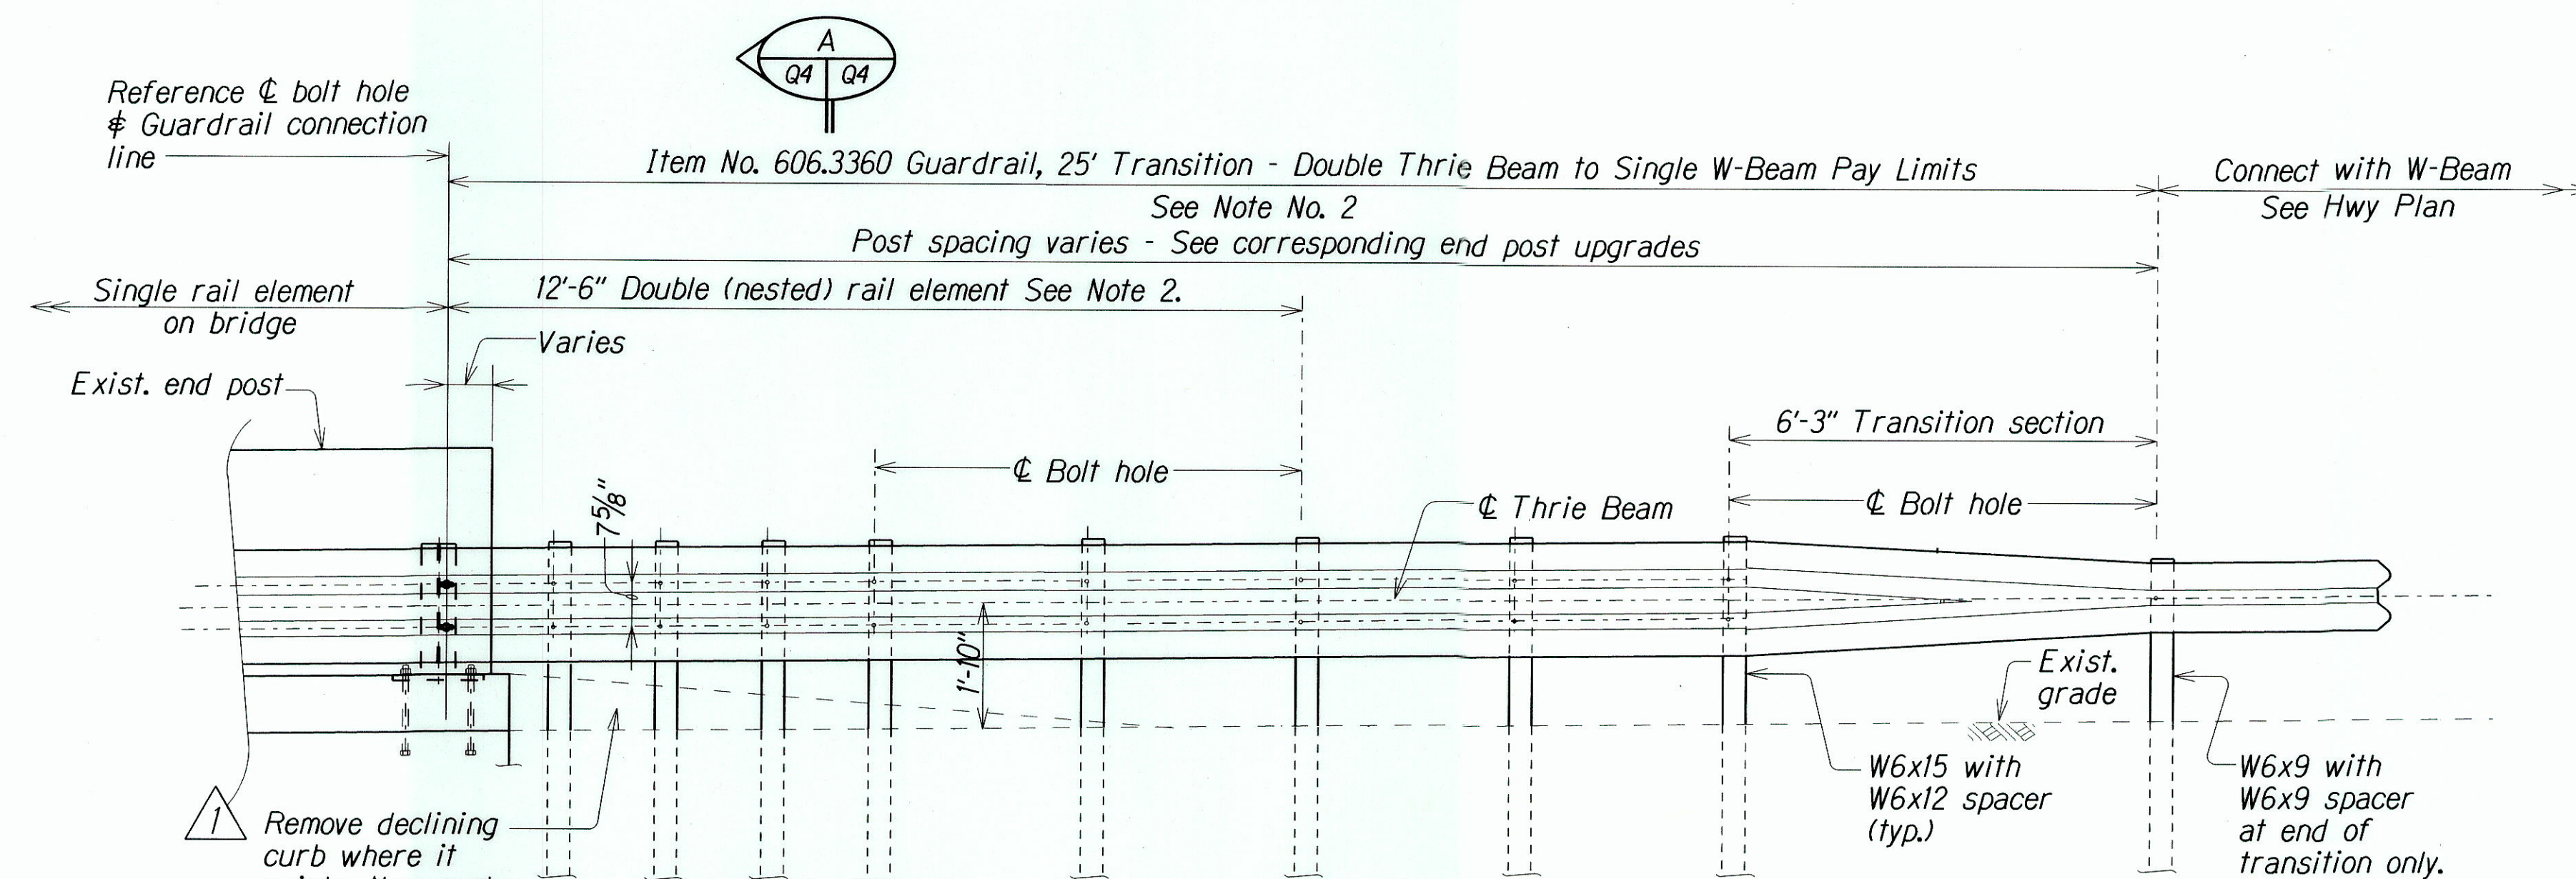

TYPICAL 25' GUARDRAIL TRANSITION
Scale: 1/2" = 1'-0"

DESIGNED BY	DATE
DRAWN BY	JUL 1993
NOTED BY	JUL 1993
CHECKED BY	JUL 1993
APPROVED BY	JUL 1993
ORIGINAL PLAN	
NOTE BOOK	
QUANTITIES BY	
CHECKED BY	
DATE	

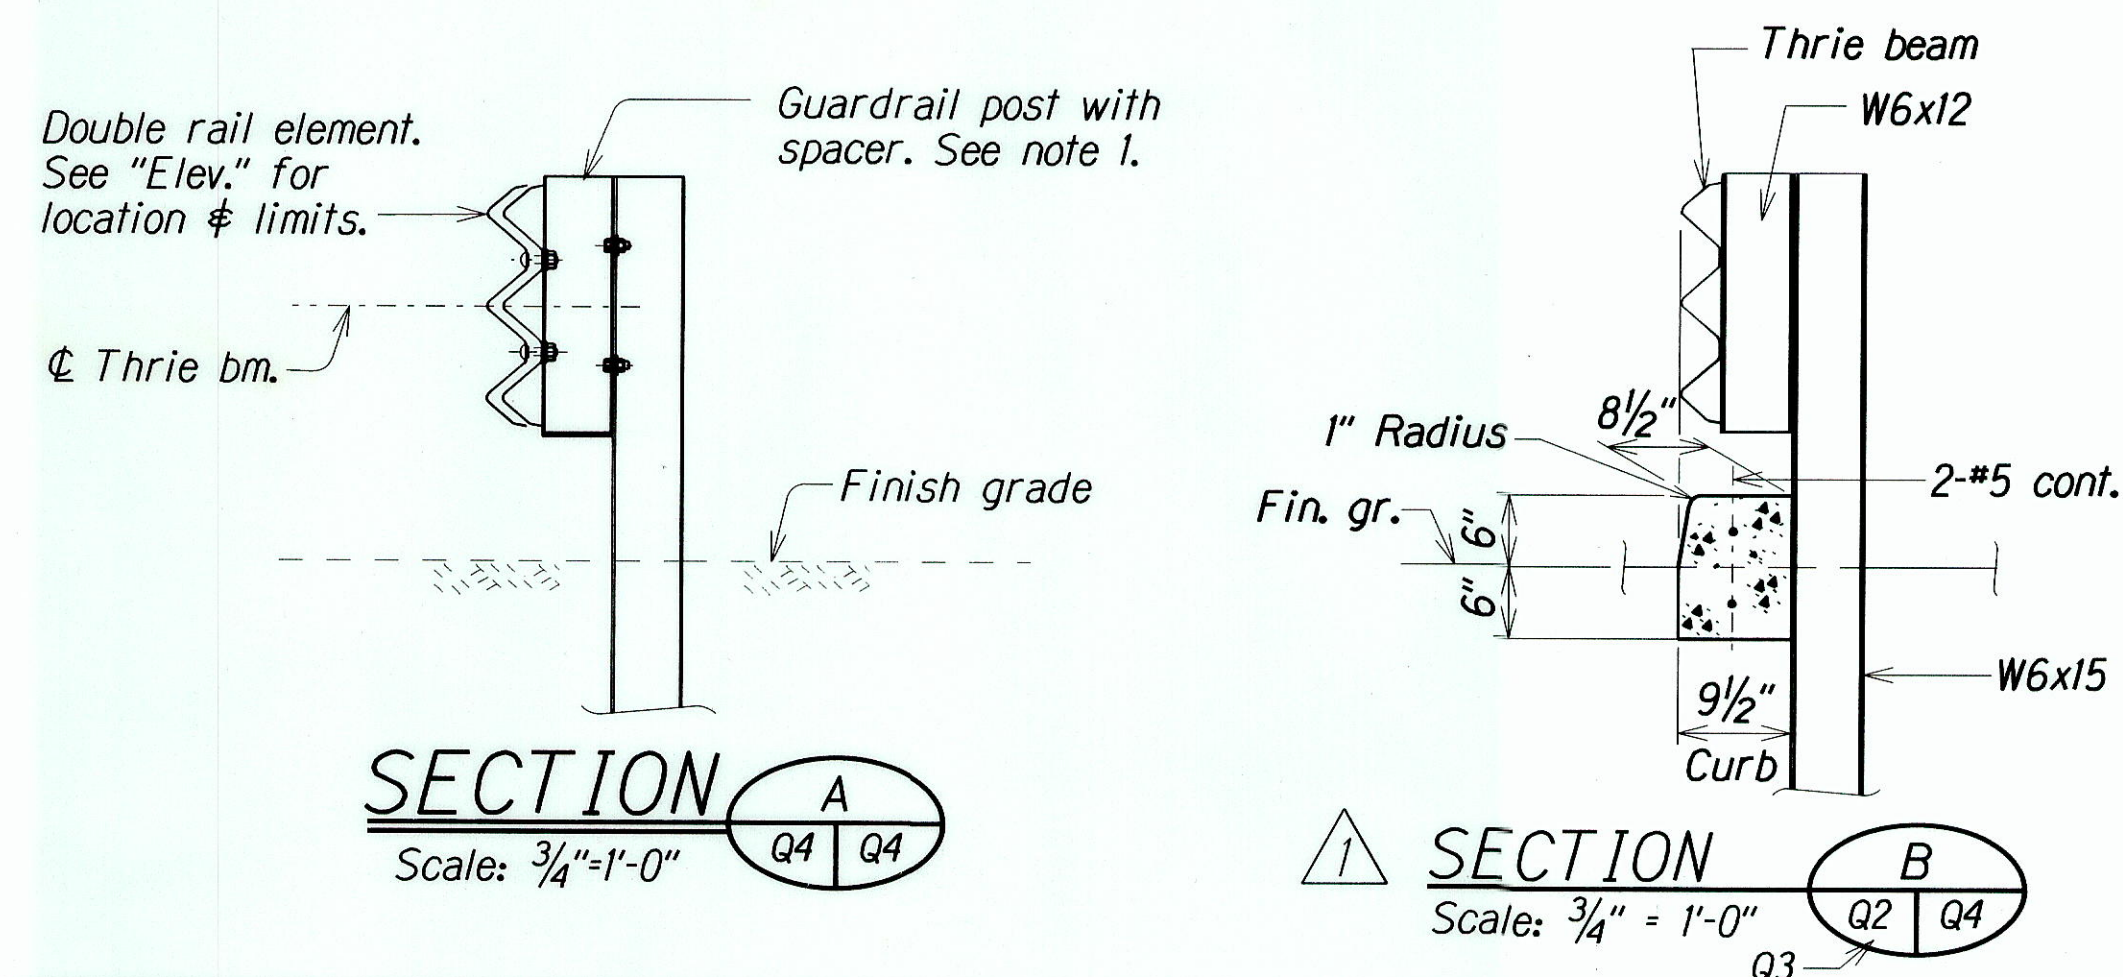

GUARDRAIL NOTES:


- The work necessary to connect guardrail to concrete end post or metal spacer block shall include all labor, materials, tools, equipment and incidentals necessary to complete the work and shall be incidental to Item No. 606.3360 - Guardrail, 25' Transition - Double Thrie Beam to Single W-Beam.
- Unless otherwise noted, all fasteners, posts, and rail elements shall conform to the latest edition and amendments of "Guide to Standardized Highway Barrier Rail Hardware," a report prepared and approved by the AASHTO-AGC-ARTBA Joint Cooperative Committee, Subcommittee on New Highway Materials, Task Force 13 Report. Dimensions of fasteners, posts and rail elements have been converted from metric units into their present form.
- Terminal connector, guardrail post, spacer block, transition section and all other associated hardware will not be paid for separately and shall be considered incidental to Item No. 606.3360 - Guardrail, 25' Transition - Double Thrie Beam to Single W-Beam.
- See "General Notes" on sht. Q1 for additional jersey barrier, guardrail and drilling information.
- All anchor bolts shall be high strength bolts conforming to the requirements of AASHTO M 164, unless otherwise noted in these drawing. See Special Provisions.
- Anchor bolt length shall be such that a snug fit of the elements and full thread engagement plus 1/4" (max.) is attained.
- Terminal connector, Thrie Beam Metal Guardrail and Transition Section shall be fabricated from 10 guage steel conforming to the requirements of AASHTO M 180 and shall be hot-dip galvanized with Type II zinc coating after fabrication. See Special Provisions.
- Guardrail posts, spacer blocks, "Terminal connectors" and all anchor bolts, cap PLs, bolts, nuts and washers shall be hot-dip galvanized after fabrication.
- Cap PLs shall be fabricated from ASTM A 36.
- First 25'-0" of guardrail adjoining "Terminal connectors" shall be galvanized steel and supports spaced as shown on the detail drawings. This section of rail shall be placed on tangent to end post or parallel to roadway, unless conditions at site renders it impossible to do so. Flare point to be determined in field.
- Double (nest 1st panel) thrie beam elements at all end post connections.
- Where double (nested) beam occur, 12" "Back-up Plate" not required.
- Heads of through anchor bolts shall be placed on the traffic side of the rail.
- Drilling of through holes shall be done in such a manner as to prevent cone puncturing of the daylighting end.
- See sht. Q7 for Guardrail Type 3 Thrie Beam details.

Added Det. "B" for guardrail detail at curb and label changed to indicate change.	
6/17/03	
DATE	REVISIONS
STATE OF HAWAII DEPARTMENT OF TRANSPORTATION HIGHWAYS DIVISION	
PALAILAI INTERCHANGE STRUCTURE	
TYPICAL 25' GUARDRAIL TRANSITION	
THRIE BEAM EXPANSION SECTION AND SECTIONS	
INTERSTATE ROUTE H-1	
PALAILAI INTERCHANGE RECONSTRUCTION	
Fed. Aid Proj. No. 1M-NH-HI-1(239)	
Scale: As Noted	Date: Apr. 2001
SHEET No. Q4 OF 7 SHEETS	


"AS-BUILT"

C.O. 51

FED. ROAD DIST. NO.	STATE	FED. AID PROJ. NO.	FISCAL YEAR	SHEET NO.	TOTAL SHEETS
HAWAII	HAW.	1M-NH-HI-1(239)	2001	52	103

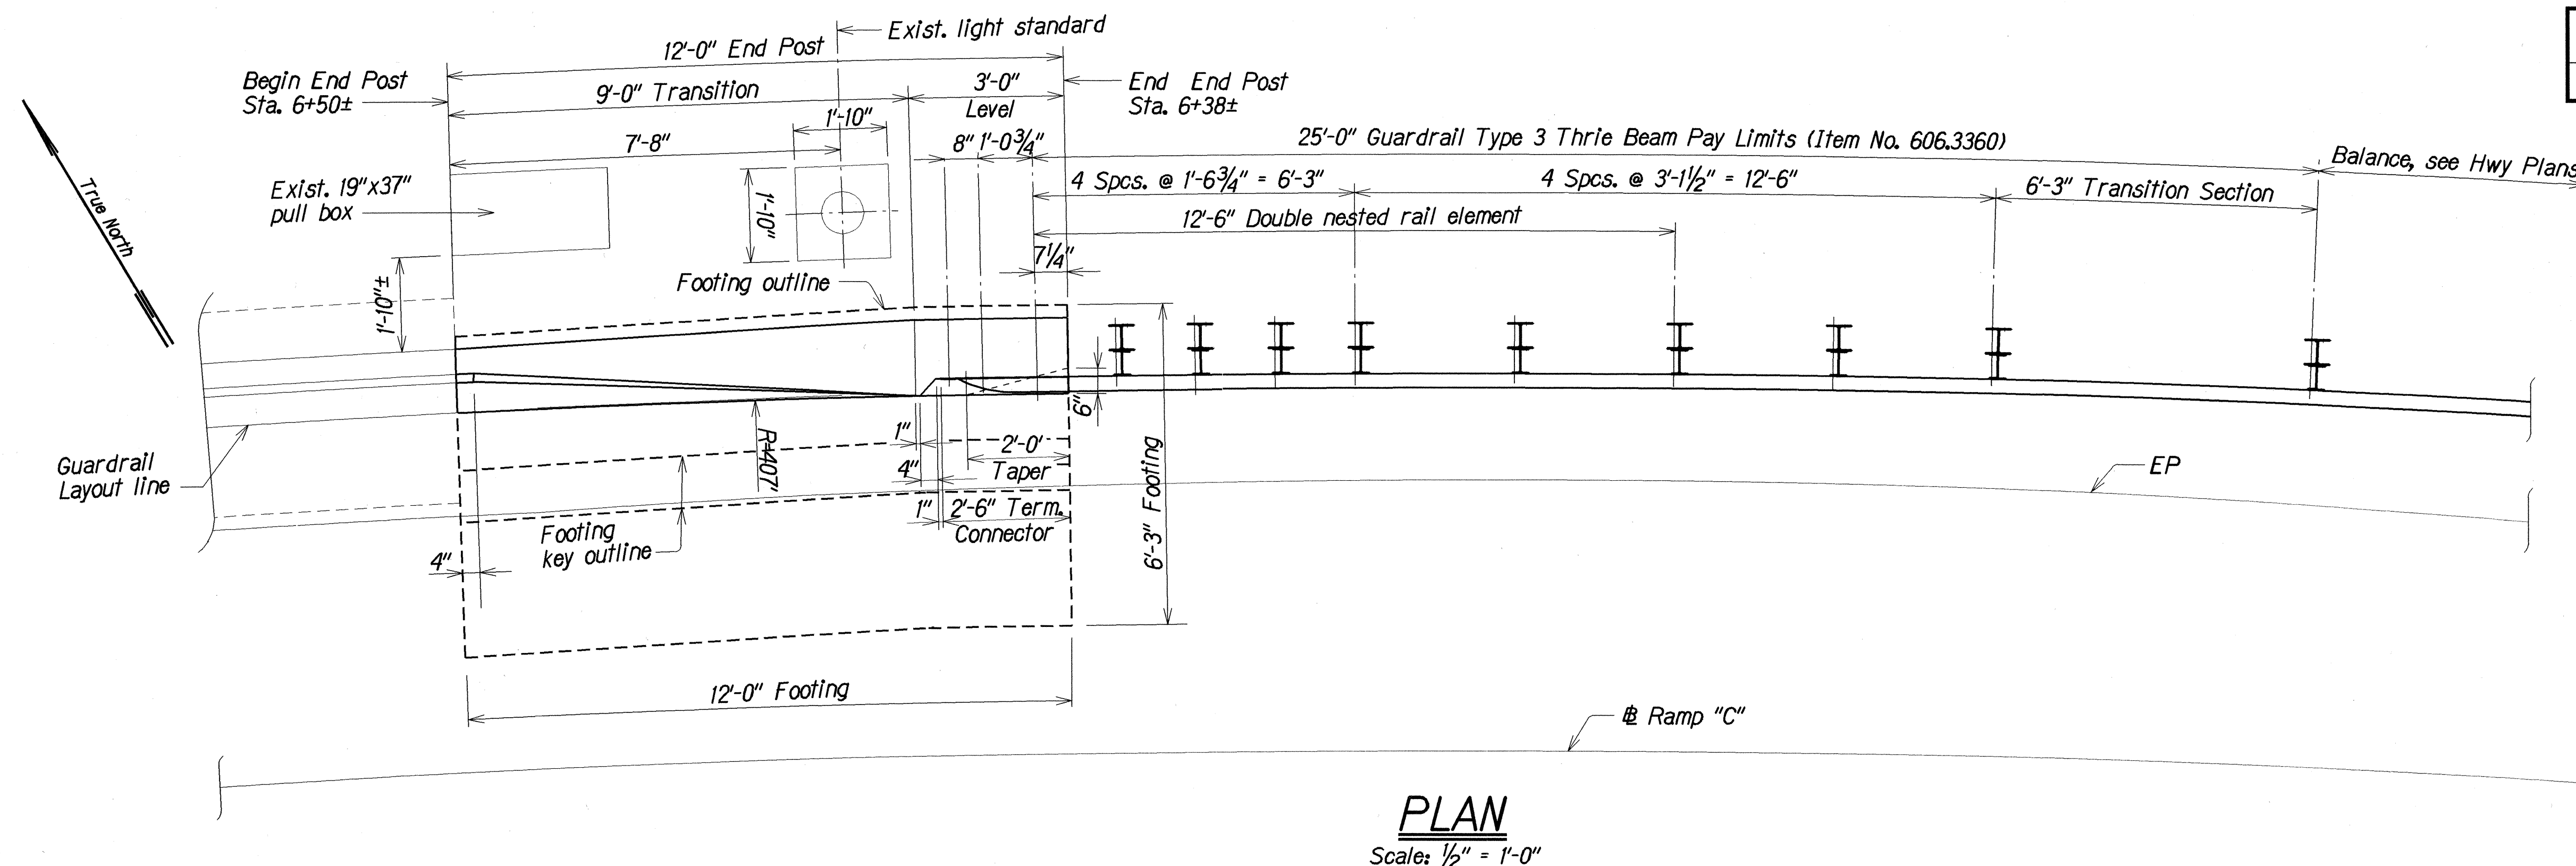

- NOTES:**
1. See Note 1 on Sht. Q2
 2. See Guardrail Notes on Sht. Q4

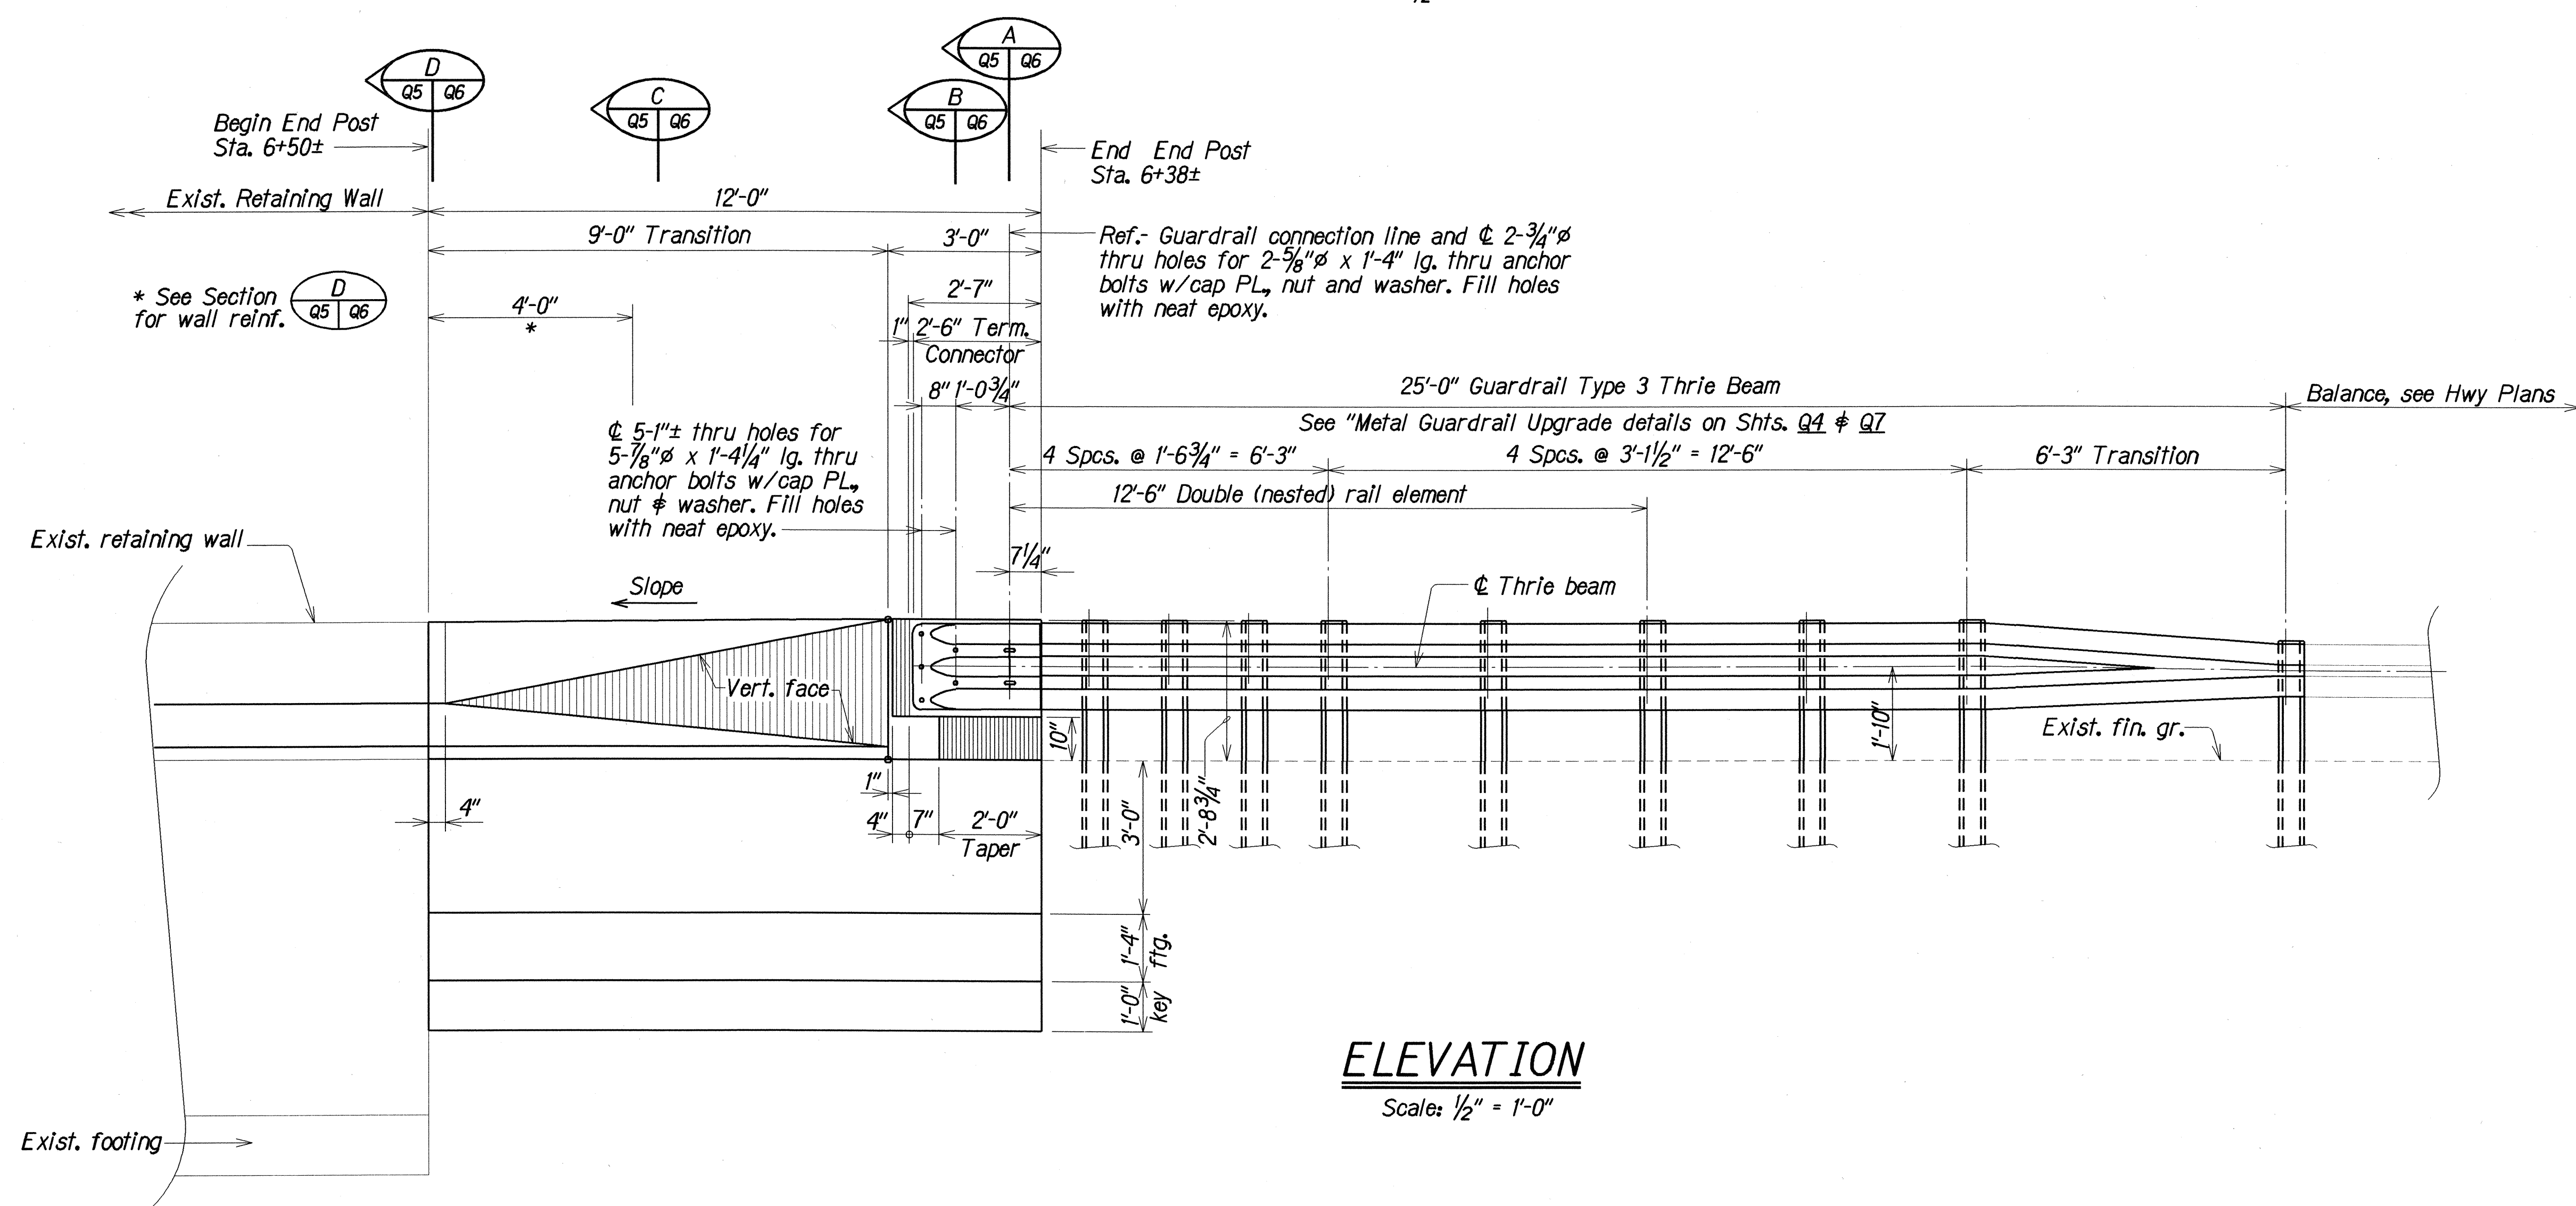

ORIGINAL PLAN	DATE	XXX 1991
DRAWN BY	XXX	
DESIGNED BY	XXX	
CHECKED BY	XXX	
NOTED BY	XXX	
DATE	2/10/01	

STATE OF HAWAII
DEPARTMENT OF TRANSPORTATION
HIGHWAYS DIVISION


PALAILAI INTERCHANGE RAMP "C"


END POST & 25' METAL GUARDRAIL TRANSITION

INTERSTATE ROUTE H-1
PALAILAI INTERCHANGE RECONSTRUCTION
Fed. Aid Project No. 1M-NH-HI-1(239)

Scale: As Noted Date: Apr. 2001

NOTE:


Structure excavation shown thus 

Structure backfill shown thus 

Structure backfill material shall conform to glassphalt base course. See Section 312 of Standard Specifications.

Diagram illustrating the cross-section of a shoulder. The shoulder material is shown as a hatched area. The ordinary backfill is shown as a solid area. The neat cut is indicated by a vertical line. Dimensions are given as 1'-0" for the shoulder width and 1'-0" for the neat cut width.

Not to Scale

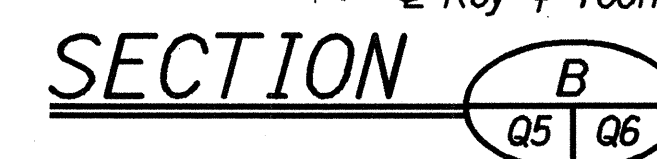

C	
Q5	Q6

Scale: $\frac{3}{4}" = 1'-0"$

STATE OF HAWAII
DEPARTMENT OF TRANSPORTATION
HIGHWAYS DIVISION






PALAILAI INTERCHANGE RAMP "C"
END POST DETAILS
INTERSTATE ROUTE H-1
PALAILAI INTERCHANGE RECONSTRUCTION
Fed. Aid Project No. 1M-NH-HI-1(239)

Scale: As Noted Date: Apr. 2001

SHEET No. 06 OF 7 SHEETS

FED. ROAD DIST. NO.	STATE	FED. AID PROJ. NO.	FISCAL YEAR	SHEET NO.	TOTAL SHEETS
HAWAII	HAW.	1M-NH-HI-1(239)	2001	54	103

NOTES:
1. Bolt length varies and shall be verified in the field.
Dimensions are approximate.

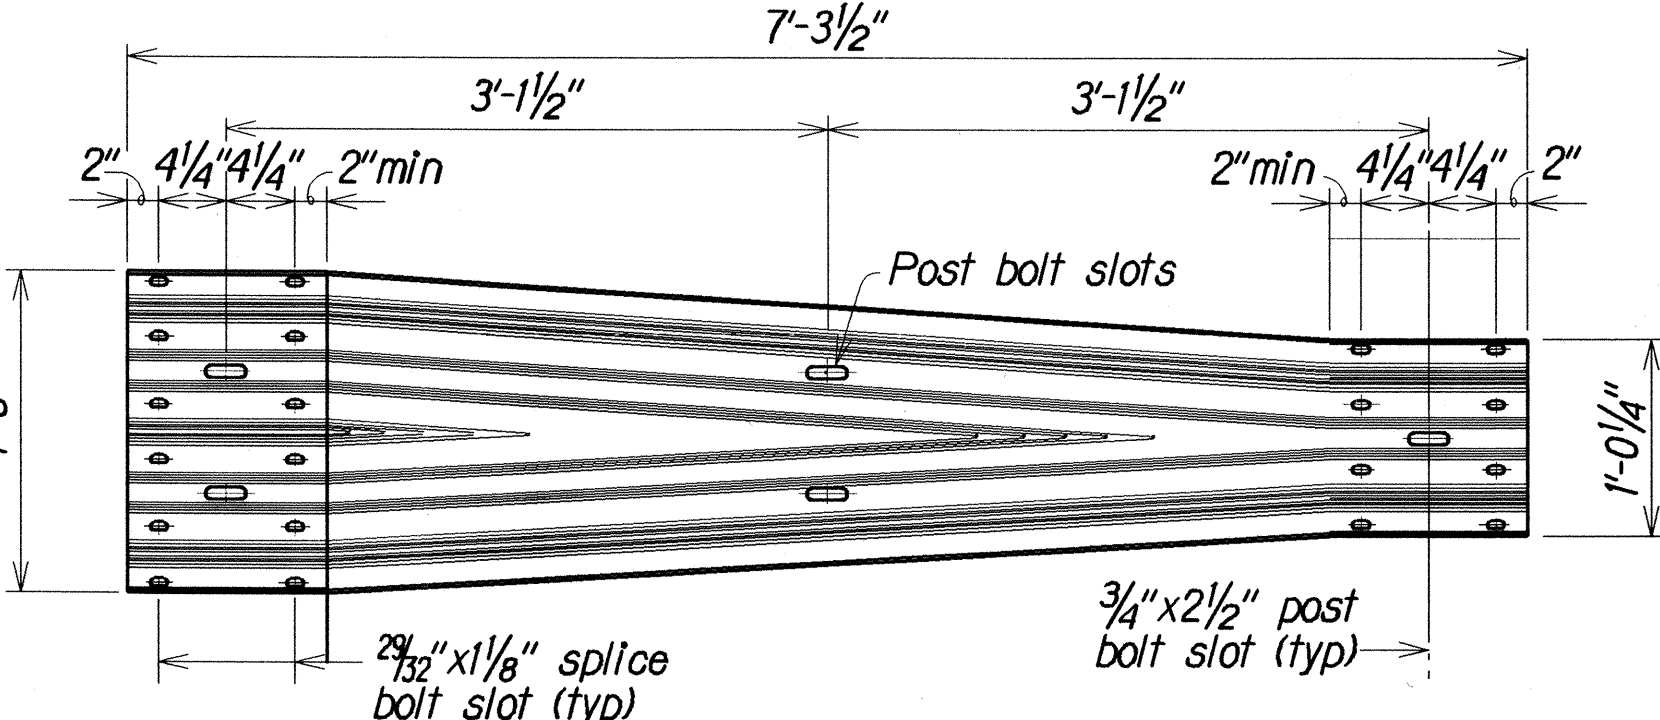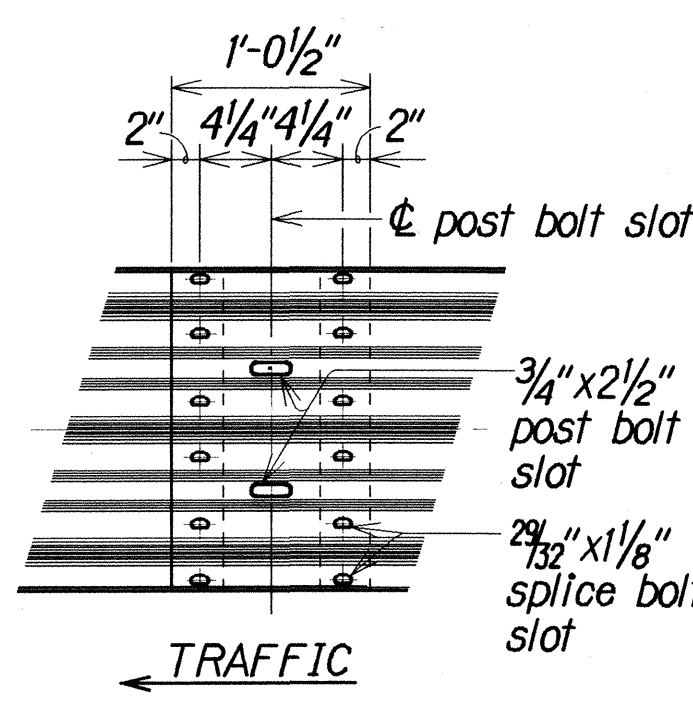
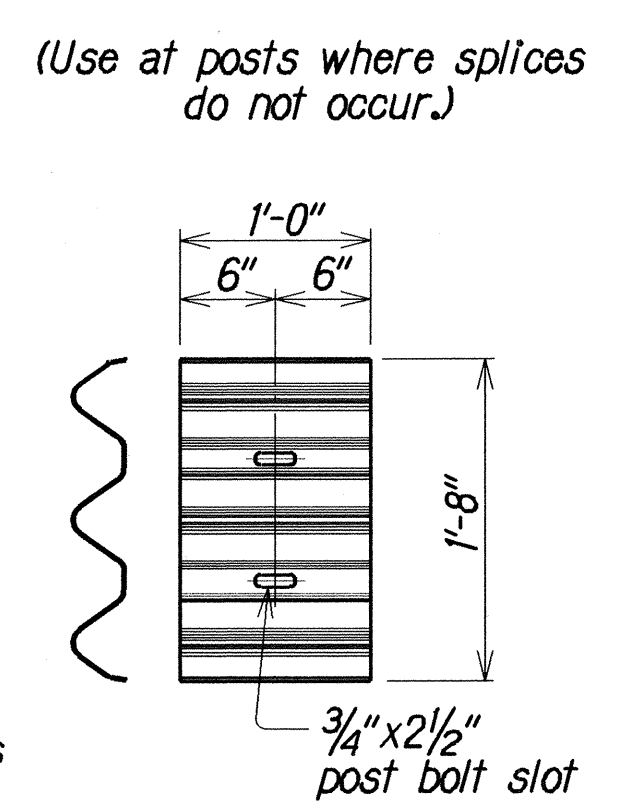
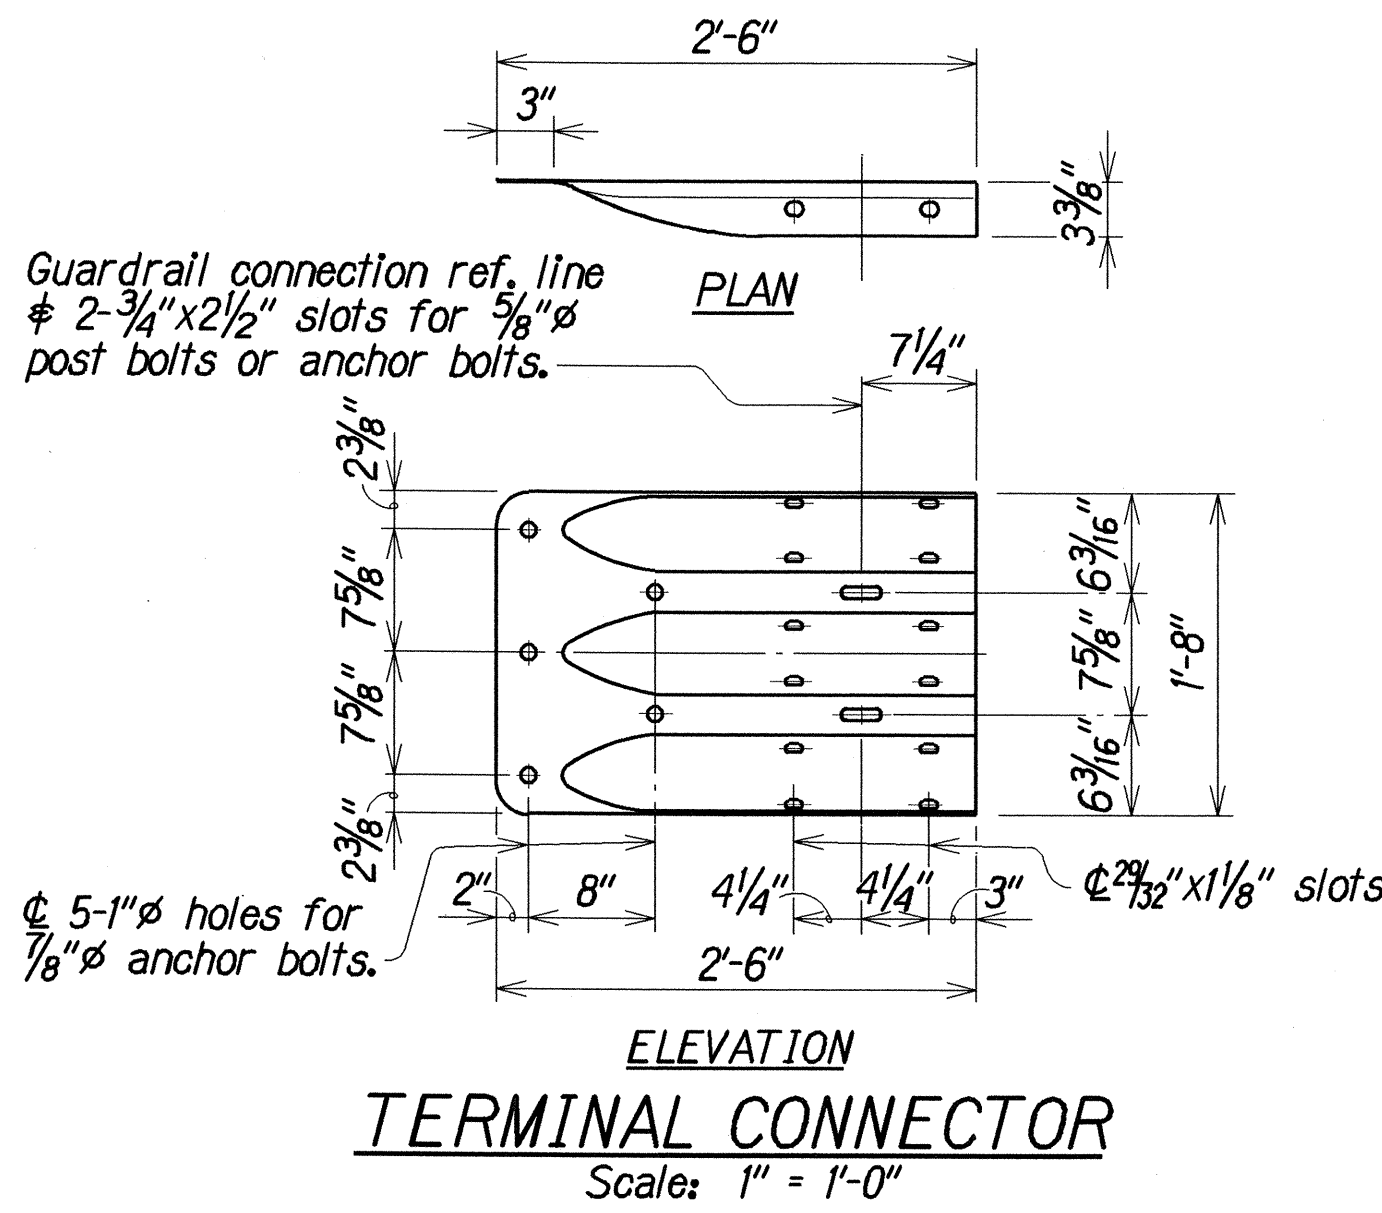
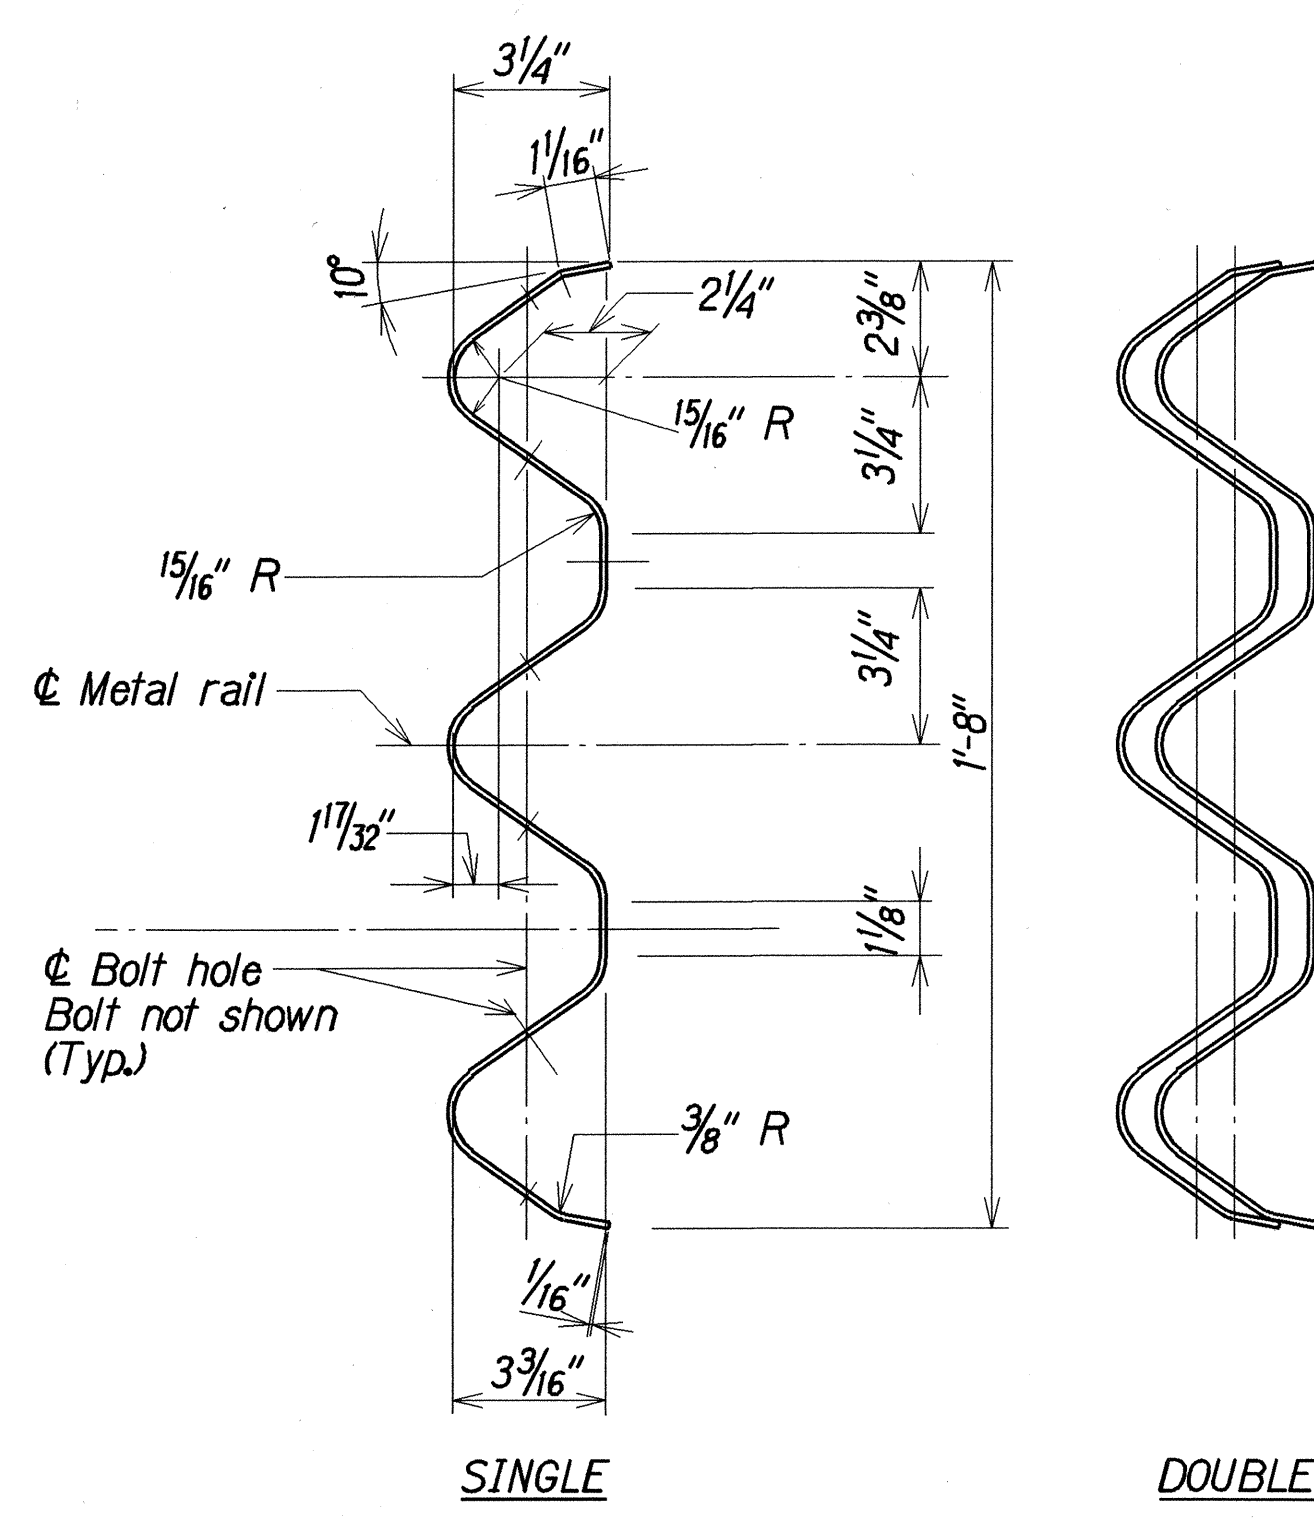


SECTION THRU
RAIL ELEMENT
Scale: 3" = 1'-0"

BACKUP PLATE
Scale: 1" = 1'-0"

RAIL SPLICE
Scale: 1" = 1'-0"

TRANSITION SECTION
Scale: 1" = 1'-0"

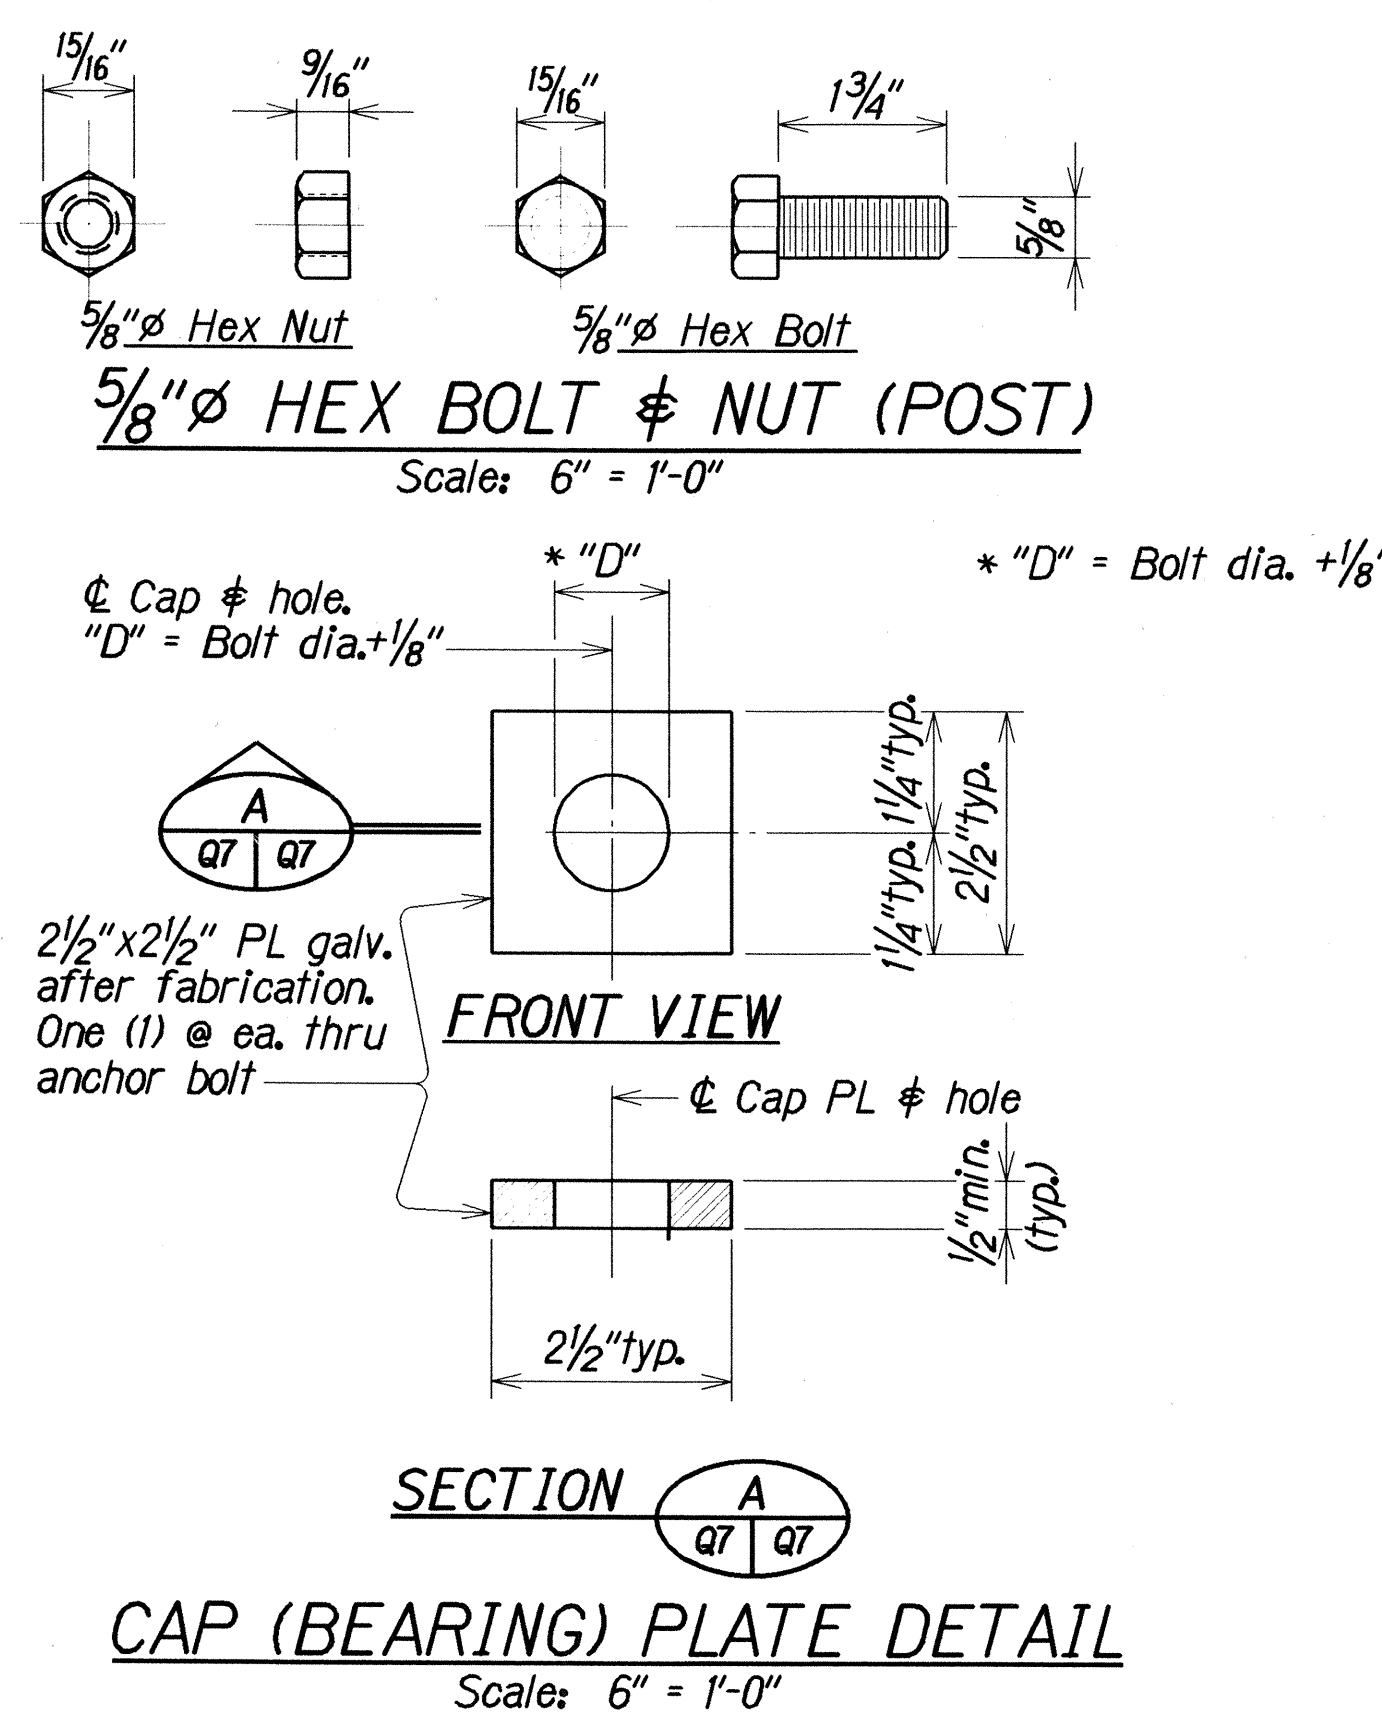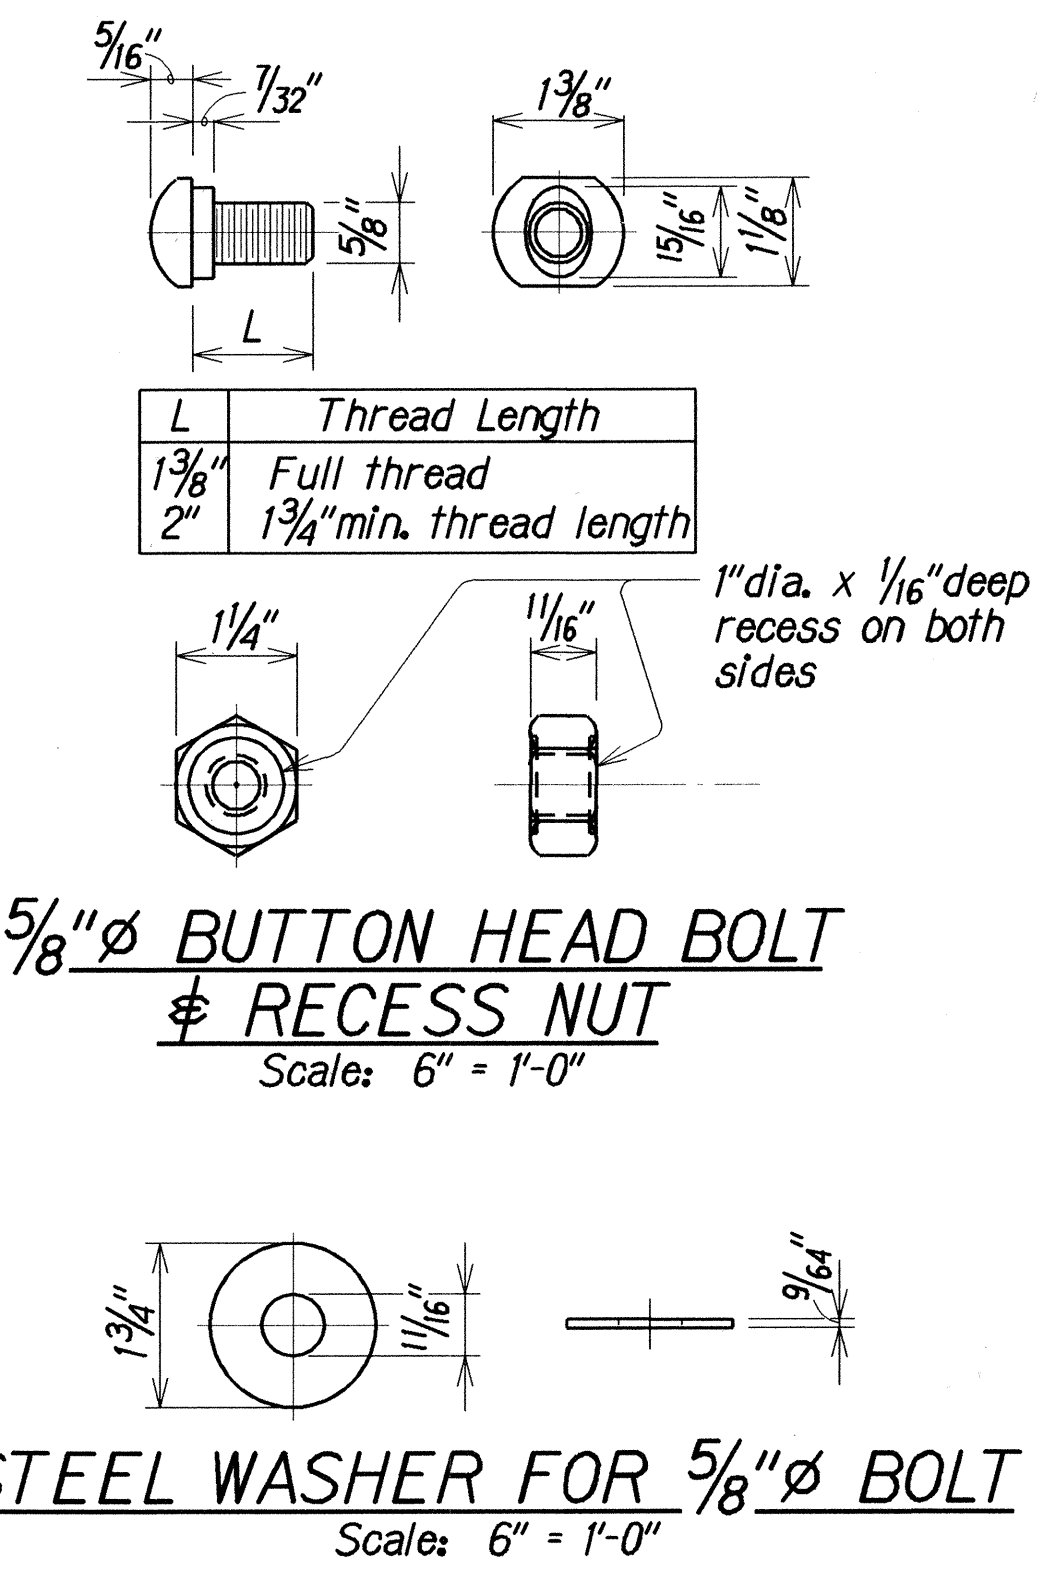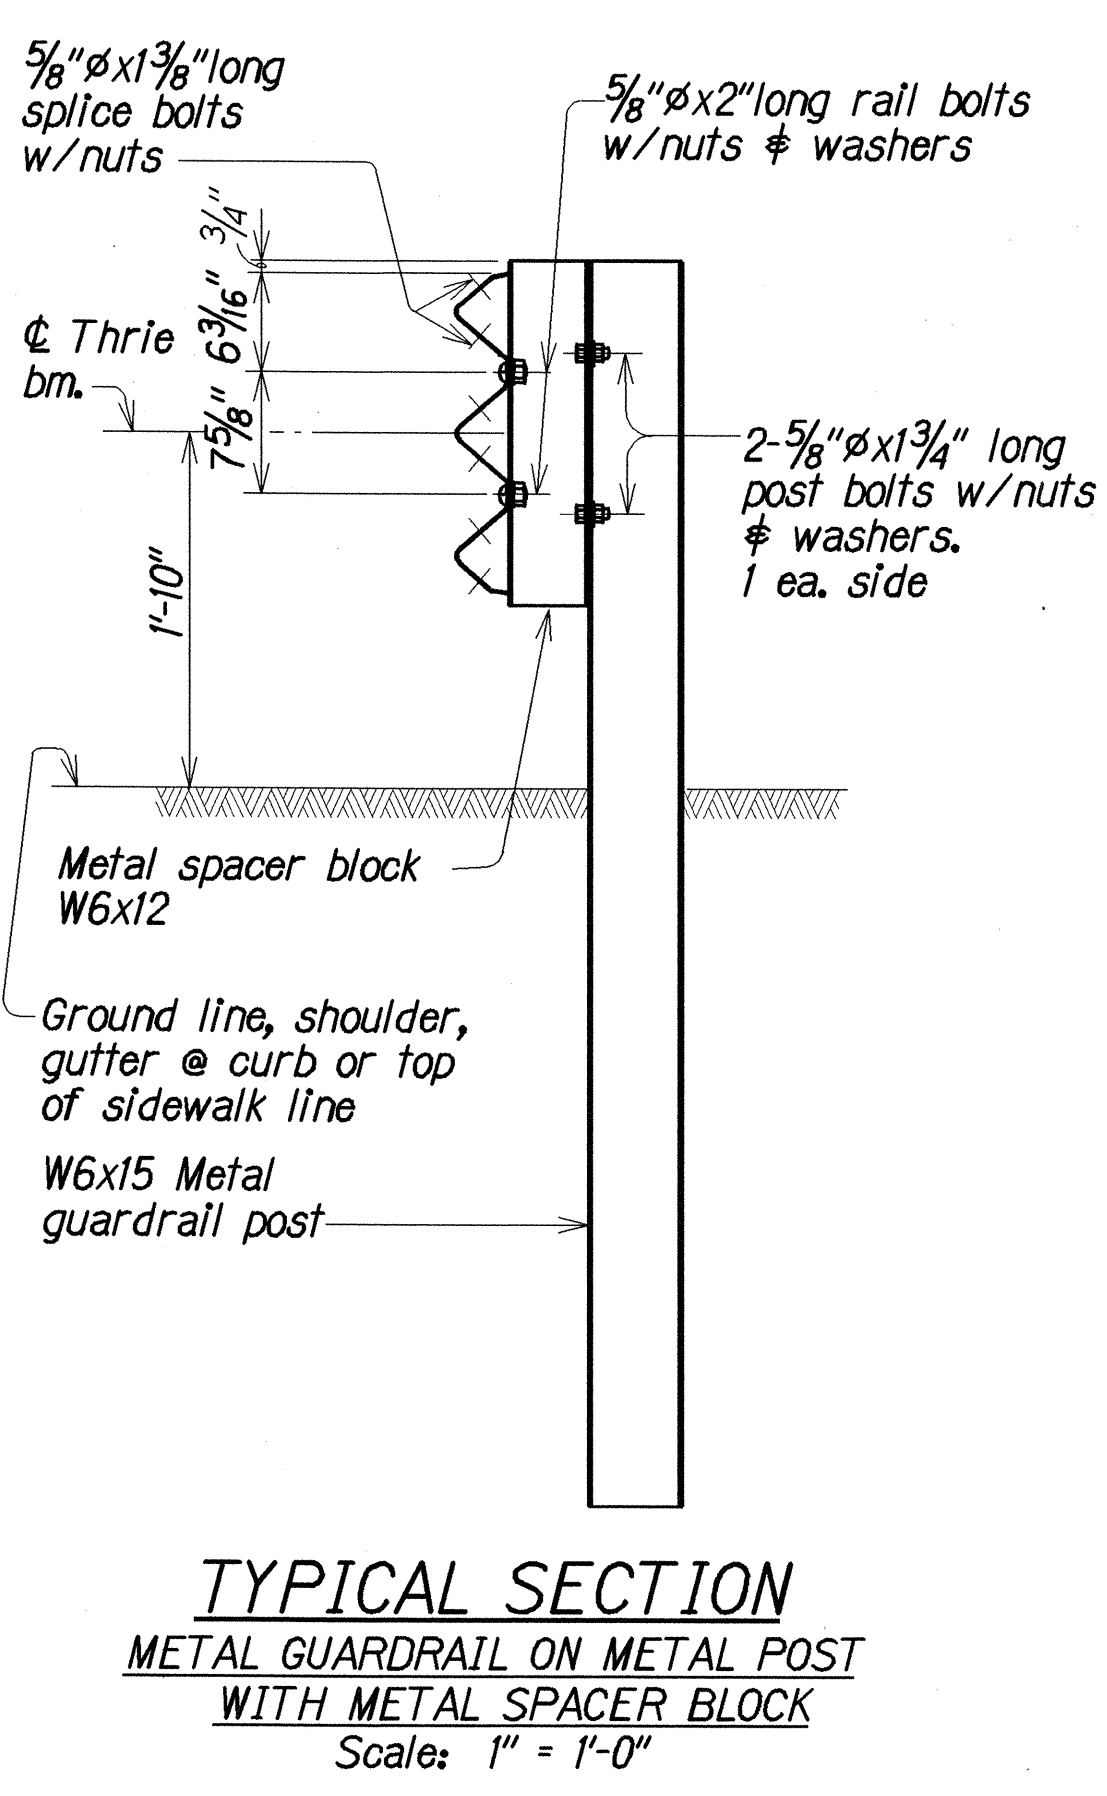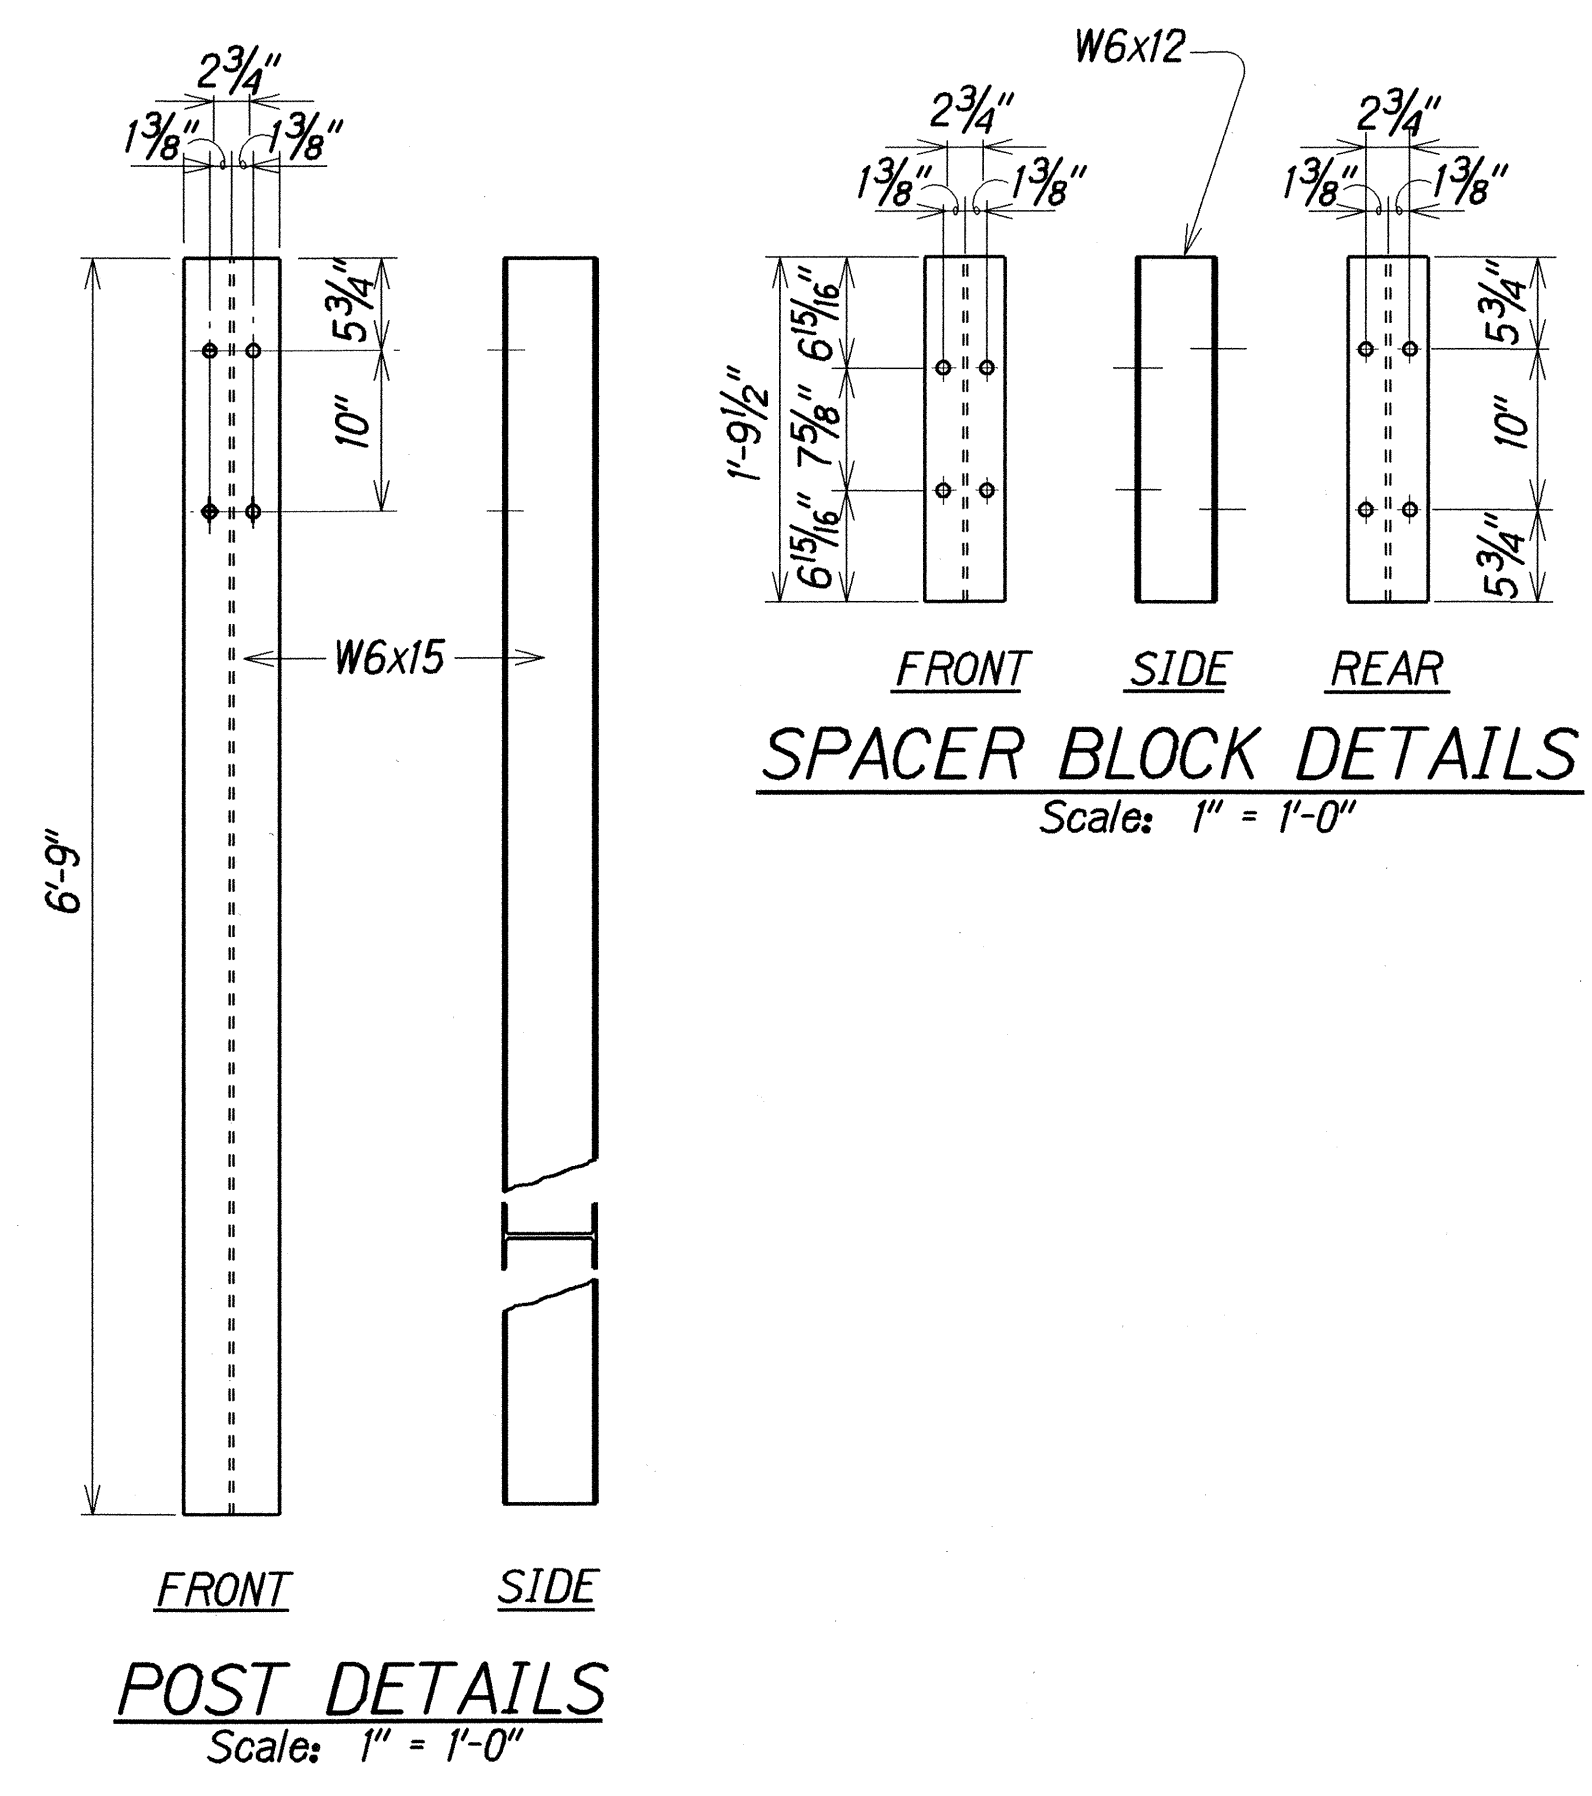

METAL GUARDRAIL TYPE 3 THRIE BEAM AND APPURTENANCES DETAILS

STATE OF HAWAII
DEPARTMENT OF TRANSPORTATION
HIGHWAYS DIVISION

PALILAI INTERCHANGE STRUCTURE
METAL GUARDRAIL TYPE 3 THRIE BEAM
AND APPURTENANCES DETAILS
INTERSTATE ROUTE HI-1
PALILAI INTERCHANGE RECONSTRUCTION
Fed. Aid Project No. 1M-NH-HI-1(239)

Scale: As Noted Date: Apr. 2001

SHEET No. Q7 OF 7 SHEETS