


| INDEX TO DRAWINGS | |
|-------------------|---|
| SHEET NO. | DESCRIPTION |
| 1 | TITLE SHEET |
| 2 | STANDARD PLANS SUMMARY |
| 3 | GENERAL NOTES |
| 4 | END POST INDEX, GENERAL NOTES, ESTIMATED QUANTITIES & ABBREVIATIONS |
| 5 - 7 | END POST UPGRADE LAYOUT PLAN |
| 8 - 32 | END POST UPGRADE |
| ● 33 - 39 | GUARDRAIL UPGRADE & DETAILS |
| 40 - 45 | DRAINAGE PLAN |
| 46 - 56 | DRAINAGE DETAILS |
| 57 - 59 | CONSTRUCTION PHASING NOTES, LEGEND & DETAILS |
| 60 - 73 | CONSTRUCTION PHASING |
| 74 | PAVEMENT MARKING LEGEND & NOTES |
| 75 - 82 | STRIPING PLAN |
| | |
| | |
● Plan Sht. Nos. C.O. 345-1 & C.O. 345-2 are supplementary sheets to this project.
TOTAL SHEET COUNT after "AS-BUILT" postings is 83 sheets.



DESIGNED BY
HWY-TD
CASEY ABE
P. S. & E. BY
692-7680
PHONE
OCT., 1998
DATE

tdl.ruby
8m1st1st1.dgn

STATE OF HAWAII
DEPARTMENT OF TRANSPORTATION
HIGHWAYS DIVISION
HONOLULU, HAWAII
"AS-BUILT"
PLANS FOR
INTERSTATE ROUTE H-1
GUARDRAIL & SHOULDER IMPROVEMENTS
PALEHUA SEPARATION TO WAIKELE BRIDGE
FEDERAL-AID PROJECT NO. IM-H1-1(228)
DISTRICT OF EWA
ISLAND OF OAHU

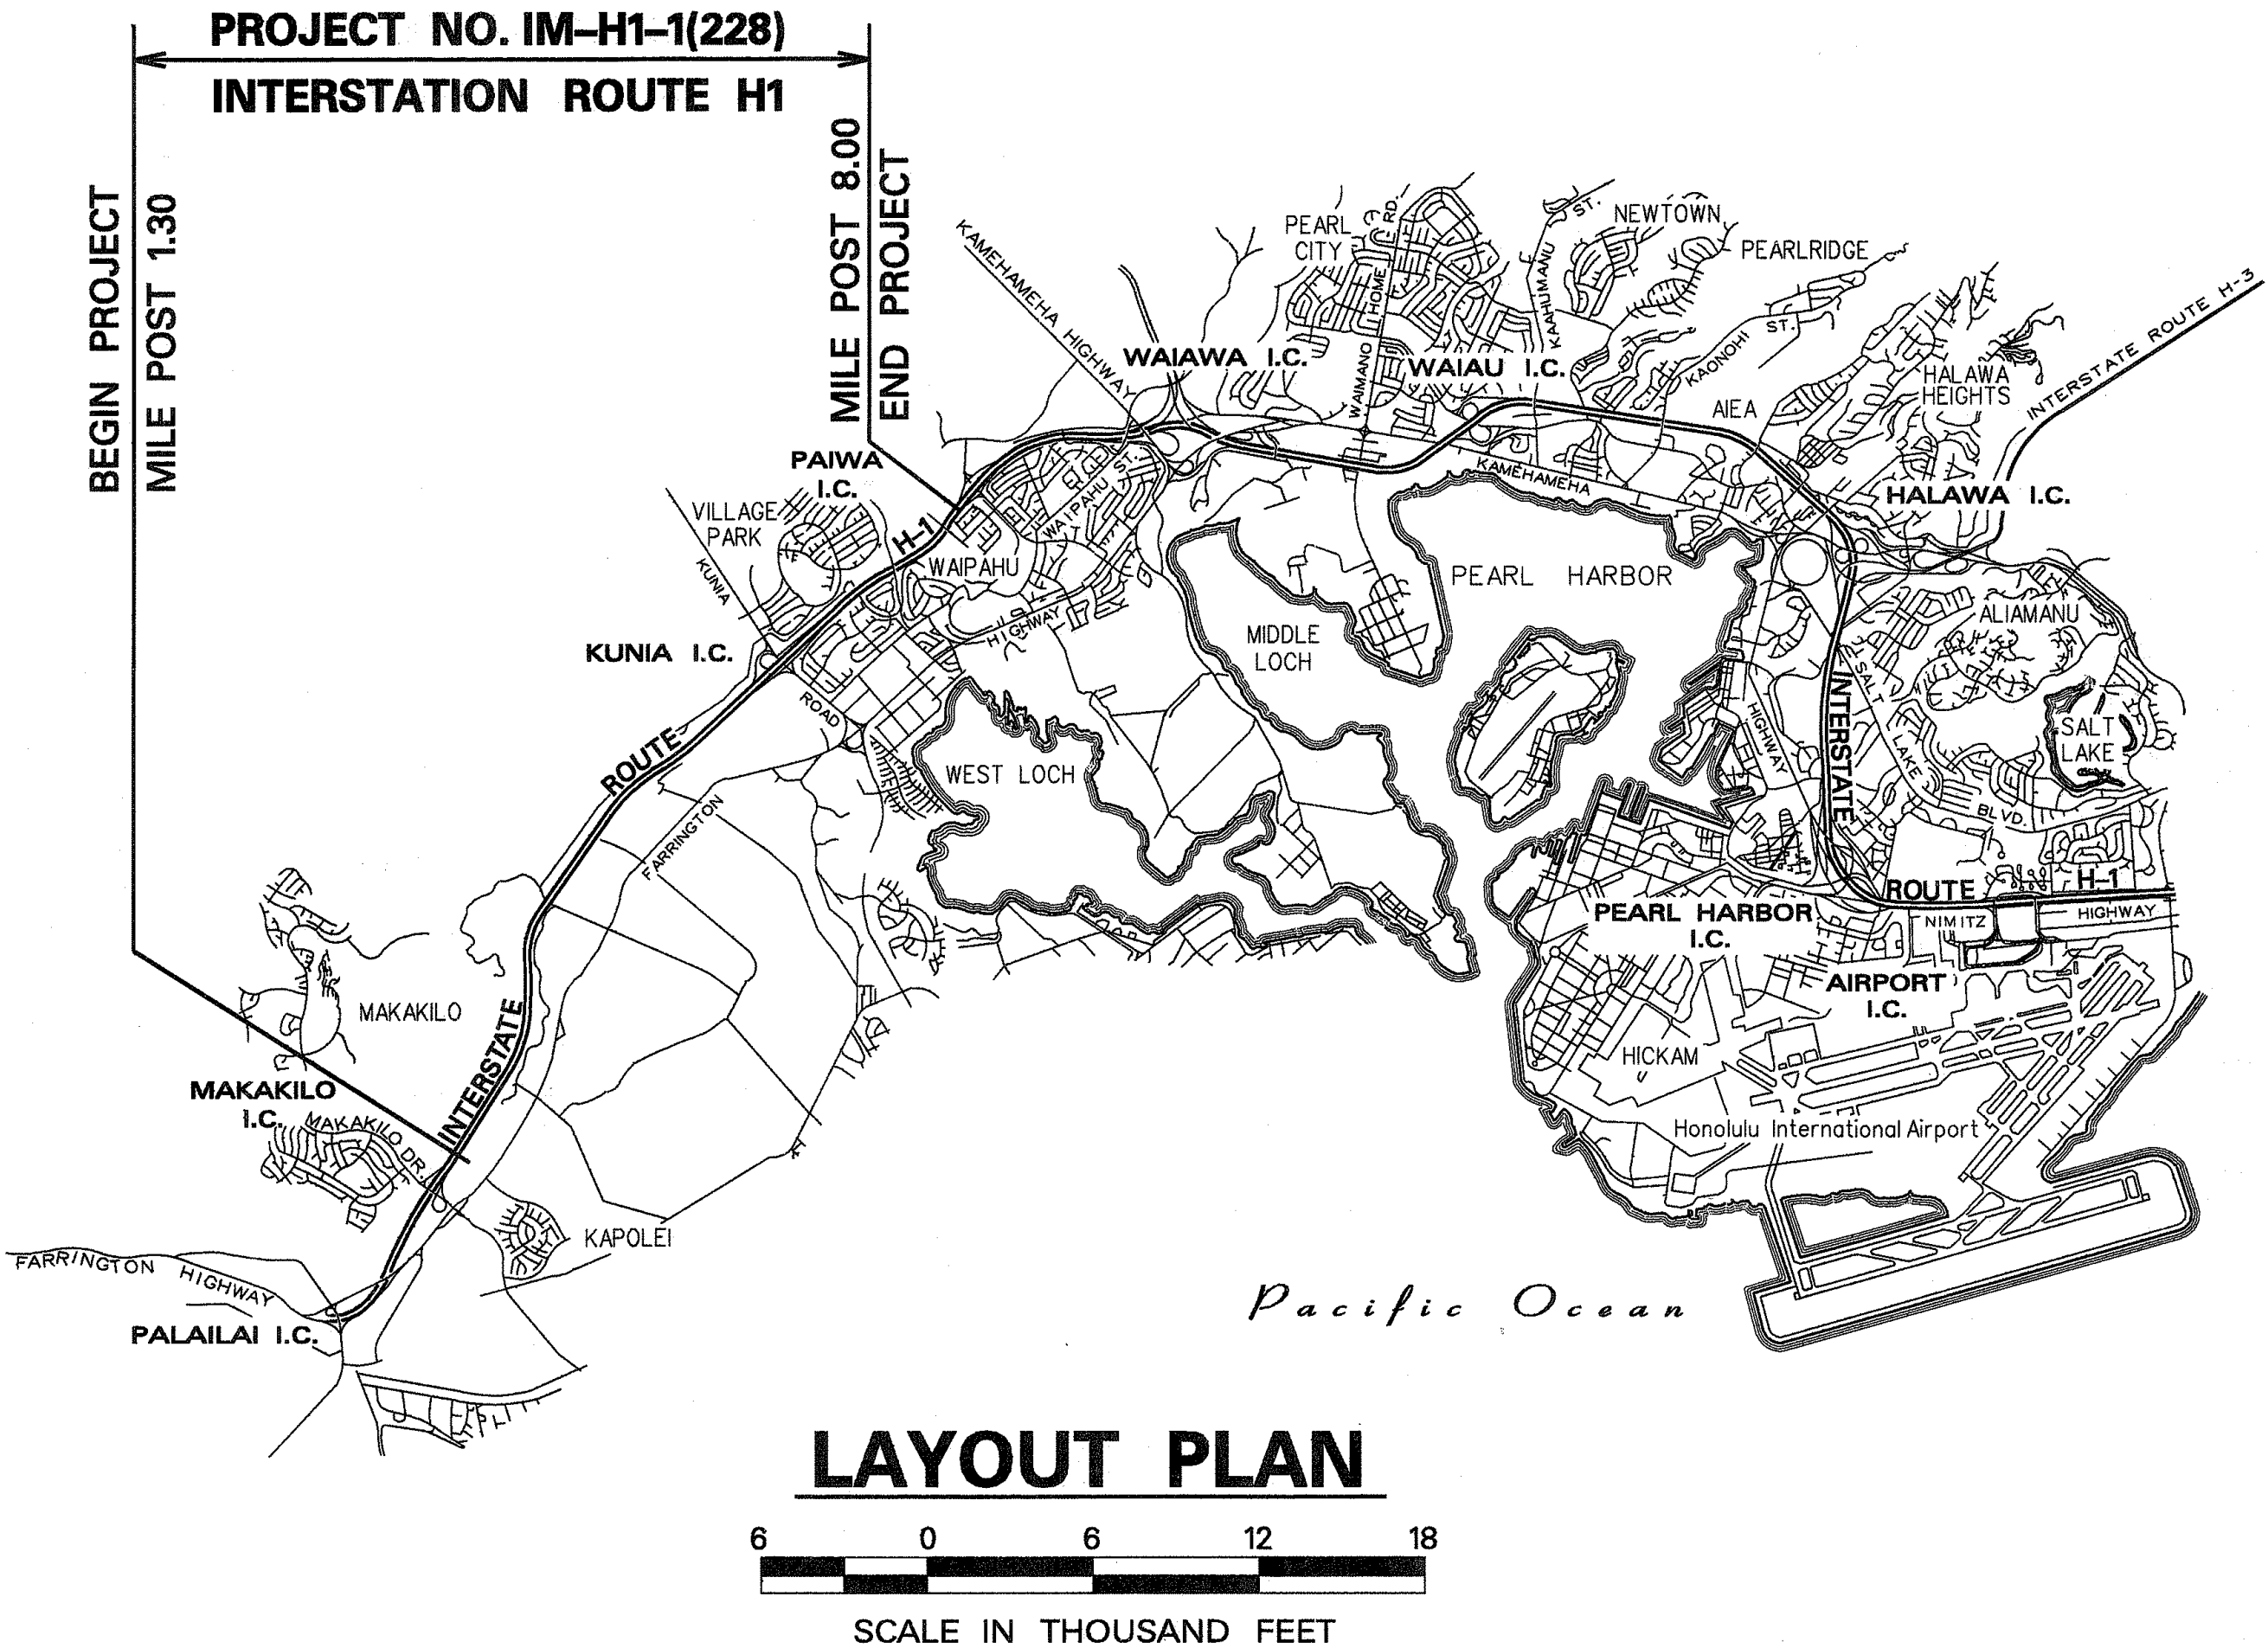

| FED. ROAD DIST. NO. | STATE | FED. AID PROJ. NO. | FISCAL YEAR | SHEET NO. | TOTAL SHEETS |
|---------------------|-------|--------------------|-------------|-----------|--------------|
| HAWAII | HAW. | IM-H1-1(228) | 1999 | 1 | 82 |

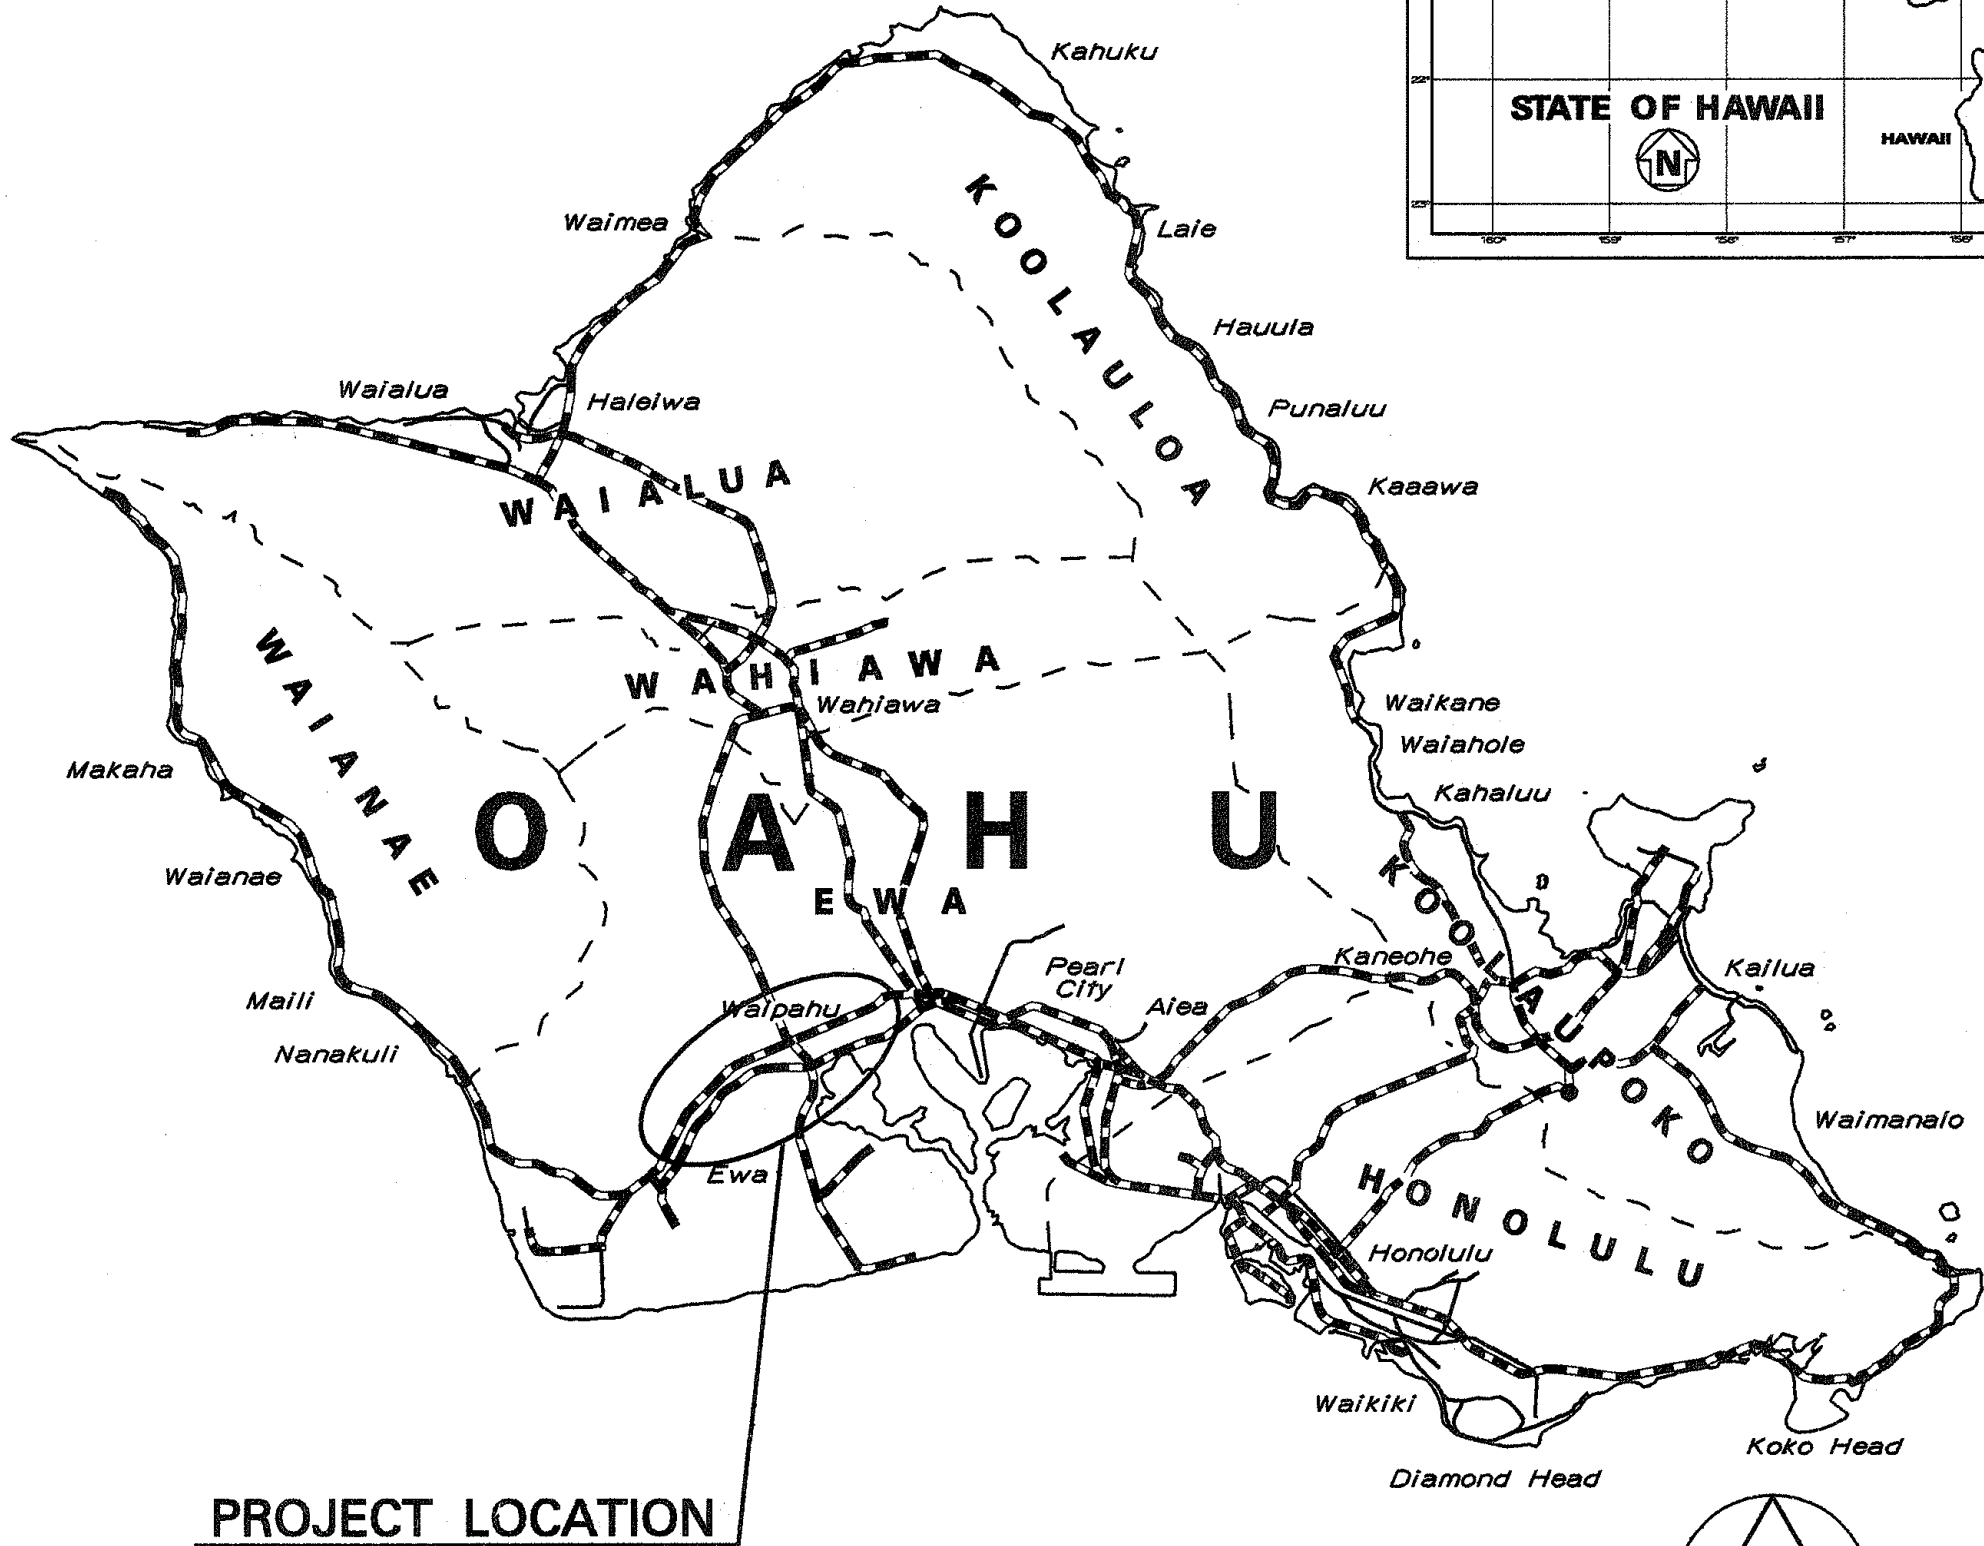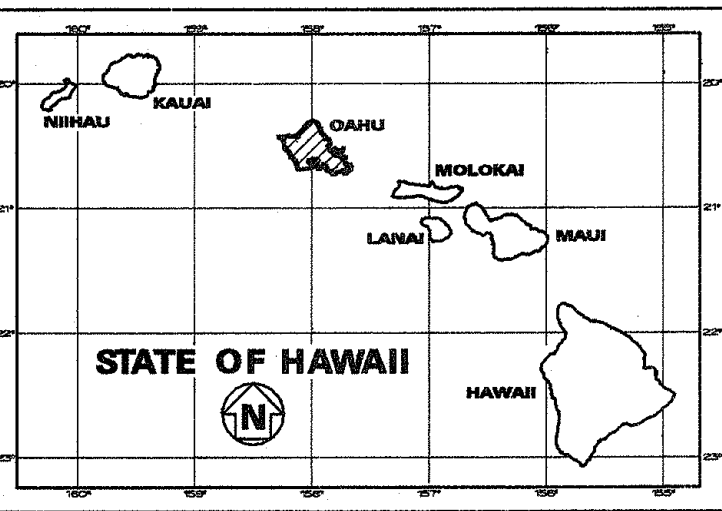

----- FEDERAL AID PROJECTS PREVIOUSLY CONSTRUCTED OR UNDER CONSTRUCTION

MILE POST 1.30 TO MILE POST 8.00

CHANGES MADE DURING CONSTRUCTION HAVE BEEN INCORPORATED ON THESE PLANS EXCEPT CHANGES IN THE ORIGINAL THEORETICAL QUANTITIES. FOR ACTUAL QUANTITIES, REFER TO PROJECT LEDGER AND/OR COMPUTATION BOOK.

RESIDENT ENGINEER
7/1/99
DATE

DEPARTMENT OF TRANSPORTATION
STATE OF HAWAII
APPROVED:
Dir. of Transportation
7/22/99
DATE