

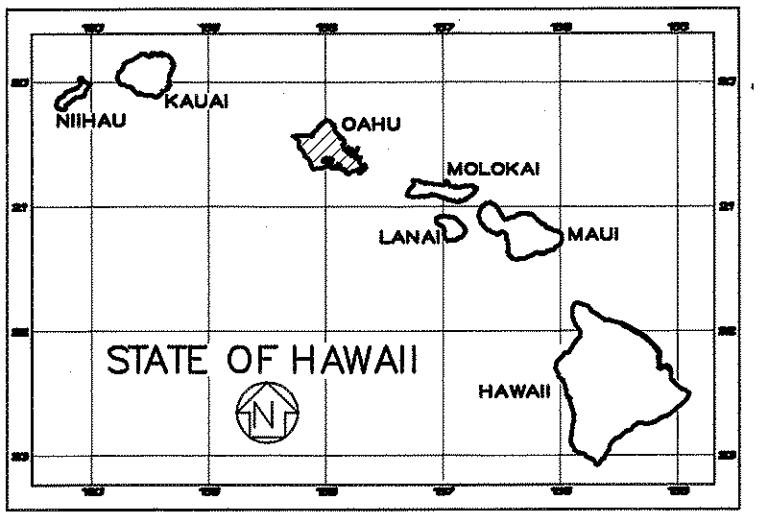
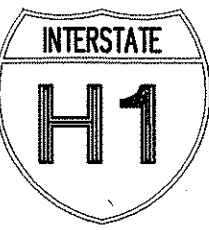


FED. ROAD DIST. NO.	STATE	FED. AID PROJ. NO.	FISCAL YEAR	SHEET NO.	TOTAL SHEETS
HAWAII	HAW.	BR-H1-1(227)	1998	1	13

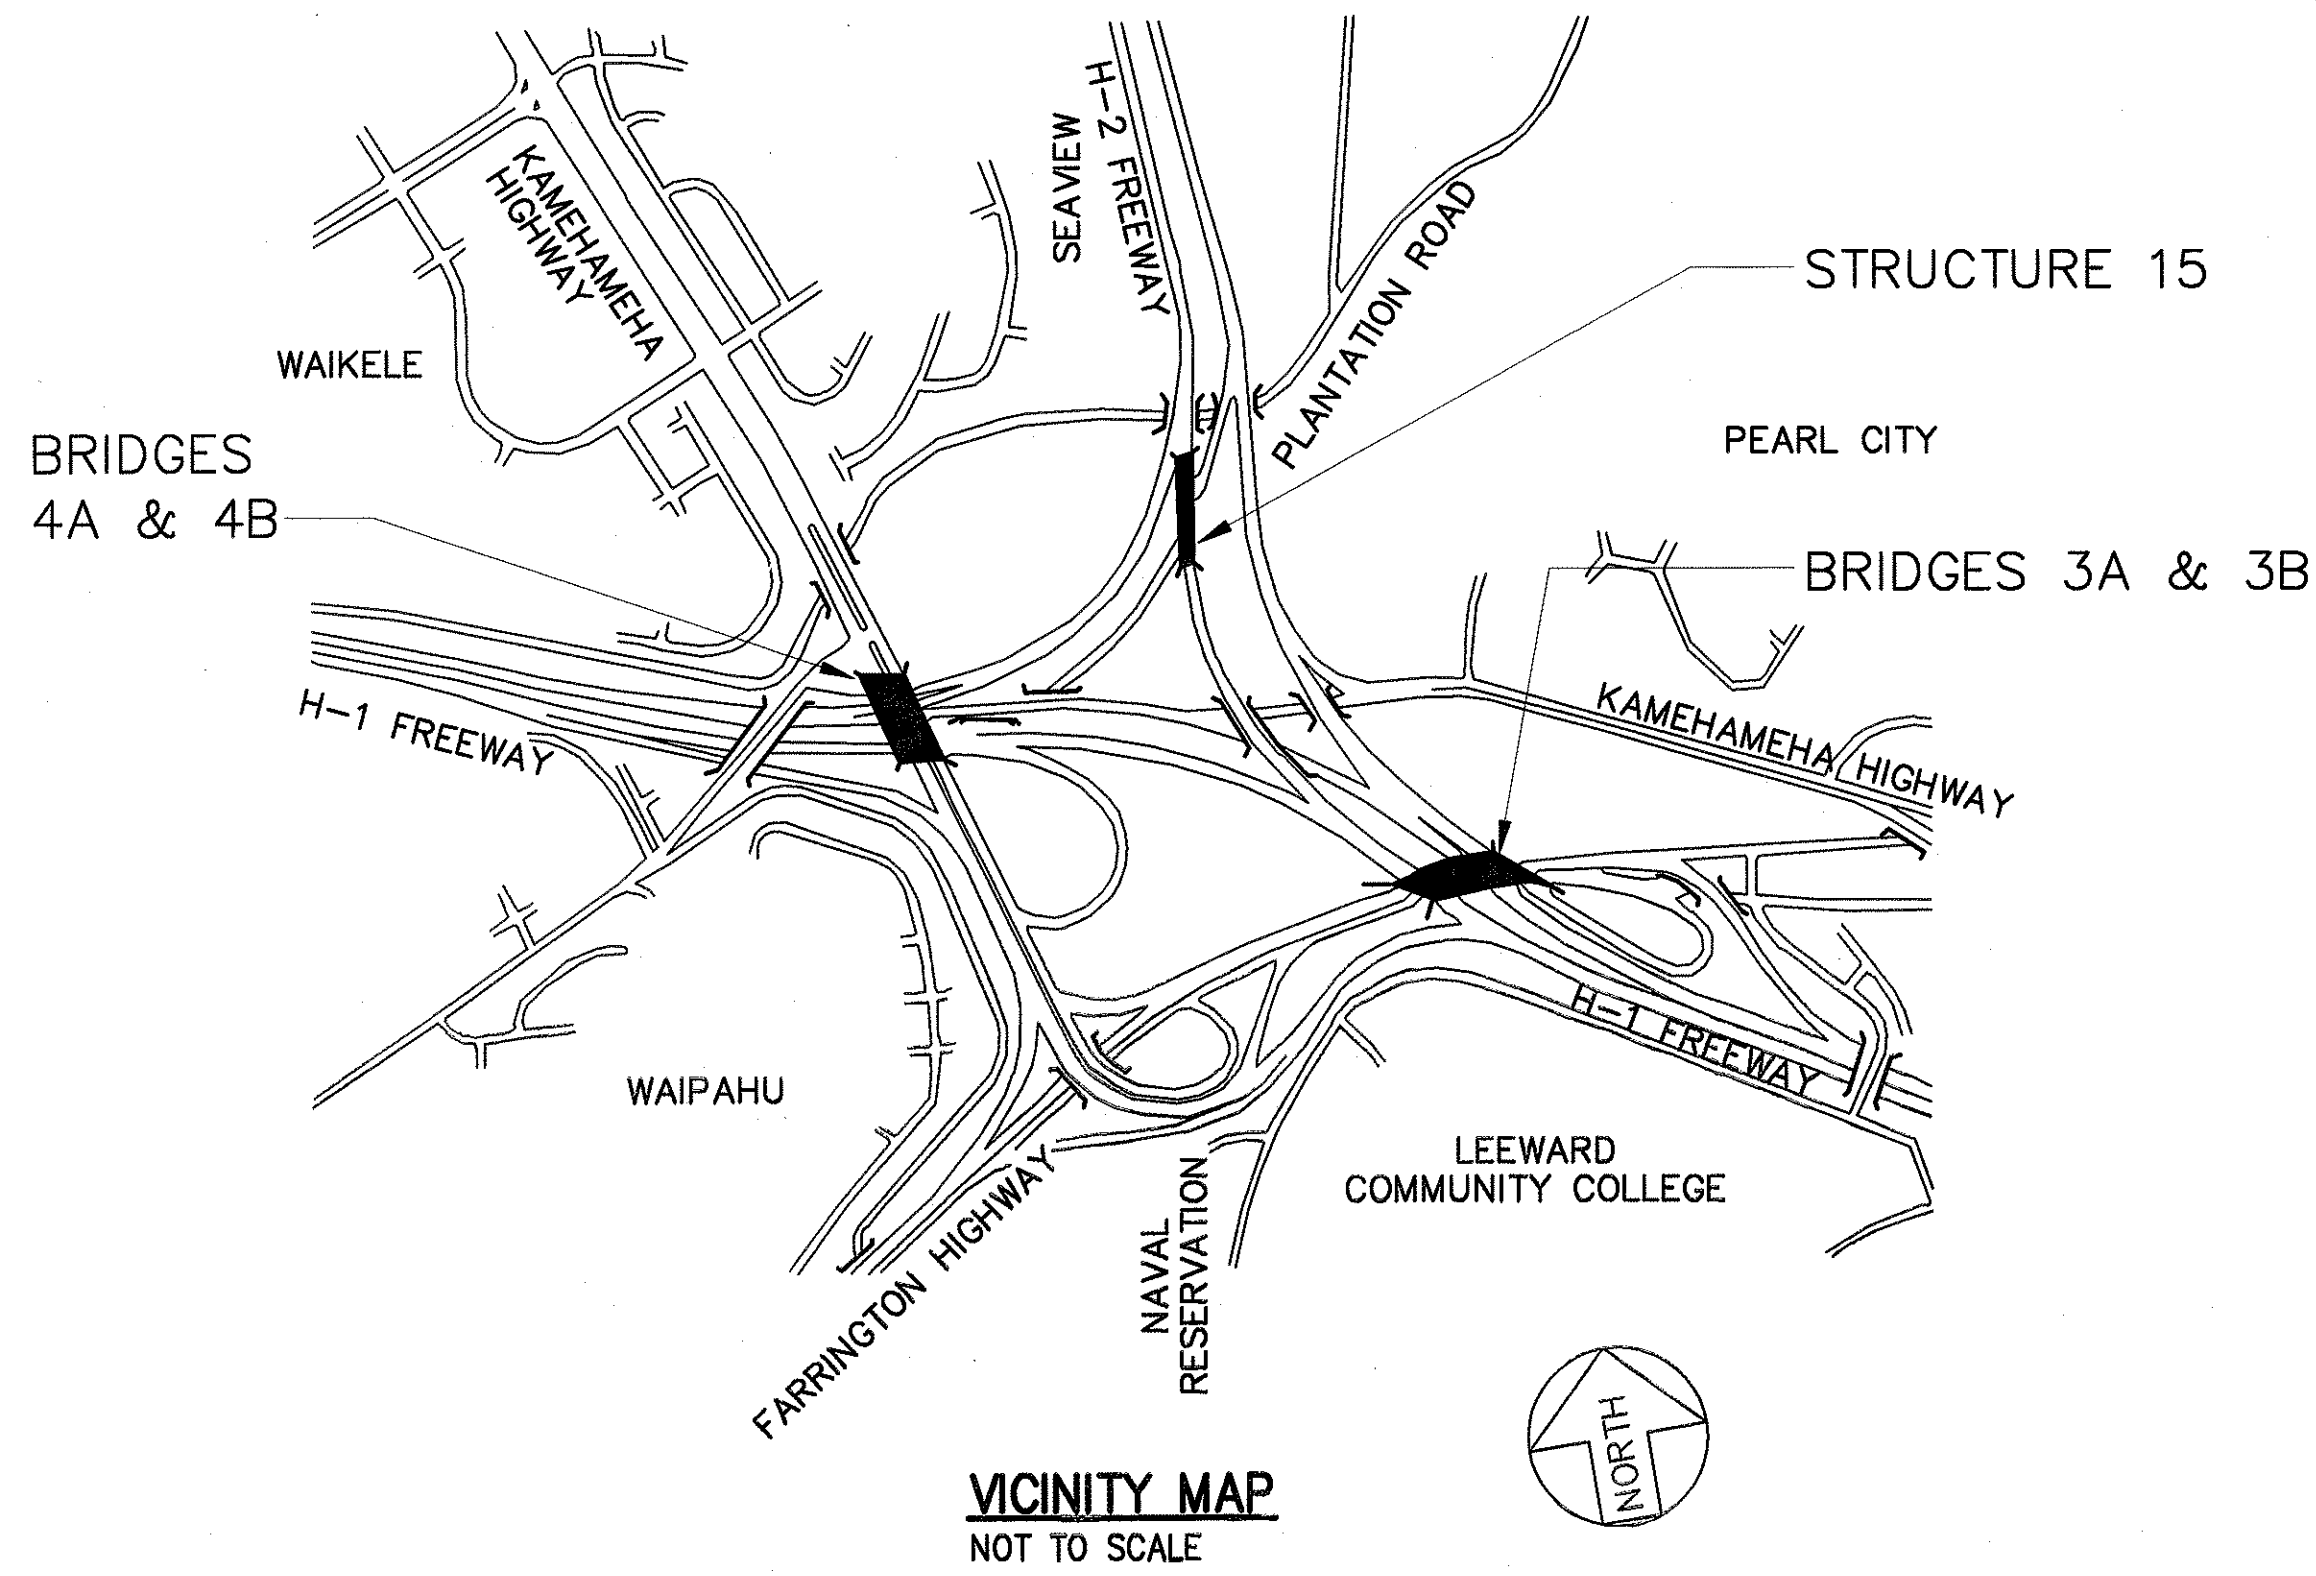

INDEX TO DRAWINGS	
SHT. NO.	DESCRIPTION
1	TITLE SHEET
2	STANDARD PLANS SUMMARY
3	GENERAL NOTES
4	BRIDGES 3A/3B - PLAN
5	BRIDGES 3A/3B - LONGITUDINAL SECTIONS
6	BRIDGES 4A/4B - PLAN AND LONGITUDINAL SECTION
7	STRUCTURE 15 - PLAN AND LONGITUDINAL SECTION
8	BRIDGES 3A/3B - RETROFIT DETAILS
9	BRIDGES 4A/4B - RETROFIT DETAILS
10	STRUCTURE 15 - RETROFIT DETAILS
11	STRUCTURE 15 - RETROFIT DETAILS
12	CABLE RESTRAINER DETAILS
13	CABLE RESTRAINER DETAILS AND ACCESS OPN'G. DETAILS

STATE OF HAWAII
DEPARTMENT OF TRANSPORTATION
HIGHWAYS DIVISION
HONOLULU, HAWAII
"AS-BUILT"
PLANS FOR
INTERSTATE ROUTE H-1
SEISMIC RETROFIT, WAIAWA INTERCHANGE
FEDERAL AID INTERSTATE PROJECT NO. BR-H1-1(227)
DISTRICT OF EWA
ISLAND OF OAHU

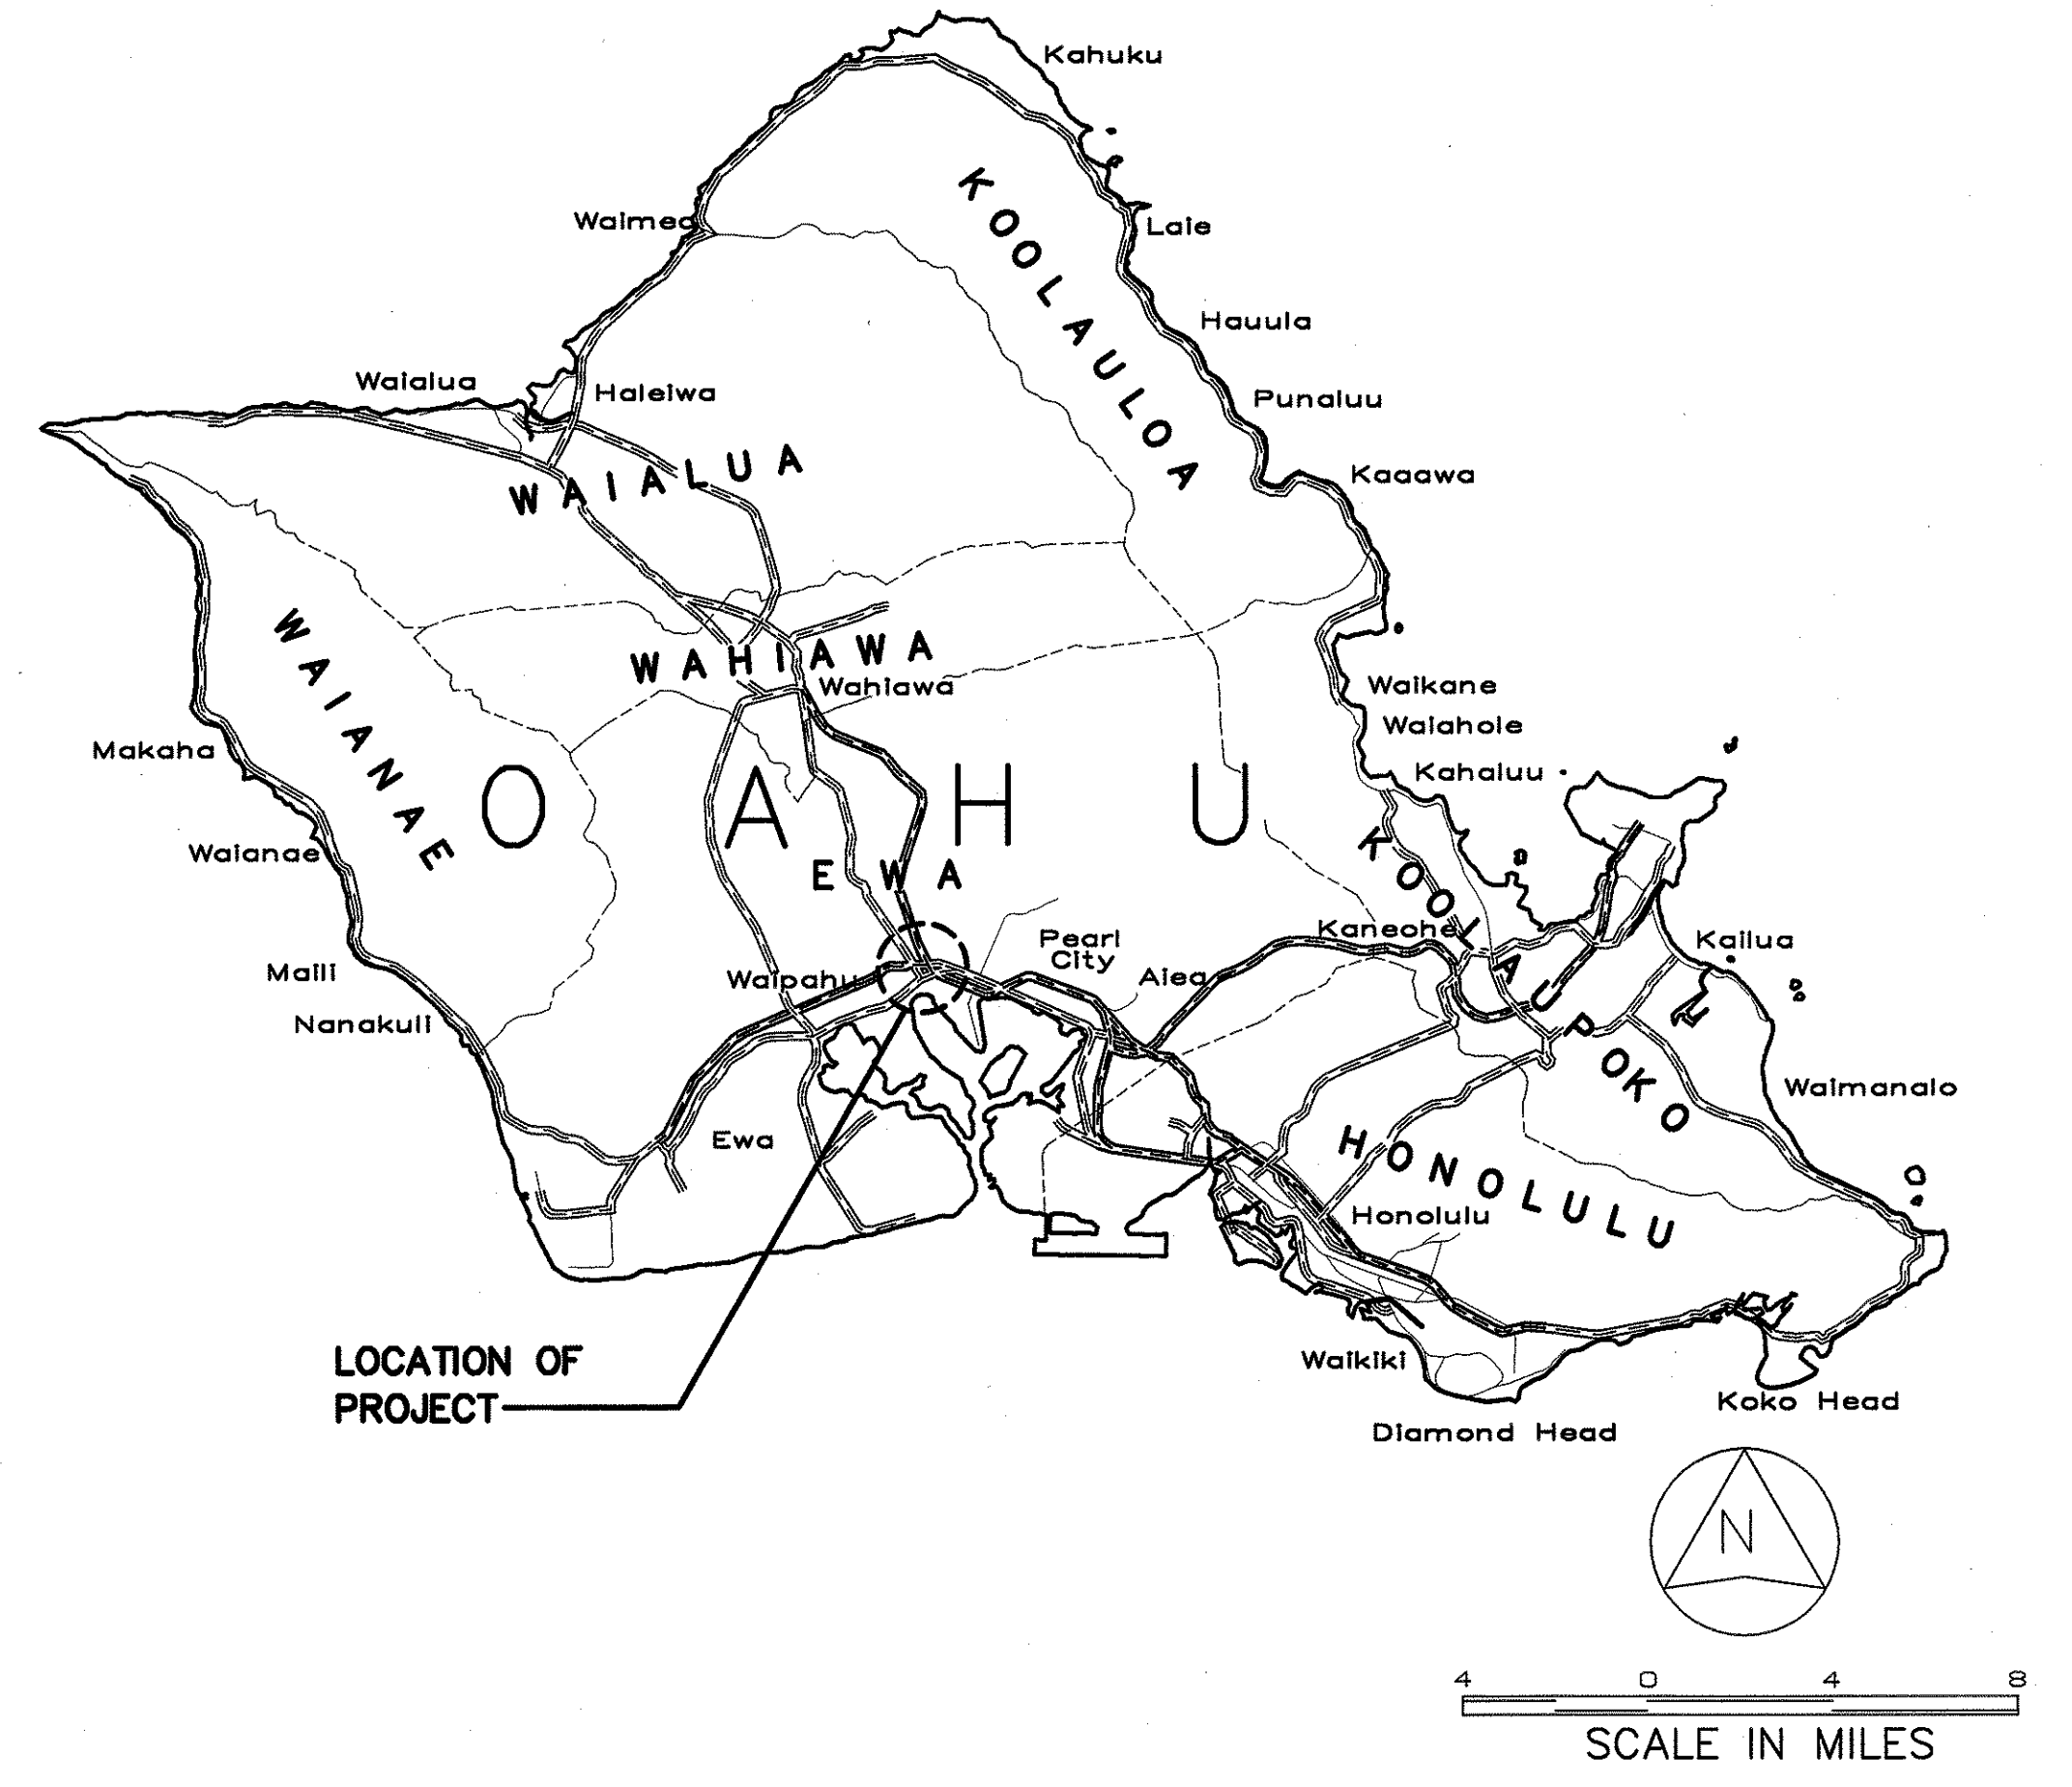

FEDERAL AID PROJECTS PREVIOUSLY CONSTRUCTED OR UNDER CONSTRUCTION				
BRIDGE	3A	MILE POST	8.75	(H-1)
BRIDGE	3B	MILE POST	8.77	(H-1)
BRIDGE	4A	MILE POST	16.87	(KAM. HWY. ROUTE 99)
BRIDGE	4B	MILE POST	16.87	(KAM. HWY. ROUTE 99)
STRUCTURE	15	MILE POST	0.24	(H-2)

CHANGES MADE DURING CONSTRUCTION HAVE BEEN INCORPORATED ON THESE PLANS EXCEPT CHANGES IN THE ORIGINAL THEORETICAL QUANTITIES. FOR ACTUAL QUANTITIES, REFER TO PROJECT LEDGER AND/OR COMPUTATION BOOK.

DEPARTMENT OF TRANSPORTATION
STATE OF HAWAII
APPROVED: *[Signature]* 3/20/98
DIR. OF TRANSPORTATION DATE

ORIGINAL PLAN	DATE
DESIGNED BY	
CHECKED BY	
NO.	

SSFM ENGINEERS, INC. E. BARROGA, JR. 587-2123 MARCH 1998
DESIGNED BY P. S. & E. BY PHONE DATE