

INDEX TO DRAWINGS	
SHEET NO.	DESCRIPTION
1	TITLE SHEET
2-19	ARCHITECTURAL DRAWINGS
20-21	STRUCTURAL DRAWINGS
22-31	MECHANICAL DRAWINGS
32-40	ELECTRICAL DRAWINGS

FED. ROAD DIST. NO.	STATE	PROJ. NO.	FISCAL YEAR	SHEET NO.	TOTAL SHEETS
HAWAII	HAW.	H11-01-99	2000	1	40

STATE OF HAWAII





DEPARTMENT OF TRANSPORTATION

HIGHWAYS DIVISION  
HONOLULU, HAWAII

"AS-BUILT"  
PLANS FOR

INTERSTATE ROUTE H-1  
PUNAHOU ST. OFF-RAMP NOISE ABATEMENT

PROJECT NO. H11-01-99  
DISTRICT OF HONOLULU  
ISLAND OF OAHU

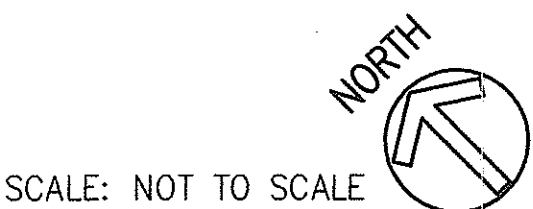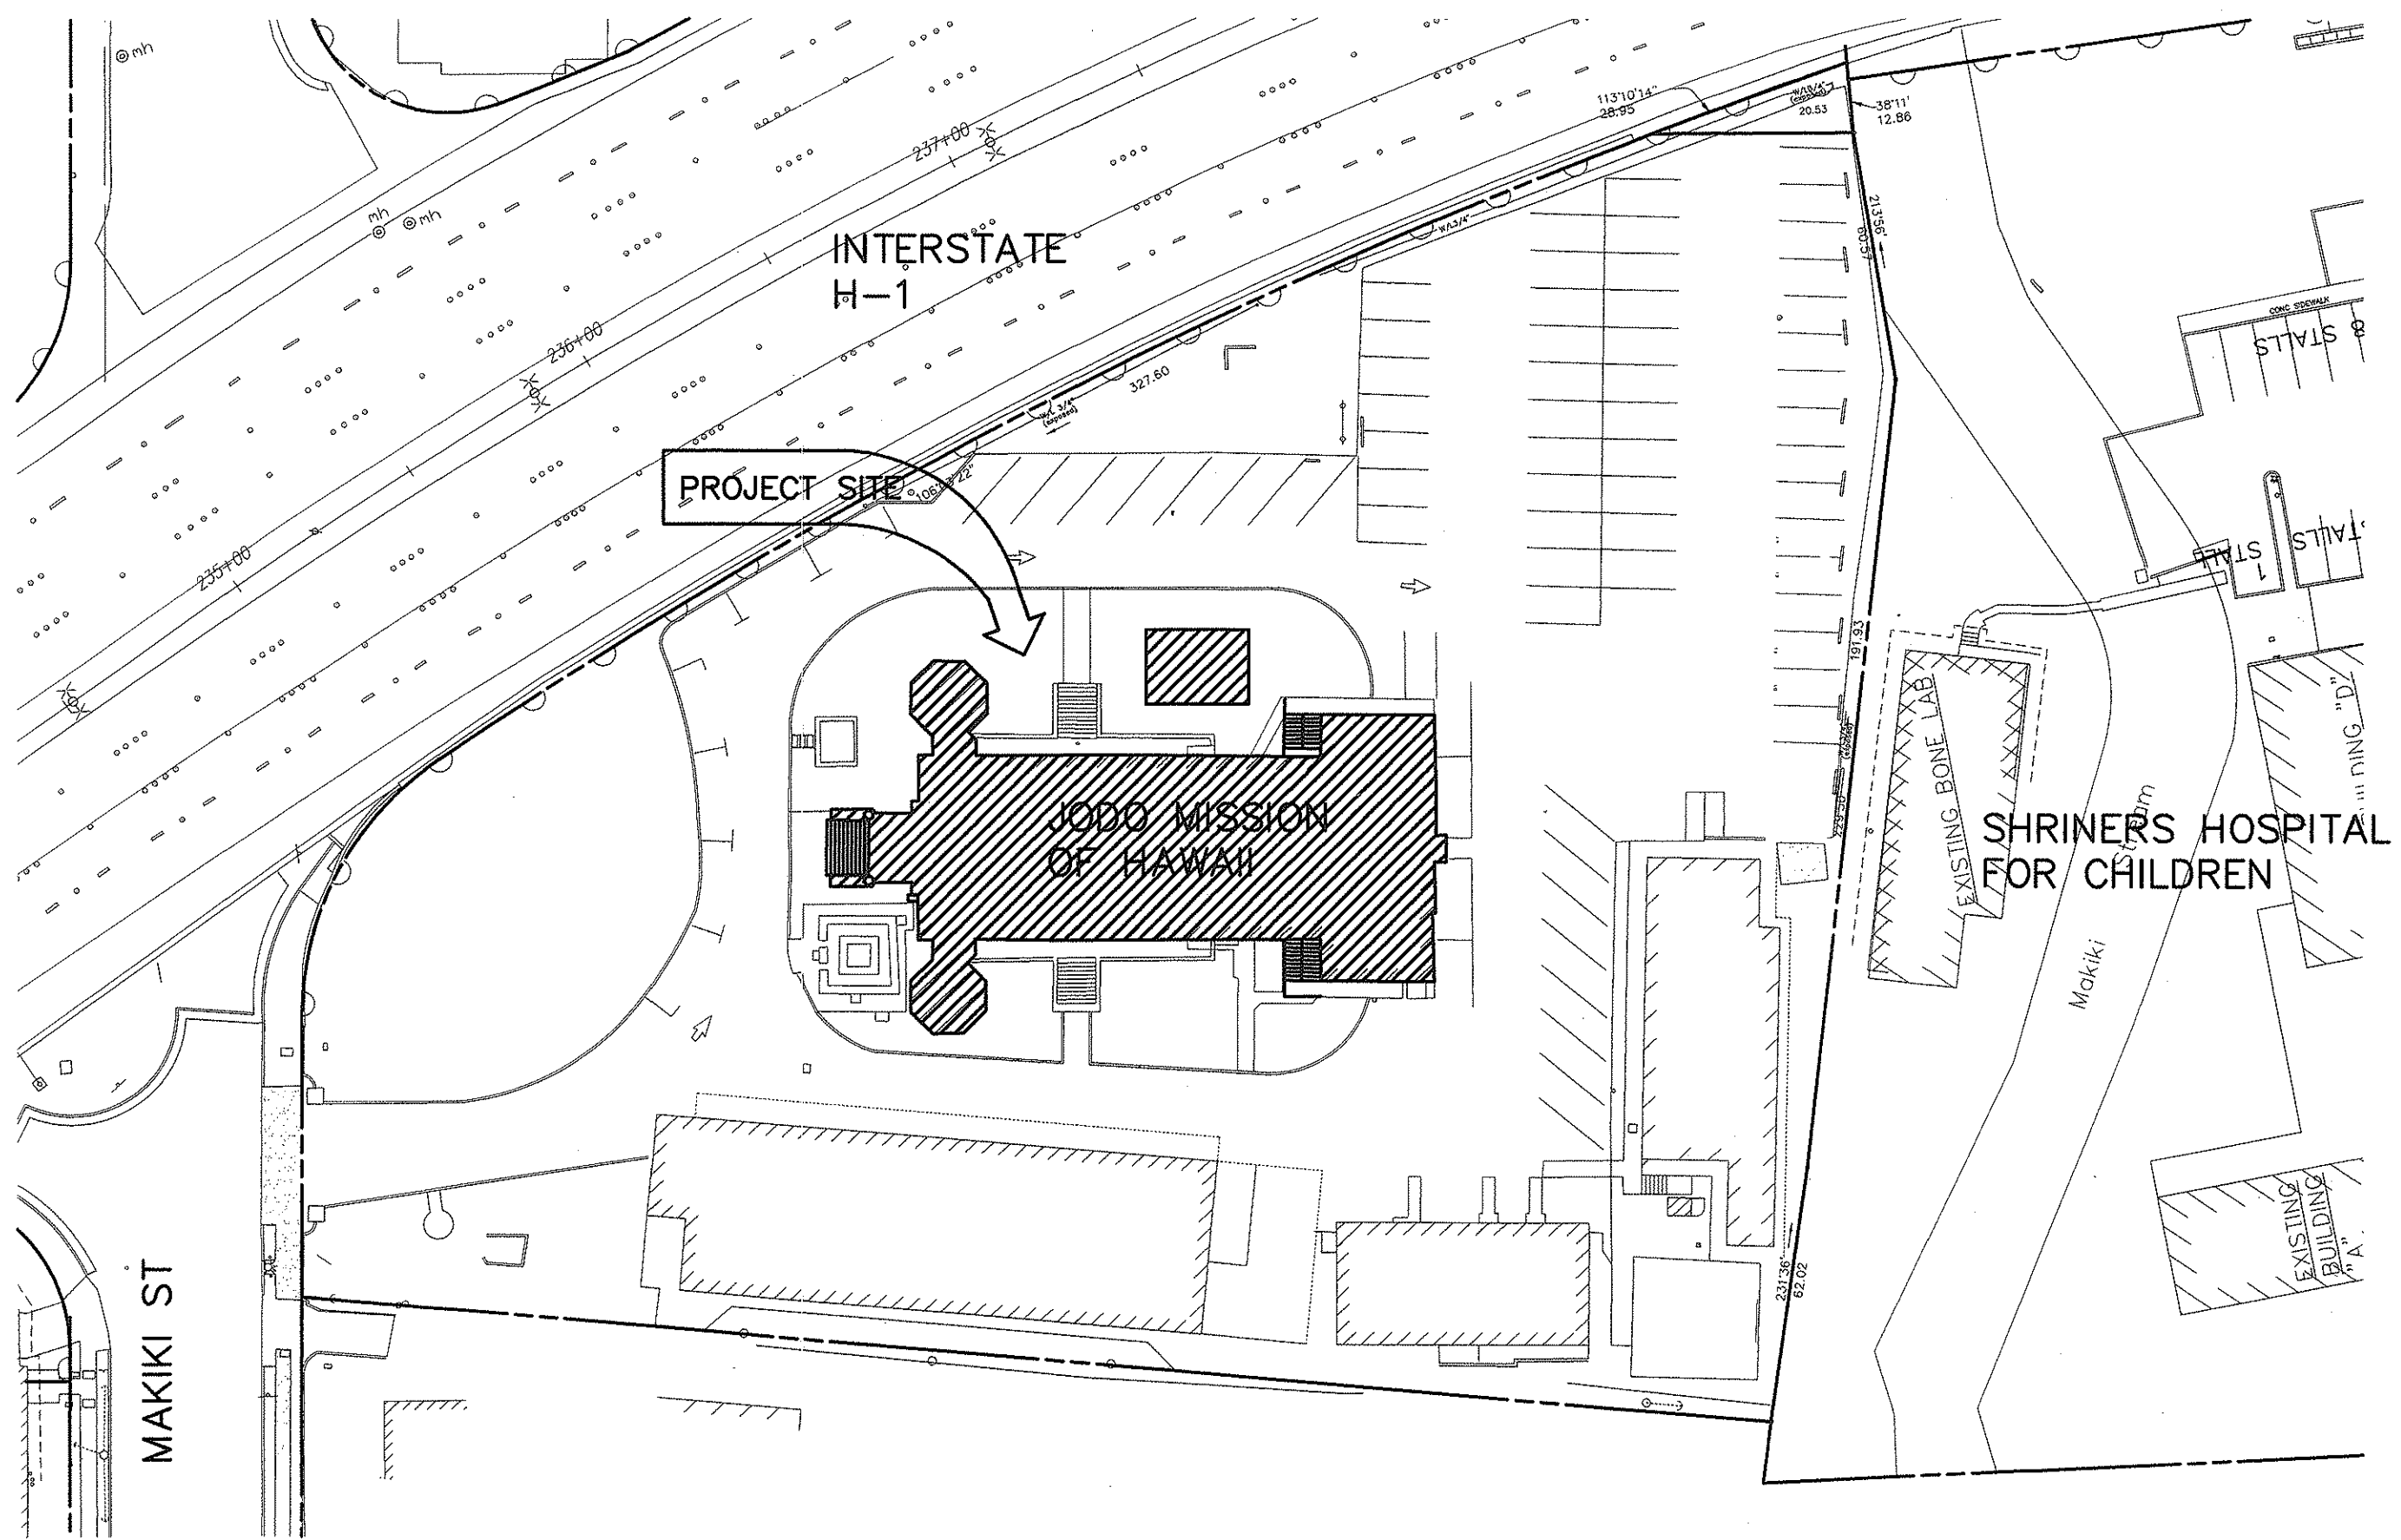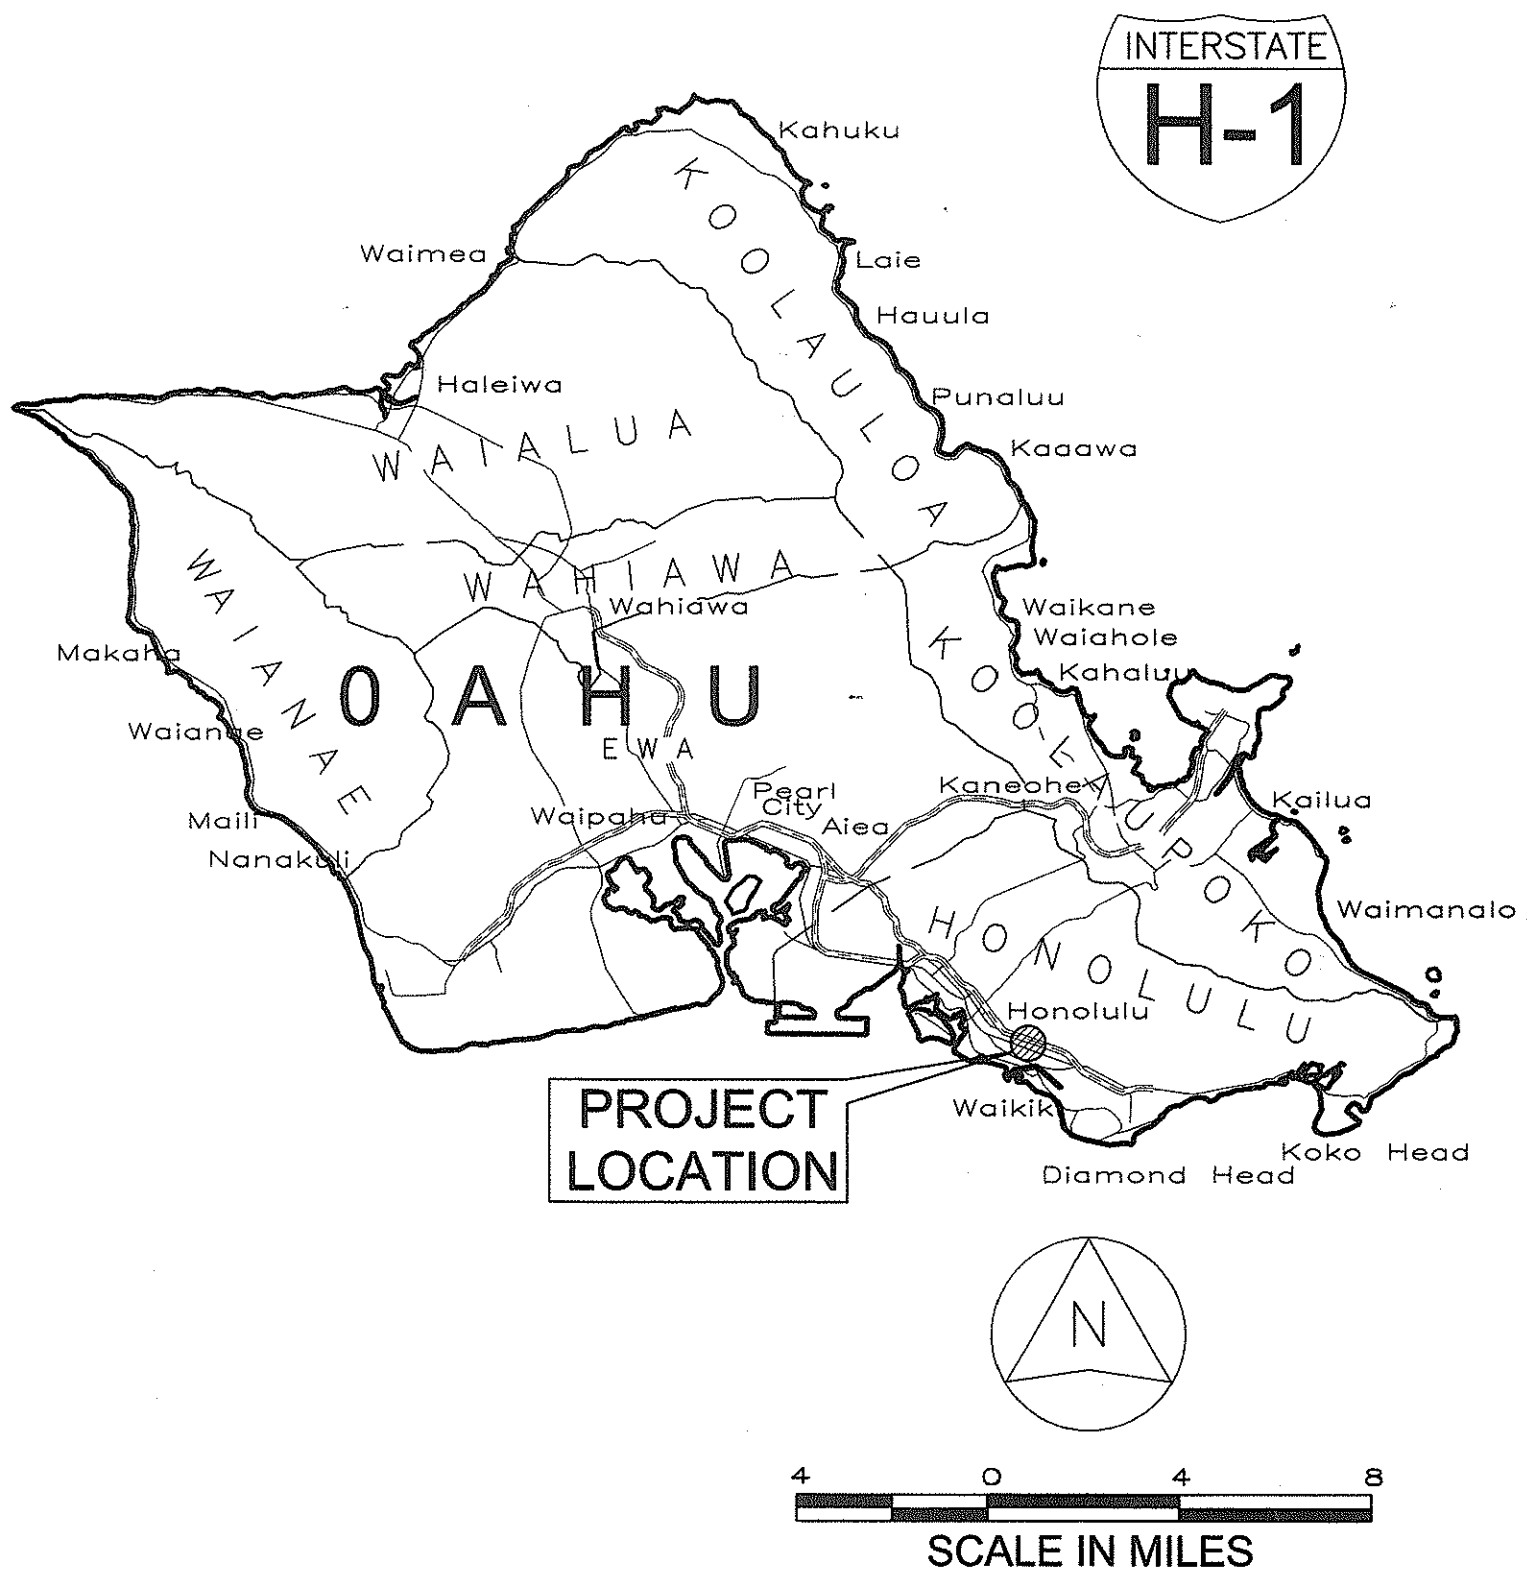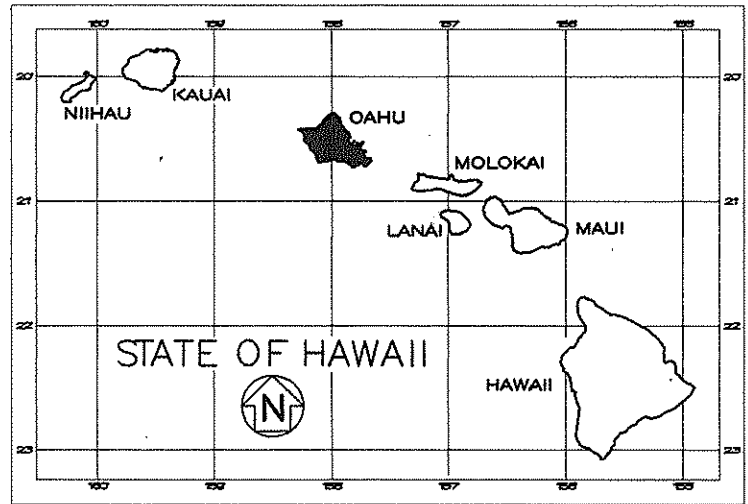

VICINITY MAP

LOCATION MAP  
SCALE: AS NOTED

CHANGES MADE DURING CONSTRUCTION HAVE BEEN INCORPORATED ON THESE PLANS EXCEPT CHANGES IN THE ORIGINAL THEORETICAL QUANTITIES. FOR ACTUAL QUANTITIES, REFER TO PROJECT LEDGER AND/OR COMPUTATION BOOK.

Kelvin Okazawa 10/16/01  
FOR PROJECT ENGINEER DATE

DEPARTMENT OF TRANSPORTATION  
STATE OF HAWAII

APPROVED: *Kay Chynoweth* 1/4/99  
DIR. OF TRANSPORTATION DATE

ORIGINAL PLAN	SURVEY PLOTTED BY	DATE
NOTE BOOK	DRAWN BY	
No.	DESIGNED BY	
	QUANTITIES BY	
	CHECKED BY	

R.M. TOWILL CORPORATION  
DESIGNED BY K. ITO  
P. S. & E. BY 692-7548 DEC. 1999  
PHONE DATE