
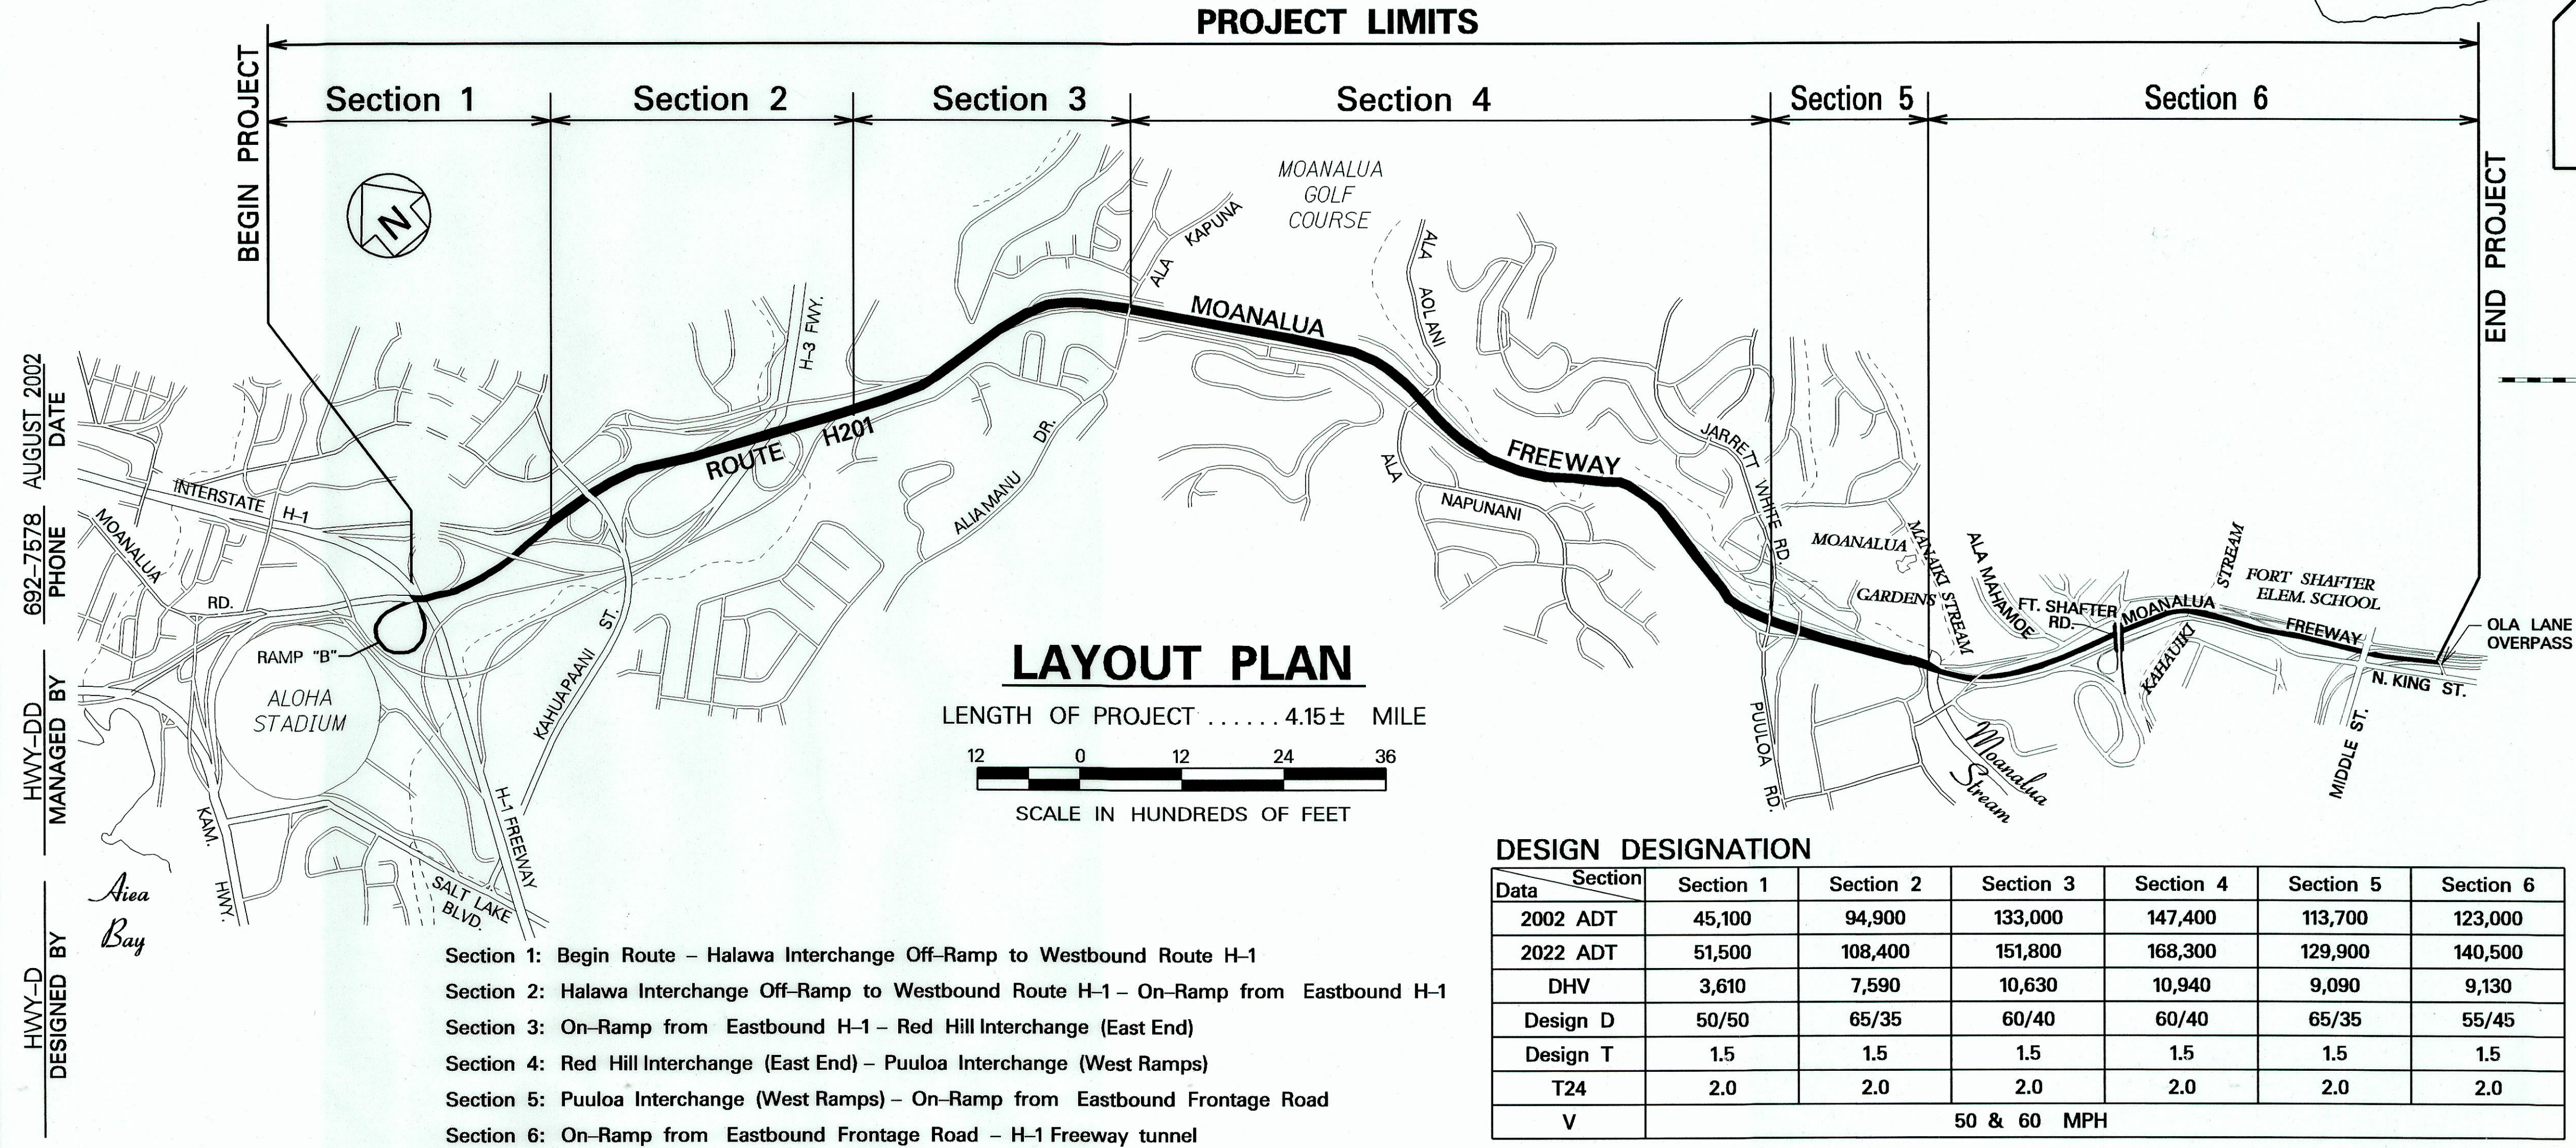
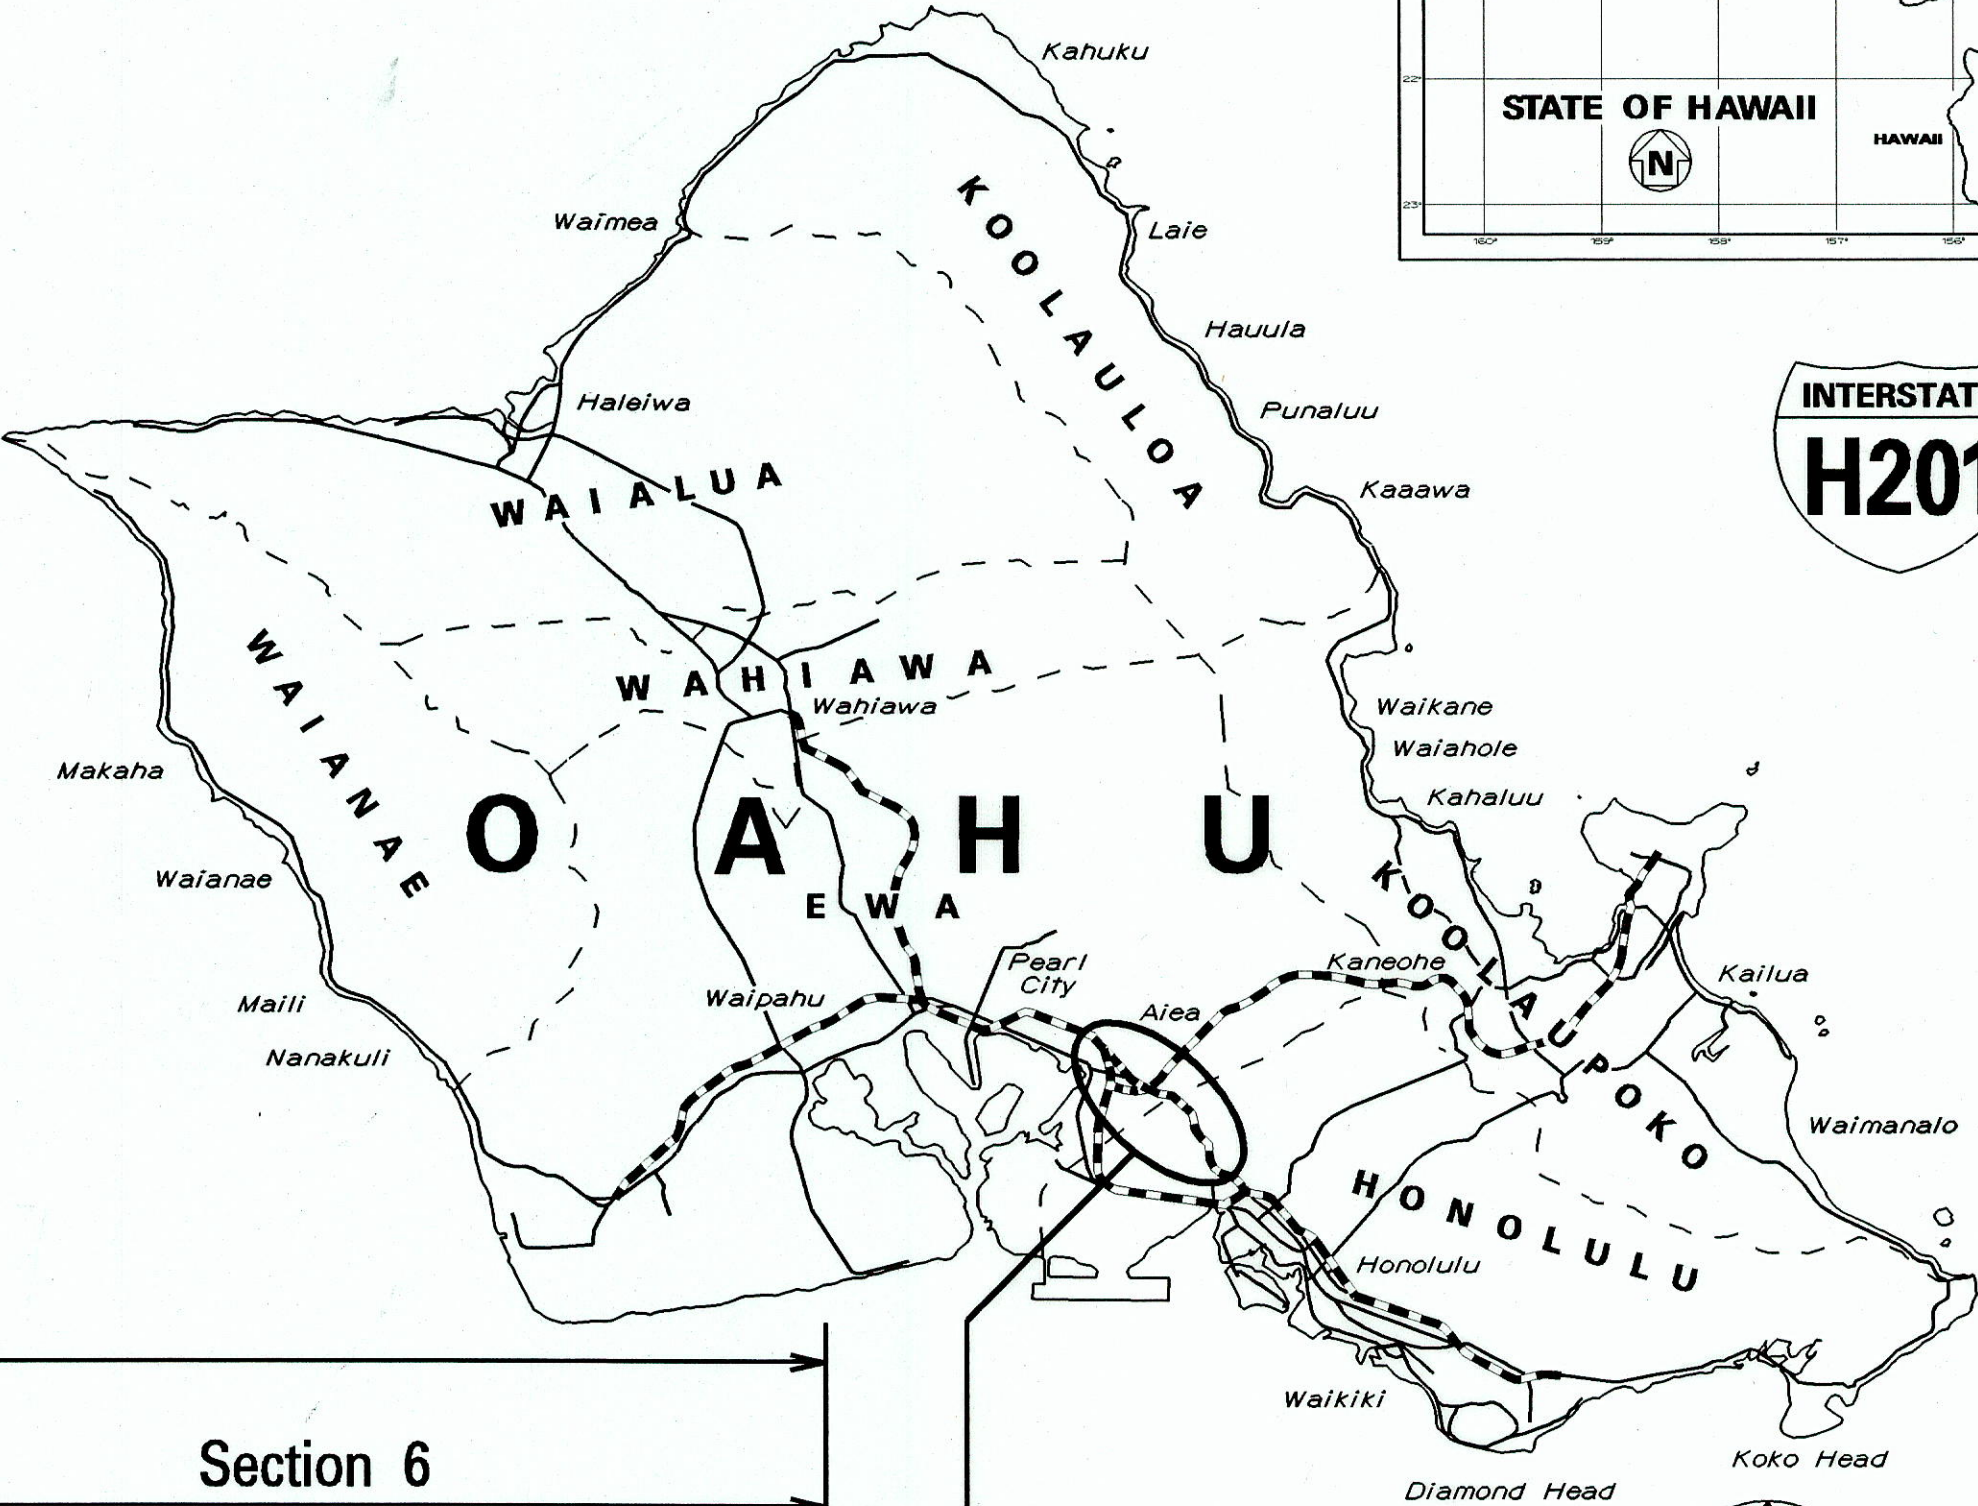


INDEX TO DRAWINGS	
SHEET NO.	DESCRIPTION
2	TITLE SHEET
3	STANDARD PLANS SUMMARY
4	GENERAL NOTES AND LEGEND
5 - 6	UTILITY NOTES
7 - 8	WATER POLLUTION & EROSION CONTROL NOTES
9 - 12	TYPICAL SECTIONS
13 - 26	ROADWAY PLANS
27	PAVEMENT MARKING, LEGEND, DETAILS, & NOTES
28 - 41	PAVEMENT MARKING & SIGNING PLAN
42 - 47	EXPRESSWAY SIGN PANEL LAYOUT
48	FREEWAY WORK ZONE SIGNING PLAN
49 - 51	TRAFFIC SUMMARIES
52	FREEWAY WORK ZONE SIGNING PLAN, NOTES & DETAILS
53 - 54	COUNTING STATION PLAN
55 - 68	STRUCTURAL PLANS

STATE OF HAWAII
DEPARTMENT OF TRANSPORTATION
HIGHWAYS DIVISION
HONOLULU, HAWAII
"AS-BUILT"
PLANS FOR
MOANALUA FREEWAY RESURFACING
HALAWA INTERCHANGE TO KAHAIKI INTERCHANGE
FEDERAL AID PROJECT NO. DPI-0203(1)
DISTRICTS OF EWA AND HONOLULU
ISLAND OF OAHU

FED. ROAD DIST. NO.	STATE	FED. AID PROJ. NO.	FISCAL YEAR	SHEET NO.	TOTAL SHEETS
HAWAII	HAW.	DPI-0203(1)	2003	2	234

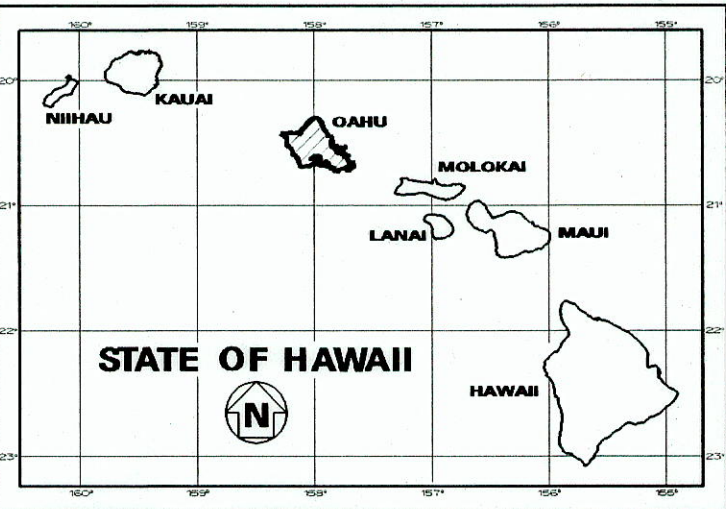

LOCATION OF PROJECT

SCALE IN MILES

FEDERAL AID INTERSTATE PROJECTS PREVIOUSLY CONSTRUCTED OR UNDER CONSTRUCTION

ROUTE H201: MILE POST 0.00 TO MILE POST 4.09
ROUTE H1: MILE POST 18.91 TO MILE POST 18.97

DESIGN DESIGNATION						
Data	Section	Section 1	Section 2	Section 3	Section 4	Section 5
2002 ADT		45,100	94,900	133,000	147,400	113,700
2022 ADT		51,500	108,400	151,800	168,300	129,900
DHV		3,610	7,590	10,630	10,940	9,090
Design D		50/50	65/35	60/40	60/40	65/35
Design T		1.5	1.5	1.5	1.5	1.5
T24		2.0	2.0	2.0	2.0	2.0
V		50 & 60 MPH				

CHANGES MADE DURING CONSTRUCTION HAVE BEEN INCORPORATED ON THESE PLANS EXCEPT CHANGES IN THE ORIGINAL THEORETICAL QUANTITIES. FOR ACTUAL QUANTITIES, REFER TO PROJECT LEDGER AND/OR CONSTRUCTION BOOK.

Sanjiv P. Sharma 6/30/12
PROJECT ENGINEER DATE

DEPARTMENT OF TRANSPORTATION
STATE OF HAWAII

APPROVED: *[Signature]* 8-8-02
IN DIR. OF TRANSPORTATION DATE