


FED. ROAD DIST. NO.	STATE	PROJ. NO.	FISCAL YEAR	SHEET NO.	TOTAL SHEETS
HAWAII	HAW.	H1H-01-00M	2003	ADD. 116	234


REMOVAL SEQUENCE:

1. 4-L4x3x1/4 w/2-1/4" stl.
2. Nuts & washers from 5/8" dia. bolts. Do not bolts.
3. Highway lighting Standard, base and grout.
4. Cut 4-1" dia. A. bolts flush w/ concrete.
5. Cut conduits flush w/ concrete & plug w/ grout.

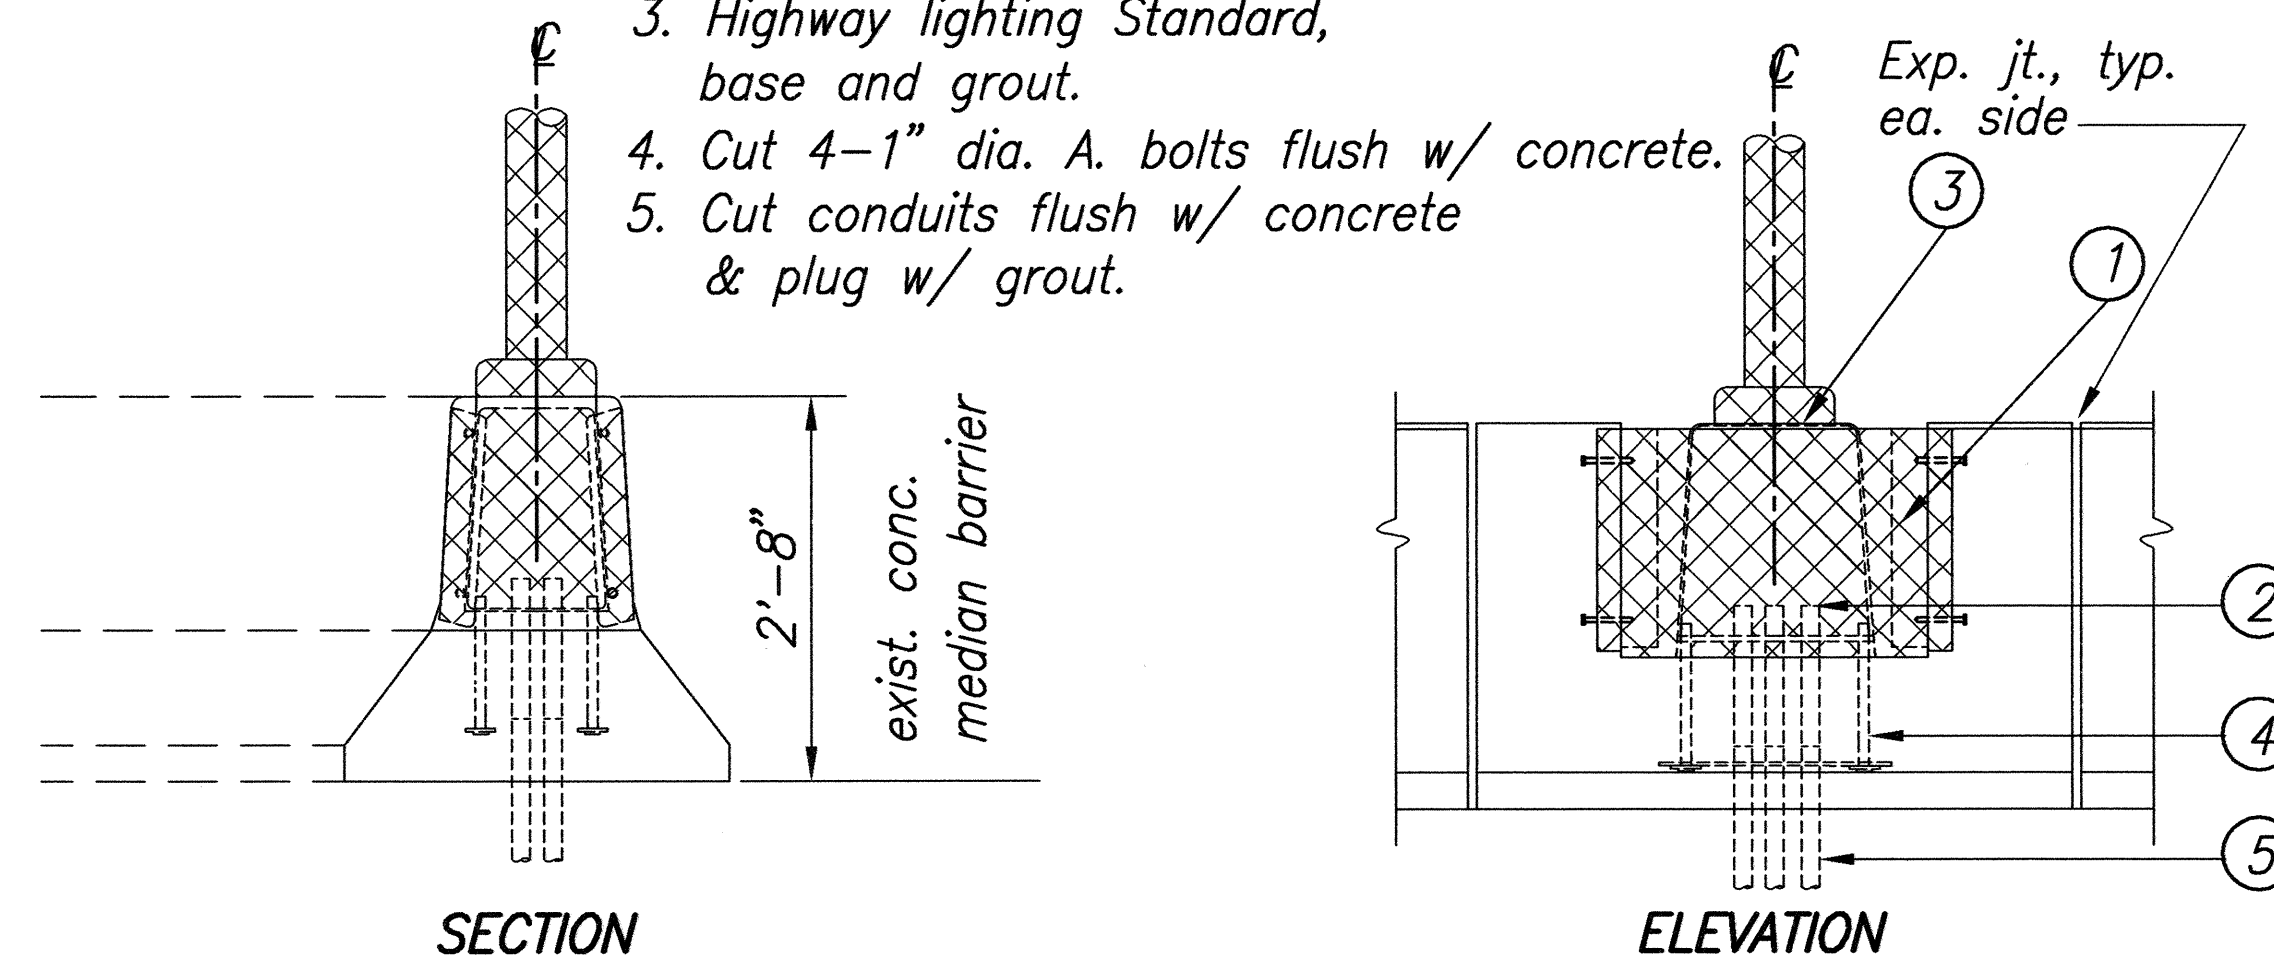


DEMOLITION DETAILS

SCALE 3/4" = 1'-0"

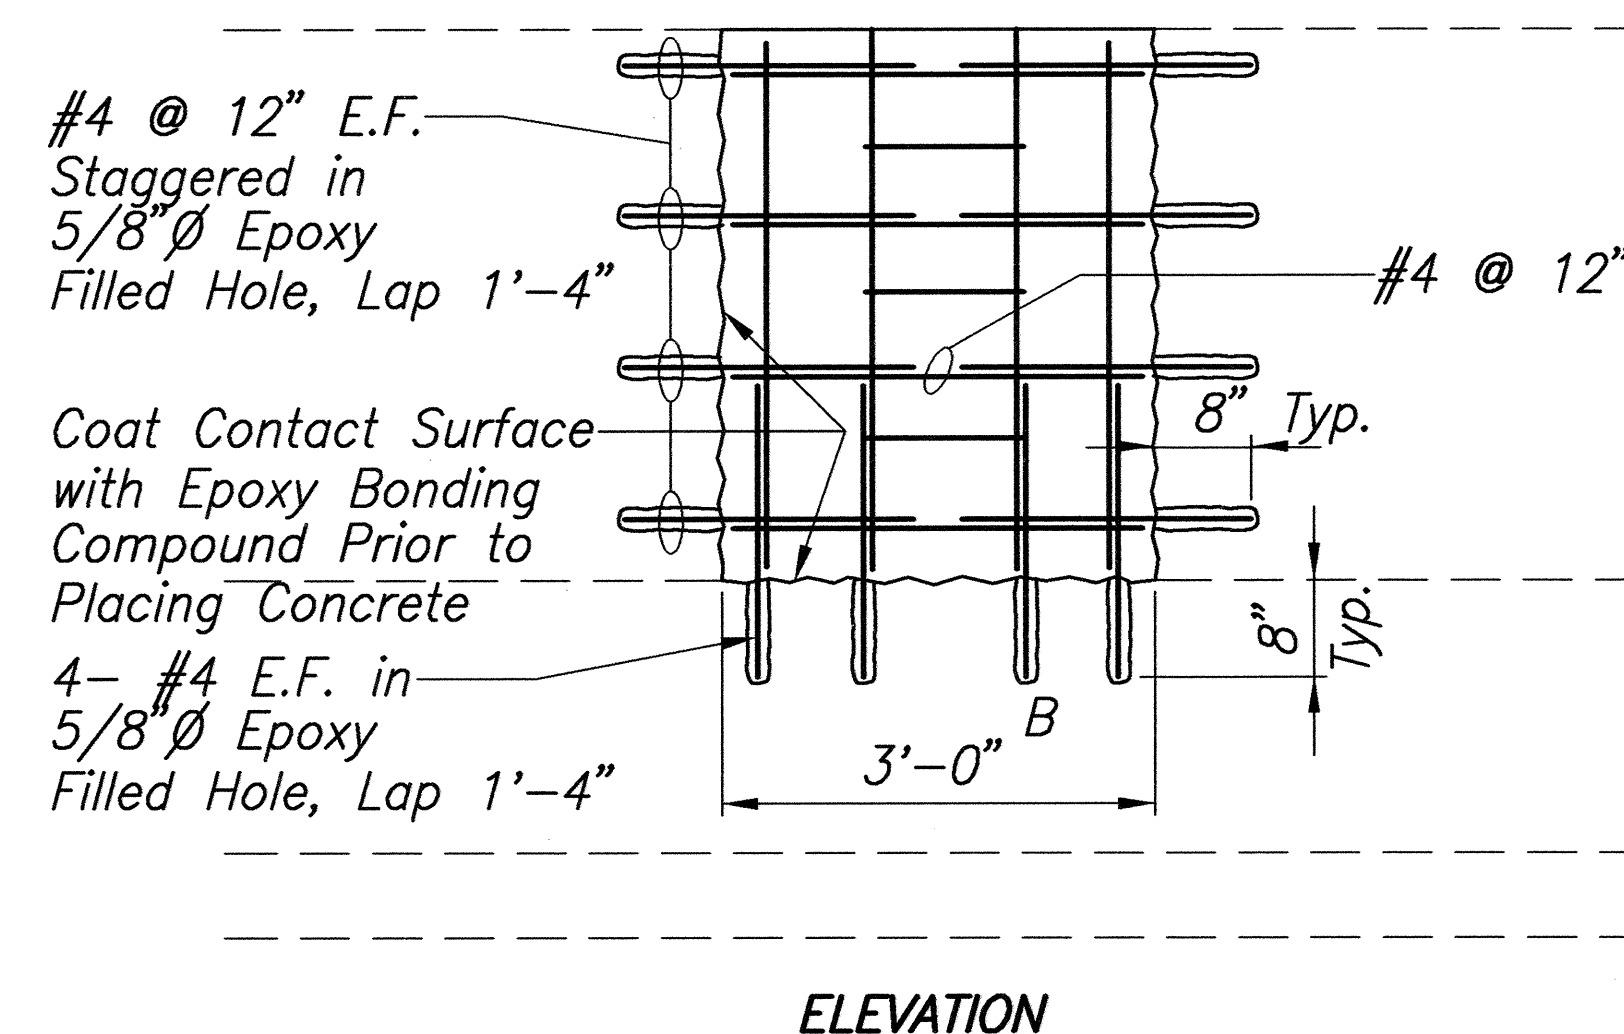

MEDIAN RECONSTRUCTION AT EXIST. LIGHT STANDARD


Not To Scale

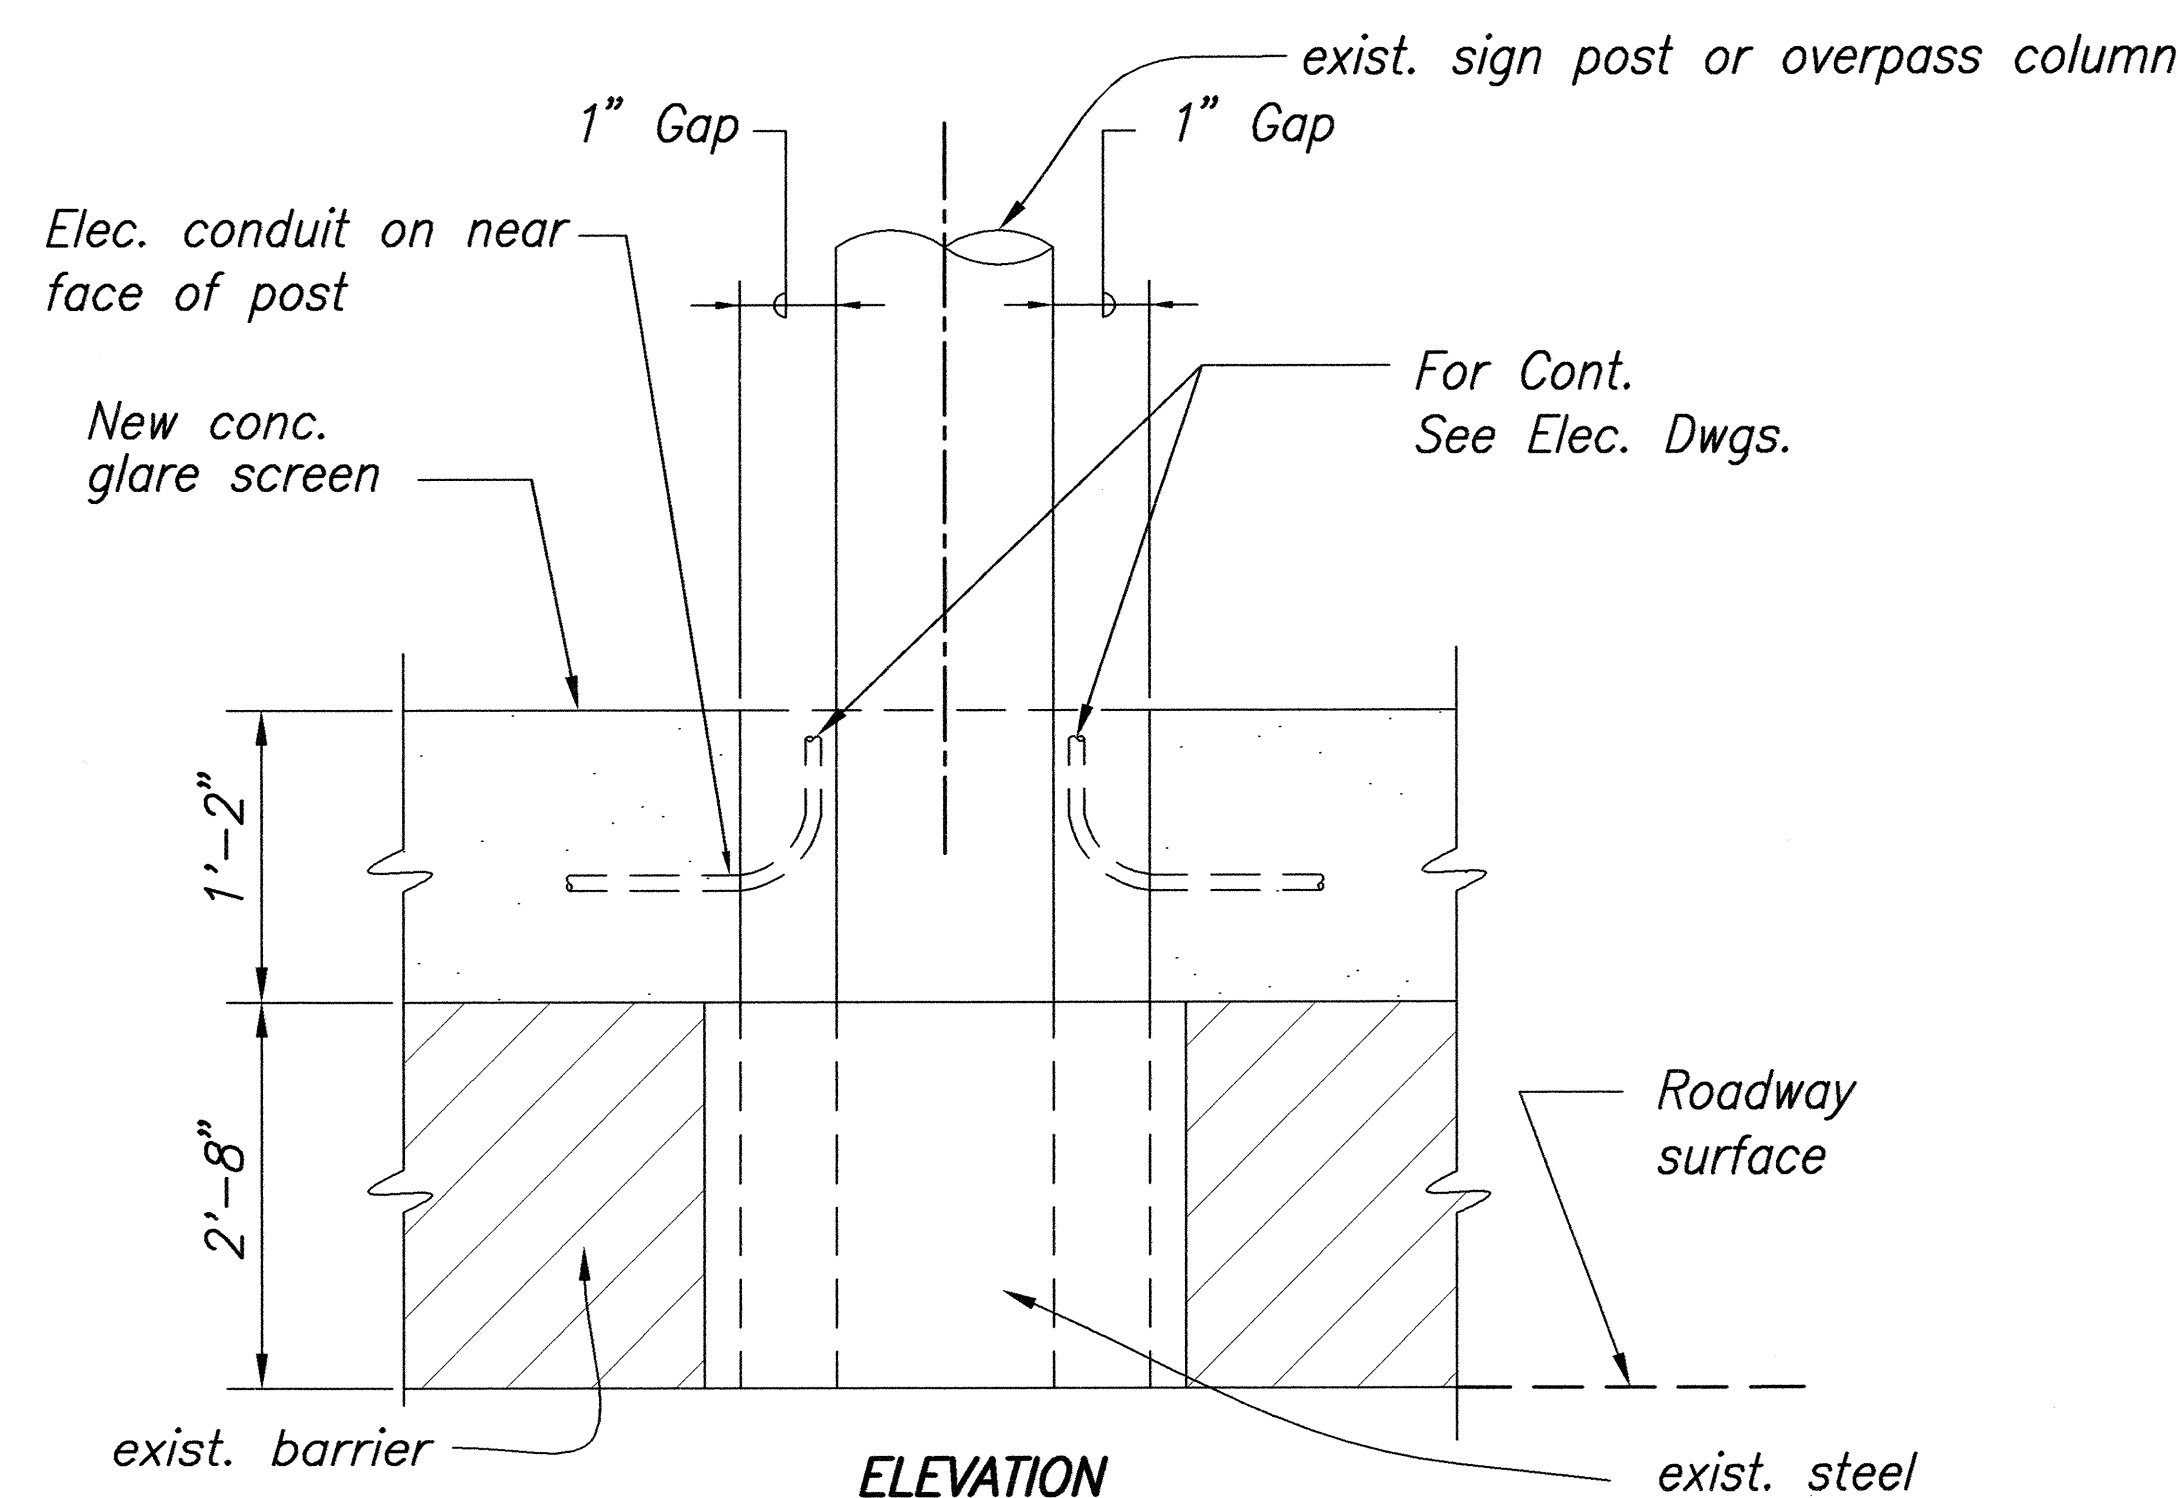

CONC. MEDIAN BARRIER UPGRADE AT POST AND MEDIAN OVERPASS

Not To Scale

GRAPHIC SCALE:

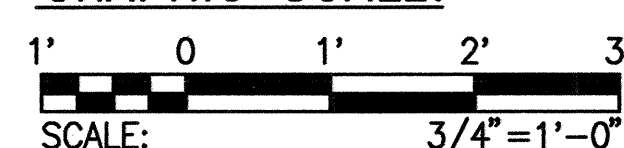


SURVEY PLOTTED BY	DATE
DRAWN BY	
TRACED BY	
DESIGNED BY	
CHECKED BY	
NO.	



THIS WORK WAS PREPARED BY
ME OR UNDER MY SUPERVISION.

SIGNATURE: Myron G. Okubo
EXPIRATION DATE: APRIL 30, 2004

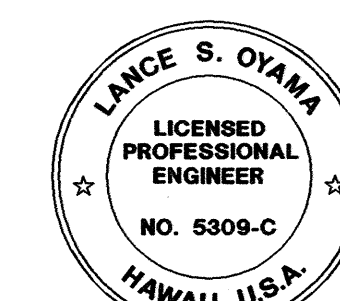

THIS WORK WAS PREPARED BY
ME OR UNDER MY SUPERVISION.

SIGNATURE: Lance S. Oyama
EXPIRATION DATE: APRIL 30, 2004

Deleted Concrete Median
Barrier Upgrade at Post
and Median Overpass Detail

6-18-03

DATE REVISION

STATE OF HAWAII
DEPARTMENT OF TRANSPORTATION
HIGHWAYS DIVISION

MISCELLANEOUS DETAILS

INTERSTATE ROUTE H-1 REHABILITATION
OLA LANE TO KALIHI STREET
PROJECT NO. H1H-01-00M

Scale: As Noted Date: October 31, 2002

SHEET No. C-47 OF C-59 SHEETS

ADD. 116

