



FED. ROAD DIST. NO.	STATE	PROJ. NO.	FISCAL YEAR	SHEET NO.	TOTAL SHEETS
HAWAII	HAW.	H1H-01-00M	2003	ADD.102	234


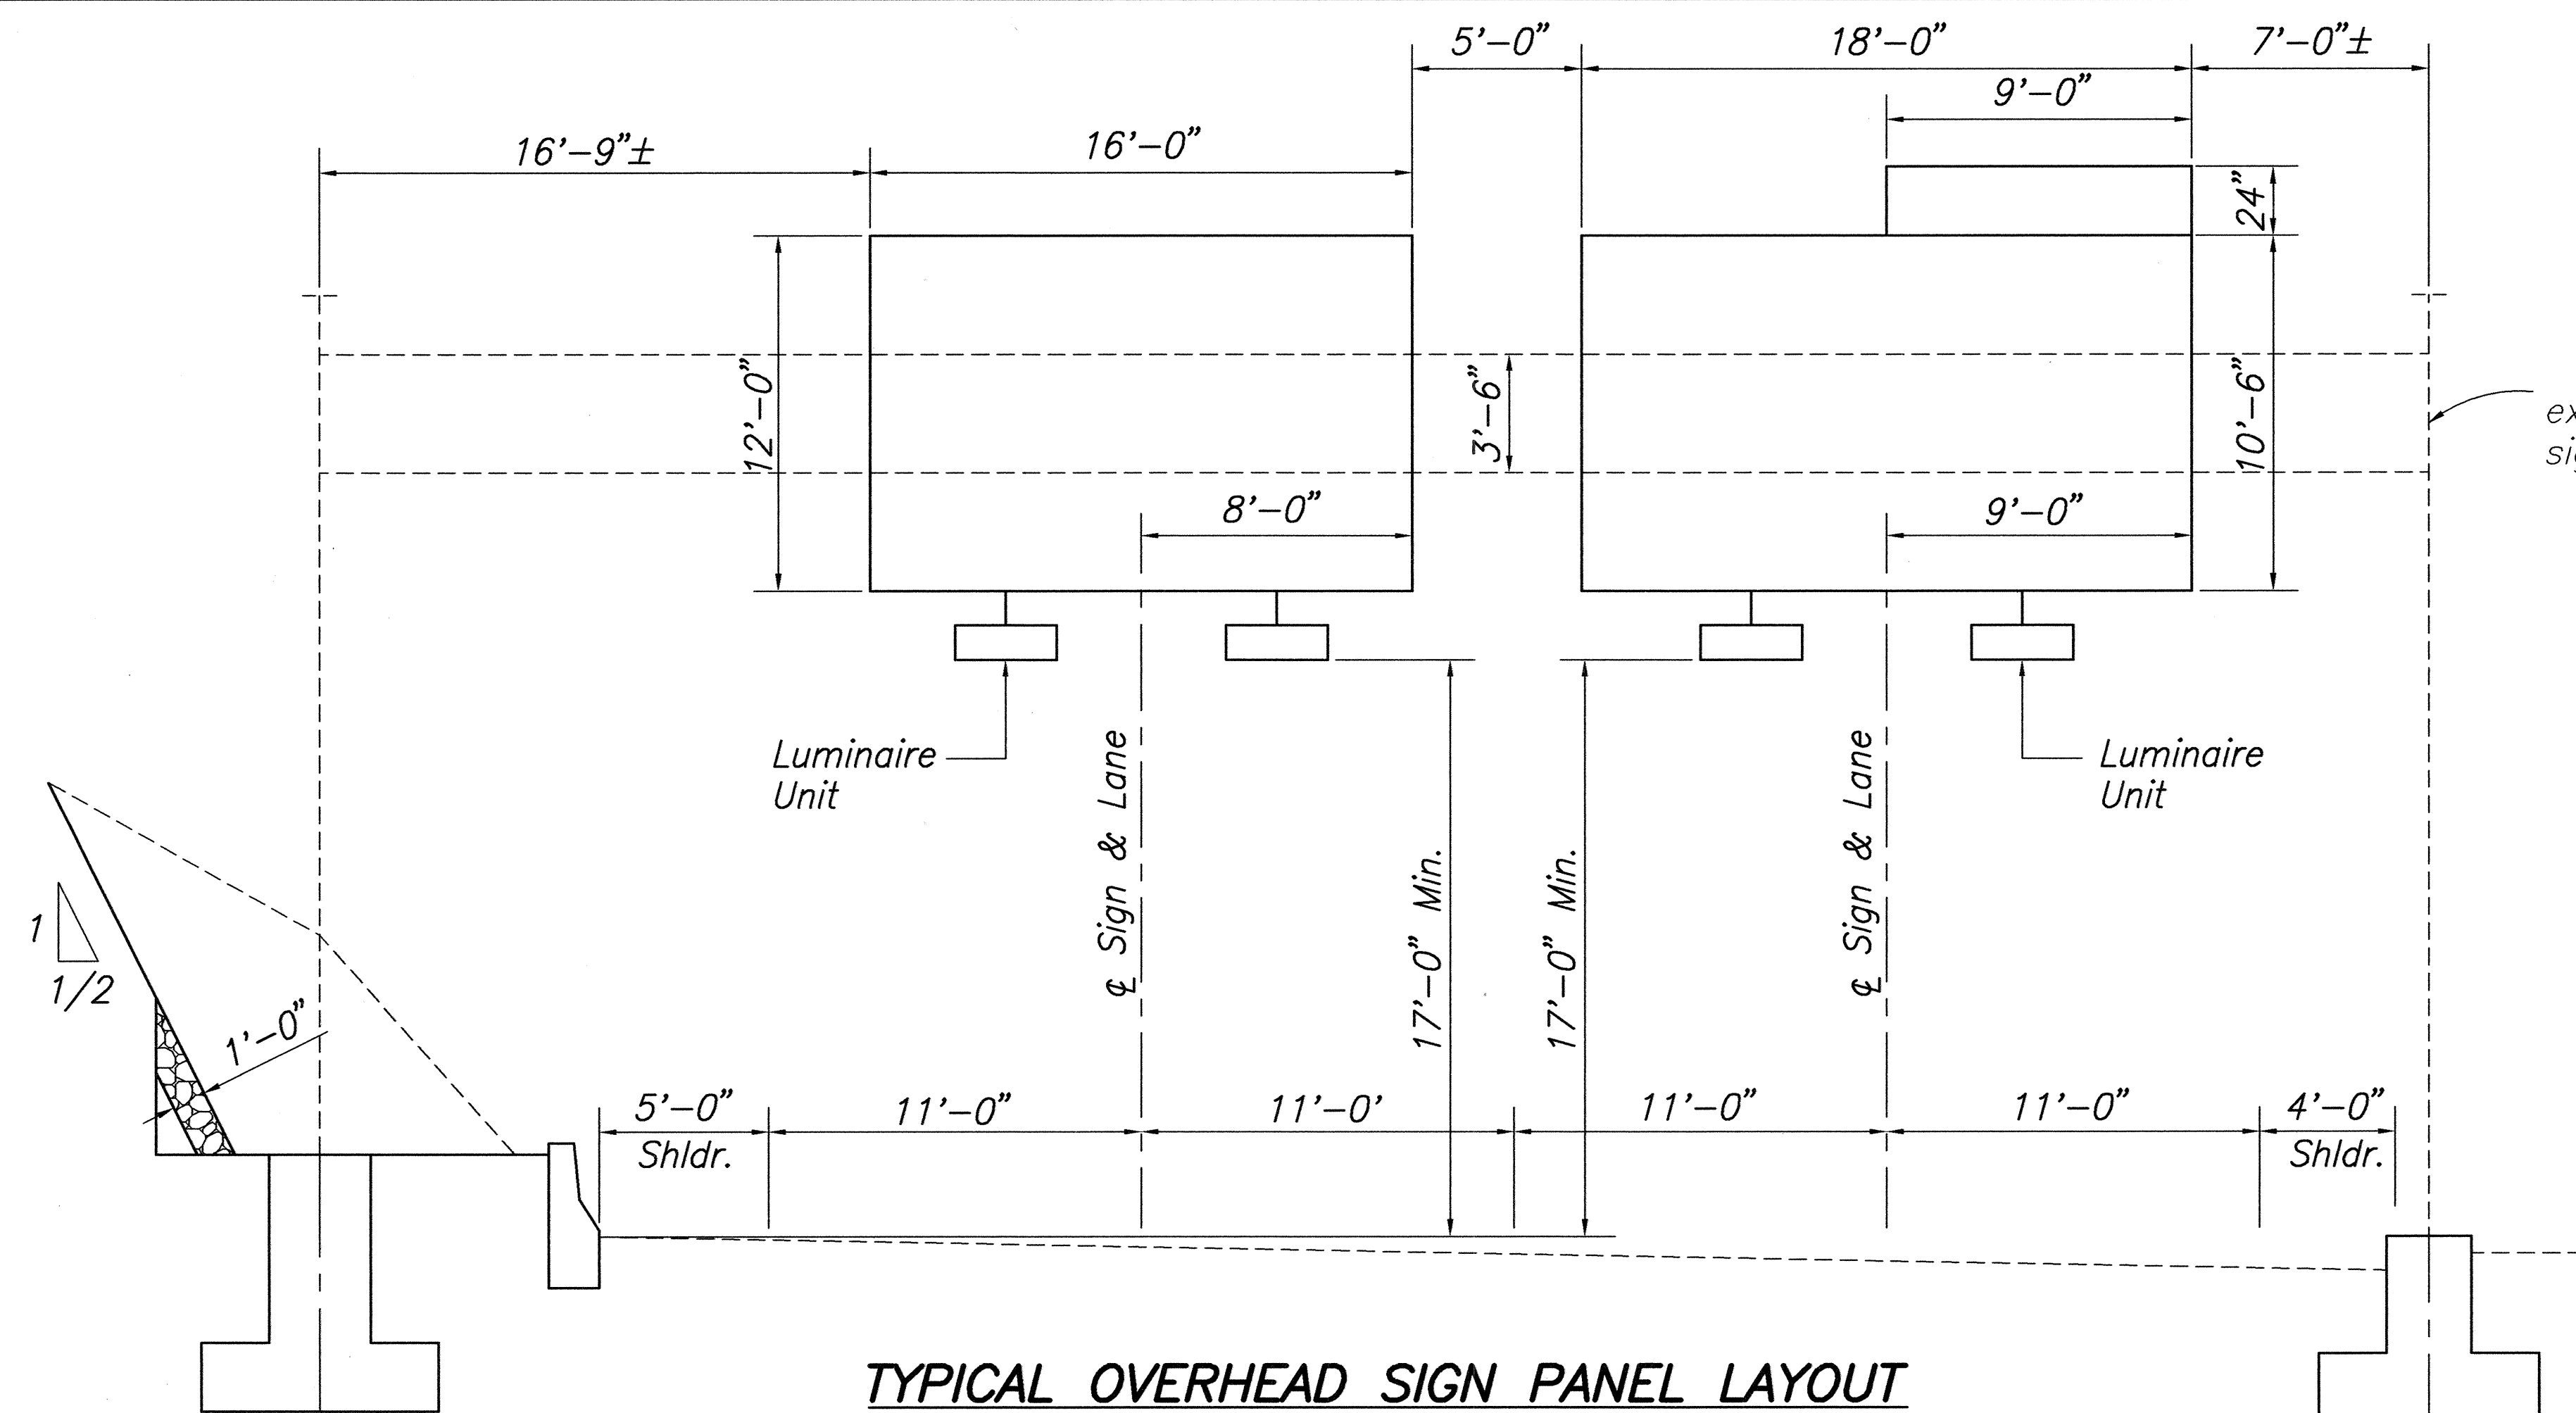


TYPICAL OVERHEAD SIGN PANEL LAYOUT
Not to Scale


exist overhead sign support

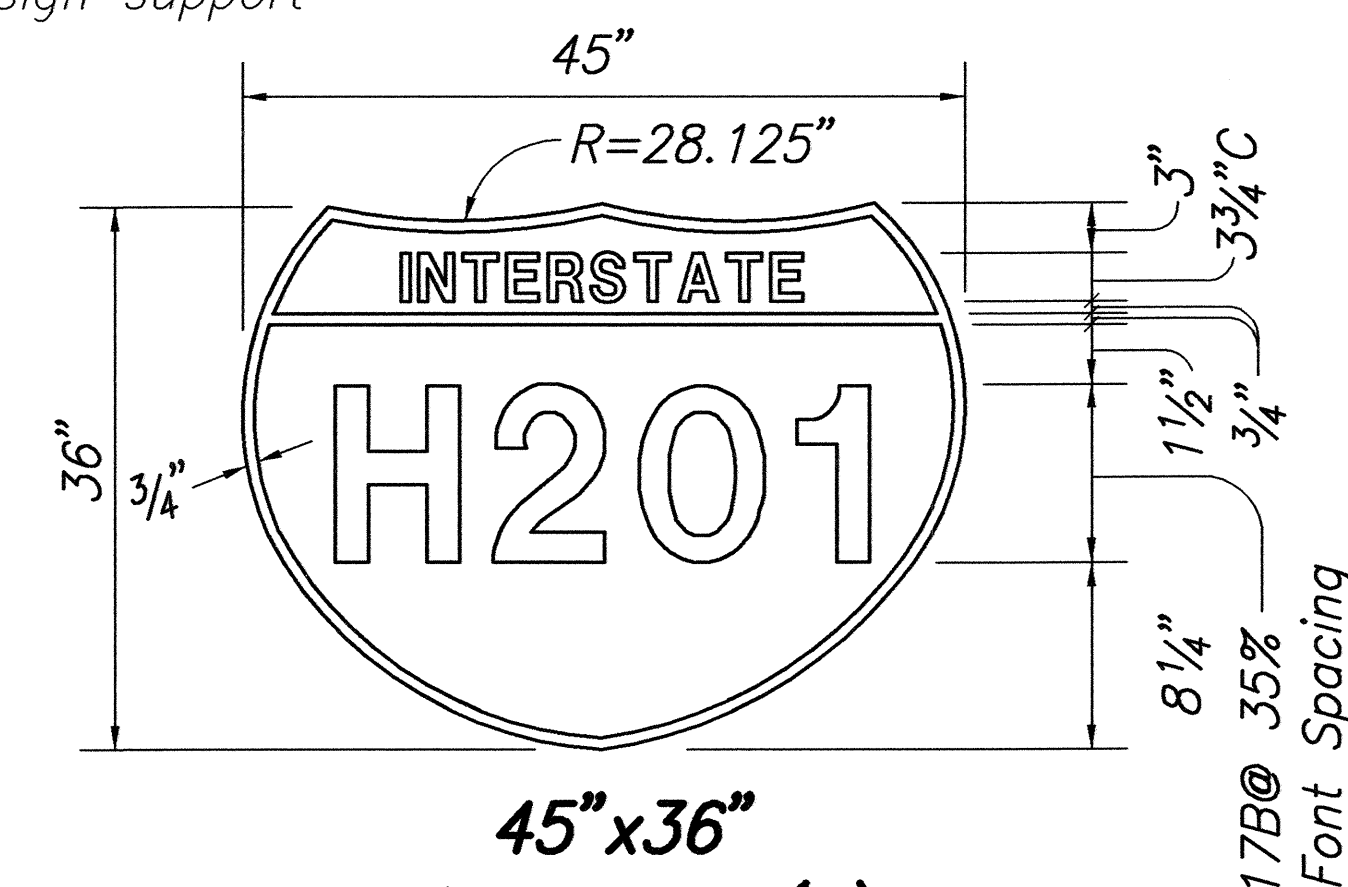


45"x36"
Sign IM-1 (2)A
Not to Scale

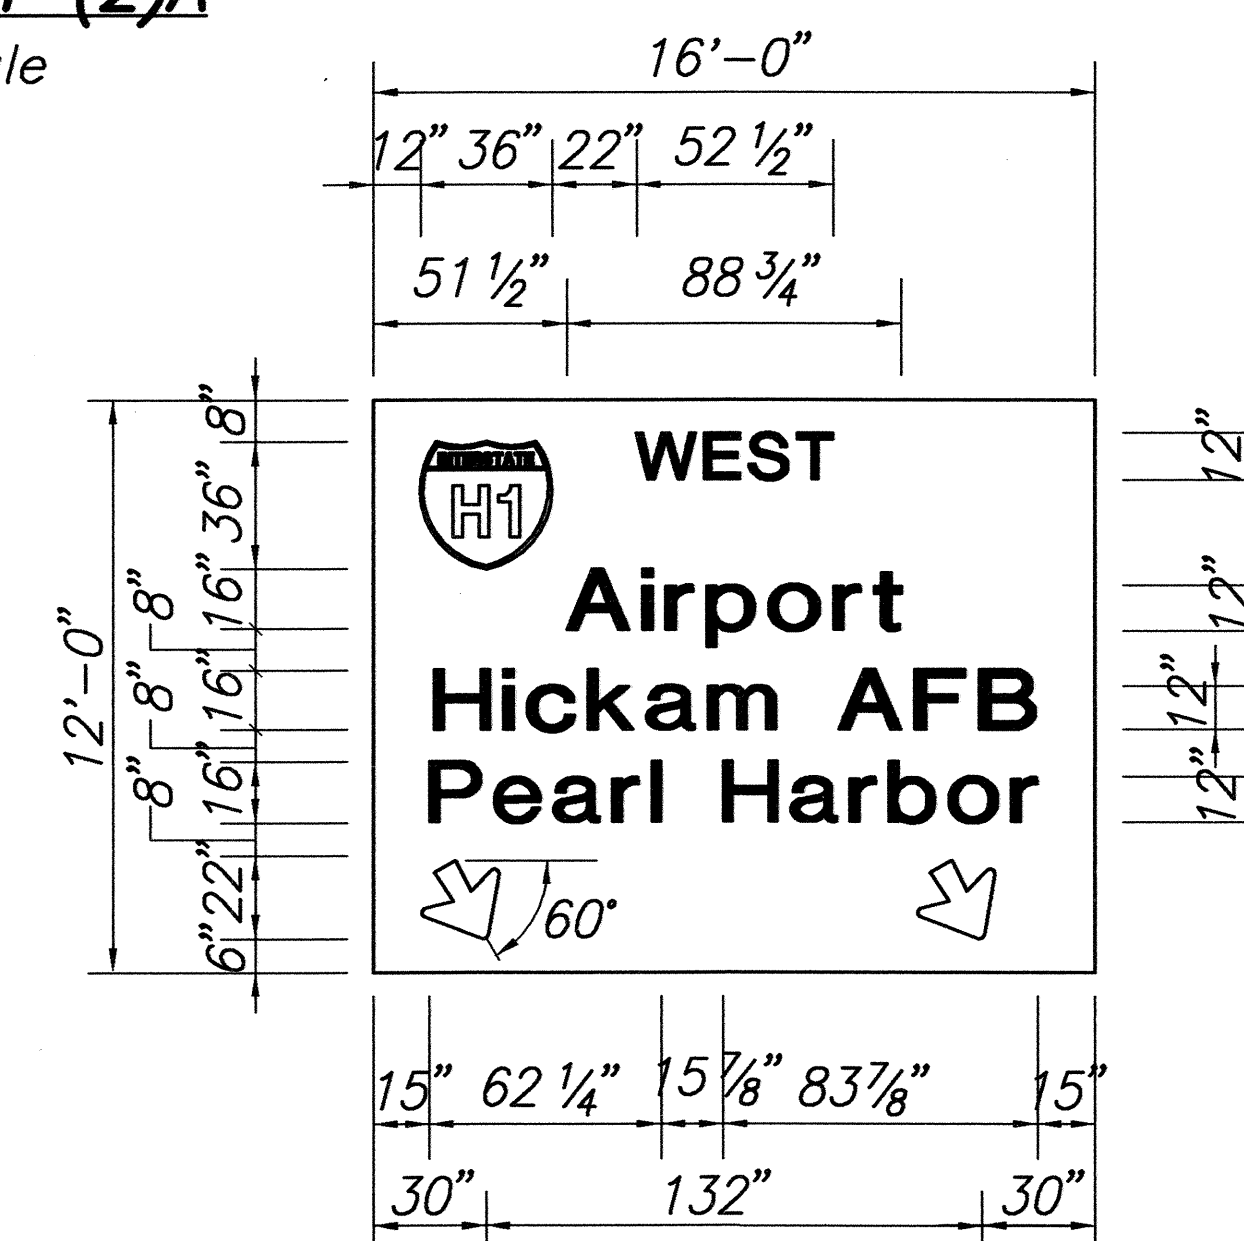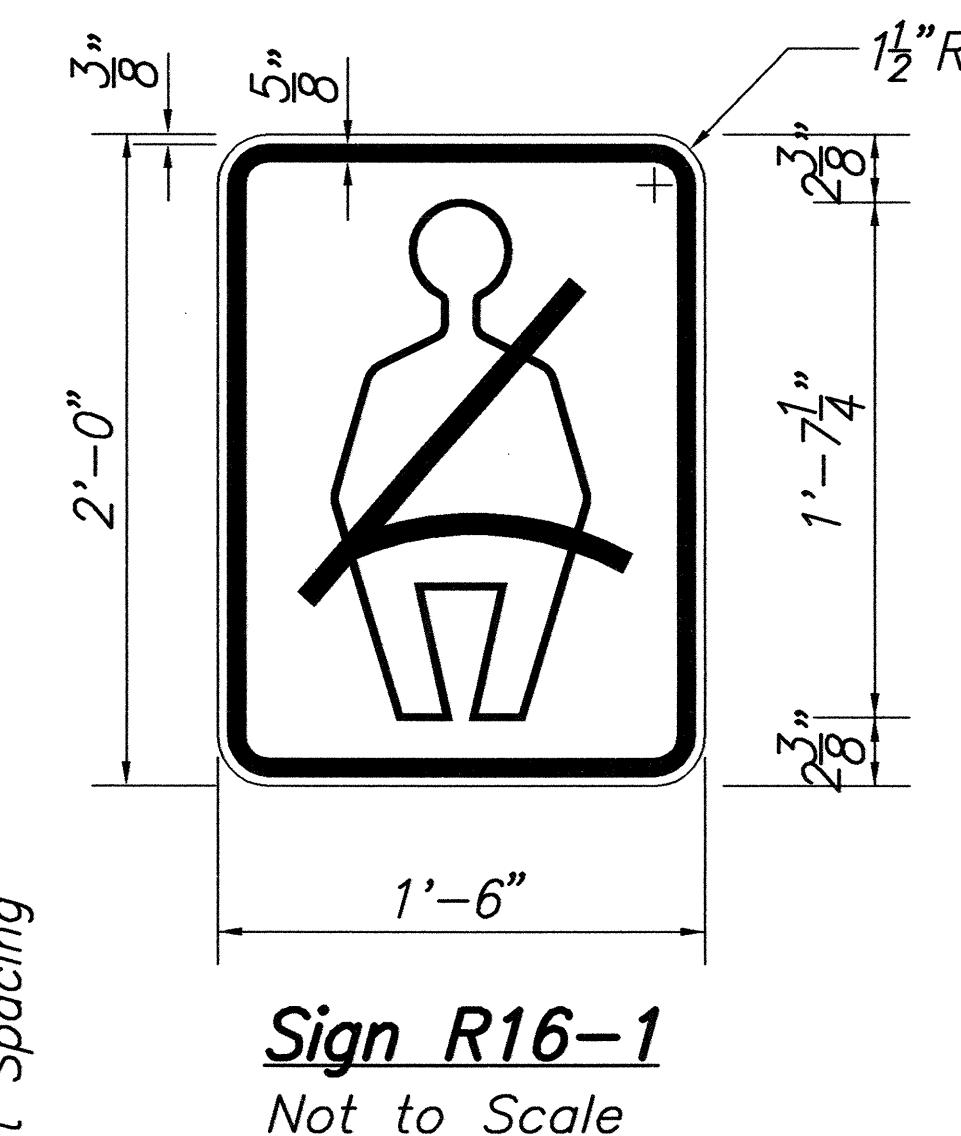


Overlay Sign Panel A-4
Not to Scale

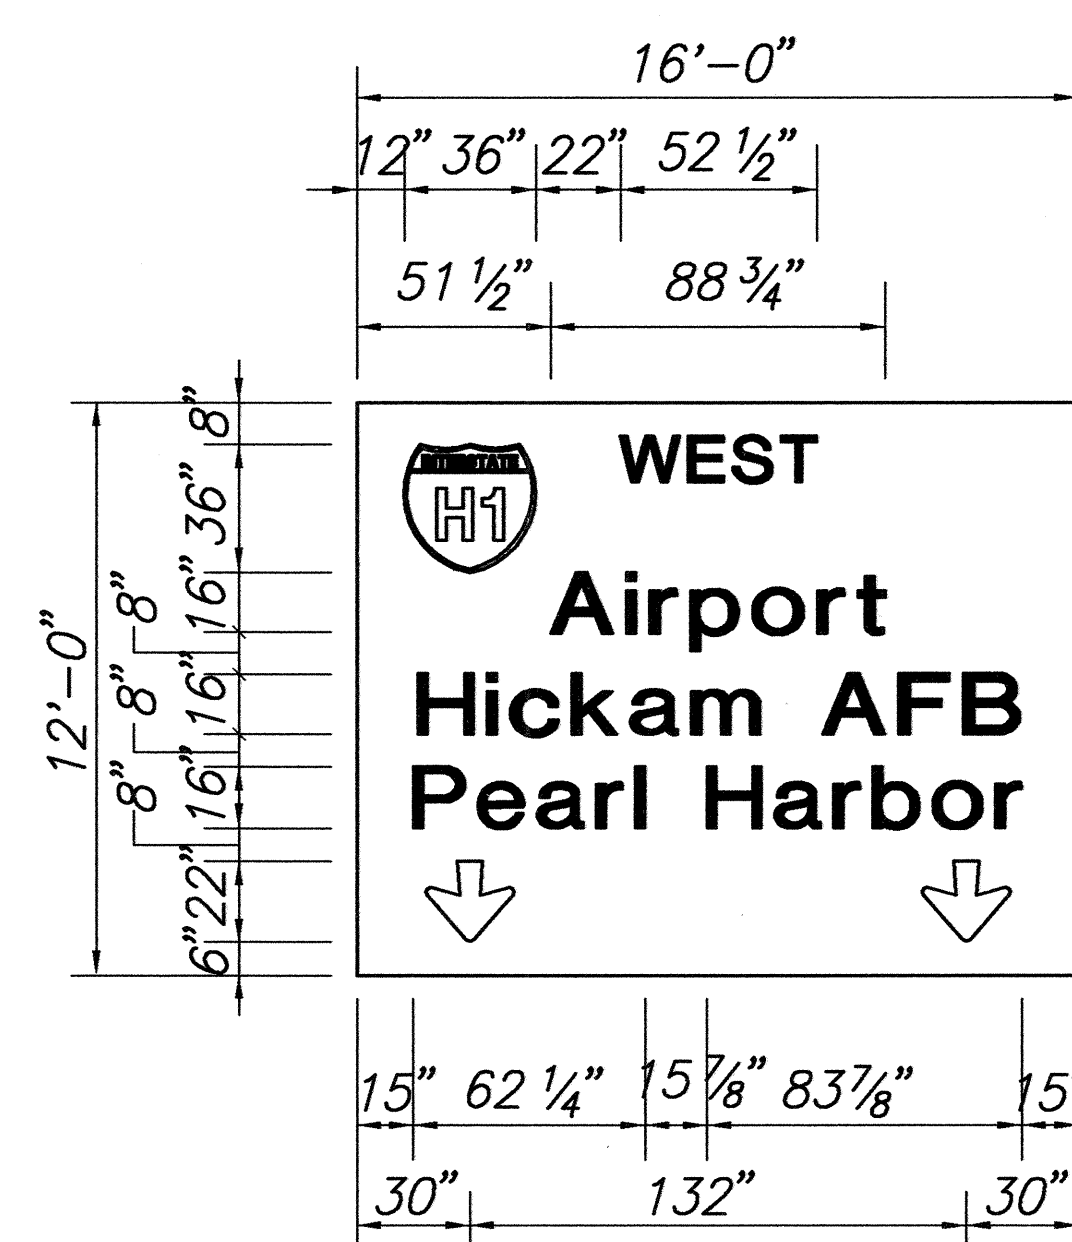


Overlay Sign Panel A-1
Not to Scale

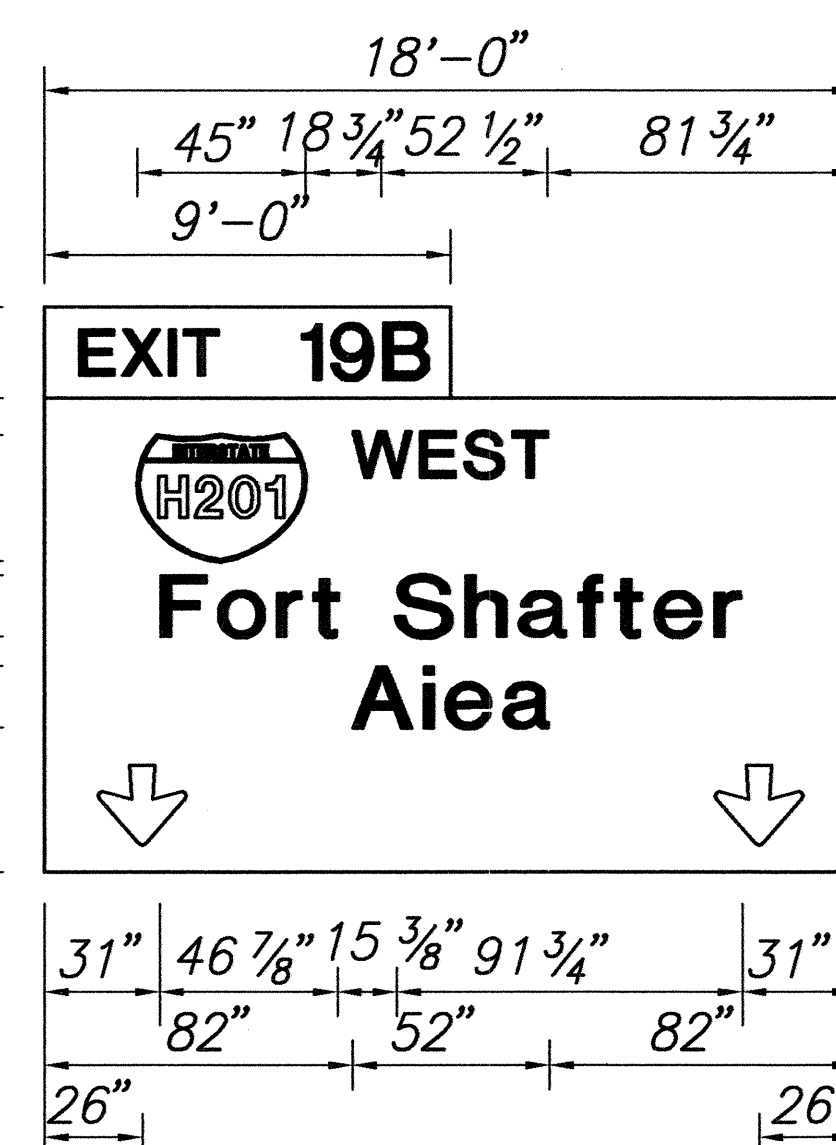

Overlay Sign Panel A-2
Not to Scale

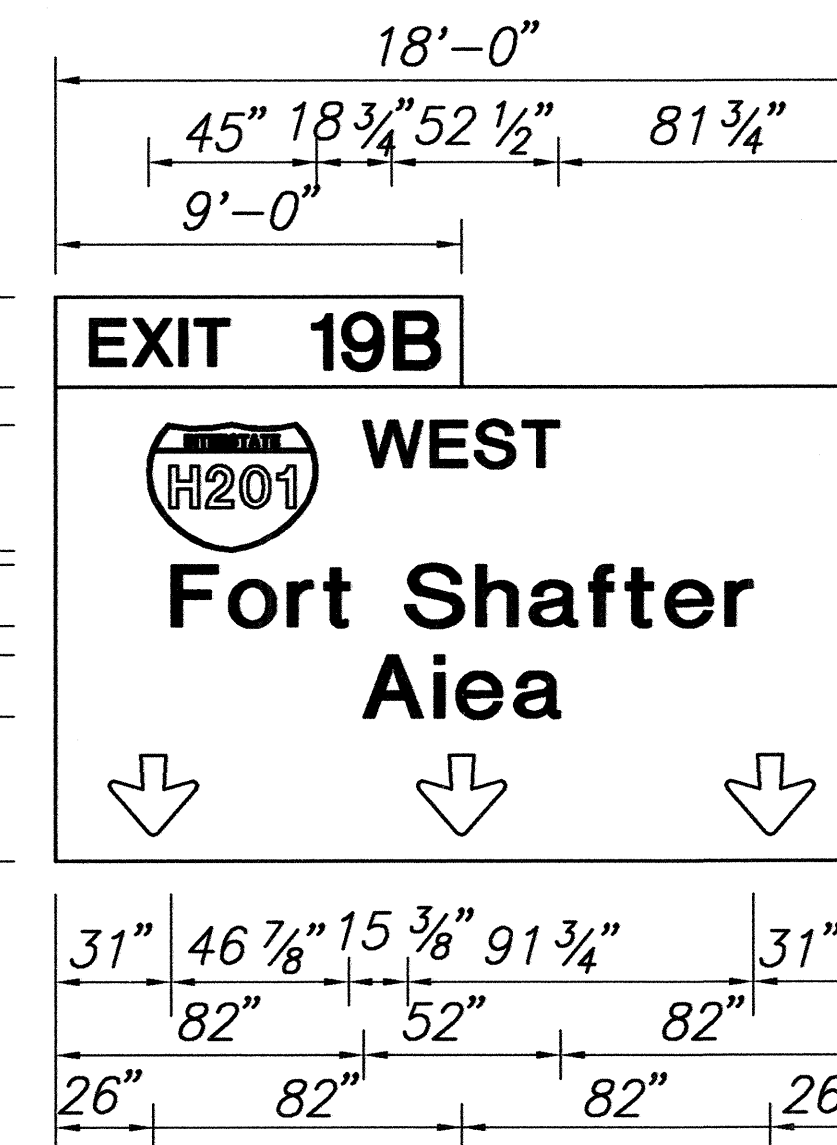

Overlay Sign Panel A-3
Not to Scale

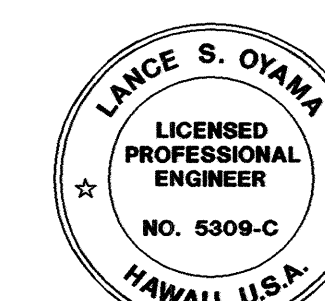

THIS WORK WAS PREPARED BY
ME OR UNDER MY SUPERVISION.
Lance S. Oyama
SIGNATURE DATE

6-18-03	Added Detail Signs A-1, A-2 and IM-1 (2)A
DATE	REVISION
STATE OF HAWAII DEPARTMENT OF TRANSPORTATION HIGHWAYS DIVISION	
OVERHEAD SIGNS	
INTERSTATE ROUTE H-1 REHABILITATION OLA LANE TO KALIHI STREET PROJECT NO. H1H-01-00M	
Scale: Not To Scale	Date: October 31, 2002

SHEET No. C-33 OF C-59 SHEETS