

| INDEX TO DRAWINGS |                                                                                                             |
|-------------------|-------------------------------------------------------------------------------------------------------------|
| SHEET NO.         | DESCRIPTION                                                                                                 |
| 2 - 68            | F.A.I. PROJECT NO. DPI-0203(1)<br>MOANALUA FREEWAY RESURFACING<br>HALAWA INTERCHANGE TO KAHAIKI INTERCHANGE |
| 69 - 163          | PROJ. NO. H1H-01-00M<br>INTERSTATE ROUTE H-1 REHABILITATION<br>OLA LANE TO KALIHI STREET                    |
| 164 - 234         | TRAFFIC CONTROL PLANS<br>F.A.I. PROJECT NO. DPI-0203(1)<br>PROJ. NO. H1H-01-00M                             |

STATE OF HAWAII

DEPARTMENT OF TRANSPORTATION

HIGHWAYS DIVISION

HONOLULU, HAWAII

"AS-BUILT"

PLANS FOR

MOANALUA FREEWAY RESURFACING

HALAWA INTERCHANGE TO KAHAIKI INTERCHANGE

FEDERAL AID PROJECT NO. DPI-0203(1)

DISTRICTS OF EWA AND HONOLULU

AND



INTERSTATE ROUTE H-1 REHABILITATION

OLA LANE TO KALIHI STREET

PROJECT NO. H1H-01-00M

DISTRICT OF HONOLULU

ISLAND OF OAHU

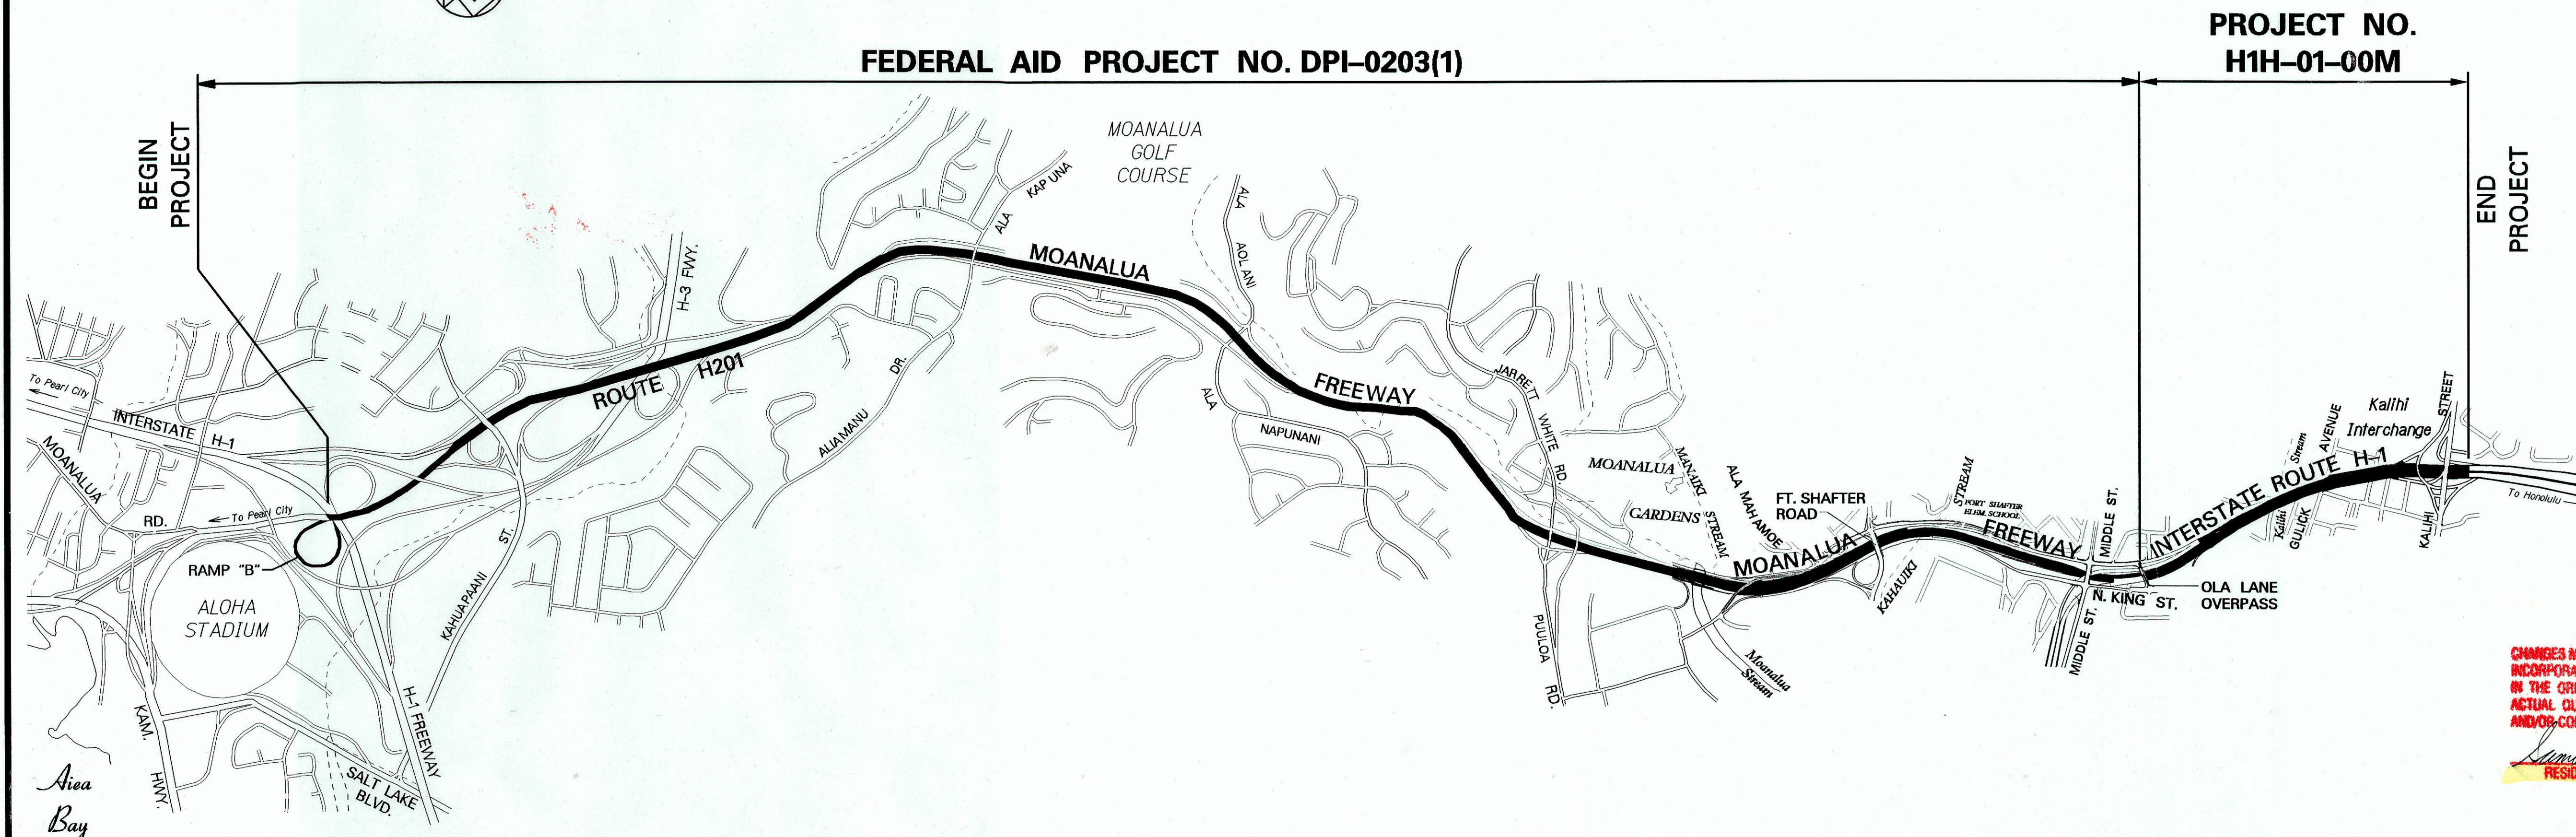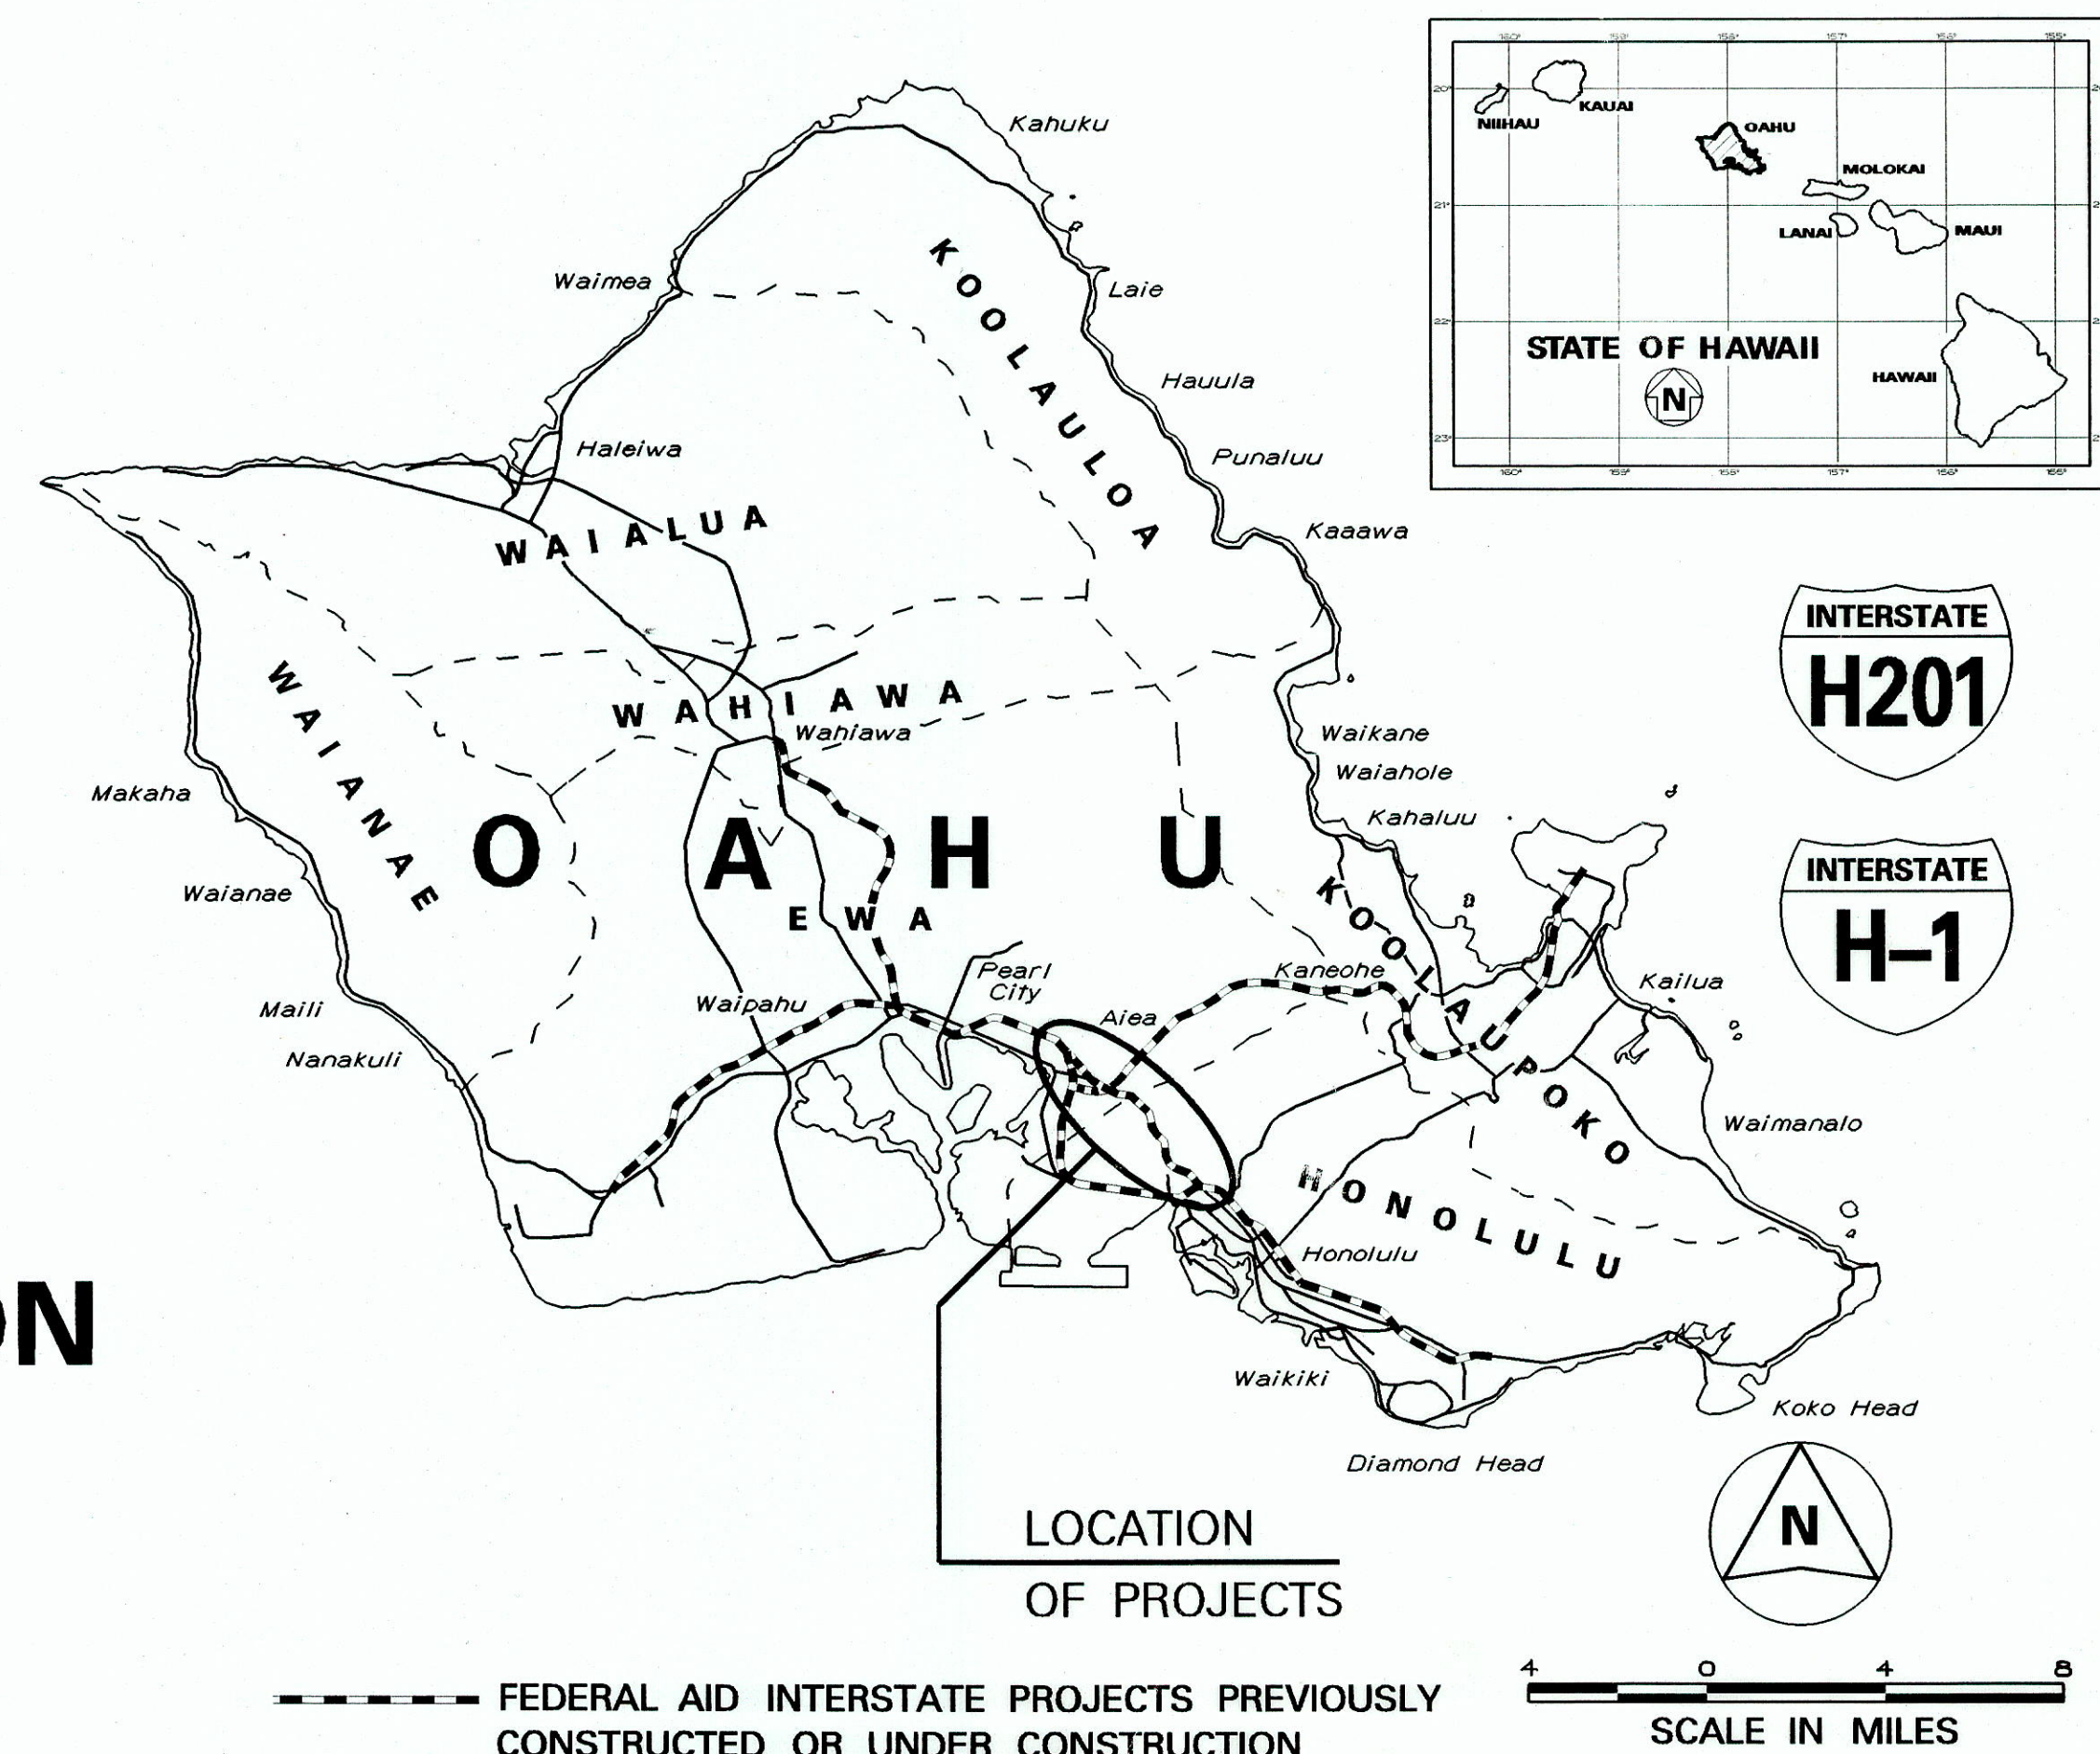

CHANGES MADE DURING CONSTRUCTION HAVE BEEN INCORPORATED ON THESE PLANS EXCEPT CHANGES IN THE ORIGINAL THEORETICAL QUANTITIES. FOR ACTUAL QUANTITIES, REFER TO PROJECT LEDGER AND/OR COMPUTATION BOOK.

*Samuel M. [Signature]* 6/30/14  
RESIDENT ENGINEER DATE