



FED. ROAD DIST. NO.	STATE	FEDERAL AID PROJ. NO.	FISCAL YEAR	SHEET NO.	TOTAL SHEETS
HAWAII	HAW.	NH-H1-K(246)	2004	70	105

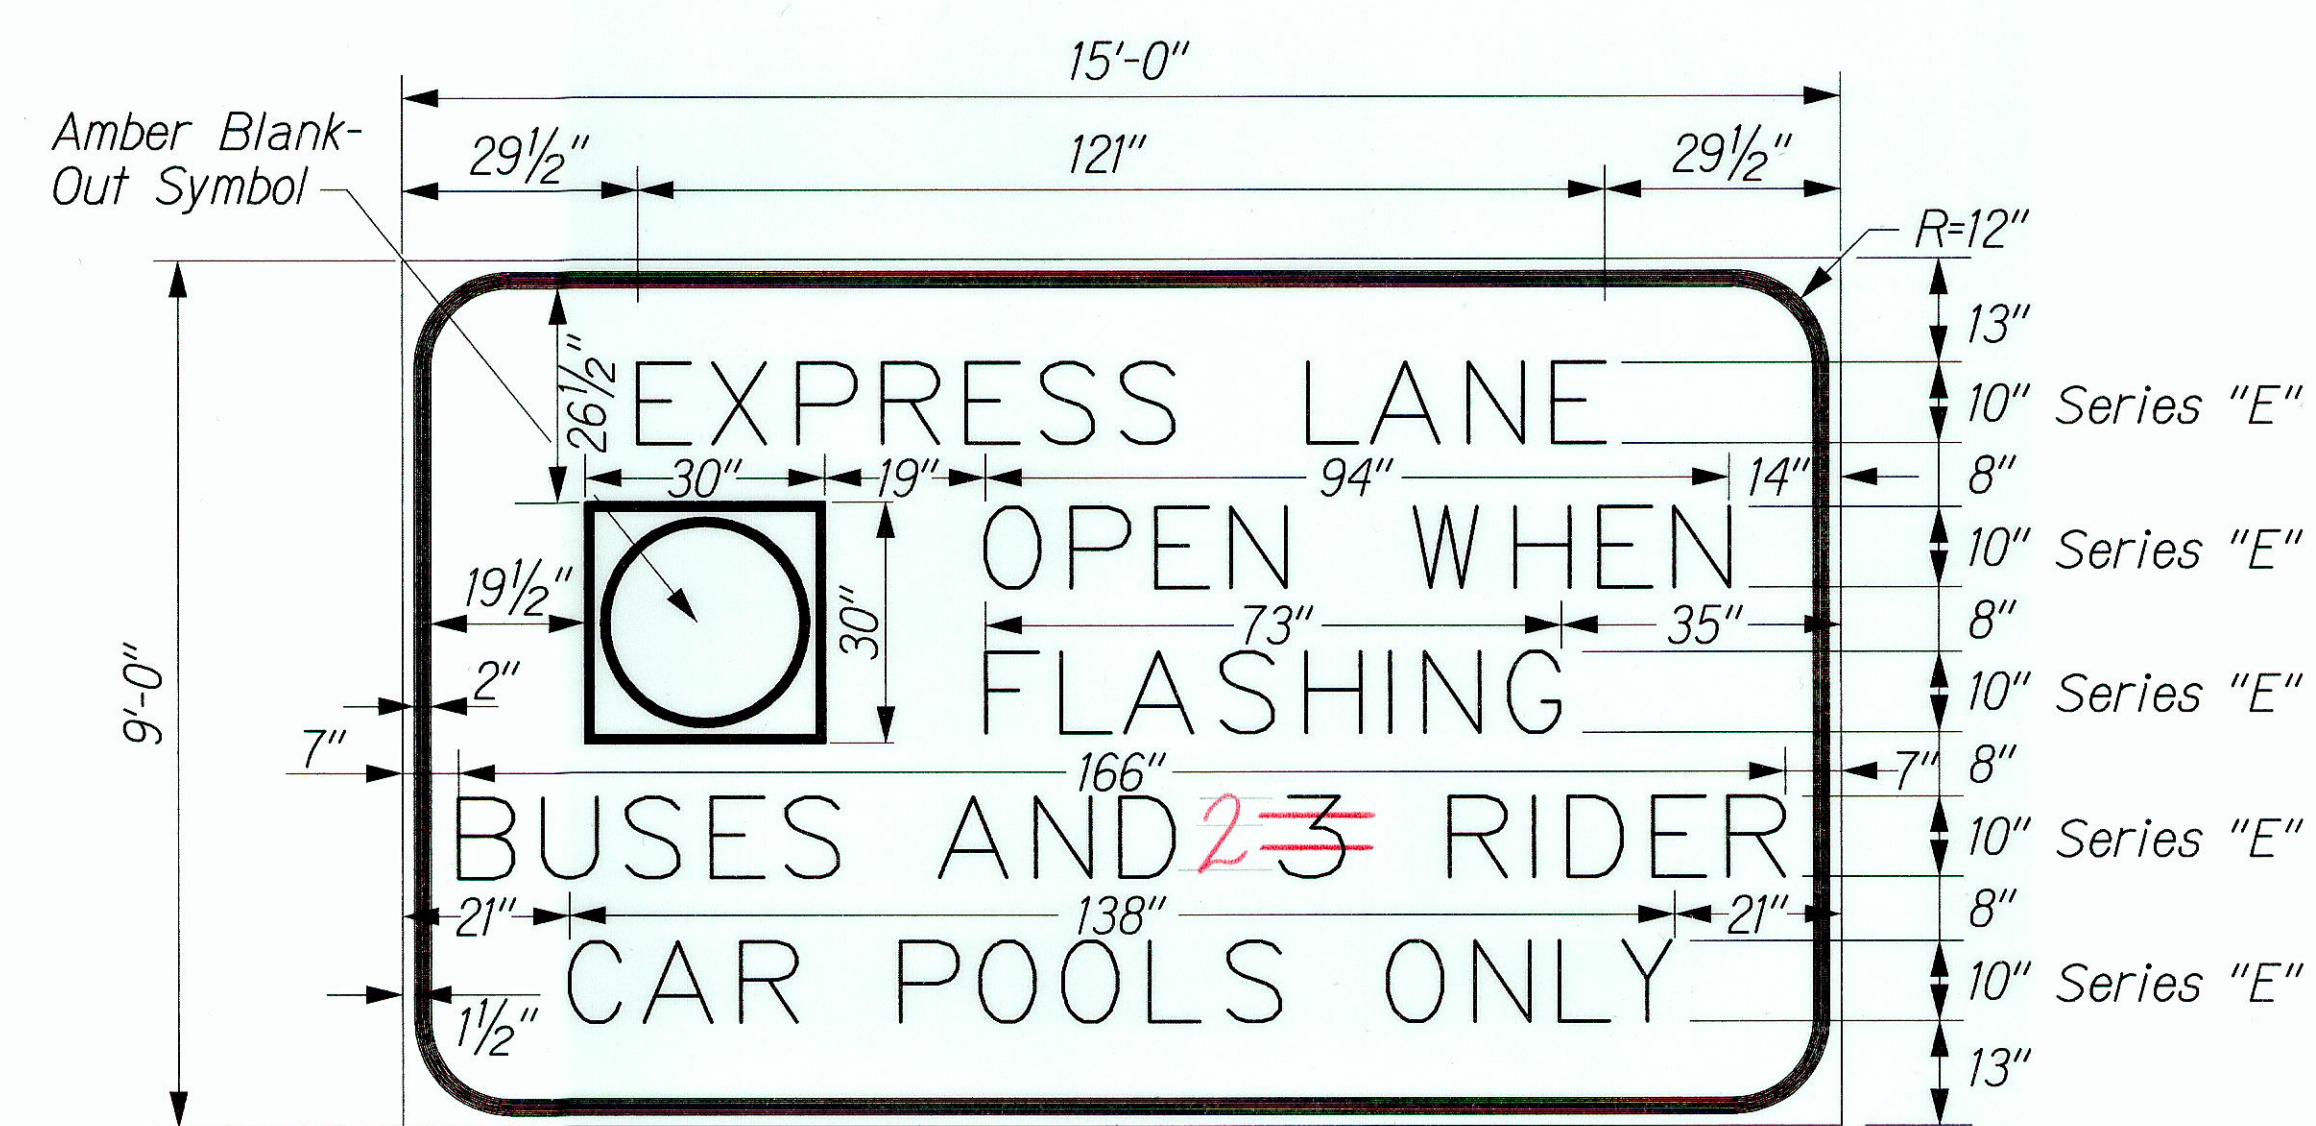


DS-1

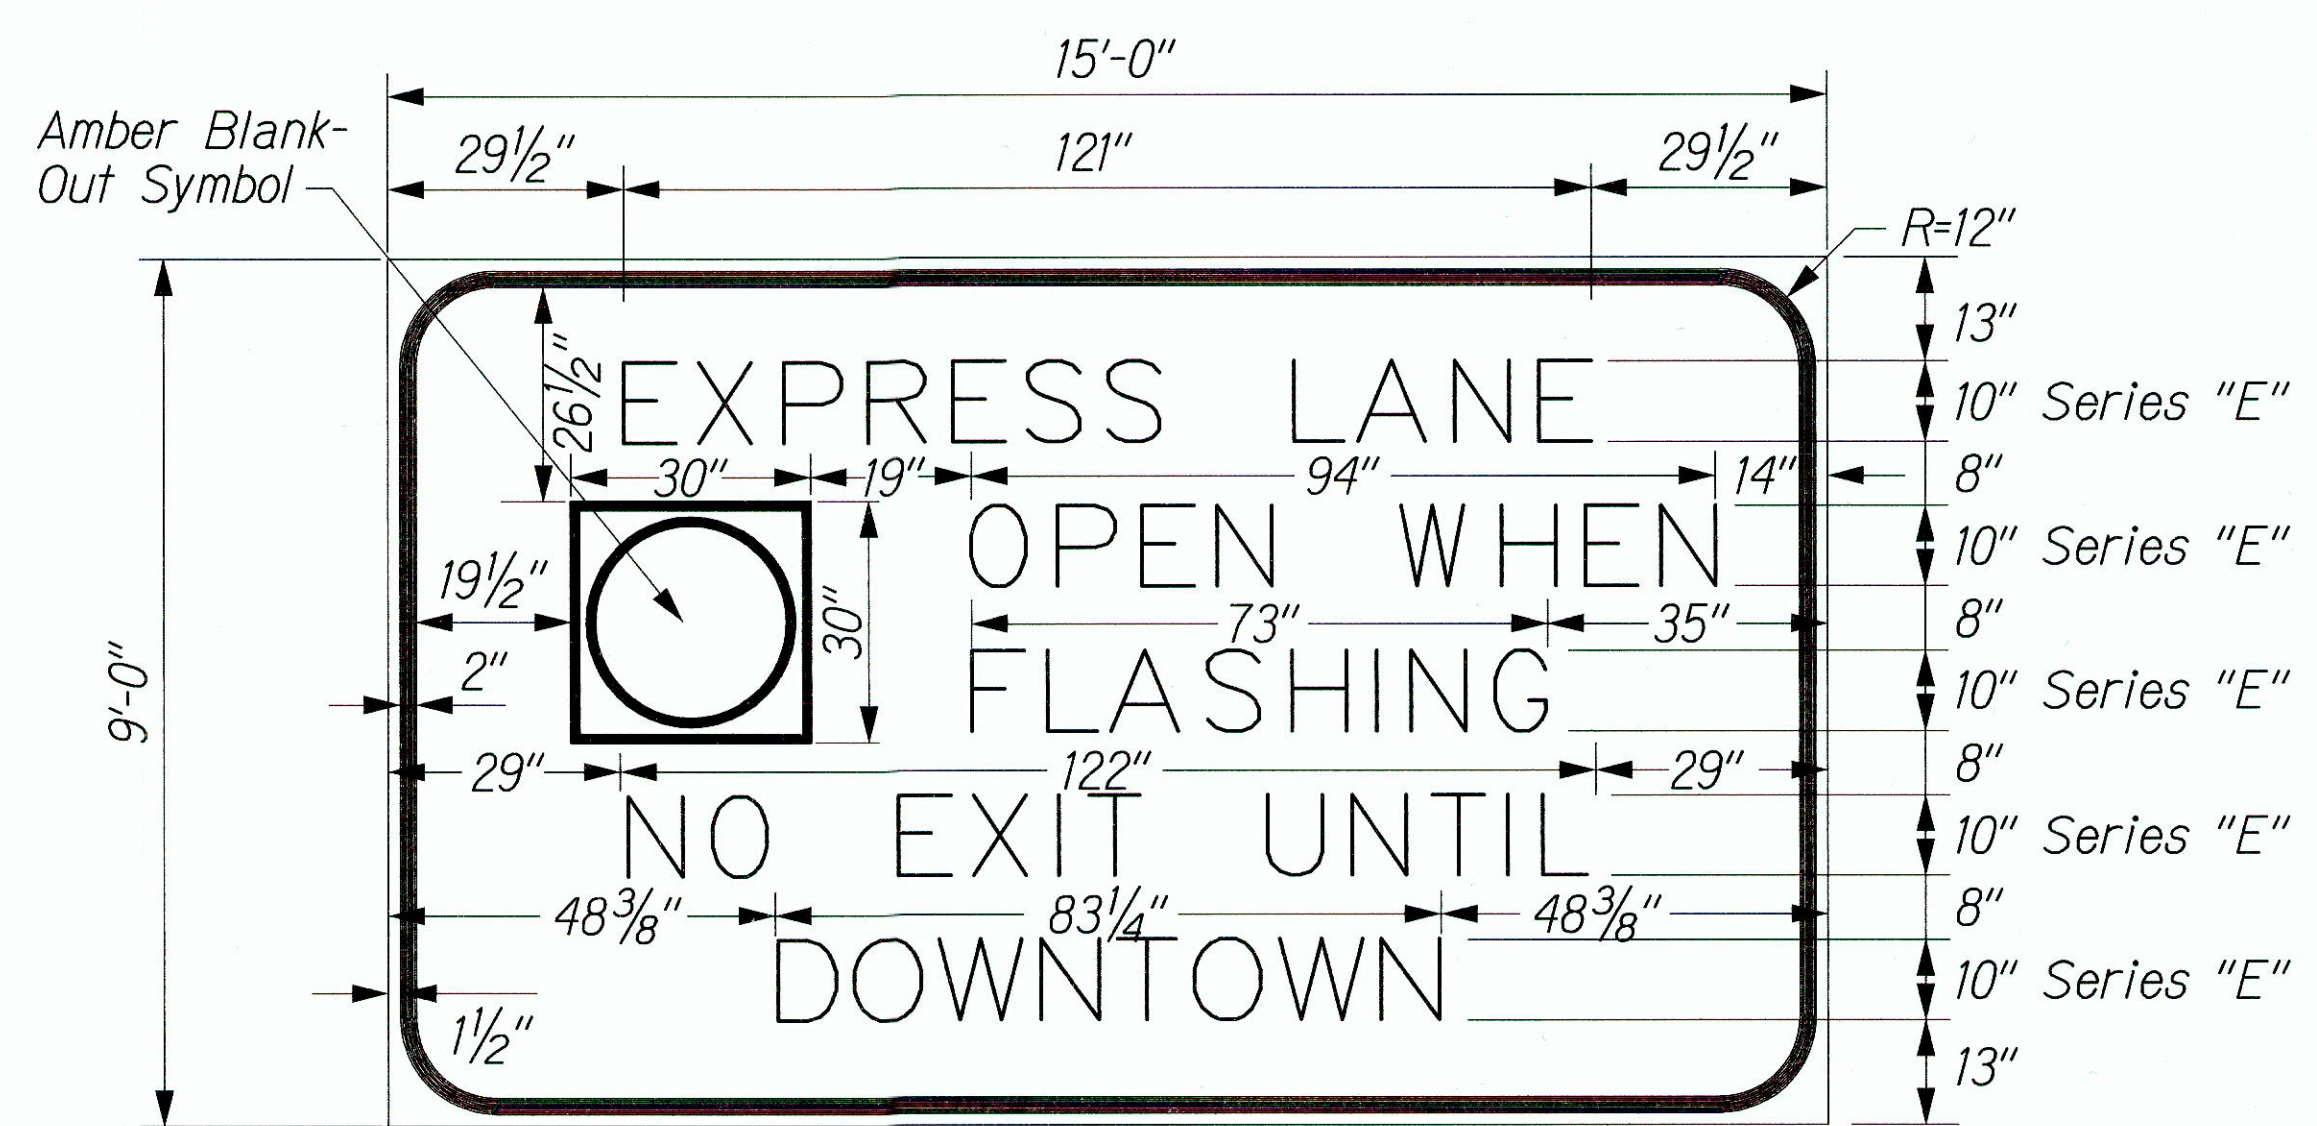


DS-2


Colors
Legend: Black (Non-Ref.)
Background: White (Ref.)
Border: Black

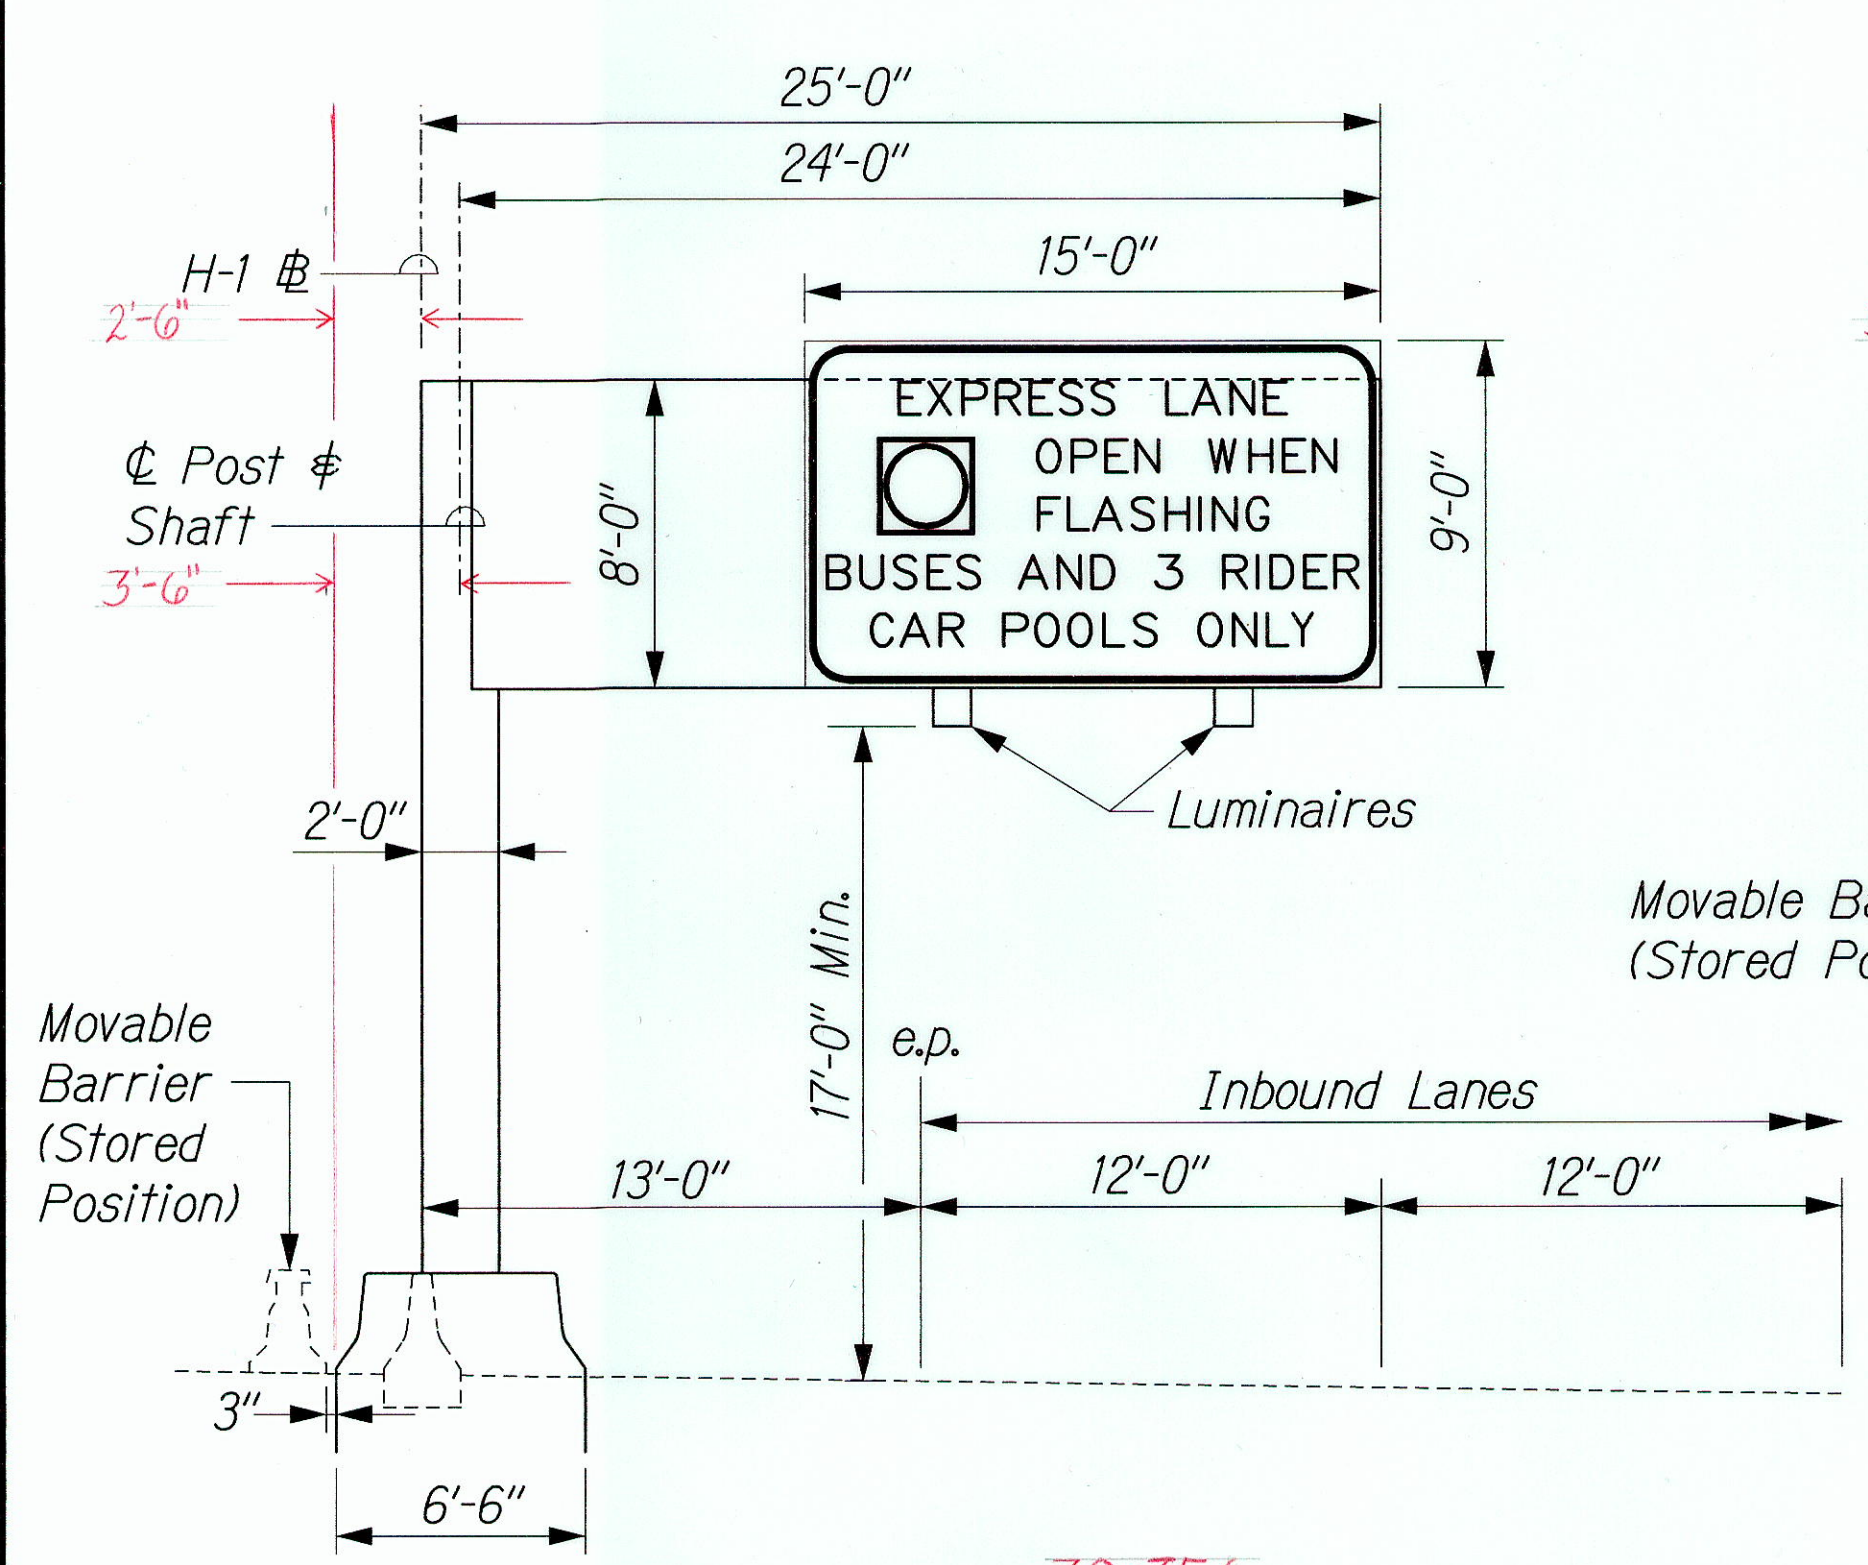

H-1 # Sta. 39+75.6
Scale: 1" = 5'-0" Per RFI 33

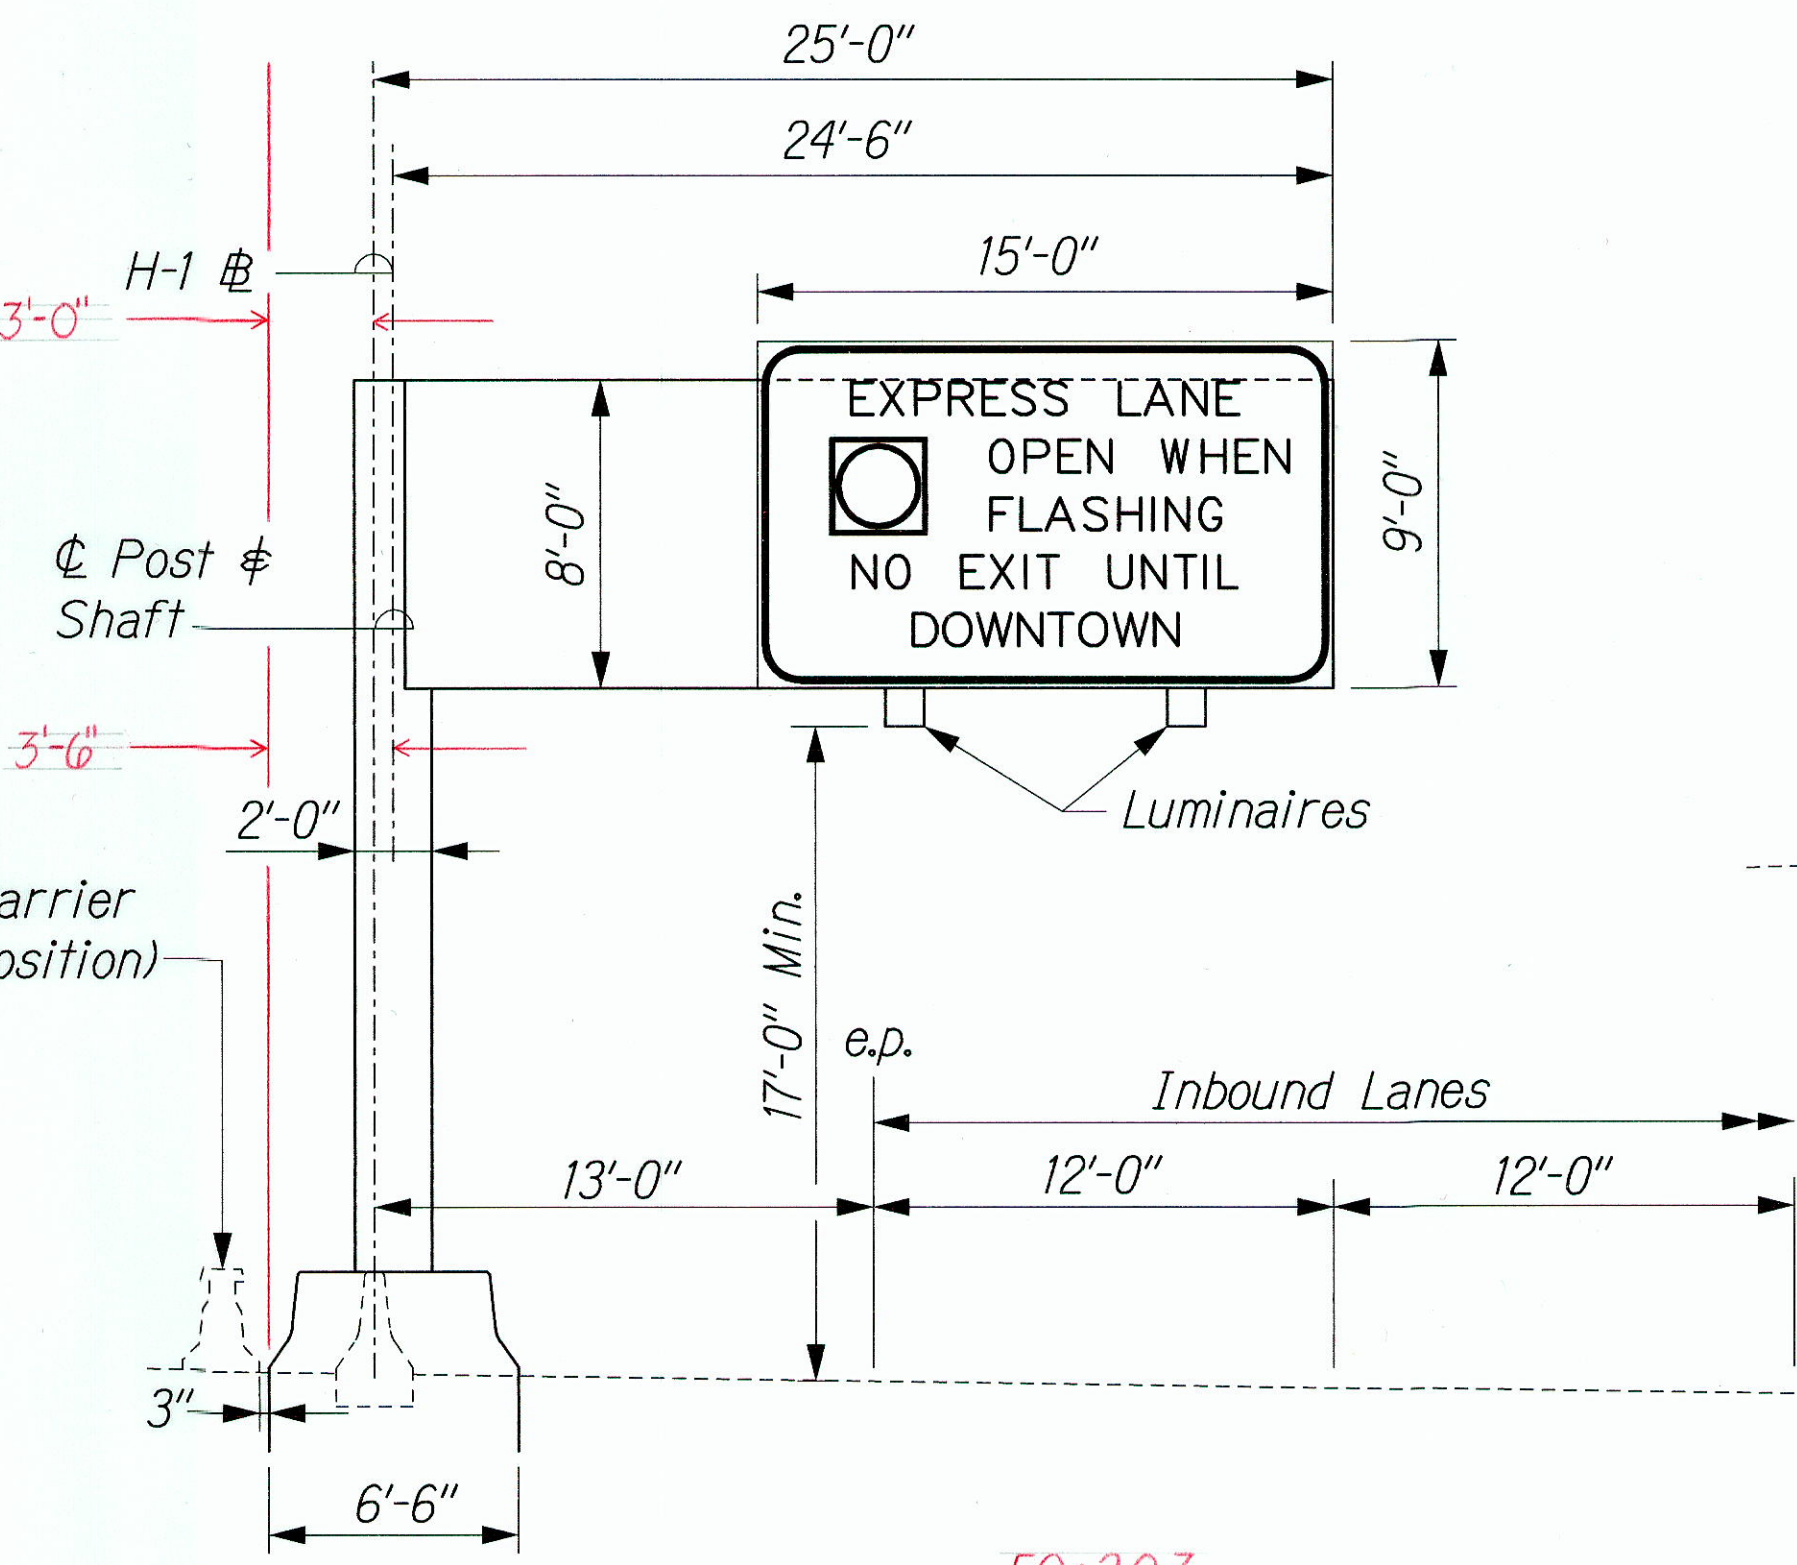

H-1 # Sta. 50+20.3
Scale: 1" = 5'-0" Per RFI 33

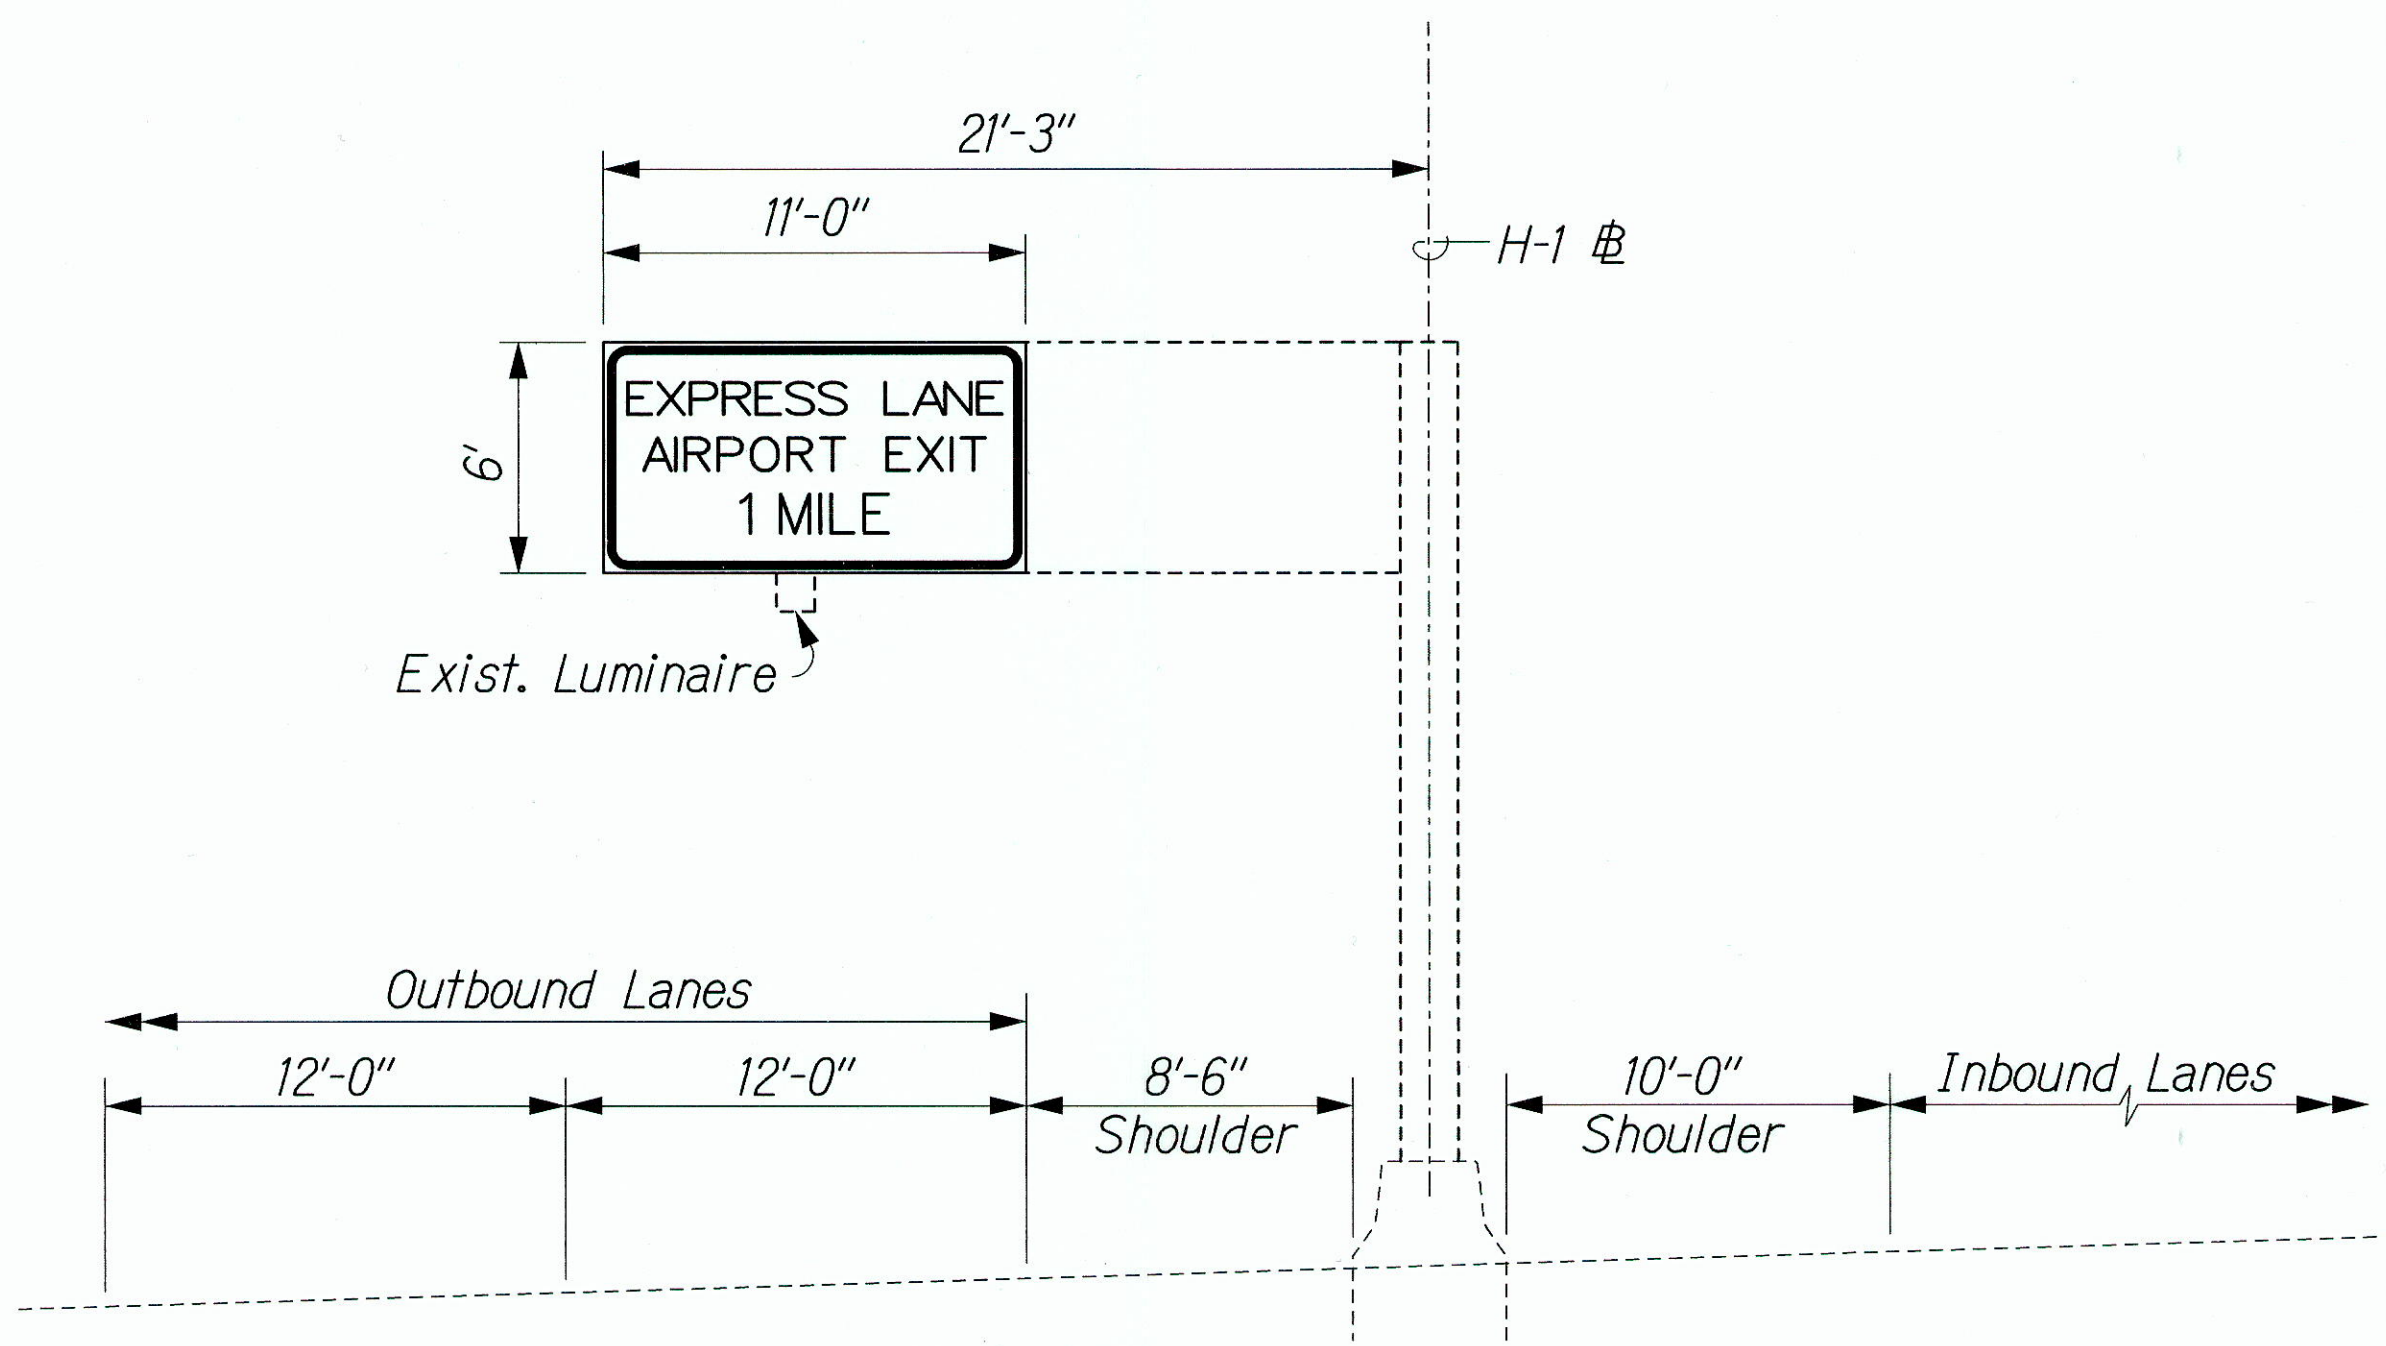

H-1 # Sta. 35+70±
Scale: 1" = 5'-0"

NOTE:
The Contractor shall field verify the exact location and grades for each Sign Support Pile Foundation prior to preparing Shop Drawings for Sign Support Frame Structures to determine the exact height of Sign Support Post and Panel.

ORIGINAL PLAN	DATE
NOTED BY	DESIGNED BY
CHECKED BY	QUANTITIES BY
DATE	DATE

1/4 ZIPPER EXTENSION/STRUCT/SIGNELL.dgn

THIS WORK WAS PREPARED BY ME OR UNDER MY SUPERVISION.

Perry M. Small

STATE OF HAWAII
DEPARTMENT OF TRANSPORTATION
HIGHWAYS DIVISION

**SIGN ELEVATION ASSEMBLY
AND SIGN PANEL LAYOUT DETAILS**

INTERSTATE ROUTE H-1 ZIPPER LANE EXTENSION
RADFORD DRIVE OVERPASS TO KEEHI INTERCHANGE
FEDERAL AID PROJECT NO. NH-H1-K(246)

Scale: 1" = 5'-0" Date: Mar. 2, 2004

"AS-BUILT"

