

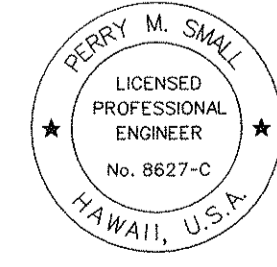
FED. ROAD DIST. NO.	STATE	FEDERAL AID PROJ. NO.	FISCAL YEAR	SHEET NO.	TOTAL SHEETS
HAWAII	HAW.	NH-HI-1(246)	2004	72	105

PAVEMENT MARKING SUMMARY	
DESCRIPTION	QUANTITY
PAVEMENT MARKERS	
TYPE A	225 EA
TYPE C	75 EA
TYPE H	330 EA
TYPE J	160 EA
TAPE, TYPE I OR THERMOPLASTIC EXTRUSION	
4-INCH PAVEMENT STRIPING	1,930 LF
TAPE, TYPE II OR THERMOPLASTIC EXTRUSION	
4-INCH PAVEMENT STRIPING	9,300 LF
8-INCH PAVEMENT STRIPING	810 LF
12-INCH PAVEMENT STRIPING	100 LF

SIGN SUMMARY	
DESCRIPTION	QUANTITY
CANTILEVER SIGN SUPPORT AND POST	4 EA
MEDIAN BARRIER MOUNTED SIGN POST	4 EA
PARAPET MOUNTED SIGN POST	6 EA
ELECTRONIC EXPRESSWAY SIGN (DS)	2 EA
PANEL FOR EXPRESSWAY SIGN (WS)	400 SF
ELECTRONIC EXPRESSWAY SIGN (WS-6)	3 EA
<del>OVERLAY PANEL FOR EXPRESSWAY SIGN</del> N.I.C.	<del>6 EA</del>
ELECTRONIC EXPRESSWAY SIGN (R-7)	1 EA
RELOCATE EXISTING SIGN	3 EA
REGULATORY AND WARNING SIGN (GREATER THAN 10 SQUARE FEET)	7 EA
RM-4	2 EA
CCOM CRASH CUSHION OBJECT MARKER	2 EA

DESIGNED BY	DATE
CHECKED BY	
QUANTITIES BY	
DESIGNED BY	
TRACED BY	
REVIEWED BY	
DATE	

\\ZIPPER\_EXTENSION\SIGN\SS-SUM.dgn

 <p>THIS WORK WAS PREPARED BY ME OR UNDER MY SUPERVISION.</p> <p><i>Perry M. Small</i></p>	<p>STATE OF HAWAII DEPARTMENT OF TRANSPORTATION HIGHWAYS DIVISION</p> <p><b>SIGNING &amp; PAVEMENT MARKING SUMMARY</b></p> <p>INTERSTATE ROUTE H-1 ZIPPER LANE EXTENSION RADFORD DRIVE OVERPASS TO KEEHI INTERCHANGE FEDERAL AID PROJECT NO. NH-HI-1(246)</p> <p>Scale: None Date: Mar. 2, 2004</p>
	<p>SHEET No. P19 OF 19 SHEETS</p>