

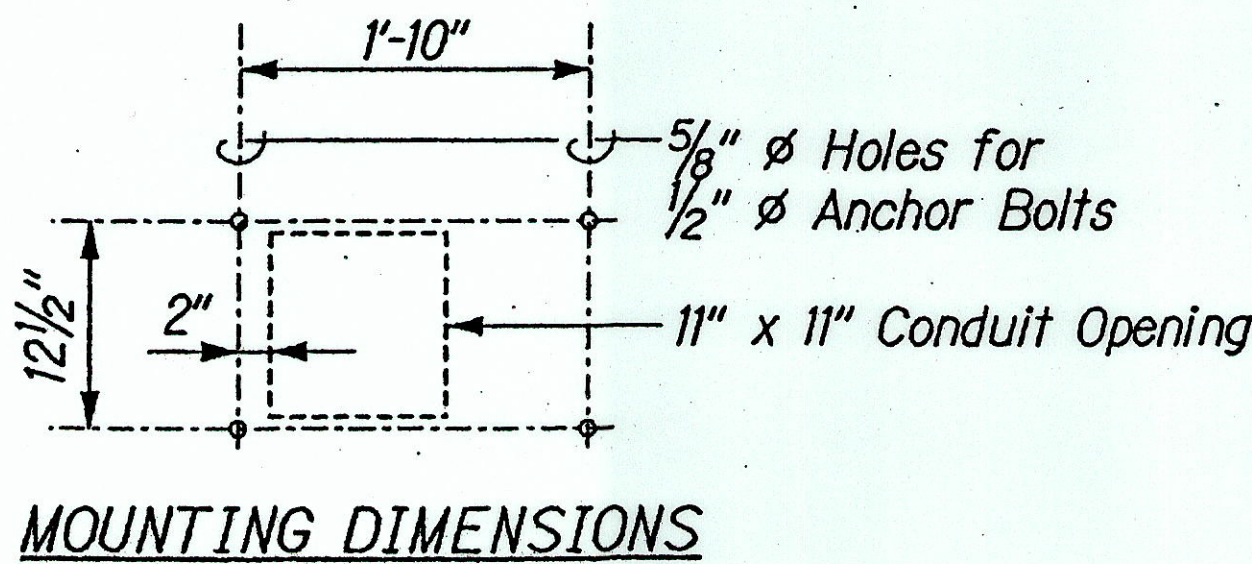
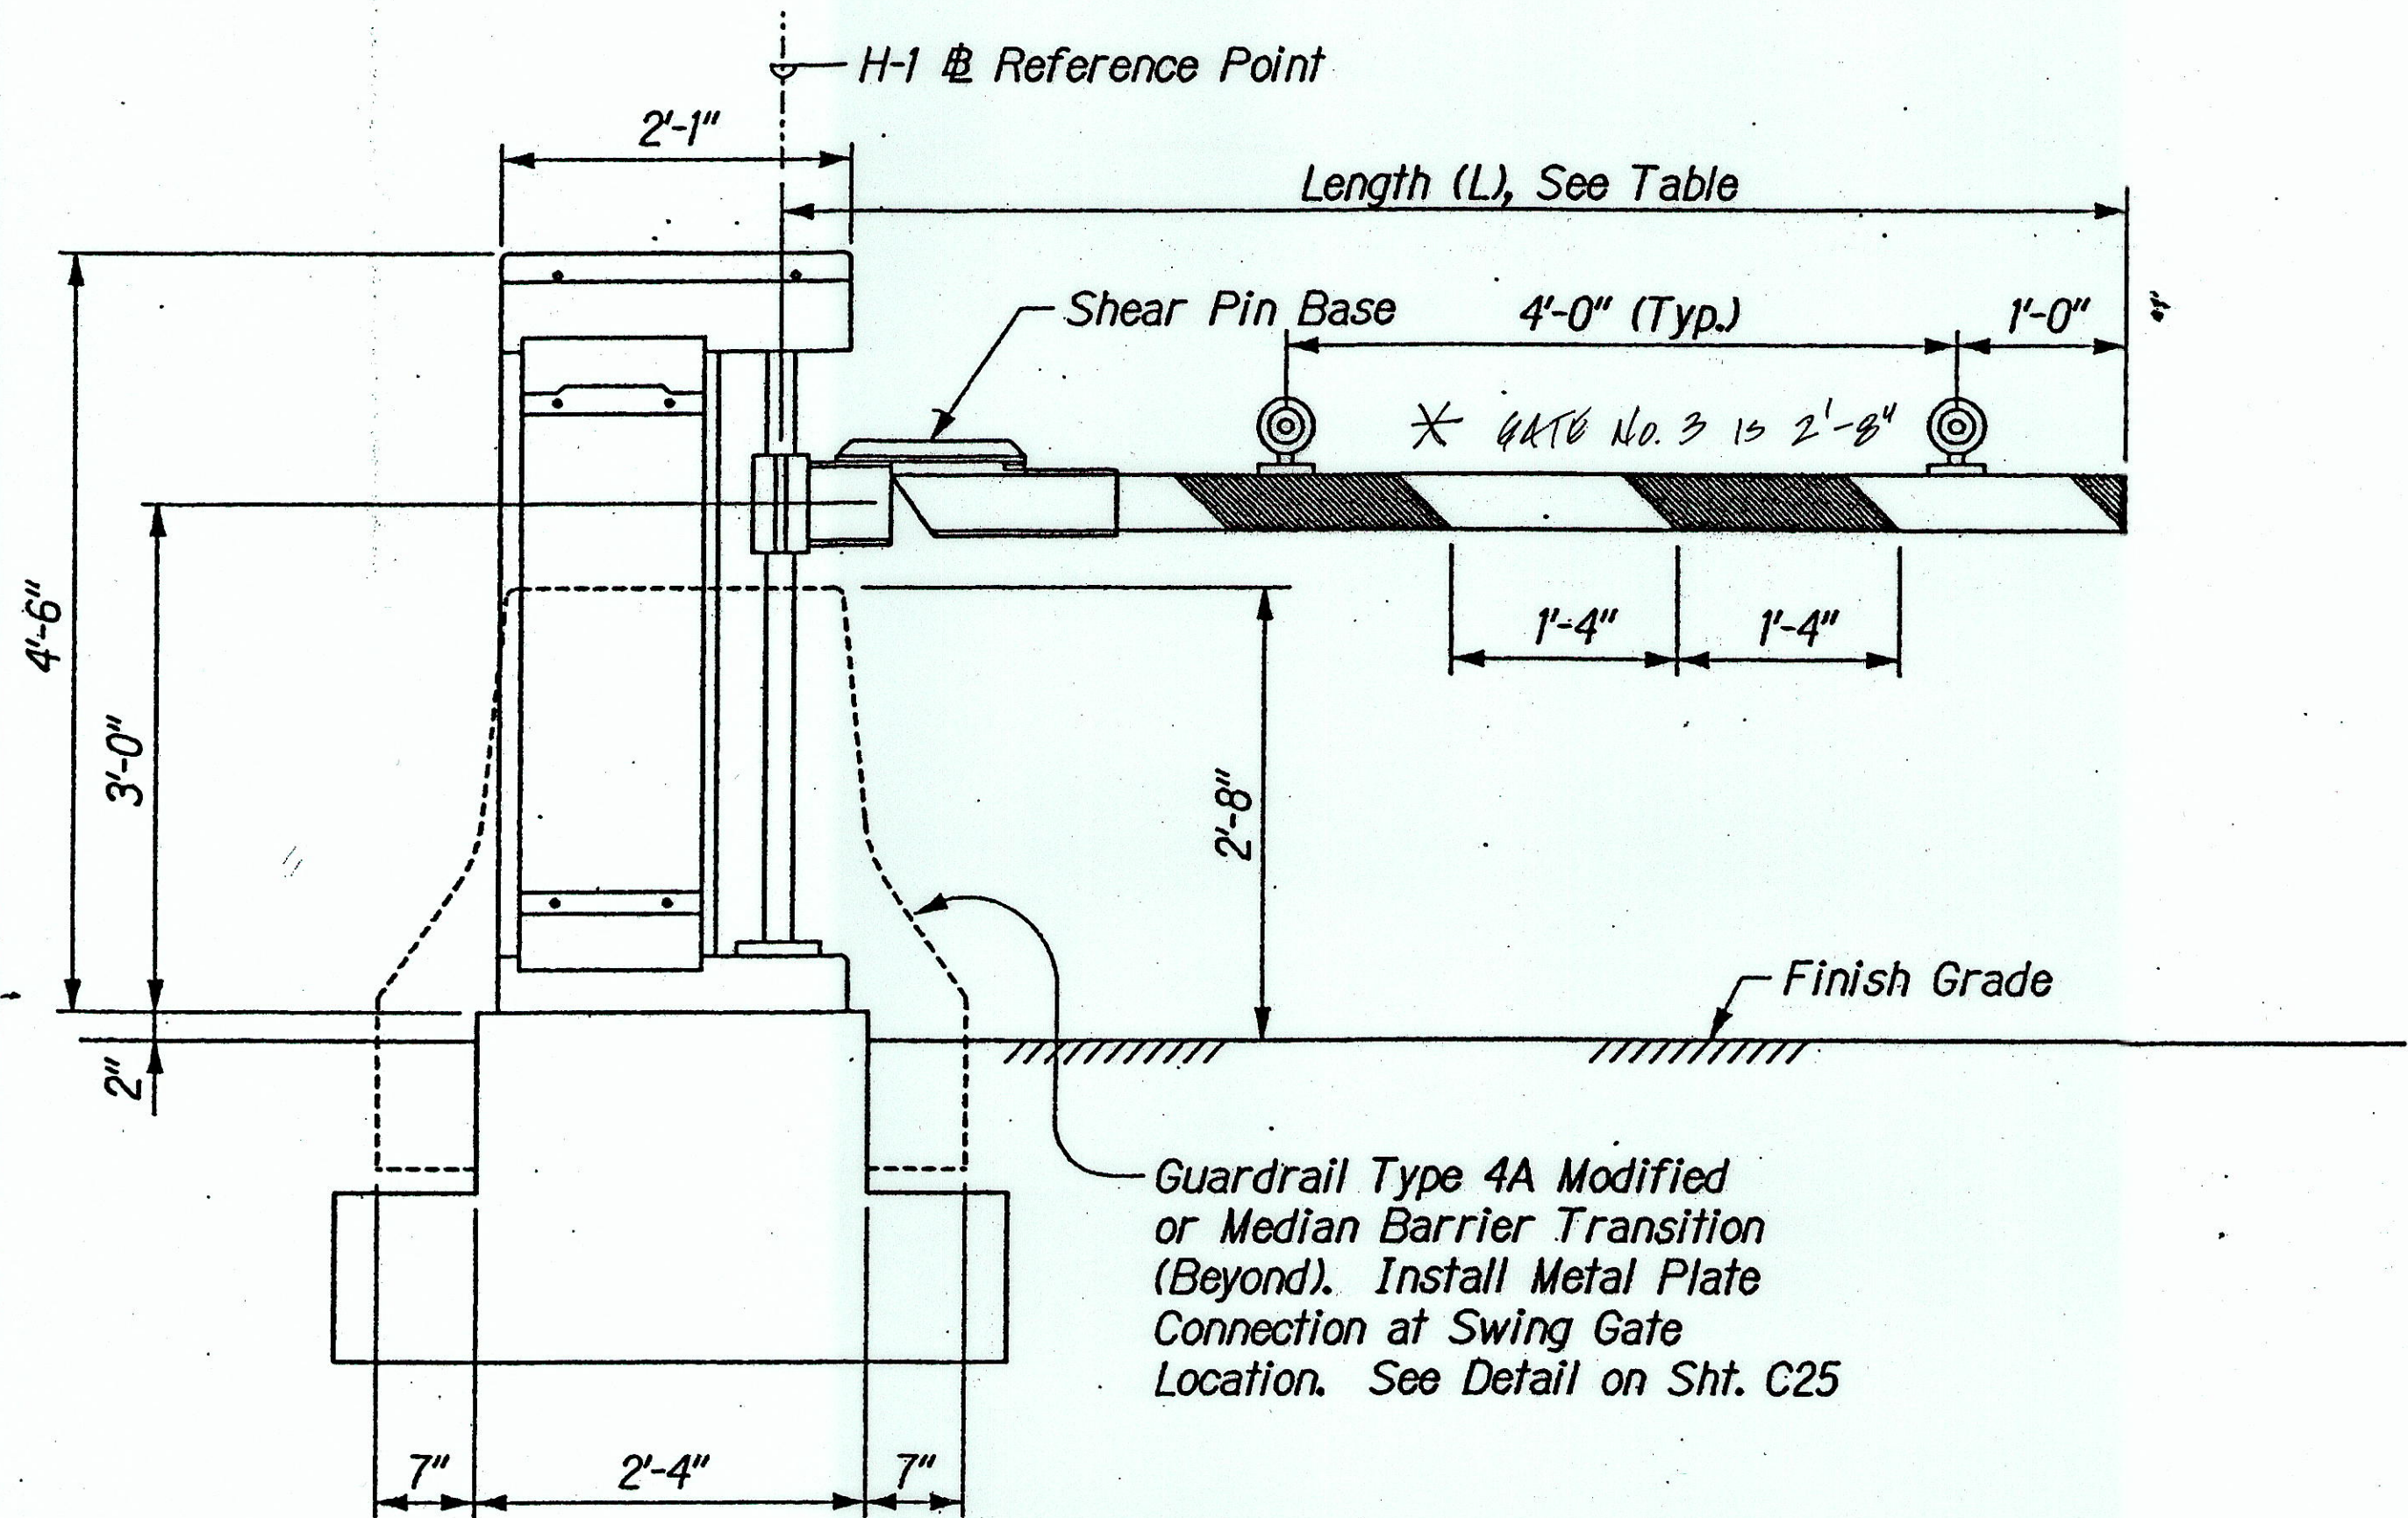


TABLE OF SWING GATES


Gate No.	Location	Length (L)	Rotation	Light Qty.
1	H-1 @ Sta. 68+65, 1.38' Rt.	8'-0"	90° CCW	2
2	H-1 @ Sta. 69+21.5, 1.38' Rt.	7'-0"	90° CCW	2
3	H-1 @ Sta. 77+75, 6.08' Rt.	7'-0" S-1"	90° CW	2
	72+05, 4.59'			

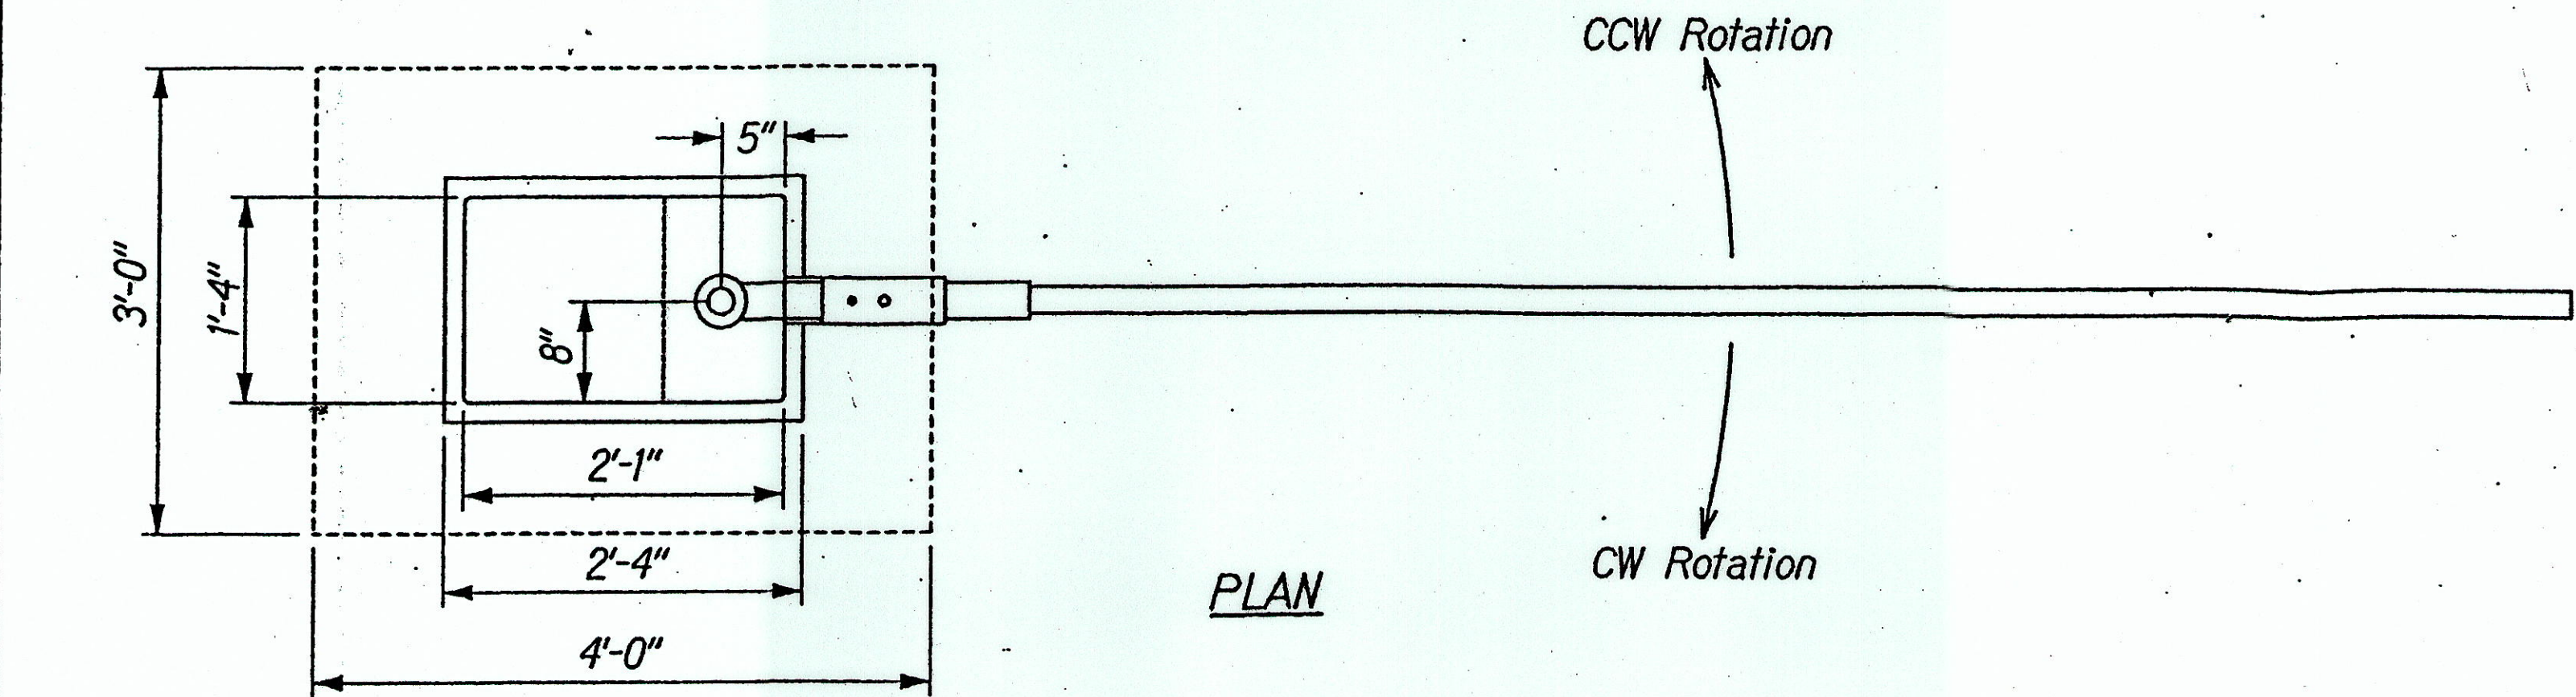

GATE STAND DETAIL A C24C24

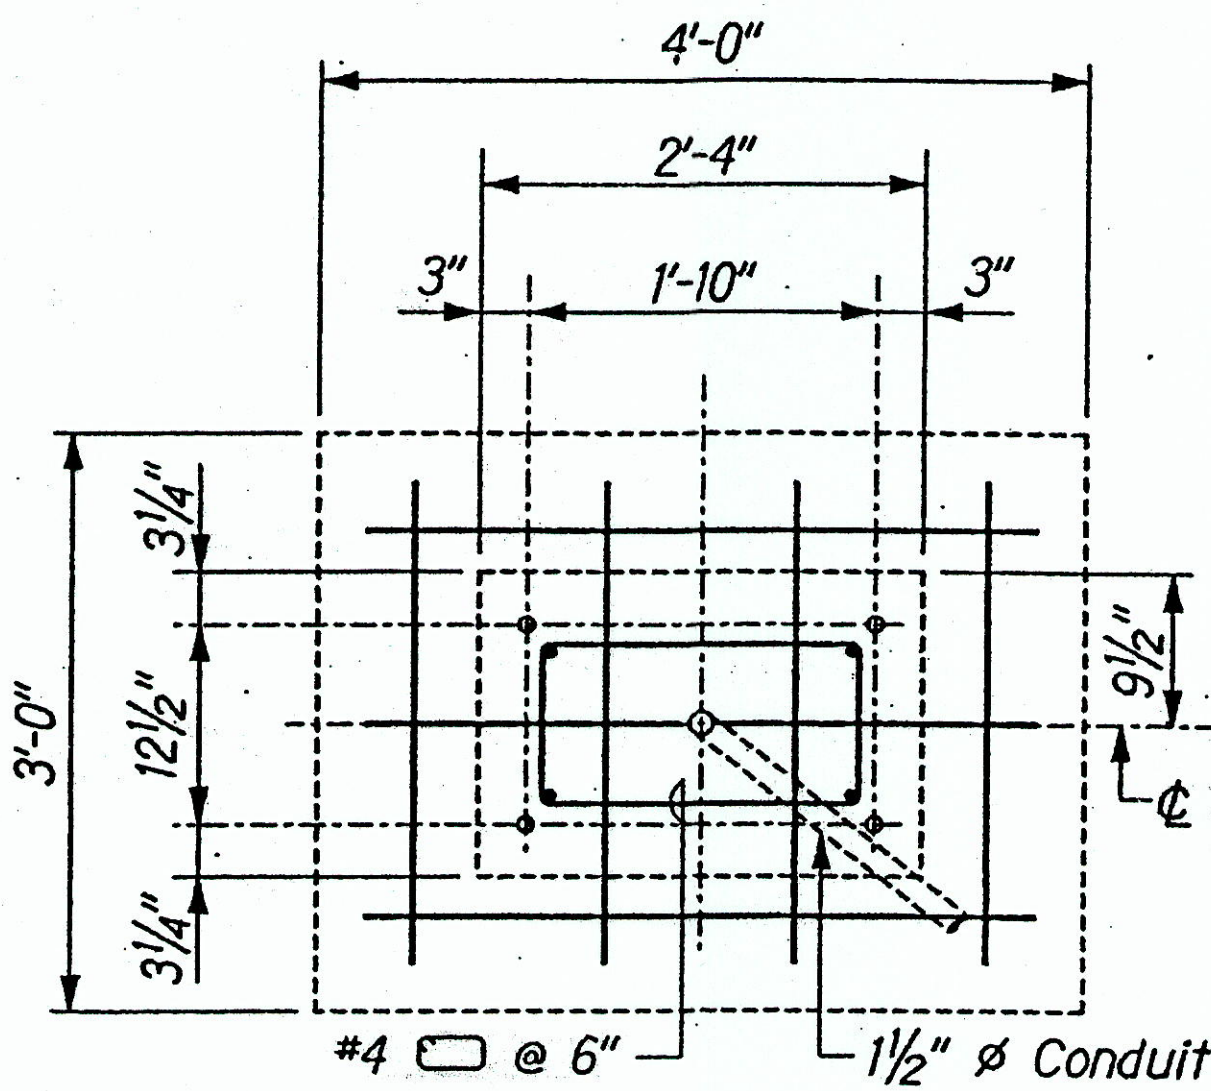

SWING GATE INSTALLATION DETAIL Scale: 1" = 1'-0"

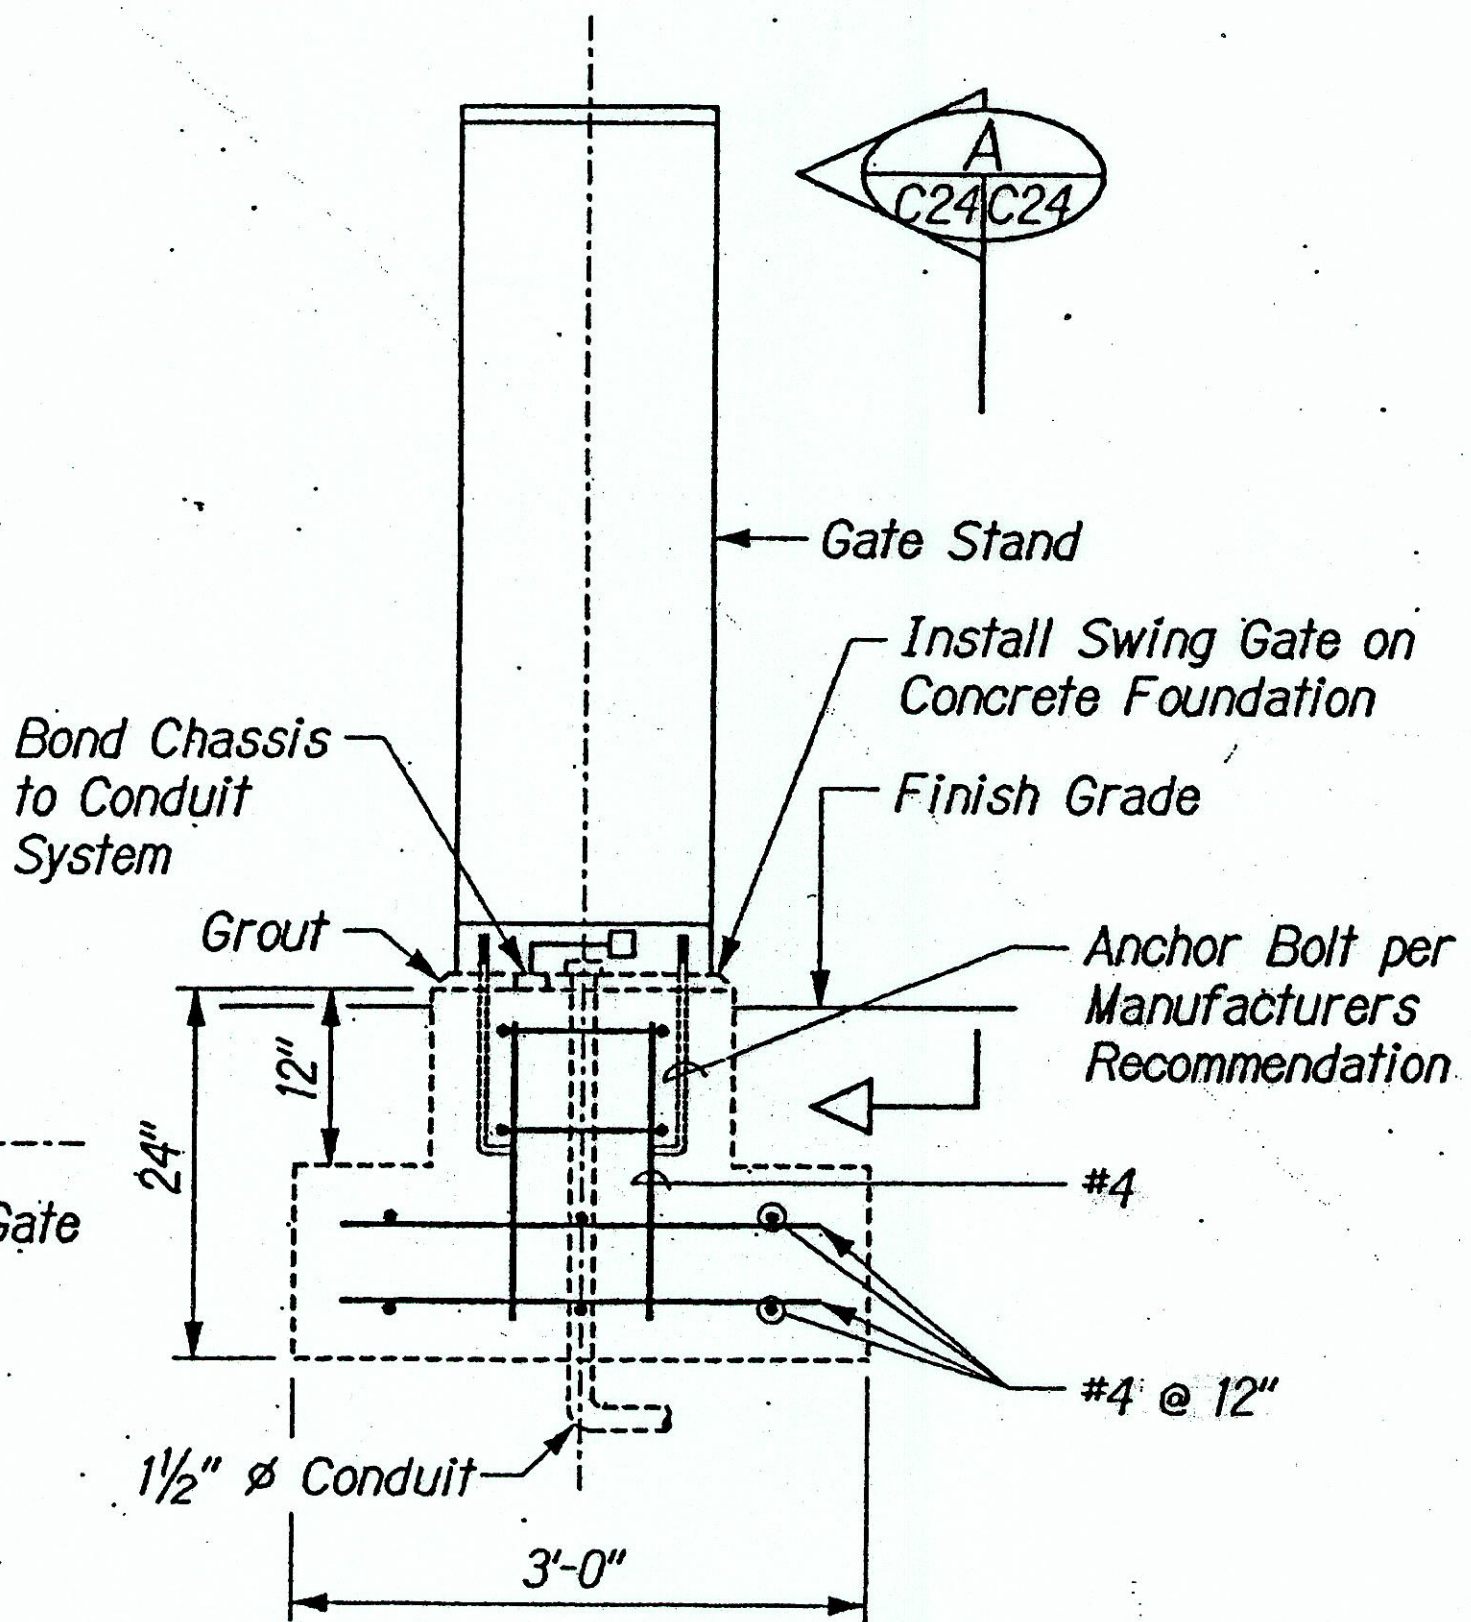

Date	Revision
9/28/04	Revise Swing Gate Footing Information

THIS WORK WAS PREPARED BY ME OR UNDER MY SUPERVISION.

Hui Pong Chen

STATE OF HAWAII
DEPARTMENT OF TRANSPORTATION
HIGHWAYS DIVISION

SWING GATE DETAILS

INTERSTATE ROUTE H-1 ZIPPER LANE EXTENSION
RADFORD DRIVE OVERPASS TO KEEHI INTERCHANGE
FEDERAL AID PROJECT NO. NH-HI-K246

Scale: 1" = 1'-0" Date: Mar. 2, 2004

SHEET No. C24 OF 29 SHEETS