


FED. ROAD DIST. NO.	STATE	FED. AID PROJ. NO.	FISCAL YEAR	SHEET NO.	TOTAL SHEETS
HAWAII	HAW.	IM-H1-1(254)	2006	9	31

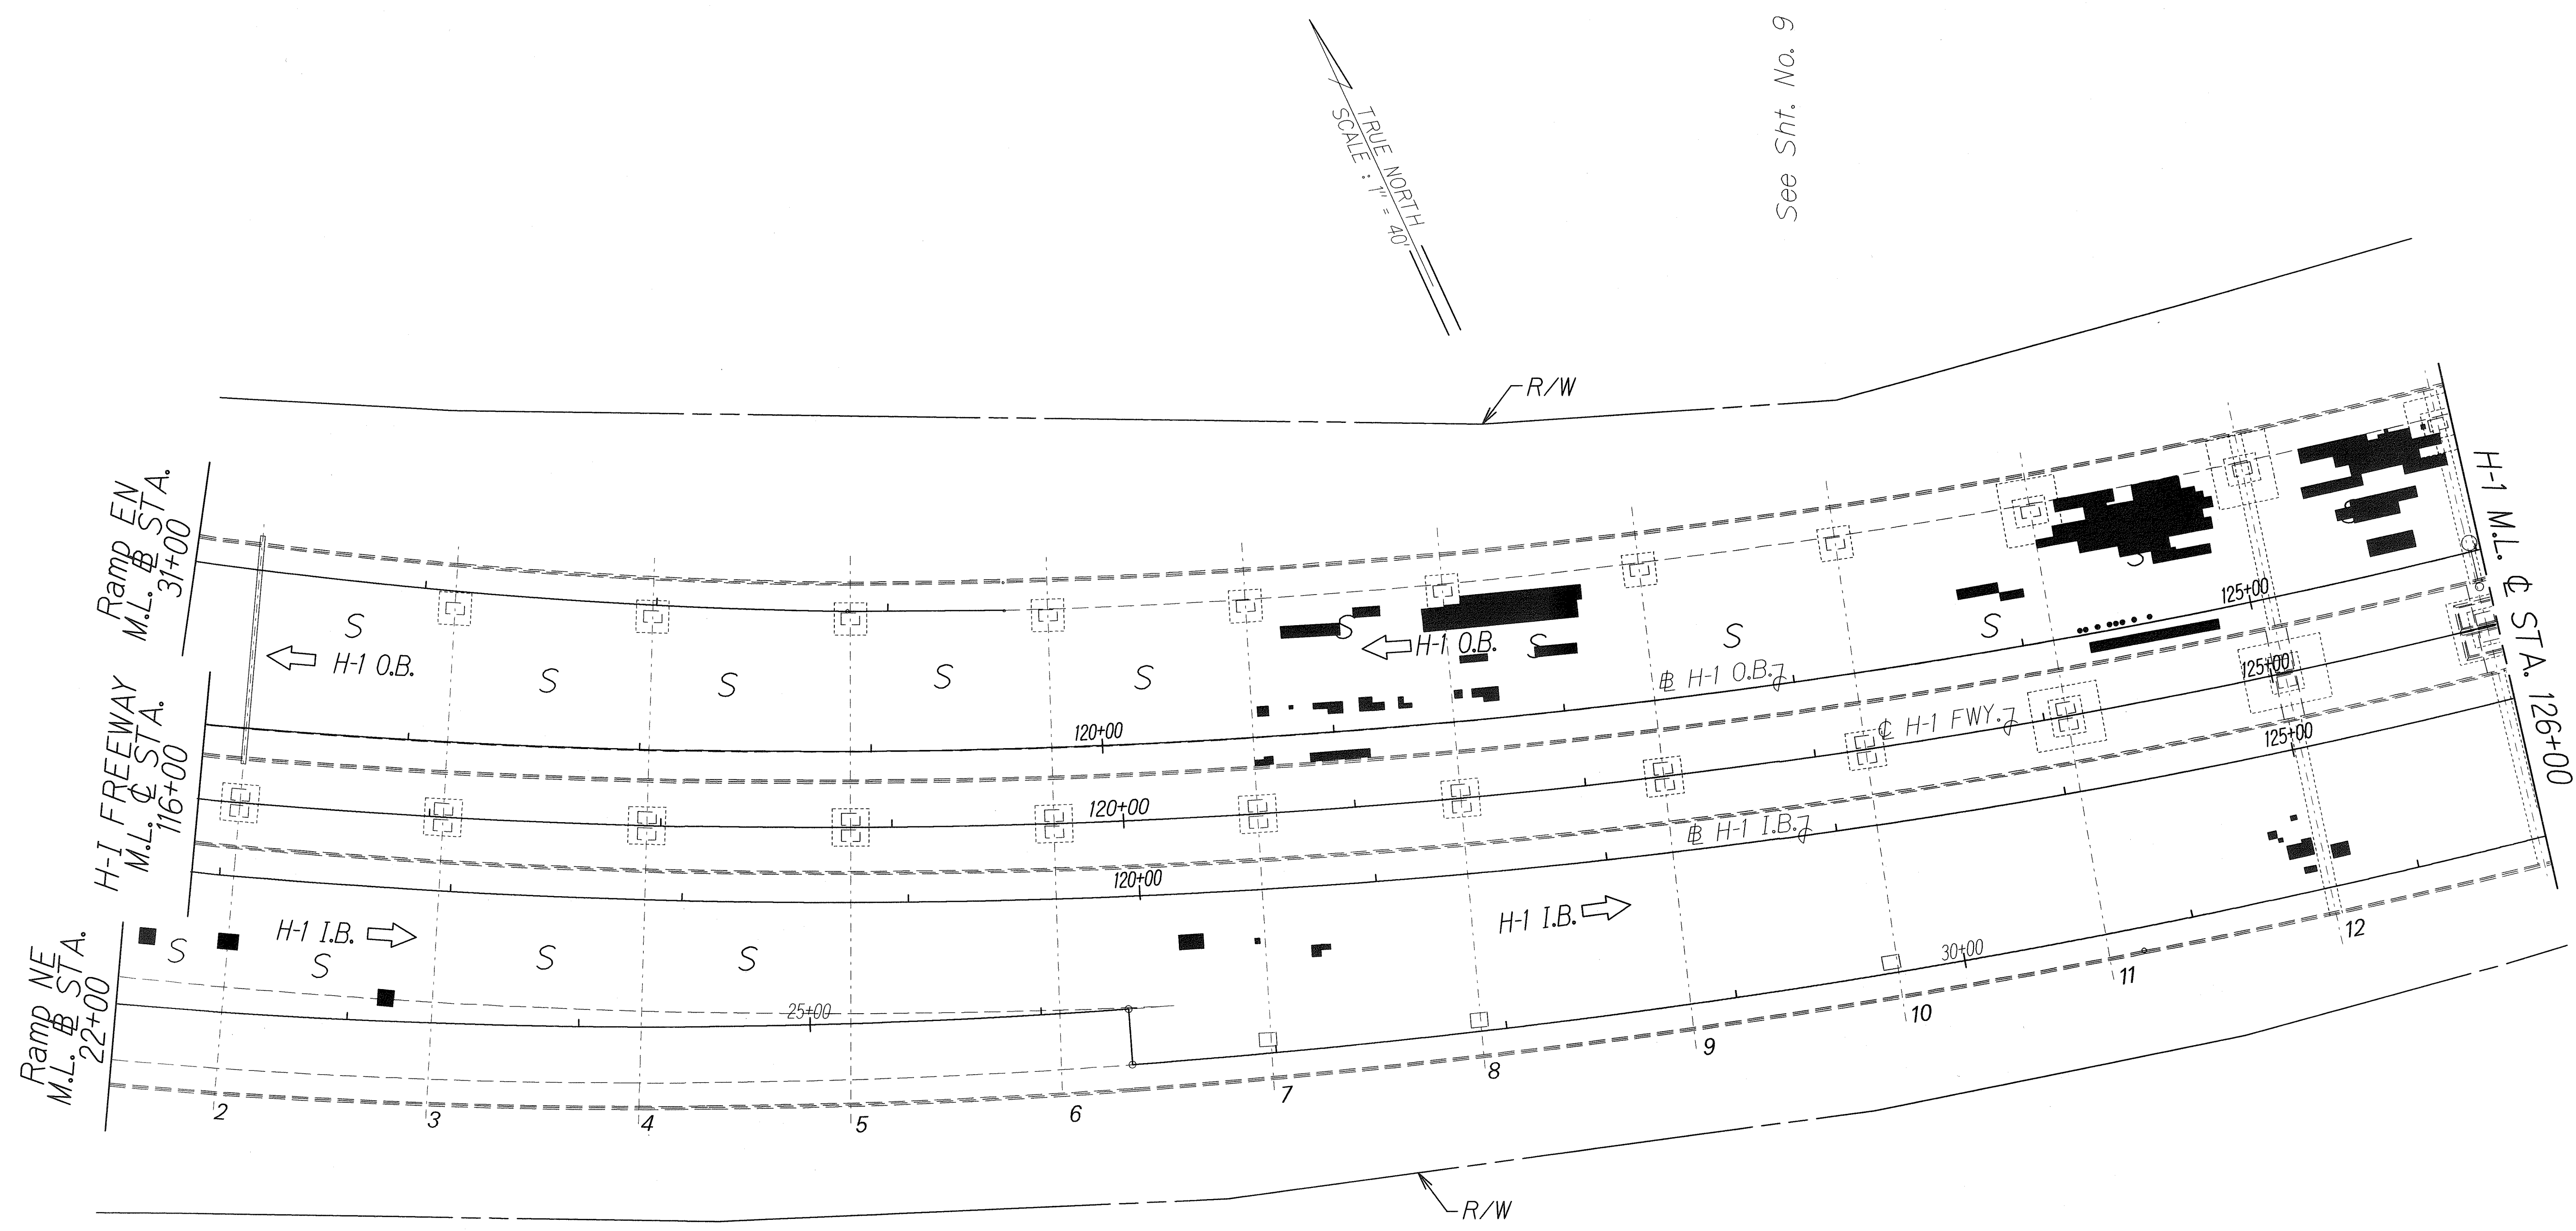

ORIGINAL PLAN	SURVEY PLOTTED BY	DATE
NOTE BOOK	DRAWN BY	
3/11/02/000	DESIGNED BY	
	QUANTITIES BY	
	CHECKED BY	

LEGEND FOR AS-BUILT POSTINGS	
	Squiggly line for as-built deletion
	Double line for as-built deletion
Roadway	Text for as-built posting

STATE OF HAWAII
DEPARTMENT OF TRANSPORTATION
HIGHWAYS DIVISION

ROADWAY PLAN

INTERSTATE ROUTE H-1

AIRPORT VIADUCT DECK REPAIR


VICINITY OF VALKENBURGH ST. TO MIDDLE ST.

Federal Aid Project No. IM-H1-1(254)

Scale: 1" = 40' Date: OCTOBER, 2005

SHEET No. 2 OF 22 SHEETS

FED. ROAD DIST. NO.	STATE	FED. AID PROJ. NO.	FISCAL YEAR	SHEET NO.	TOTAL SHEETS
HAWAII	HAW.	IM-H1-1(254)	2006	10	31

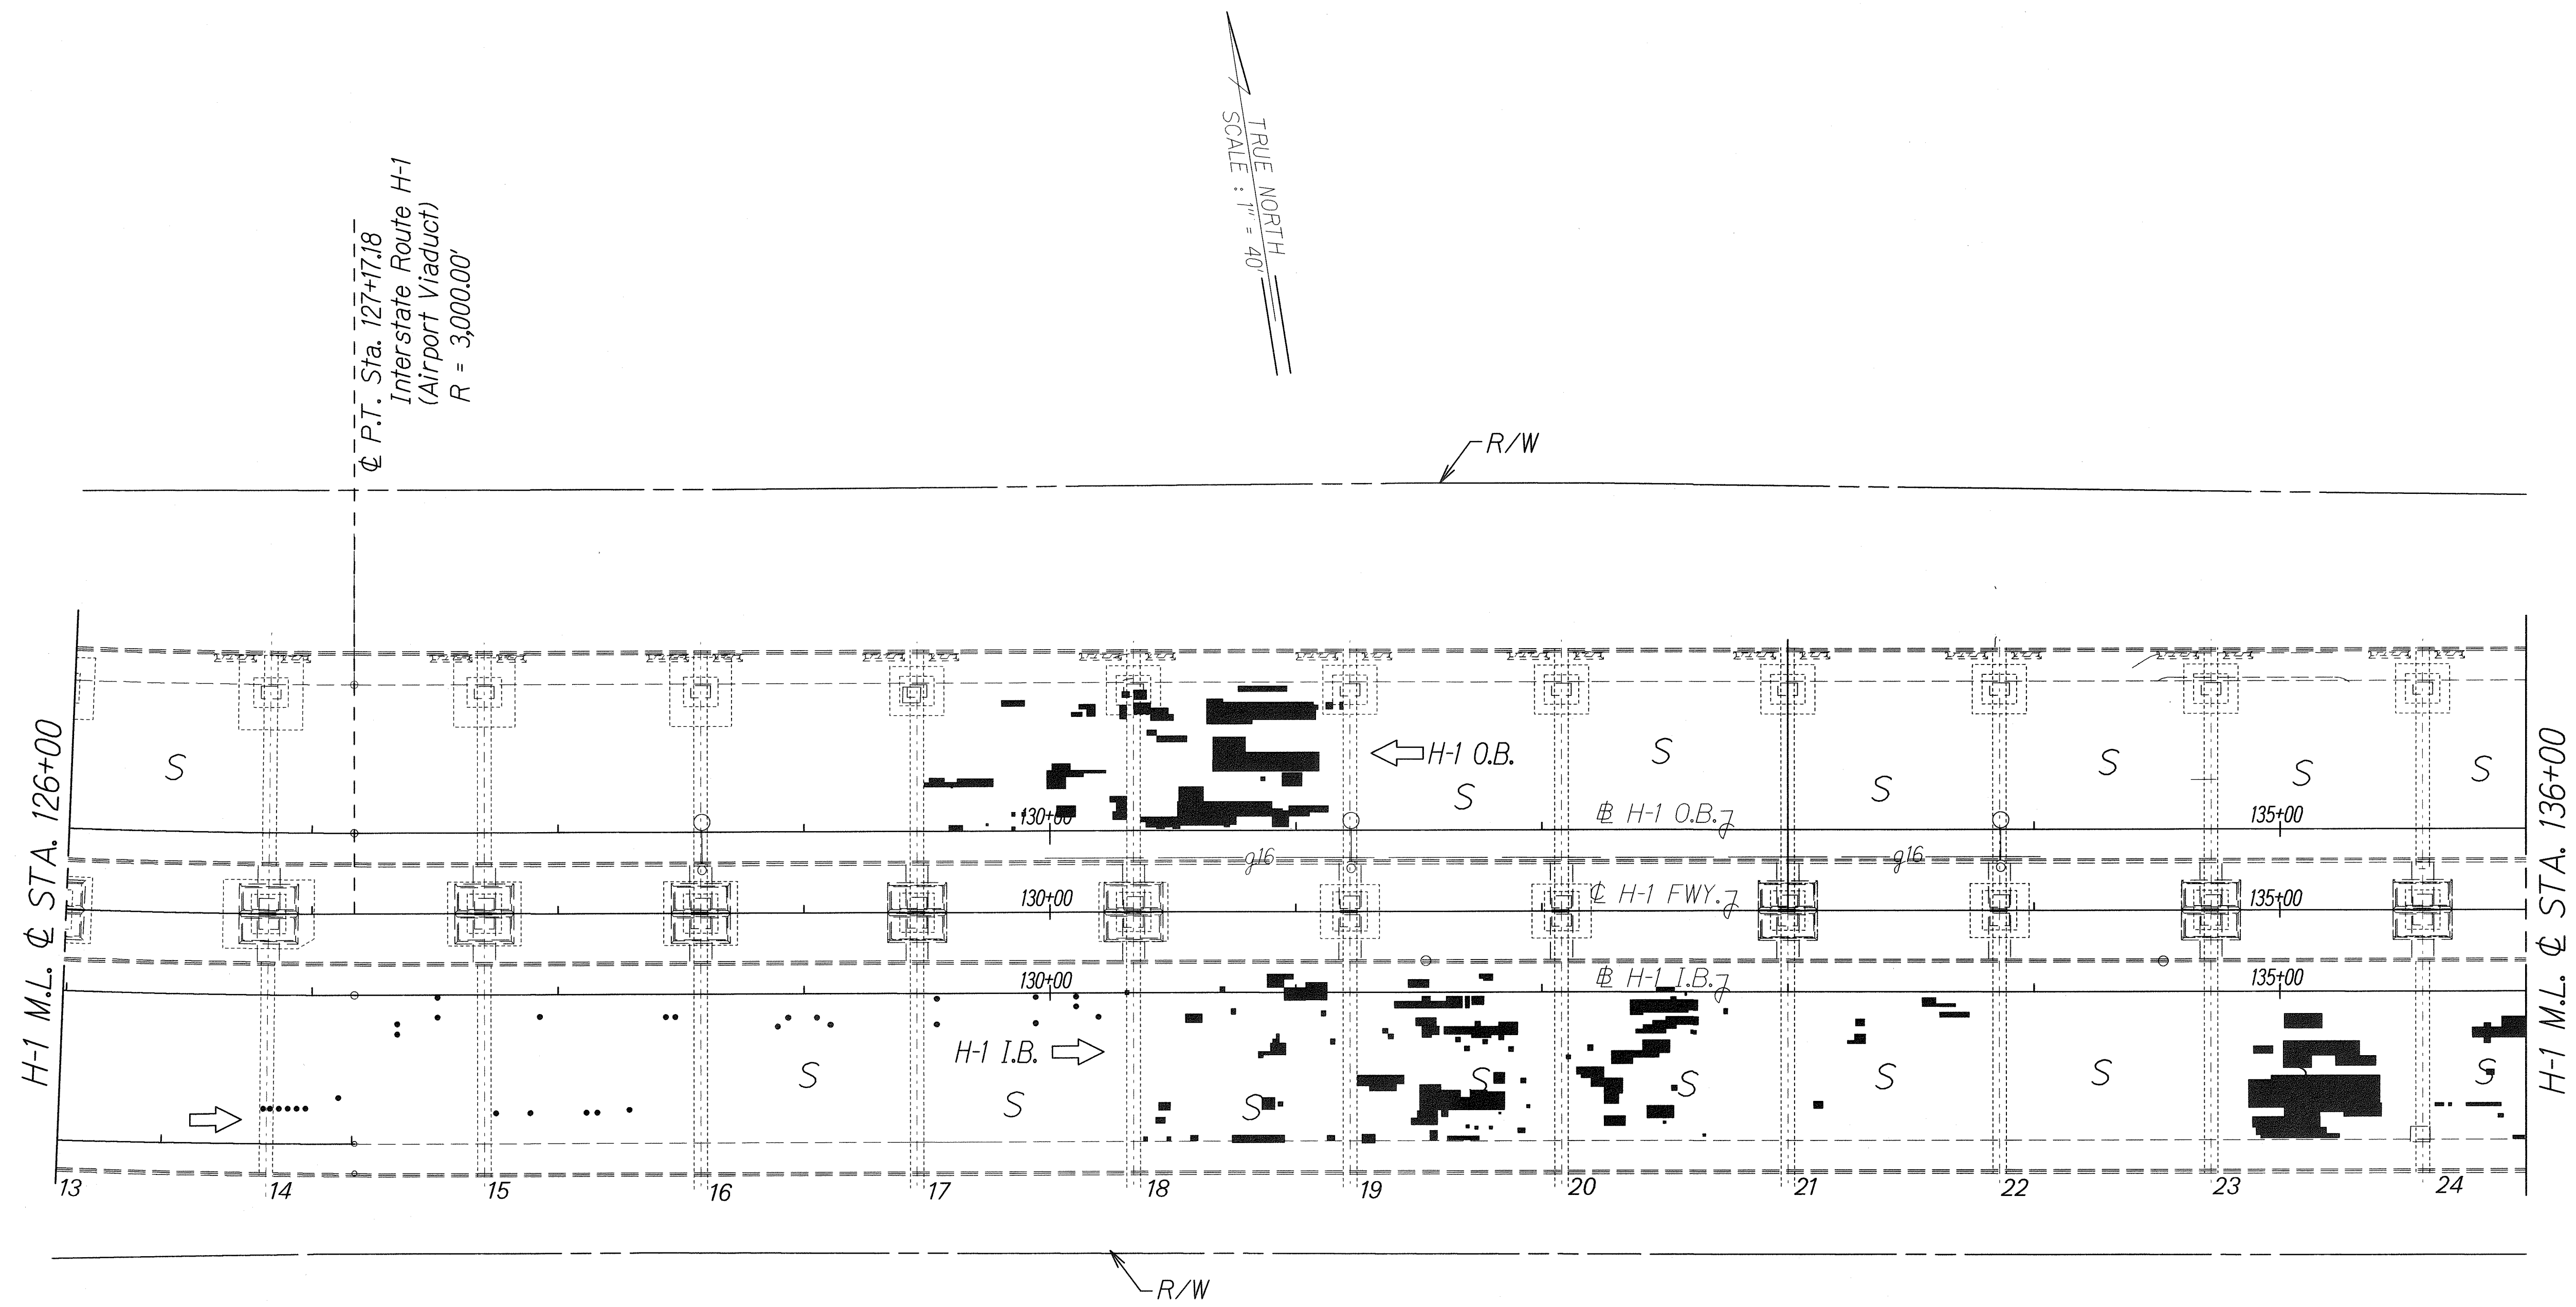

TRUE NORTH
SCALE: 1" = 40'


ORIGINAL PLAN	SURVEY PLOTTED BY	DATE
	DRAWN BY	
NOTE BOOK	DESIGNED BY	
	CHECKED BY	

LEGEND FOR AS-BUILT POSTINGS	
	Squiggly line for as-built deletion
	Double line for as-built deletion
Roadway	Text for as-built posting

STATE OF HAWAII
DEPARTMENT OF TRANSPORTATION
HIGHWAYS DIVISION
ROADWAY PLAN
INTERSTATE ROUTE H-1
AIRPORT VIADUCT DECK REPAIR
VICINITY OF VALKENBURGH ST. TO MIDDLE ST.
Federal Aid Project No. IM-H1-1(254)
Scale: 1" = 40' Date: OCTOBER, 2005
SHEET No. 3 OF 22 SHEETS

"AS-BUILT"

FED. ROAD DIST. NO.	STATE	FED. AID PROJ. NO.	FISCAL YEAR	SHEET NO.	TOTAL SHEETS
HAWAII	HAW.	IM-H1-1(254)	2006	11	31

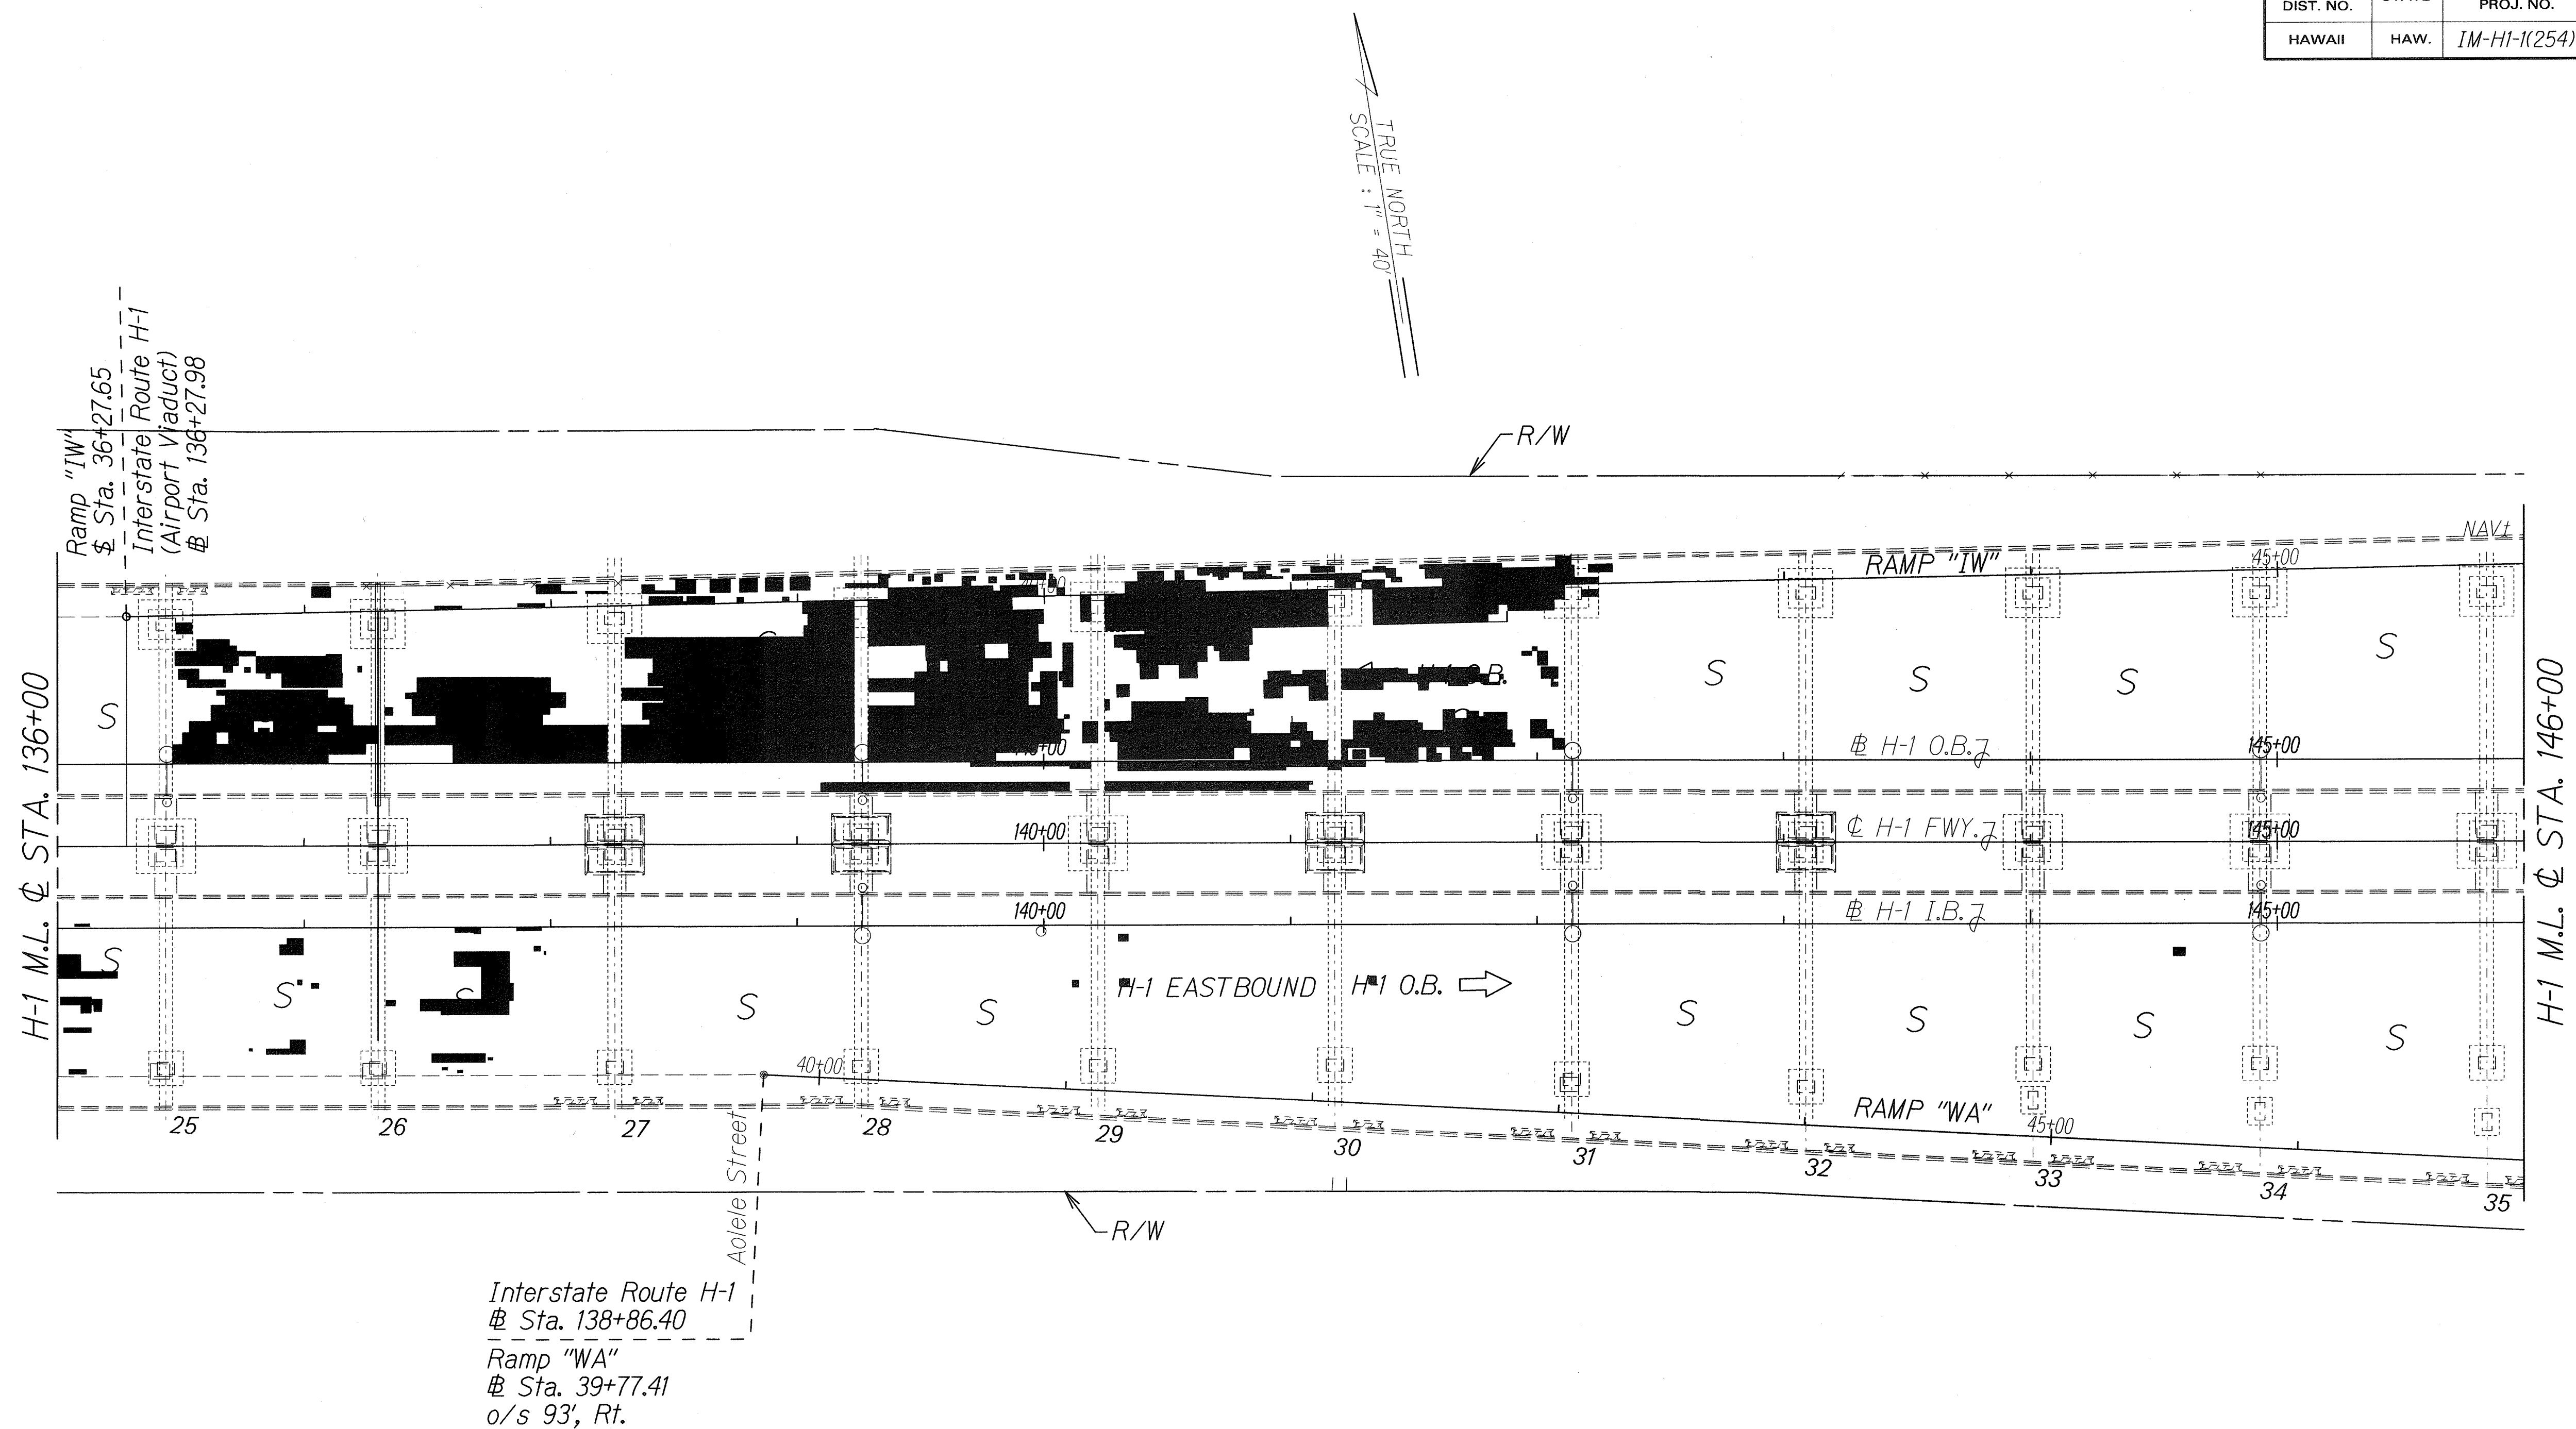


ORIGINAL PLAN	SURVEY PLOTTED BY	DATE
DRAWN BY		
DESIGNED BY		
CHECKED BY		
3/11/00		

LEGEND FOR AS-BUILT POSTINGS	
	Squiggly line for as-built deletion
	Double line for as-built deletion
Roadway	Text for as-built posting

STATE OF HAWAII DEPARTMENT OF TRANSPORTATION HIGHWAYS DIVISION
ROADWAY PLAN
INTERSTATE ROUTE H-1 AIRPORT VIADUCT DECK REPAIR
VICINITY OF VALKENBURGH ST. TO MIDDLE ST.
Federal Aid Project No. IM-H1-1(254)
Scale: 1" = 40' Date: OCTOBER, 2005
SHEET No. 4 OF 22 SHEETS

"AS-BUILT"


FED. ROAD DIST. NO.	STATE	FED. AID PROJ. NO.	FISCAL YEAR	SHEET NO.	TOTAL SHEETS
HAWAII	HAW.	IM-HI-1(254)	2006	12	31

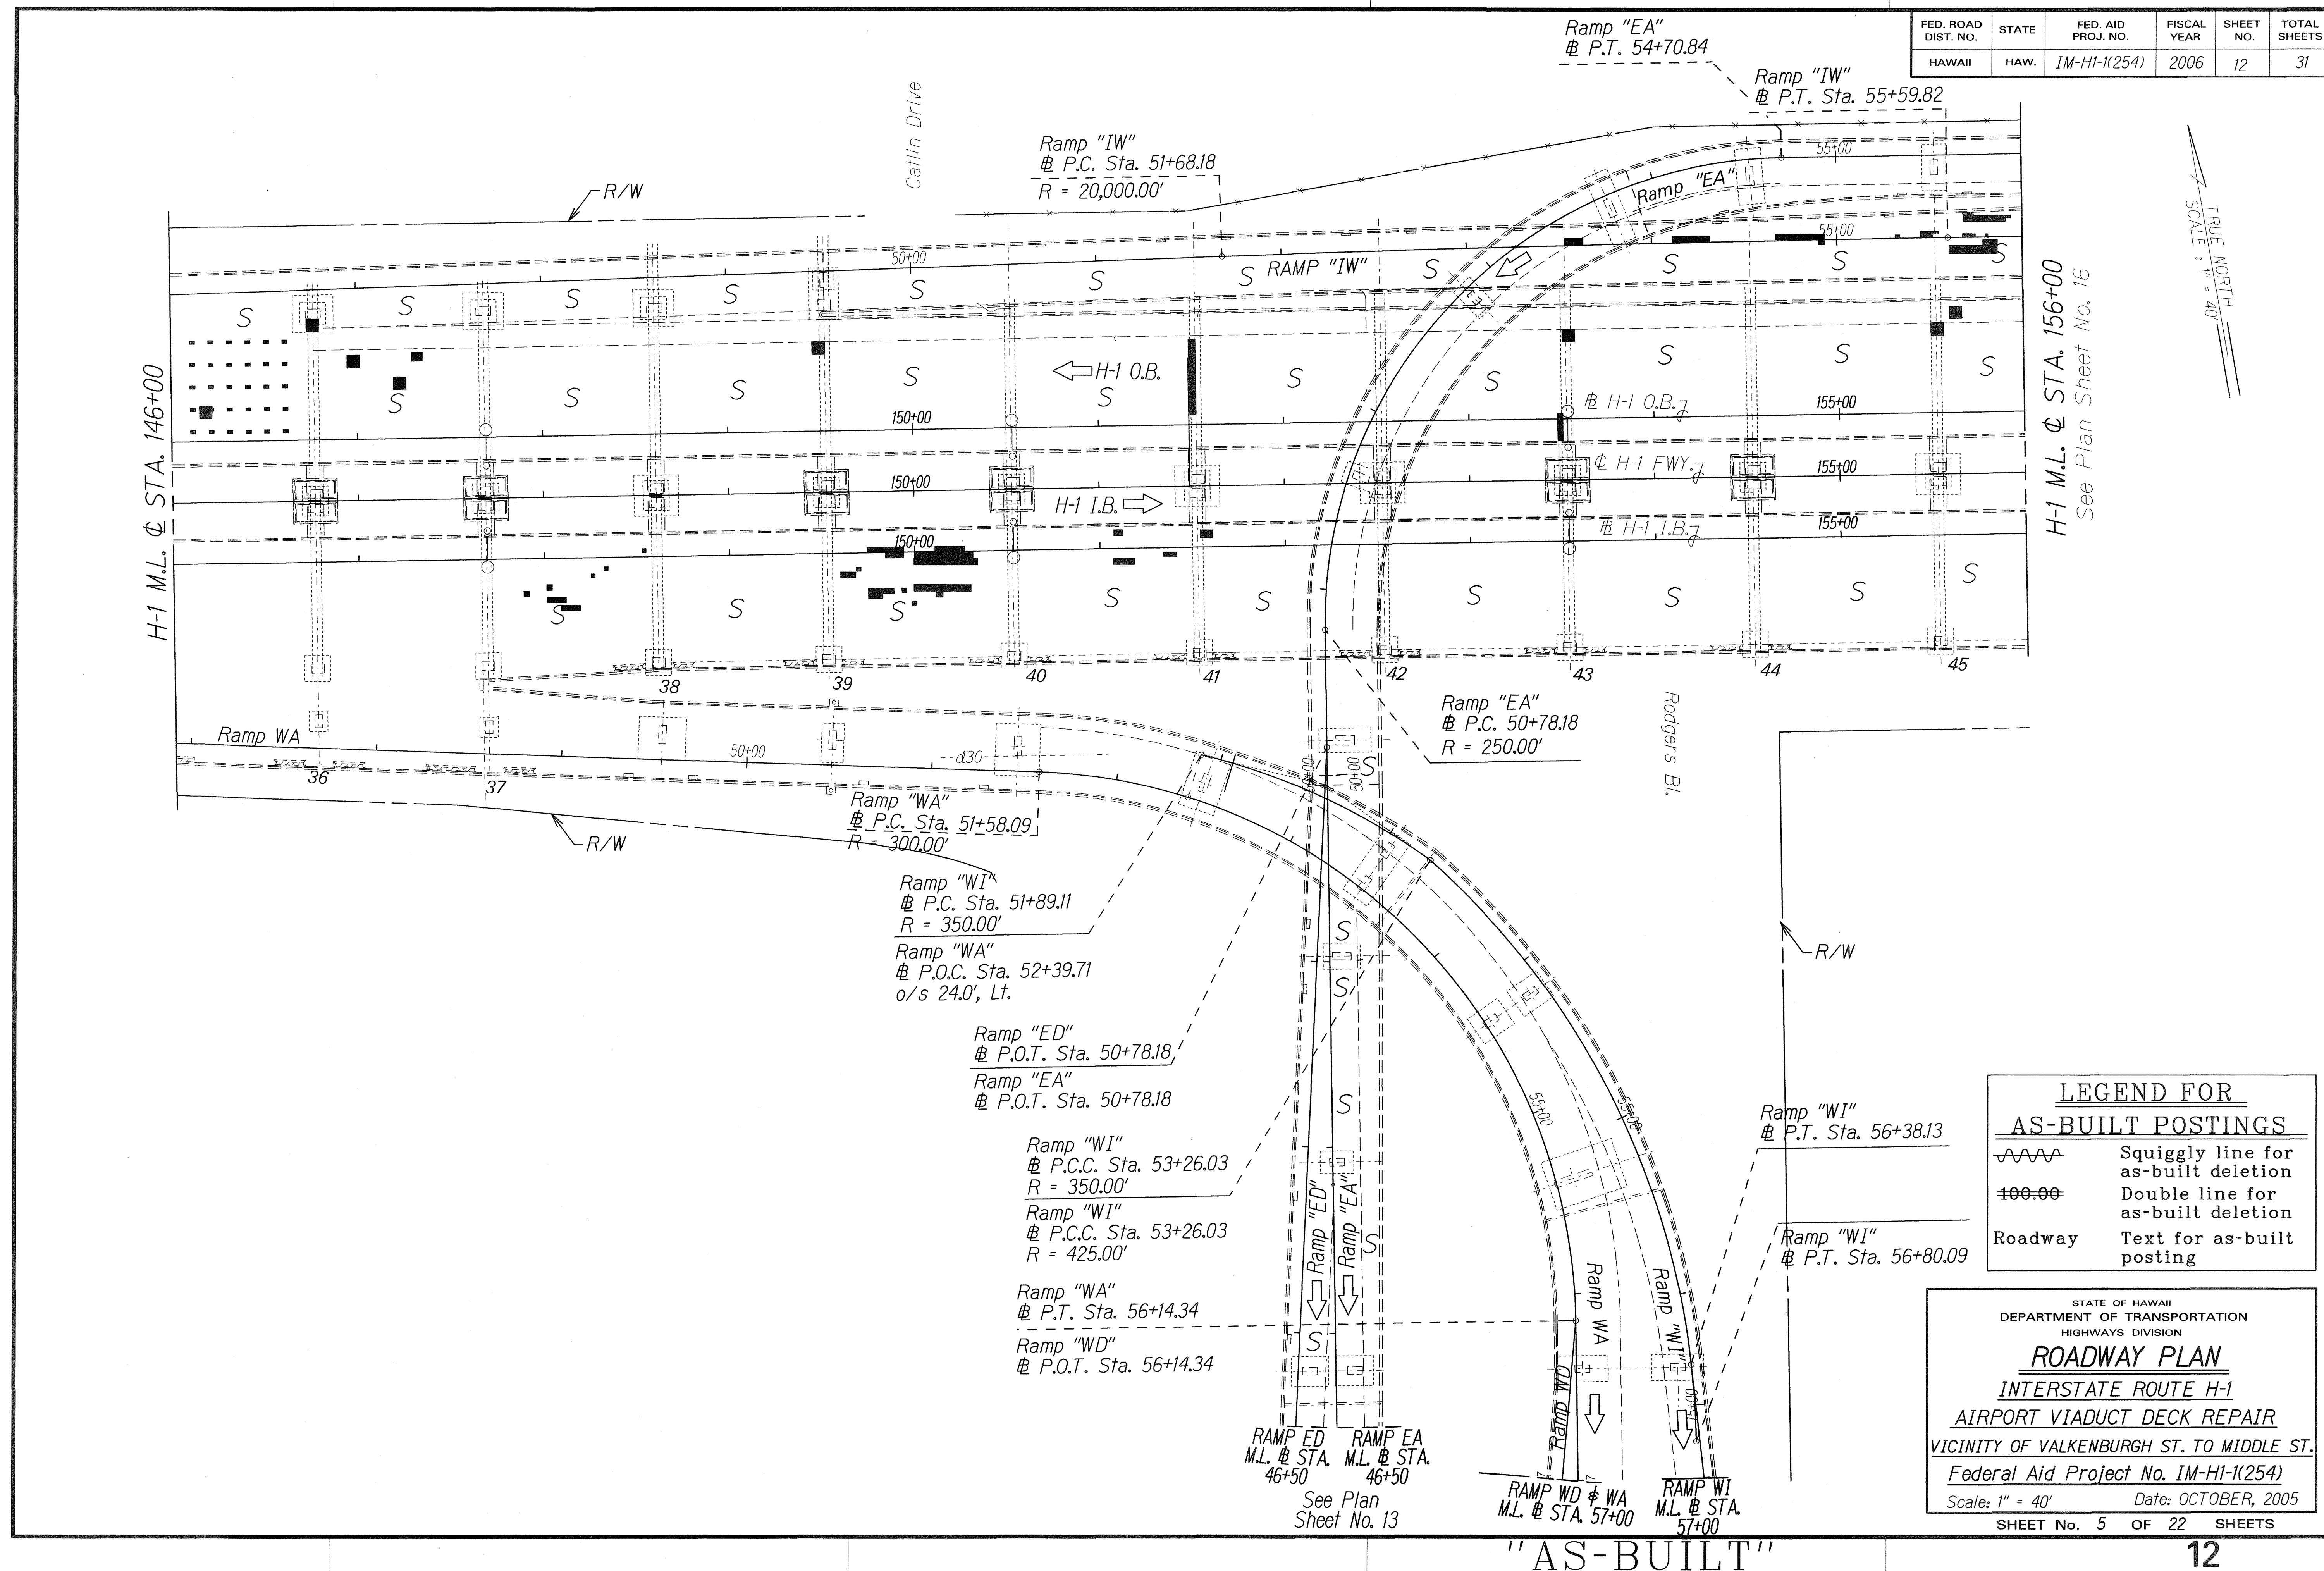

ORIGINAL PLAN	SURVEY PLOTTED BY	DATE
NOTE BOOK	DRAWN BY	
3/10/05	DESIGNED BY	
	QUANTITIES BY	
	CHECKED BY	

FED. ROAD DIST. NO.	STATE	FED. AID PROJ. NO.	FISCAL YEAR	SHEET NO.	TOTAL SHEETS
HAWAII	HAW.	IM-HI-1(254)	2006	13	31

ORIGINAL PLAN	SURVEY PLOTTED BY	DATE
NOTE BOOK	DRAWN BY	
201565W	DESIGNED BY	
20106000	QUANTITIES BY	
	CHECKED BY	

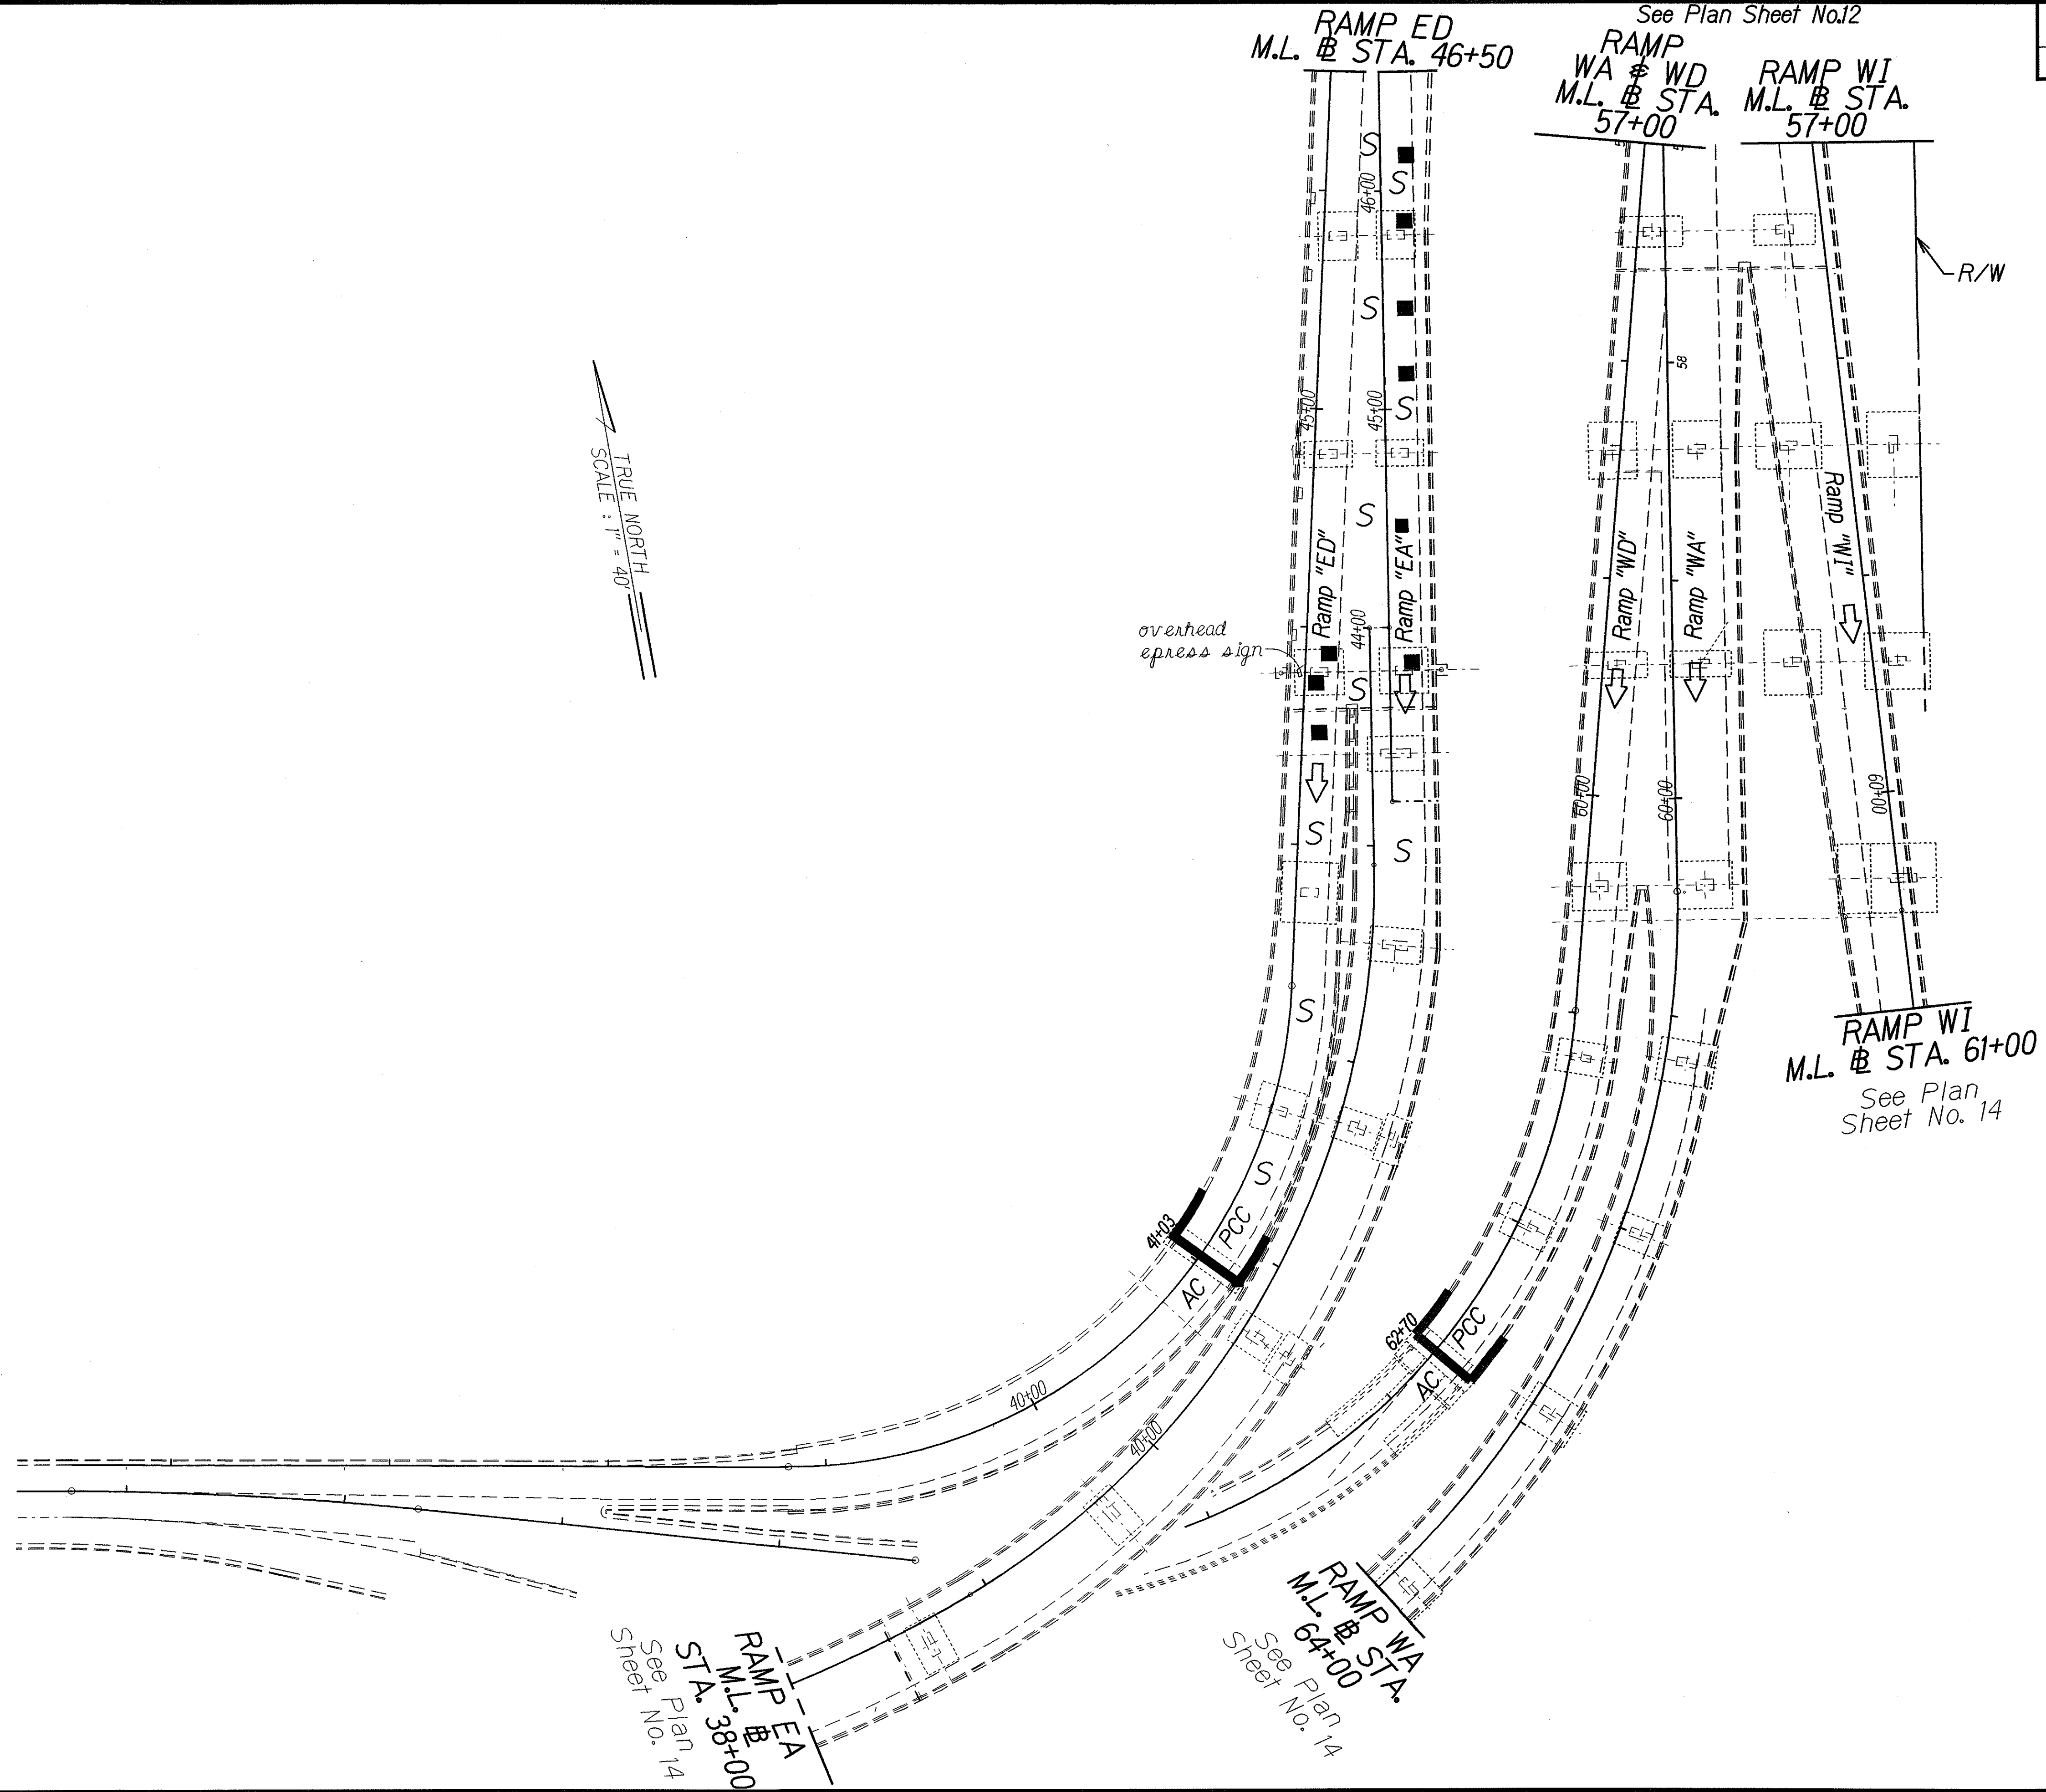

STATE OF HAWAII
DEPARTMENT OF TRANSPORTATION
HIGHWAYS DIVISION

ROADWAY PLAN

INTERSTATE ROUTE H-1

AIRPORT VIADUCT DECK REPAIR


VICINITY OF VALKENBURGH ST. TO MIDDLE ST.

Federal Aid Project No. IM-HI-1(254)

Scale: 1" = 40' Date: OCTOBER, 2005

SHEET No. 6 OF 22 SHEETS

FED. ROAD DIST. NO.	STATE	FED. AID PROJ. NO.	FISCAL YEAR	SHEET NO.	TOTAL SHEETS
HAWAII	HAW.	IM-HI-1(254)	2006	14	31

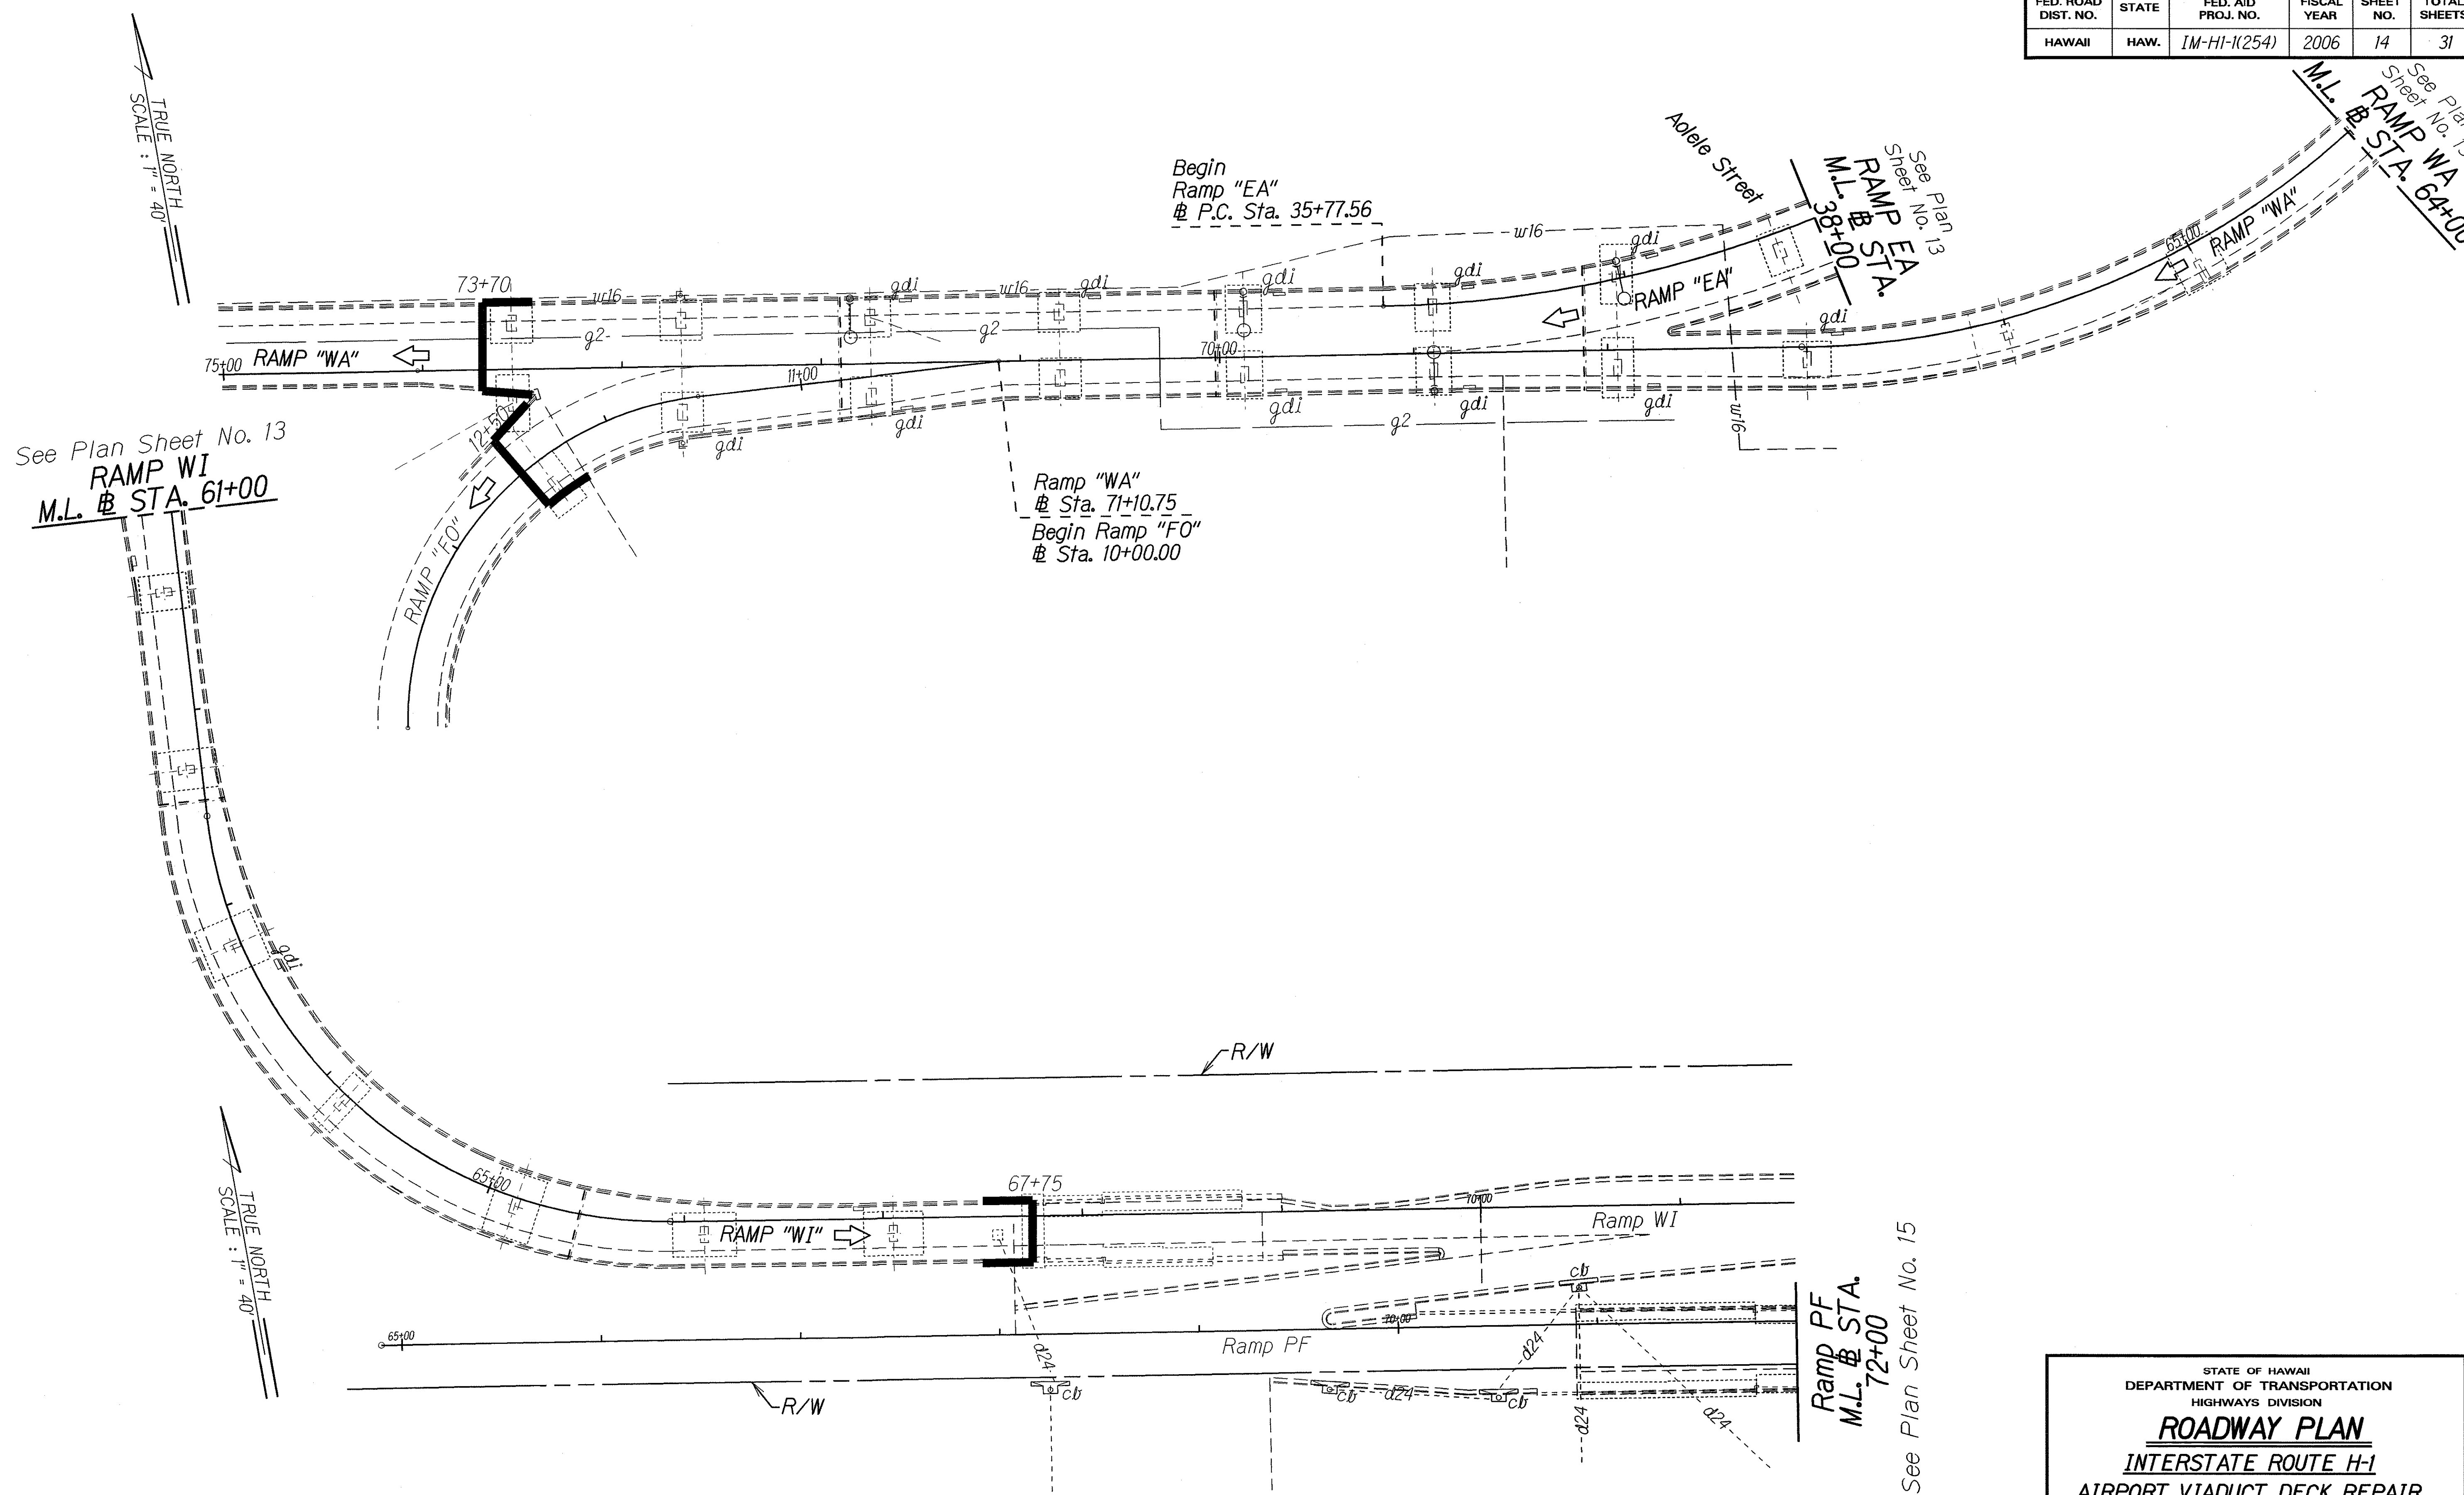

ORIGINAL PLAN	SURVEY PLOTTED BY	DATE
NOTE BOOK	DRAWN BY	
DESIGNED BY	CHECKED BY	
QUANTITIES BY		
8/1/05		

STATE OF HAWAII
DEPARTMENT OF TRANSPORTATION
HIGHWAYS DIVISION

ROADWAY PLAN

INTERSTATE ROUTE H-1

AIRPORT VIADUCT DECK REPAIR


VICINITY OF VALKENBURGH ST. TO MIDDLE ST.

Federal Aid Project No. IM-HI-1(254)

Scale: 1" = 40' Date: OCTOBER, 2005

SHEET No. 7 OF 22 SHEETS

FED. ROAD DIST. NO.	STATE	FED. AID PROJ. NO.	FISCAL YEAR	SHEET NO.	TOTAL SHEETS
HAWAII	HAW.	IM-HI-1(254)	2006	15	31

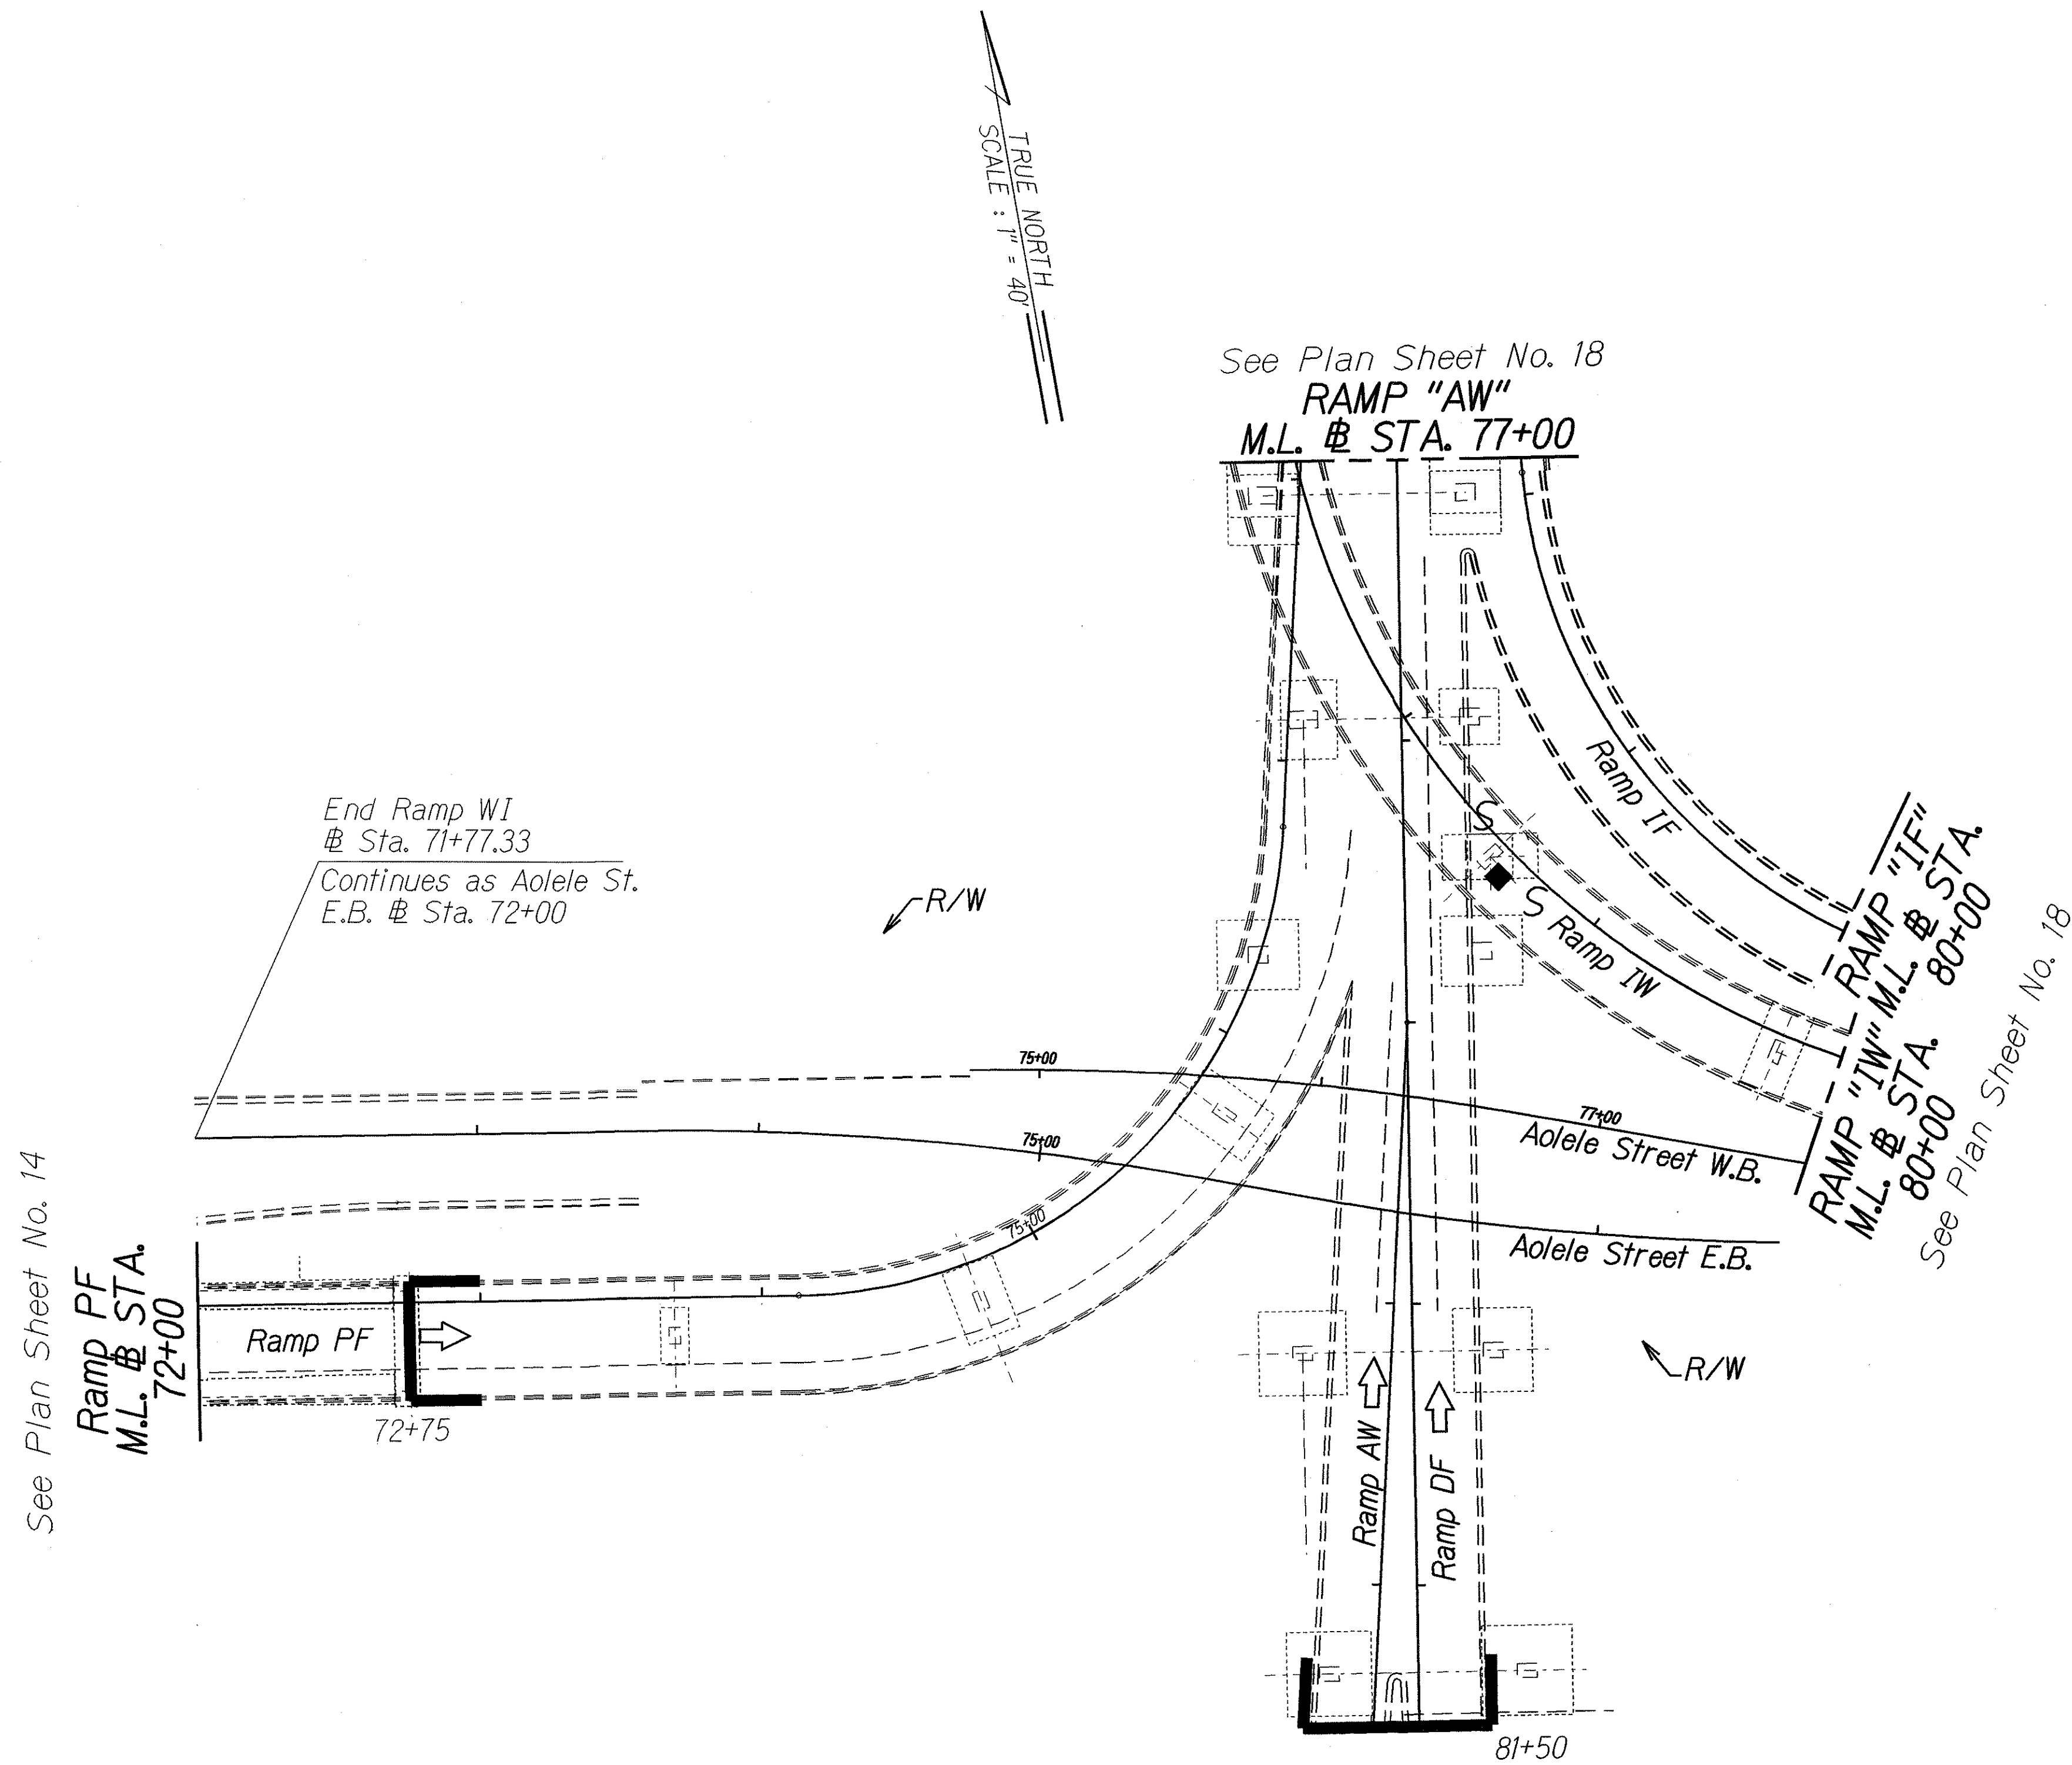

ORIGINAL PLAN	SURVEY PLOTTED BY	DATE
NOTE BOOK	DRAWN BY	
3/10/2006	CHECKED BY	
3/10/2006	DESIGNED BY	
3/10/2006	QUANTITIES BY	
3/10/2006	CHECKED BY	

STATE OF HAWAII
DEPARTMENT OF TRANSPORTATION
HIGHWAYS DIVISION

ROADWAY PLAN

INTERSTATE ROUTE H-1

AIRPORT VIADUCT DECK REPAIR


VICINITY OF VALKENBURGH ST. TO MIDDLE ST.

Federal Aid Project No. IM-HI-1(254)

Scale: 1" = 40' Date: OCTOBER, 2005

SHEET No. 8 OF 23 SHEETS

FED. ROAD DIST. NO.	STATE	FED. AID PROJ. NO.	FISCAL YEAR	SHEET NO.	TOTAL SHEETS
HAWAII	HAW.	IM-HI-1(254)	2006	16	31

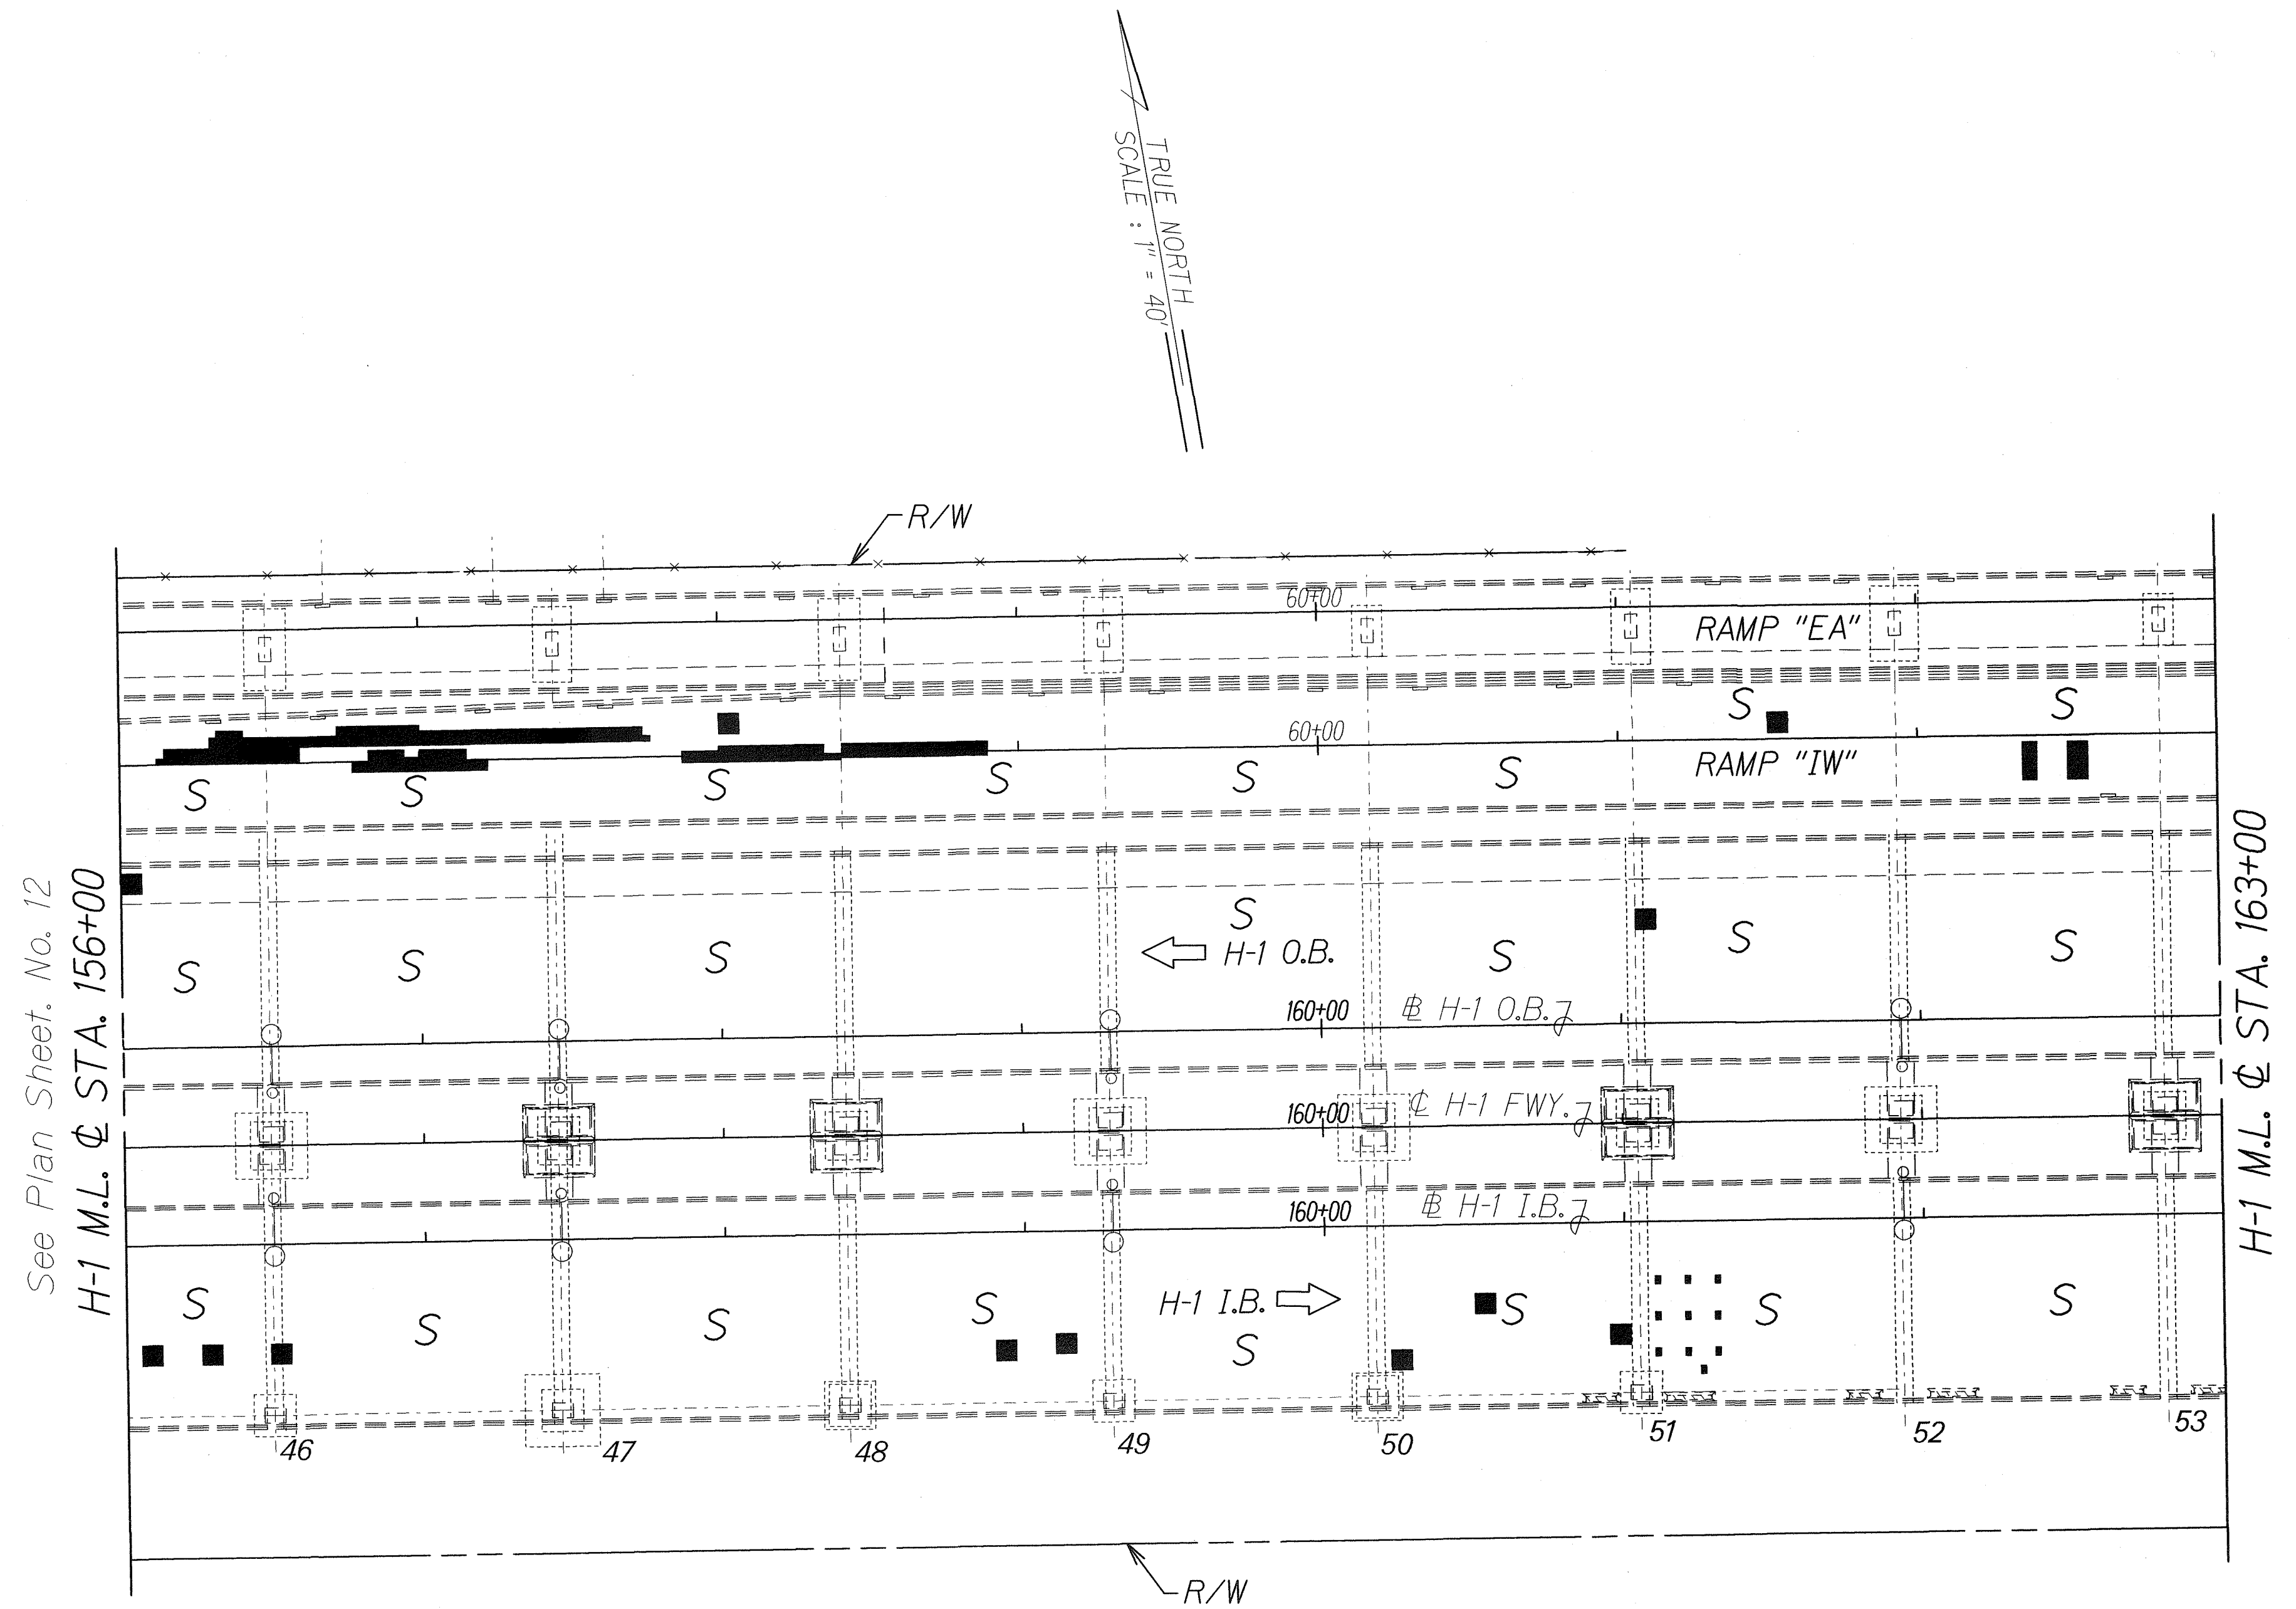

ORIGINAL PLAN	SURVEY PLOTTED BY	DATE
NOTE BOOK	DESIGNED BY	
QUANTITIES BY	CHECKED BY	
3/11/09		

LEGEND FOR AS-BUILT POSTINGS	
	Squiggly line for as-built deletion
	Double line for as-built deletion
Roadway	Text for as-built posting

STATE OF HAWAII
DEPARTMENT OF TRANSPORTATION
HIGHWAYS DIVISION

ROADWAY PLAN

INTERSTATE ROUTE H-1

AIRPORT VIADUCT DECK REPAIR


VICINITY OF VALKENBURGH ST. TO MIDDLE ST.

Federal Aid Project No. IM-HI-1(254)

Scale: 1" = 40' Date: OCTOBER, 2005

SHEET No. 9 OF 22 SHEETS

FED. ROAD DIST. NO.	STATE	FED. AID PROJ. NO.	FISCAL YEAR	SHEET NO.	TOTAL SHEETS
HAWAII	HAW.	IM-HI-1(254)	2006	17	31

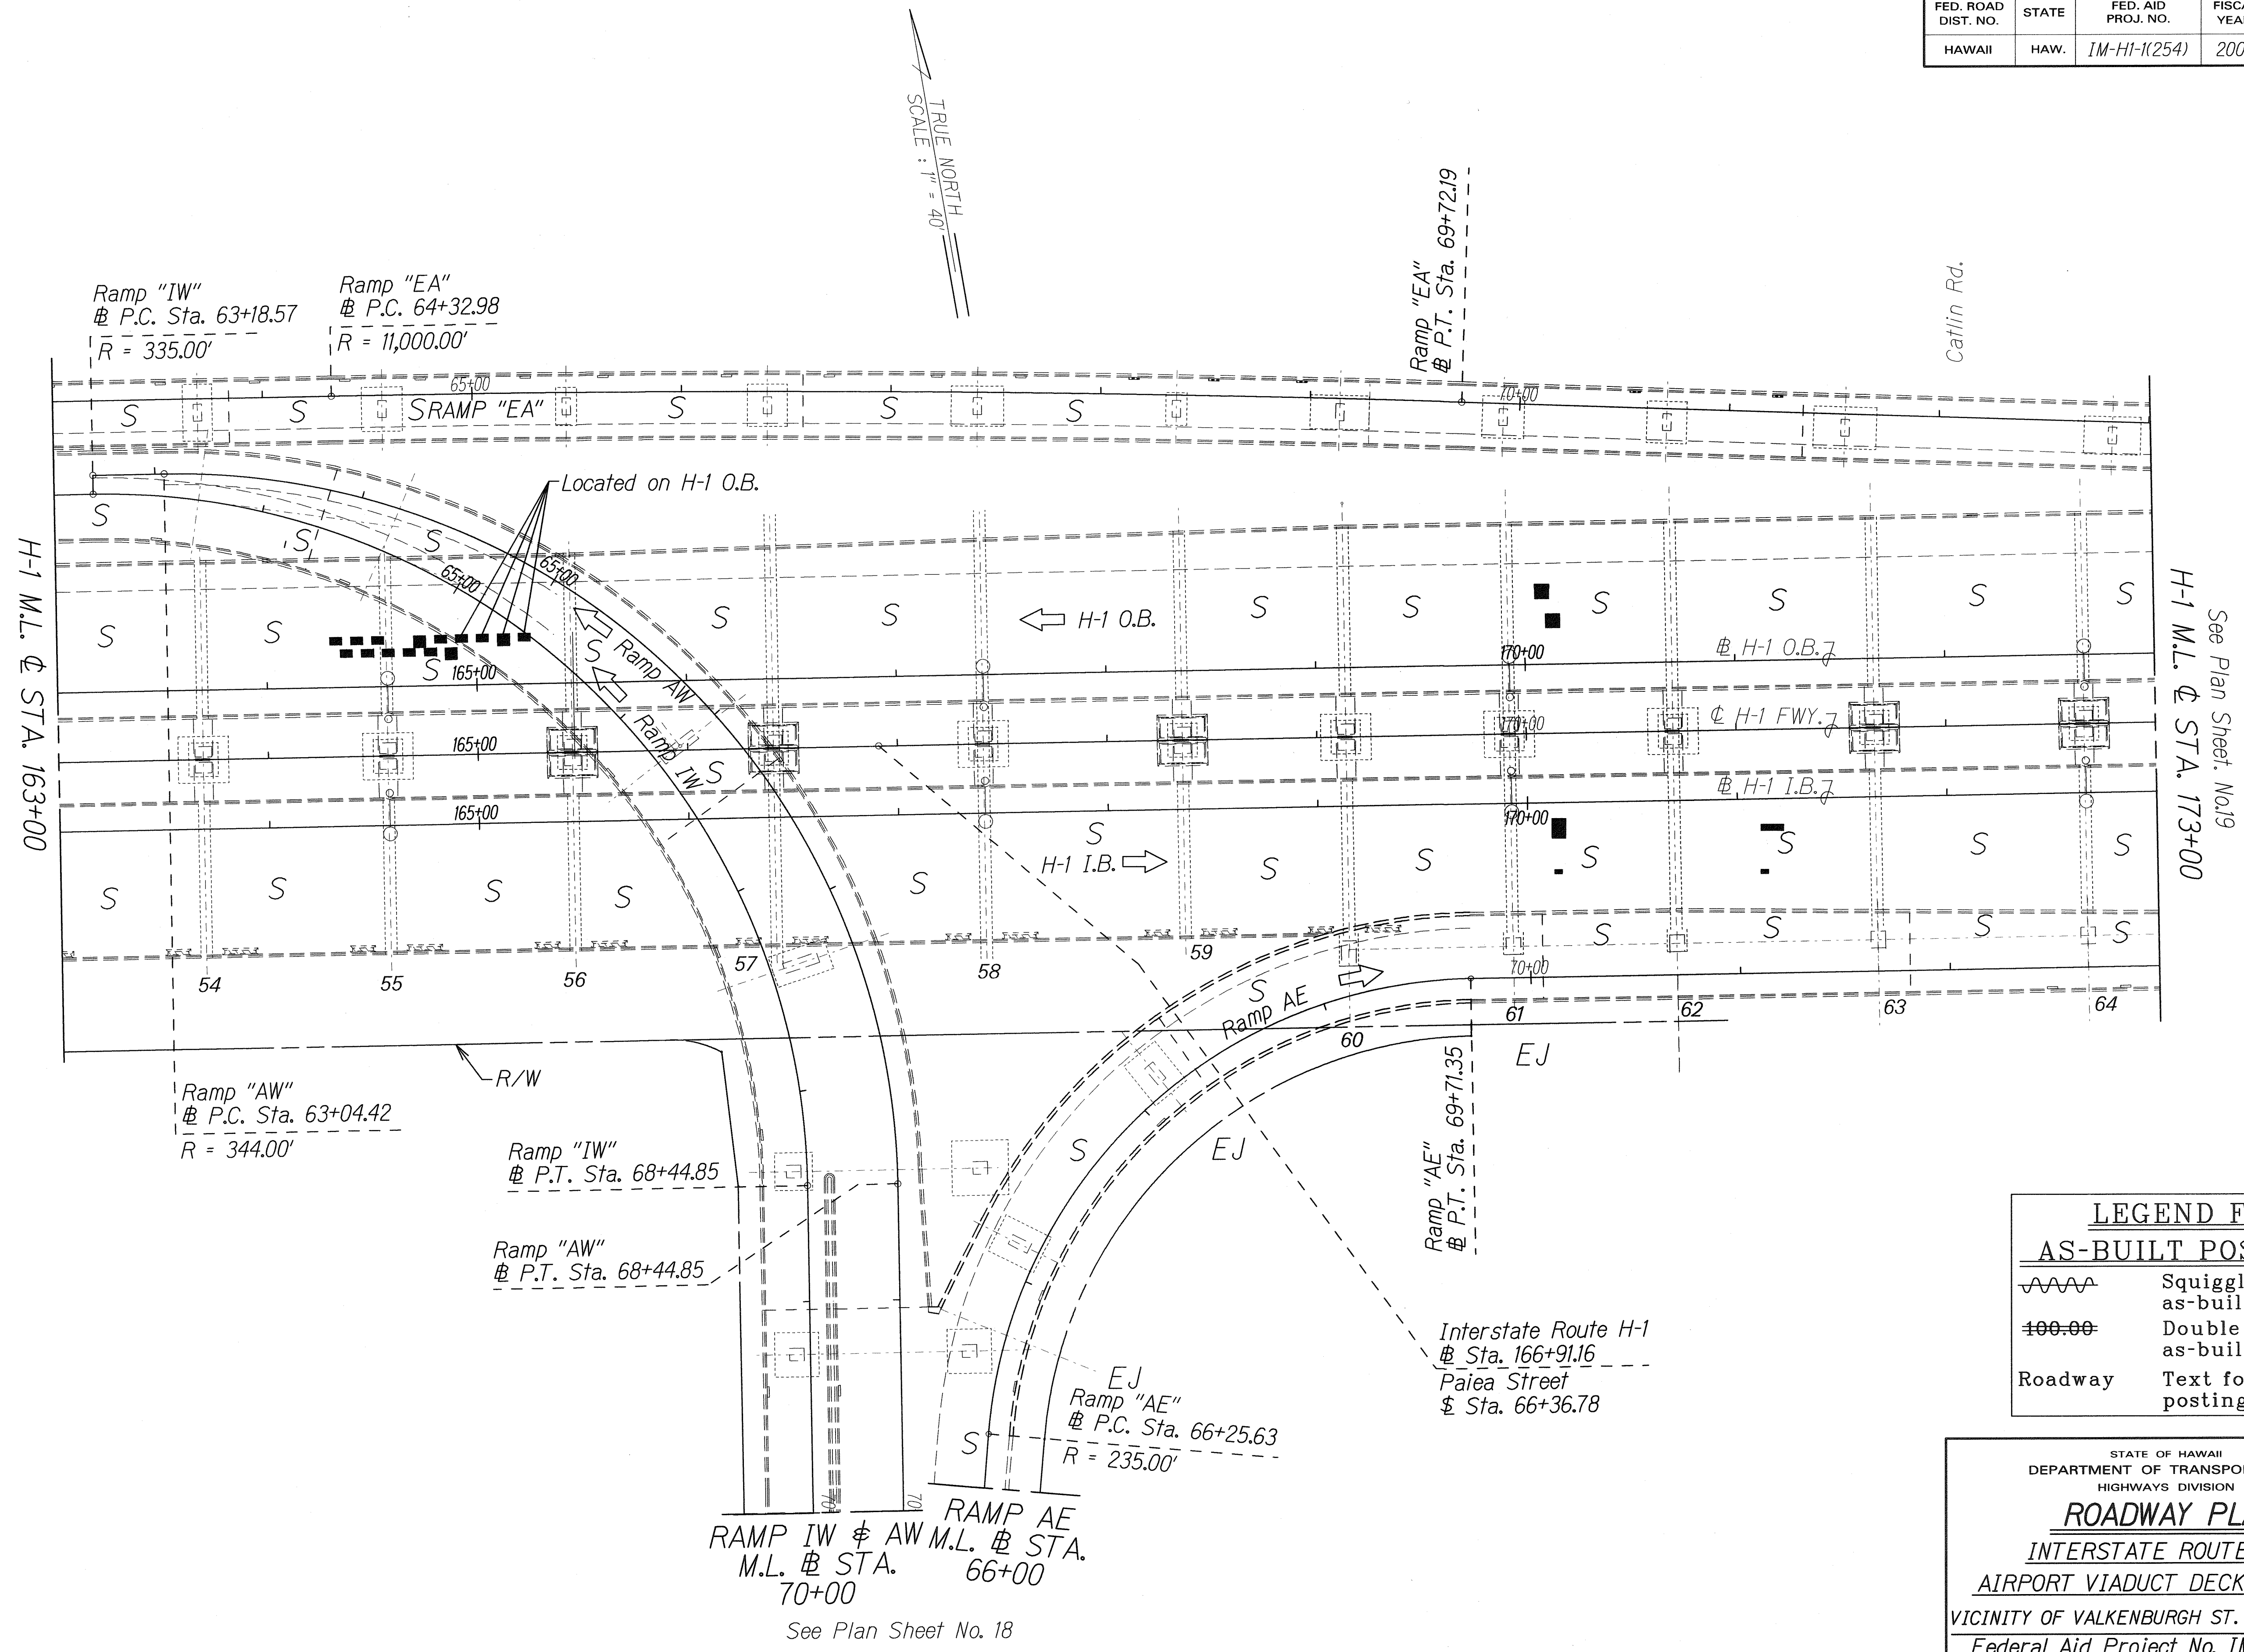

LEGEND FOR AS-BUILT POSTINGS

	Squiggly line for as-built deletion
	Double line for as-built deletion
Roadway	Text for as-built posting

STATE OF HAWAII
DEPARTMENT OF TRANSPORTATION
HIGHWAYS DIVISION

ROADWAY PLAN

INTERSTATE ROUTE H-1
AIRPORT VIADUCT DECK REPAIR
VICINITY OF VALKENBURGH ST. TO MIDDLE ST.
Federal Aid Project No. IM-HI-1(254)



Scale: 1" = 40' Date: OCTOBER, 2005

SHEET No. 10 OF 22 SHEETS

ORIGINAL PLAN	SURVEY PLOTTED BY	DATE
NOTE BOOK	DRAWN BY	
DESIGNED BY		
CHECKED BY		

"AS-BUILT"

FED. ROAD DIST. NO.	STATE	FED. AID PROJ. NO.	FISCAL YEAR	SHEET NO.	TOTAL SHEETS
HAWAII	HAW.	IM-HI-1(254)	2006	18	31

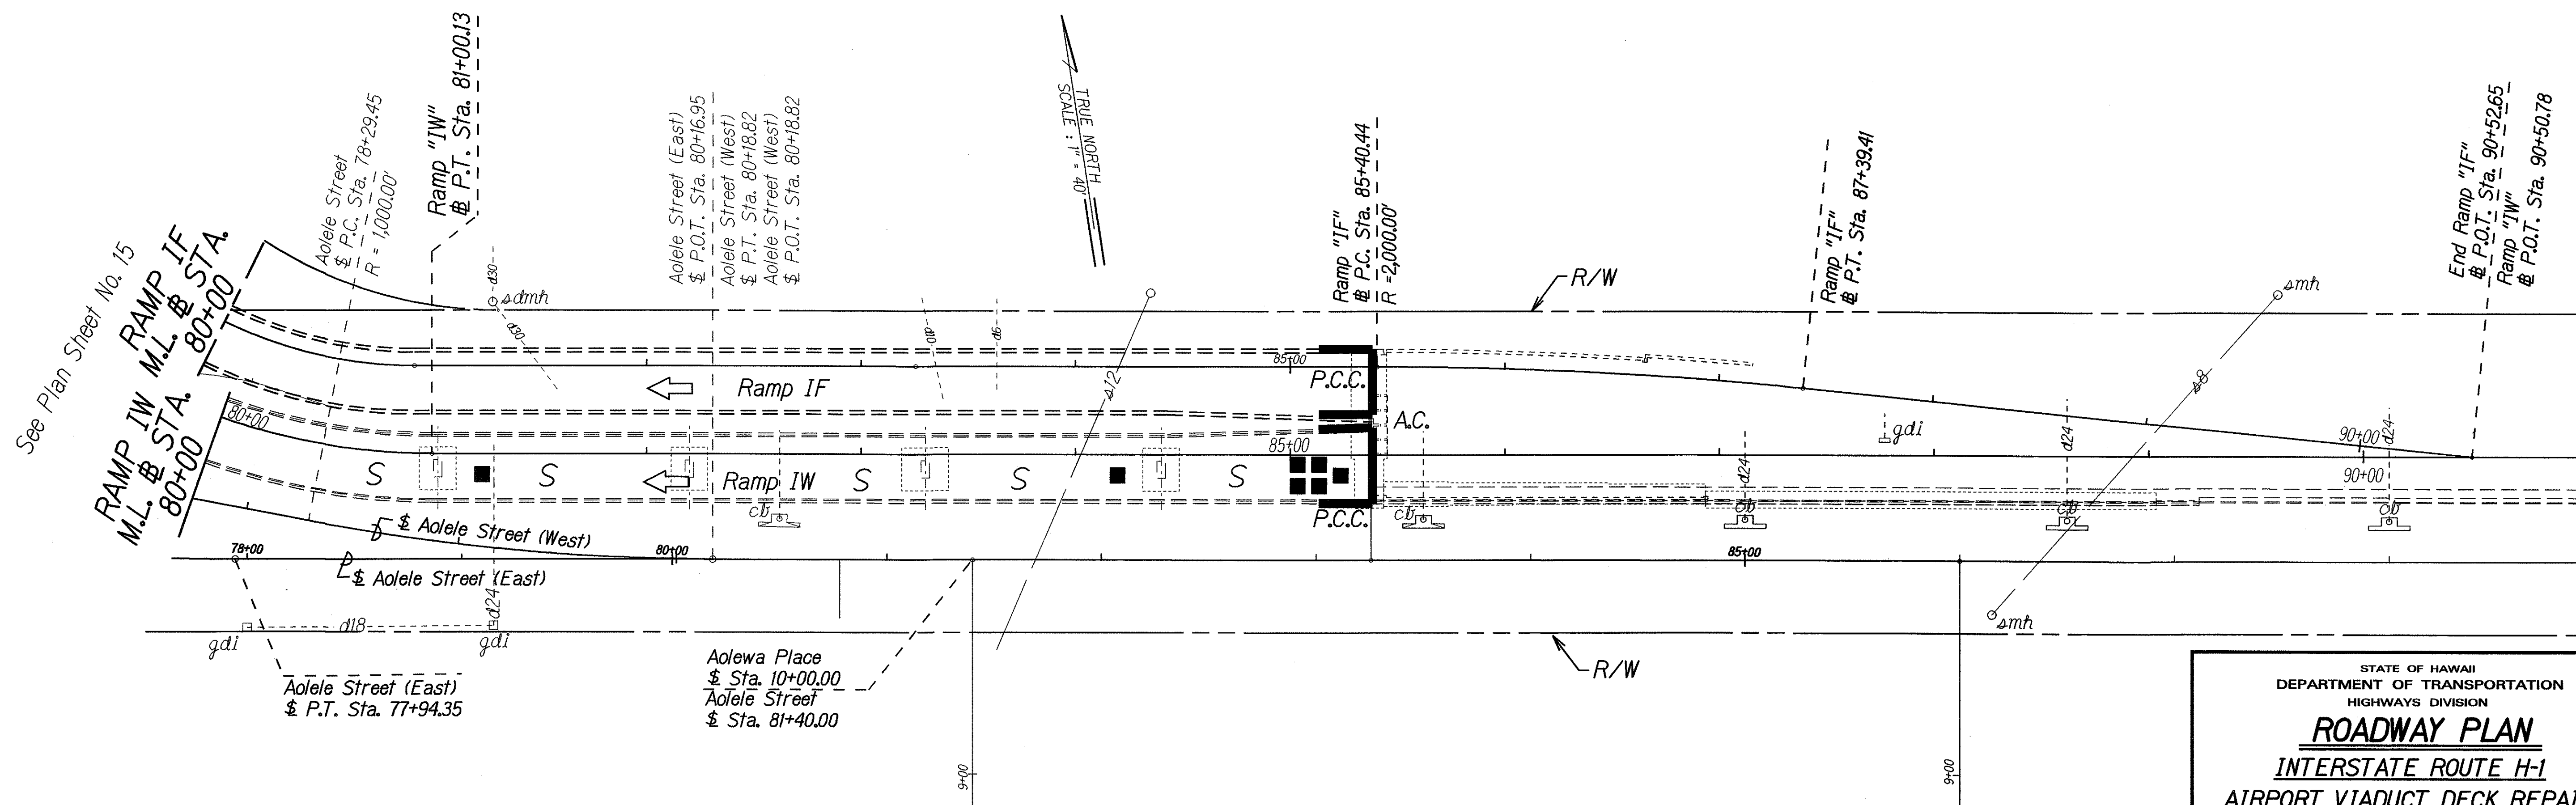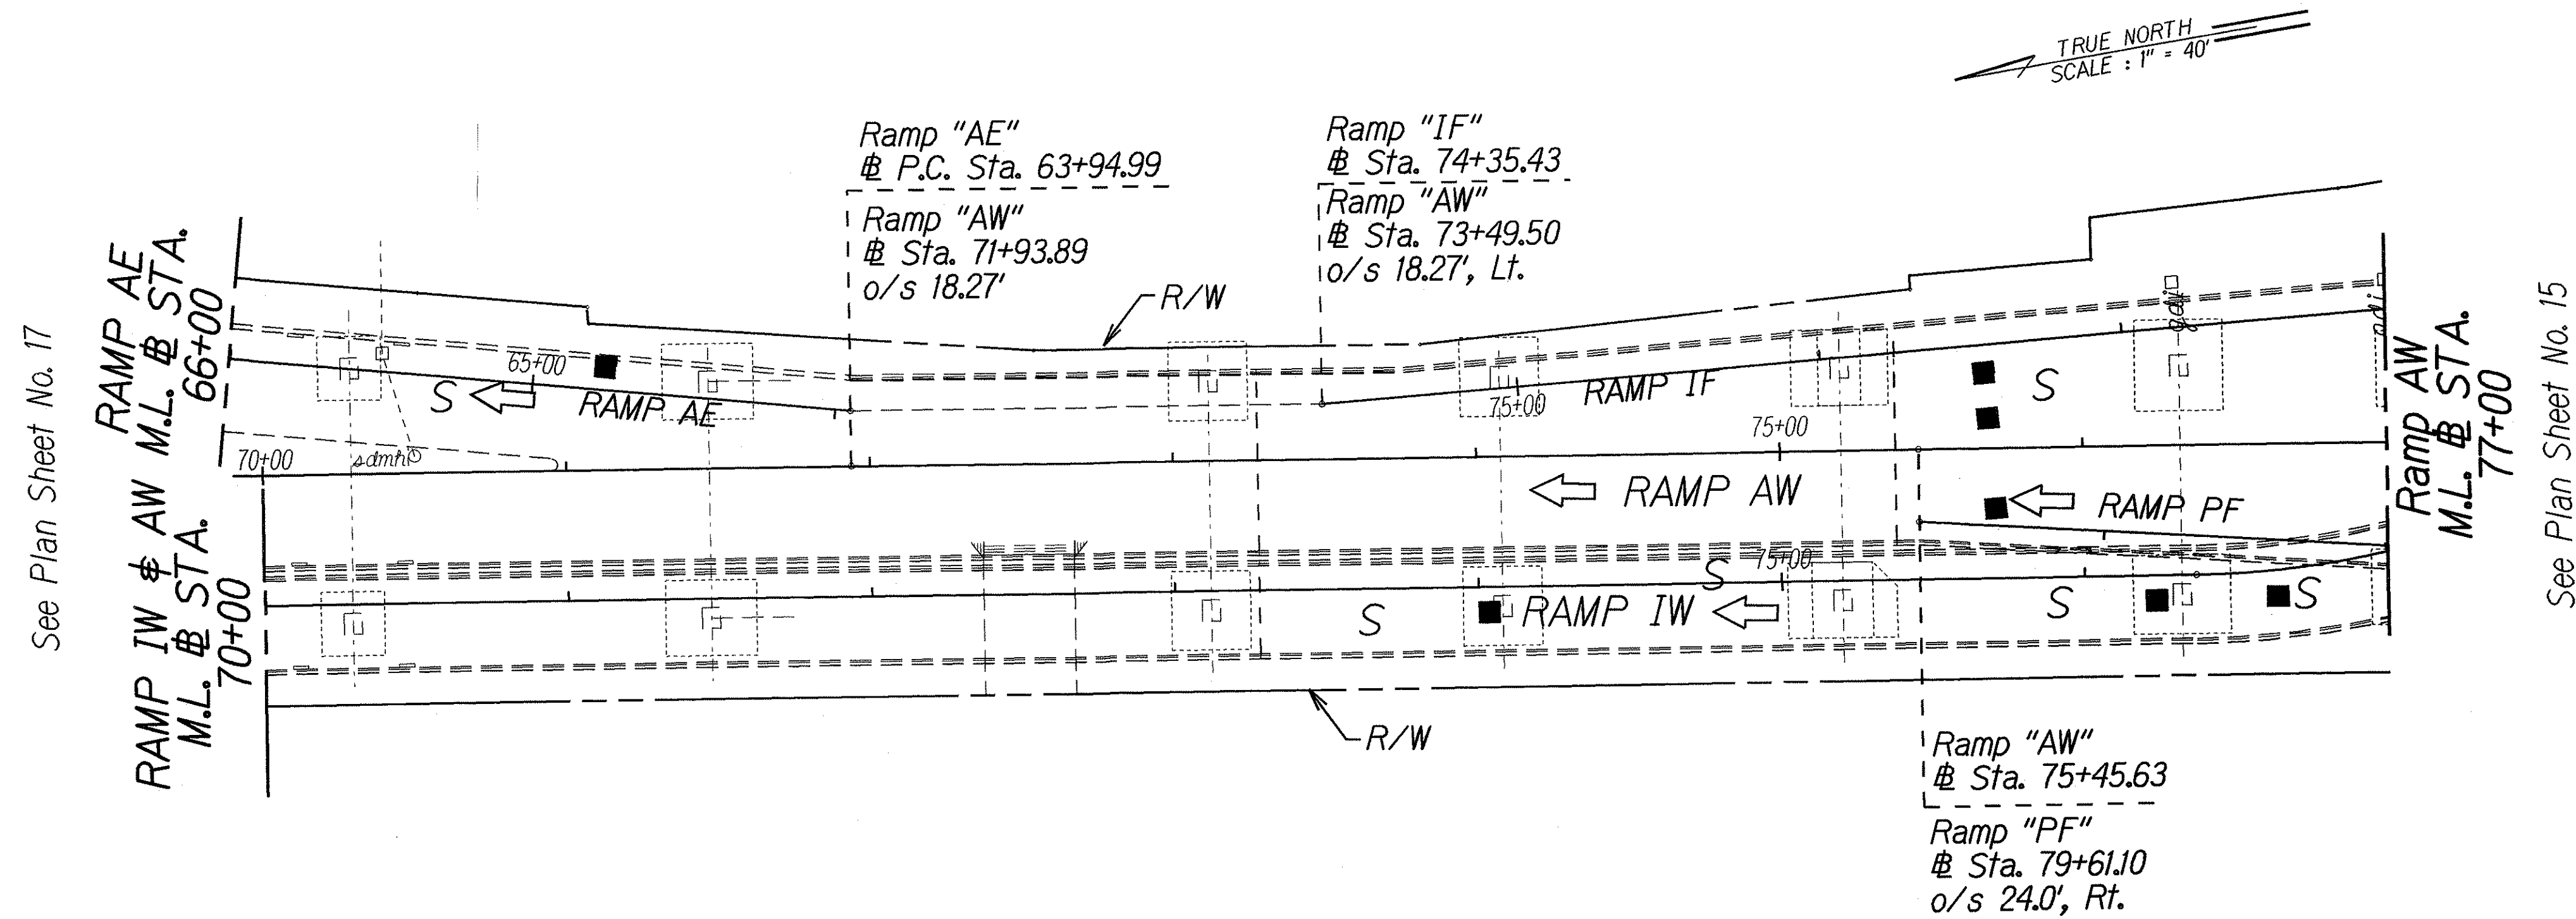

ORIGINAL PLAN	SURVEY PLOTTED BY	DATE
NOTE BOOK	DRAWN BY	
DESIGNED BY	CHECKED BY	
QUANTITIES BY		

STATE OF HAWAII
DEPARTMENT OF TRANSPORTATION
HIGHWAYS DIVISION

ROADWAY PLAN

INTERSTATE ROUTE H-1

AIRPORT VIADUCT DECK REPAIR


VICINITY OF VALKENBURGH ST. TO MIDDLE ST.

Federal Aid Project No. IM-HI-1(254)

Scale: 1" = 40' Date: OCTOBER, 2005

SHEET No. 11 OF 22 SHEETS

FED. ROAD DIST. NO.	STATE	FED. AID PROJ. NO.	FISCAL YEAR	SHEET NO.	TOTAL SHEETS
HAWAII	HAW.	IM-HI-1(254)	2006	19	31

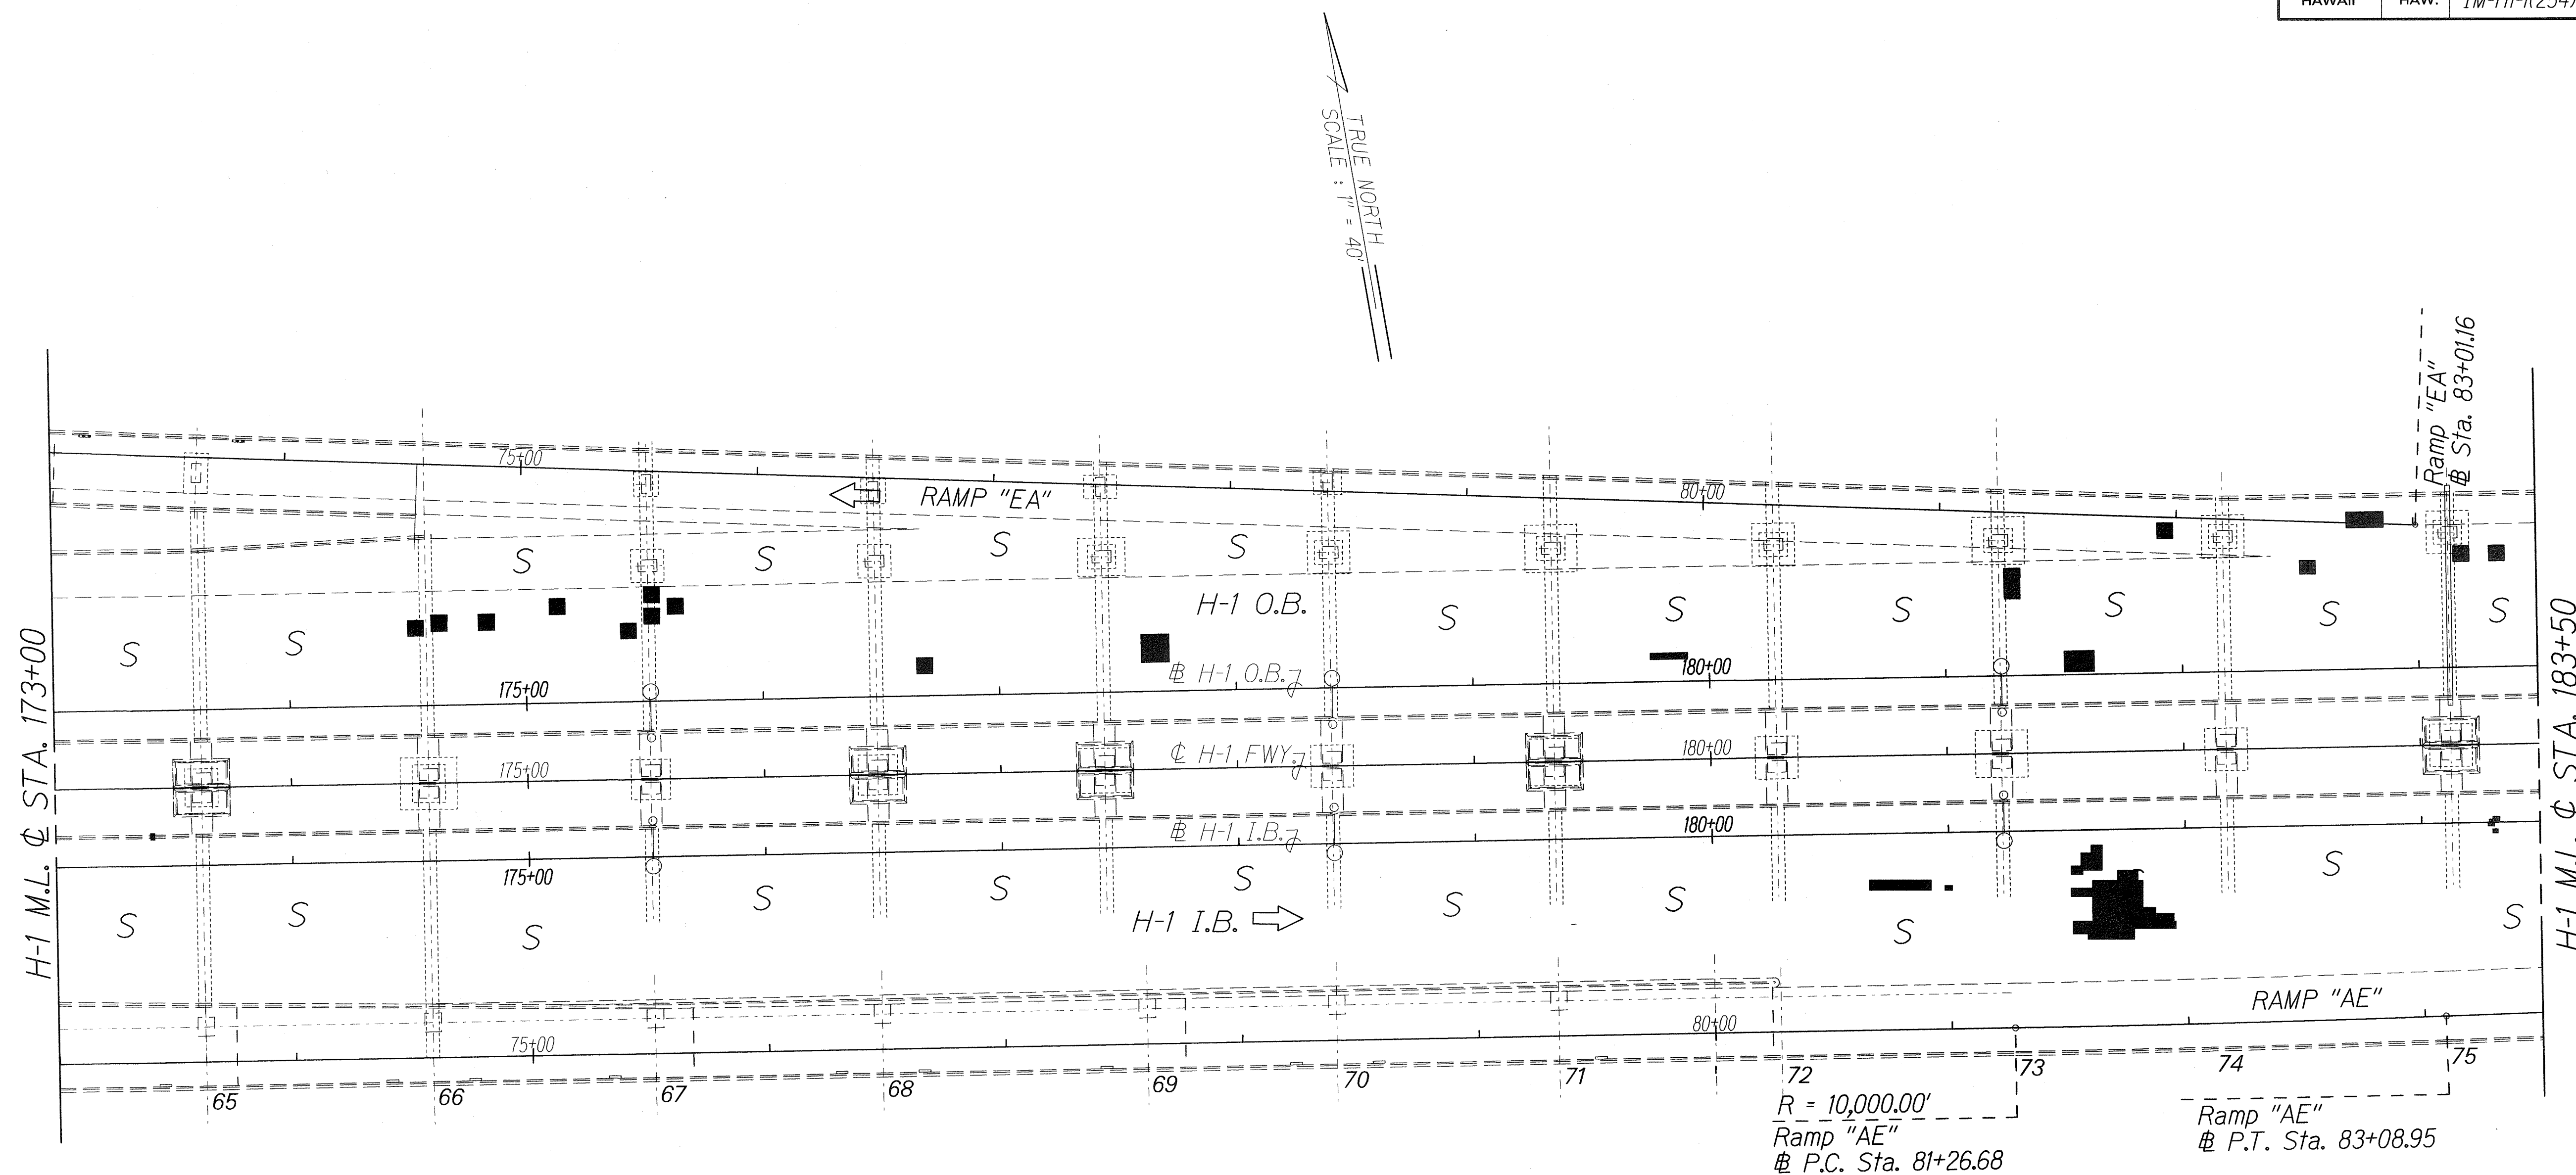


ORIGINAL PLAN	SURVEY PLOTTED BY	DATE
NOTE BOOK	DRAWN BY	
8/13/05	TRACED BY	
8/13/05	DESIGNED BY	
8/13/05	QUANTITIES BY	
8/13/05	CHECKED BY	

LEGEND FOR AS-BUILT POSTINGS	
	Squiggly line for as-built deletion
	Double line for as-built deletion
Roadway	Text for as-built posting

STATE OF HAWAII DEPARTMENT OF TRANSPORTATION HIGHWAYS DIVISION	
ROADWAY PLAN	
INTERSTATE ROUTE H-1	
AIRPORT VIADUCT DECK REPAIR	
VICINITY OF VALKENBURGH ST. TO MIDDLE ST.	
Federal Aid Project No. IM-HI-1(254)	
Scale: 1" = 40'	Date: OCTOBER, 2005
SHEET No. 12 OF 22 SHEETS	

"AS-BUILT"

FED. ROAD DIST. NO.	STATE	FED. AID PROJ. NO.	FISCAL YEAR	SHEET NO.	TOTAL SHEETS
HAWAII	HAW.	IM-HI-1(254)	2006	21	31

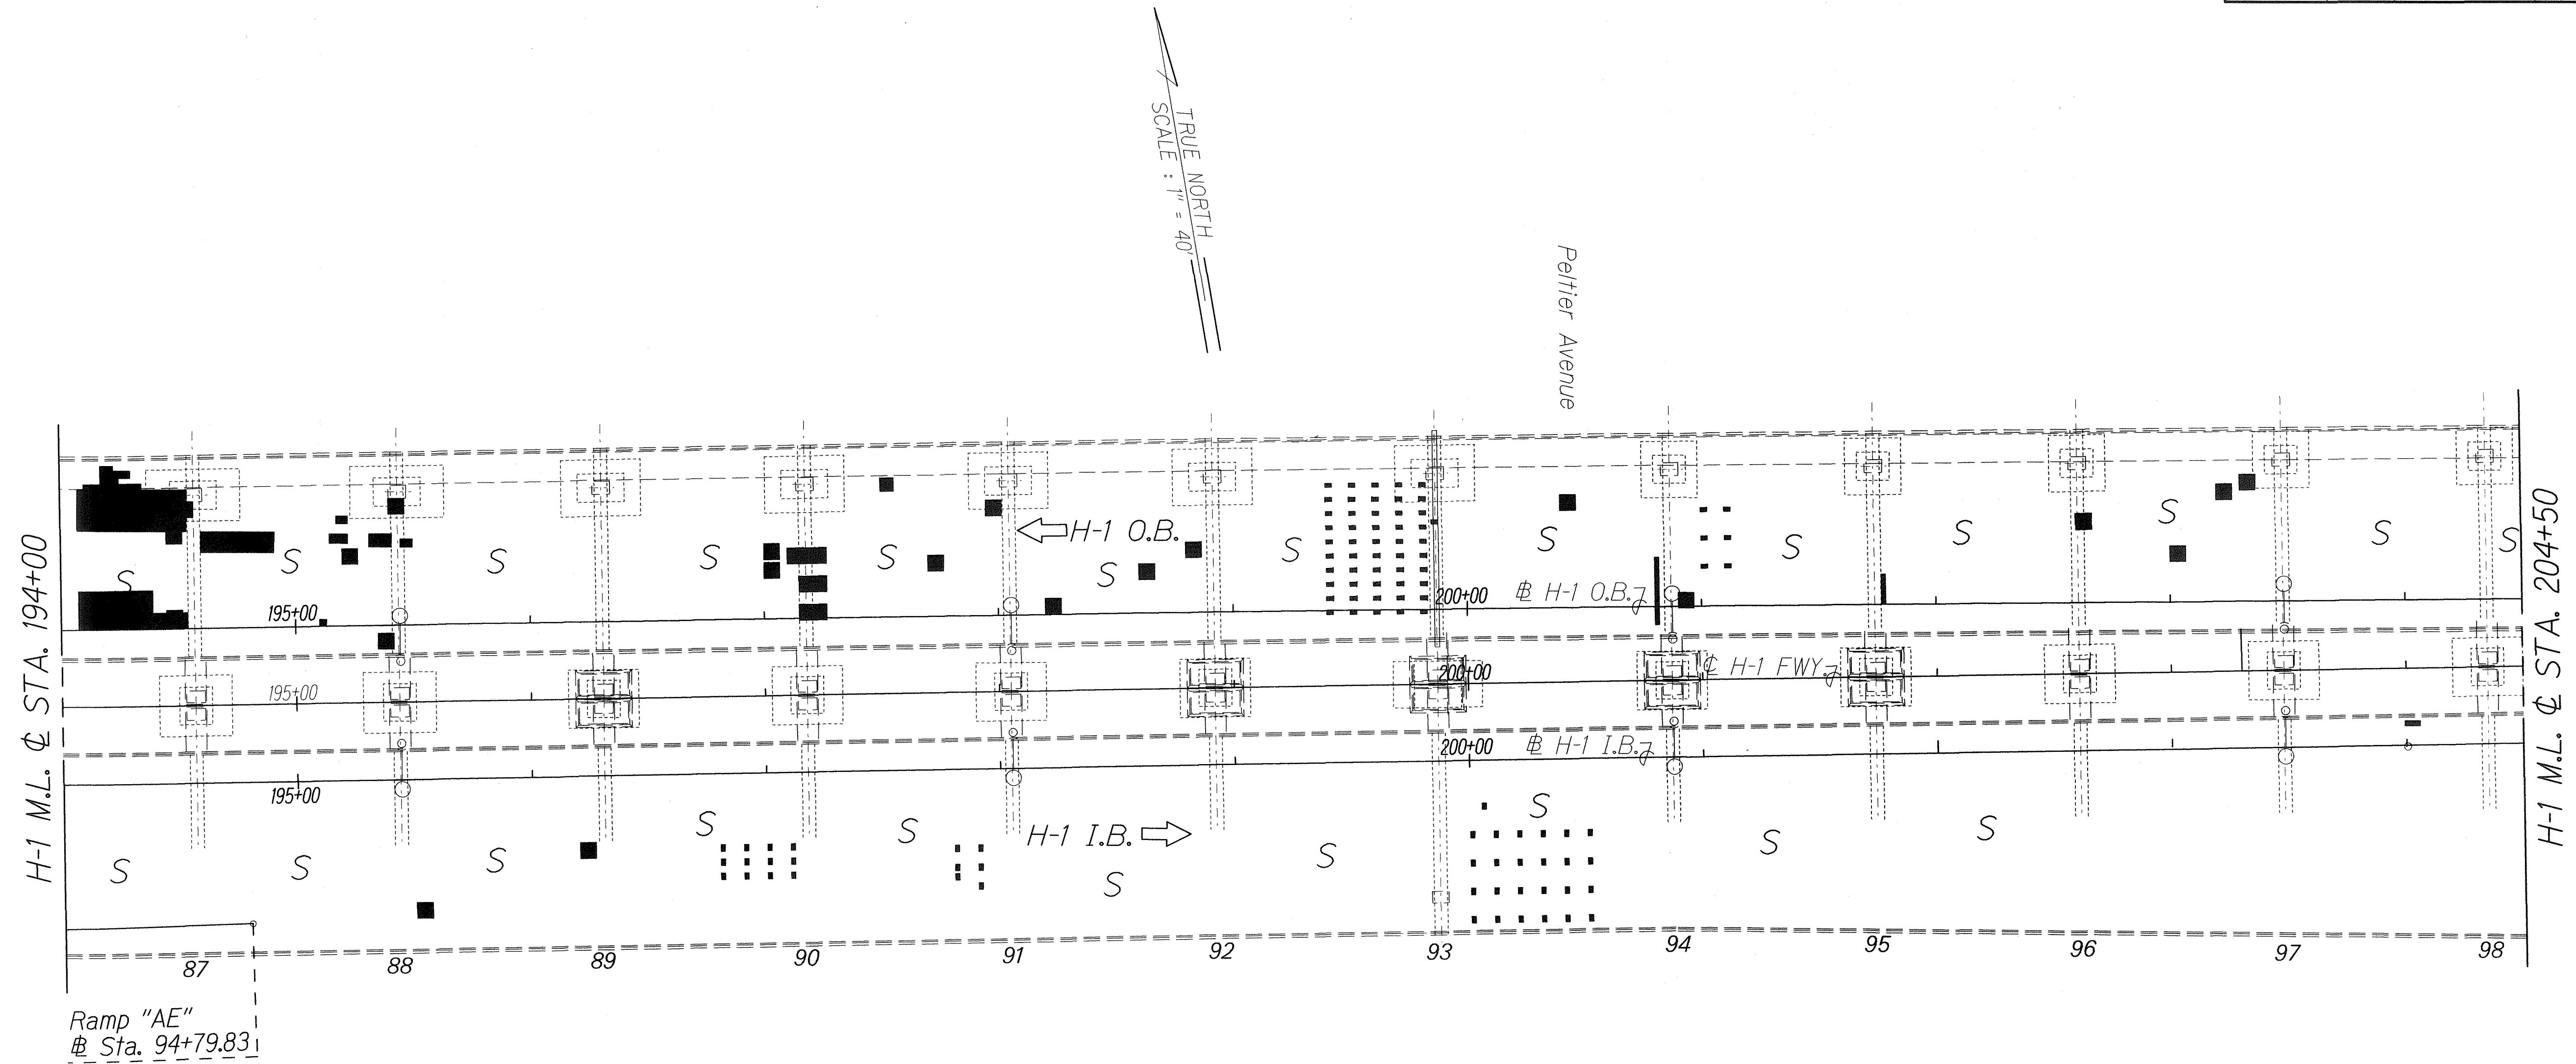


ORIGINAL PLAN	SURVEY PLOTTED BY	DATE
NOTE BOOK	DRAWN BY	
003357W	TRACED BY	
003357W	QUANTITIES BY	
003357W	CHECKED BY	

LEGEND FOR AS-BUILT POSTINGS	
	Squiggly line for as-built deletion
	Double line for as-built deletion
Roadway	Text for as-built posting

STATE OF HAWAII DEPARTMENT OF TRANSPORTATION HIGHWAYS DIVISION	
ROADWAY PLAN	
INTERSTATE ROUTE H-1	
AIRPORT VIADUCT DECK REPAIR	
VICINITY OF VALKENBURGH ST. TO MIDDLE ST.	
Federal Aid Project No. IM-HI-1(254)	
Scale: 1" = 40'	Date: OCTOBER, 2005
SHEET No. 14 OF 8 SHEETS	

"AS-BUILT"

FED. ROAD DIST. NO.	STATE	FED. AID PROJ. NO.	FISCAL YEAR	SHEET NO.	TOTAL SHEETS
HAWAII	HAW.	IM-HI-1(254)	2006	22	31

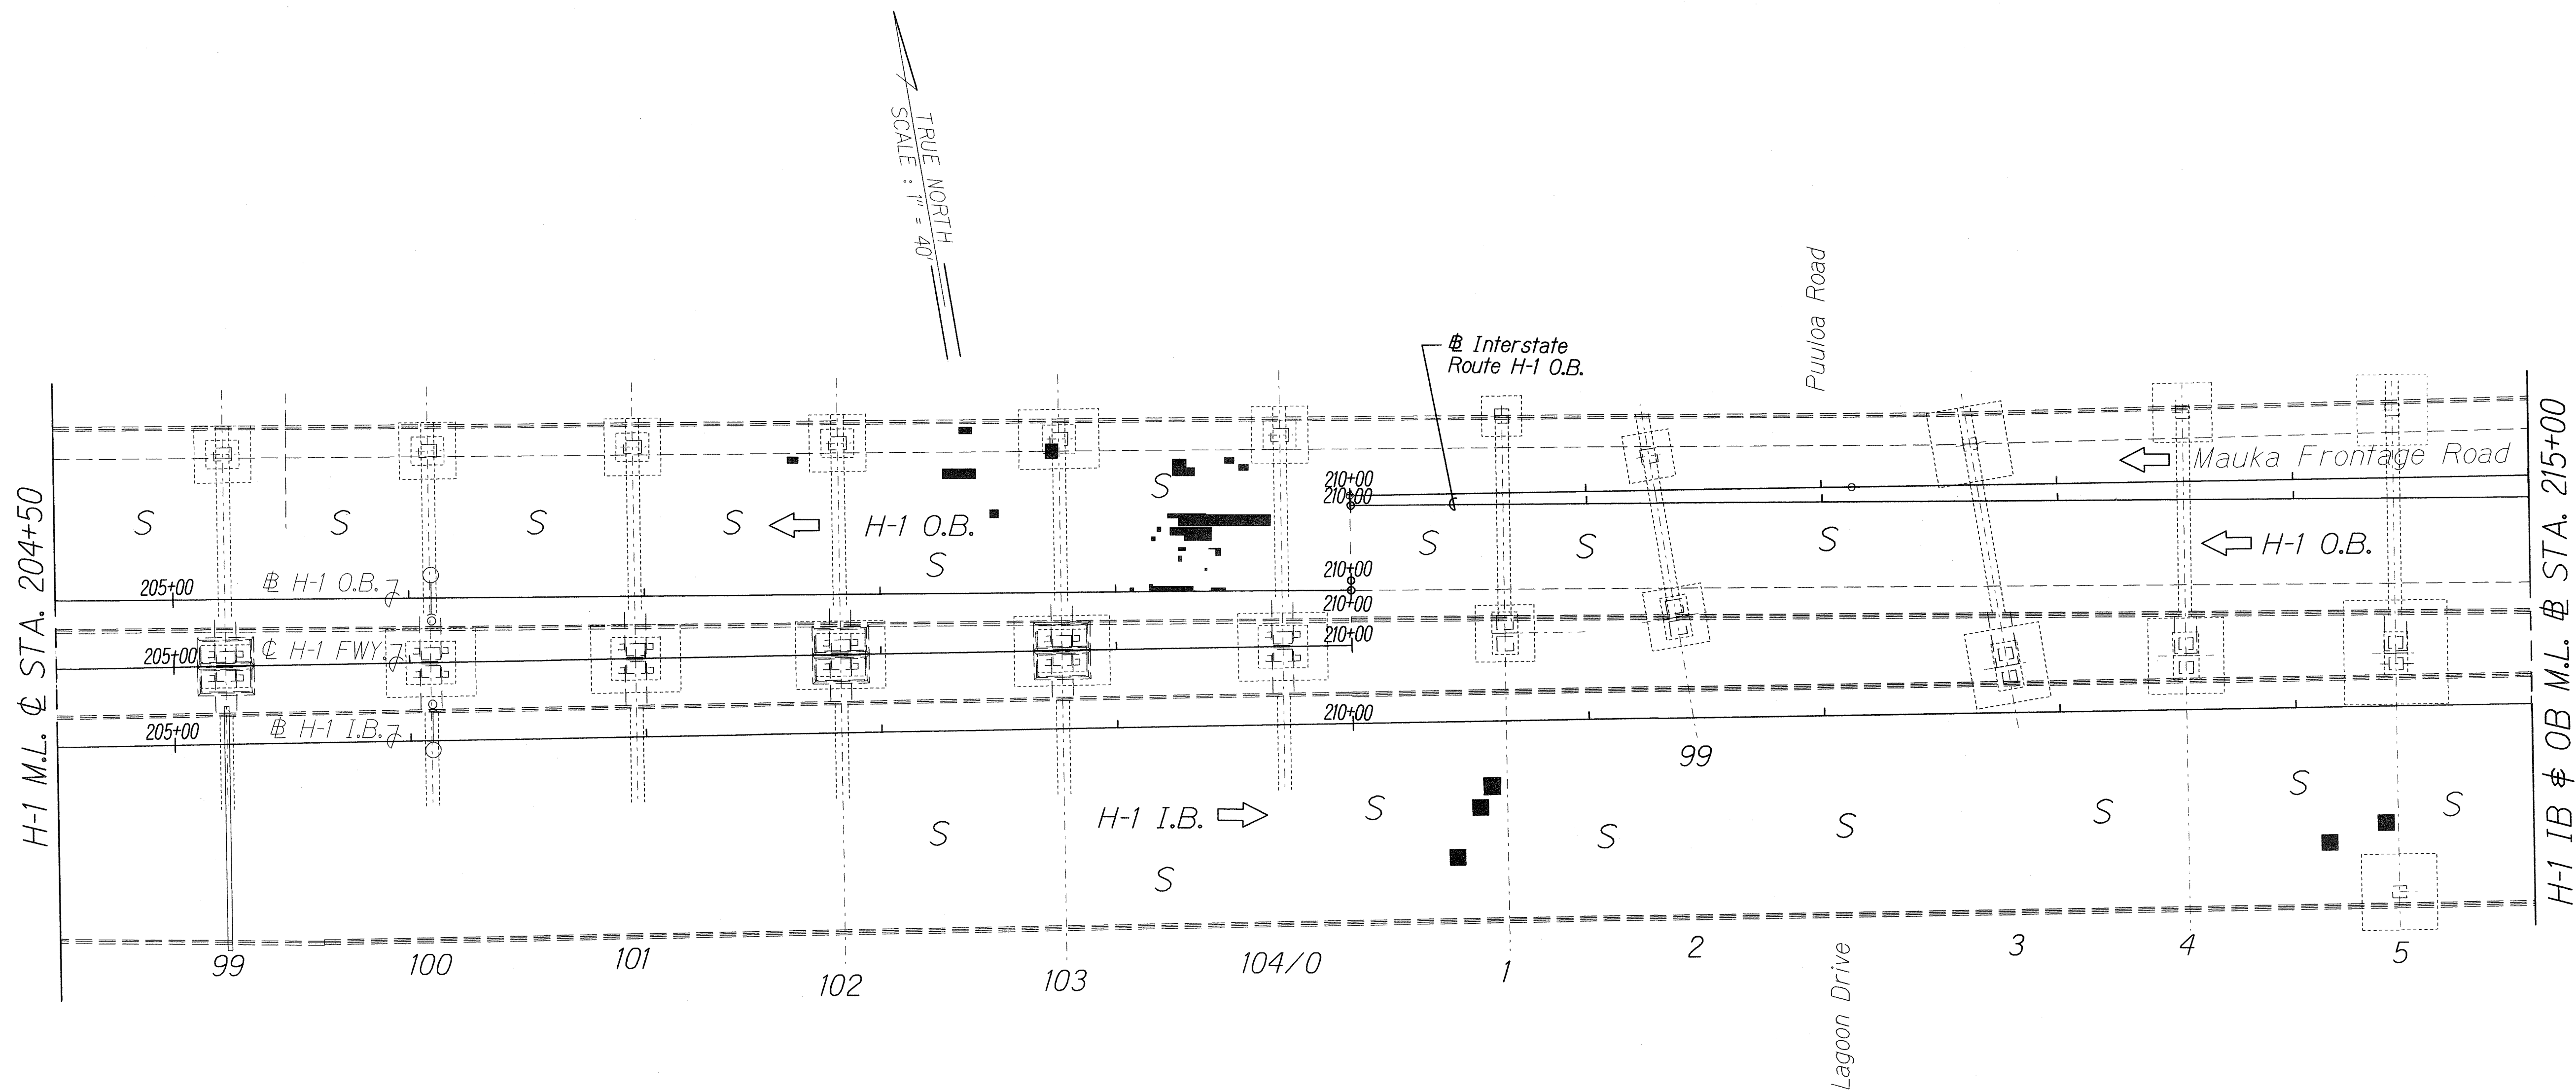

ORIGINAL PLAN	SURVEY PLOTTED BY	DATE
NOTE BOOK	DRAWN BY	
DESIGNED BY	CHECKED BY	
DATE		


LEGEND FOR AS-BUILT POSTINGS	
	Squiggly line for as-built deletion
	Double line for as-built deletion
Roadway	Text for as-built posting

STATE OF HAWAII DEPARTMENT OF TRANSPORTATION HIGHWAYS DIVISION
ROADWAY PLAN
INTERSTATE ROUTE H-1 AIRPORT VIADUCT DECK REPAIR
VICINITY OF VALKENBURGH ST. TO MIDDLE ST.
Federal Aid Project No. IM-HI-1(254)
Scale: 1" = 40'
Date: OCTOBER, 2005
SHEET No. 15 OF 22 SHEETS

"AS-BUILT"

FED. ROAD DIST. NO.	STATE	FED. AID PROJ. NO.	FISCAL YEAR	SHEET NO.	TOTAL SHEETS
HAWAII	HAW.	IM-HI-1(254)	2006	23	31

Note:
 All spans on the lower roads within the project limits are to be sounded. Lower roads include Makai and Mauka Frontage Roads and Ramps D, E, Ewa Portion of Ramp G and A.

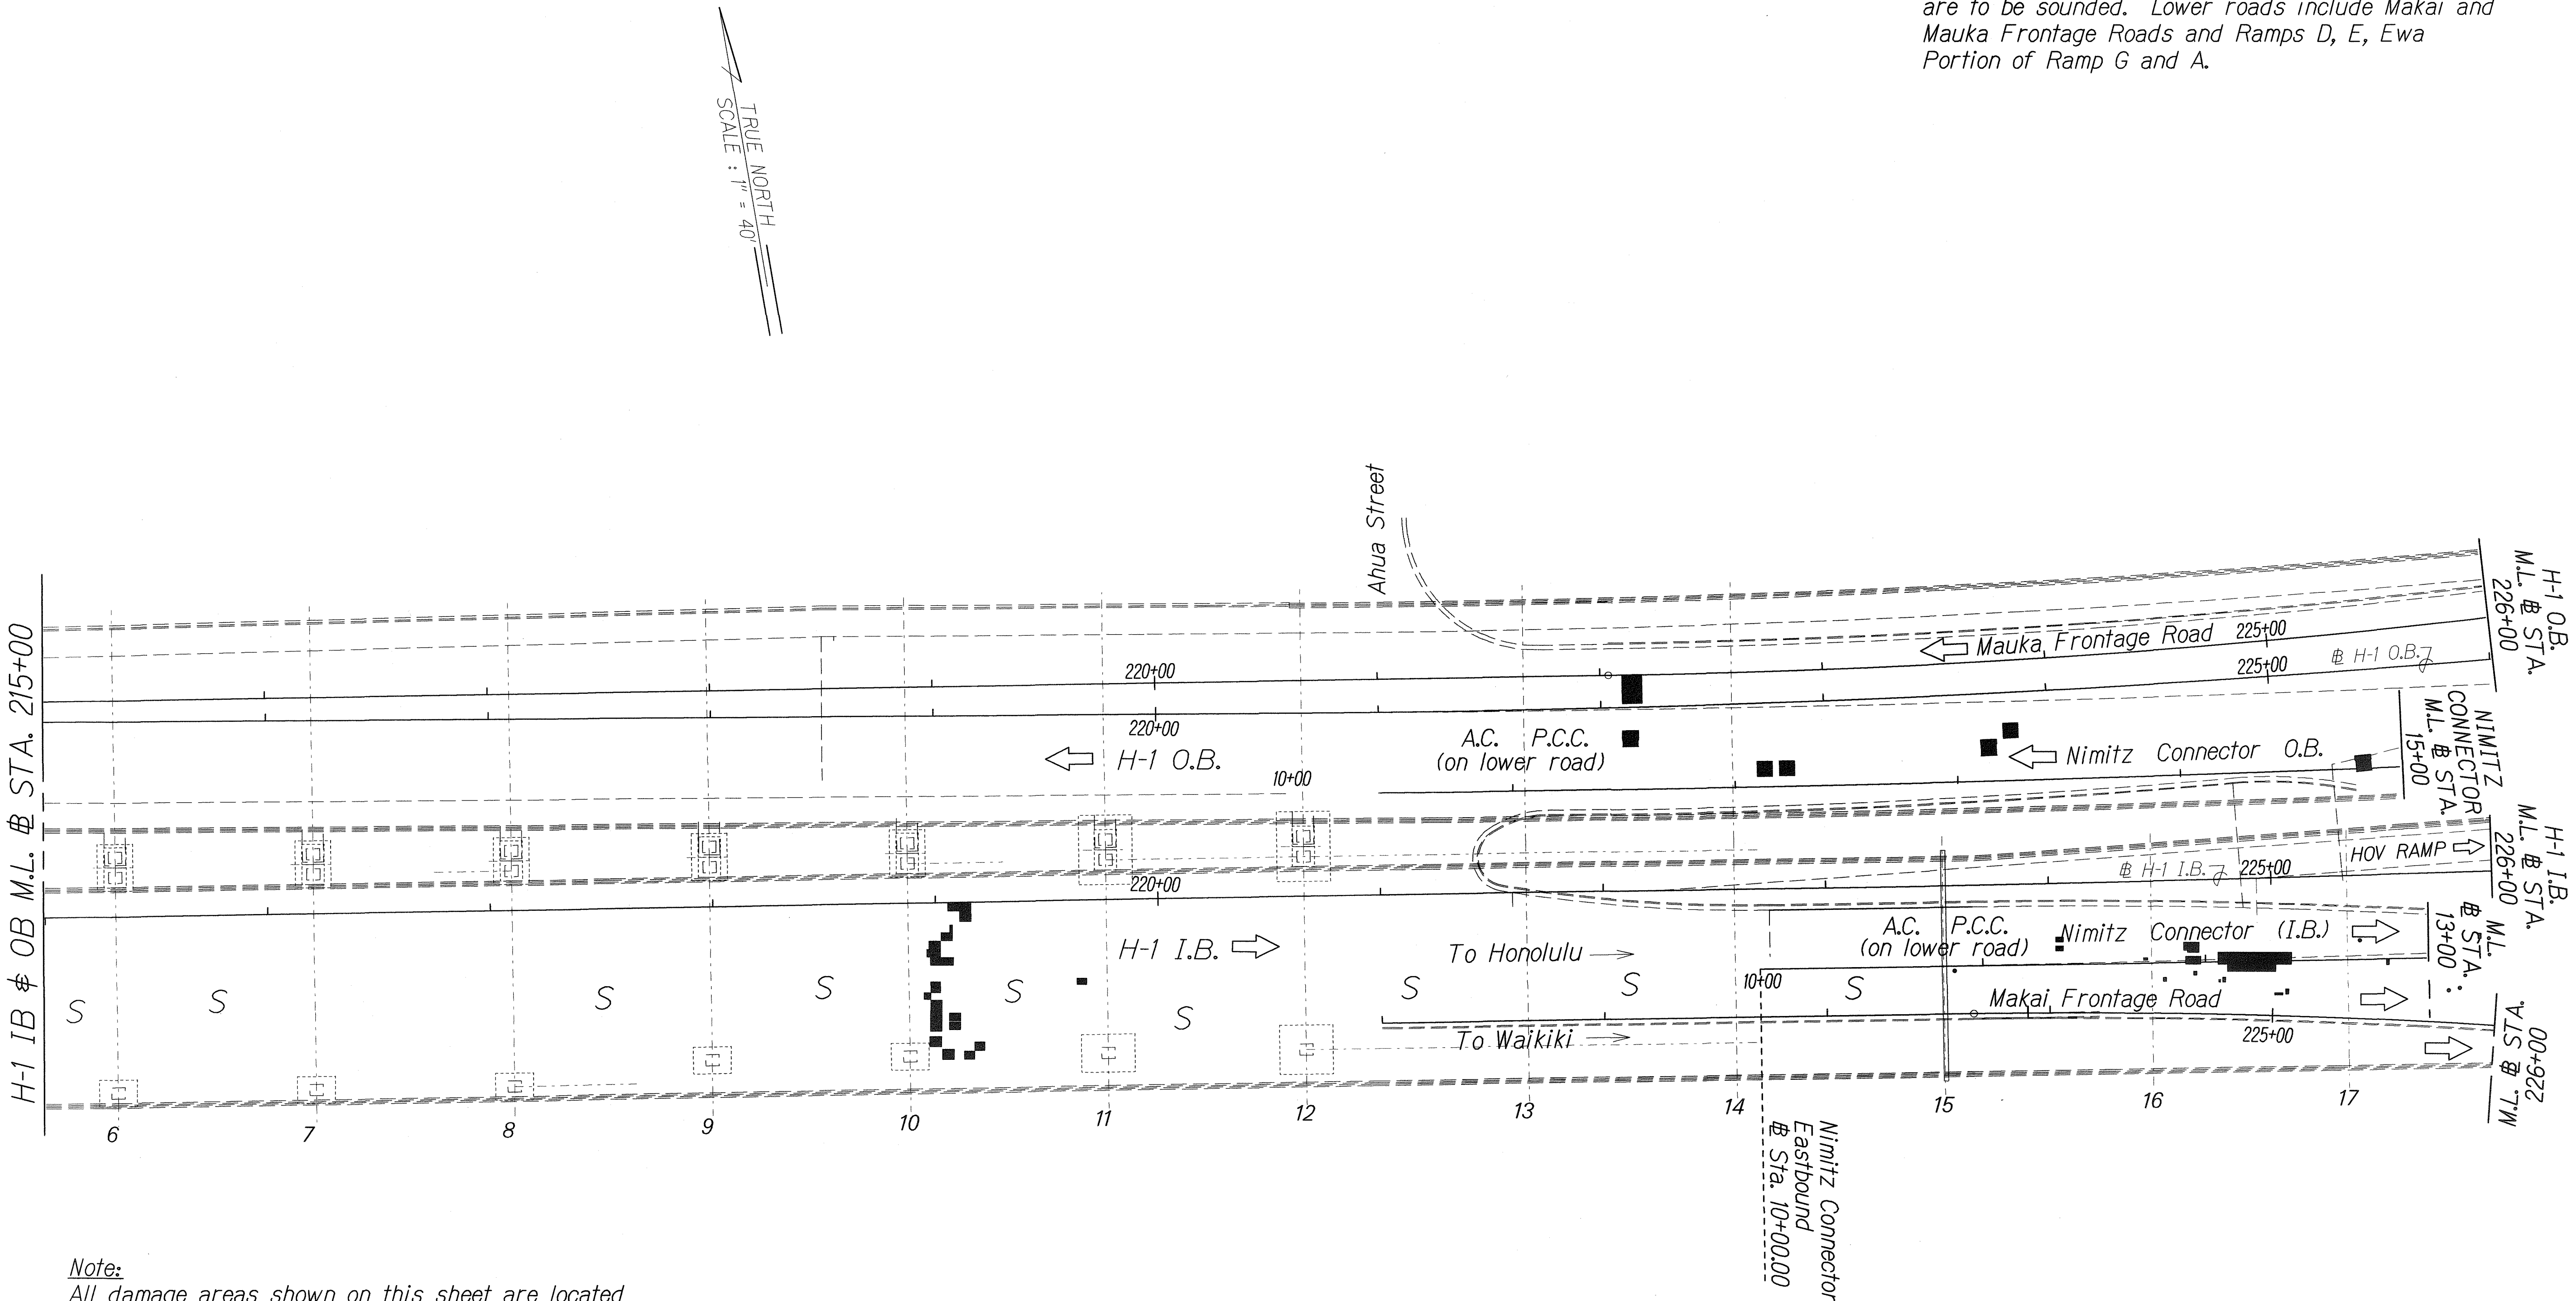

Note:
 All damage areas shown on this sheet are located on lower road unless noted otherwise.


ORIGINAL PLAN	DATE
NOTED BY	DATE
DESIGNED BY	DATE
CHECKED BY	DATE

LEGEND FOR AS-BUILT POSTINGS	
	Squiggly line for as-built deletion
	Double line for as-built deletion
Roadway	Text for as-built posting

STATE OF HAWAII
 DEPARTMENT OF TRANSPORTATION
 HIGHWAYS DIVISION

ROADWAY PLAN
 INTERSTATE ROUTE H-1
 AIRPORT VIADUCT DECK REPAIR
 VICINITY OF VALKENBURGH ST. TO MIDDLE ST.
 Federal Aid Project No. IM-HI-1(254)
 Scale: 1" = 40' Date: OCTOBER, 2005

FED. ROAD DIST. NO.	STATE	FED. AID PROJ. NO.	FISCAL YEAR	SHEET NO.	TOTAL SHEETS
HAWAII	HAW.	IM-HI-1(254)	2006	24	31

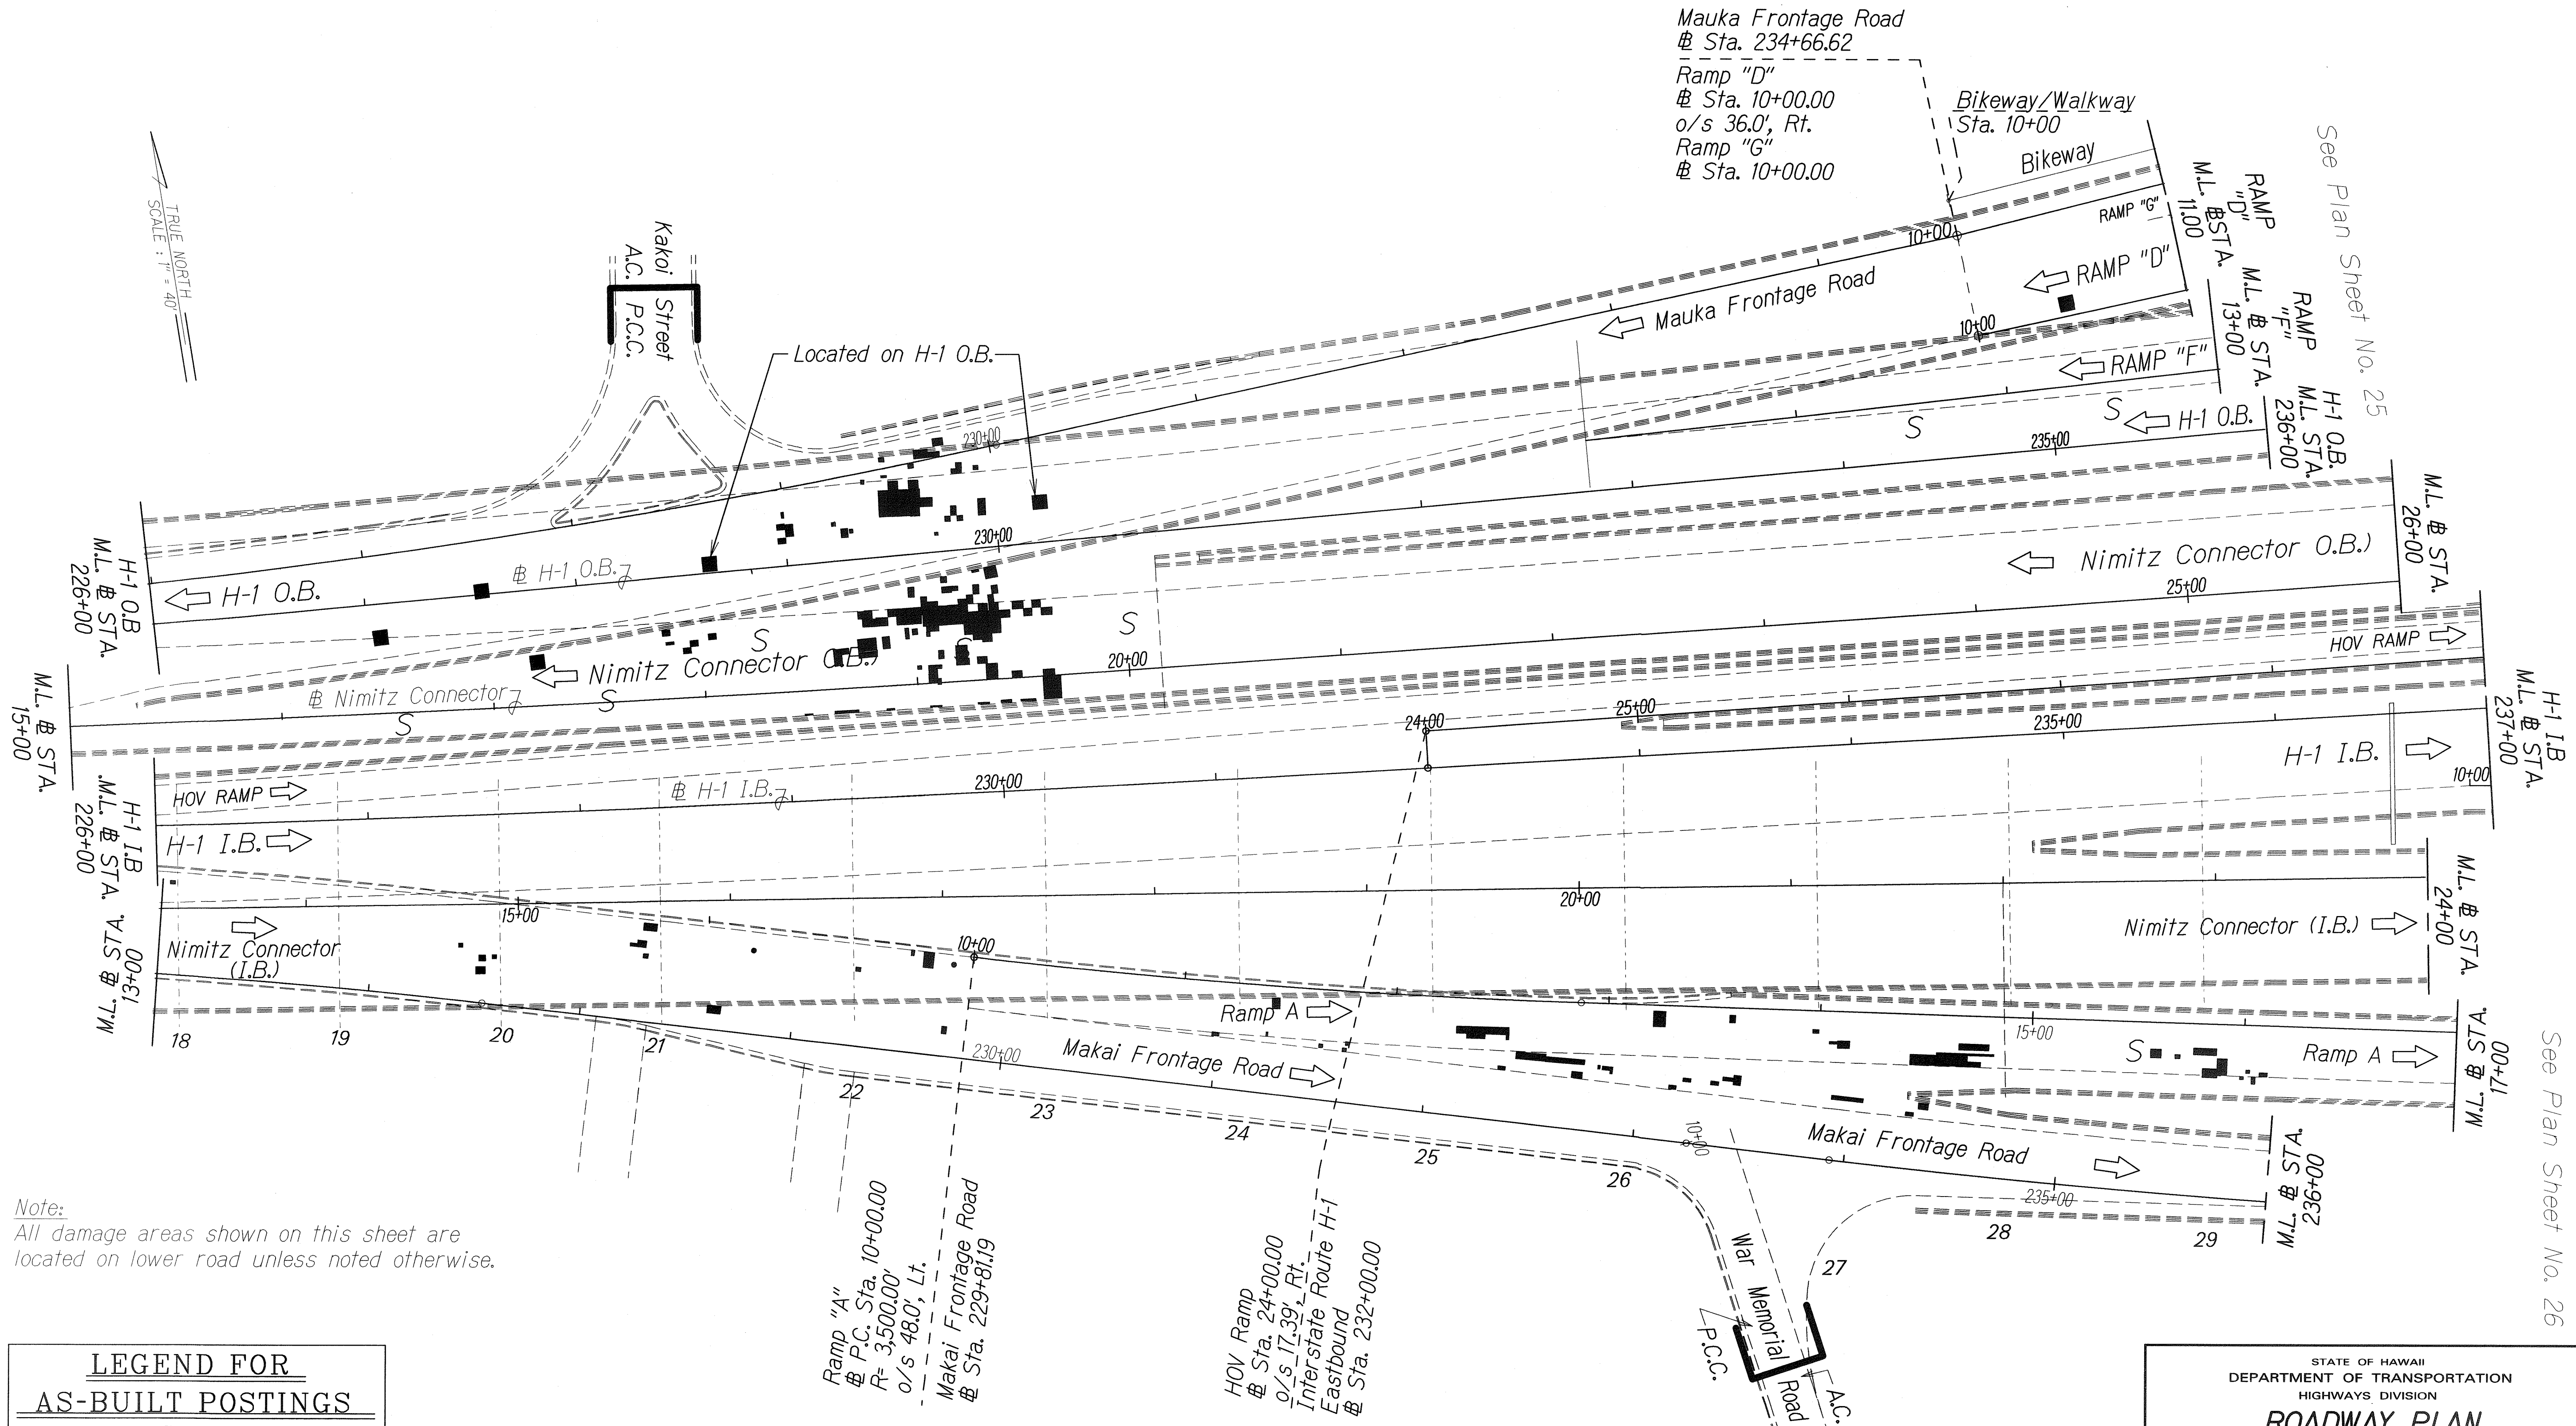

Note:
All damage areas shown on this sheet are located on lower road unless noted otherwise.

LEGEND FOR AS-BUILT POSTINGS	
	Squiggly line for as-built deletion
	Double line for as-built deletion
Roadway	Text for as-built posting

STATE OF HAWAII
DEPARTMENT OF TRANSPORTATION
HIGHWAYS DIVISION

ROADWAY PLAN

INTERSTATE ROUTE H-1

AIRPORT VIADUCT DECK REPAIR

VICINITY OF VALKENBURGH ST. TO MIDDLE ST.

Federal Aid Project No. IM-HI-1(254)


Scale: 1" = 40' Date: OCTOBER, 2005

SHEET No. 17 OF 22 SHEETS

ORIGINAL PLAN	DATE
SURVEY PLOTTED BY	
DESIGNED BY	
TRACED BY	
QUANTITIES BY	
CHECKED BY	

"AS-BUILT"

FED. ROAD DIST. NO.	STATE	FED. AID PROJ. NO.	FISCAL YEAR	SHEET NO.	TOTAL SHEETS
HAWAII	HAW.	IM-HI-1(254)	2006	24	31

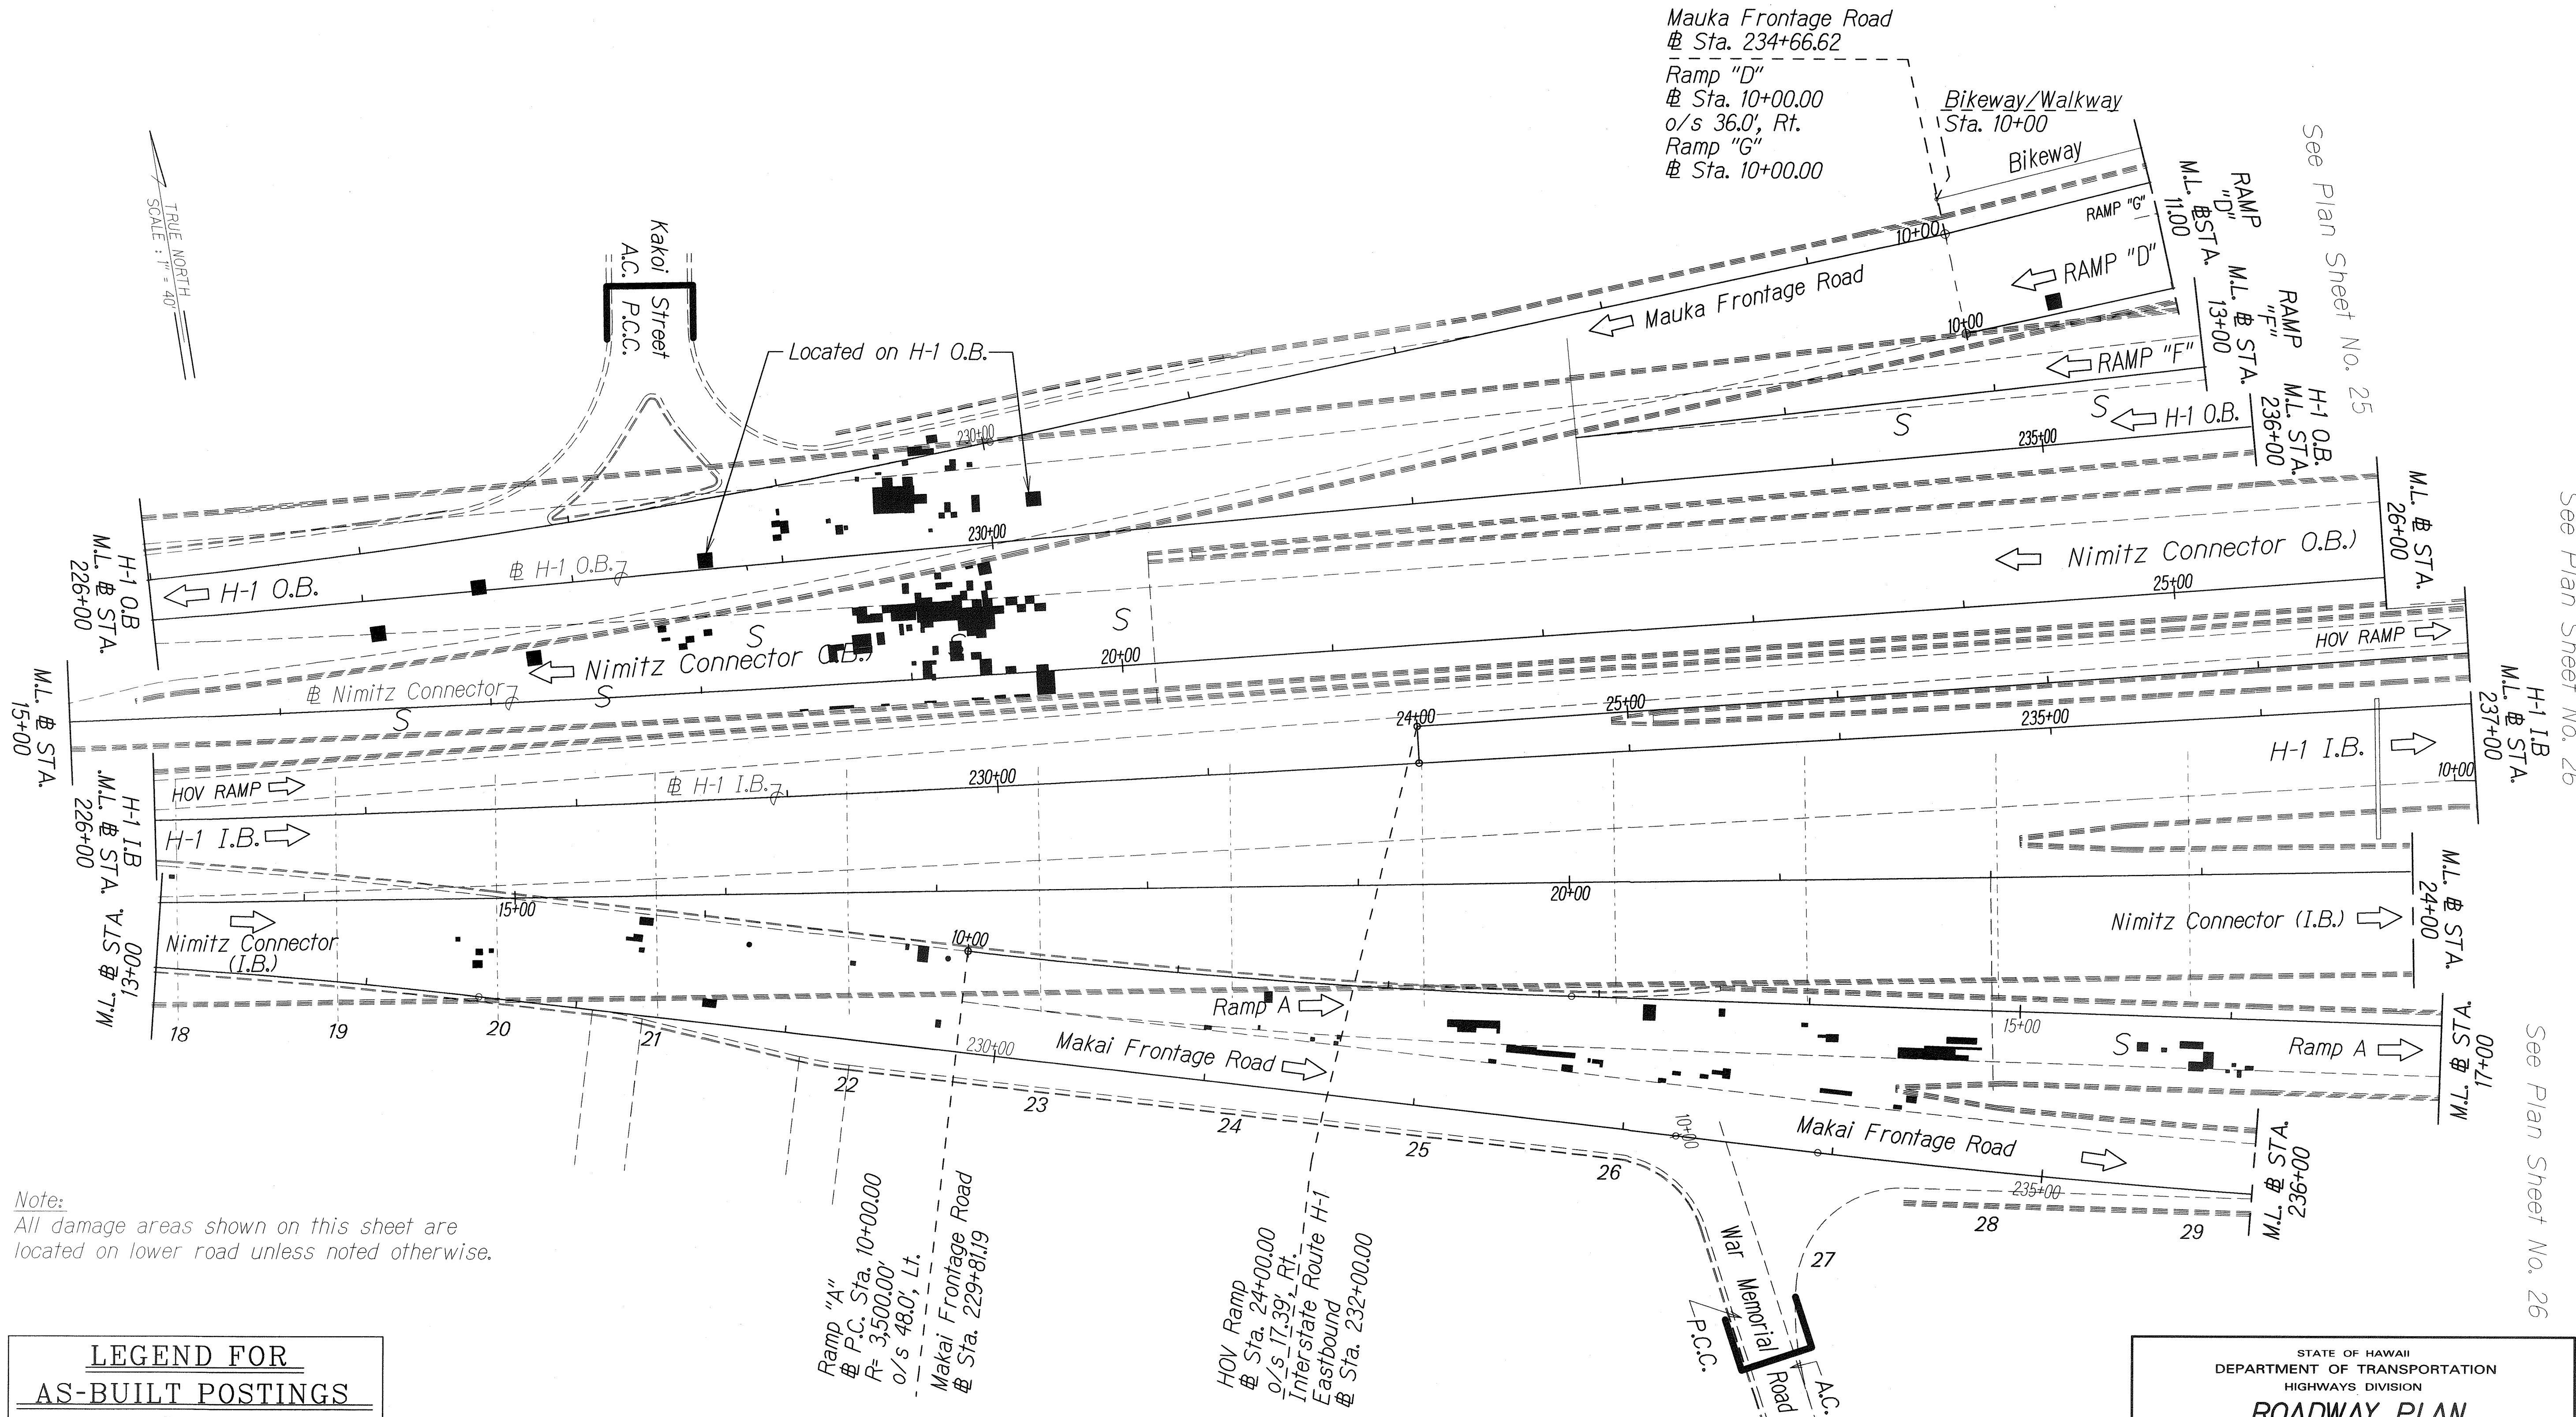

Note:
All damage areas shown on this sheet are located on lower road unless noted otherwise.

LEGEND FOR AS-BUILT POSTINGS	
	Squiggly line for as-built deletion
	Double line for as-built deletion
Roadway	Text for as-built posting

STATE OF HAWAII
DEPARTMENT OF TRANSPORTATION
HIGHWAYS DIVISION

ROADWAY PLAN

INTERSTATE ROUTE H-1

AIRPORT VIADUCT DECK REPAIR

VICINITY OF VALKENBURGH ST. TO MIDDLE ST.

Federal Aid Project No. IM-HI-1(254)


Scale: 1" = 40' Date: OCTOBER, 2005

SHEET No. 17 OF 22 SHEETS

ORIGINAL PLAN	DATE
SURVEY PLOTTED BY	
DESIGNED BY	
TRACED BY	
QUANTITIES BY	
CHECKED BY	

"AS-BUILT"

FED. ROAD DIST. NO.	STATE	FED. AID PROJ. NO.	FISCAL YEAR	SHEET NO.	TOTAL SHEETS
HAWAII	HAW.	IM-HI-1(254)	2006	25	31

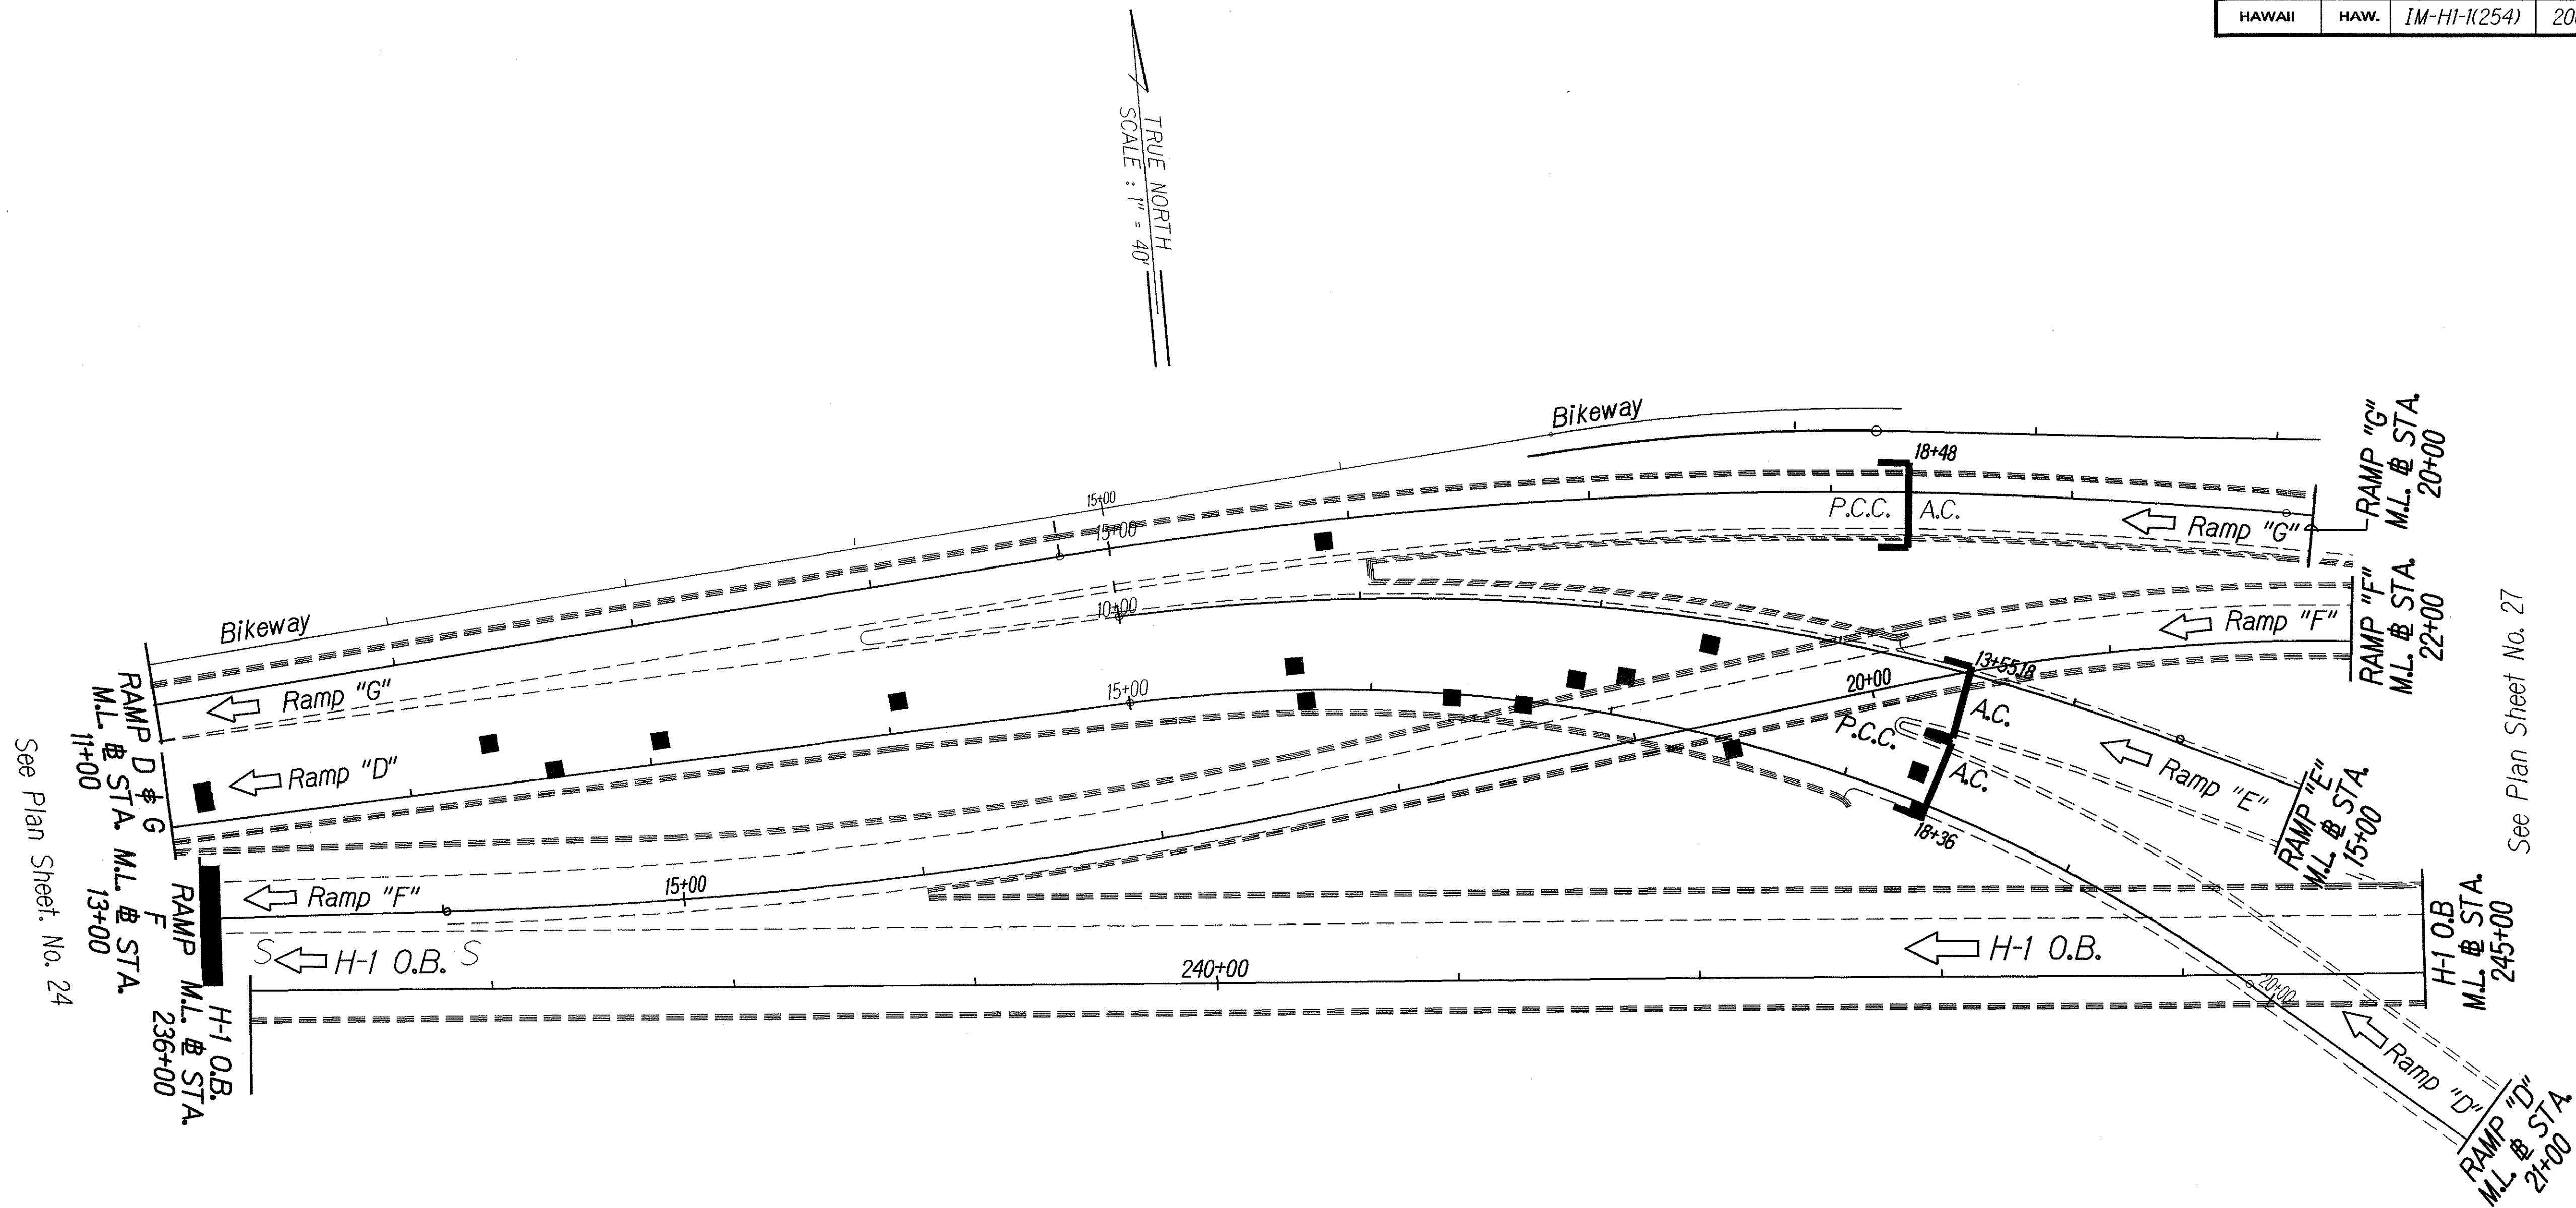

See Plan Sheet No. 24

See Plan Sheet No. 27

ORIGINAL PLAN	SURVEY PLOTTED BY	DATE
NOTE BOOK	DRAWN BY	
DESIGNED BY	CHECKED BY	
QUANTITIES BY		

STATE OF HAWAII
DEPARTMENT OF TRANSPORTATION
HIGHWAYS DIVISION

ROADWAY PLAN

INTERSTATE ROUTE H-1


AIRPORT VIADUCT DECK REPAIR

VICINITY OF VALKENBURGH ST. TO MIDDLE ST.

Federal Aid Project No. IM-HI-1(254)

Scale: 1" = 40' Date: OCTOBER, 2005

FED. ROAD DIST. NO.	STATE	FED. AID PROJ. NO.	FISCAL YEAR	SHEET NO.	TOTAL SHEETS
HAWAII	HAW.	IM-H1-K(254)	2006	26	31

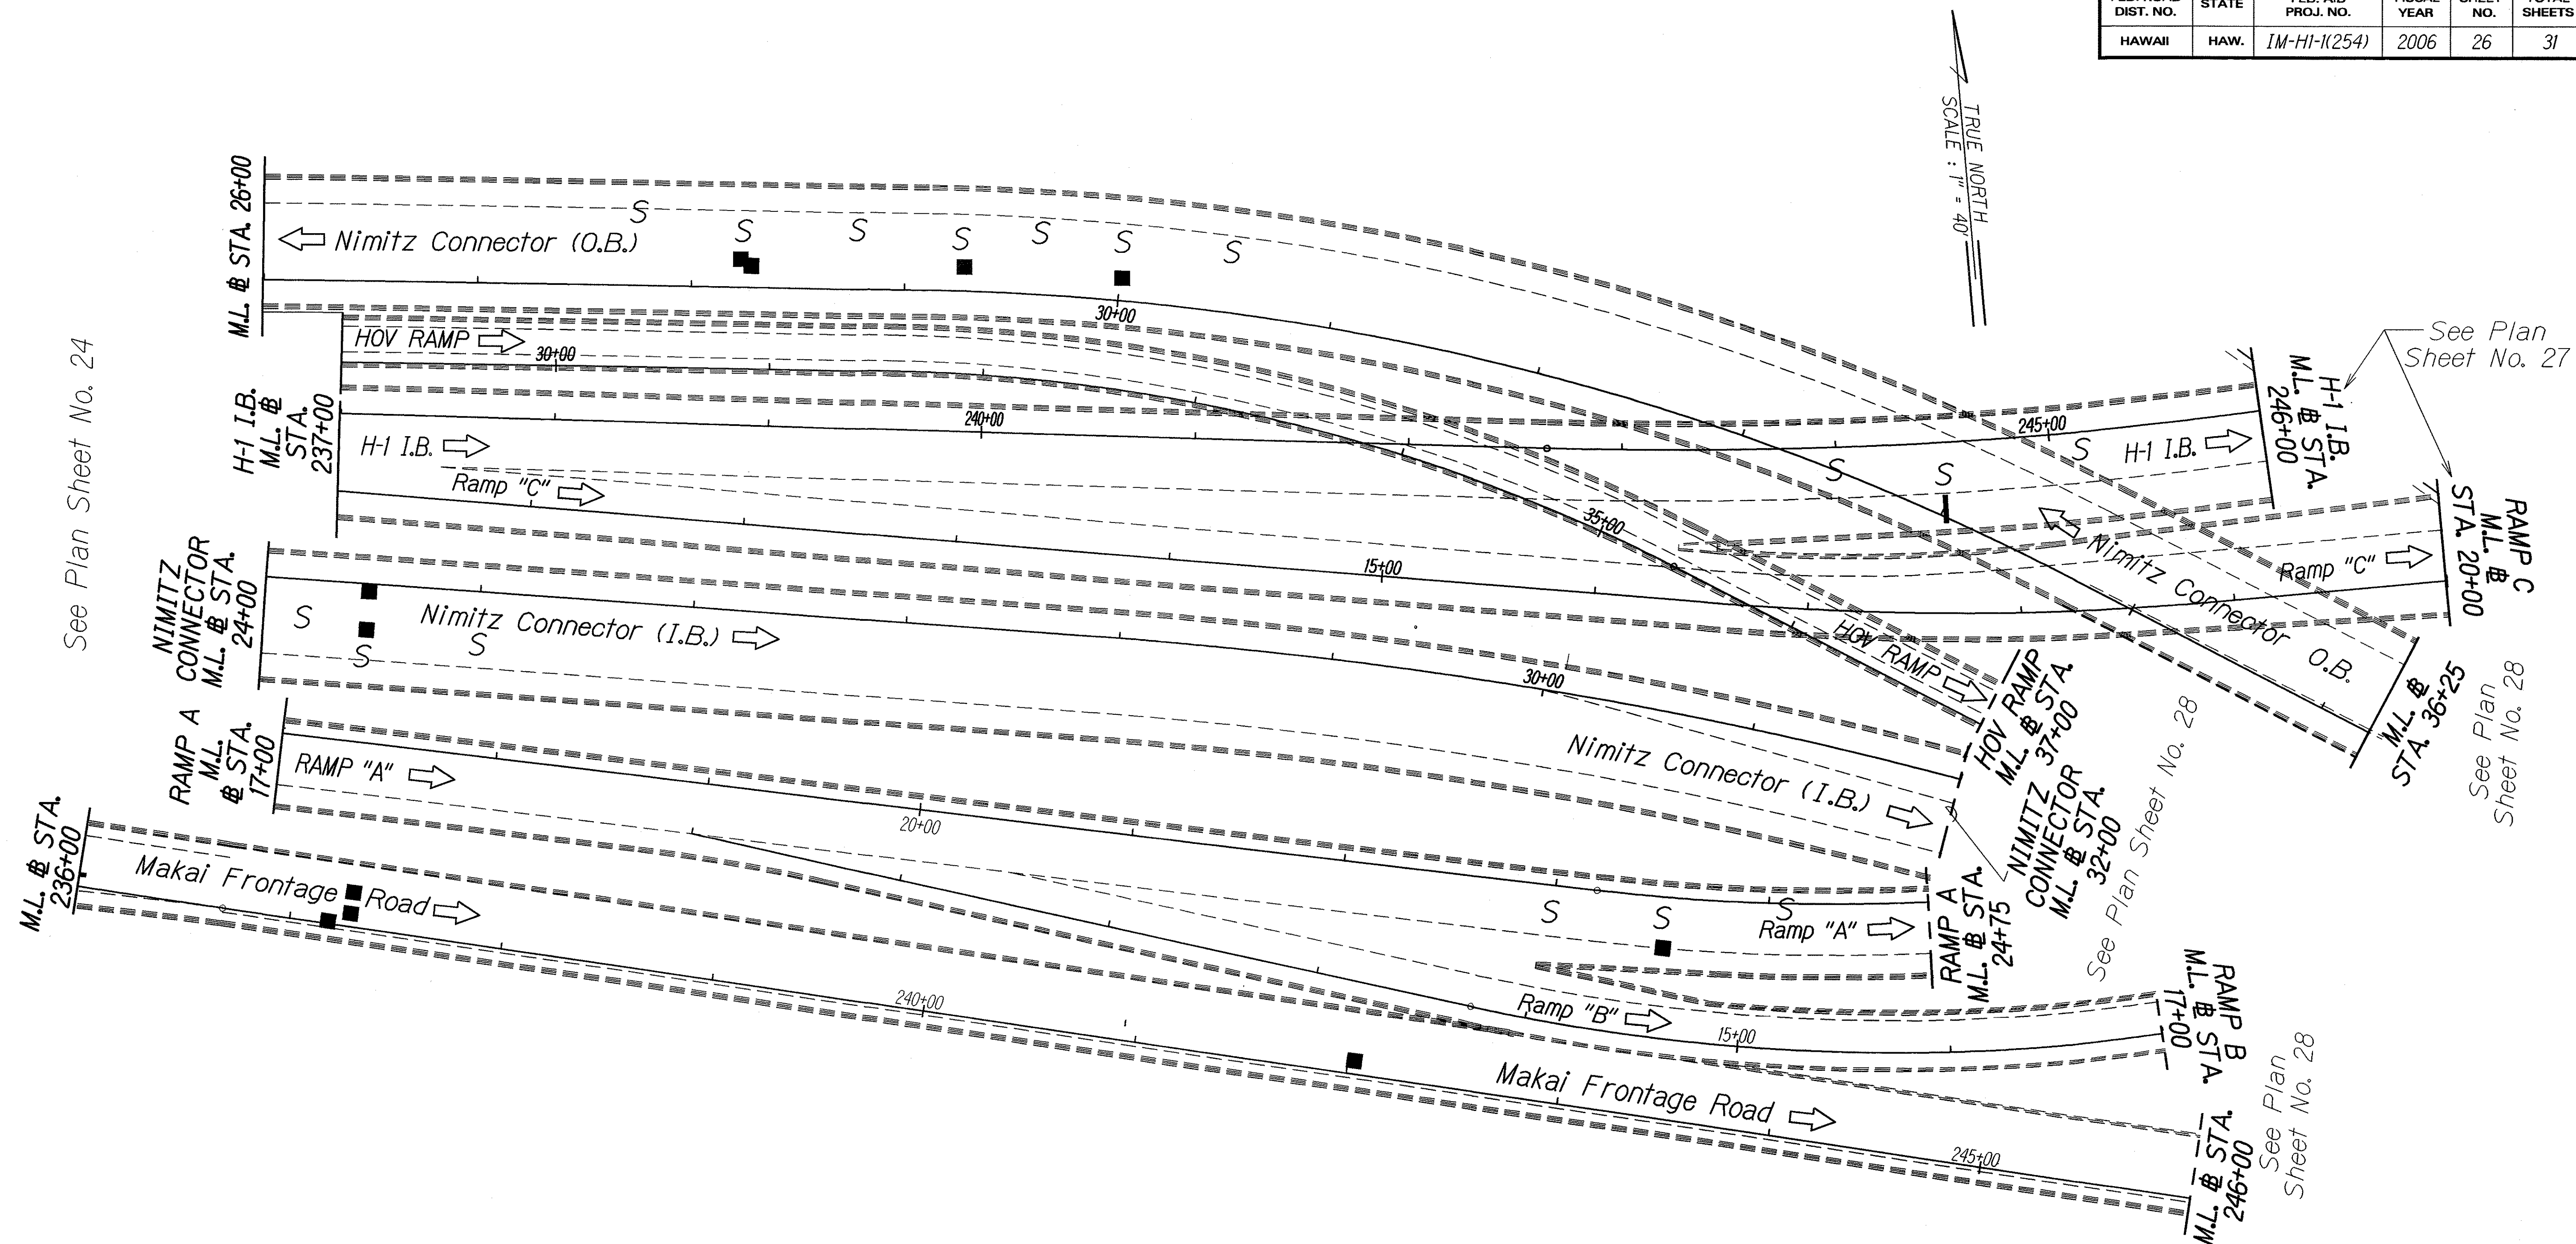

ORIGINAL PLAN	SURVEY PLOTTED BY	DATE
NOTE BOOK	DRAWN BY	
DESIGNED BY	CHECKED BY	
QUANTITIES BY		

STATE OF HAWAII
DEPARTMENT OF TRANSPORTATION
HIGHWAYS DIVISION

ROADWAY PLAN

INTERSTATE ROUTE H-1

AIRPORT VIADUCT DECK REPAIR

VICINITY OF VALKENBURGH ST. TO MIDDLE ST.

Federal Aid Project No. IM-H1-K(254)


Scale: 1" = 40' Date: OCTOBER, 2005

SHEET No. 19 OF 22 SHEETS

FED. ROAD DIST. NO.	STATE	FED. AID PROJ. NO.	FISCAL YEAR	SHEET NO.	TOTAL SHEETS
HAWAII	HAW.	IM-HI-1(254)	2006	28	31

See Plan Sheet No. 26


See Plan Sheet No. 27

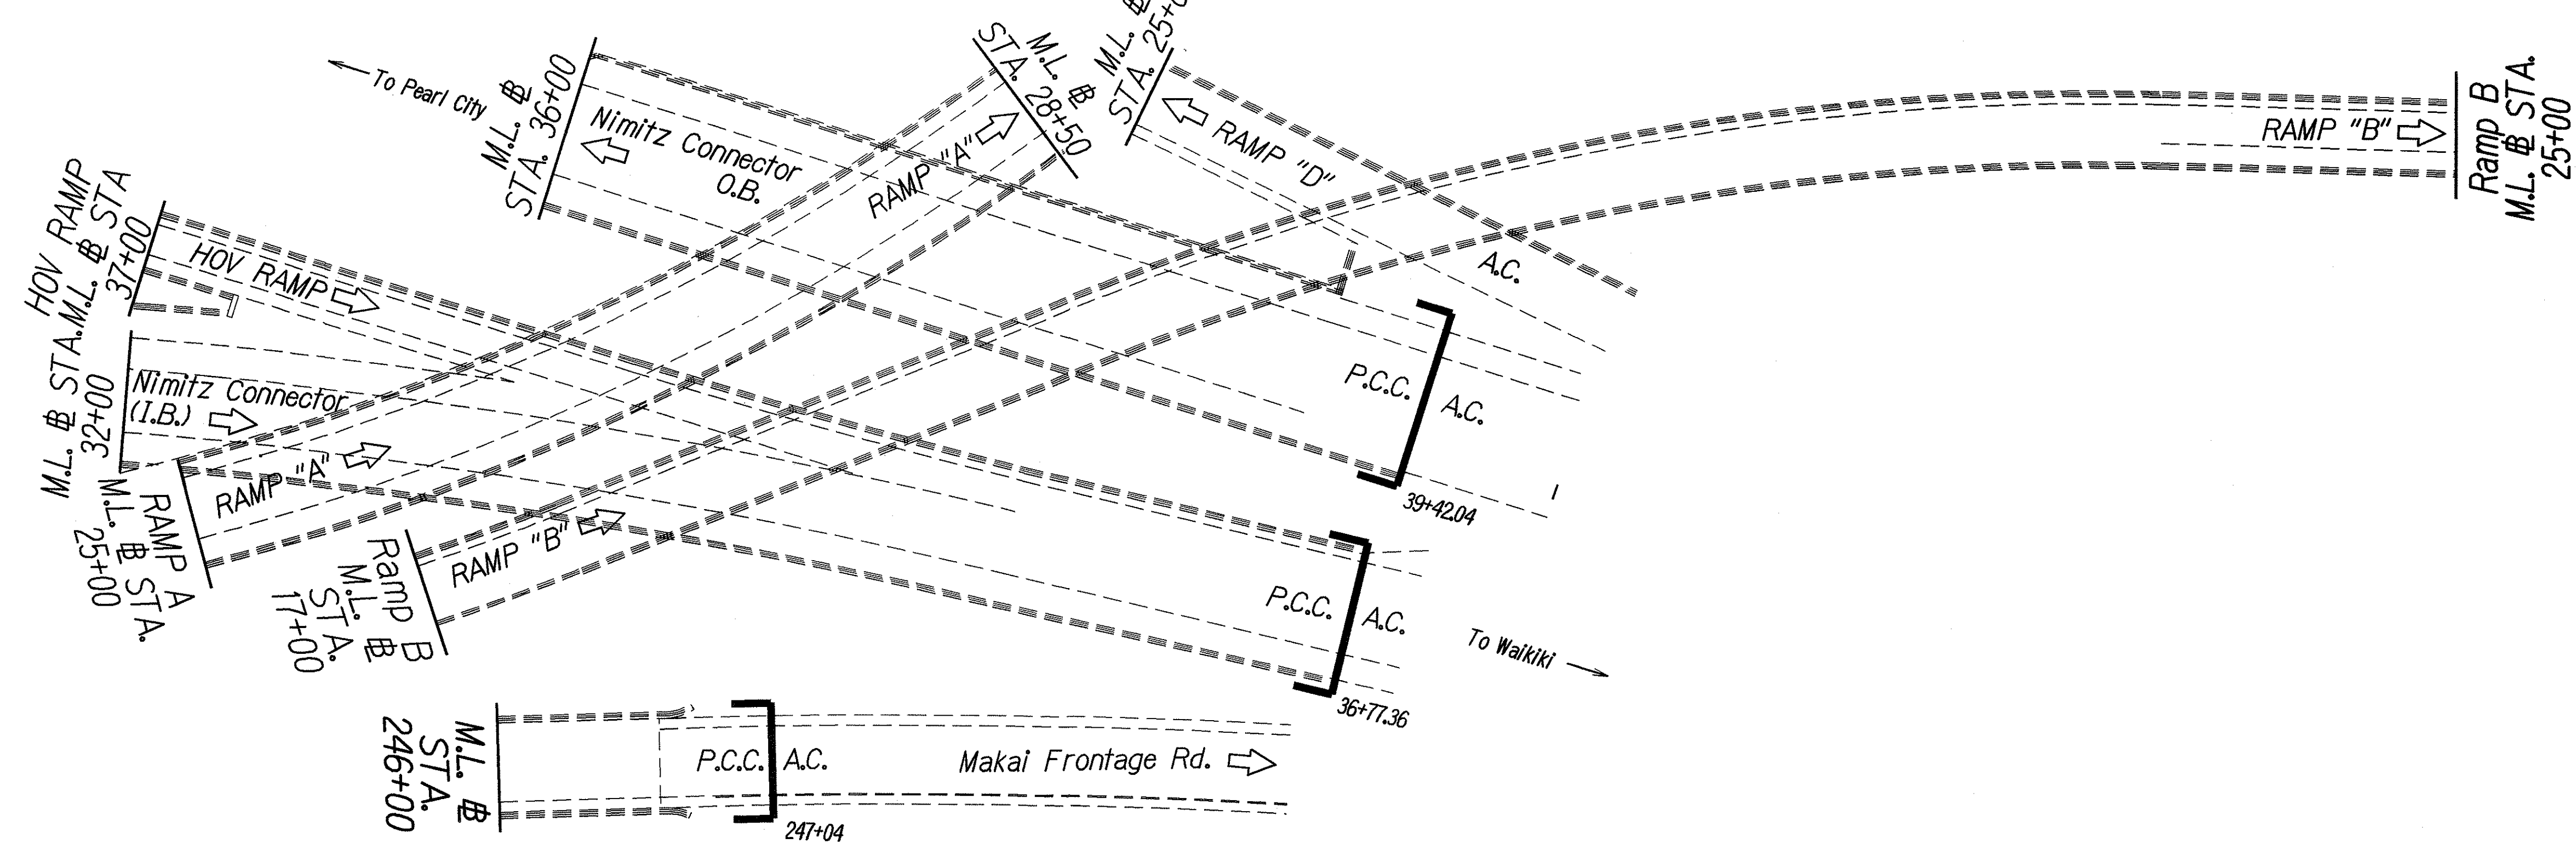

TRUE NORTH
SCALE: 1" = 40'

See Plan Sheet No. 27

M.L. # STA. 25+00
(See Above)

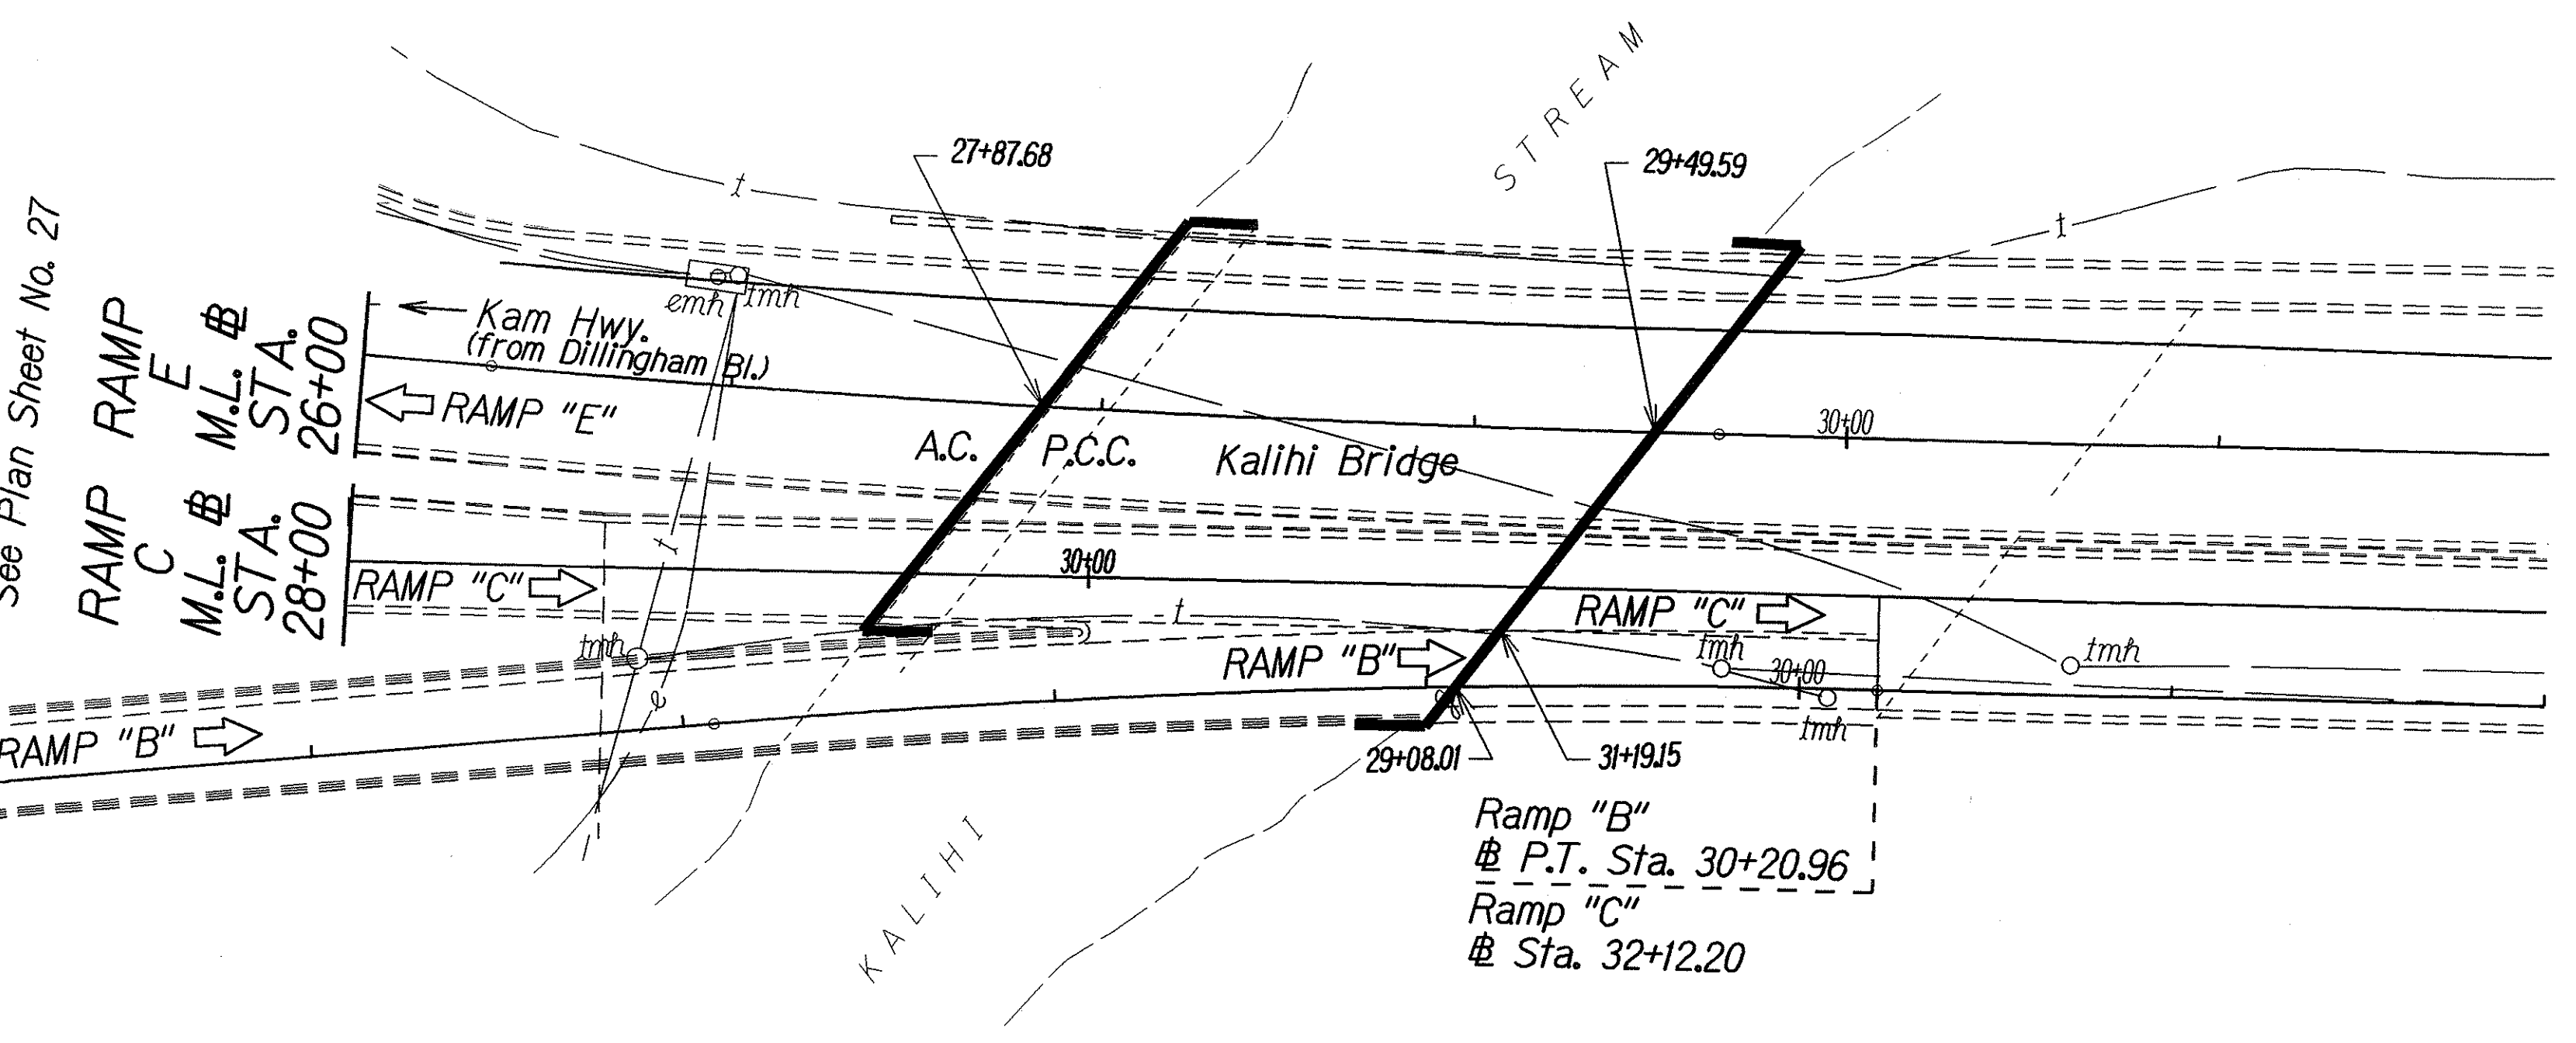

TRUE NORTH
SCALE: 1" = 40'

ORIGINAL PLAN	SURVEY PLOTTED BY	DATE
NOTE BOOK	DRAWN BY	
DESIGNED BY		
CHECKED BY		

STATE OF HAWAII
DEPARTMENT OF TRANSPORTATION
HIGHWAYS DIVISION

ROADWAY PLAN
INTERSTATE ROUTE H-1
AIRPORT VIADUCT DECK REPAIR
VICINITY OF VALKENBURGH ST. TO MIDDLE ST.
Federal Aid Project No. IM-HI-1(254)

Scale: 1" = 40' Date: OCTOBER, 2005

SHEET No. 28 OF 31 SHEETS

