


FED. ROAD DIST. NO.	STATE	FED. AID PROJ. NO.	FISCAL YEAR	SHEET NO.	TOTAL SHEETS
HAWAII	HAW.	I-HI-1(10)	1960	8	2

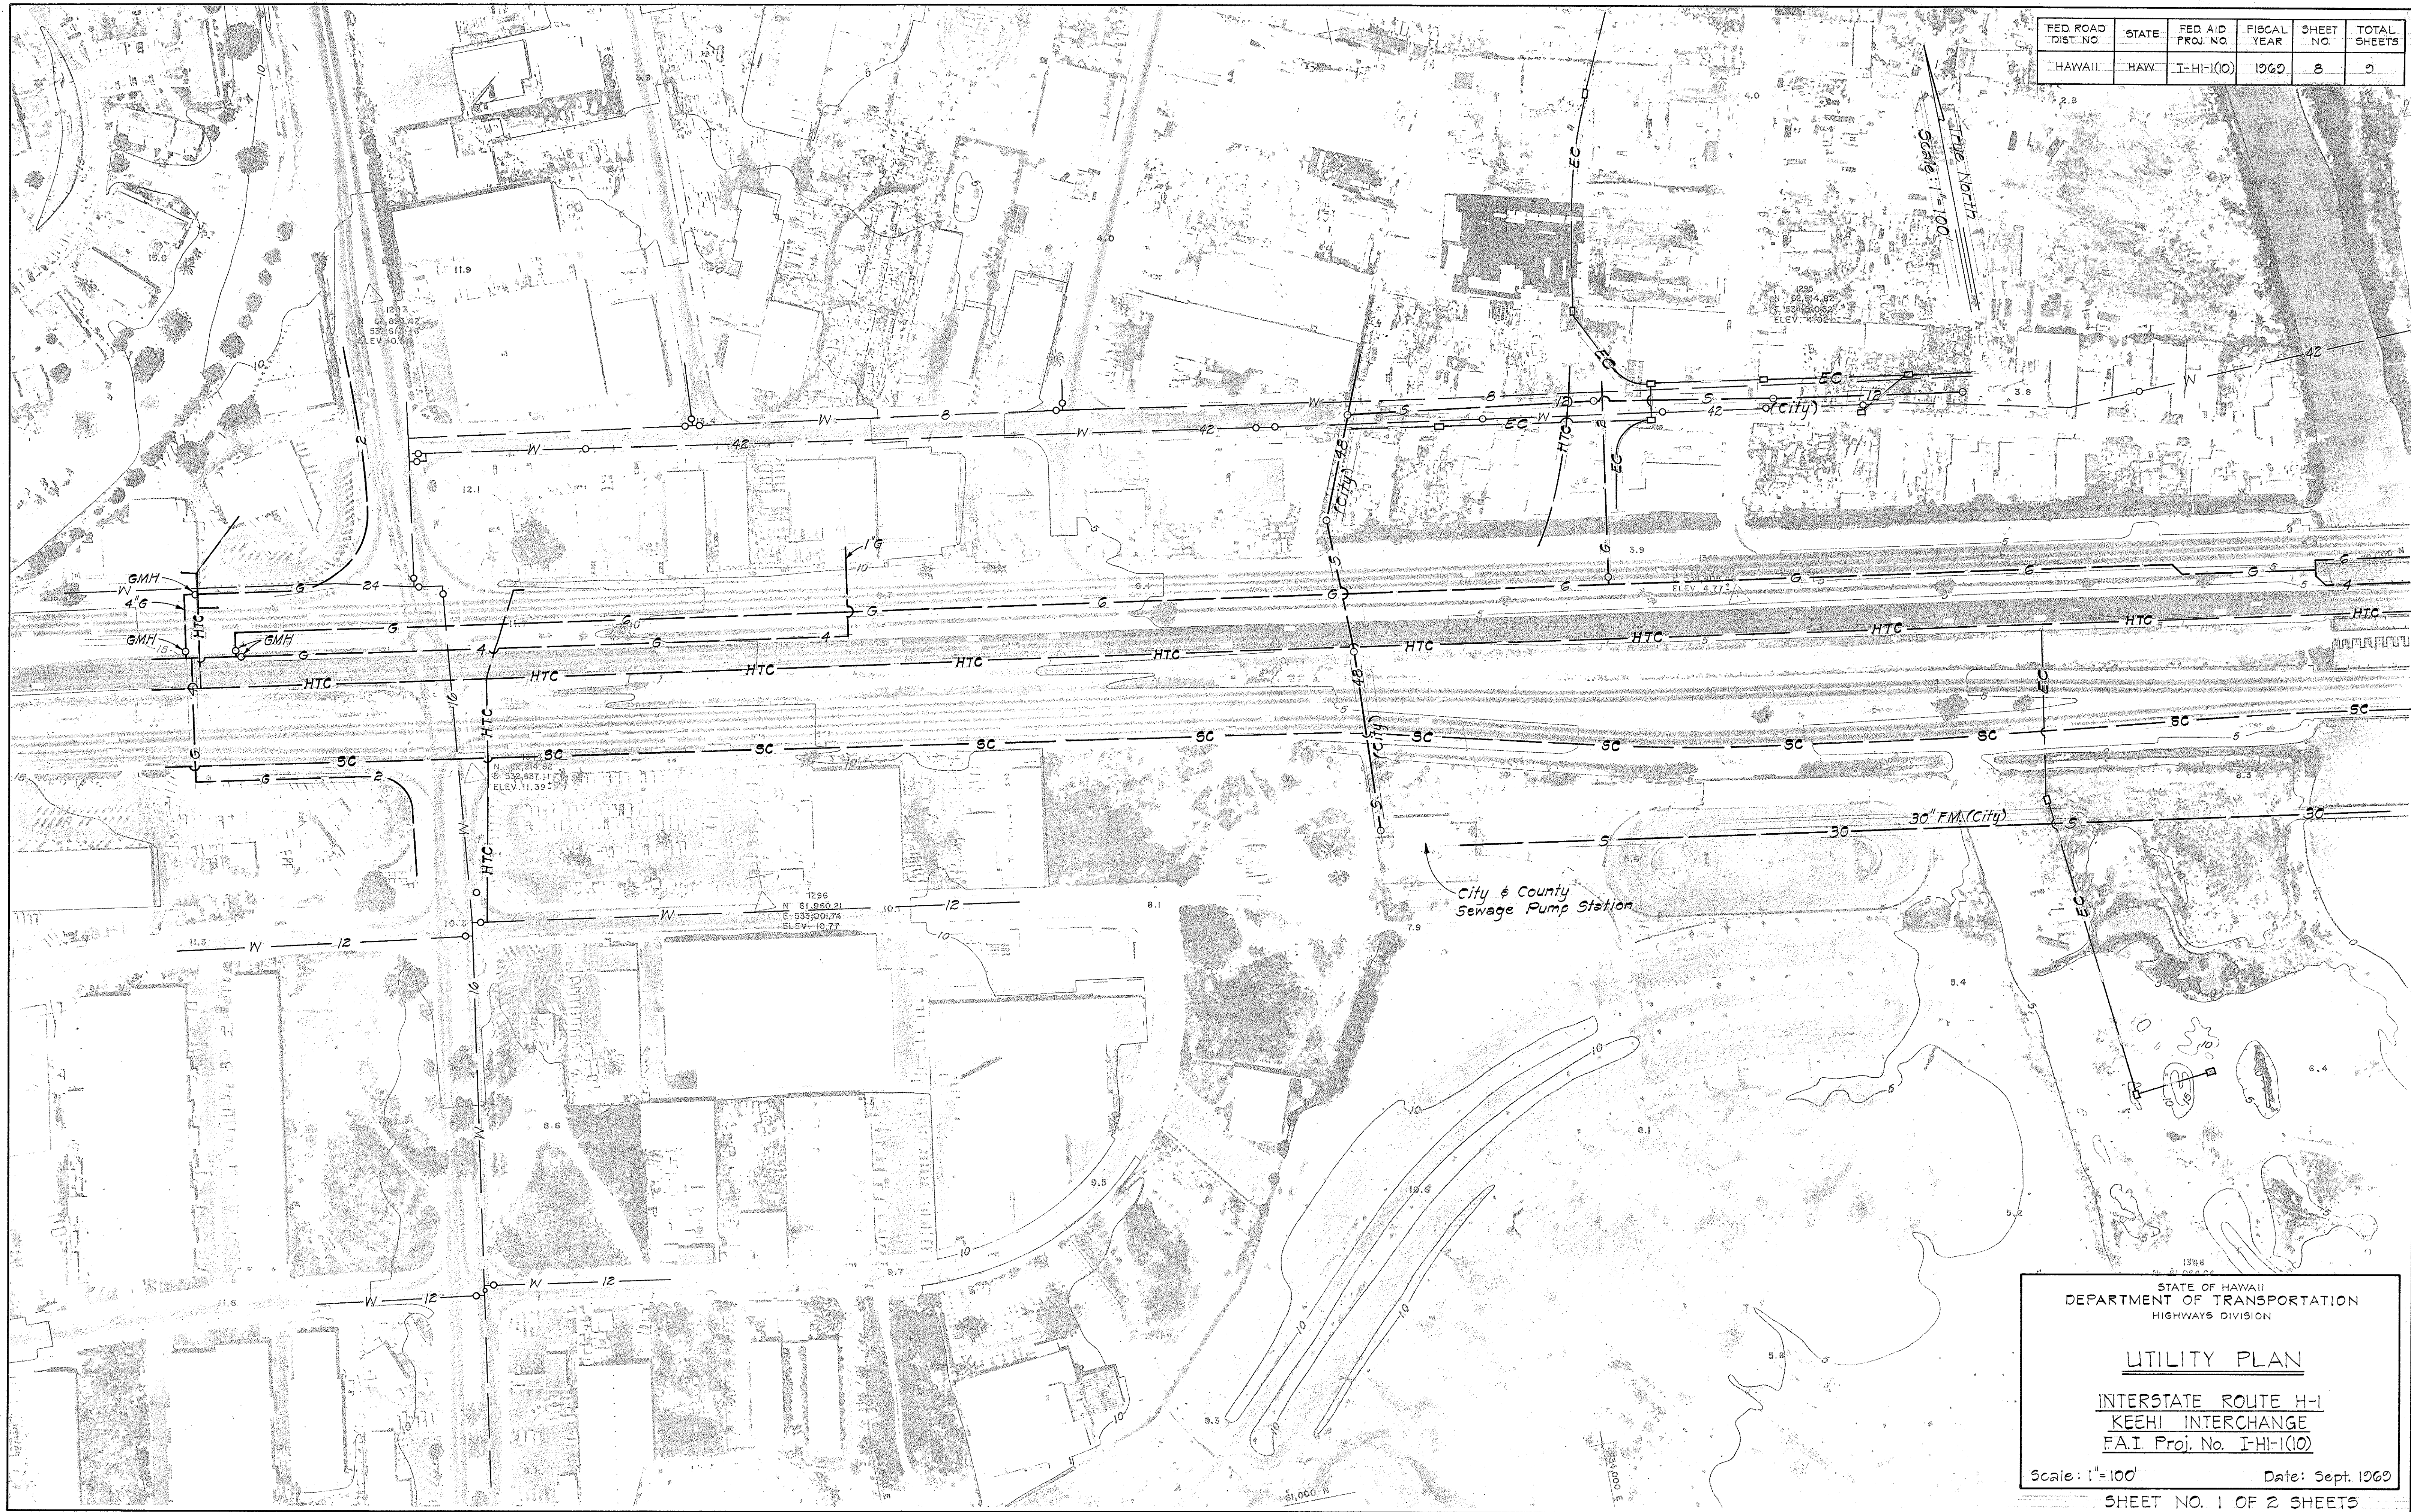

STATE OF HAWAII
DEPARTMENT OF TRANSPORTATION
HIGHWAYS DIVISION


UTILITY PLAN

INTERSTATE ROUTE H-1
KEEHI INTERCHANGE
F.A.I. Proj. No. I-HI-1(10)

Scale: 1"=100' Date: Sept. 1960

SHEET NO. 1 OF 2 SHEETS

FED. ROAD DIST. NO.	STATE	FED. AID PROJ. NO.	FISCAL YEAR	SHEET NO.	TOTAL SHEETS
HAWAII	HAW.	I-HI-1(10)	1960	2	2

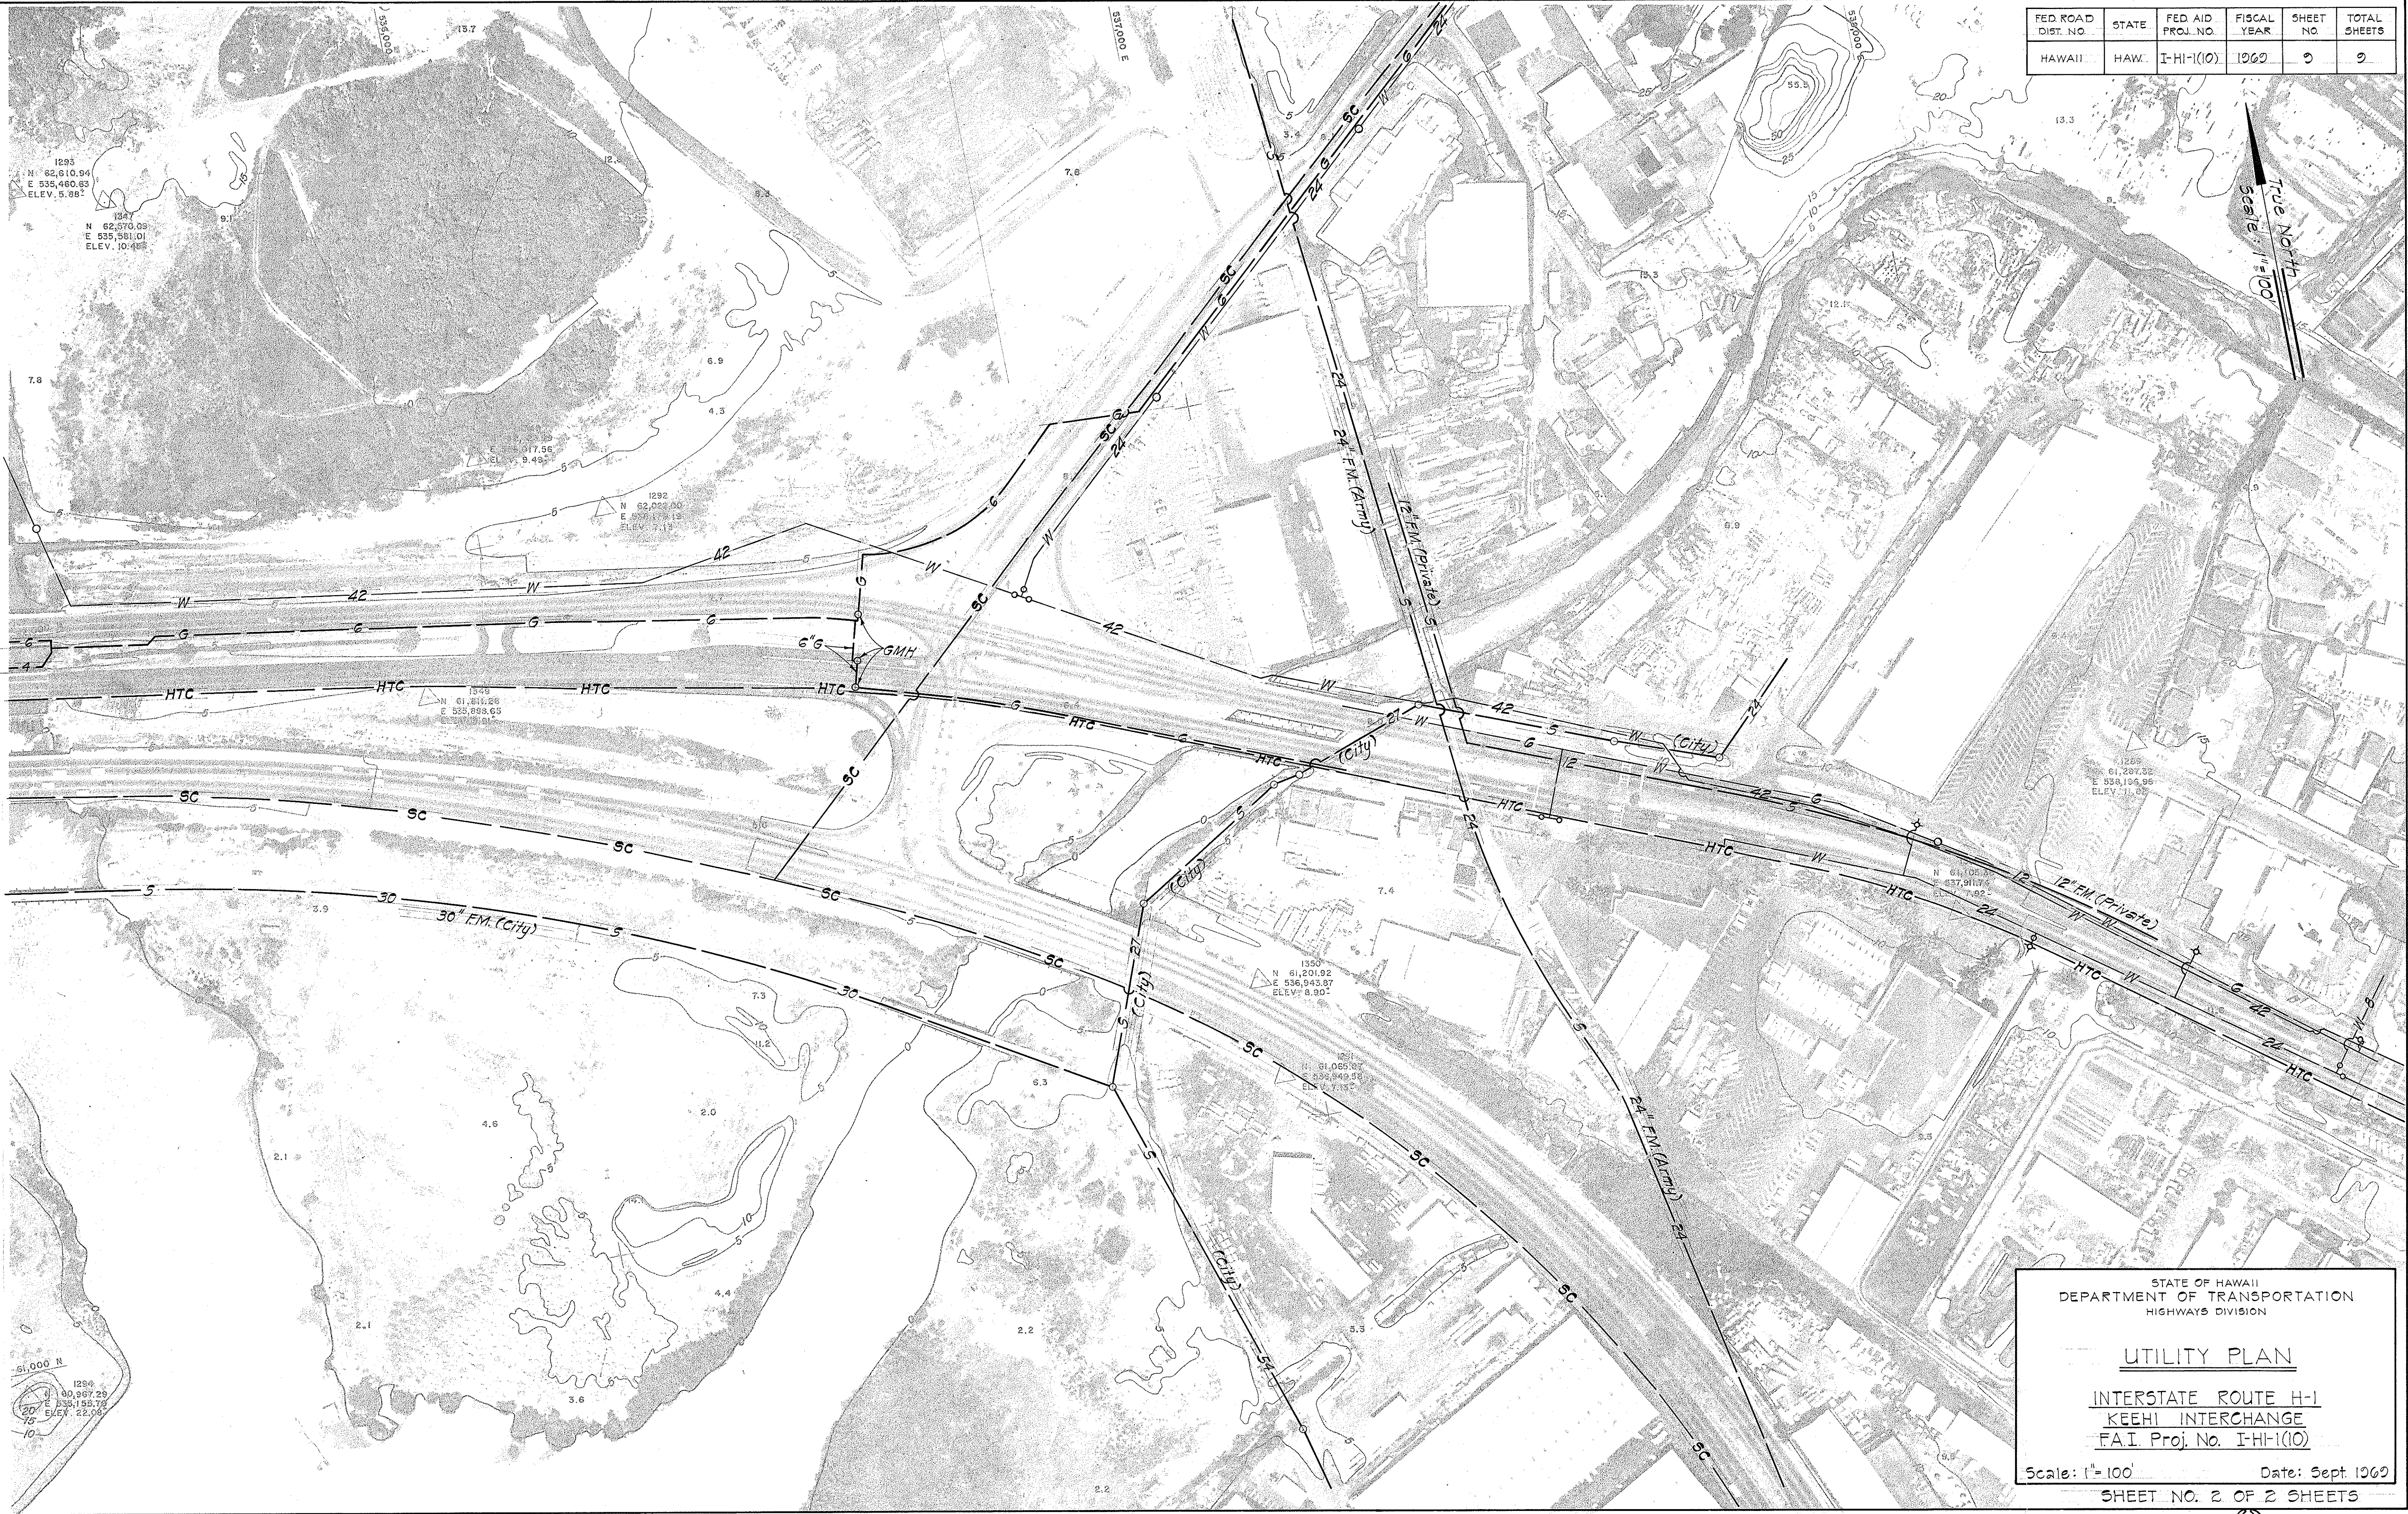

STATE OF HAWAII
DEPARTMENT OF TRANSPORTATION
HIGHWAYS DIVISION

UTILITY PLAN
INTERSTATE ROUTE H-1
KEEHI INTERCHANGE
F.A.I. Proj. No. I-HI-1(10)

Scale: 1"=100'
Date: Sept. 1960

SHEET NO. 2 OF 2 SHEETS