




FED. ROAD DIST. NO.	STATE	FED. AID PROJ. NO.	FISCAL YEAR	SHEET NO.	TOTAL SHEETS

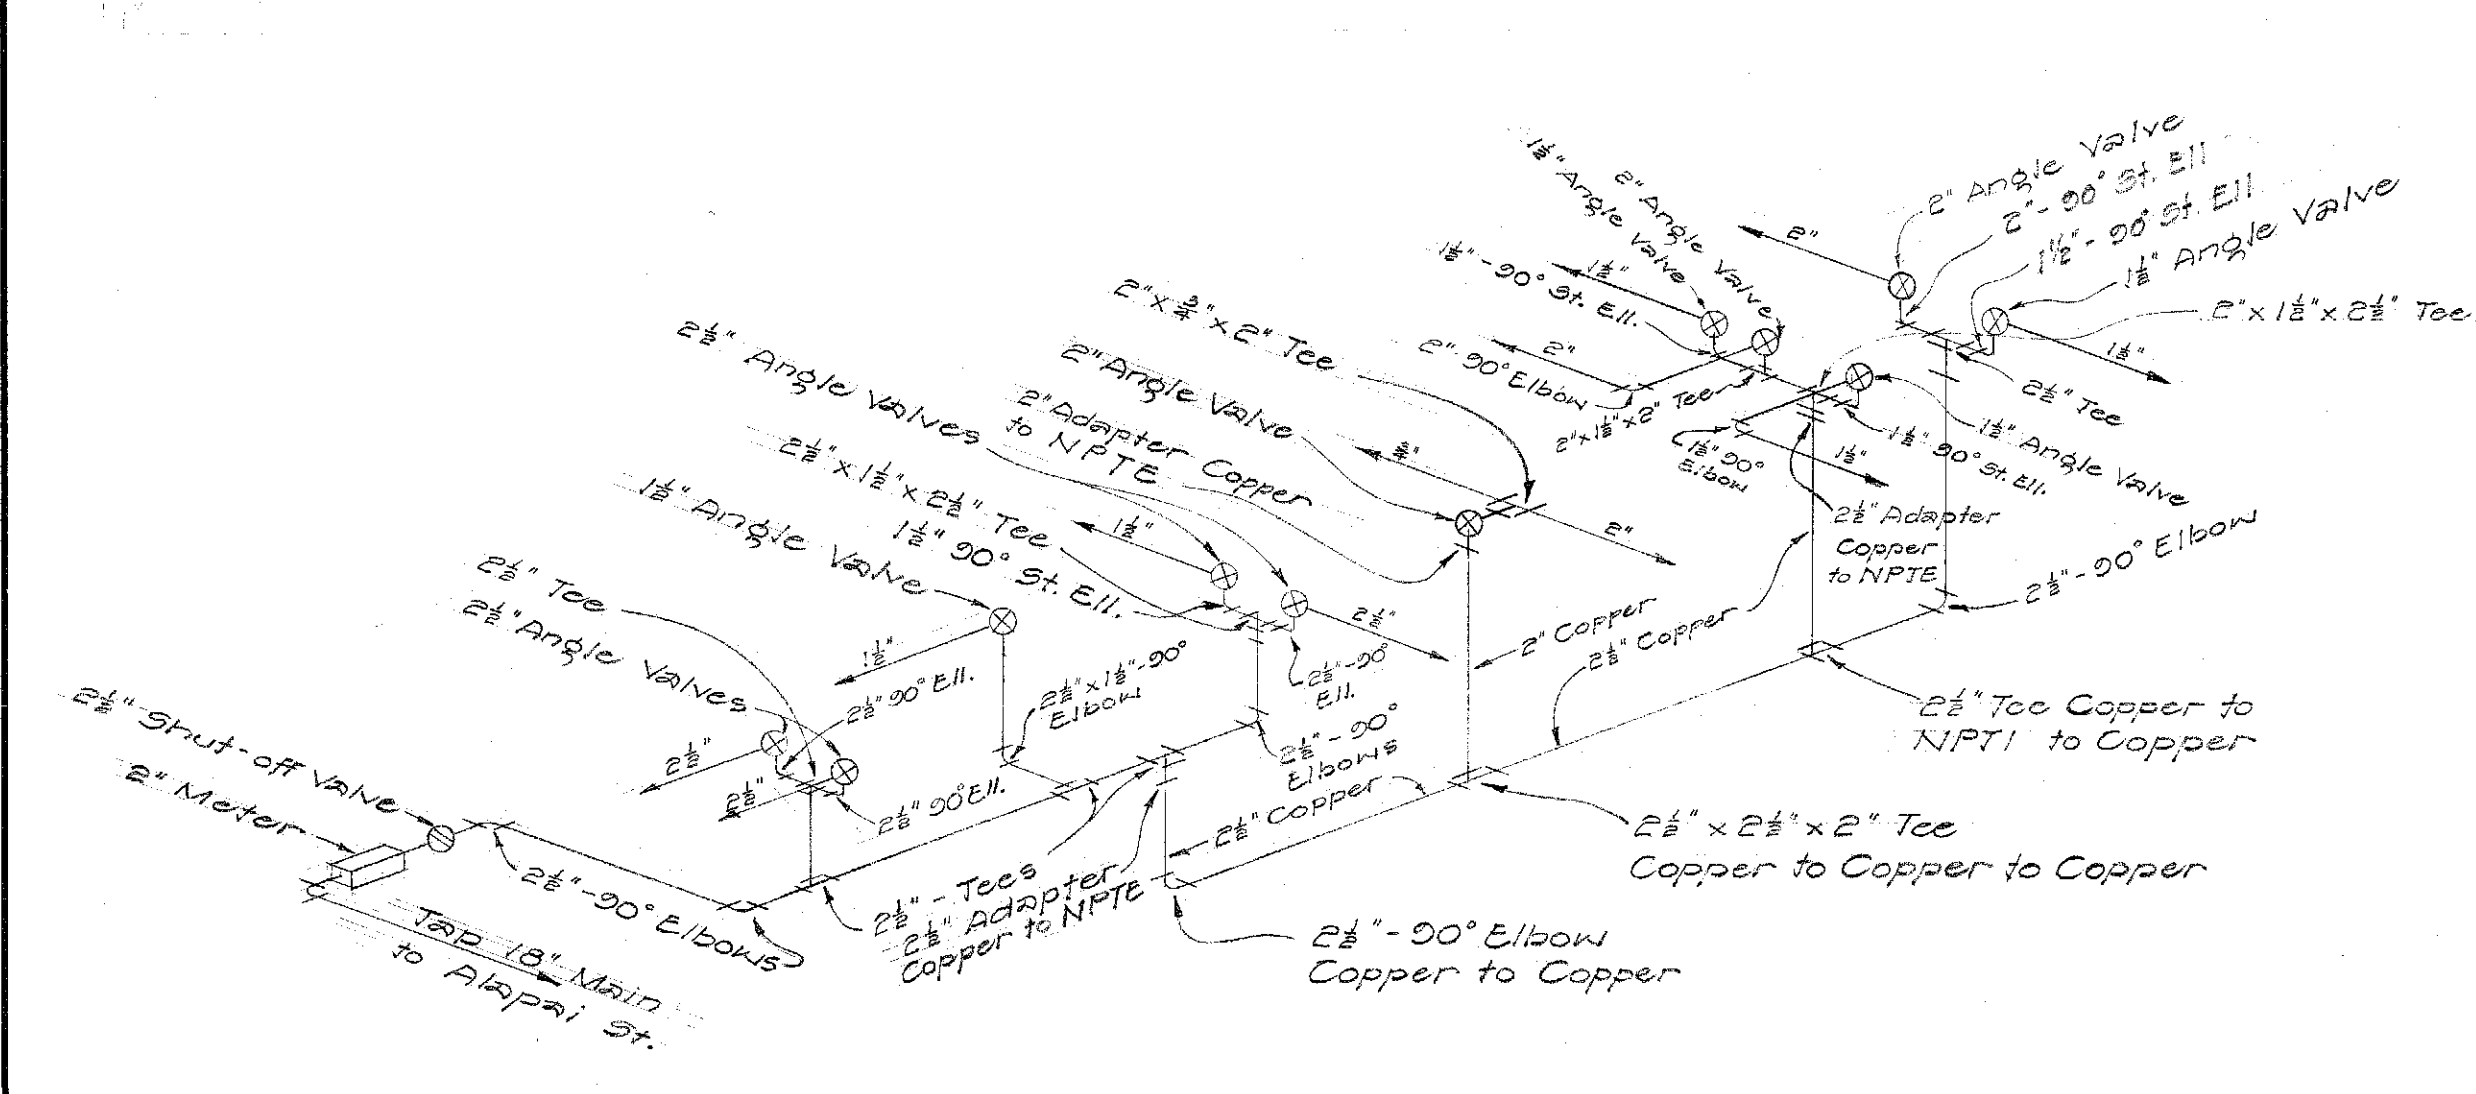

DETAIL 3-A

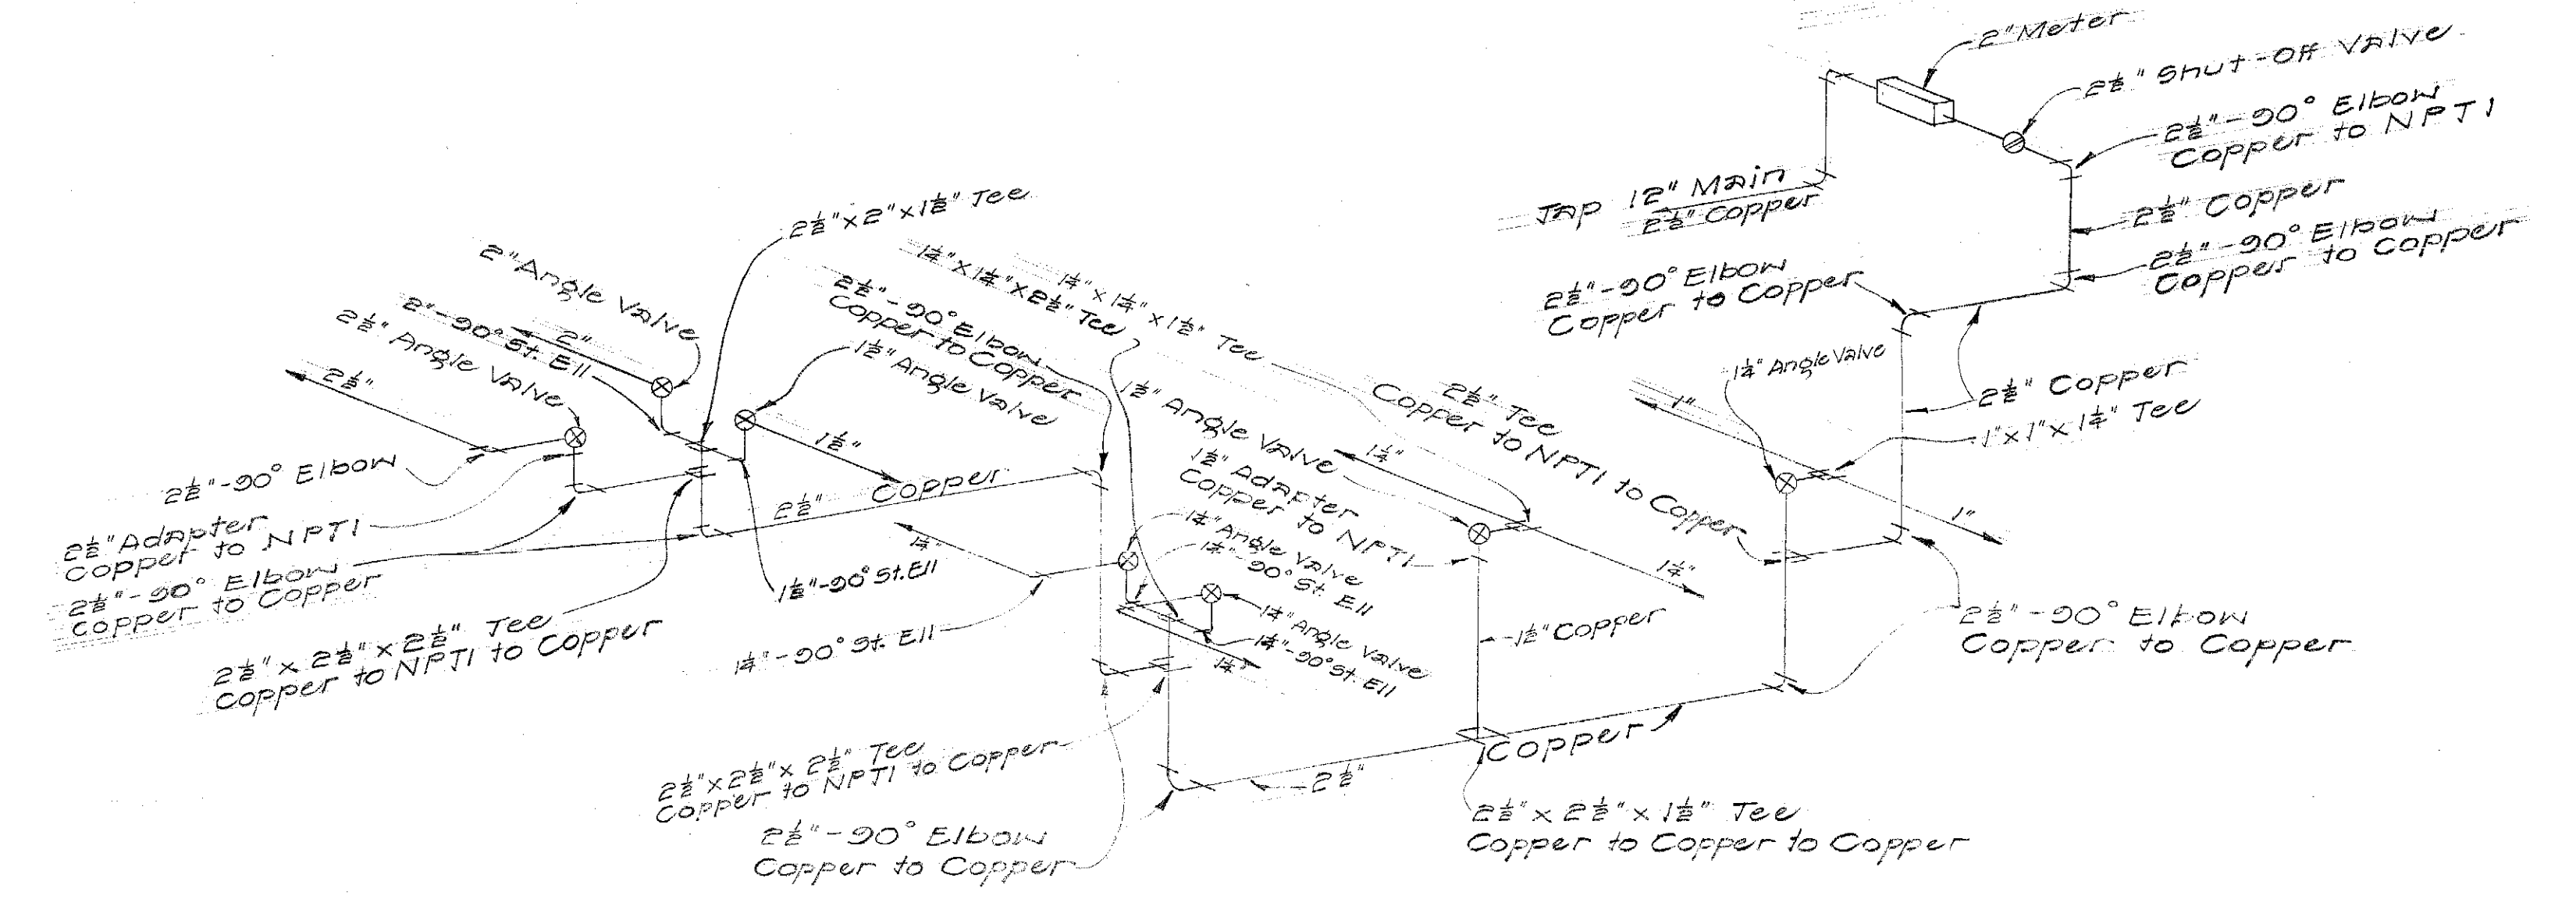

DETAIL 4-B

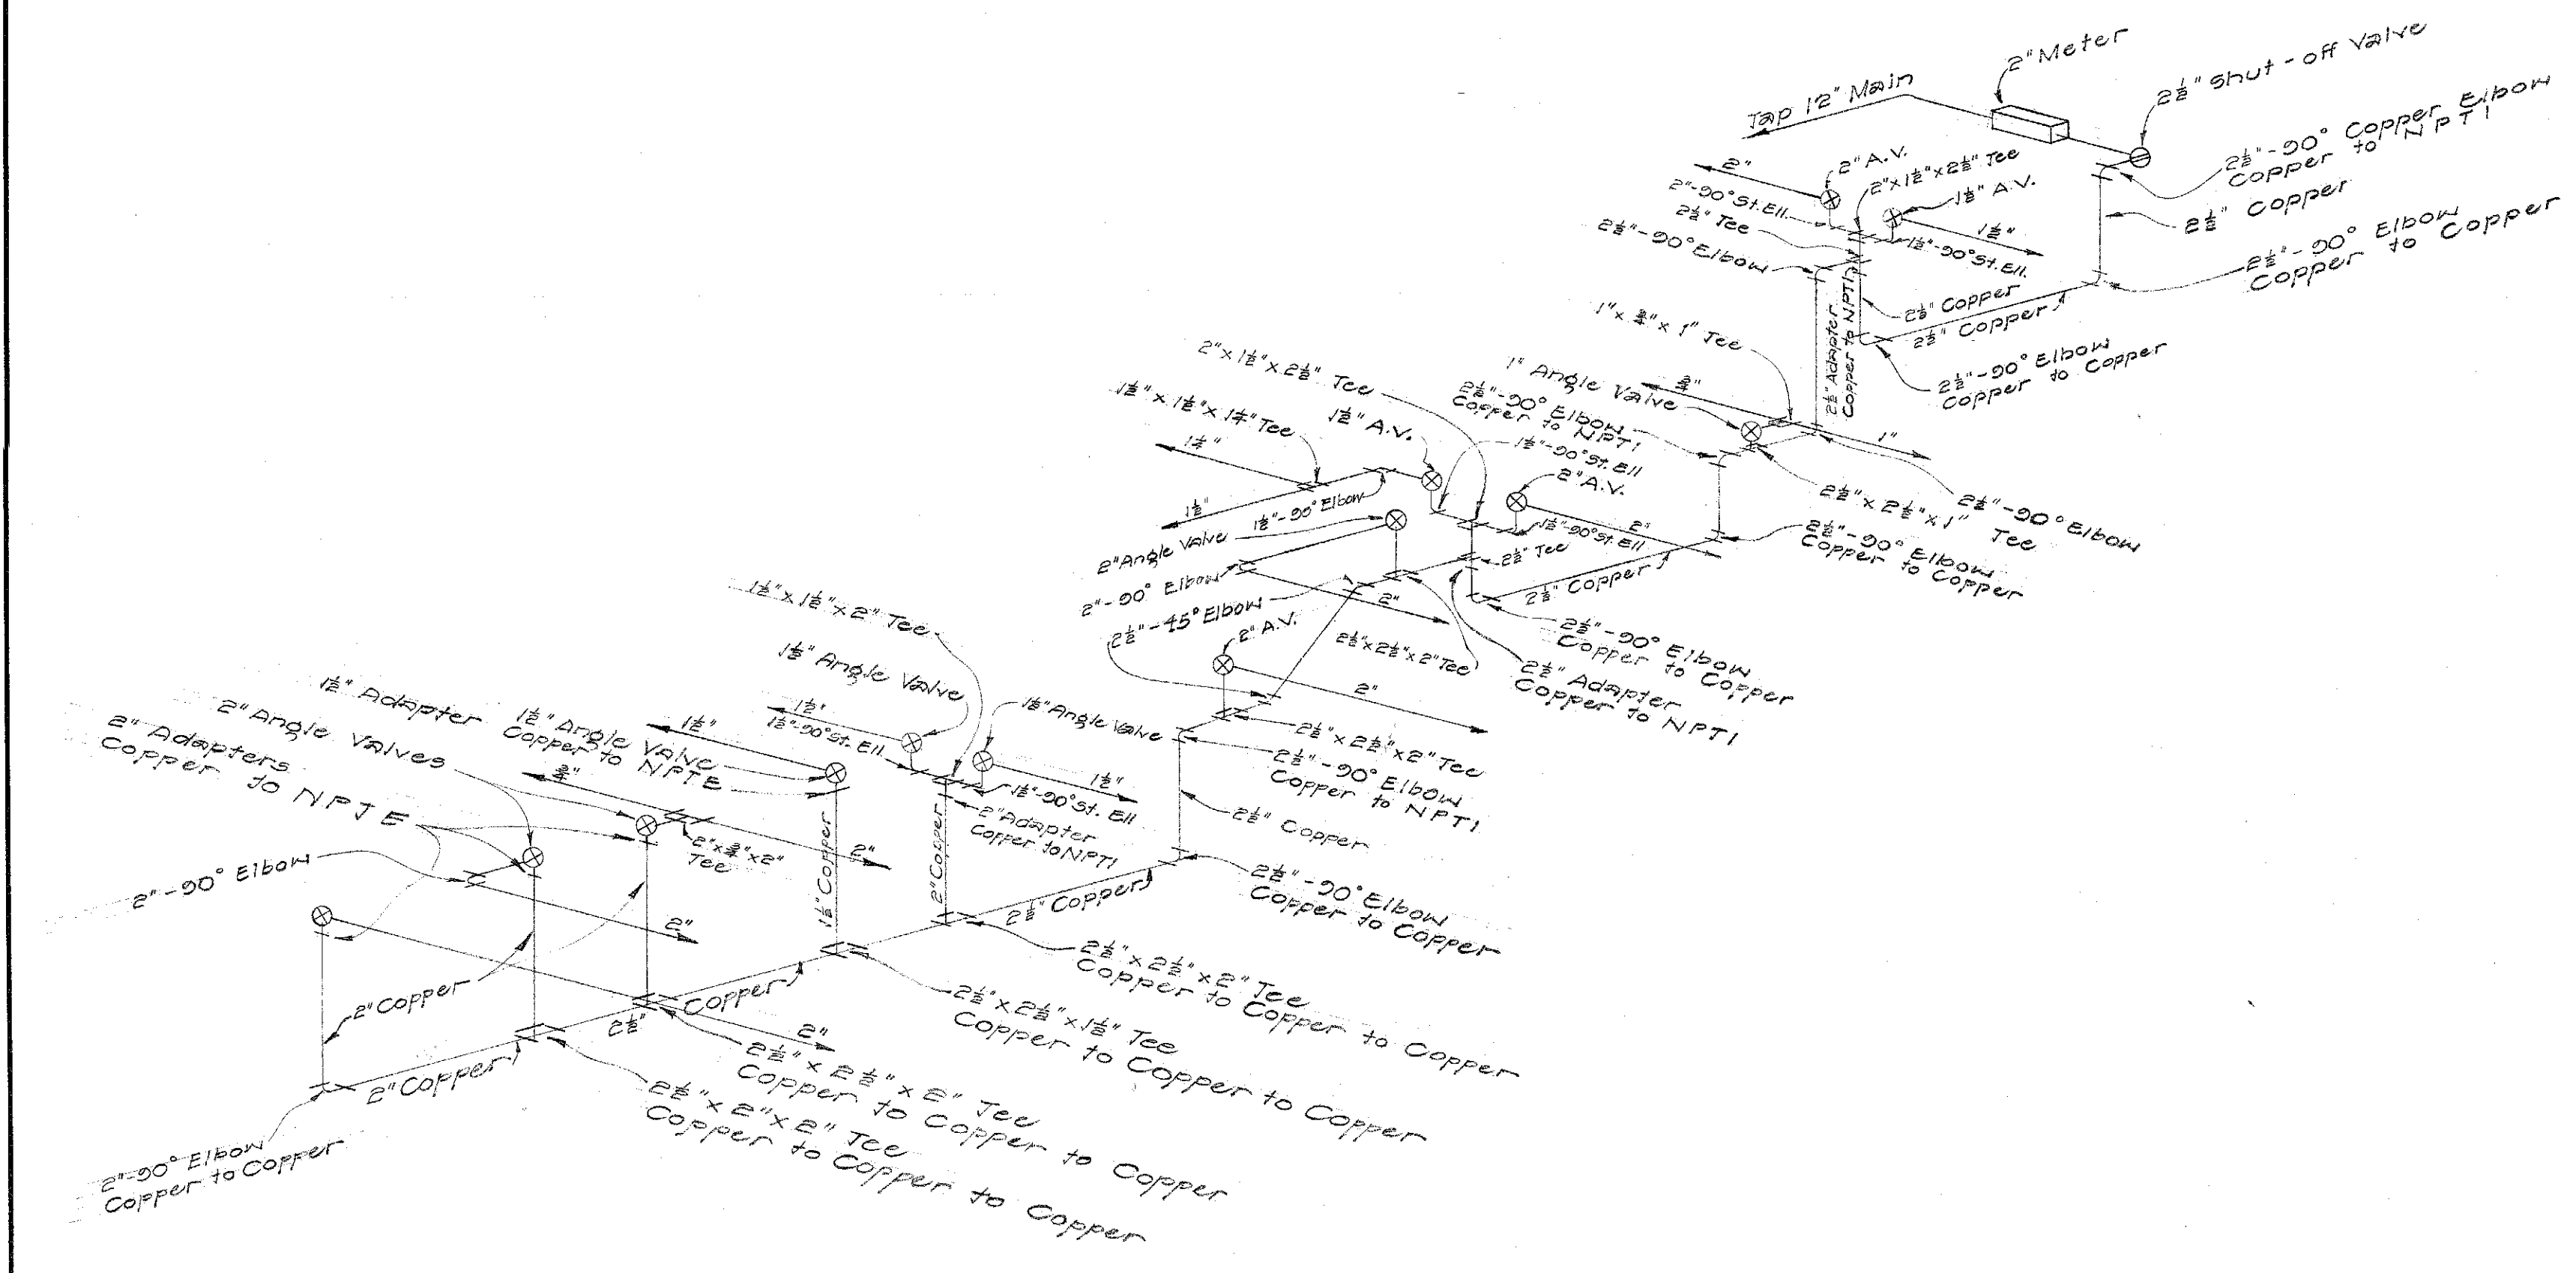

DETAIL 4-A

TERRITORIAL HIGHWAY DEPARTMENT
TERRITORY OF HAWAII

SHEET NO. 12 OF 12 SHEETS

5927

DATE	
SURVEY PLANNED BY	
DESIGNED BY	
DRAWN BY	
CHECKED BY	
NOTED BY	
ORIGINAL PLAN	
NOTE BOOK	
No.	