


FED. ROAD DIST. NO.	STATE	FED. AID PROJ. NO.	FISCAL YEAR	SHEET NO.	TOTAL SHEETS
HAWAII	HAWAII	BU-07B(4)			

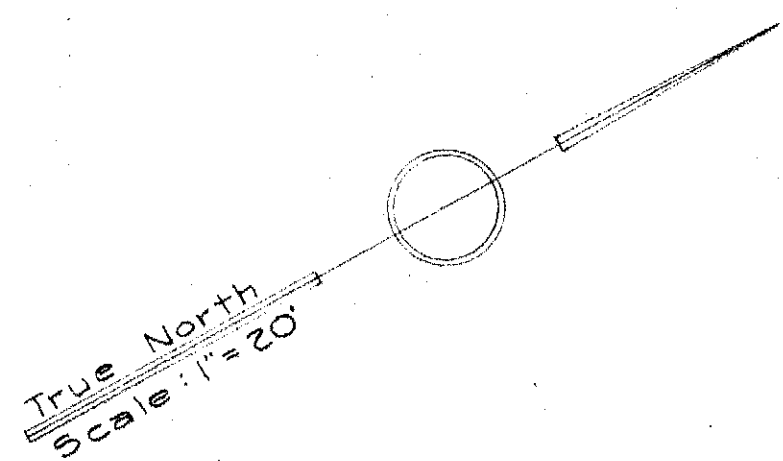

KINAI ST

MALCOLM ST

KEEAUMOKU ST

MATCH LINE

MAIN PARK

TERRITORIAL HIGHWAY DEPARTMENT
TERRITORY OF HAWAII
SPRINKLER SYSTEM
LUNALILO FREEWAY
PELE ST. TO KEEAUMOKU ST.
PROJECT NO. BU-07B(4)

Scale: As Noted

SHEET No. 12 OF 15 SHEETS


5927.



SPRINKLER SYSTEM
REDACTED

DESIGNED BY	DATE
DRAWN BY	
CHECKED BY	
NOTED BY	
QUANTITIES BY	
CHECKED BY	
NO.	

FED. ROAD DIST. NO.	STATE	FED. AID PROJ. NO.	FISCAL YEAR	SHEET NO.	TOTAL SHEETS
HAWAII	HAWAII	BU-072-14			

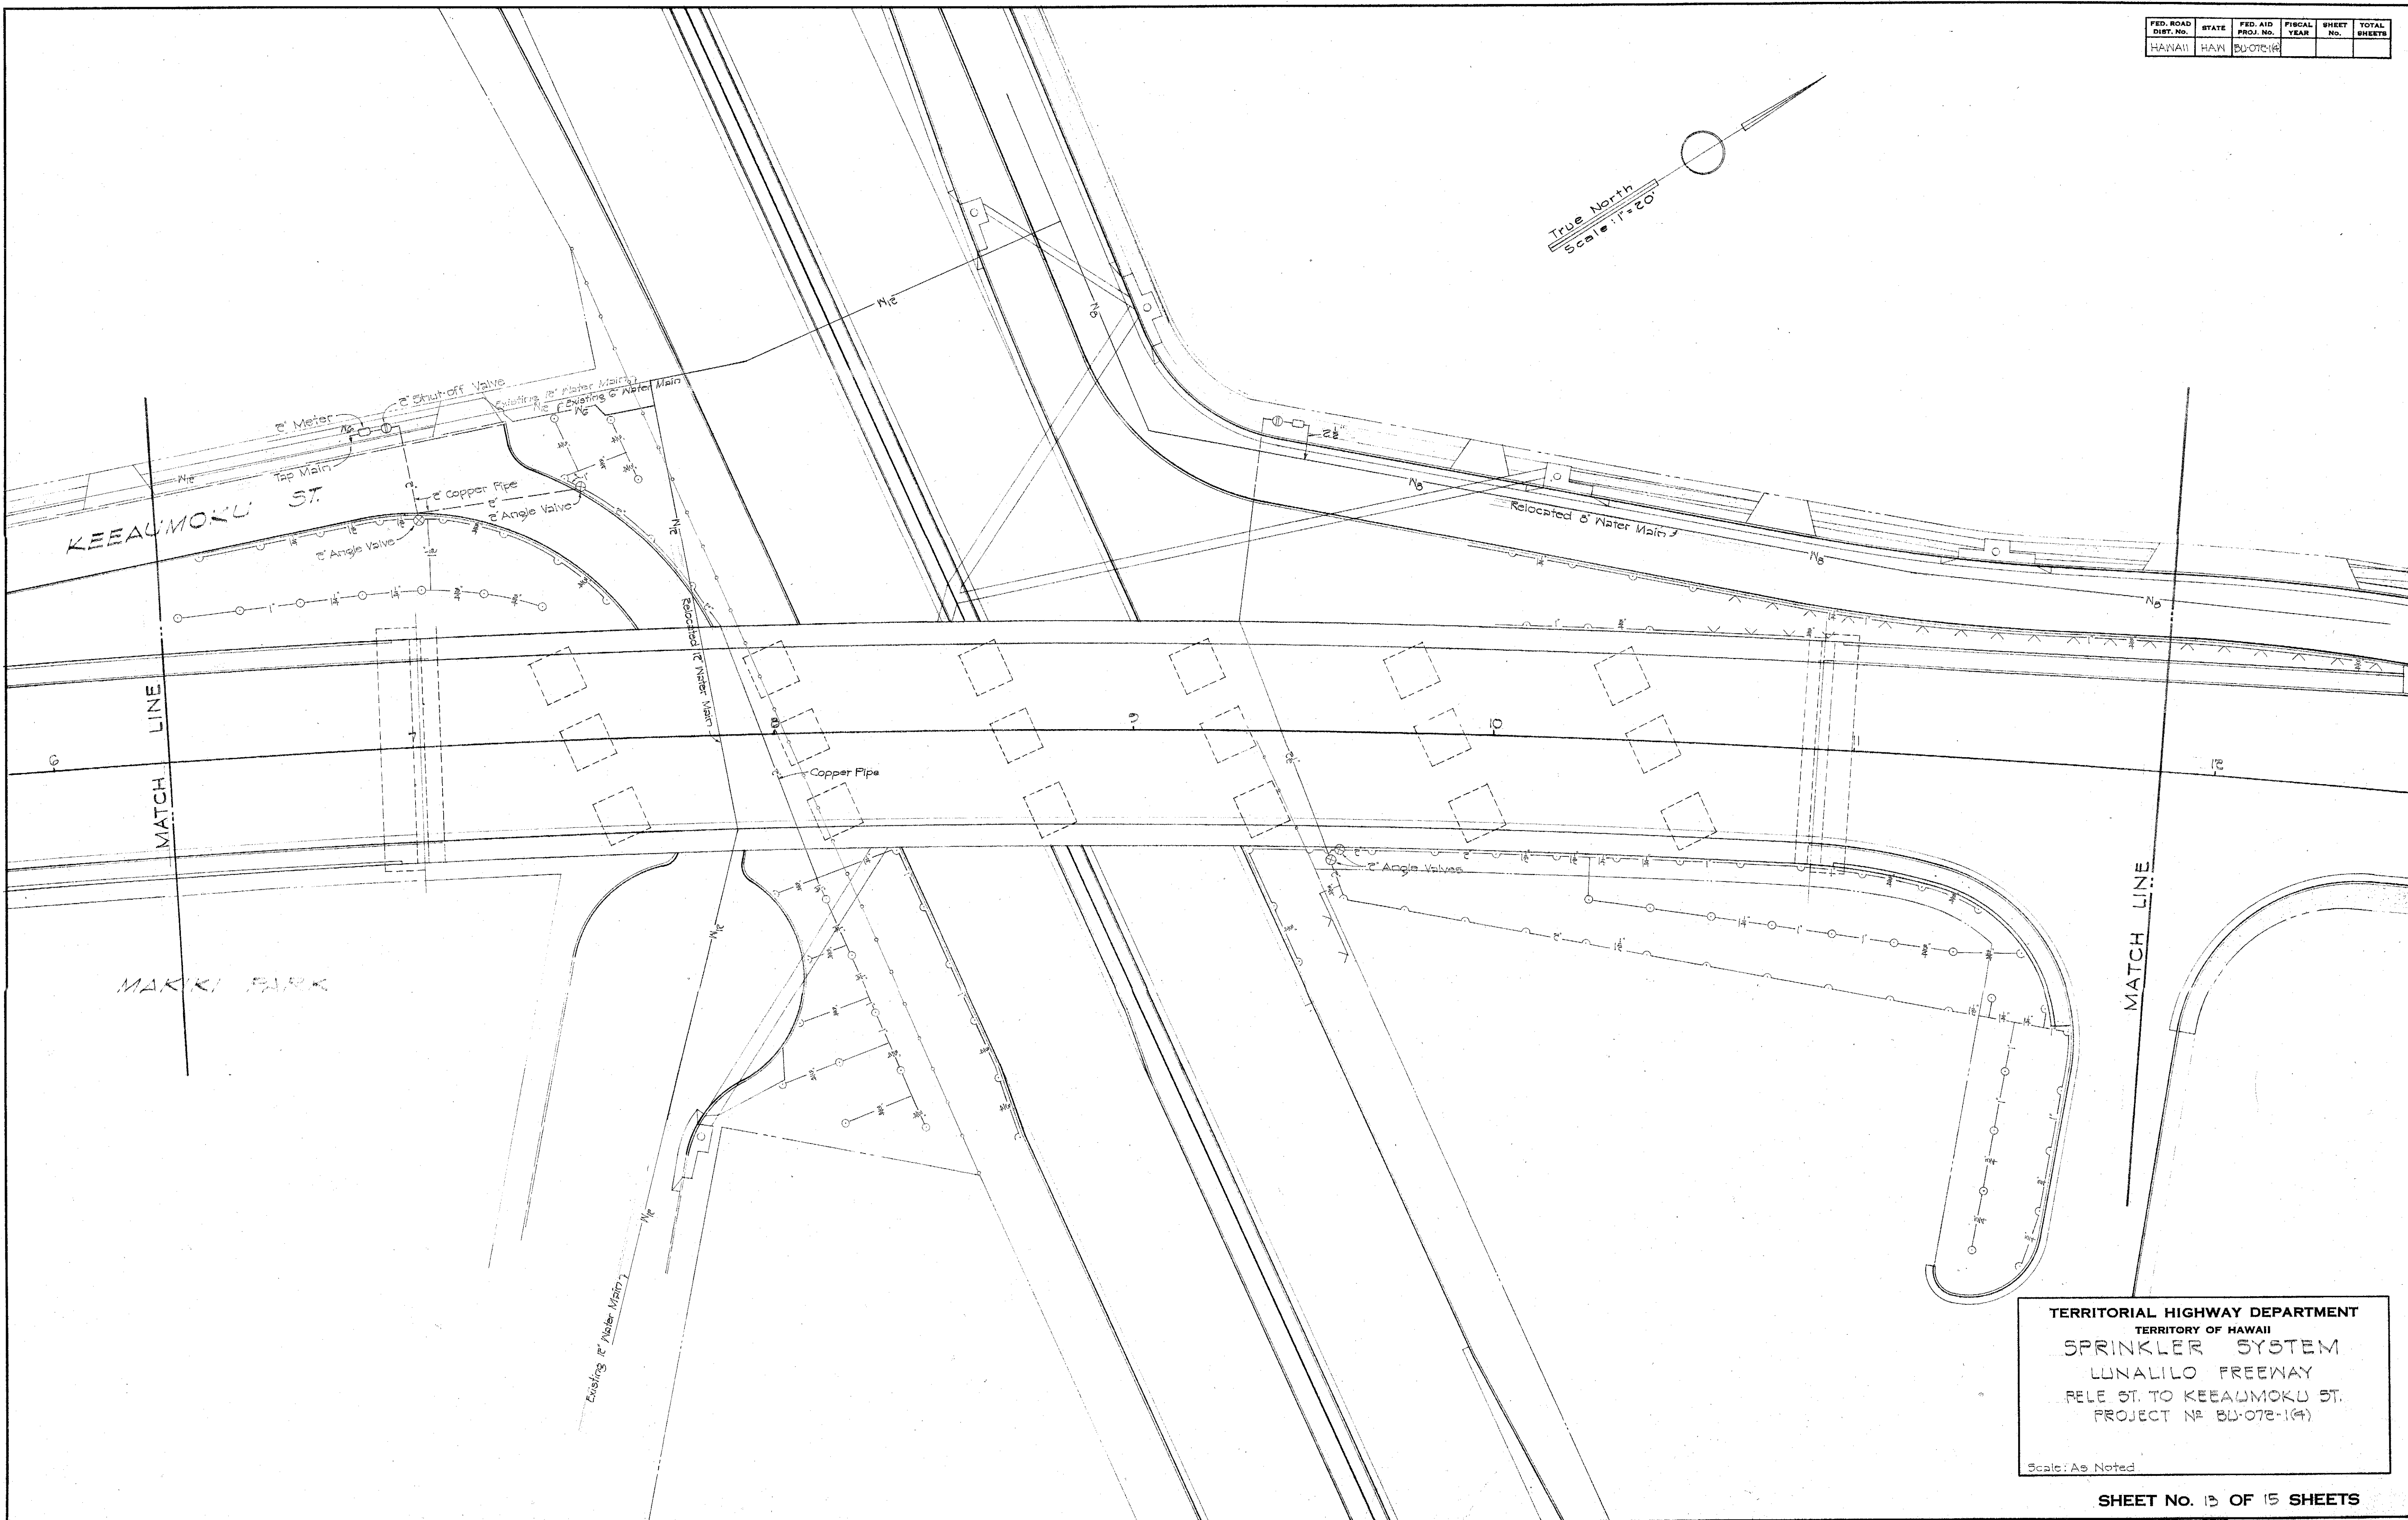



ORIGINAL PLAN	SURVEYED BY	DATE
NO. 1	_____	_____
NO. 2	_____	_____
NO. 3	_____	_____
NO. 4	_____	_____
NO. 5	_____	_____
NO. 6	_____	_____
NO. 7	_____	_____
NO. 8	_____	_____
NO. 9	_____	_____
NO. 10	_____	_____

TERRITORIAL HIGHWAY DEPARTMENT
 TERRITORY OF HAWAII
SPRINKLER SYSTEM
 LUNALILO FREEWAY
 RELE ST. TO KEEPAUMOKU ST.
 PROJECT NO. BU-072-14
 Scale: As Noted

SHEET NO. 13 OF 15 SHEETS

5927.

FED. ROAD DIST. No.	STATE	FED. AID PROJ. No.	FISCAL YEAR	SHEET No.	TOTAL SHEETS
HAWAII	HAW.	BU-078-16			

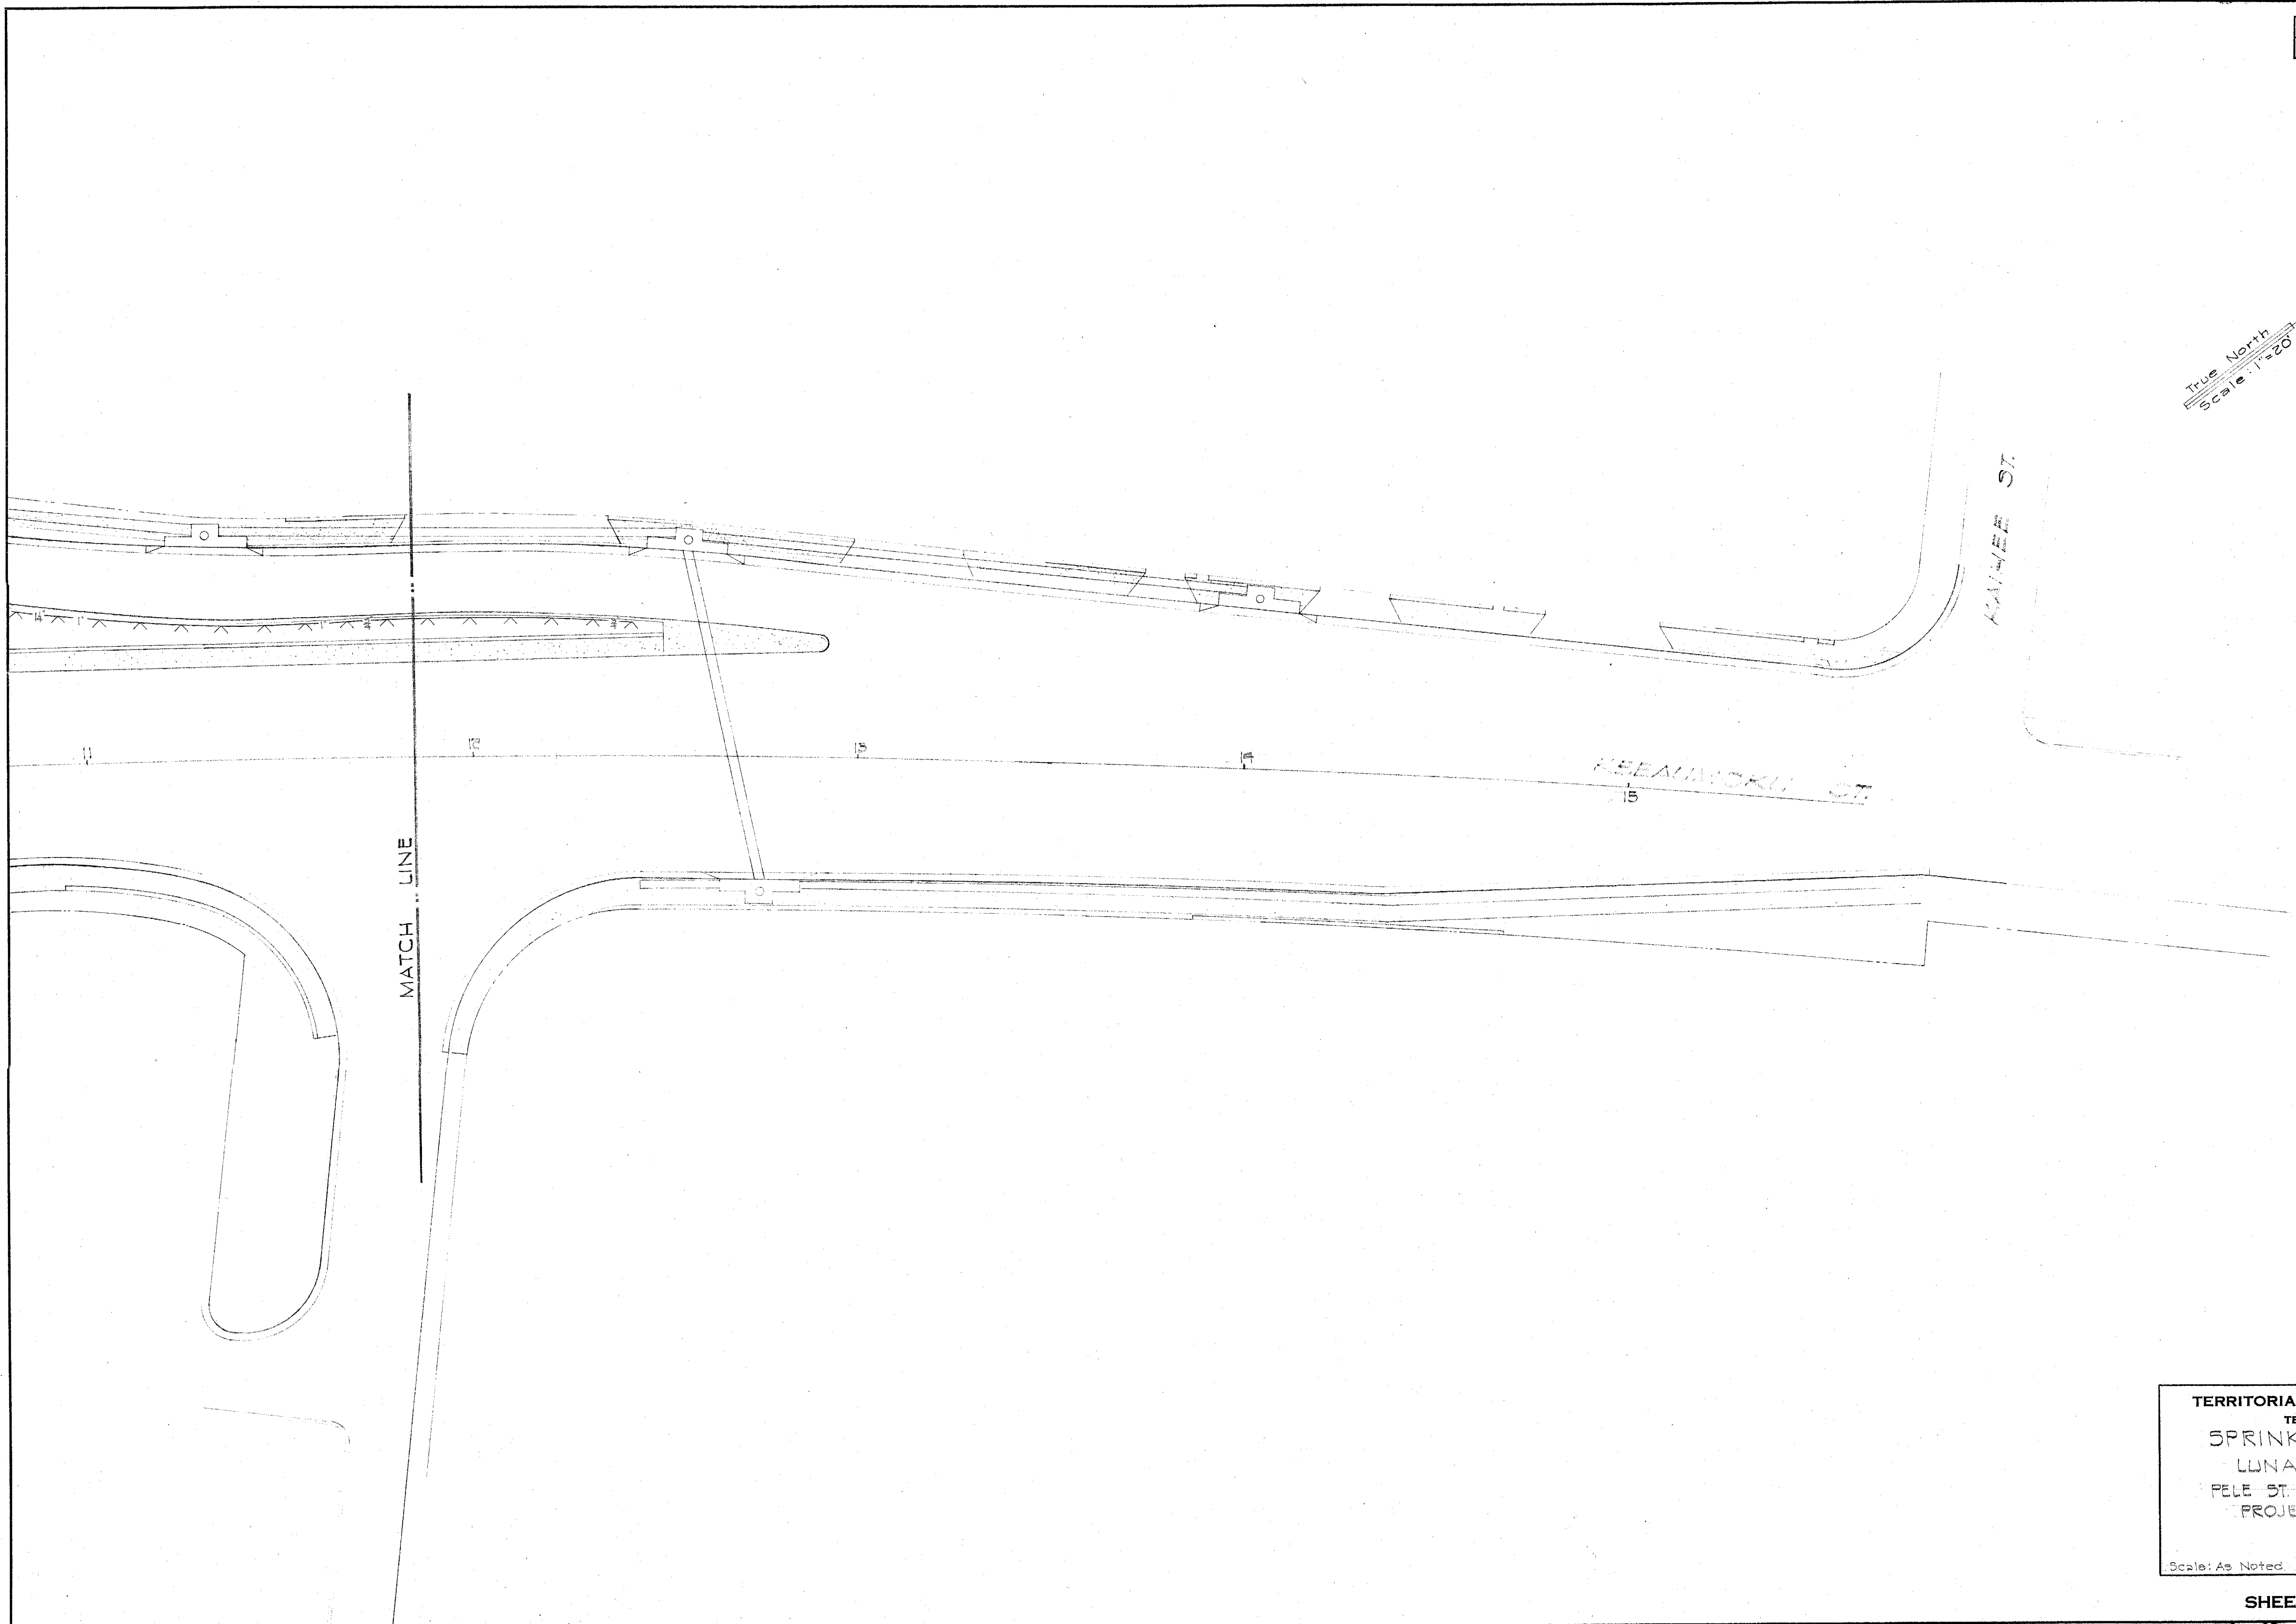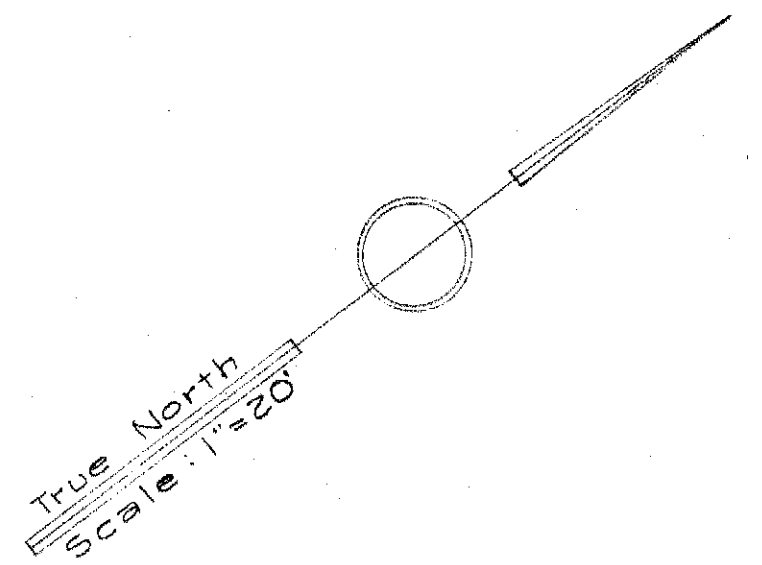

ORIGINAL	SURVEY PLOTTED BY	DATE
PLAN	DESIGNED BY	"
	DRAWN BY	"
	TRACED BY	"
NOTE BOOK	QUANTITIES BY	"
No.	QUANTITIES CHECKED BY	"
	CHECKED BY	"

TERRITORIAL HIGHWAY DEPARTMENT
TERRITORY OF HAWAII
SPRINKLER SYSTEM
LUNALILO FREEWAY
PELE ST. TO KEEAUMOKU ST.
PROJECT NO. BU-072-1(4)

Scale: As Noted.

SHEET NO. 14 OF 15 SHEETS

5927. (24)

④