




FED. ROAD DIST. NO.	STATE	FED. AID PROJ. NO.	FISCAL YEAR	SHEET NO.	TOTAL SHEETS
HAWAII	HAWAII	BU-078-14A		6	6

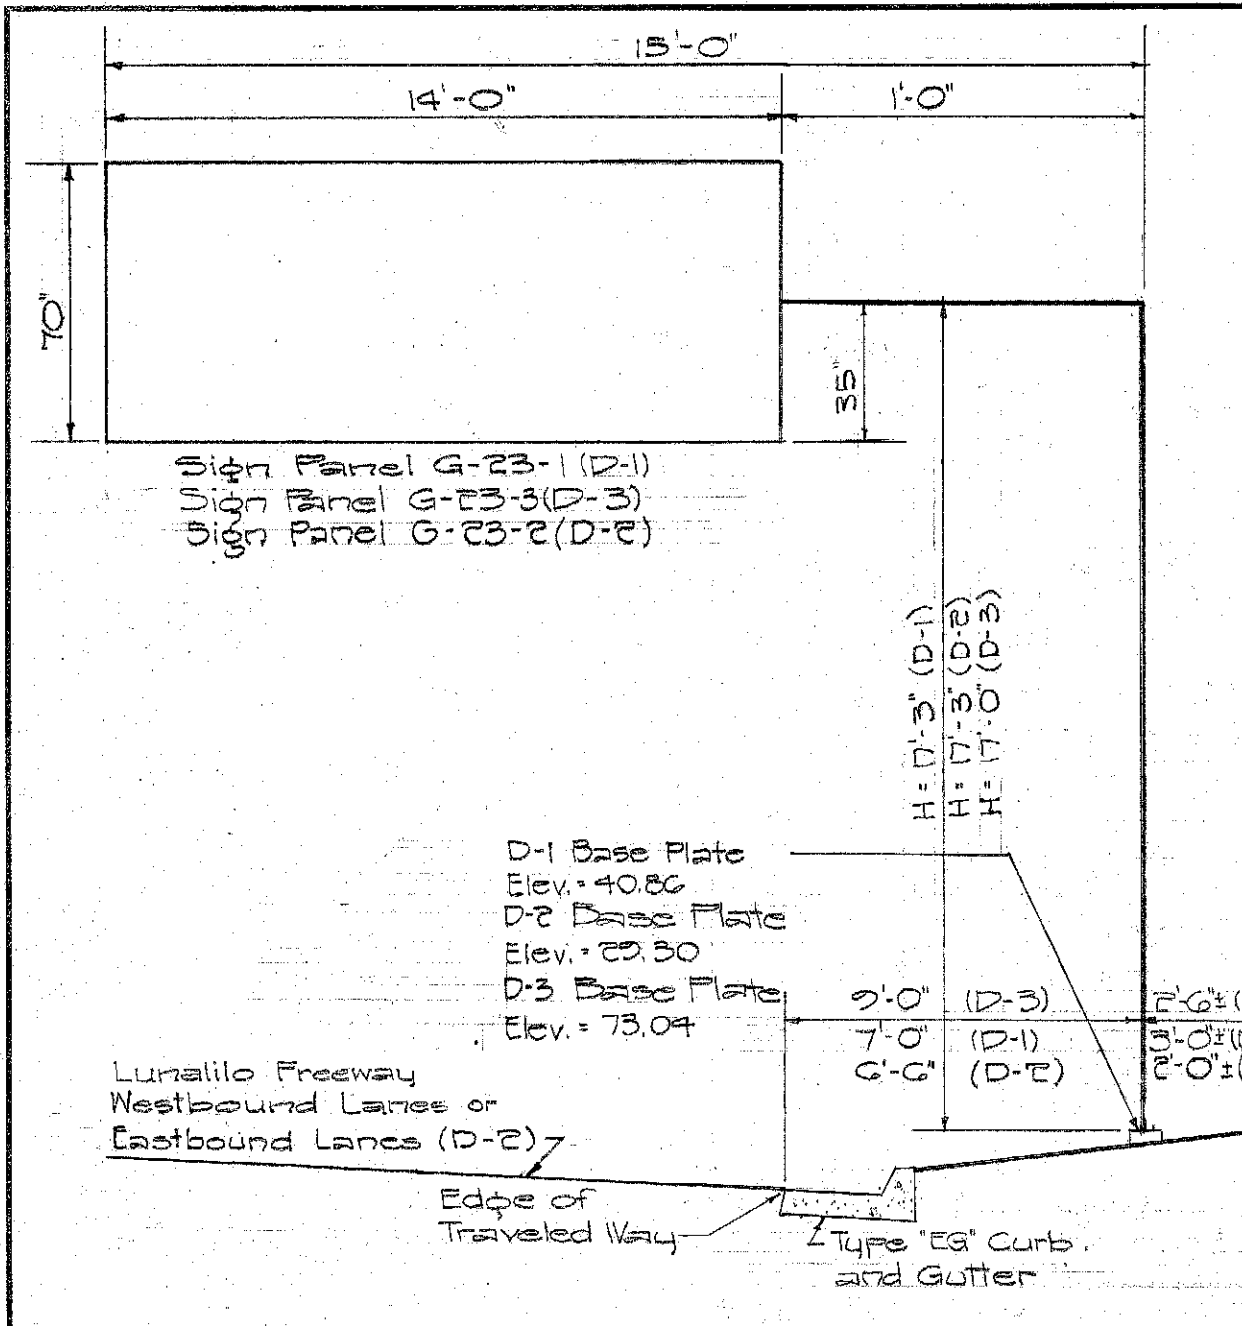


SIGN D-1, D-2 & D-3

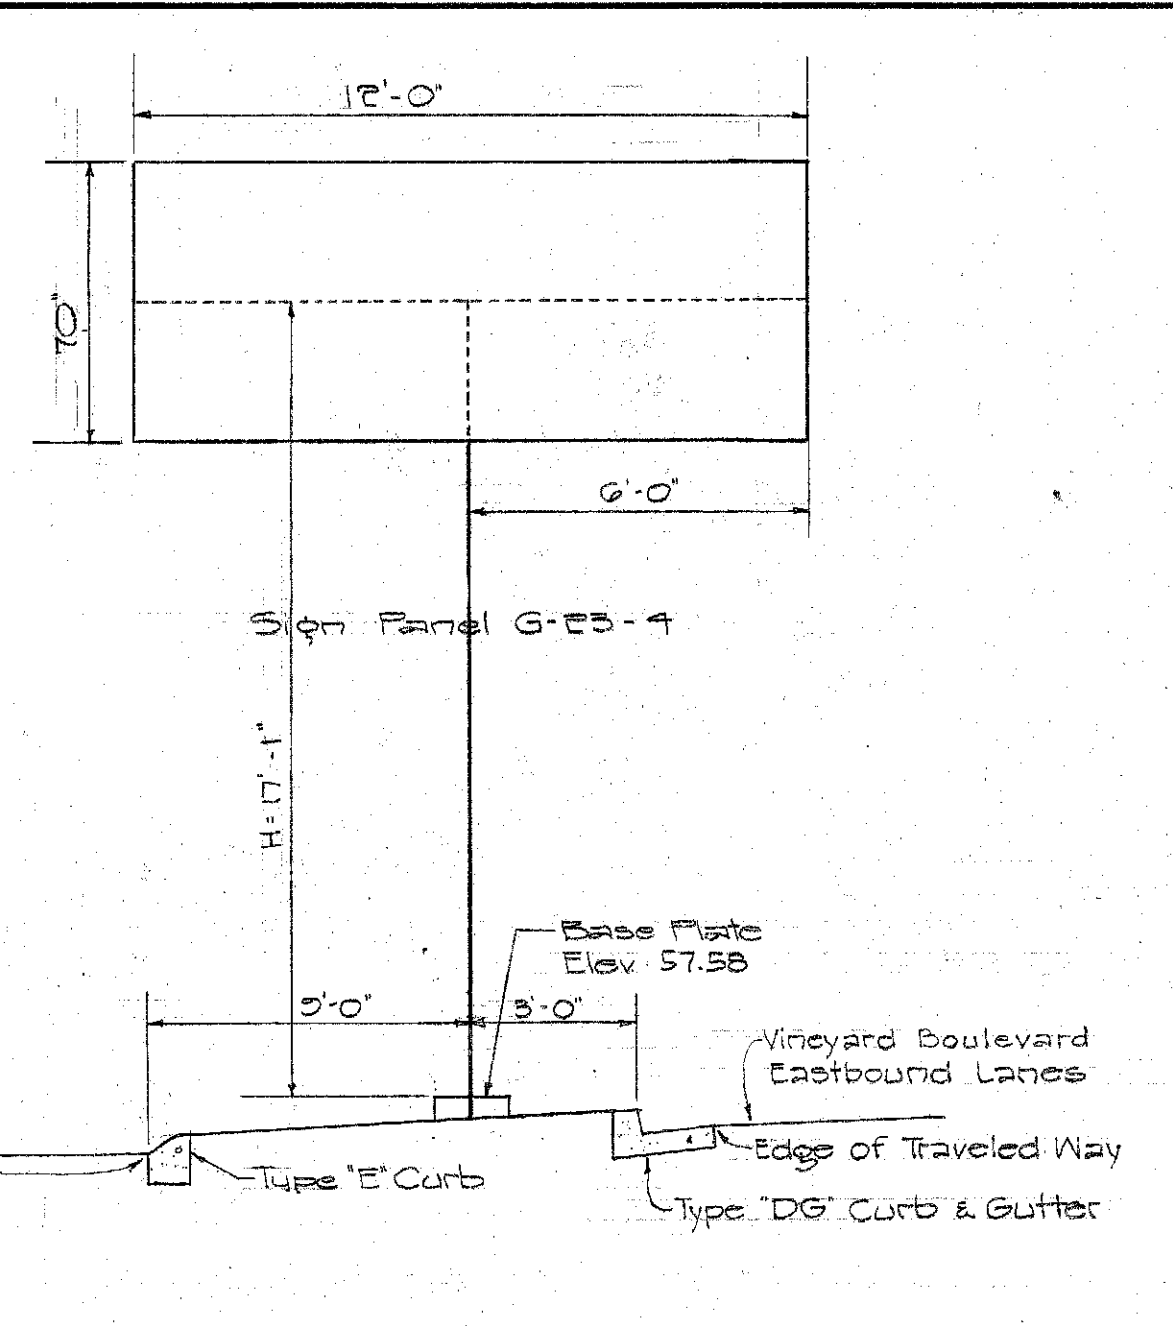

SIGN D-4

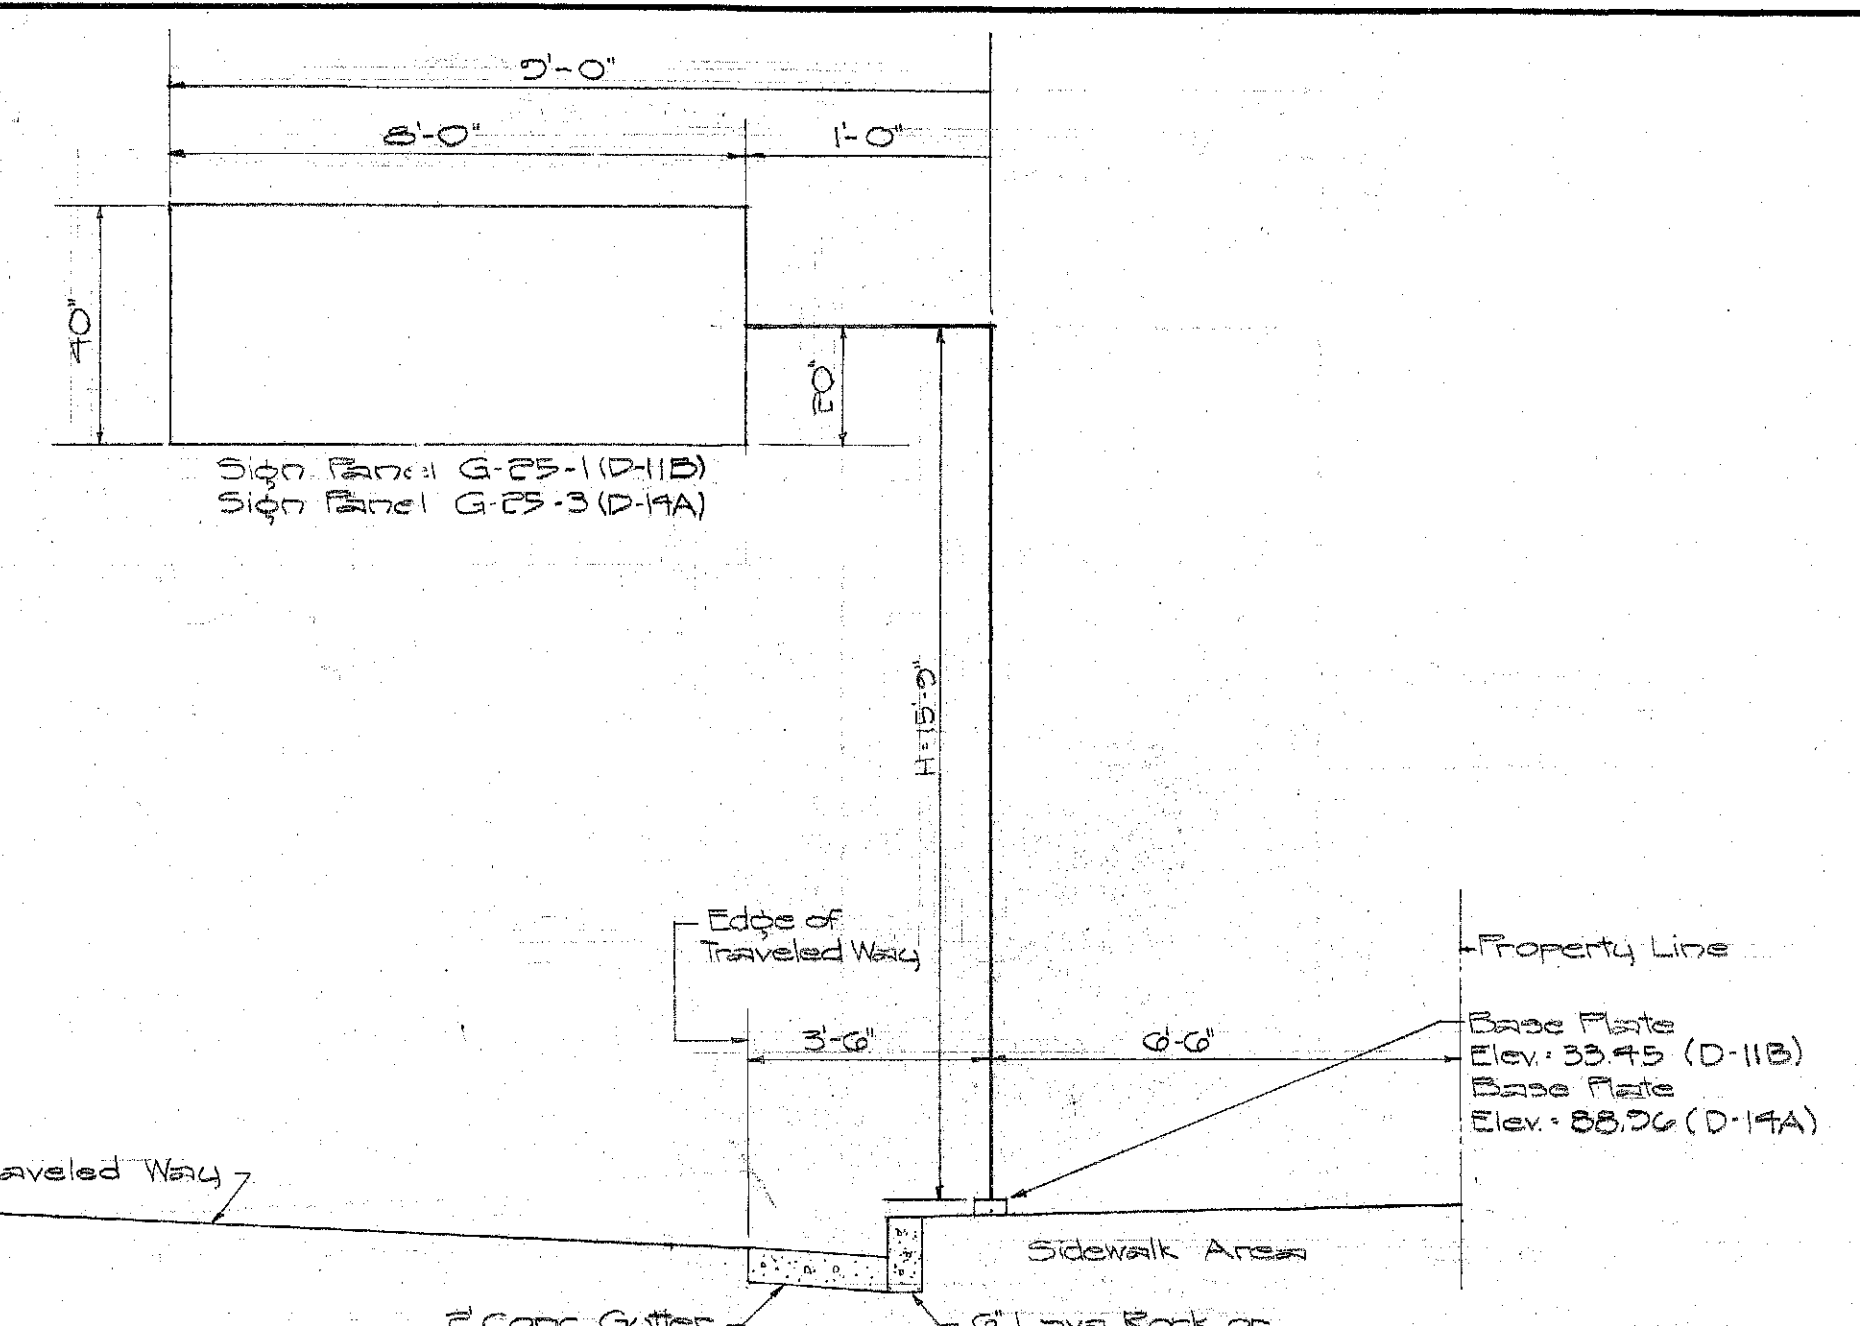


SIGN D-11B, D-14A

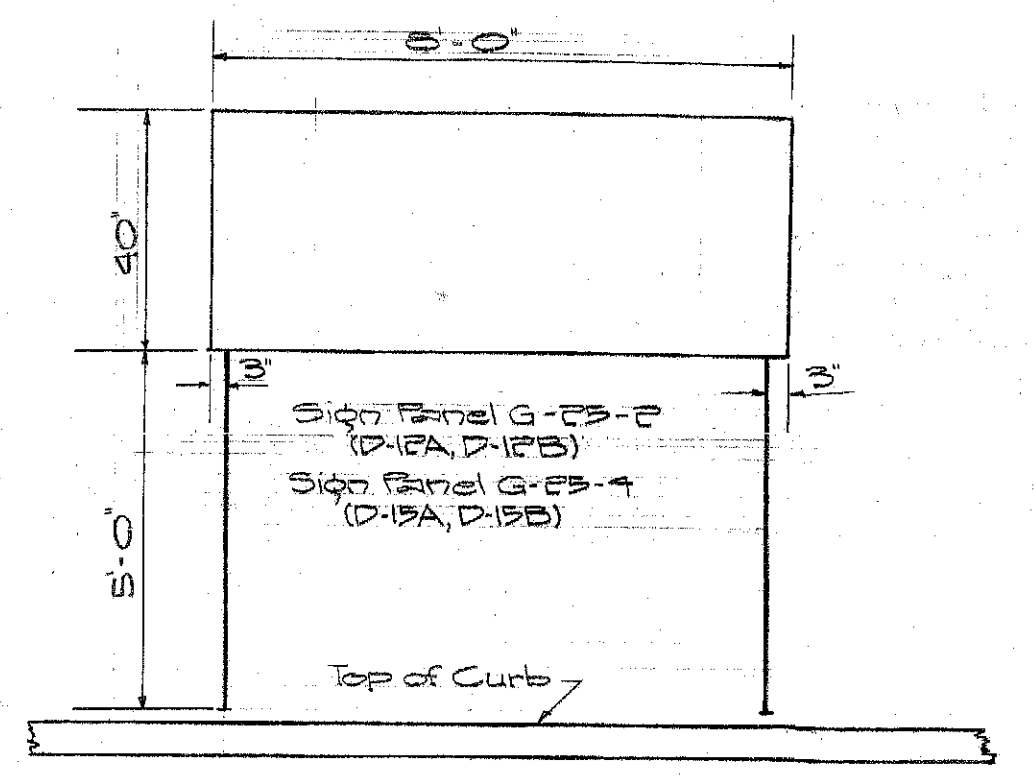


SIGN D-11A, D-12B, D-13A, D-15B


NOTE
For details of lighting units
refer to Standard Details,
Expressway Signs, Fluorescent
Luminaire Supports.

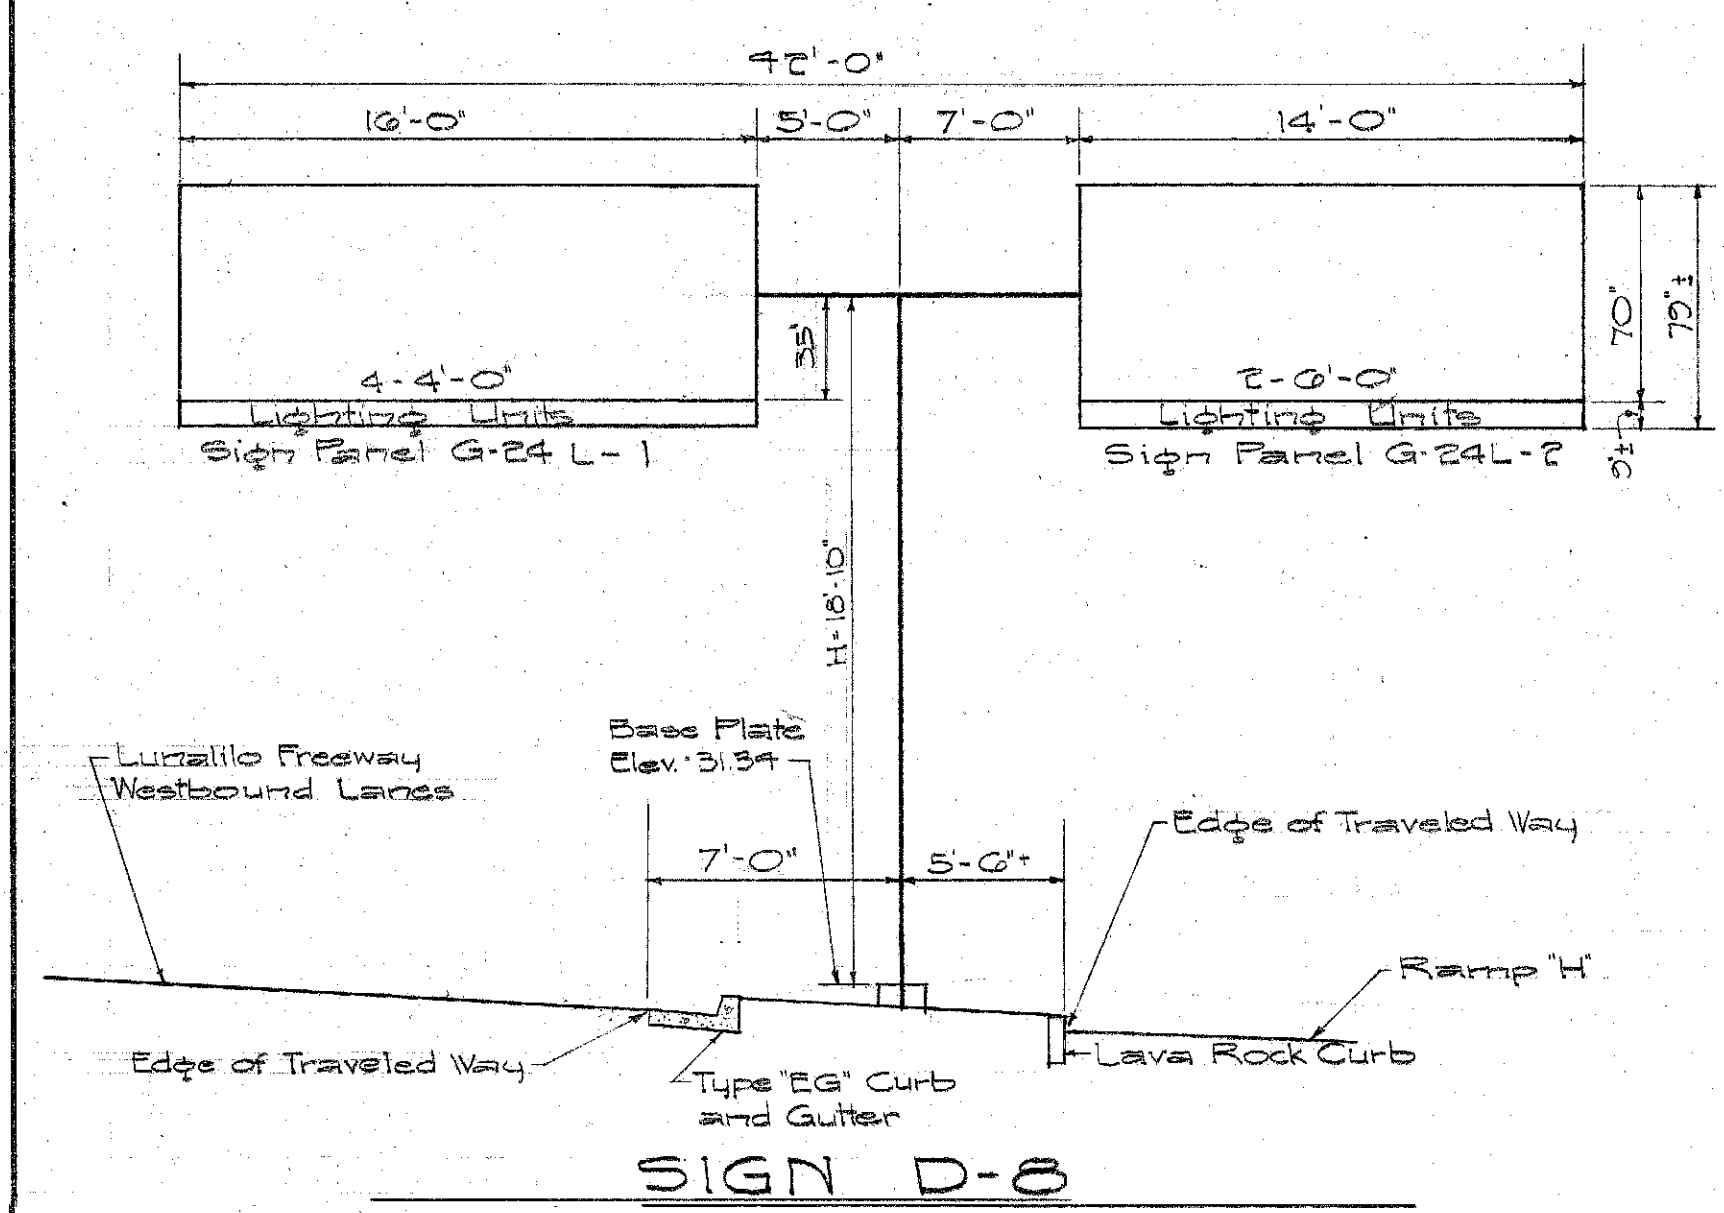


SIGN D-8

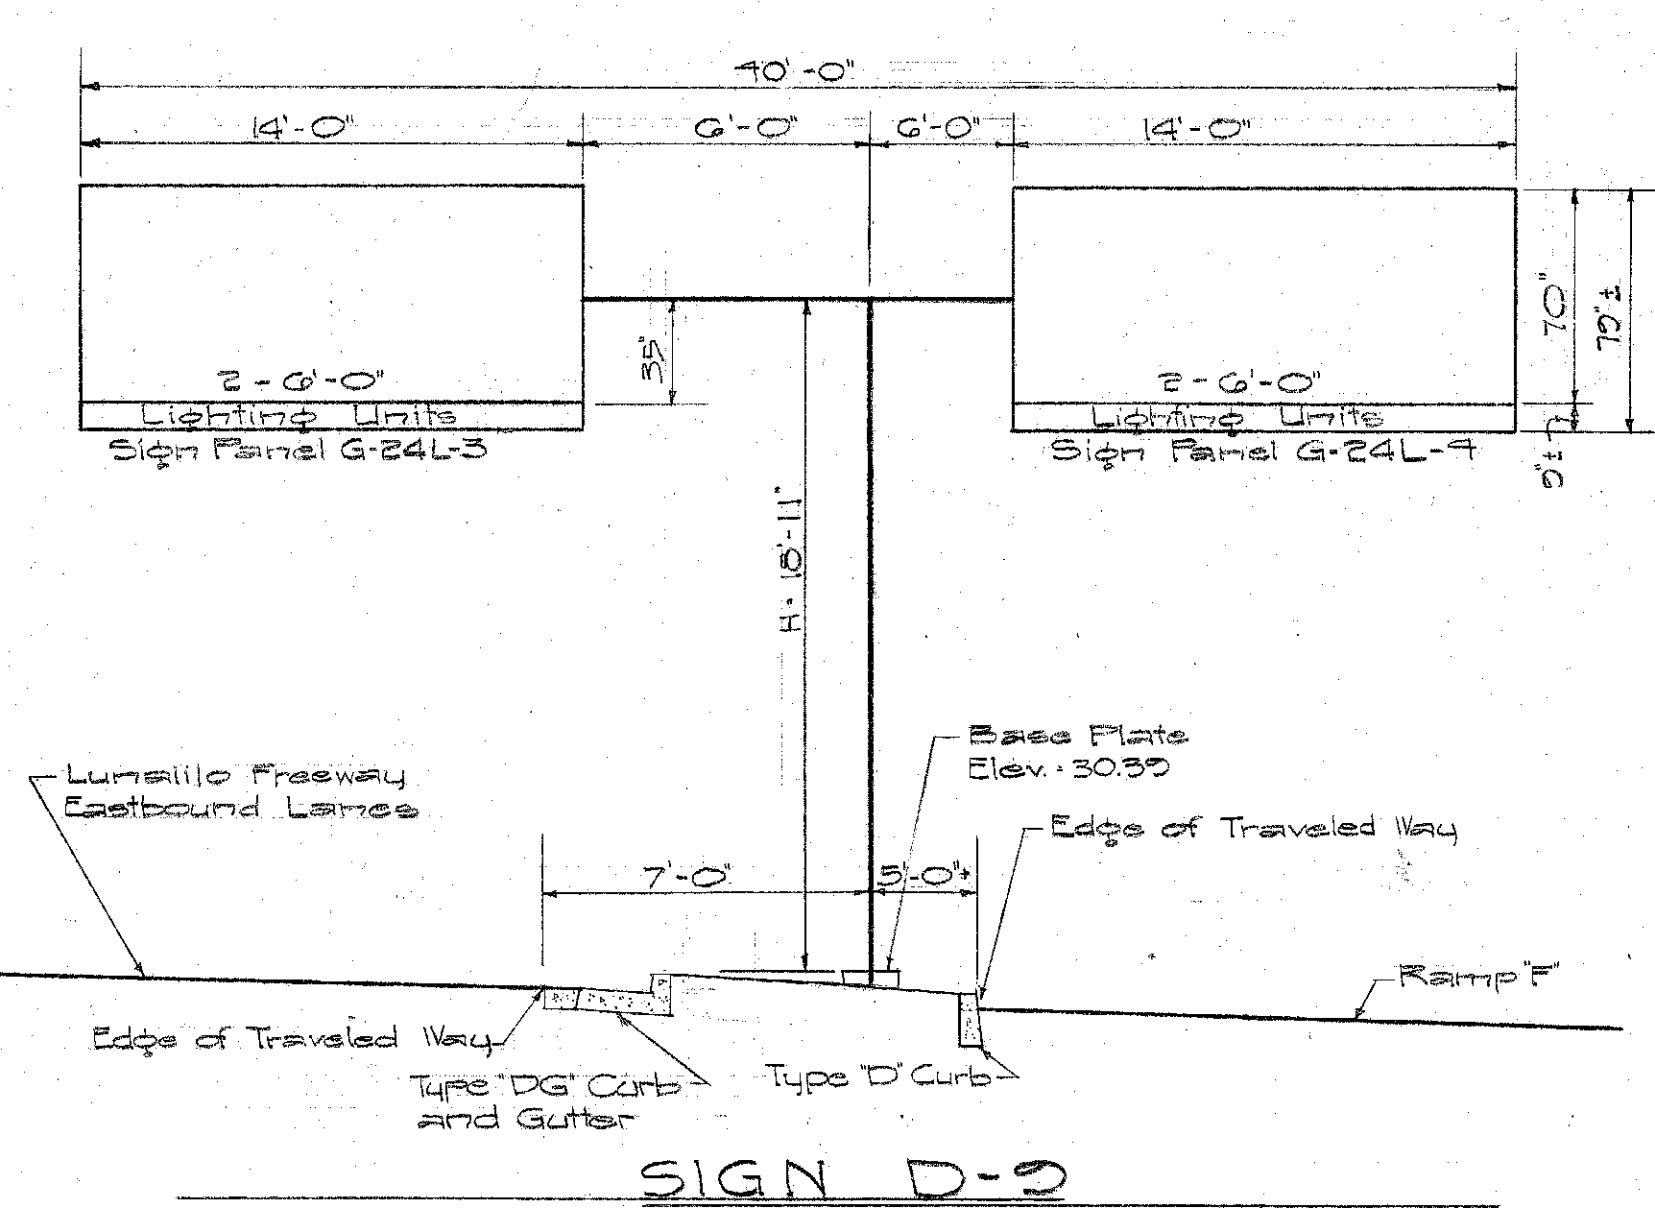


SIGN D-9

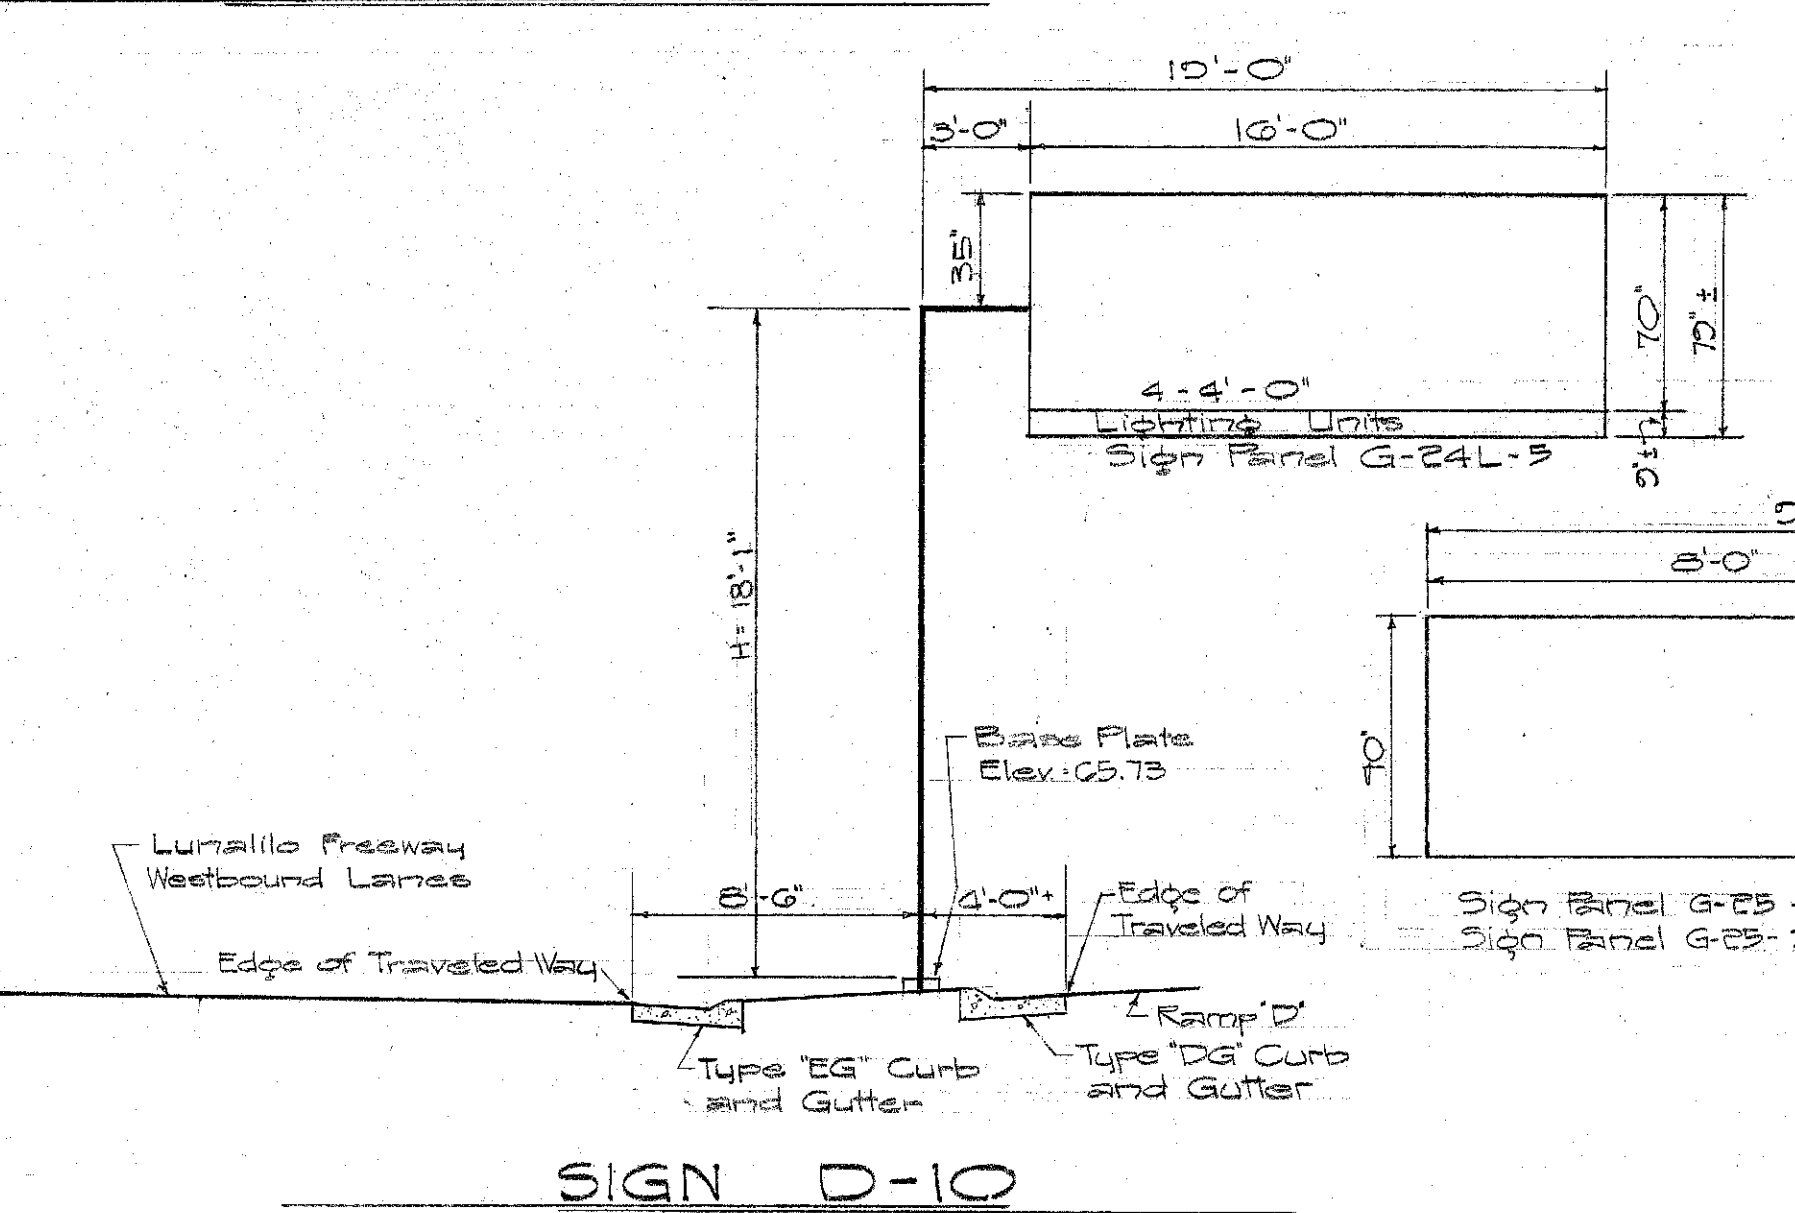


SIGN D-10

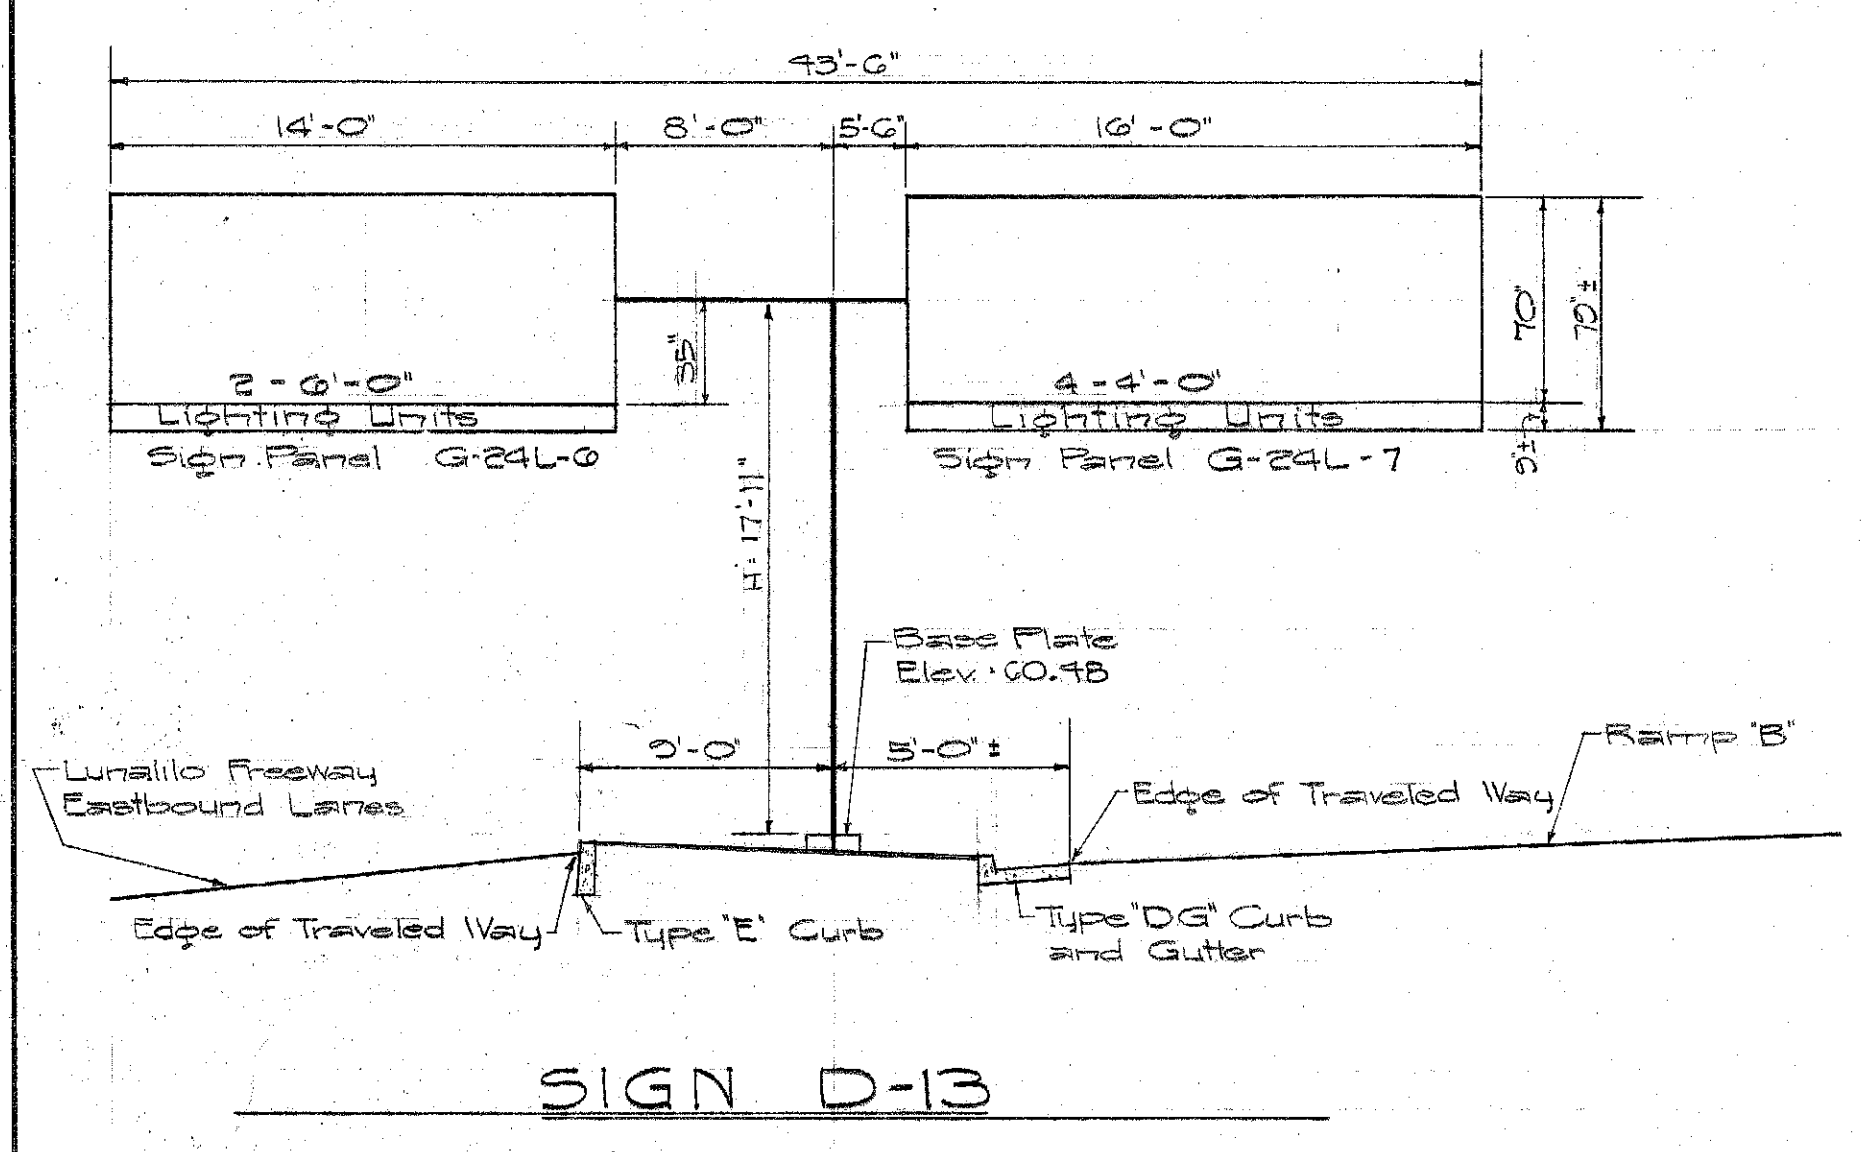

SIGN D-13

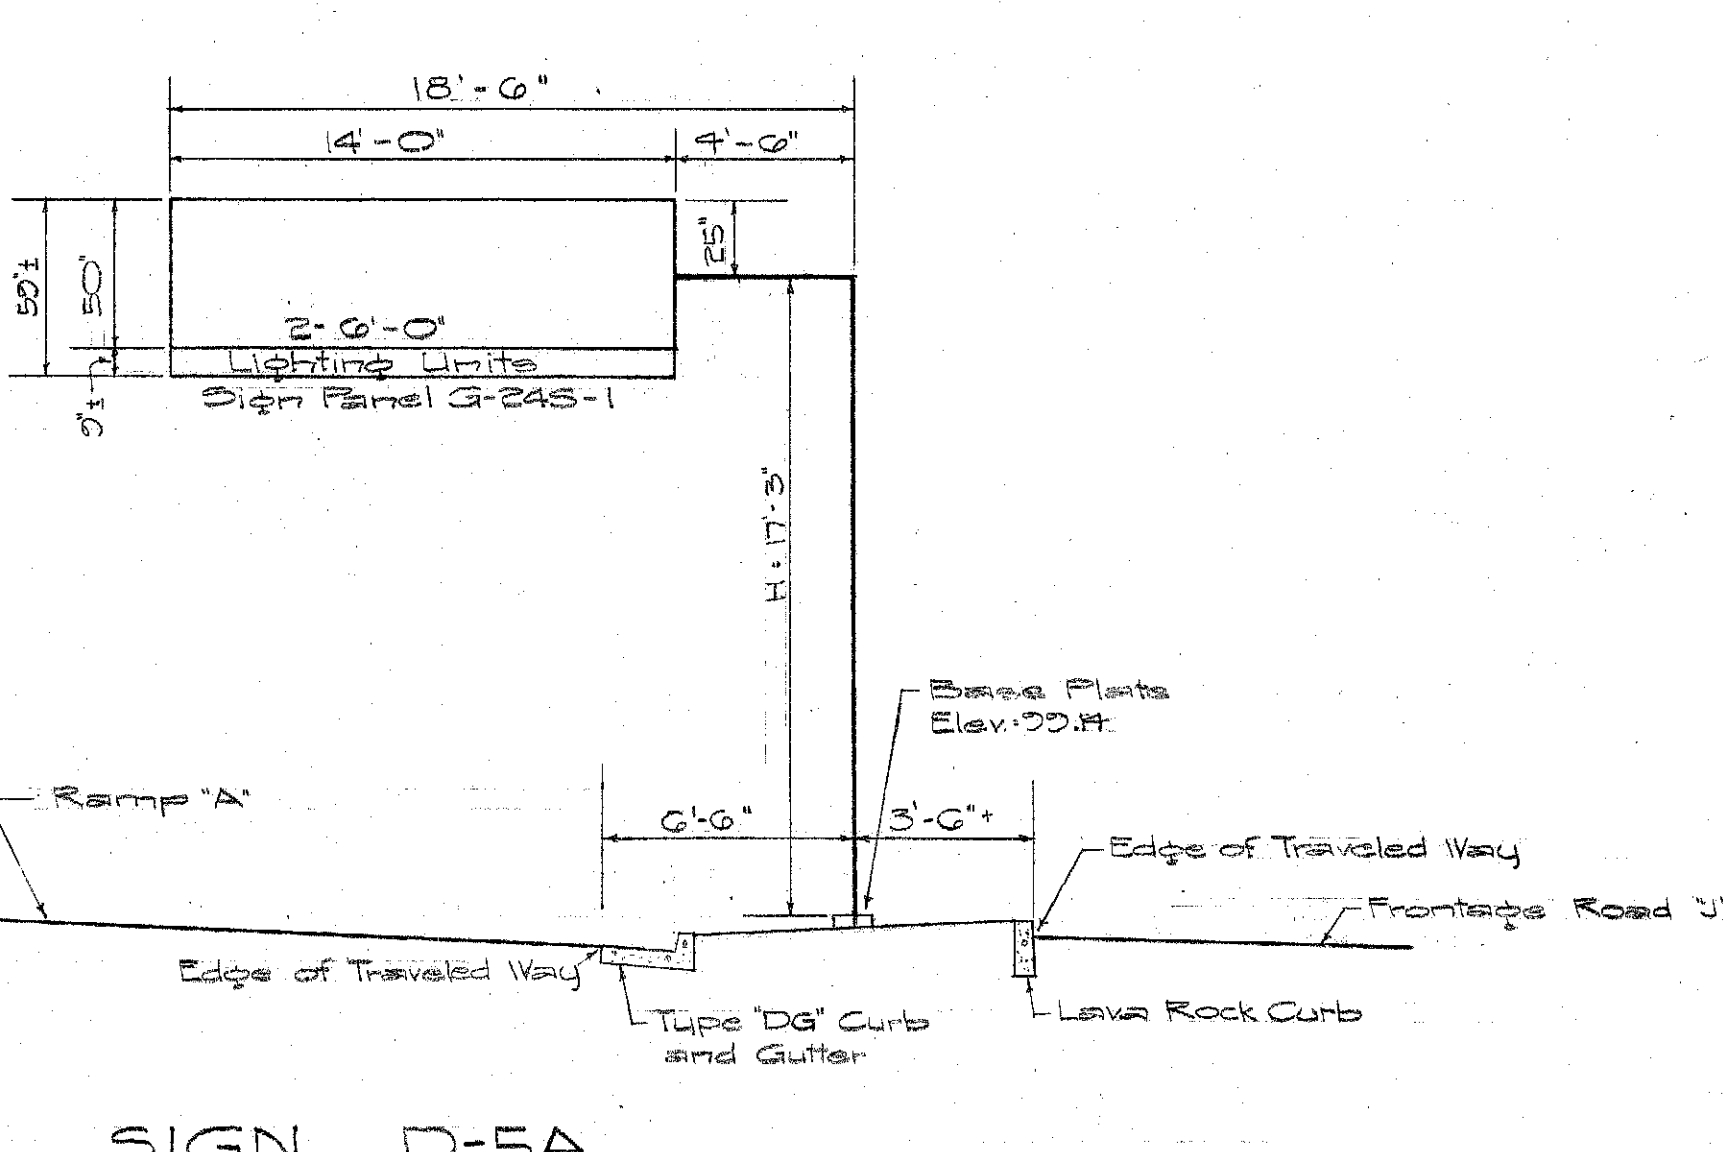

SIGN D-5A

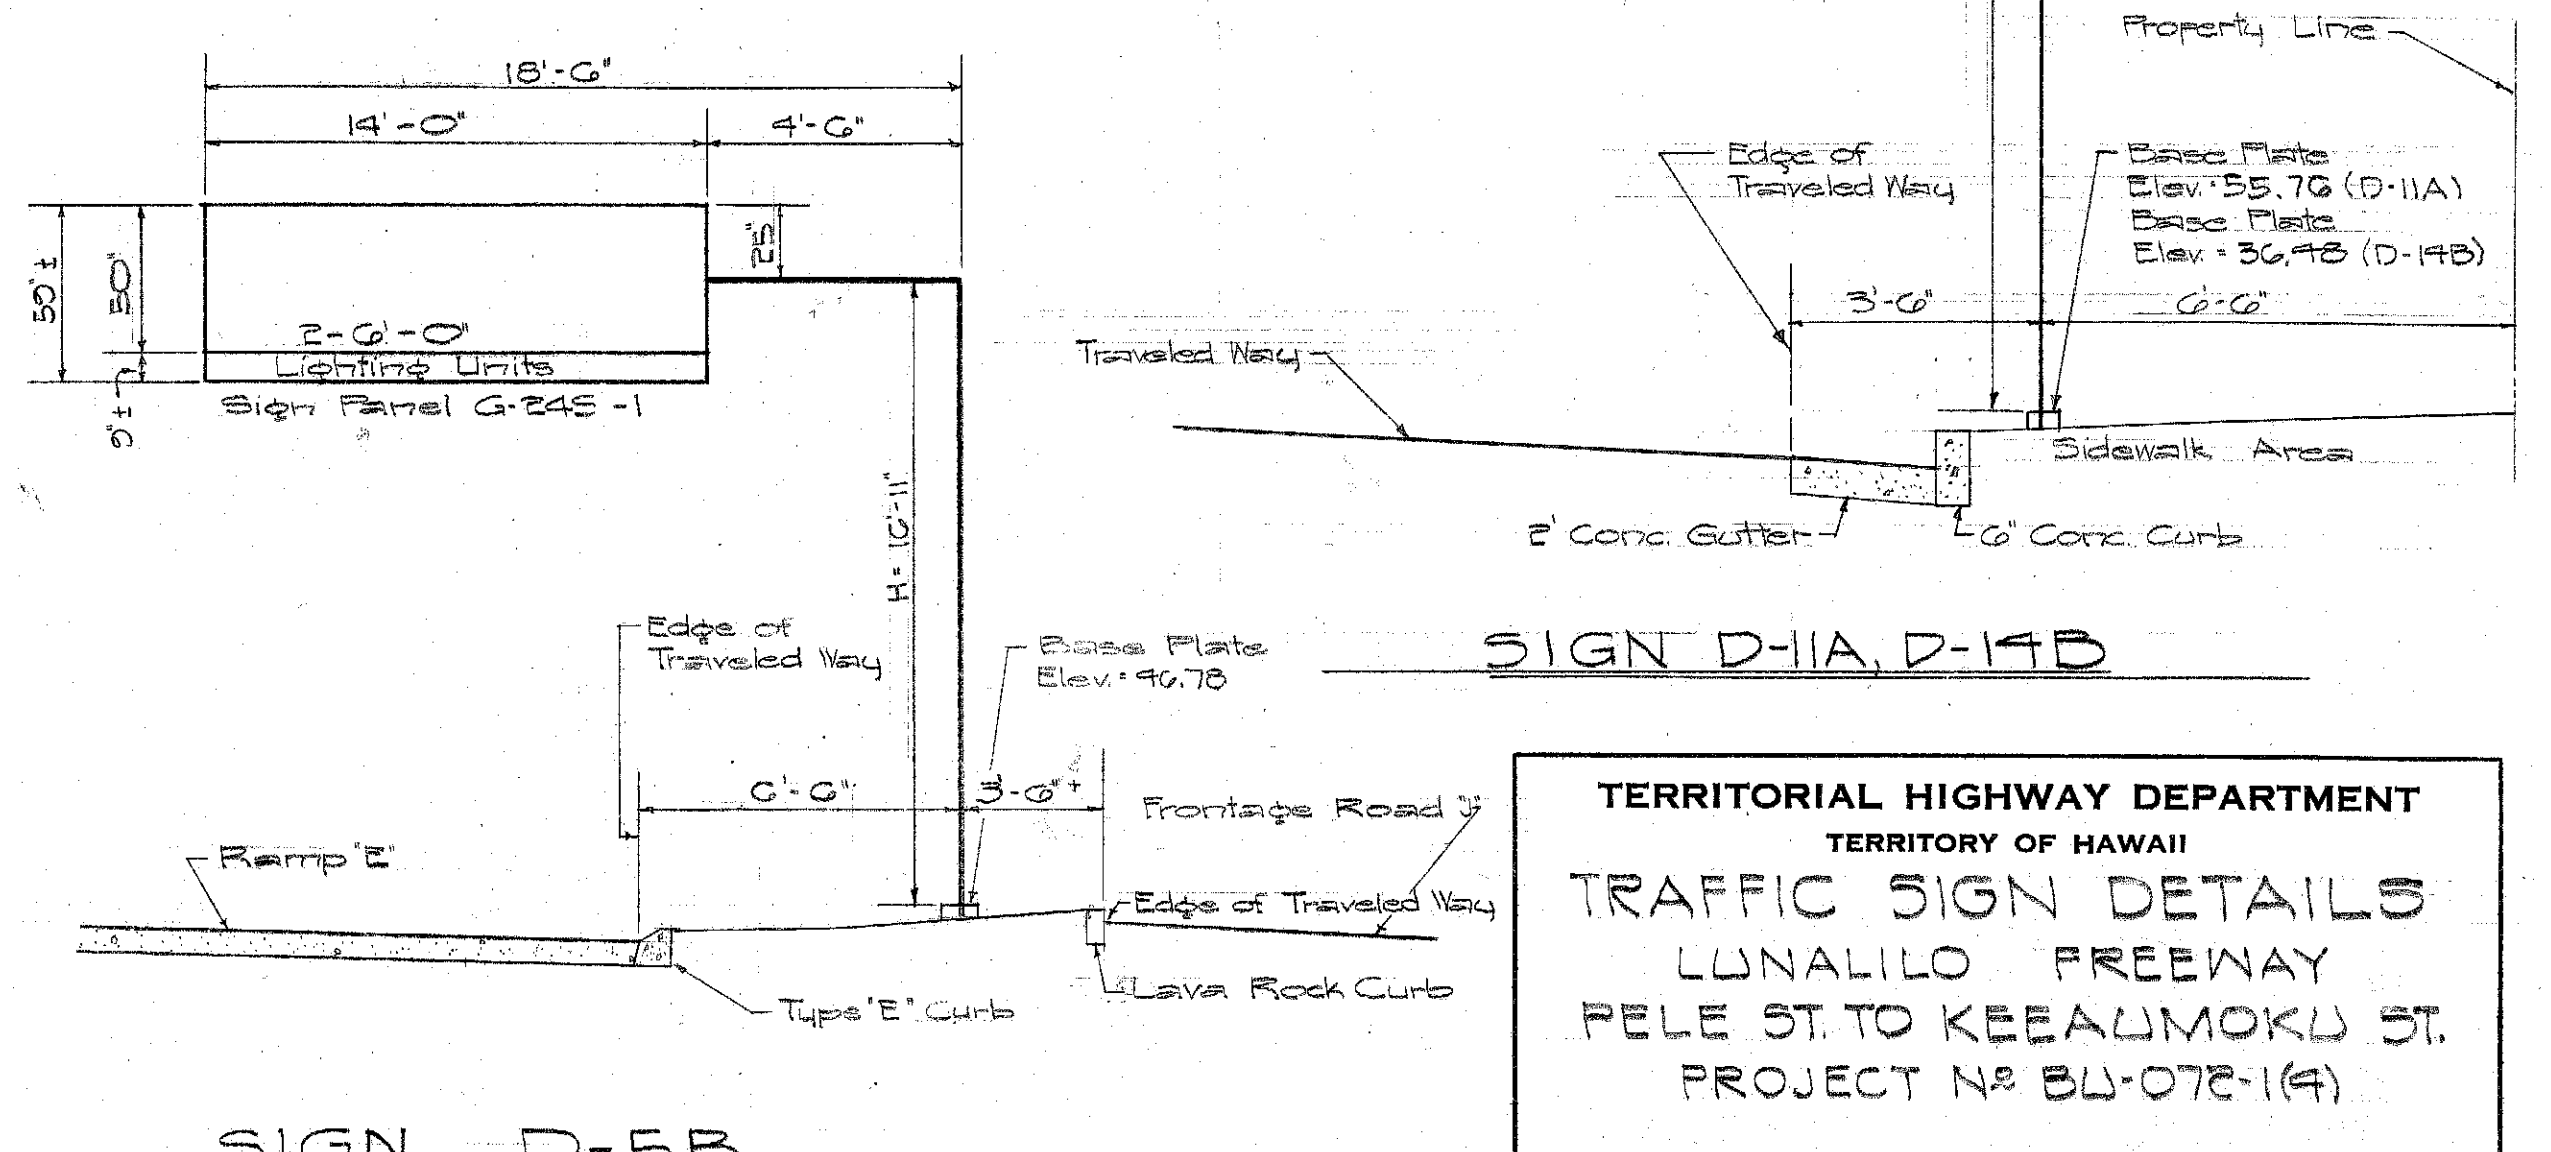

SIGN D-11A, D-14B

SIGN D-5B

TERRITORIAL HIGHWAY DEPARTMENT
TERRITORY OF HAWAII
TRAFFIC SIGN DETAILS
LUALABA FREEWAY
PELE ST. TO KEEAUMOKU ST.
PROJECT NO. BU-078-14A

DATE	
DESIGNED BY	
DRAWN BY	
CHECKED BY	
NOTED BY	
QUANTITIES CHECKED BY	
NO.	