



FED. ROAD DIST. NO.	STATE	PROJ. NO.	FISCAL YEAR	SHEET NO.	TOTAL SHEETS
HAWAII	HAW.	HWY-01-80	1981		


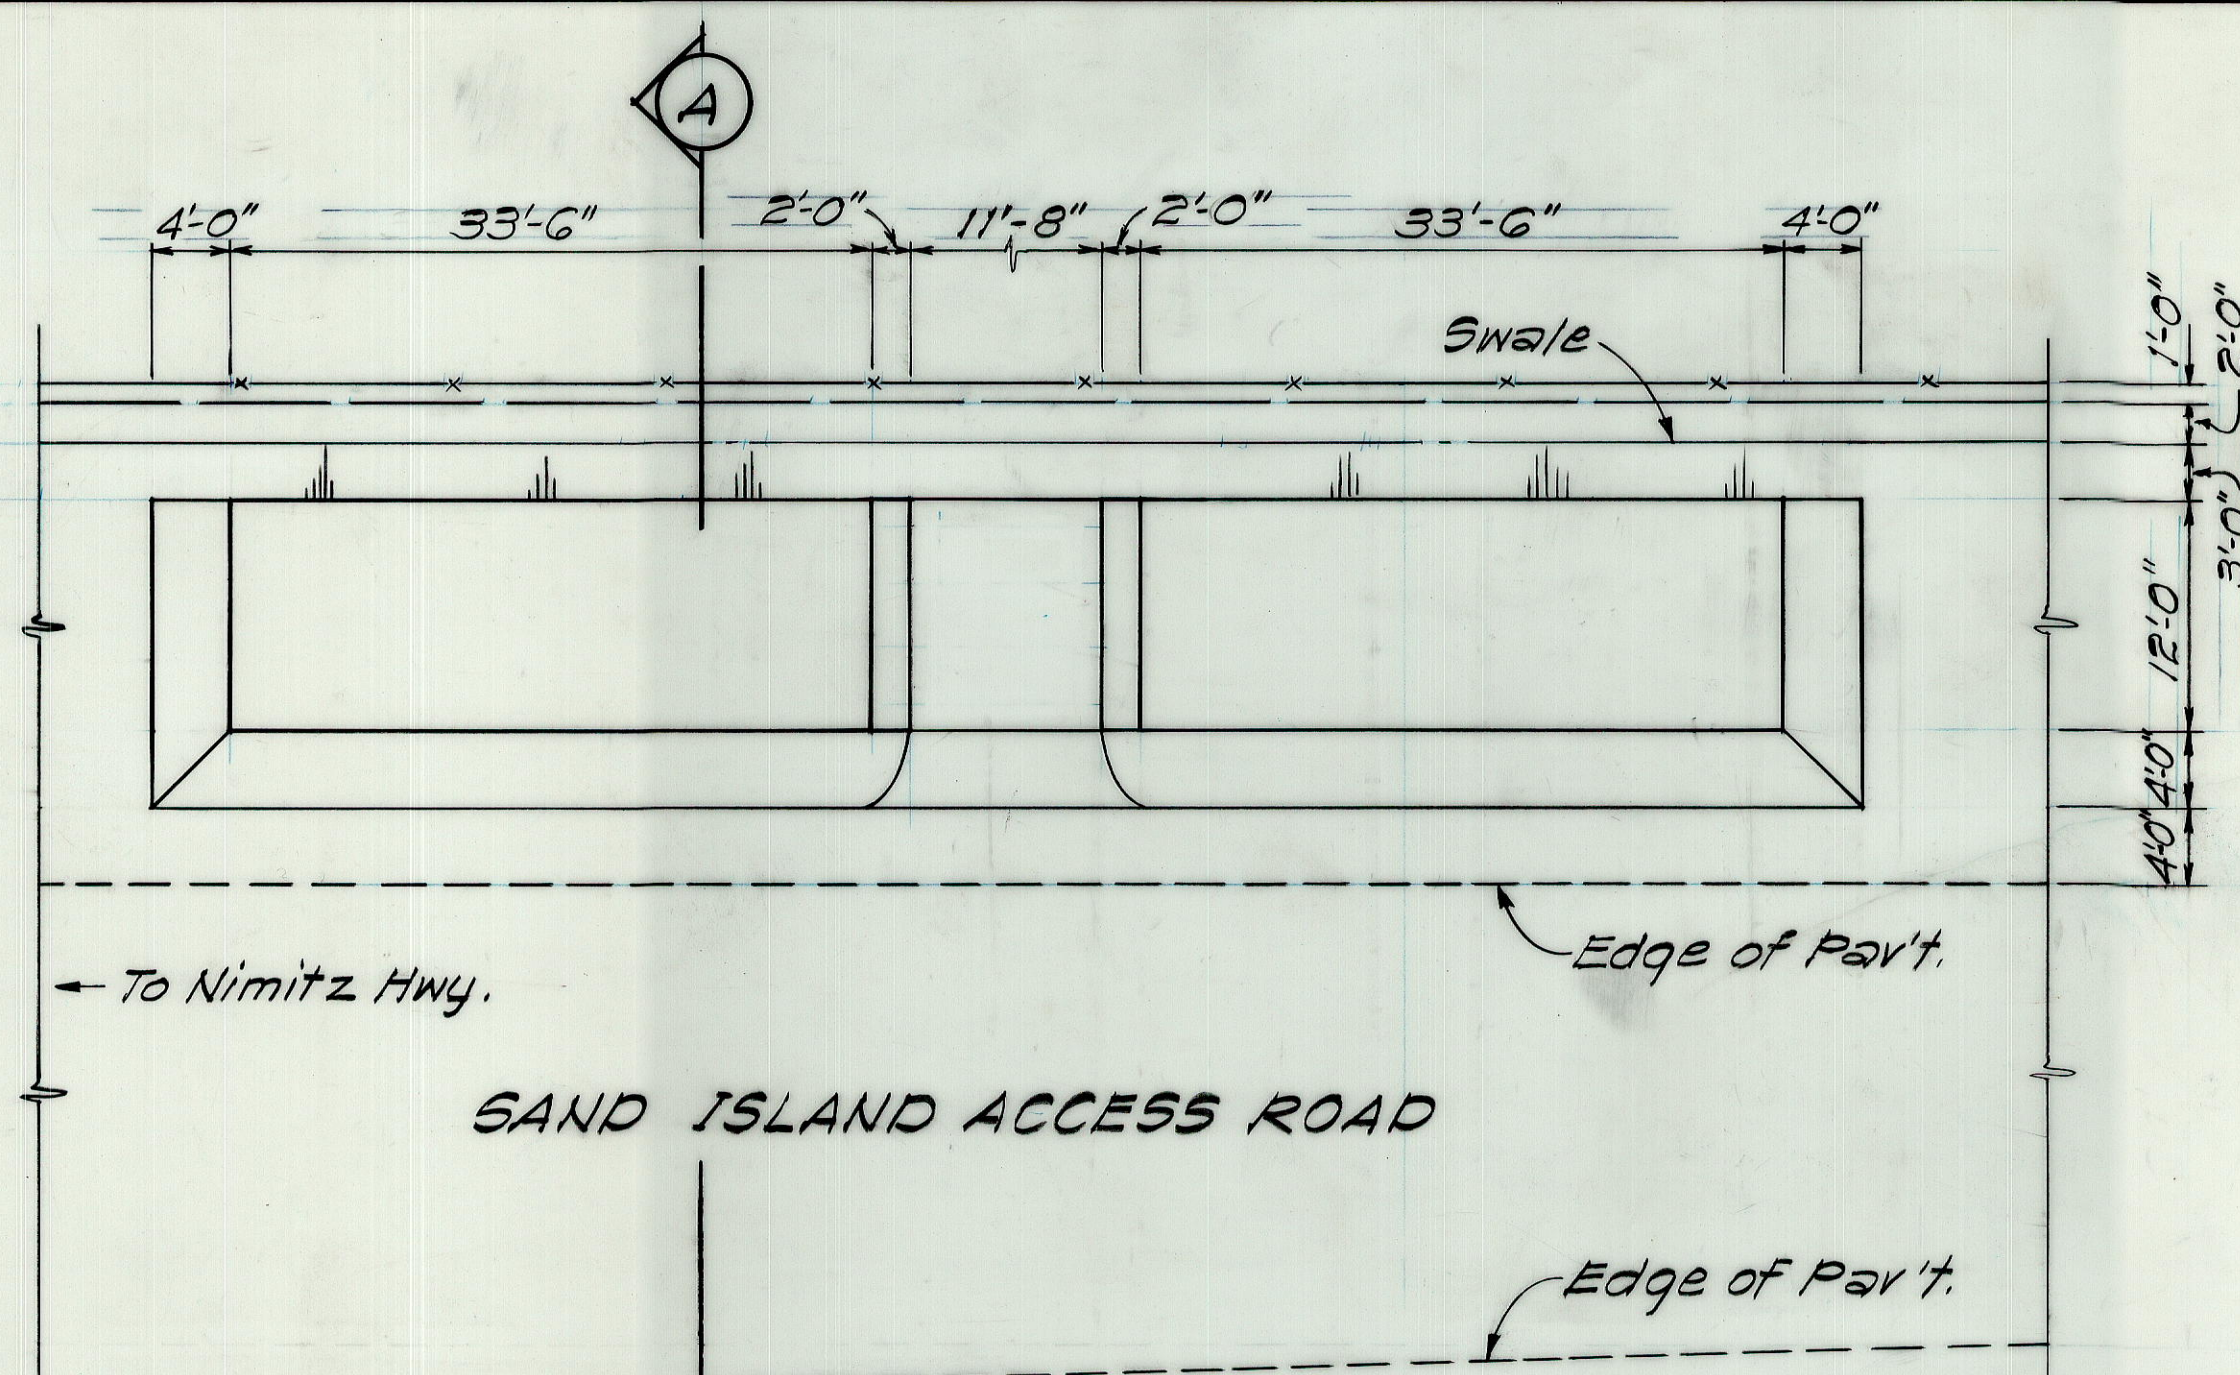


PLAN
Scale: 1" = 1'-0"

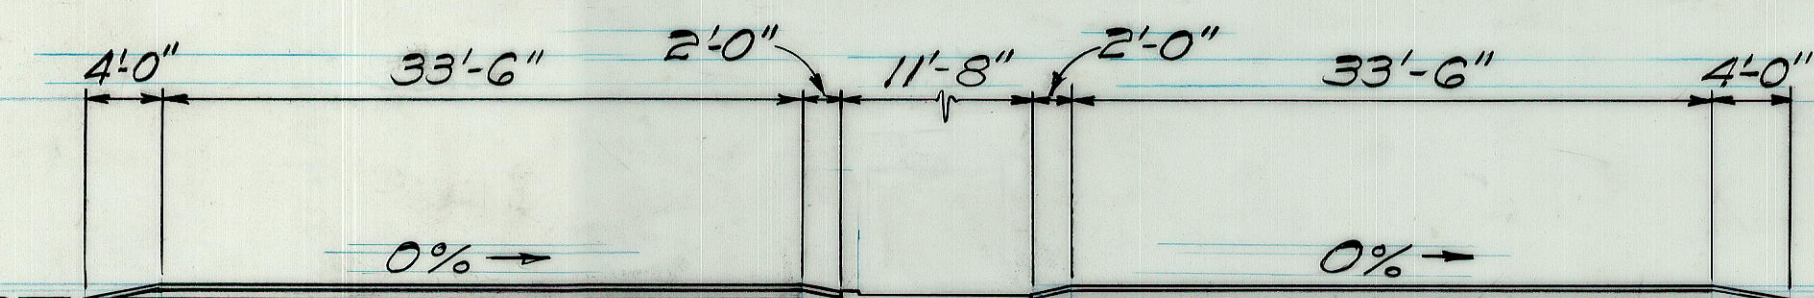


PROFILE
Scale: 1" = 1'-0"


True North
Scale: 1" = 40'

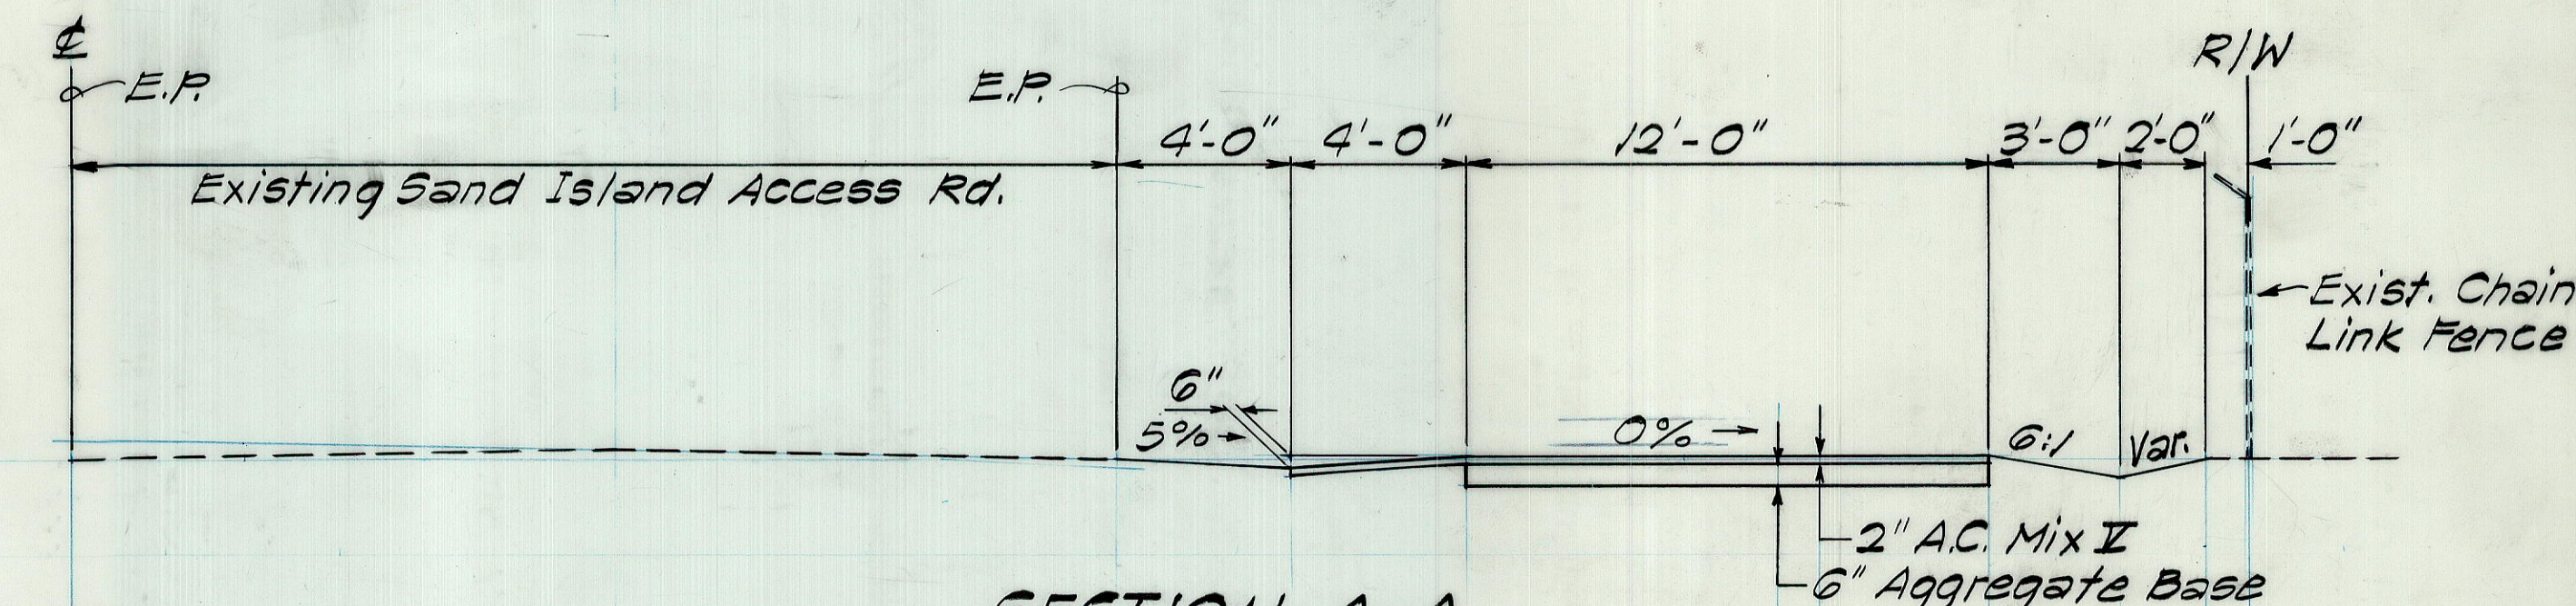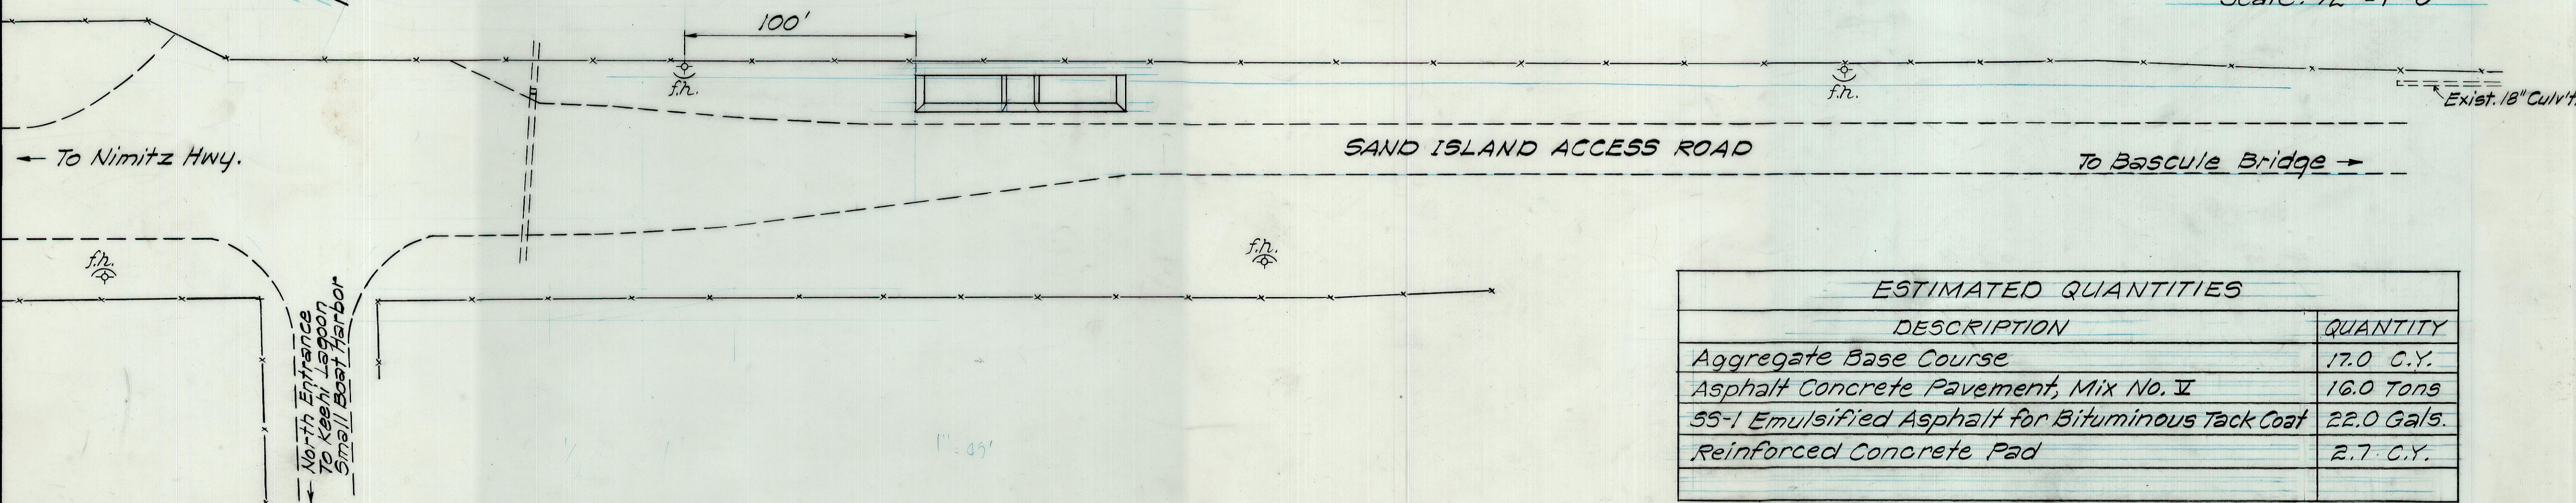

SECTION A-A
Scale: 1/4" = 1'-0"

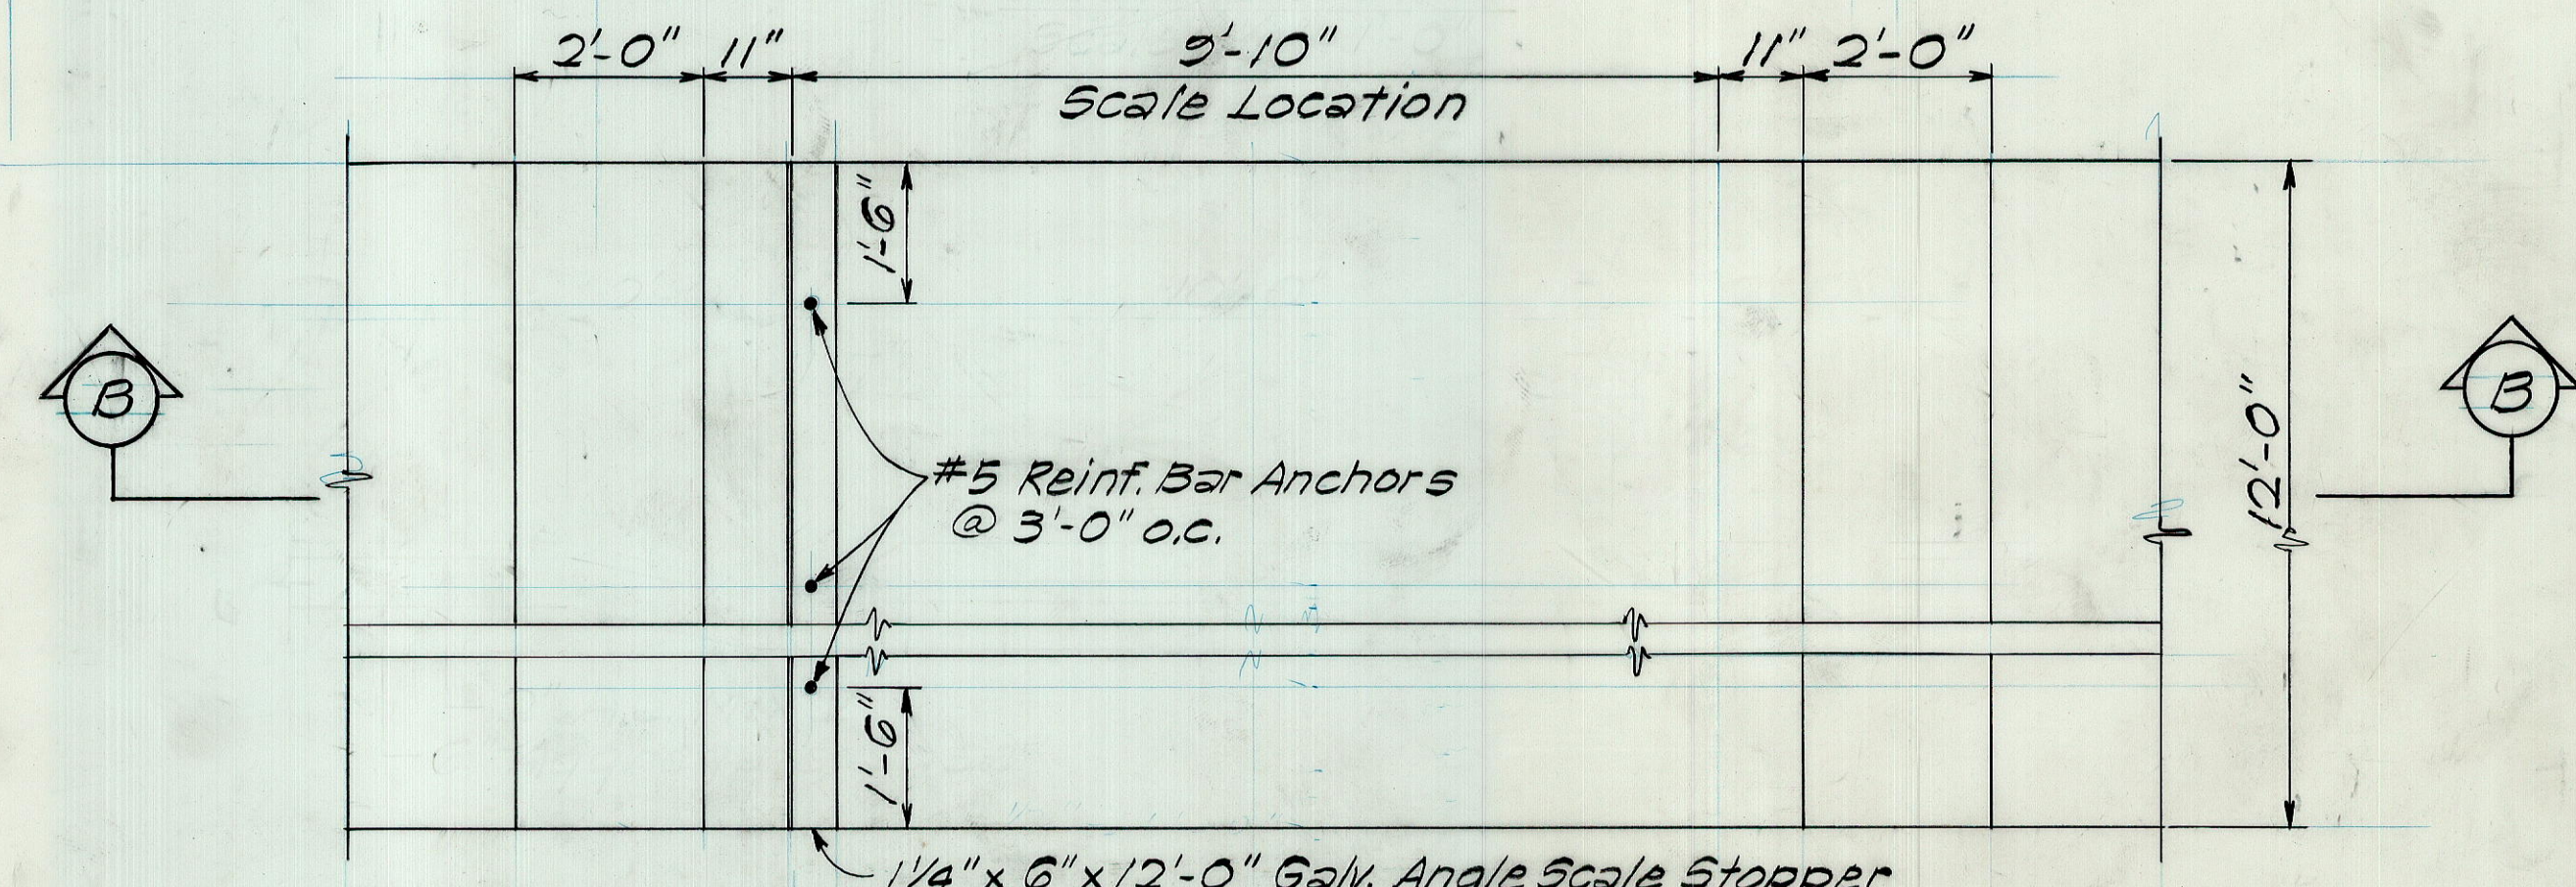

PLAN

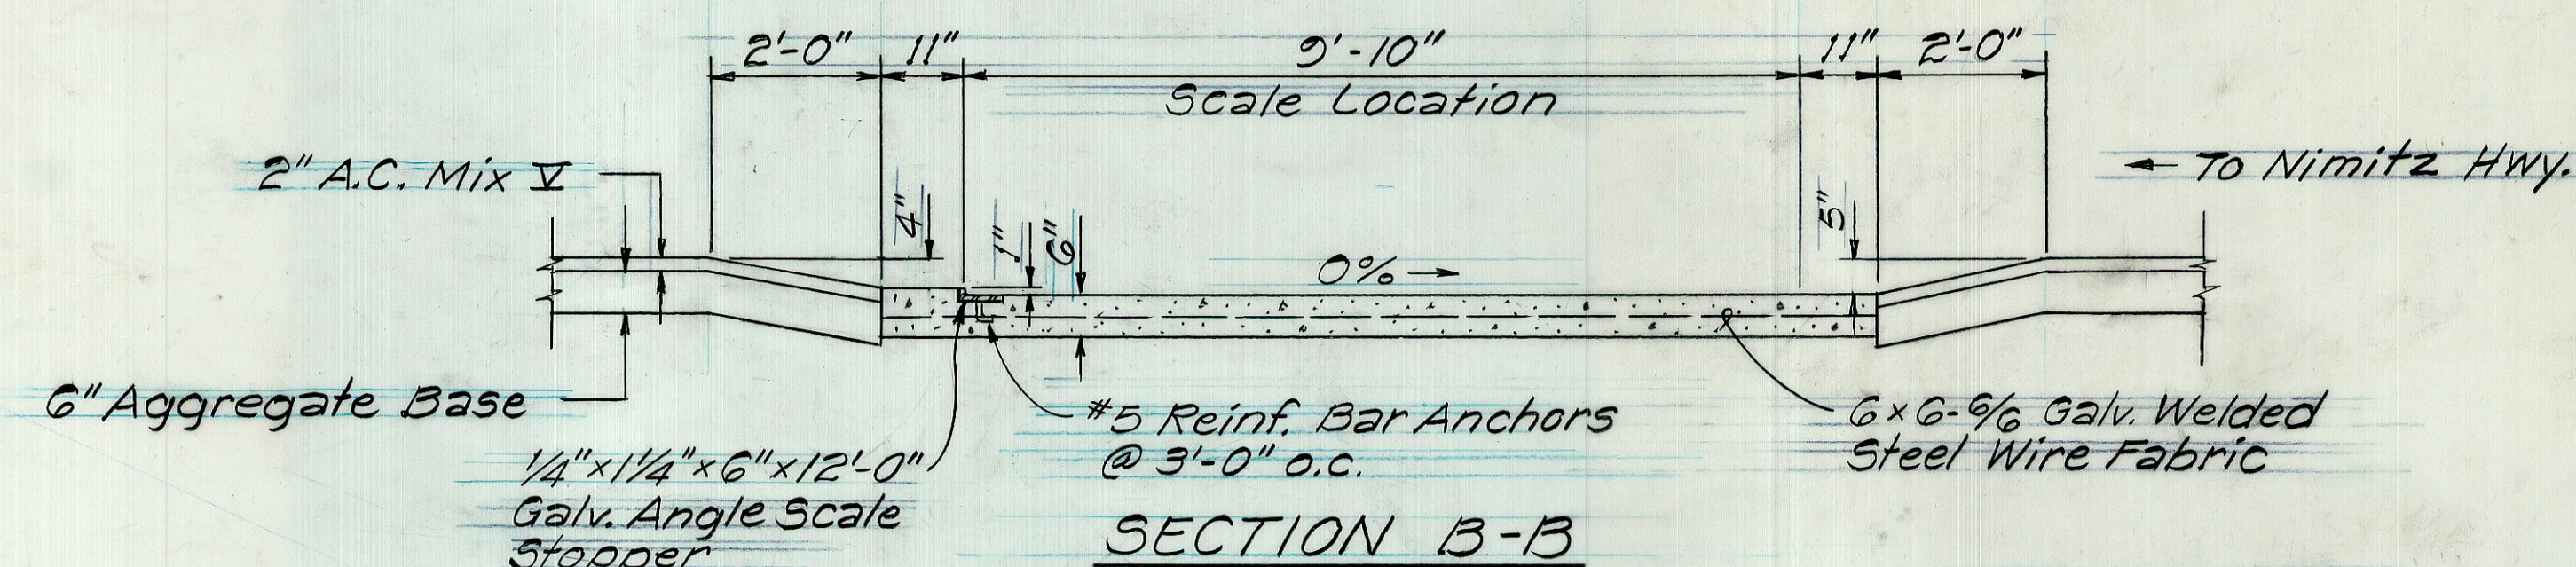

SECTION B-B
DETAIL OF REINFORCED CONCRETE PAD FOR PORTABLE SCALE
Scale: 1/2" = 1'-0"

ESTIMATED QUANTITIES	
DESCRIPTION	QUANTITY
Aggregate Base Course	17.0 C.Y.
Asphalt Concrete Pavement, Mix No. II	16.0 Tons
SS-1 Emulsified Asphalt for Bituminous Tack Coat	22.0 Gals.
Reinforced Concrete Pad	2.7 C.Y.

STATE OF HAWAII
DEPARTMENT OF TRANSPORTATION
SAND ISLAND SITE
VEHICLE SIZE & WEIGHT ENFORCEMENT
SITES, VARIOUS LOCATIONS
PROJECT NO. HWY-01-80
Scale: As Shown Date: Oct, 1980
SHEET NO. OF SHEETS

SURVEY PLOTTED BY	DATE
DRAWN BY	
DESIGNED BY	
CHECKED BY	
NOTE BOOK	
No.	