




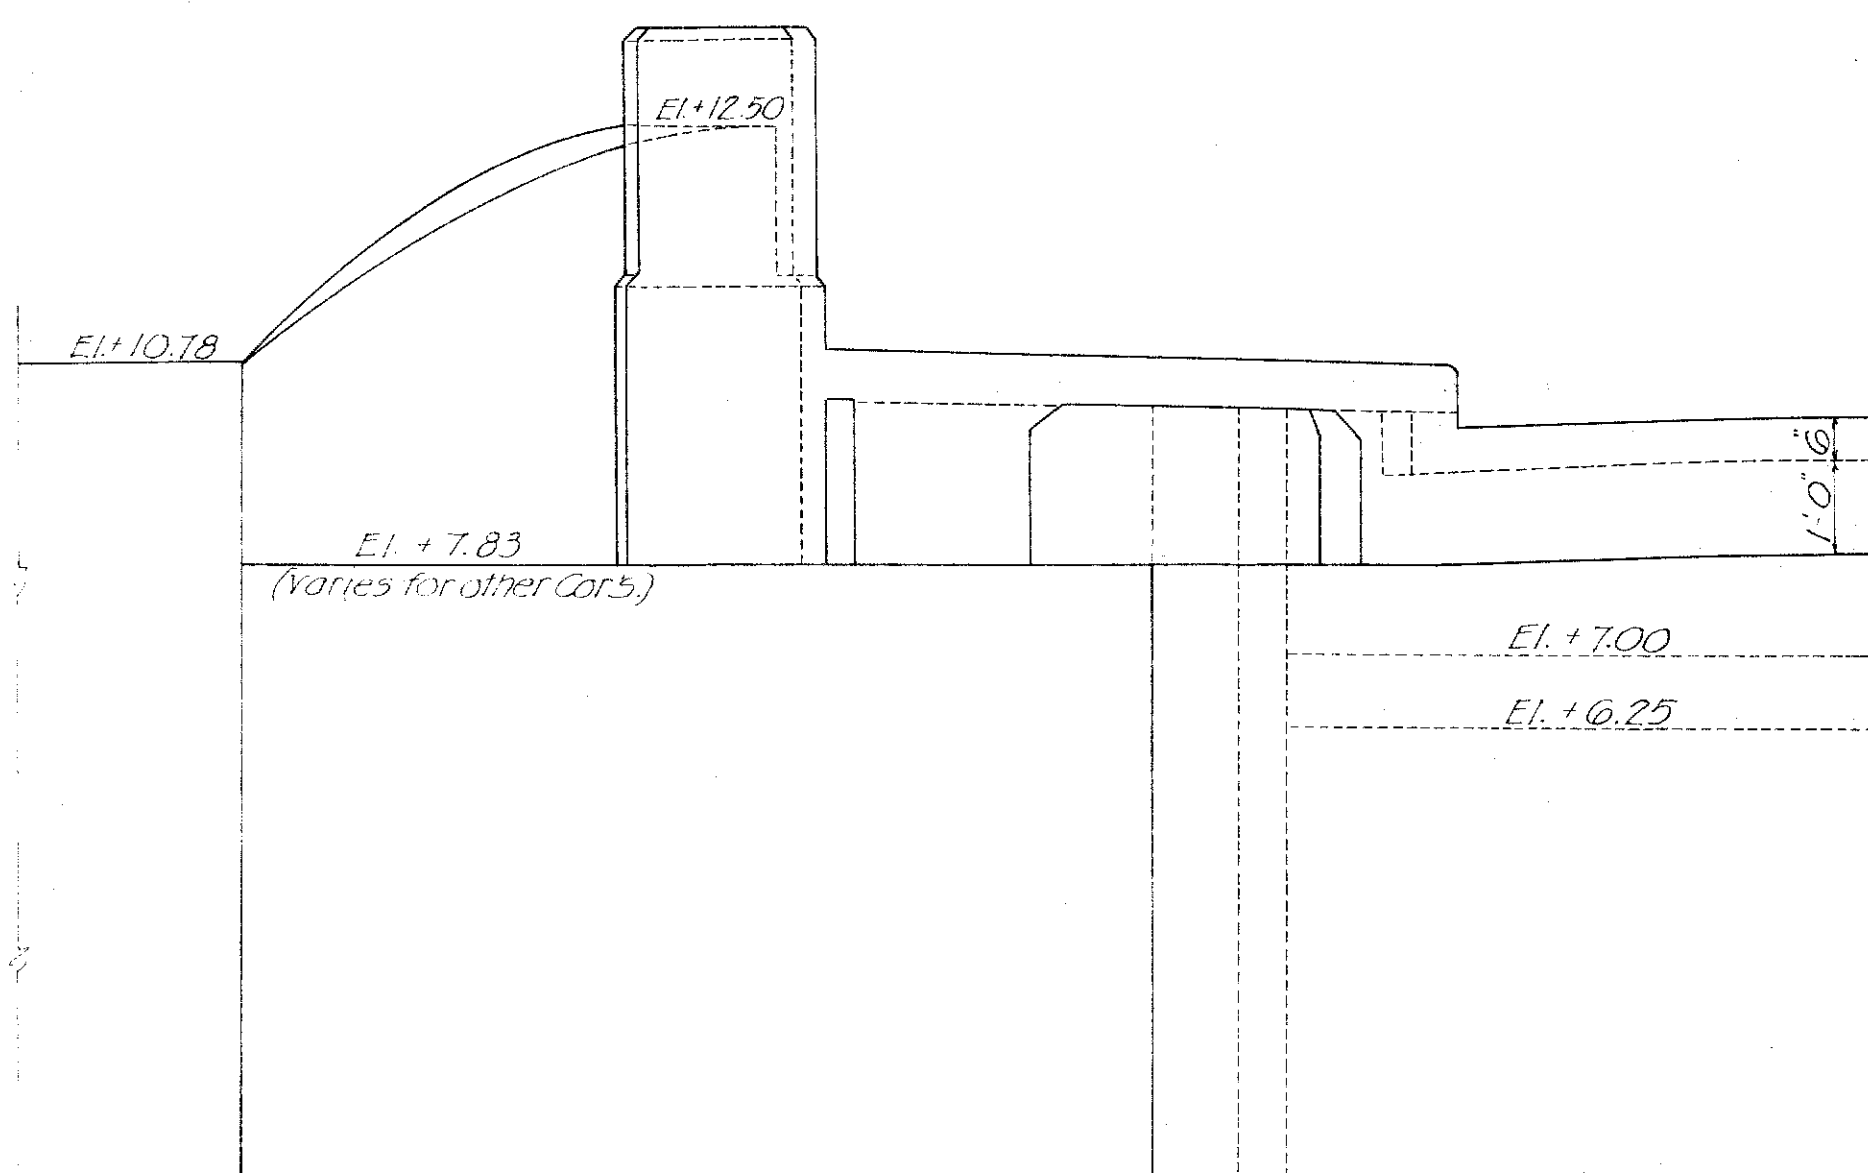

SEC. R-R

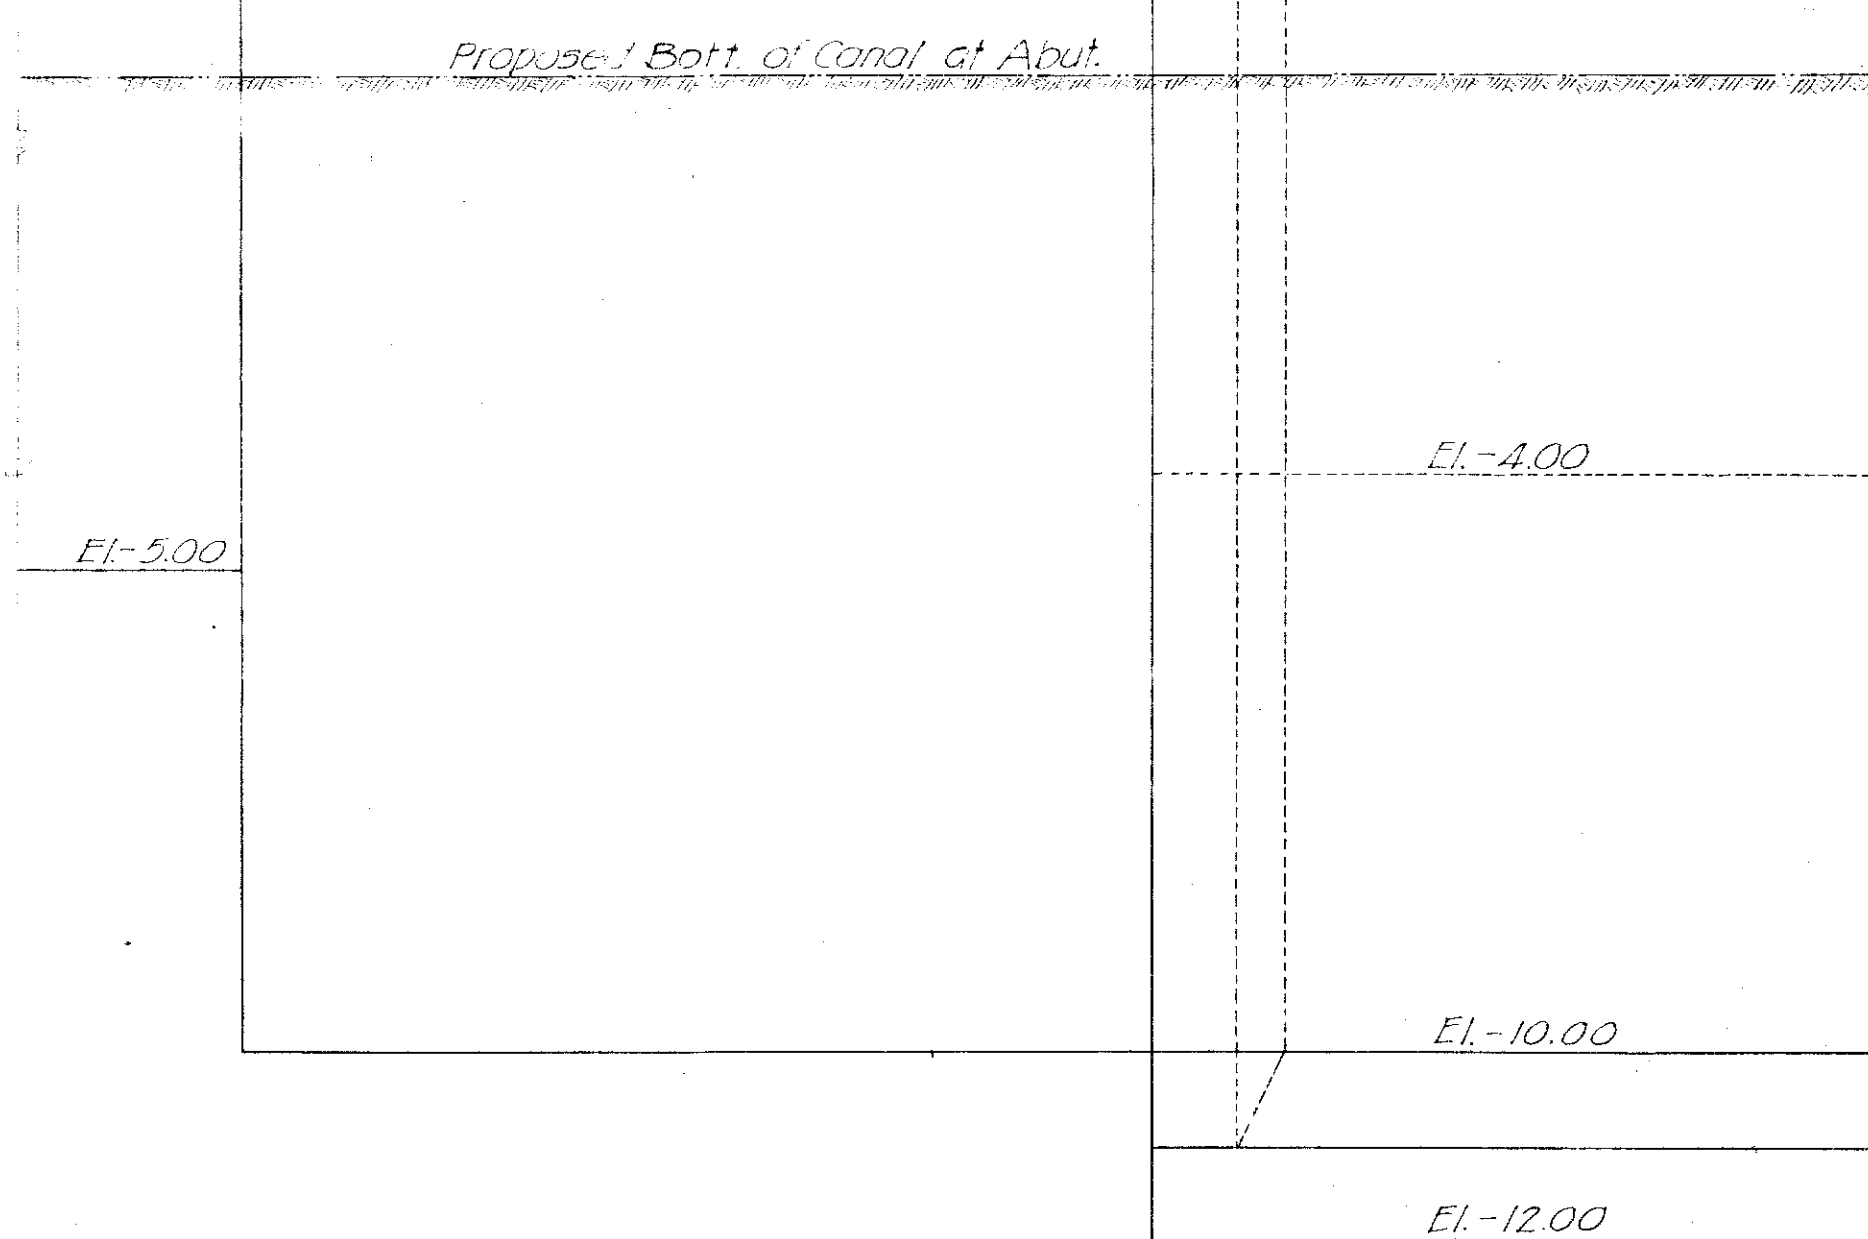

SECTION L-L
Scale 1 in. = 1'-0"

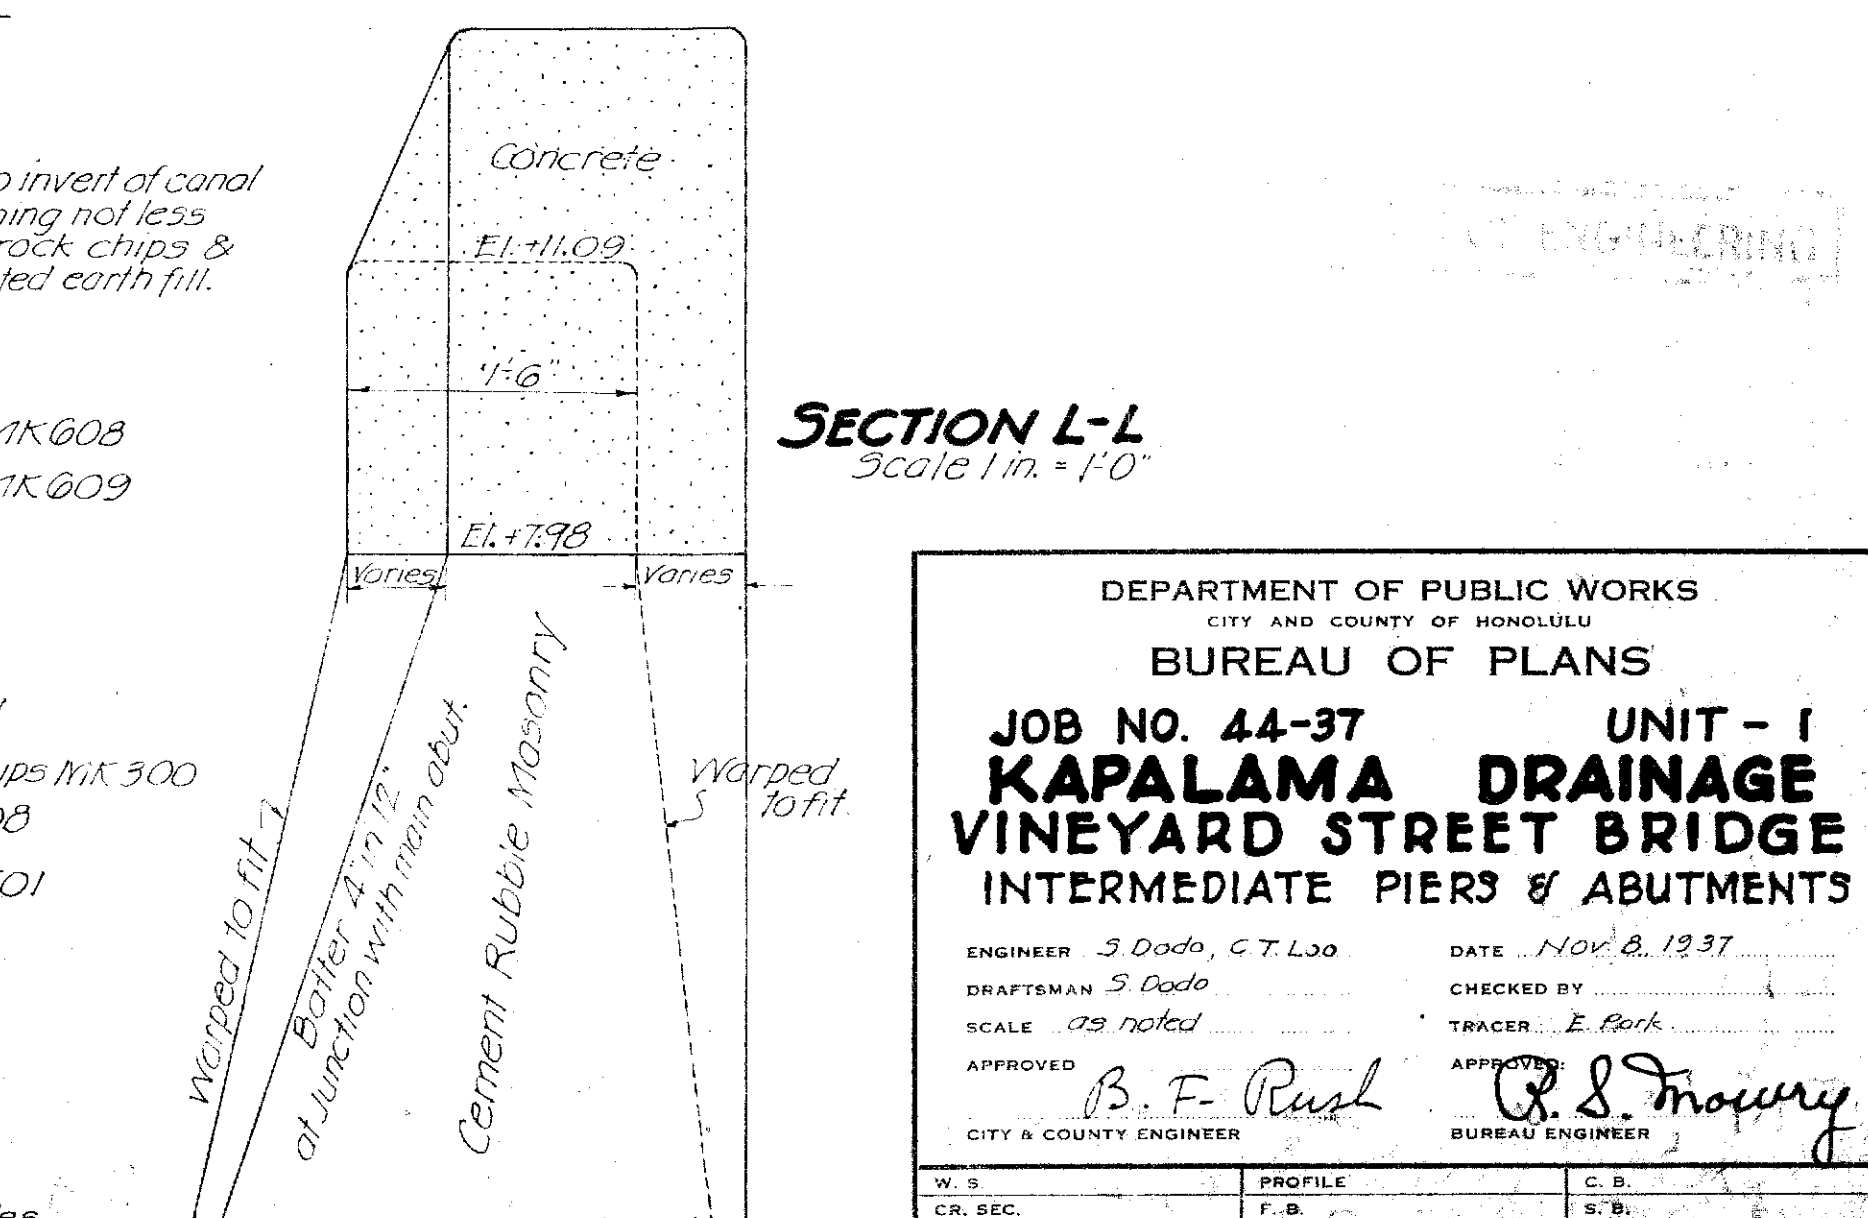

SEC. 5-5

FILE	POCKET	FOLDER	NO.
5	1	1	35