



| FED. ROAD DIST. NO. | STATE | FEDERAL AID PROJ. NO. | FISCAL YEAR | SHEET NO. | TOTAL SHEETS |
|---------------------|-------|-----------------------|-------------|-----------|--------------|
| HAWAII              | HAW.  | 1M-0300(123)          | 2011        | C.O. 32   | 65           |

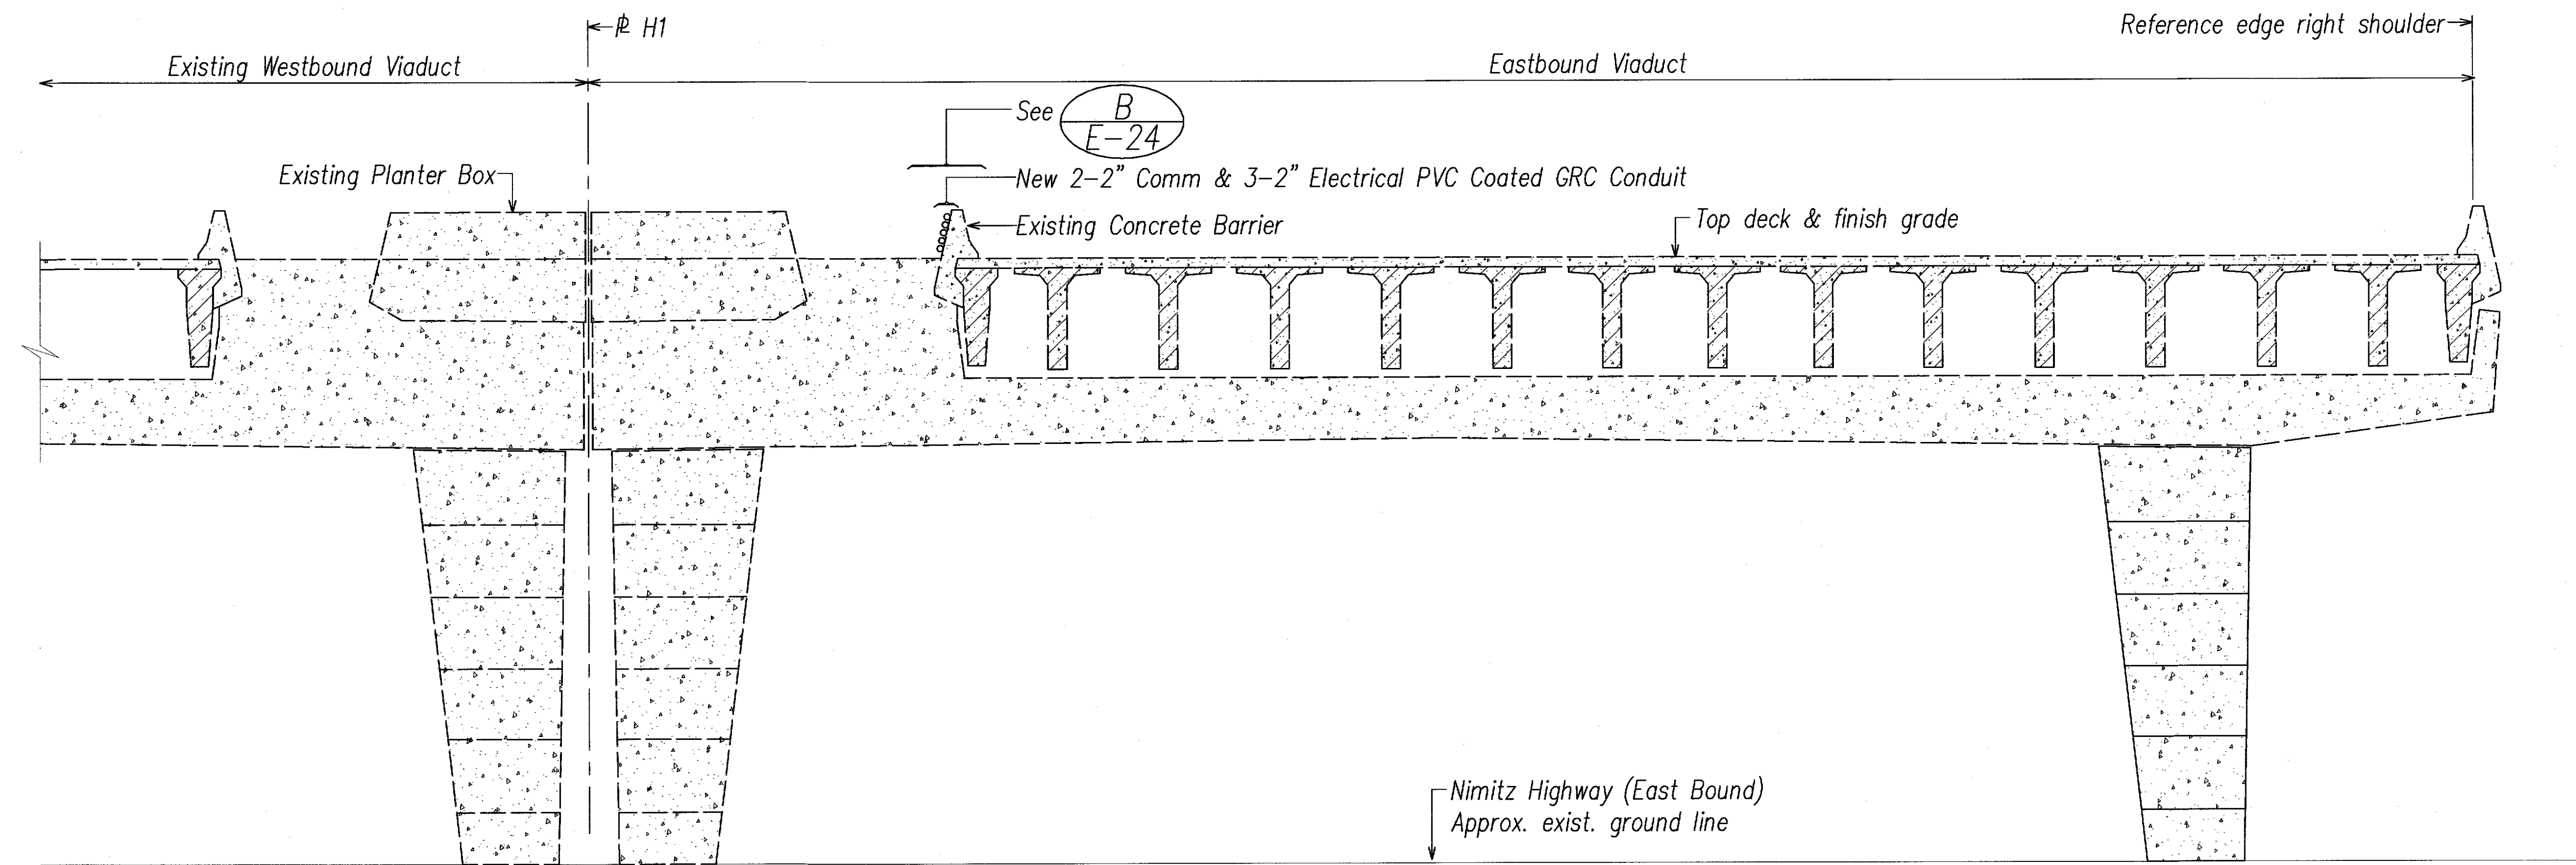

**A**  
**E-24** **Cross Section Of Viaduct Deck**  
NOT TO SCALE

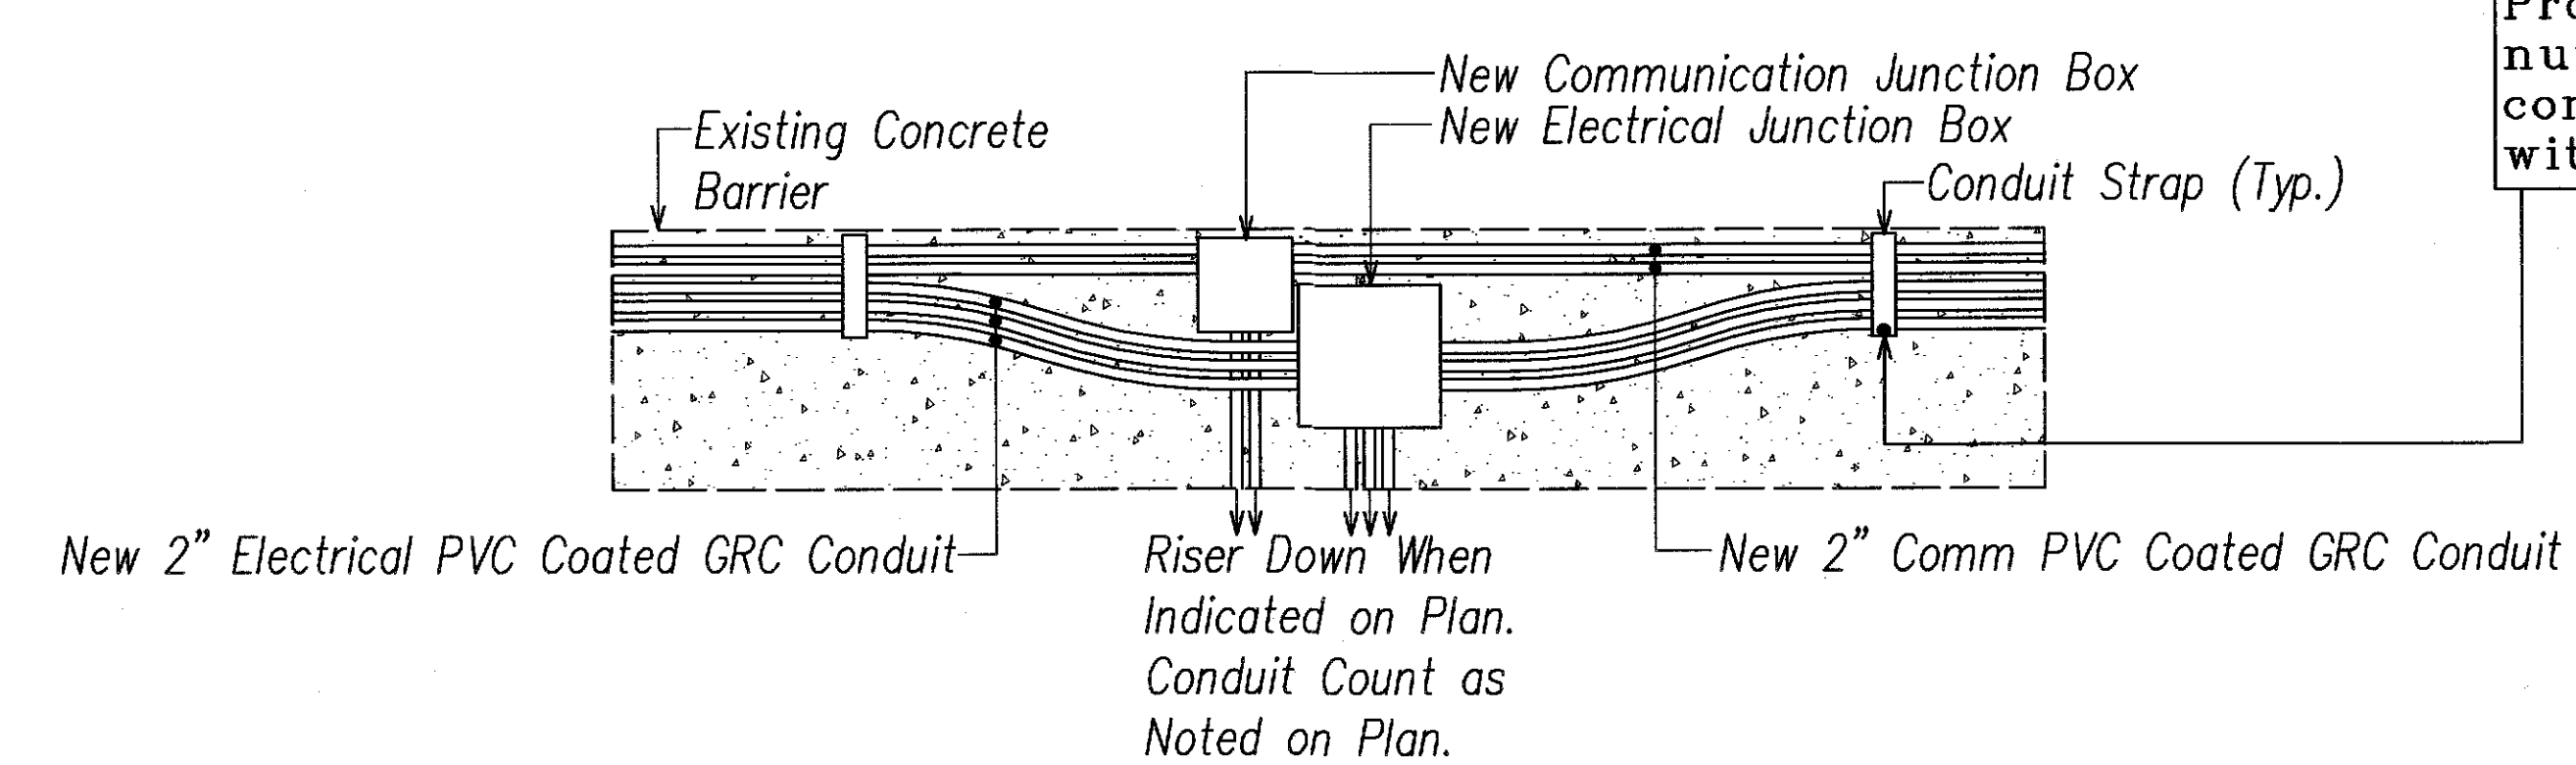


**B**  
**E-24** **Typical Junction Box/Conduit Elevation Detail**  
NOT TO SCALE

Provided additional supports on flex conduits 5' and longer. (Typ.)

**LEGEND FOR AS-BUILT POSTINGS**

|  |                                     |
|--|-------------------------------------|
|  | Squiggly line for as-built deletion |
|  | Double line for as-built deletion   |
|  | Text for as-built posting           |

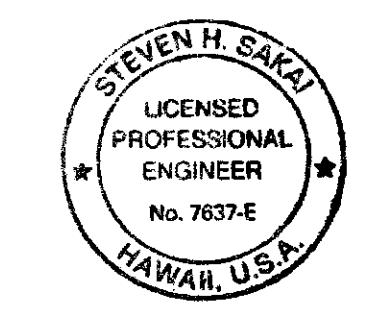

| NO. | DATE   | REVISION                                                  |
|-----|--------|-----------------------------------------------------------|
| 1   | 8/8/13 | ADDED SPRING NUTS, ADDITIONAL UNISTRUTS FOR FLEX CONDUITS |

STATE OF HAWAII  
DEPARTMENT OF TRANSPORTATION  
HIGHWAYS DIVISION

**Conduit Installation Detail**

Freeway Management System, Phase 1C,  
Part 1A: Communication and  
Power Infrastructure  
Federal Aid Project No. 1M-0300(123)

SCALE: As Noted DATE: 3-28-11

SHEET No. E-24 OF 26 SHEETS

ORIGINAL PLAN  
DRAWN BY  
DESIGNED BY  
NOTED BY  
CHECKED BY  
DATE  
NO.

LAST DATE: 10/04/13  
2. AS-BUILT PROJECTS: 12/00/10, 12/00/11, 12/00/12, 12/00/99, 12/00/100