




FED. ROAD DIST. NO.	STATE	FEDERAL AID PROJ. NO.	FISCAL YEAR	SHEET NO.	TOTAL SHEETS
HAWAII	HAW.	IM-0300(123)	2011	33	65

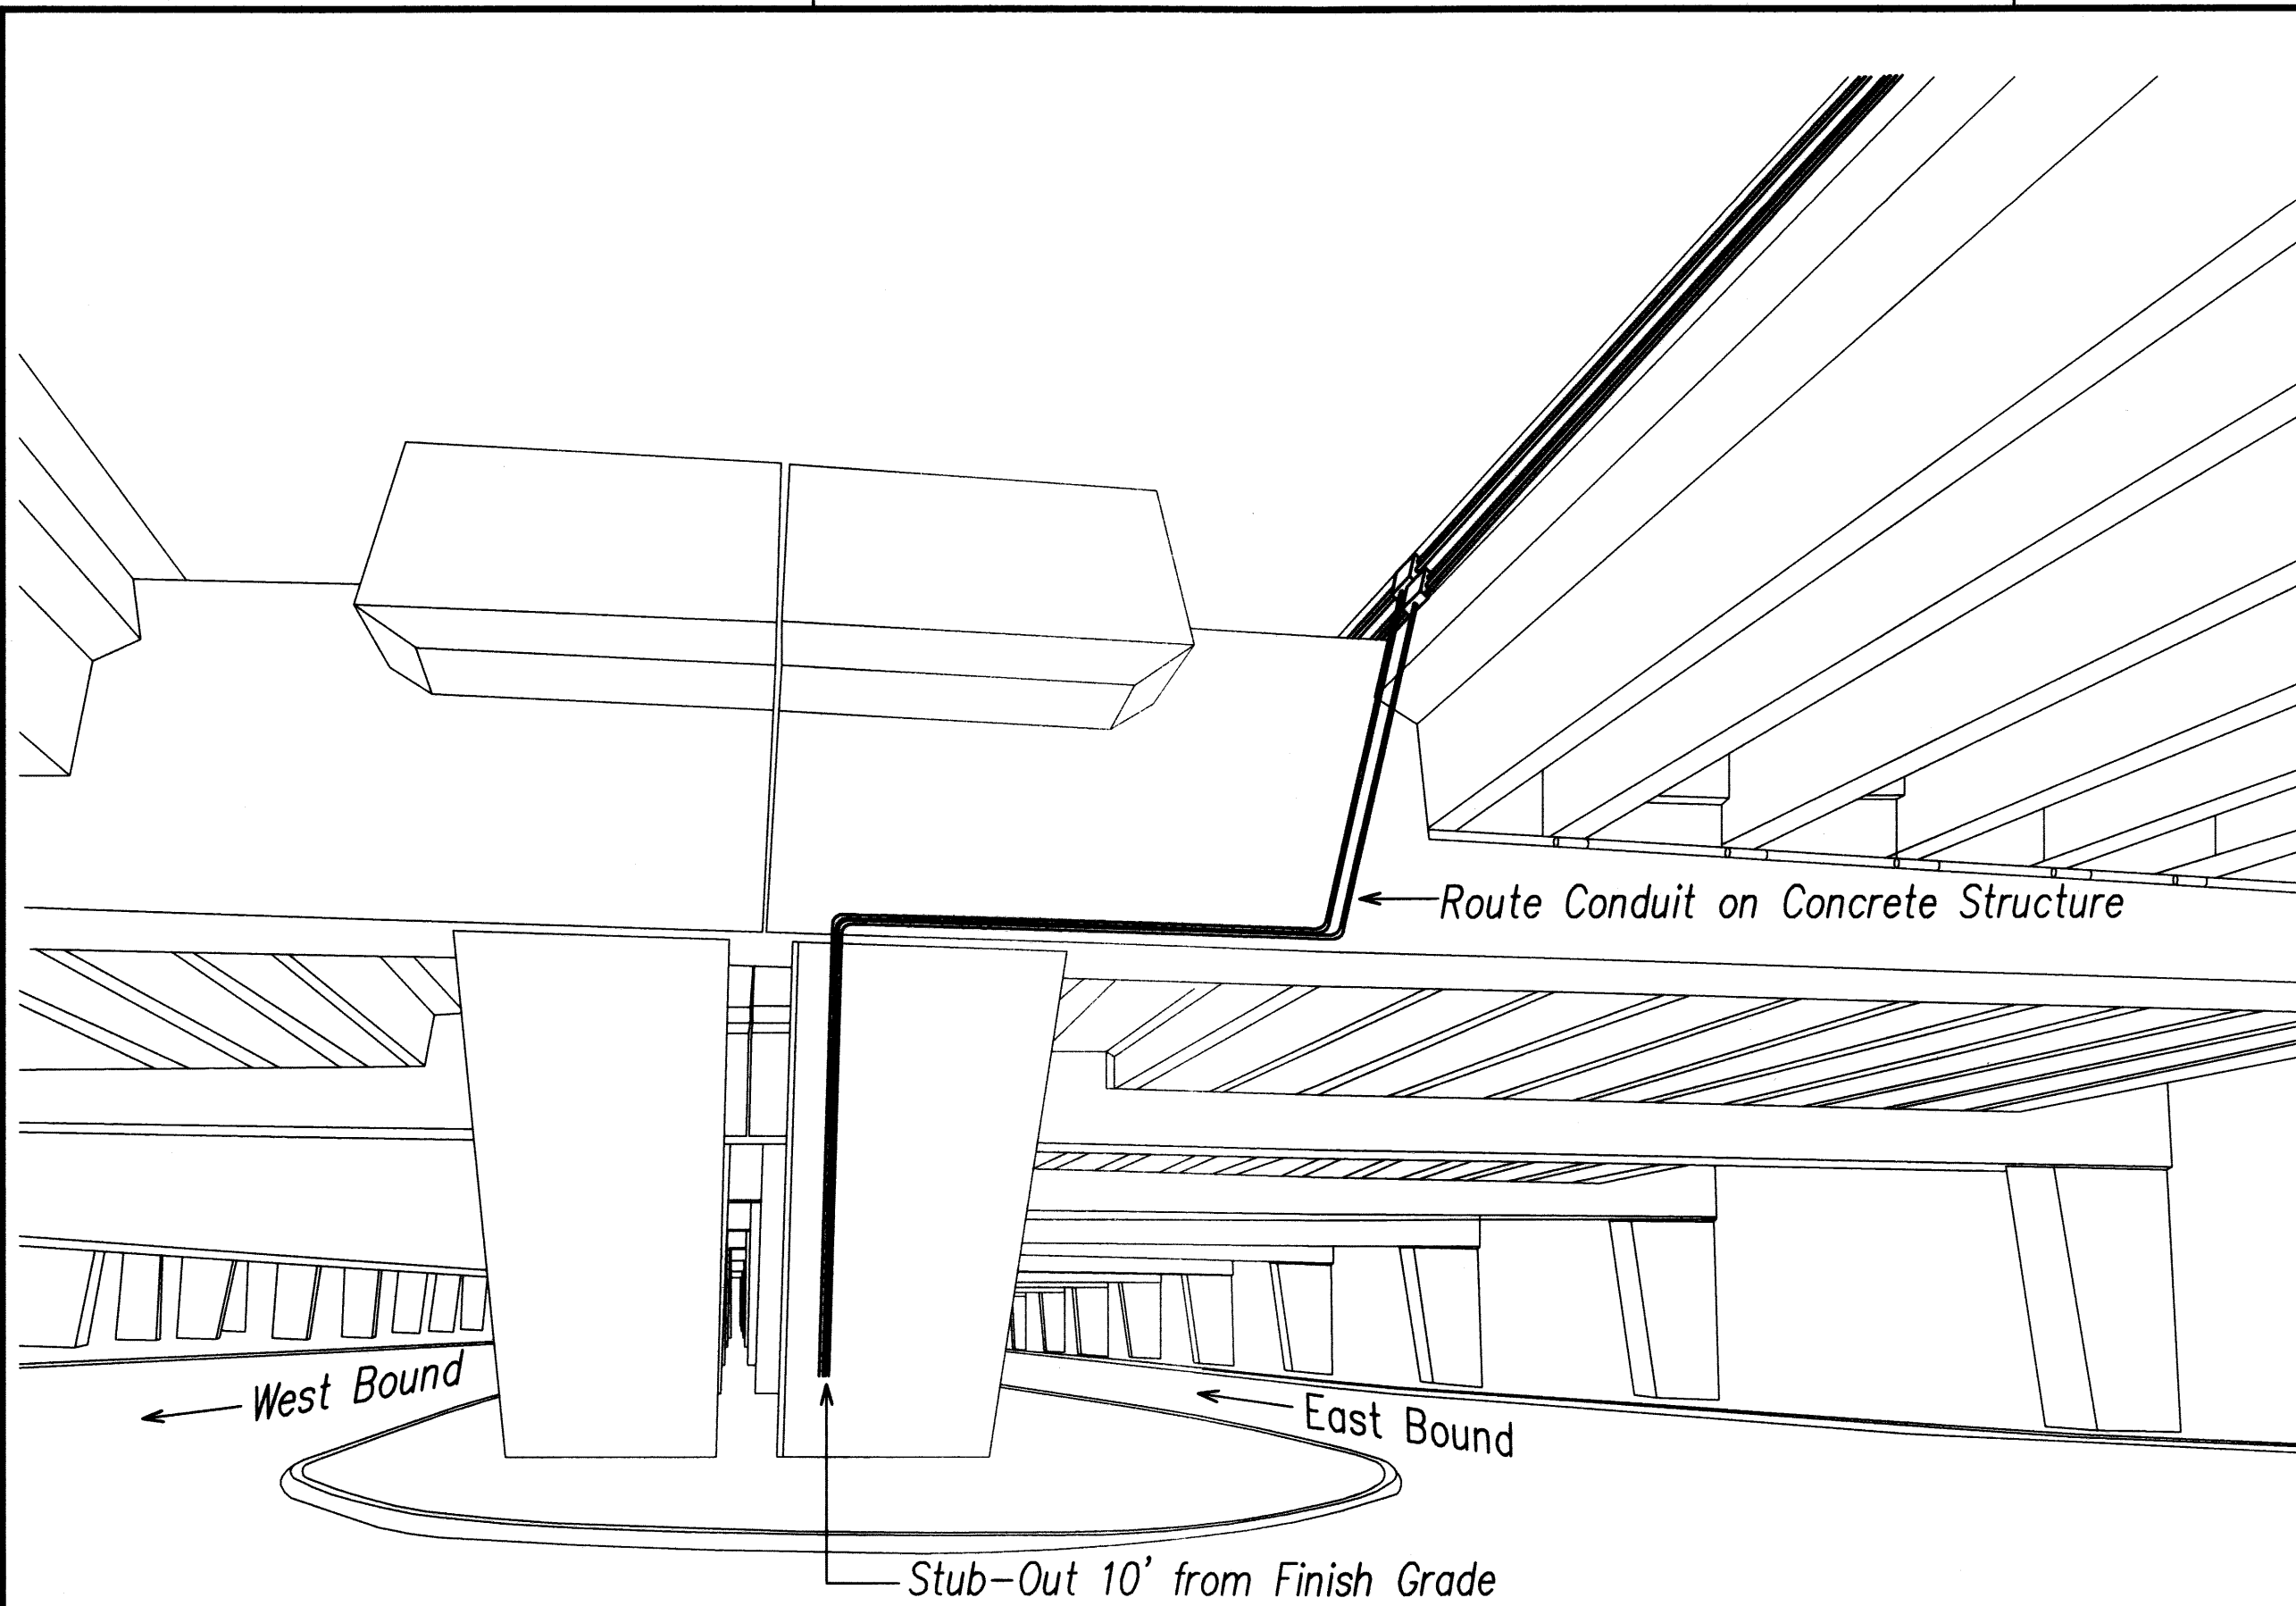

A
E-25 *Typical Viaduct Conduit Routing*
NOT TO SCALE

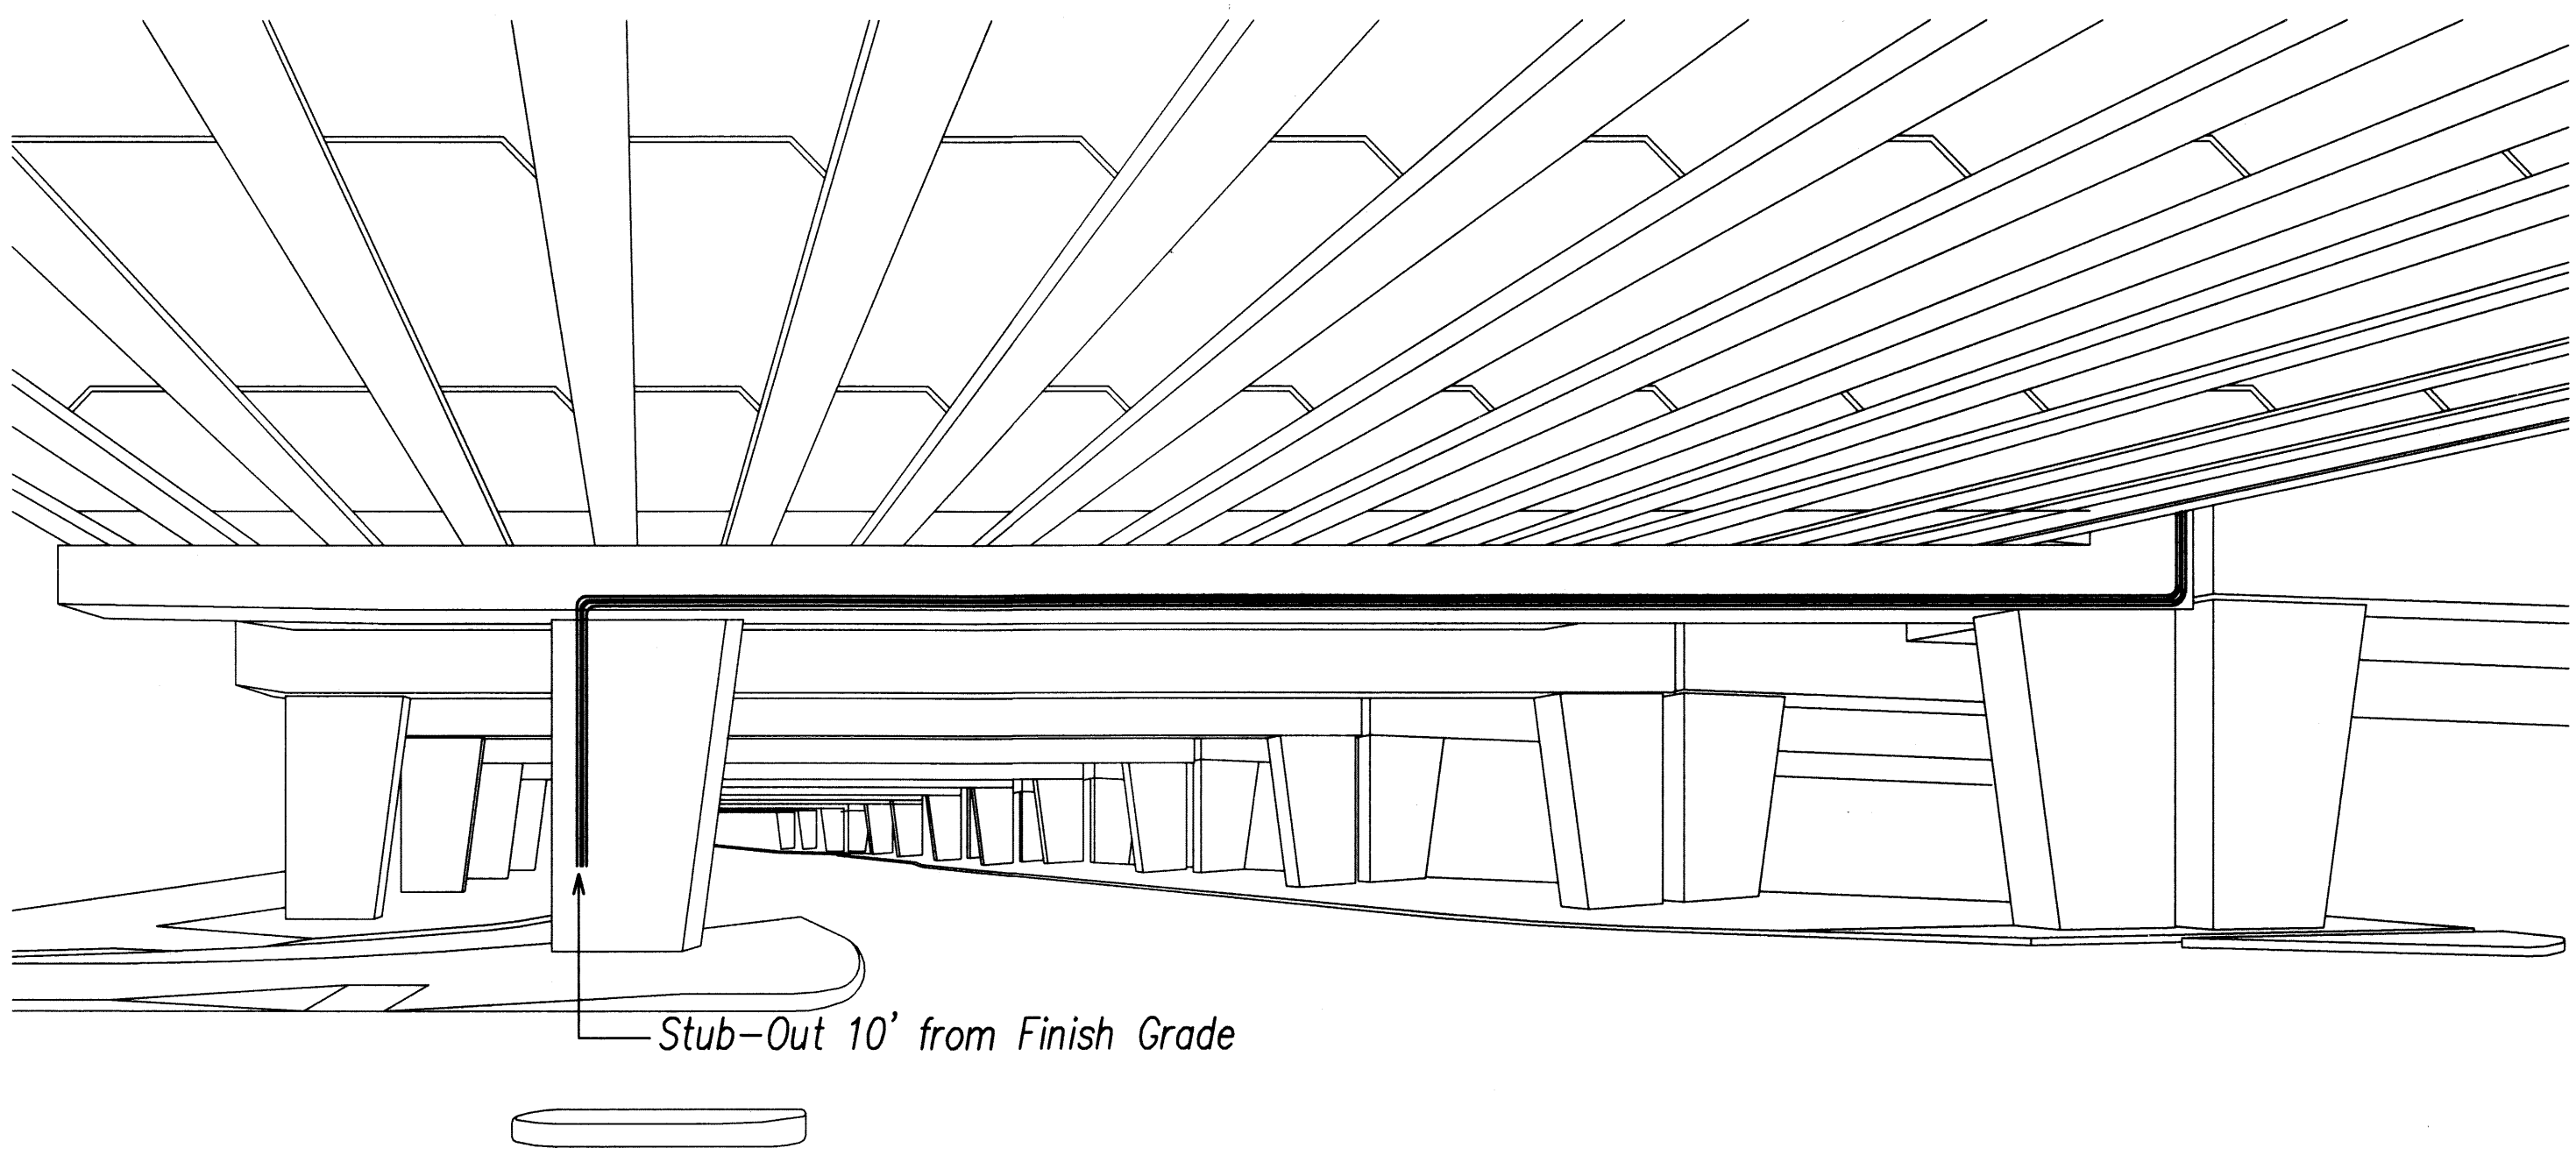

B
E-25 *Puuloa/Lagoon Drive Viaduct Conduit Routing*
NOT TO SCALE

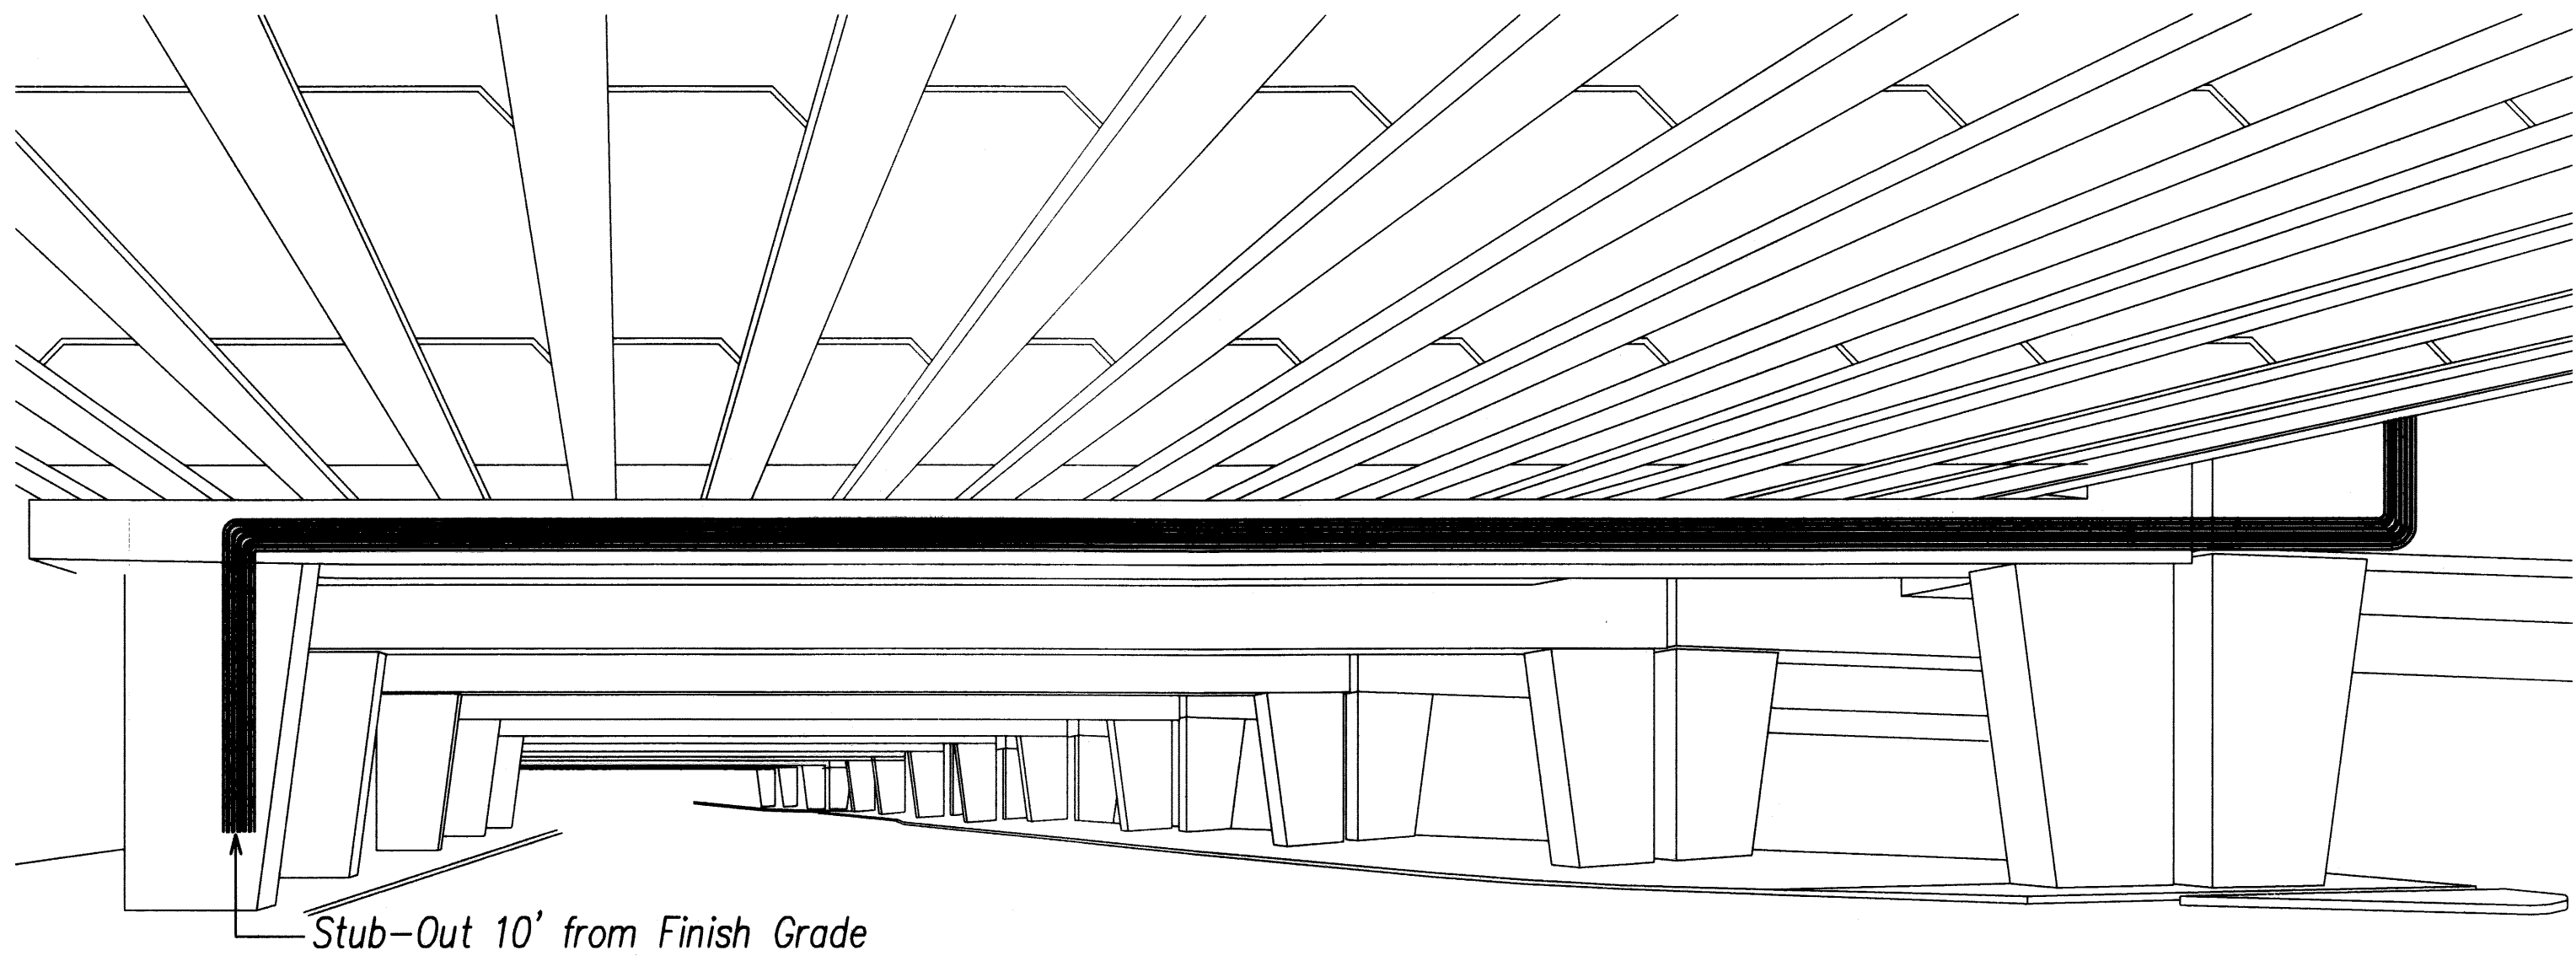

C
E-25 *Various Viaduct Conduit Routing*
NOT TO SCALE

ORIGINAL PLAN	SURVEY PLOTTED BY	DATE
NOTED	DRAWN BY	
	DESIGNED BY	
	QUANTITIES BY	
	CHECKED BY	
	IN CHARGE	

LAST DATE OF REVISION: 08/25/11 BY: [Signature] PROJECT: [Project Name] SHEET: 33 OF 65

NO.	DATE	REVISION

STATE OF HAWAII
DEPARTMENT OF TRANSPORTATION
HIGHWAYS DIVISION


Viaduct Conduit Routing

*Freeway Management System, Phase 1C,
Part 1A: Communication and
Power Infrastructure*

Federal Aid Project No. IM-0300(123)


SCALE: As Noted DATE: 3-28-11

SHEET No. E-25 OF 26 SHEETS

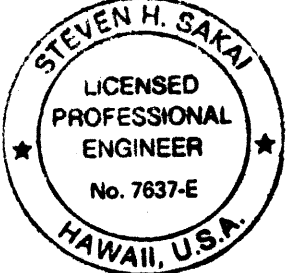


[Signature]
THIS WORK WAS PREPARED BY ME
OR UNDER MY SUPERVISION
DATE: 4/20/12


FED. ROAD DIST. NO.	STATE	FEDERAL AID PROJ. NO.	FISCAL YEAR	SHEET NO.	TOTAL SHEET
HAWAII	HAW.	IM-0300(123)	2011	34	65

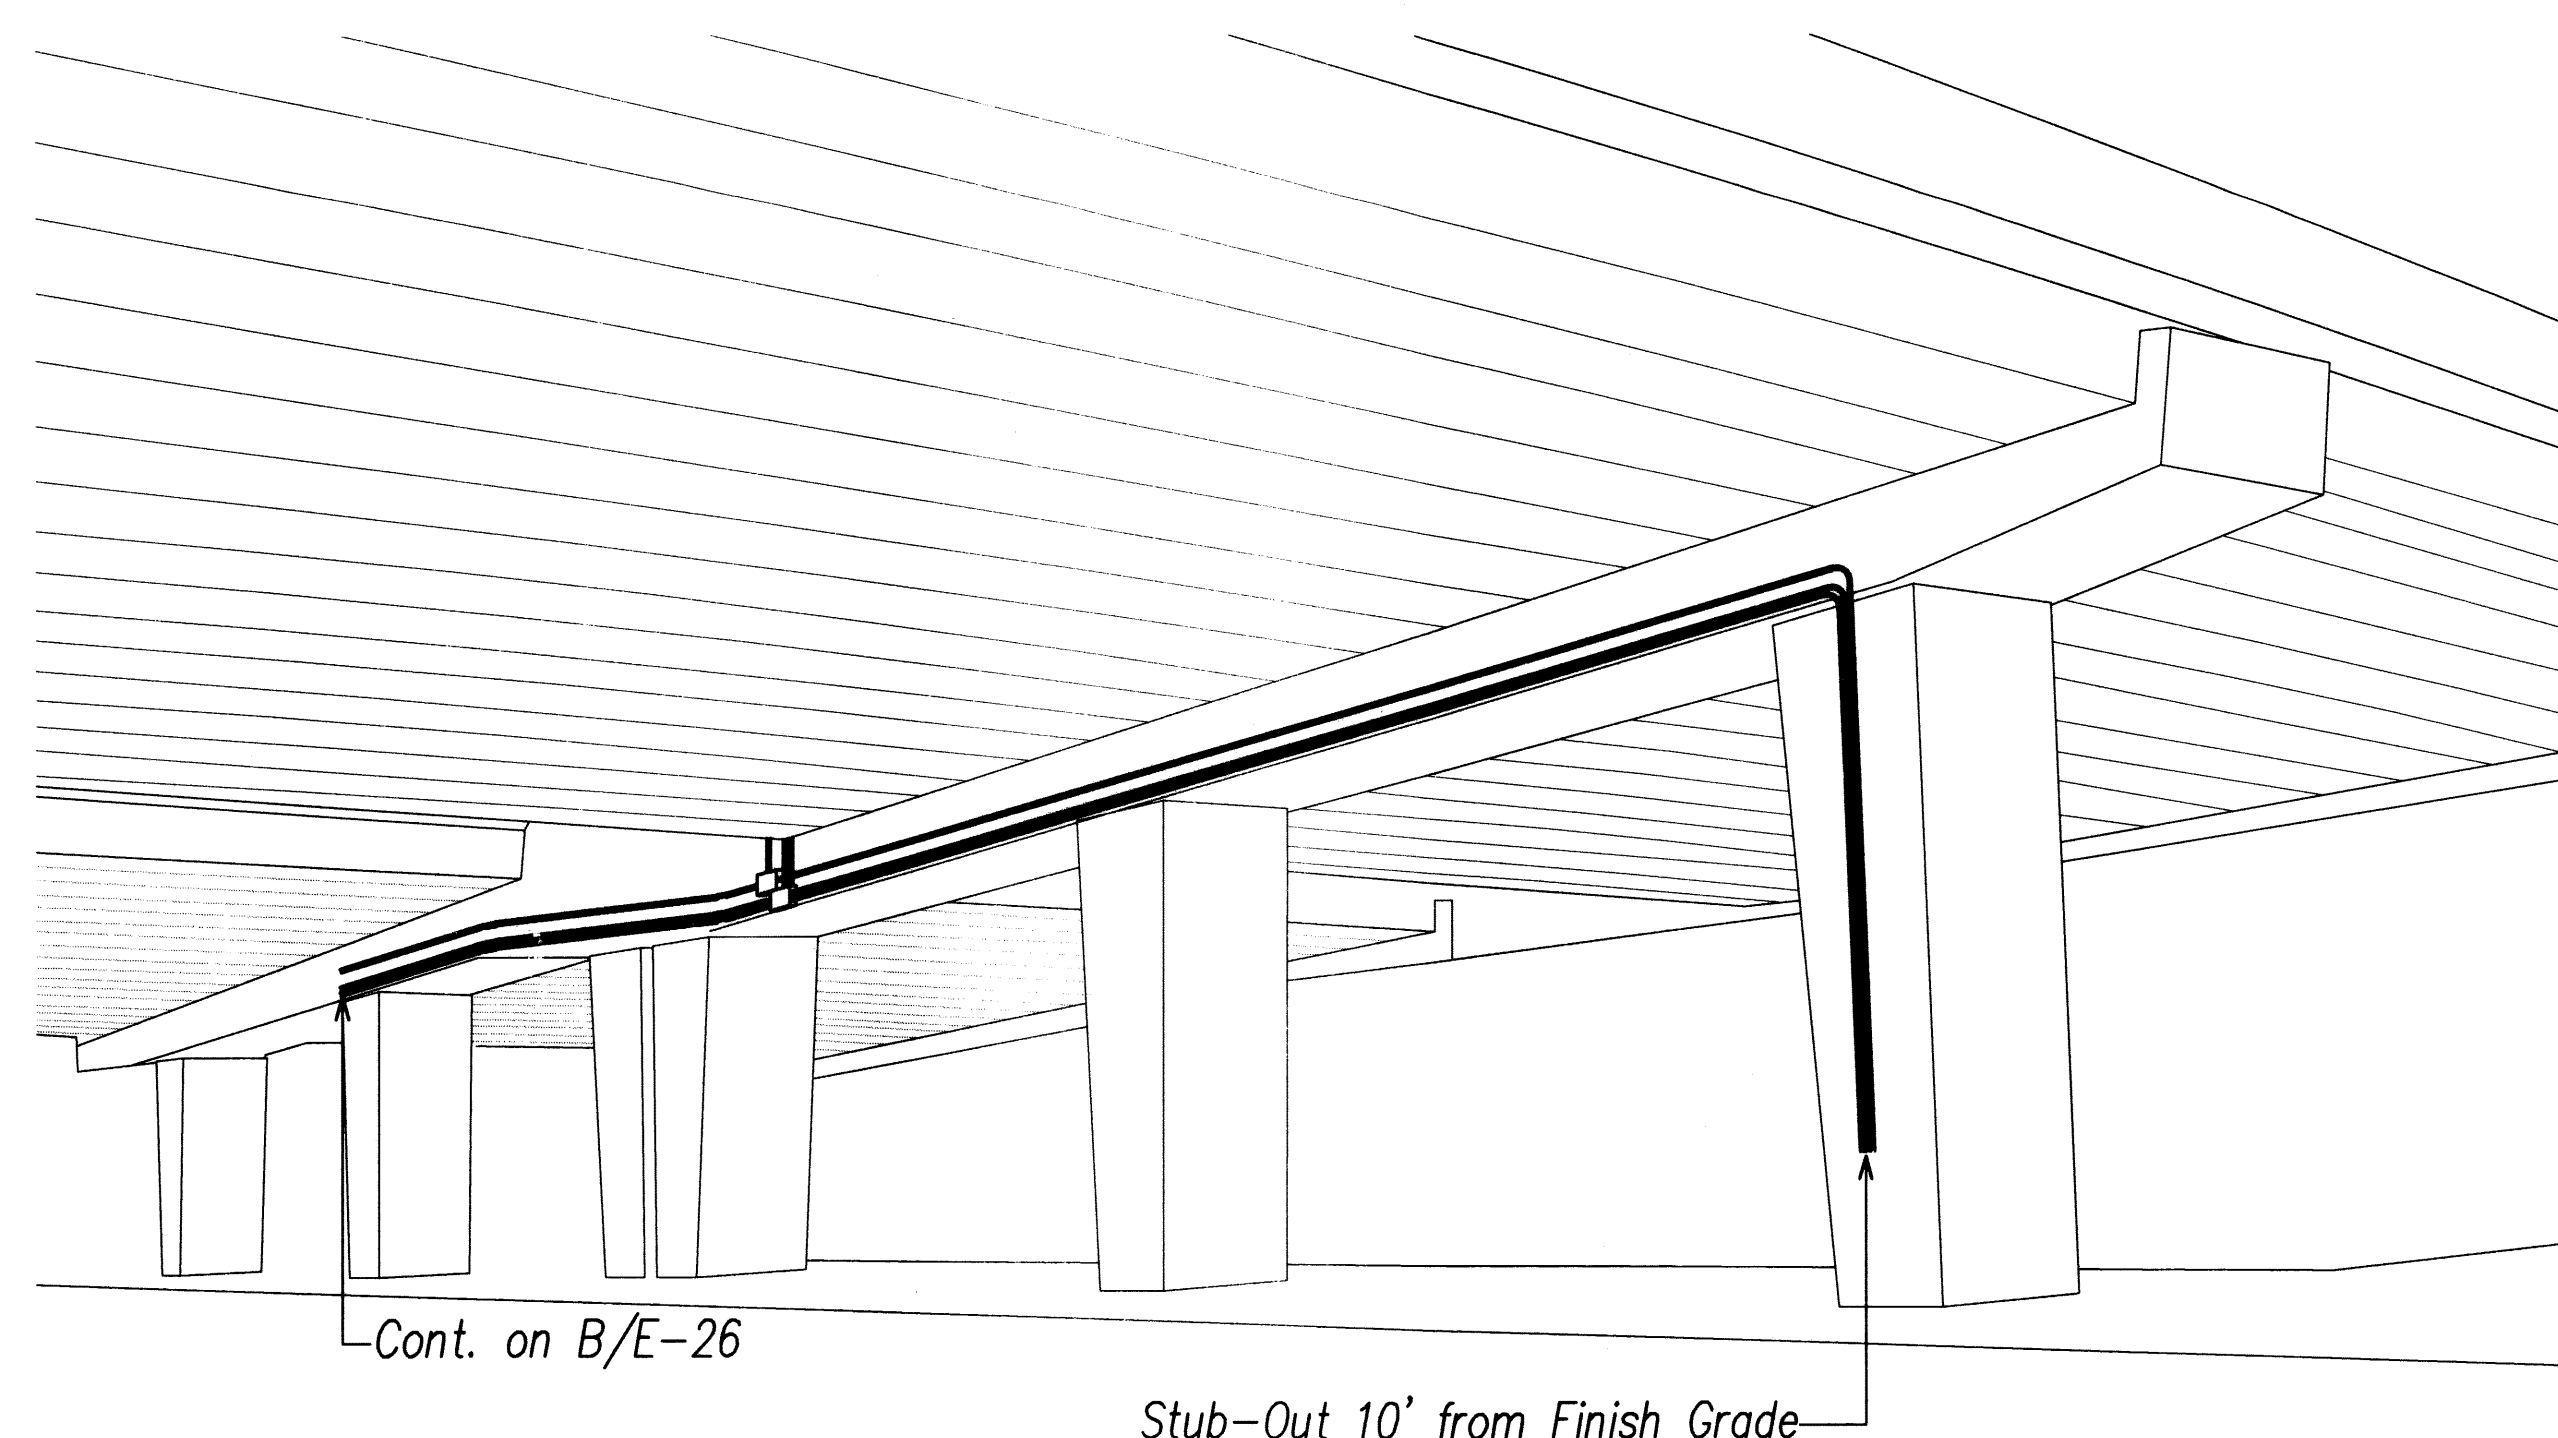


 Valkenburg Conduit Routing
NOT TO SCALE

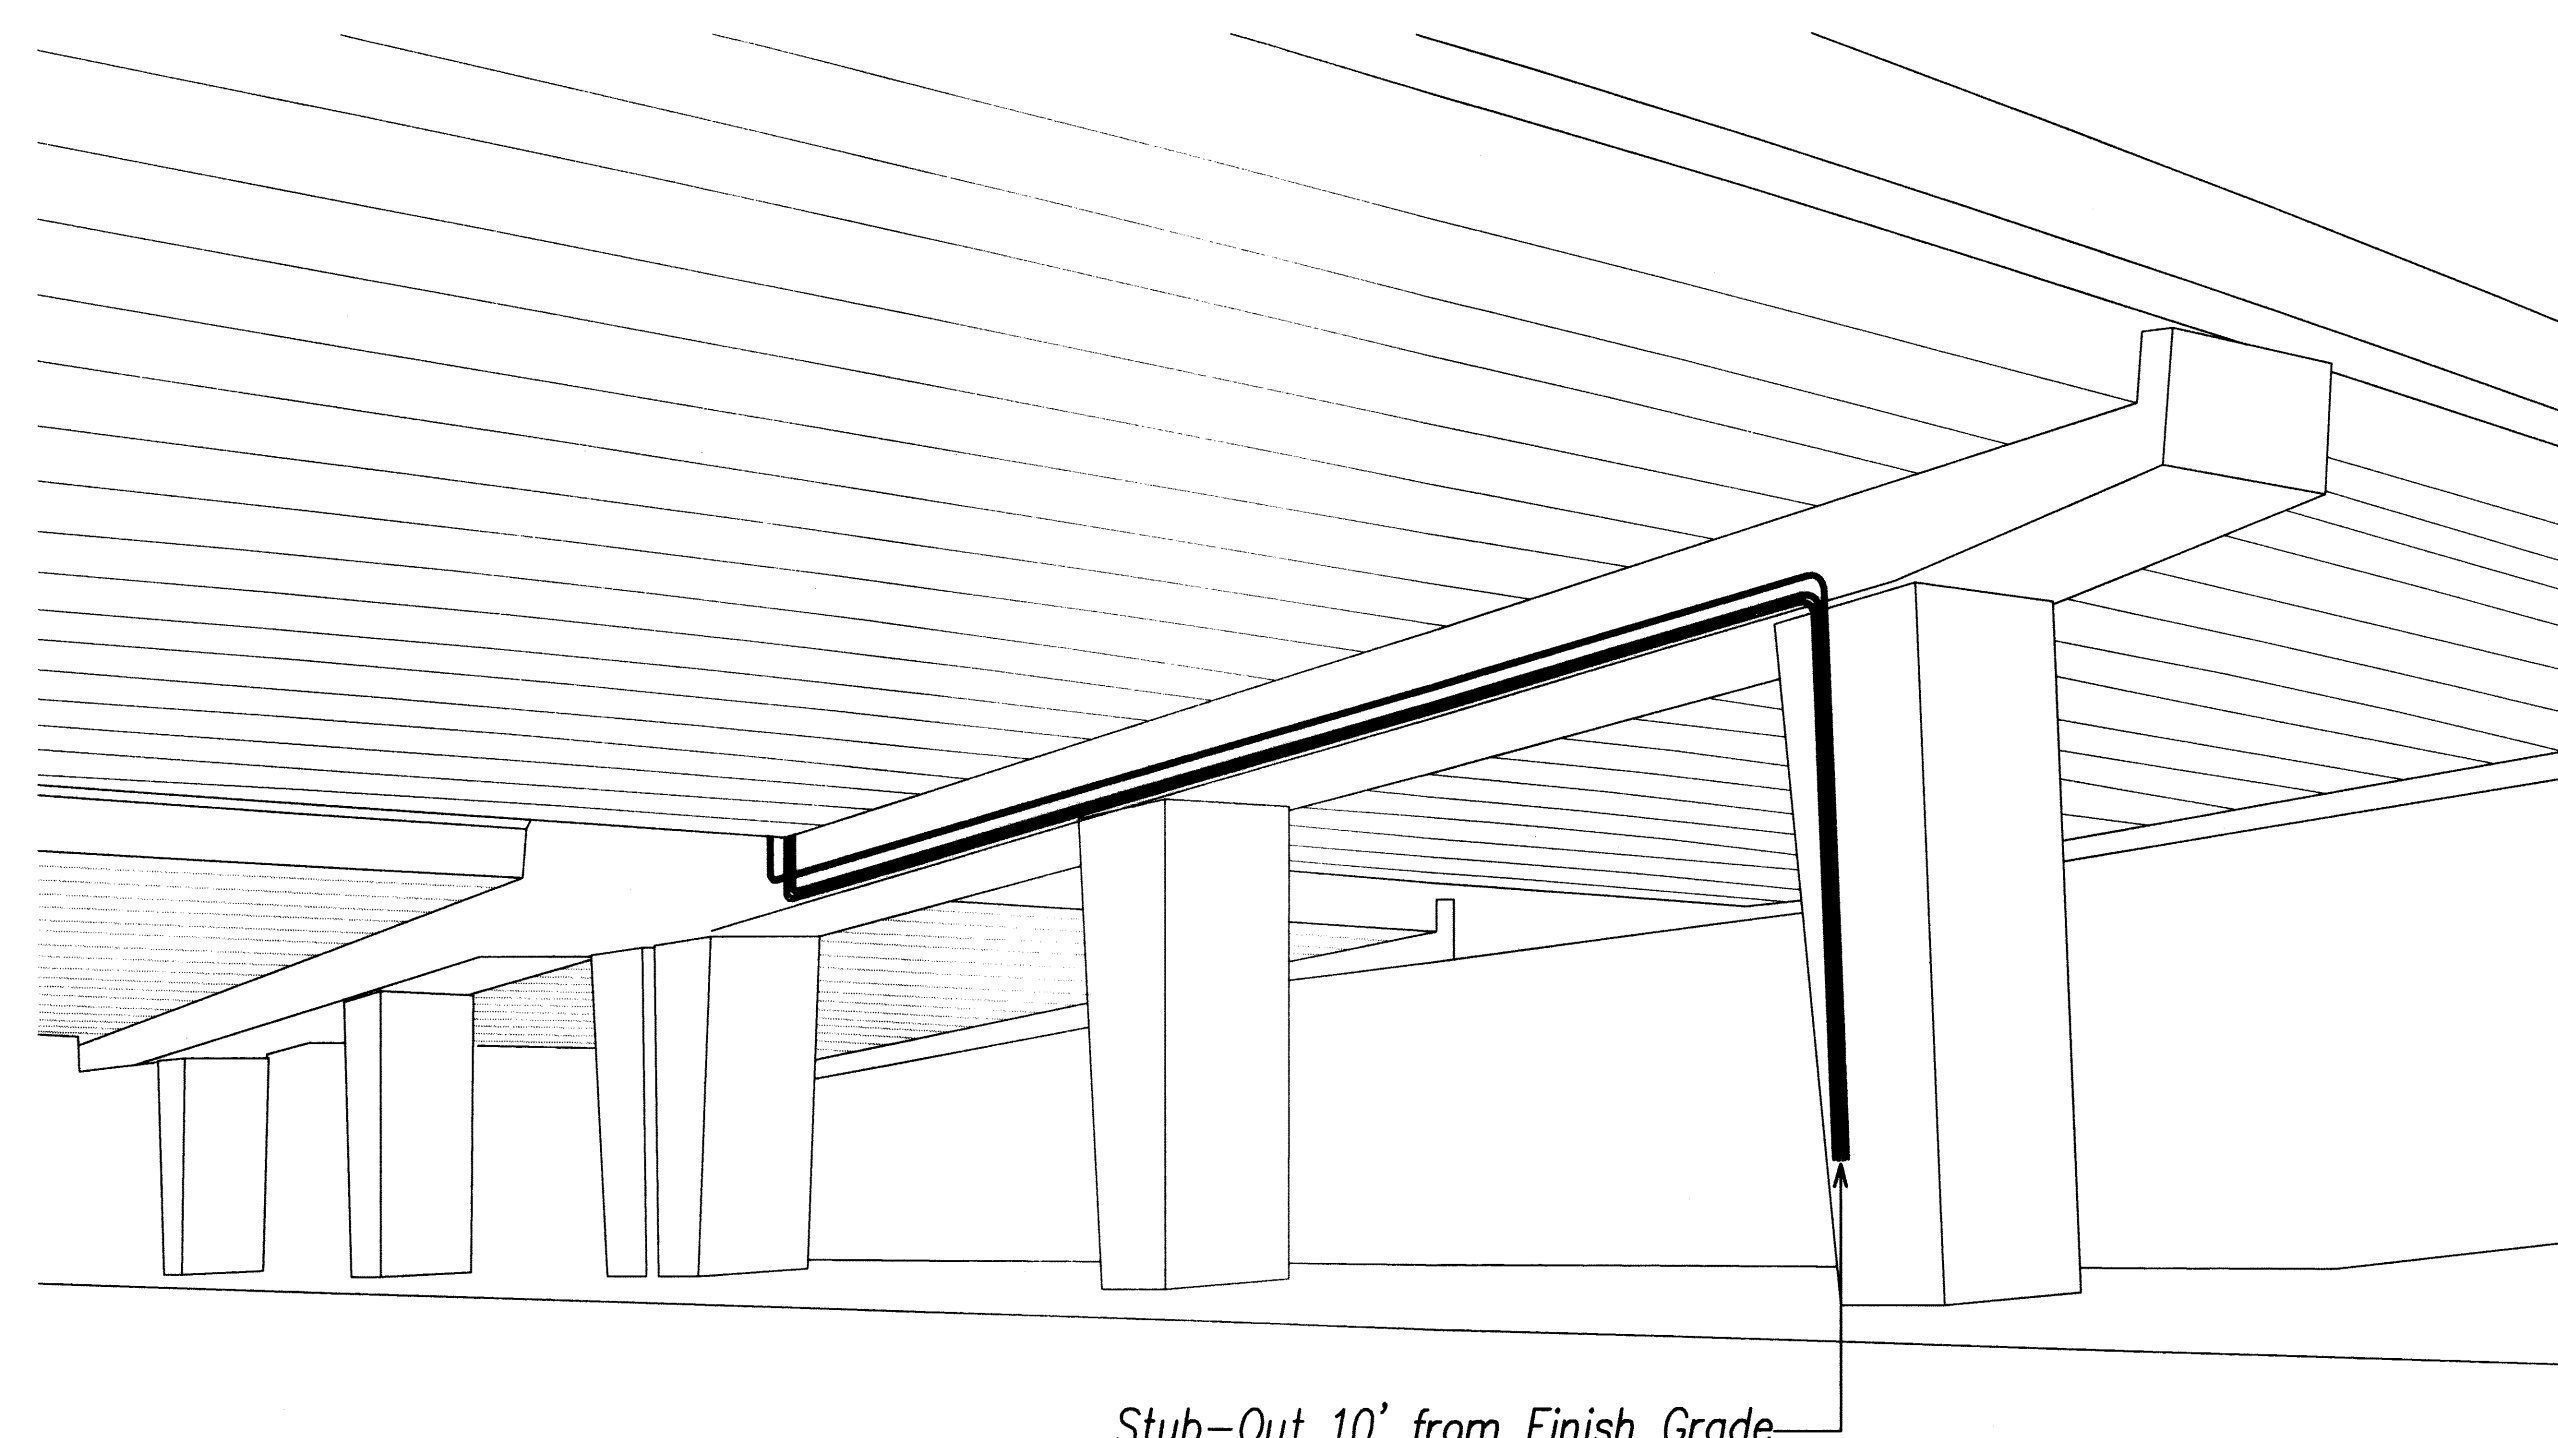


 Valkenburg Conduit Routing
NOT TO SCALE

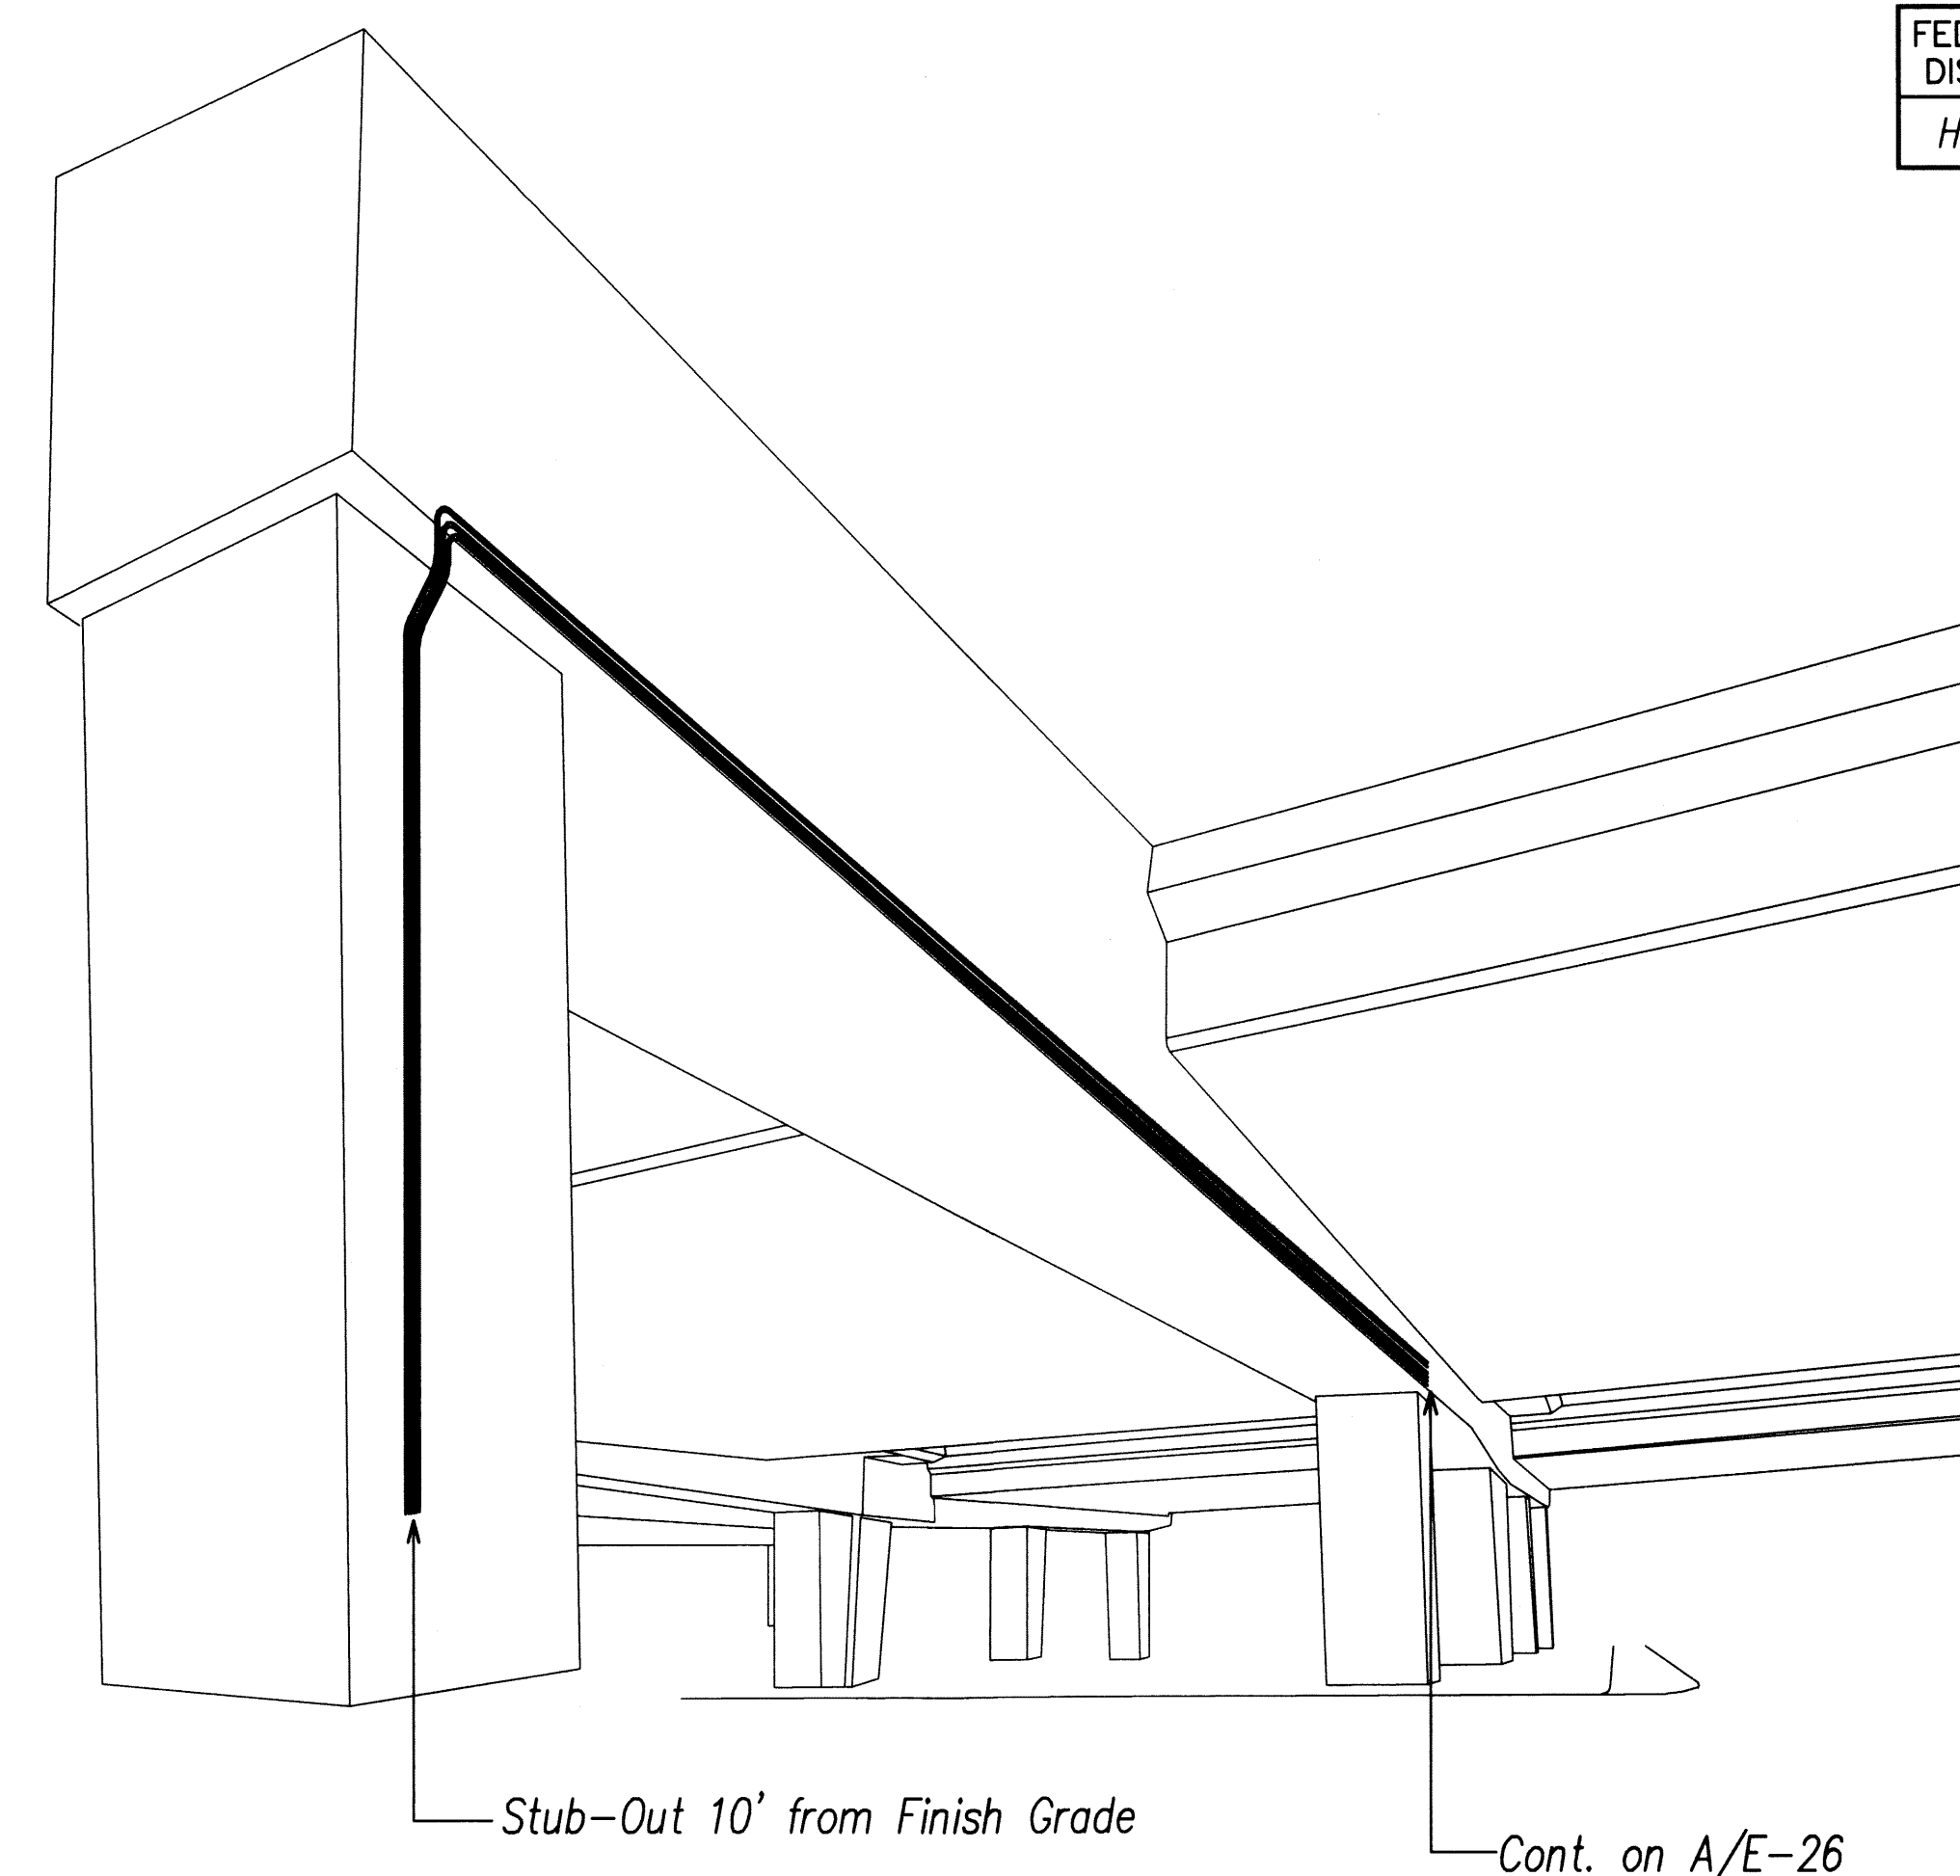

 Valkenburgh Conduit Routing
NOT TO SCALE

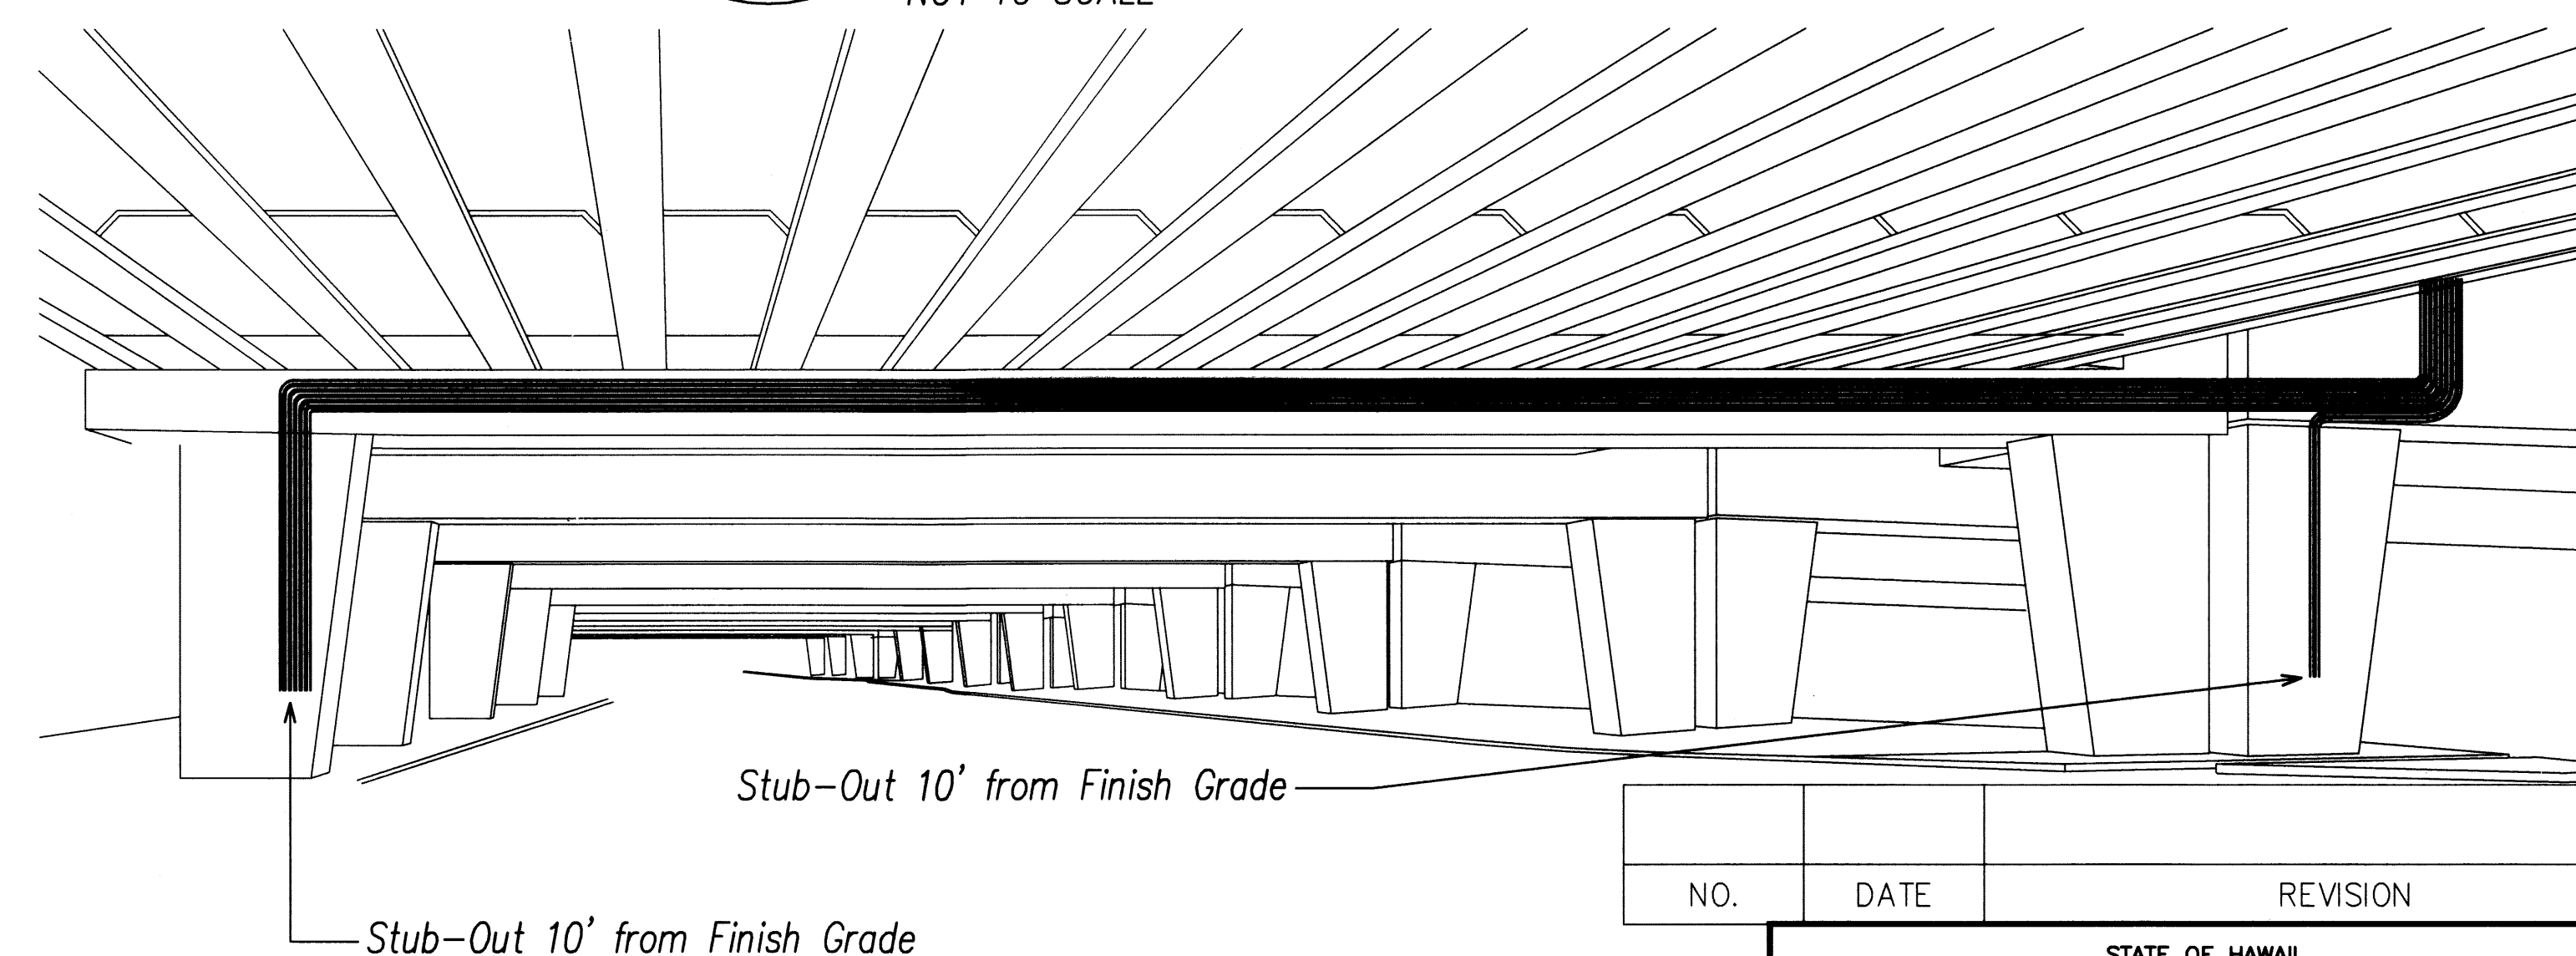

 Ohohia Viaduct Conduit Routing
NOT TO SCALE

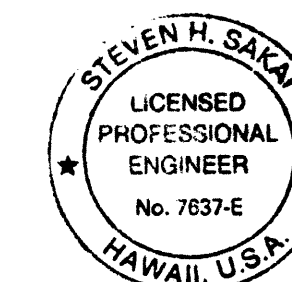

THIS WORK WAS PREPARED BY ME
OR UNDER MY SUPERVISION

NO.	DATE	REVISION

STATE OF HAWAII
DEPARTMENT OF TRANSPORTATION
HIGHWAYS DIVISION
Valkenburg Conduit Routing

Freeway Management System, Phase 1C,
Part 1A: Communication and
Power Infrastructure
Federal Aid Project No. 1M-0300(123)

SCALE: As Noted DATE: 3-28-11

SHEET No. E-26 OF 26 SHEETS