




FED. ROAD DIST. NO.	STATE	FEDERAL AID PROJ. NO.	FISCAL YEAR	SHEET NO.	TOTAL SHEETS
HAWAII	HAW.	IM-0300(123)	2011	12	65

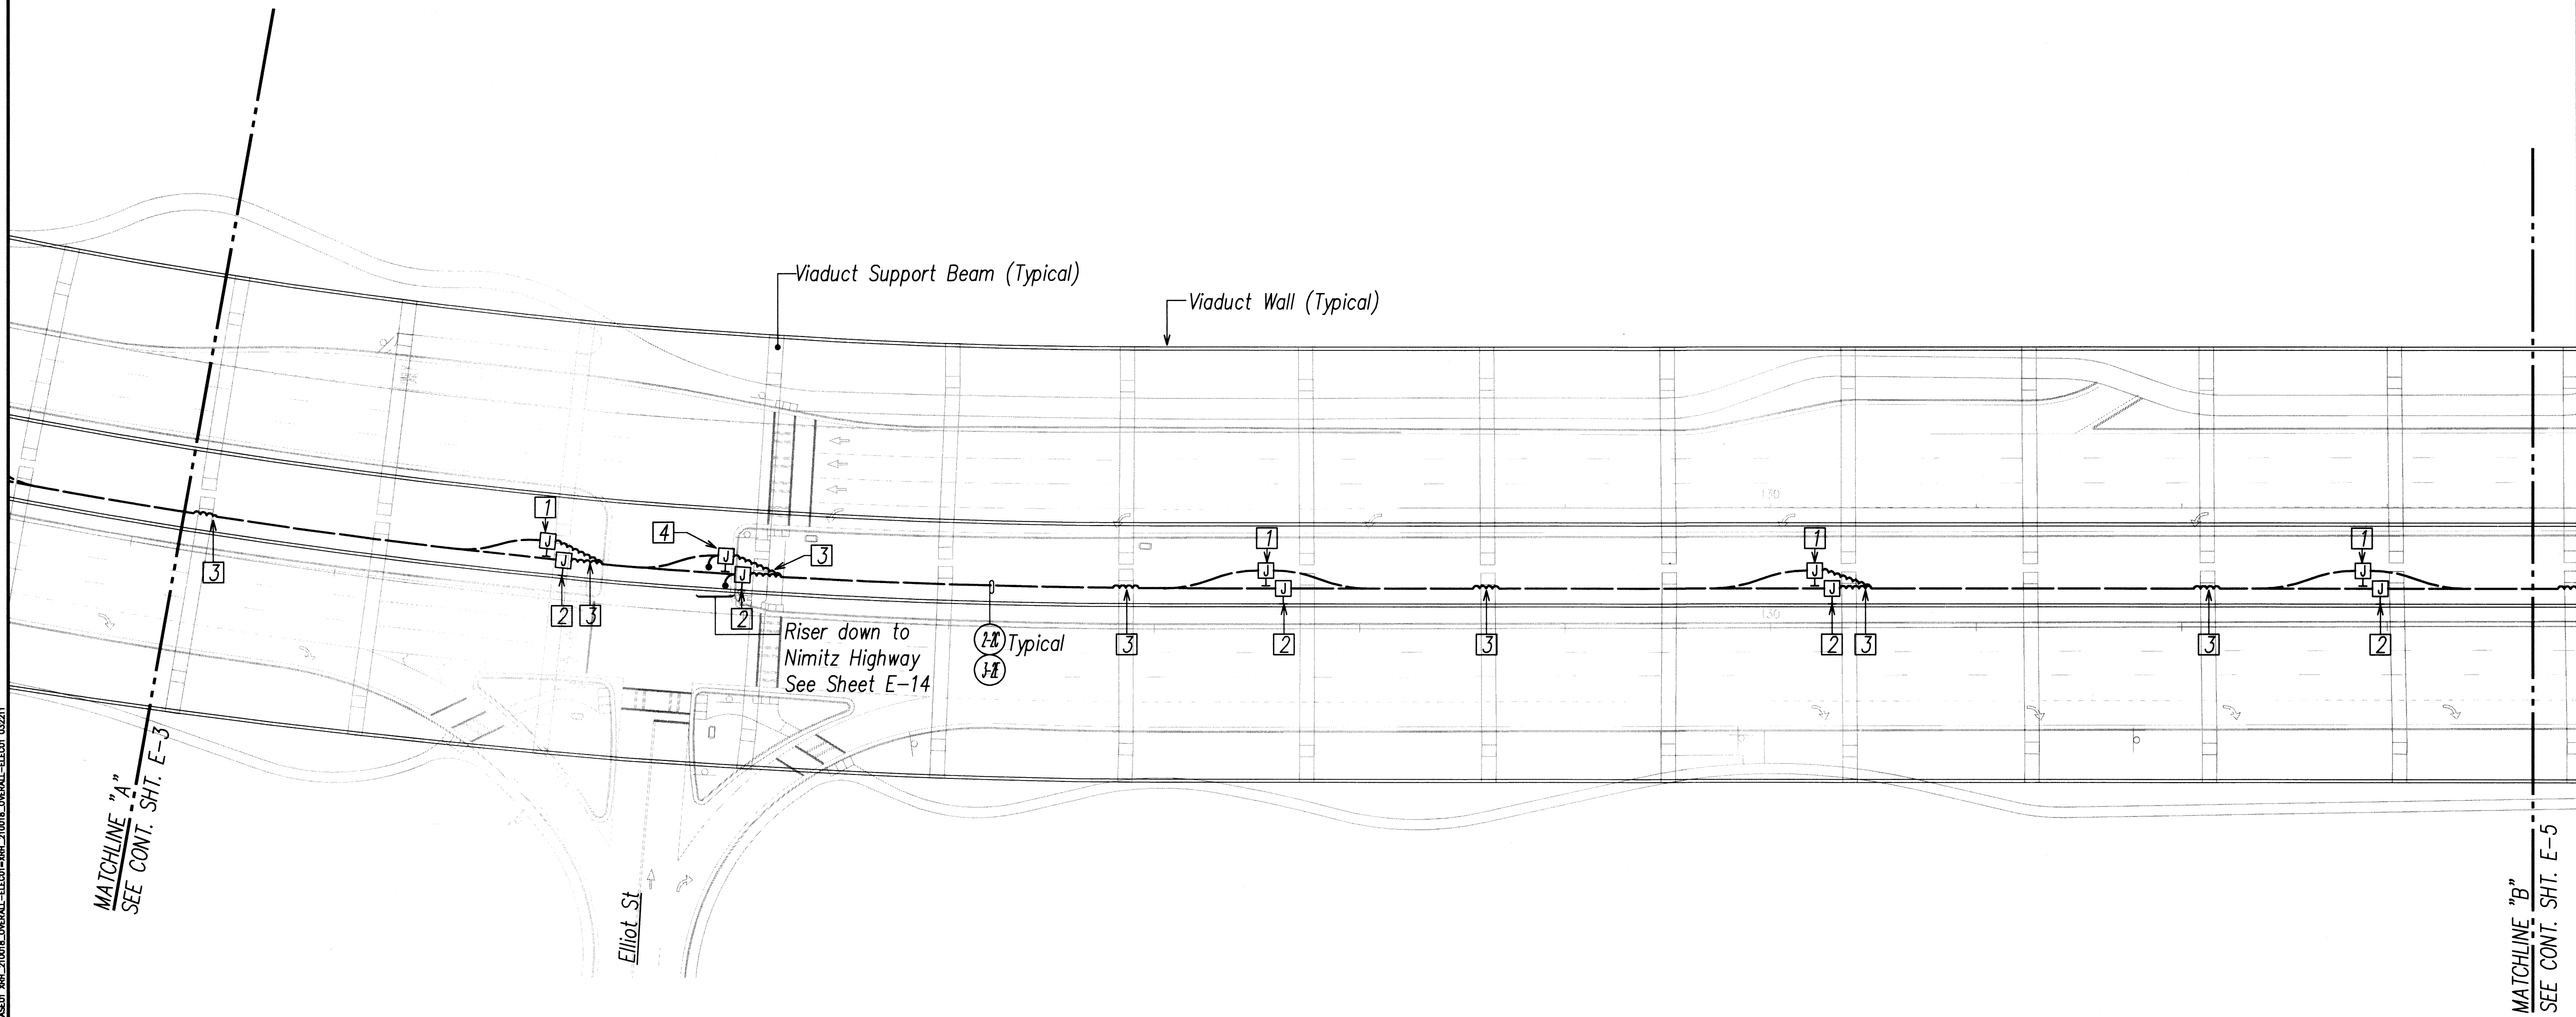



NOTE(S):

- 1 32" X 32" X 8" SS Communication Junction Box
- 2 36" X 36" X 8" SS Electrical Junction Box
- 3 Provide Flex Conduit at Viaduct Construction Joint.
- 4 32" X 32" X 12" SS Communication Junction Box



Electrical Distribution Plan 2

SCALE: 1"=40'

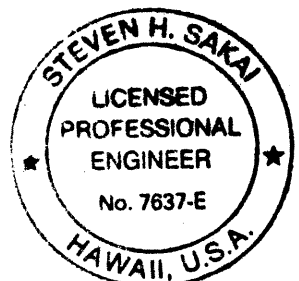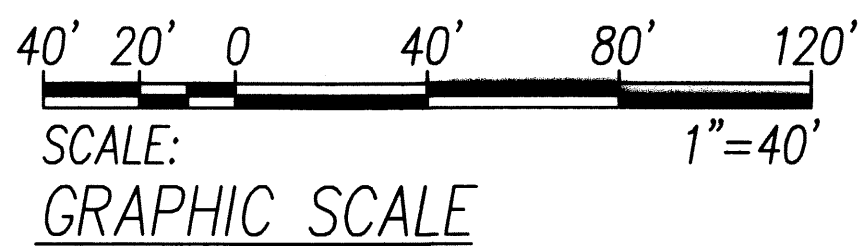

THIS WORK WAS PREPARED BY ME  
OR UNDER MY SUPERVISION  
EXP. 4/20/12

NO.	DATE	REVISION

STATE OF HAWAII  
DEPARTMENT OF TRANSPORTATION  
HIGHWAYS DIVISION


**Electrical Distribution Plan 2**

Freeway Management System, Phase 1C,  
Part 1A: Communication and  
Power Infrastructure  
Federal Aid Project No. IM-0300(123)

SCALE: As Noted      DATE: 3-28-11

**SHEET No. E-4 OF 28 SHEETS**

FED. ROAD DIST. NO.	STATE	FEDERAL AID PROJ. NO.	FISCAL YEAR	SHEET NO.	TOTAL SHEETS
HAWAII	HAW.	IM-0300(123)	2011	13	65


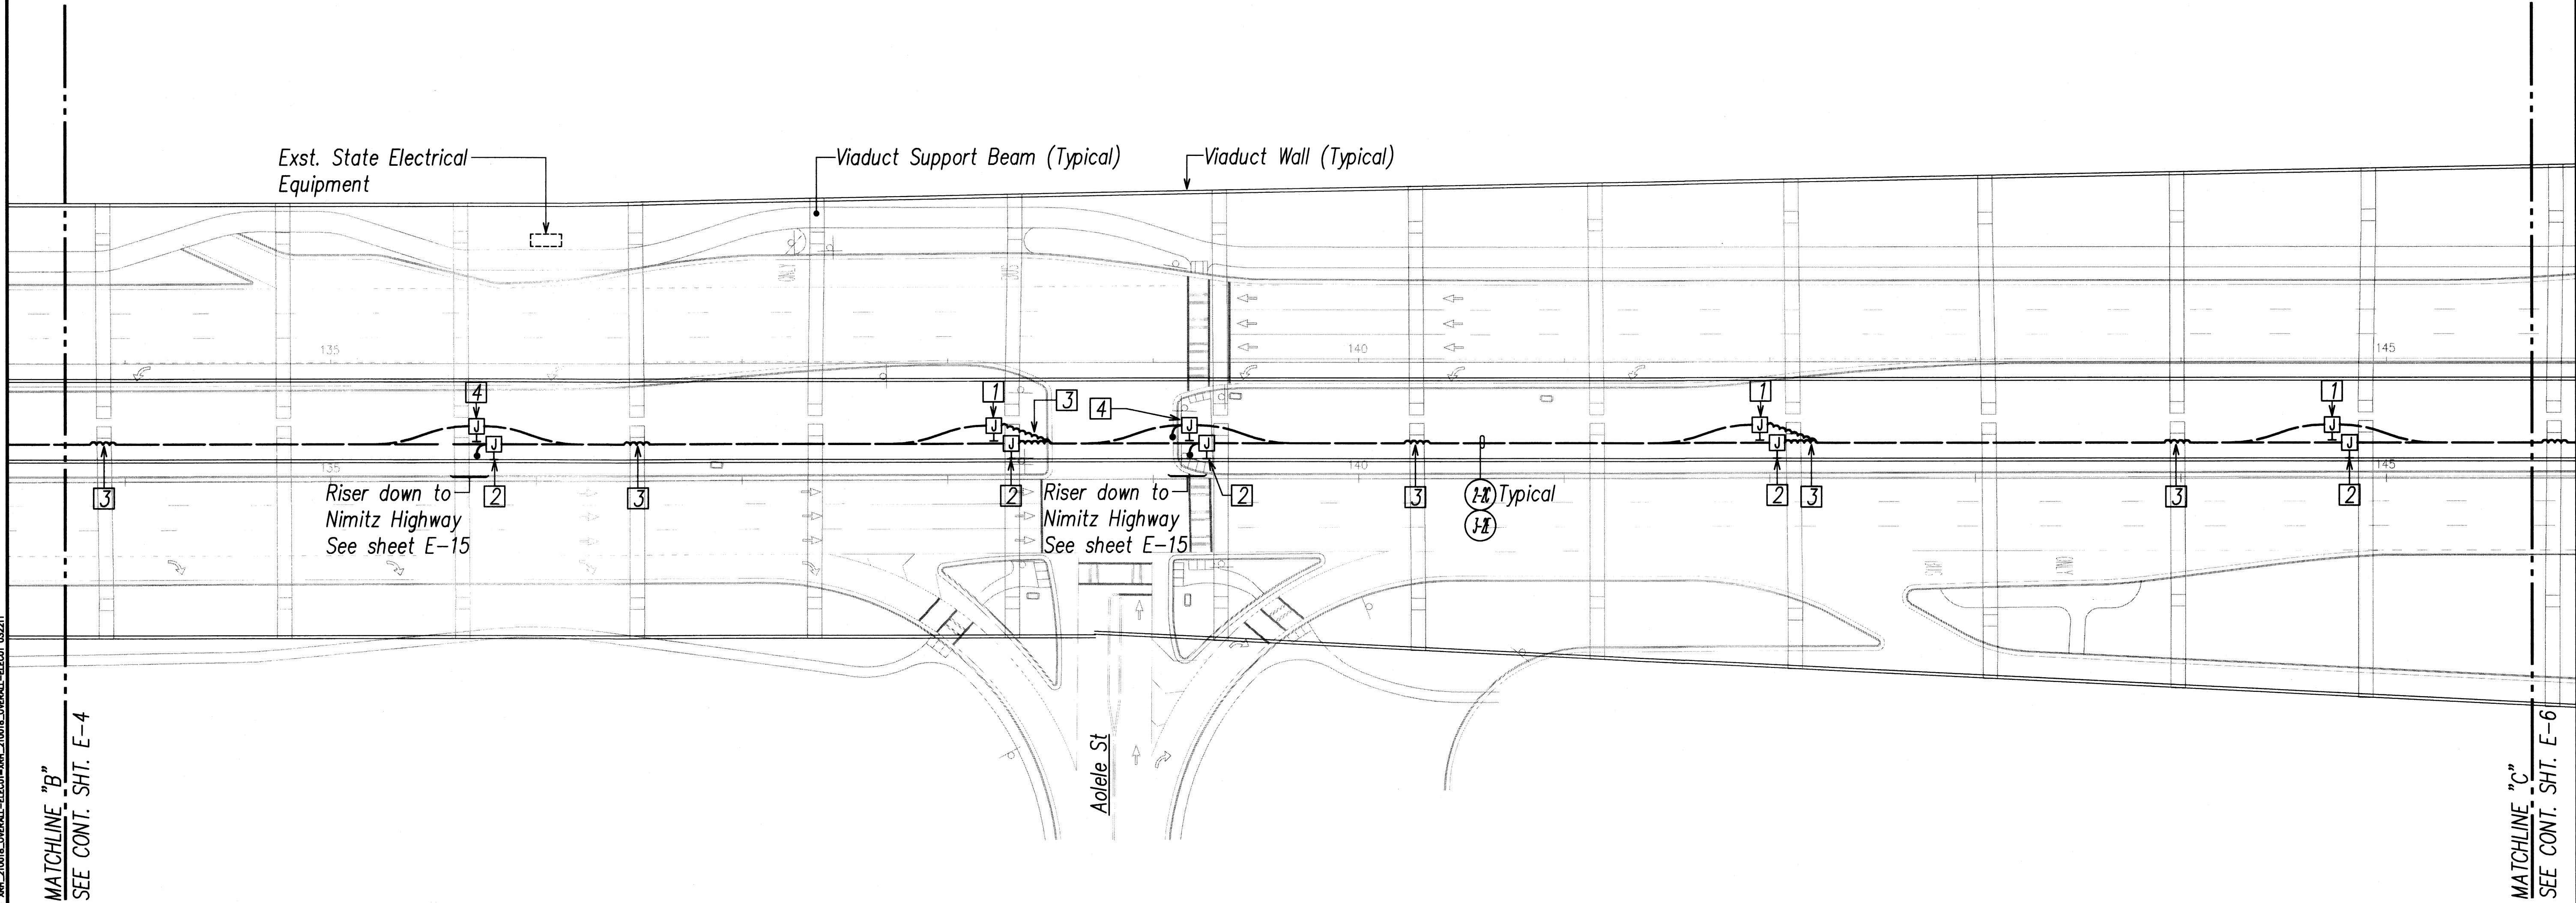


NOTE(S):

- 1 32" X 32" X 8" SS Communication Junction Box
- 2 36" X 36" X 8" SS Electrical Junction Box
- 3 Provide Flex Conduit at Viaduct Construction Joint.
- 4 32" X 32" X 12" SS Communication Junction Box



Electrical Distribution Plan 3  
SCALE: 1"=40'

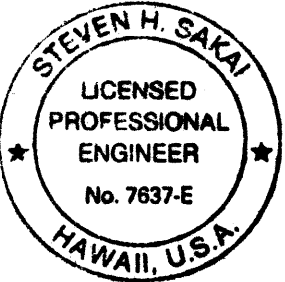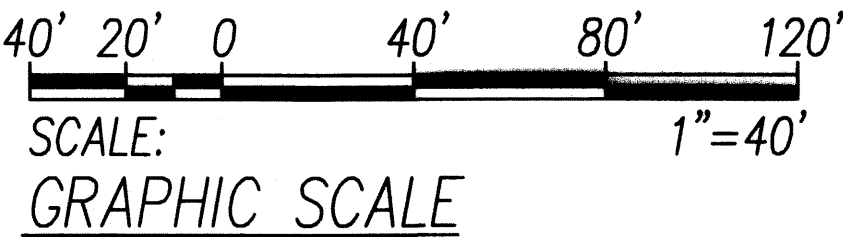

THIS WORK WAS PREPARED BY ME  
OR UNDER MY SUPERVISION  
EXP. 4/30/15

NO.	DATE	REVISION

STATE OF HAWAII  
DEPARTMENT OF TRANSPORTATION  
HIGHWAYS DIVISION

**Electrical Distribution Plan 3**


Freeway Management System, Phase 1C,  
Part 1A: Communication and  
Power Infrastructure  
Federal Aid Project No. IM-0300(123)

SCALE: As Noted DATE: 3-28-11

**SHEET No. E-5 OF 28 SHEETS**



FED. ROAD DIST. NO.	STATE	FEDERAL AID PROJ. NO.	FISCAL YEAR	SHEET NO.	TOTAL SHEETS
HAWAII	HAW.	IM-0300(123)	2011	14	65

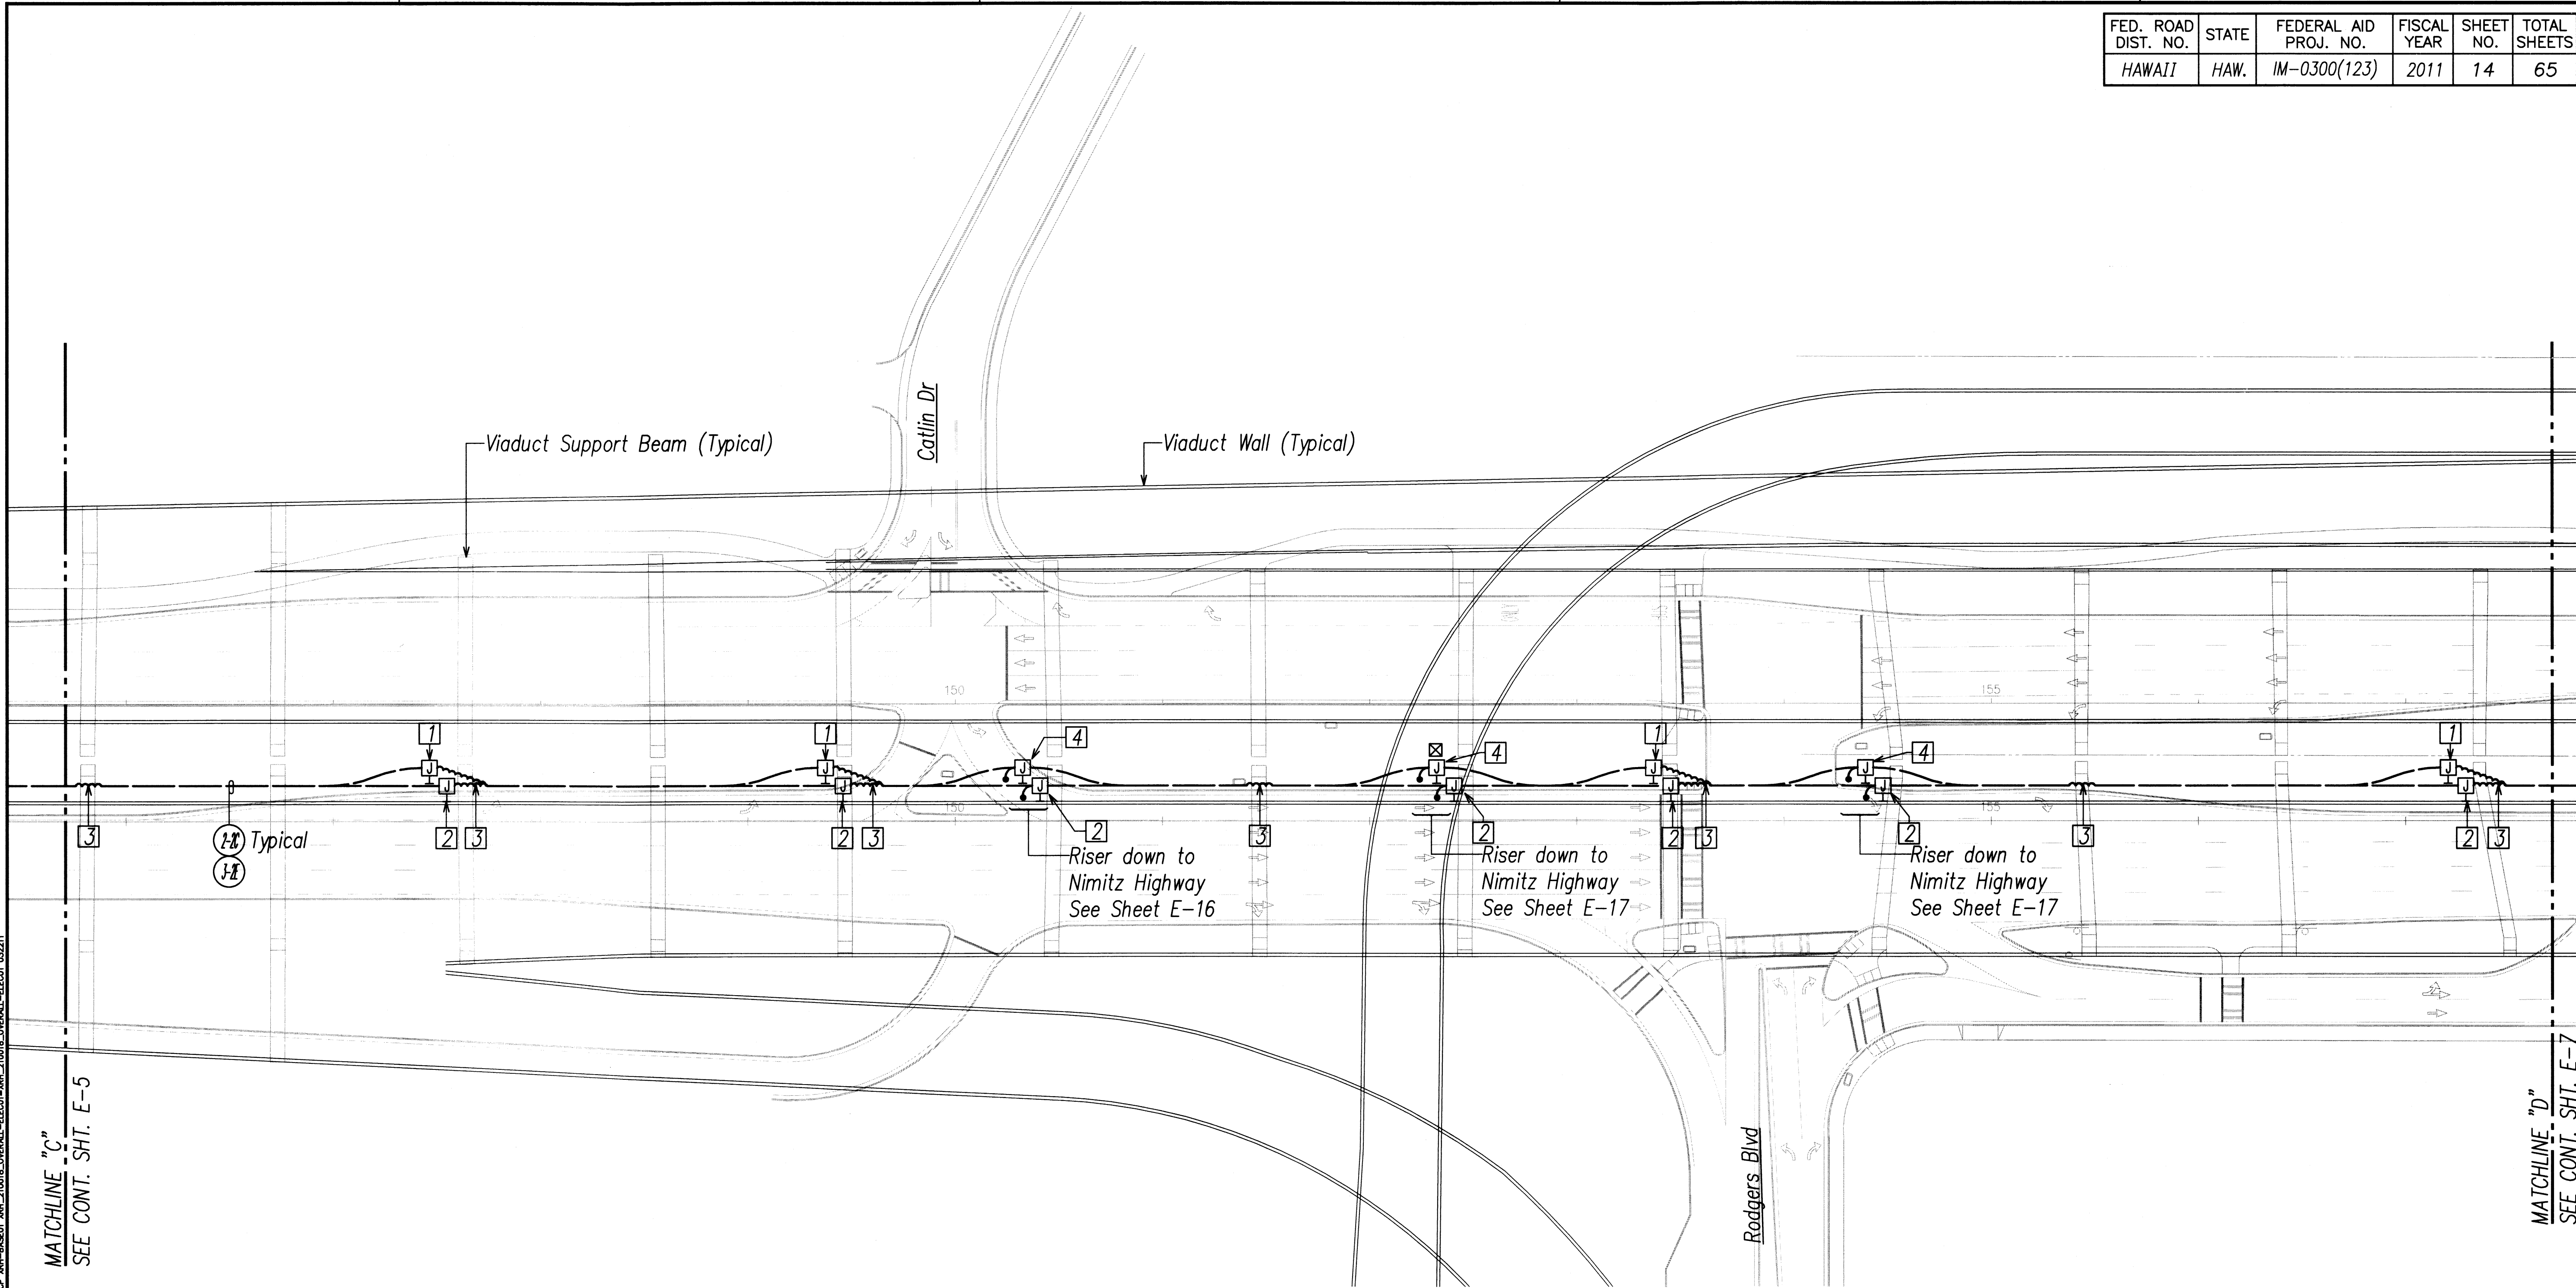

MATCHLINE "C"  
SEE CONT. SHT. E-5



MATCHLINE "D"  
SEE CONT. SHT. E-7

NOTE(S):

- 1 32" X 32" X 8" SS Communication Junction Box
- 2 36" X 36" X 8" SS Electrical Junction Box
- 3 Provide Flex Conduit at Viaduct Construction Joint.
- 4 32" X 32" X 12" SS Communication Junction Box



Electrical Distribution Plan 4  
SCALE: 1"=40'

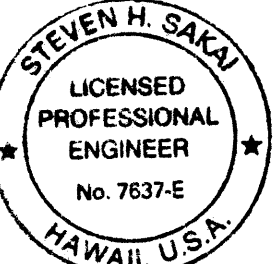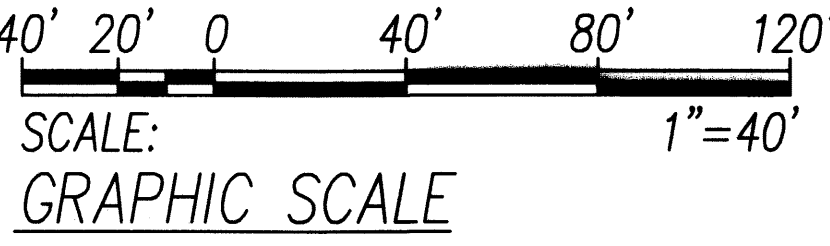

THIS WORK WAS PREPARED BY ME  
OR UNDER MY SUPERVISION  
DATE: 4/26/12

NO.	DATE	REVISION

STATE OF HAWAII  
DEPARTMENT OF TRANSPORTATION  
HIGHWAYS DIVISION

**Electrical Distribution Plan 4**

Freeway Management System, Phase 1C,  
Part 1A: Communication and  
Power Infrastructure  
Federal Aid Project No. IM-0300(123)


SCALE: As Noted      DATE: 3-28-11

**SHEET No. E-6 OF 26 SHEETS**

SURVEY PLOTTED BY	DATE
DRAWN BY	
TRACED BY	
DESIGNED BY	
NOTED BY	
QUANTITIES BY	
CHECKED BY	

LAST DATE: 03/26/11  
2. ALSO PROJECTS VARIOUS OTHER STATE HIGHWAYS  
3. ALSO PROJECTS VARIOUS OTHER STATE HIGHWAYS  
4. ALSO PROJECTS VARIOUS OTHER STATE HIGHWAYS  
FED. ROAD DIST. NO.	STATE	FEDERAL AID PROJ. NO.	FISCAL YEAR	SHEET NO.	TOTAL SHEETS
HAWAII	HAW.	IM-0300(123)	2011	15	65


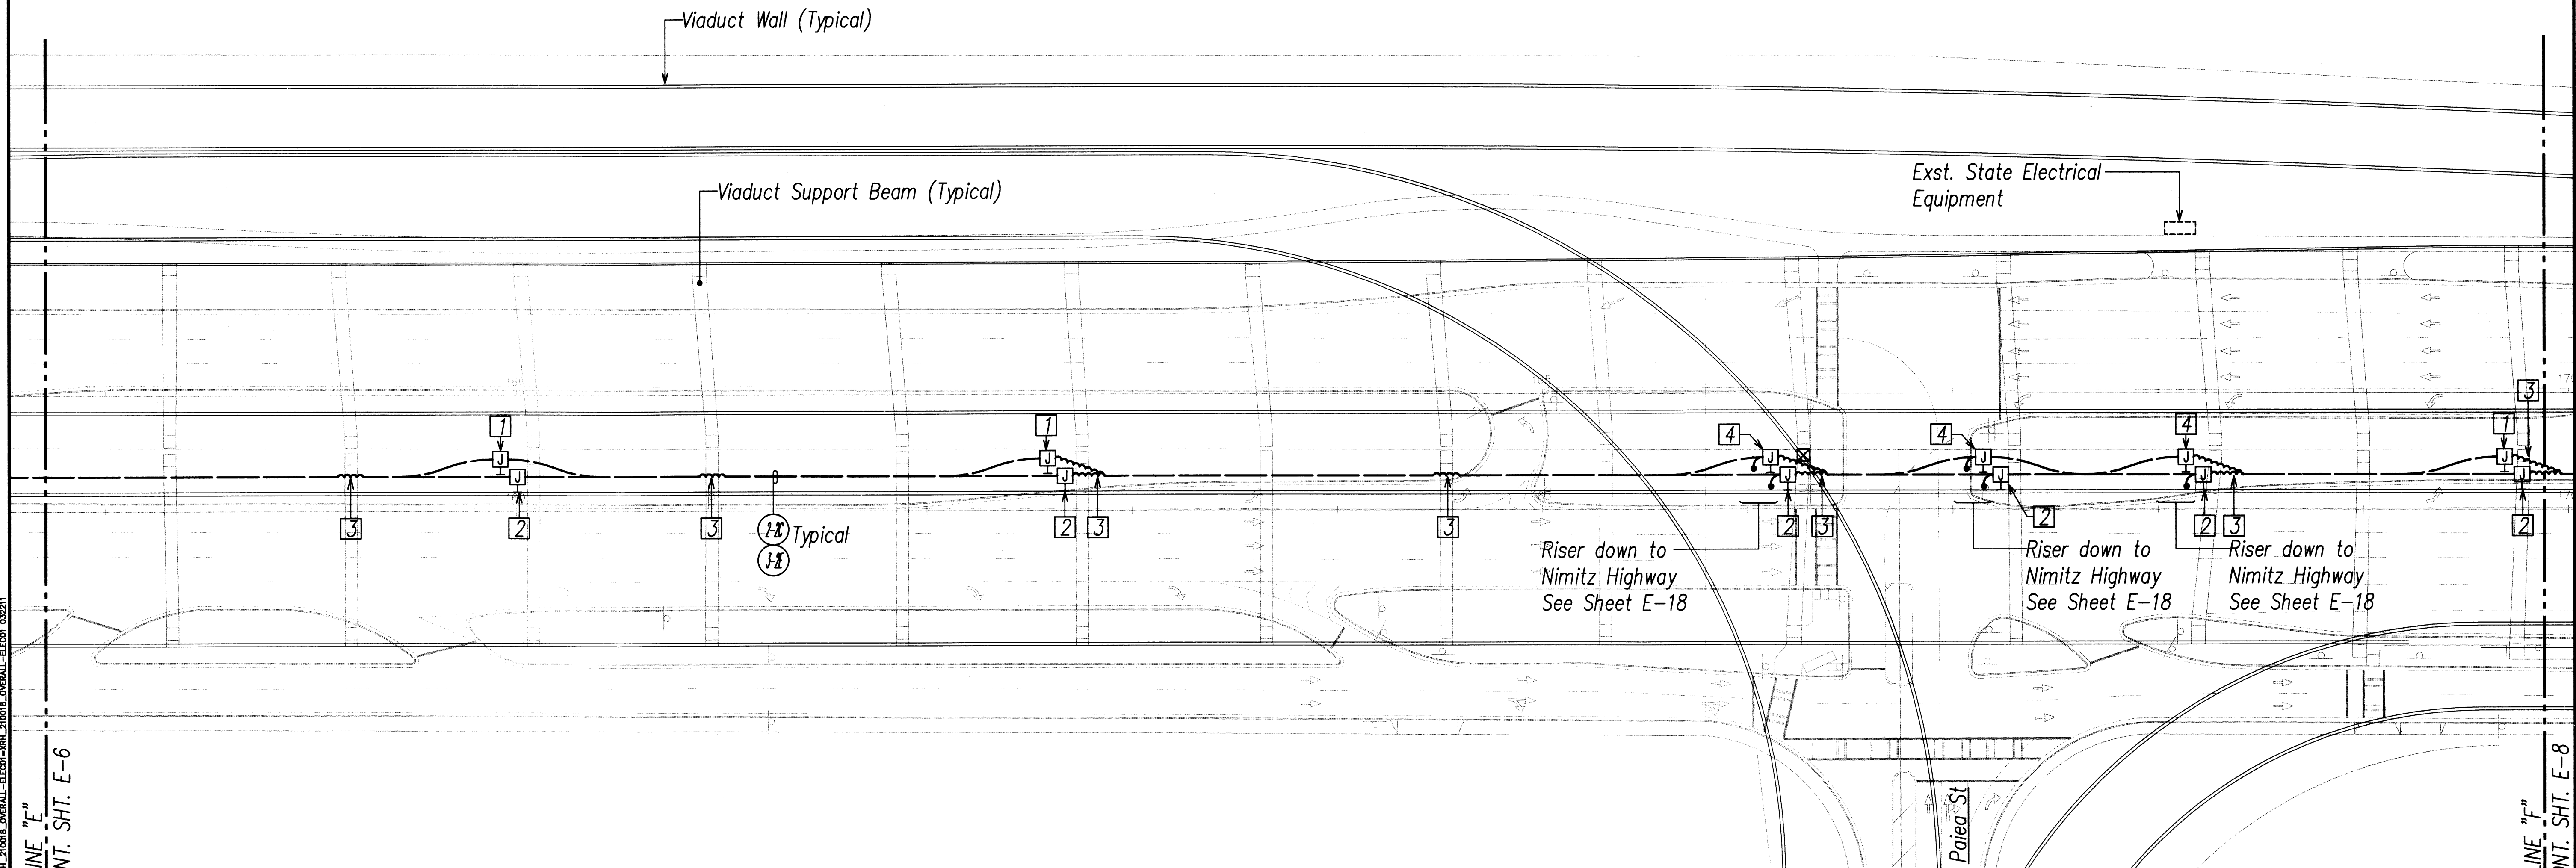


NOTE(S):

- 1 32" X 32" X 8" SS Communication Junction Box
- 2 36" X 36" X 8" SS Electrical Junction Box
- 3 Provide Flex Conduit at Viaduct Construction Joint.
- 4 32" X 32" X 12" SS Communication Junction Box



Electrical Distribution Plan 5  
SCALE: 1"=40'

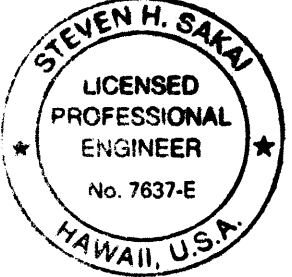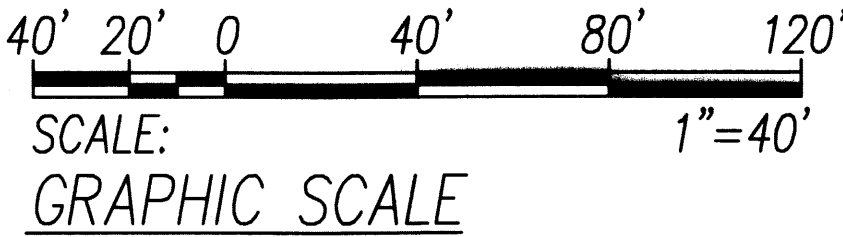

THIS WORK WAS PREPARED BY ME  
OR UNDER MY SUPERVISION  
EXP. 4/30/12

NO.	DATE	REVISION

STATE OF HAWAII  
DEPARTMENT OF TRANSPORTATION  
HIGHWAYS DIVISION

**Electrical Distribution Plan 5**


Freeway Management System, Phase 1C,  
Part 1A: Communication and  
Power Infrastructure  
Federal Aid Project No. IM-0300(123)

SCALE: As Noted DATE: 3-28-11

**SHEET No. E-7 OF 28 SHEETS**



FED. ROAD DIST. NO.	STATE	FEDERAL AID PROJ. NO.	FISCAL YEAR	SHEET NO.	TOTAL SHEETS
HAWAII	HAW.	IM-0300(123)	2011	16	65

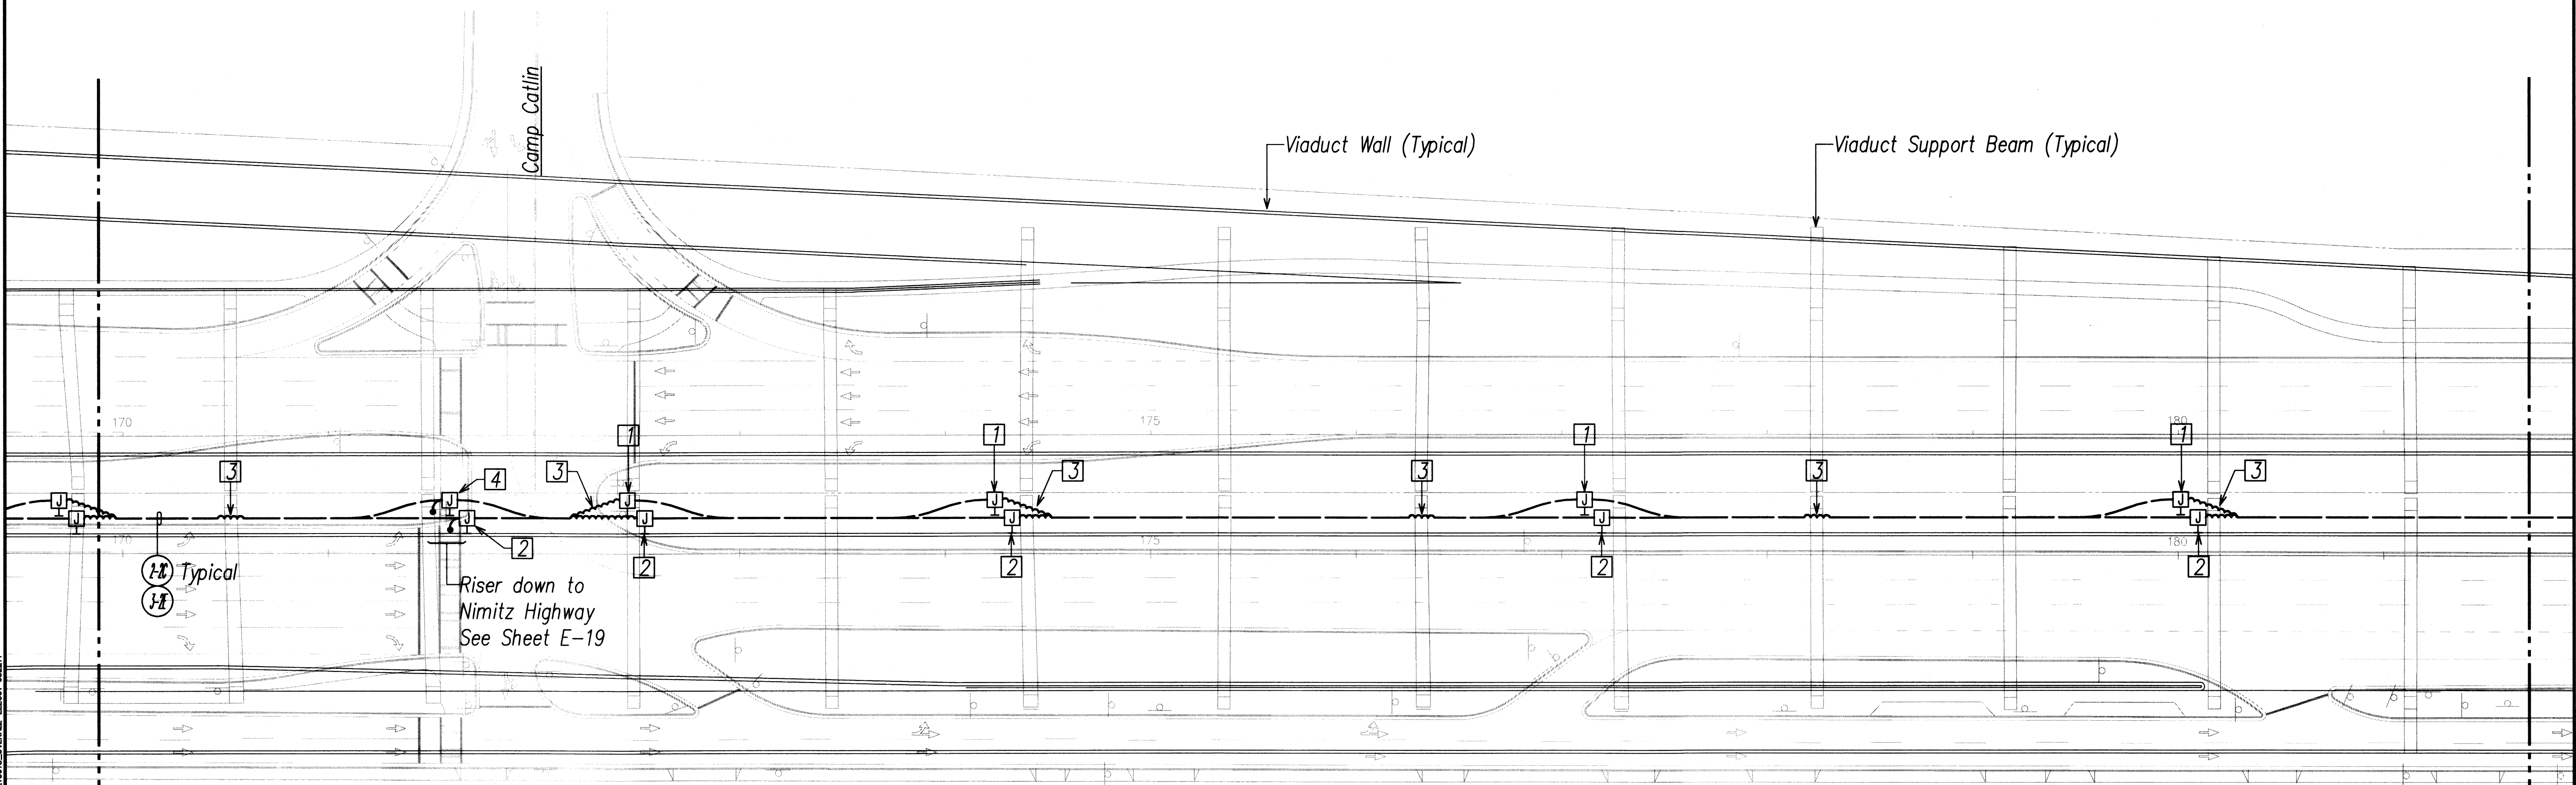

MATCHLINE "F"  
SEE CONT. SHT. E-7



MATCHLINE "G"  
SEE CONT. SHT. E-9

NOTE(S):

- 1 32" X 32" X 8" SS Communication Junction Box
- 2 36" X 36" X 8" SS Electrical Junction Box
- 3 Provide Flex Conduit at Viaduct Construction Joint.
- 4 32" X 32" X 12" SS Communication Junction Box



Electrical Distribution Plan 6  
SCALE: 1"=40'

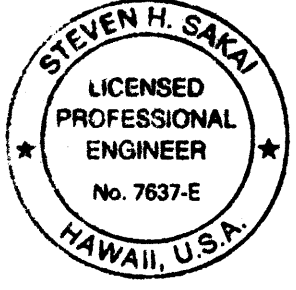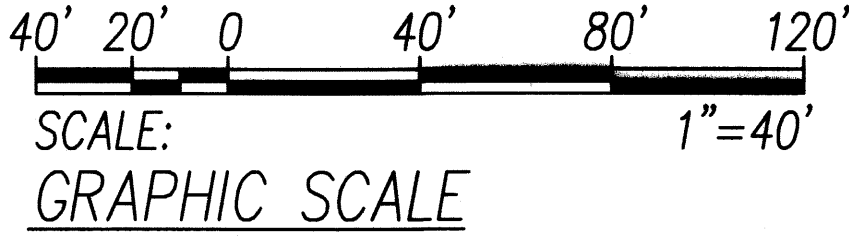

THIS WORK WAS PREPARED BY ME  
OR UNDER MY SUPERVISION  
EXP. 4/30/12

NO.	DATE	REVISION

STATE OF HAWAII  
DEPARTMENT OF TRANSPORTATION  
HIGHWAYS DIVISION

**Electrical Distribution Plan 6**

Freeway Management System, Phase 1C,  
Part 1A: Communication and  
Power Infrastructure  
Federal Aid Project No. IM-0300(123)


SCALE: As Noted      DATE: 3-28-11

**SHEET No. E-8 OF 28 SHEETS**

SURVEY PLOTTED BY	DATE
DRAWN BY	
TRACED BY	
DESIGNED BY	
QUANTITIES BY	
CHECKED BY	

LAST SAVE: 03/29/11 @ 08:42:38 BY: GPT PLOT OF: I:\03\000000  
C:\WINDOWS\SYSTEM32\cmd.exe /c cd I:\03\000000 & xcopy /s /e /y I:\03\000000\ALL\UNITS\BASE-TOP\WRI-BASED\WRI-210016\OVERALL-ELECTR-032211

FED. ROAD DIST. NO.	STATE	FEDERAL AID PROJ. NO.	FISCAL YEAR	SHEET NO.	TOTAL SHEETS
HAWAII	HAW.	IM-0300(123)	2011	17	65


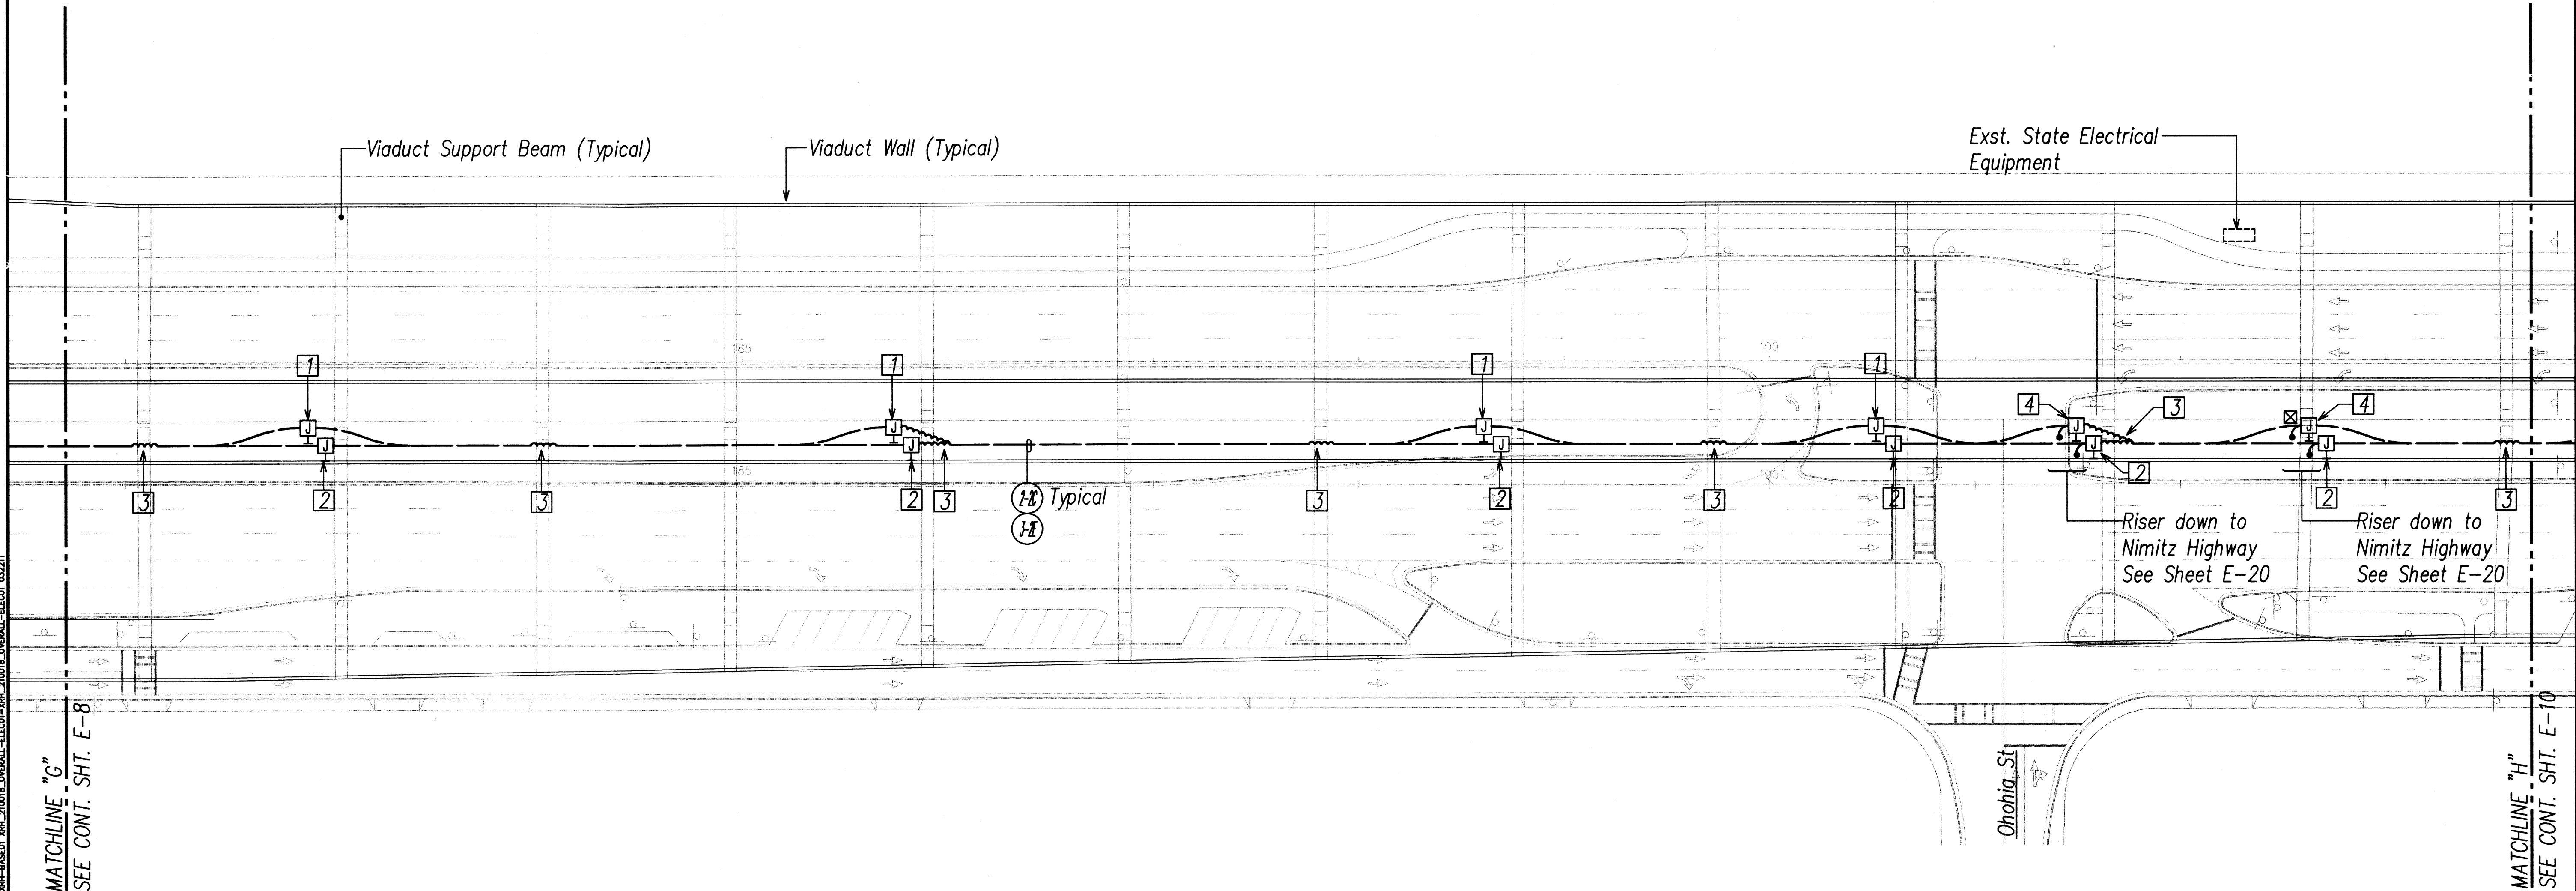


NOTE(S):

- 32" X 32" X 8" SS Communication Junction Box
- 36" X 36" X 8" SS Electrical Junction Box
- Provide Flex Conduit at Viaduct Construction Joint.
- 32" X 32" X 12" SS Communication Junction Box



Electrical Distribution Plan 7  
SCALE: 1"=40'

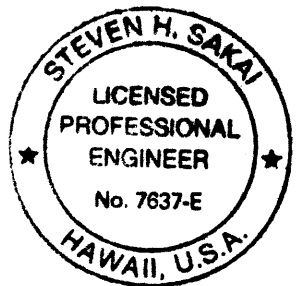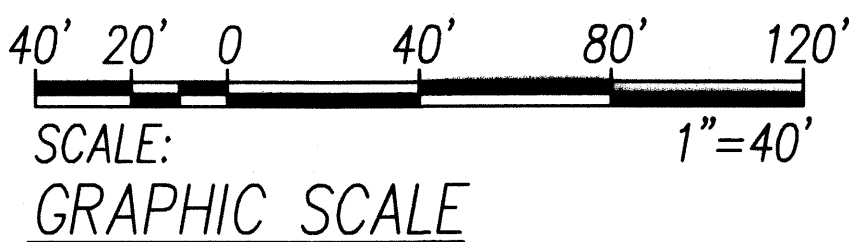

THIS WORK WAS PREPARED BY ME  
OR UNDER MY SUPERVISION  
EXP. 4/30/12

NO.	DATE	REVISION

STATE OF HAWAII  
DEPARTMENT OF TRANSPORTATION  
HIGHWAYS DIVISION

**Electrical Distribution Plan 7**

Freeway Management System, Phase 1C,  
Part 1A: Communication and  
Power Infrastructure  
Federal Aid Project No. IM-0300(123)

SCALE: As Noted      DATE: 3-28-11

**SHEET No. E-8 OF 28 SHEETS**
















FED. ROAD DIST. NO.	STATE	FEDERAL AID PROJ. NO.	FISCAL YEAR	SHEET NO.	TOTAL SHEETS
HAWAII	HAW.	IM-0300(123)	2011	23	65

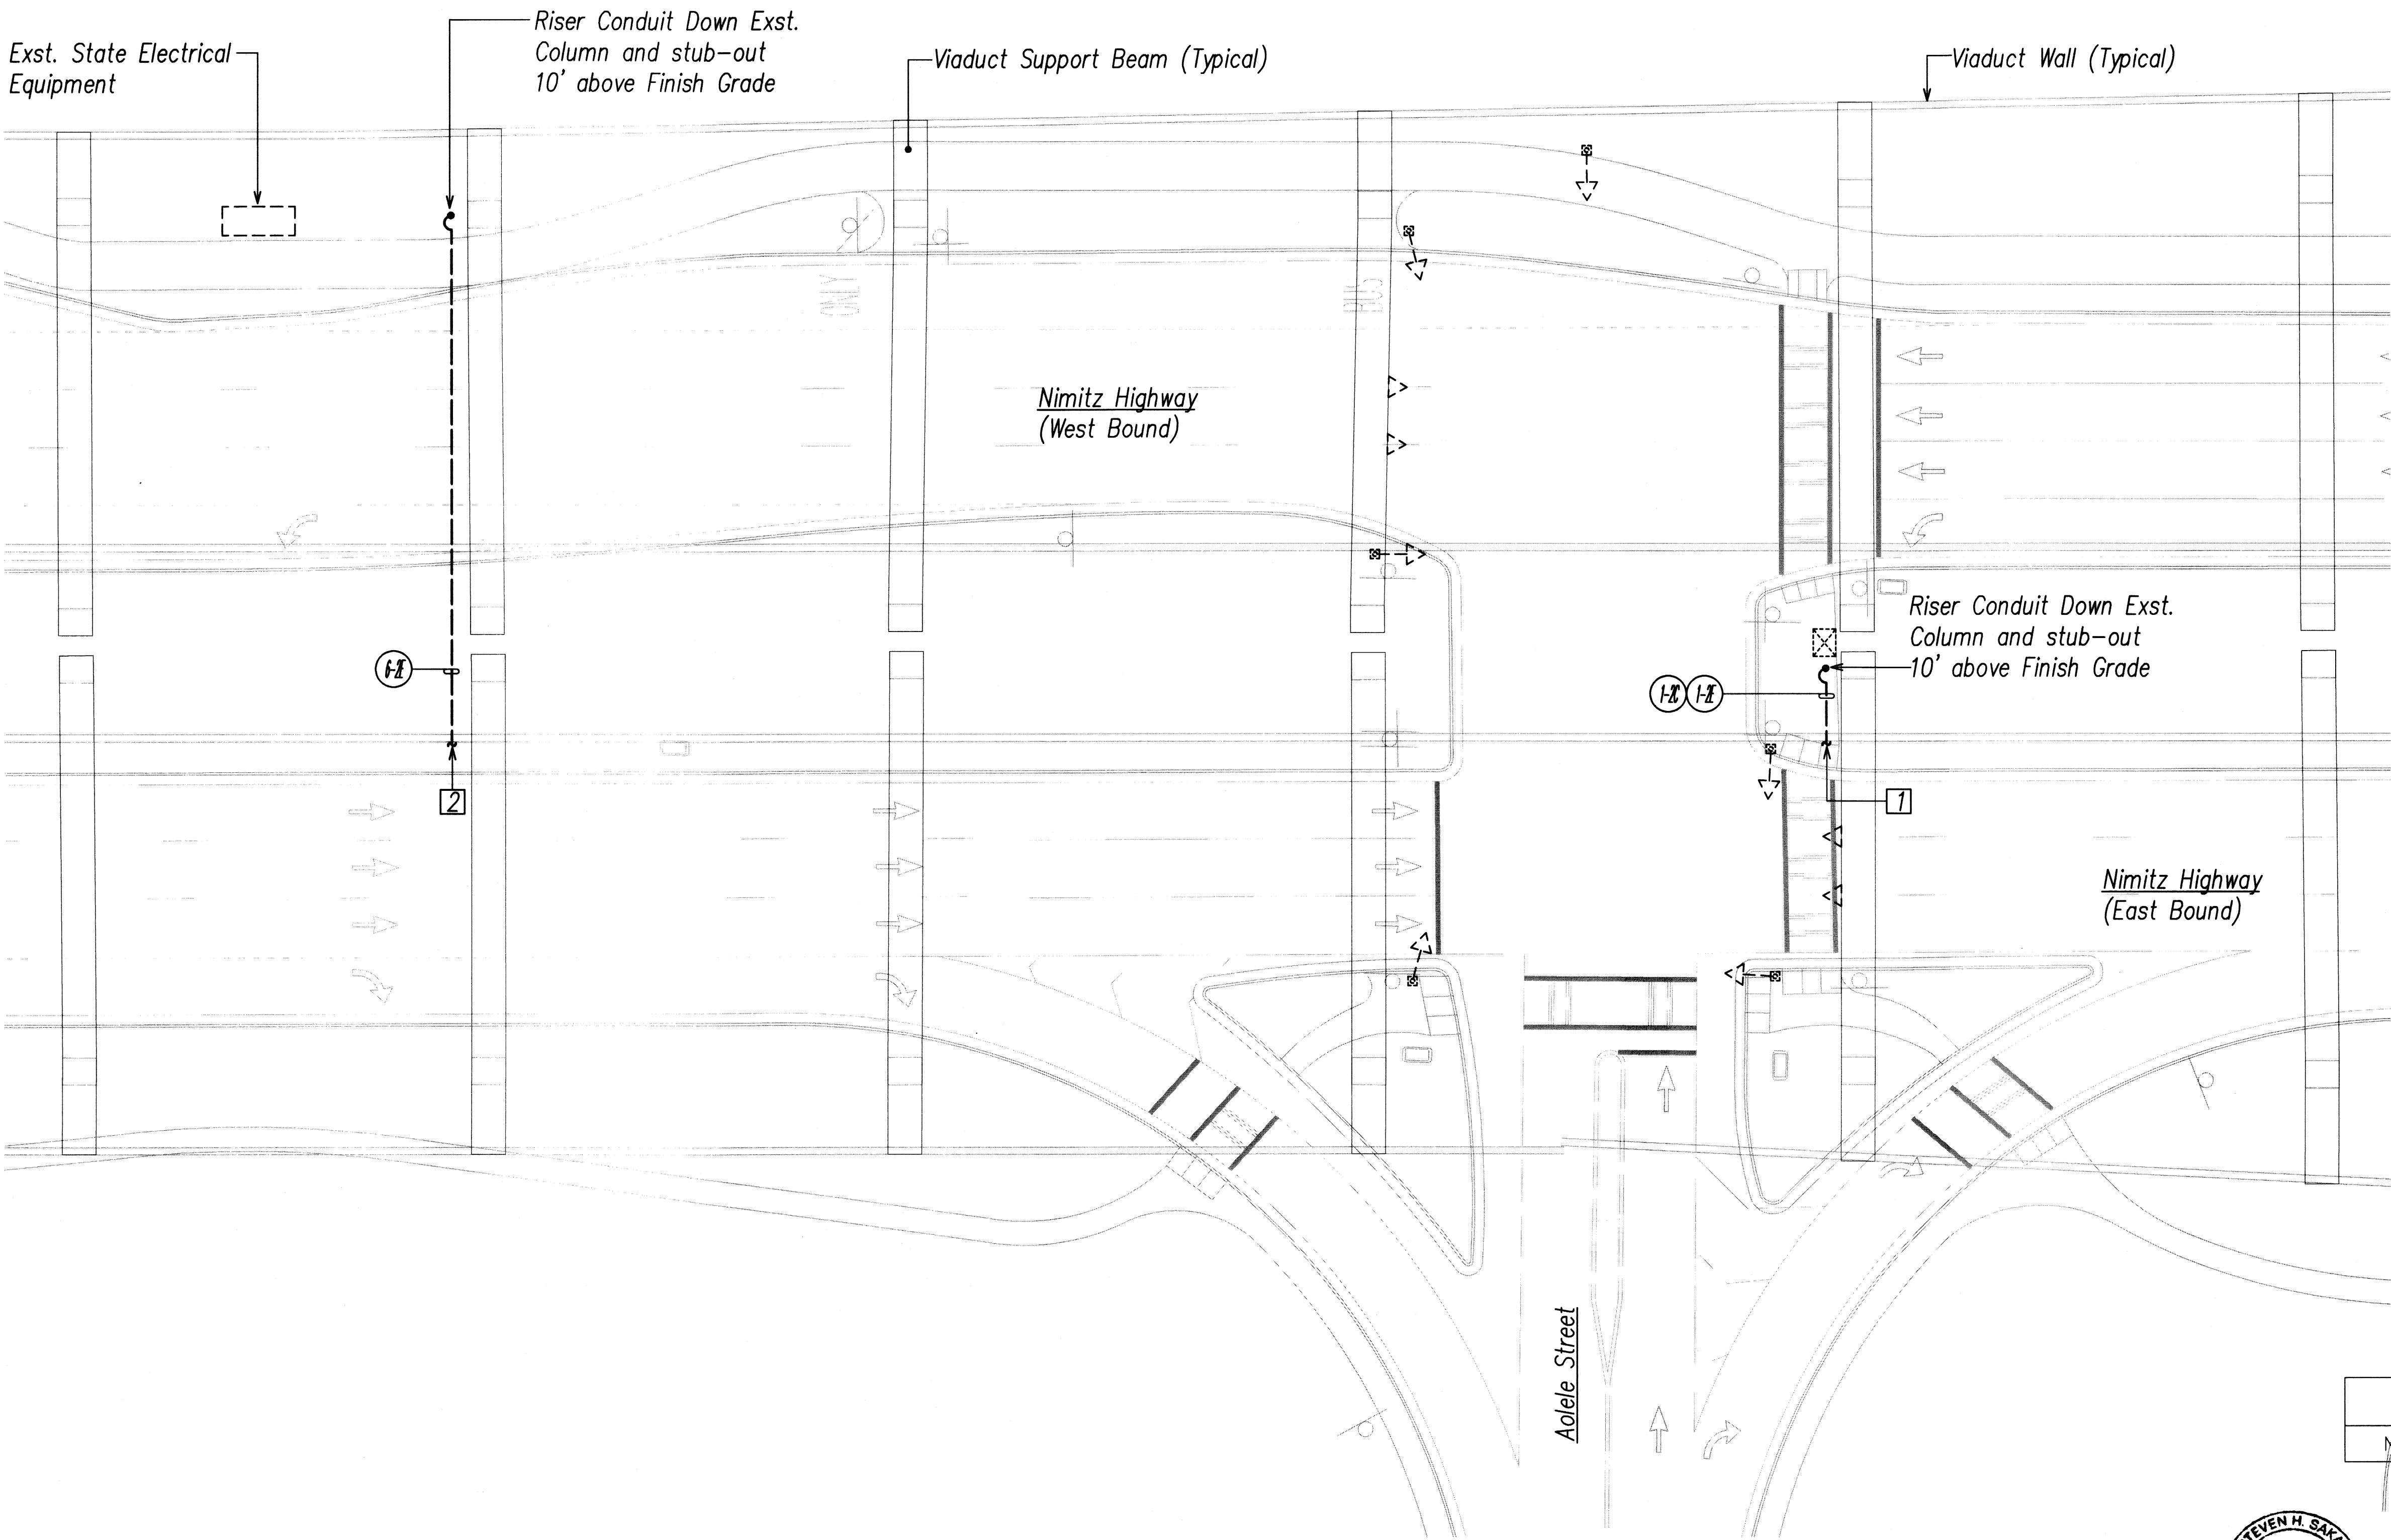

- NOTE(S):**
- 1 Continuation from Junction Box on Sheet E-4. See A/E-25 for Conduit Routing Detail.
  - 2 Continuation from Junction Box on Sheet E-4. See C/E-25 for Conduit Routing Detail.

**Aolele Distribution Plan**  
SCALE: 1"=20'

ORIGINAL PLAN	SURVEY PLOTTED BY	DATE
NOTEBOOK	DRAWN BY	
	DESIGNED BY	
	QUANTITIES BY	
	CHECKED BY	

LAST SAVE: 03/29/11 @ 08:42:34 BY: GPT PLOT SC 12-20-00000  
C:\WORK\PROJECTS\2010\12-20-00000\12-20-00000.DWG PLOT: 12-20-00000.DWG ALL DIMENSIONS: 12-20-00000.DWG



*Steven H. Sakai*  
THIS WORK WAS PREPARED BY ME  
OR UNDER MY SUPERVISION  
DATE: 4/20/12

NO.	DATE	REVISION

STATE OF HAWAII  
DEPARTMENT OF TRANSPORTATION  
HIGHWAYS DIVISION


**Aolele Distribution Plan**

Freeway Management System, Phase 1C,  
Part 1A: Communication and  
Power Infrastructure  
Federal Aid Project No. IM-0300(123)

SCALE: As Noted      DATE: 3-28-11

**SHEET No. E-15 OF 26 SHEETS**

FED. ROAD DIST. NO.	STATE	FEDERAL AID PROJ. NO.	FISCAL YEAR	SHEET NO.	TOTAL SHEETS
HAWAII	HAW.	1M-0300(123)	2011	24	65

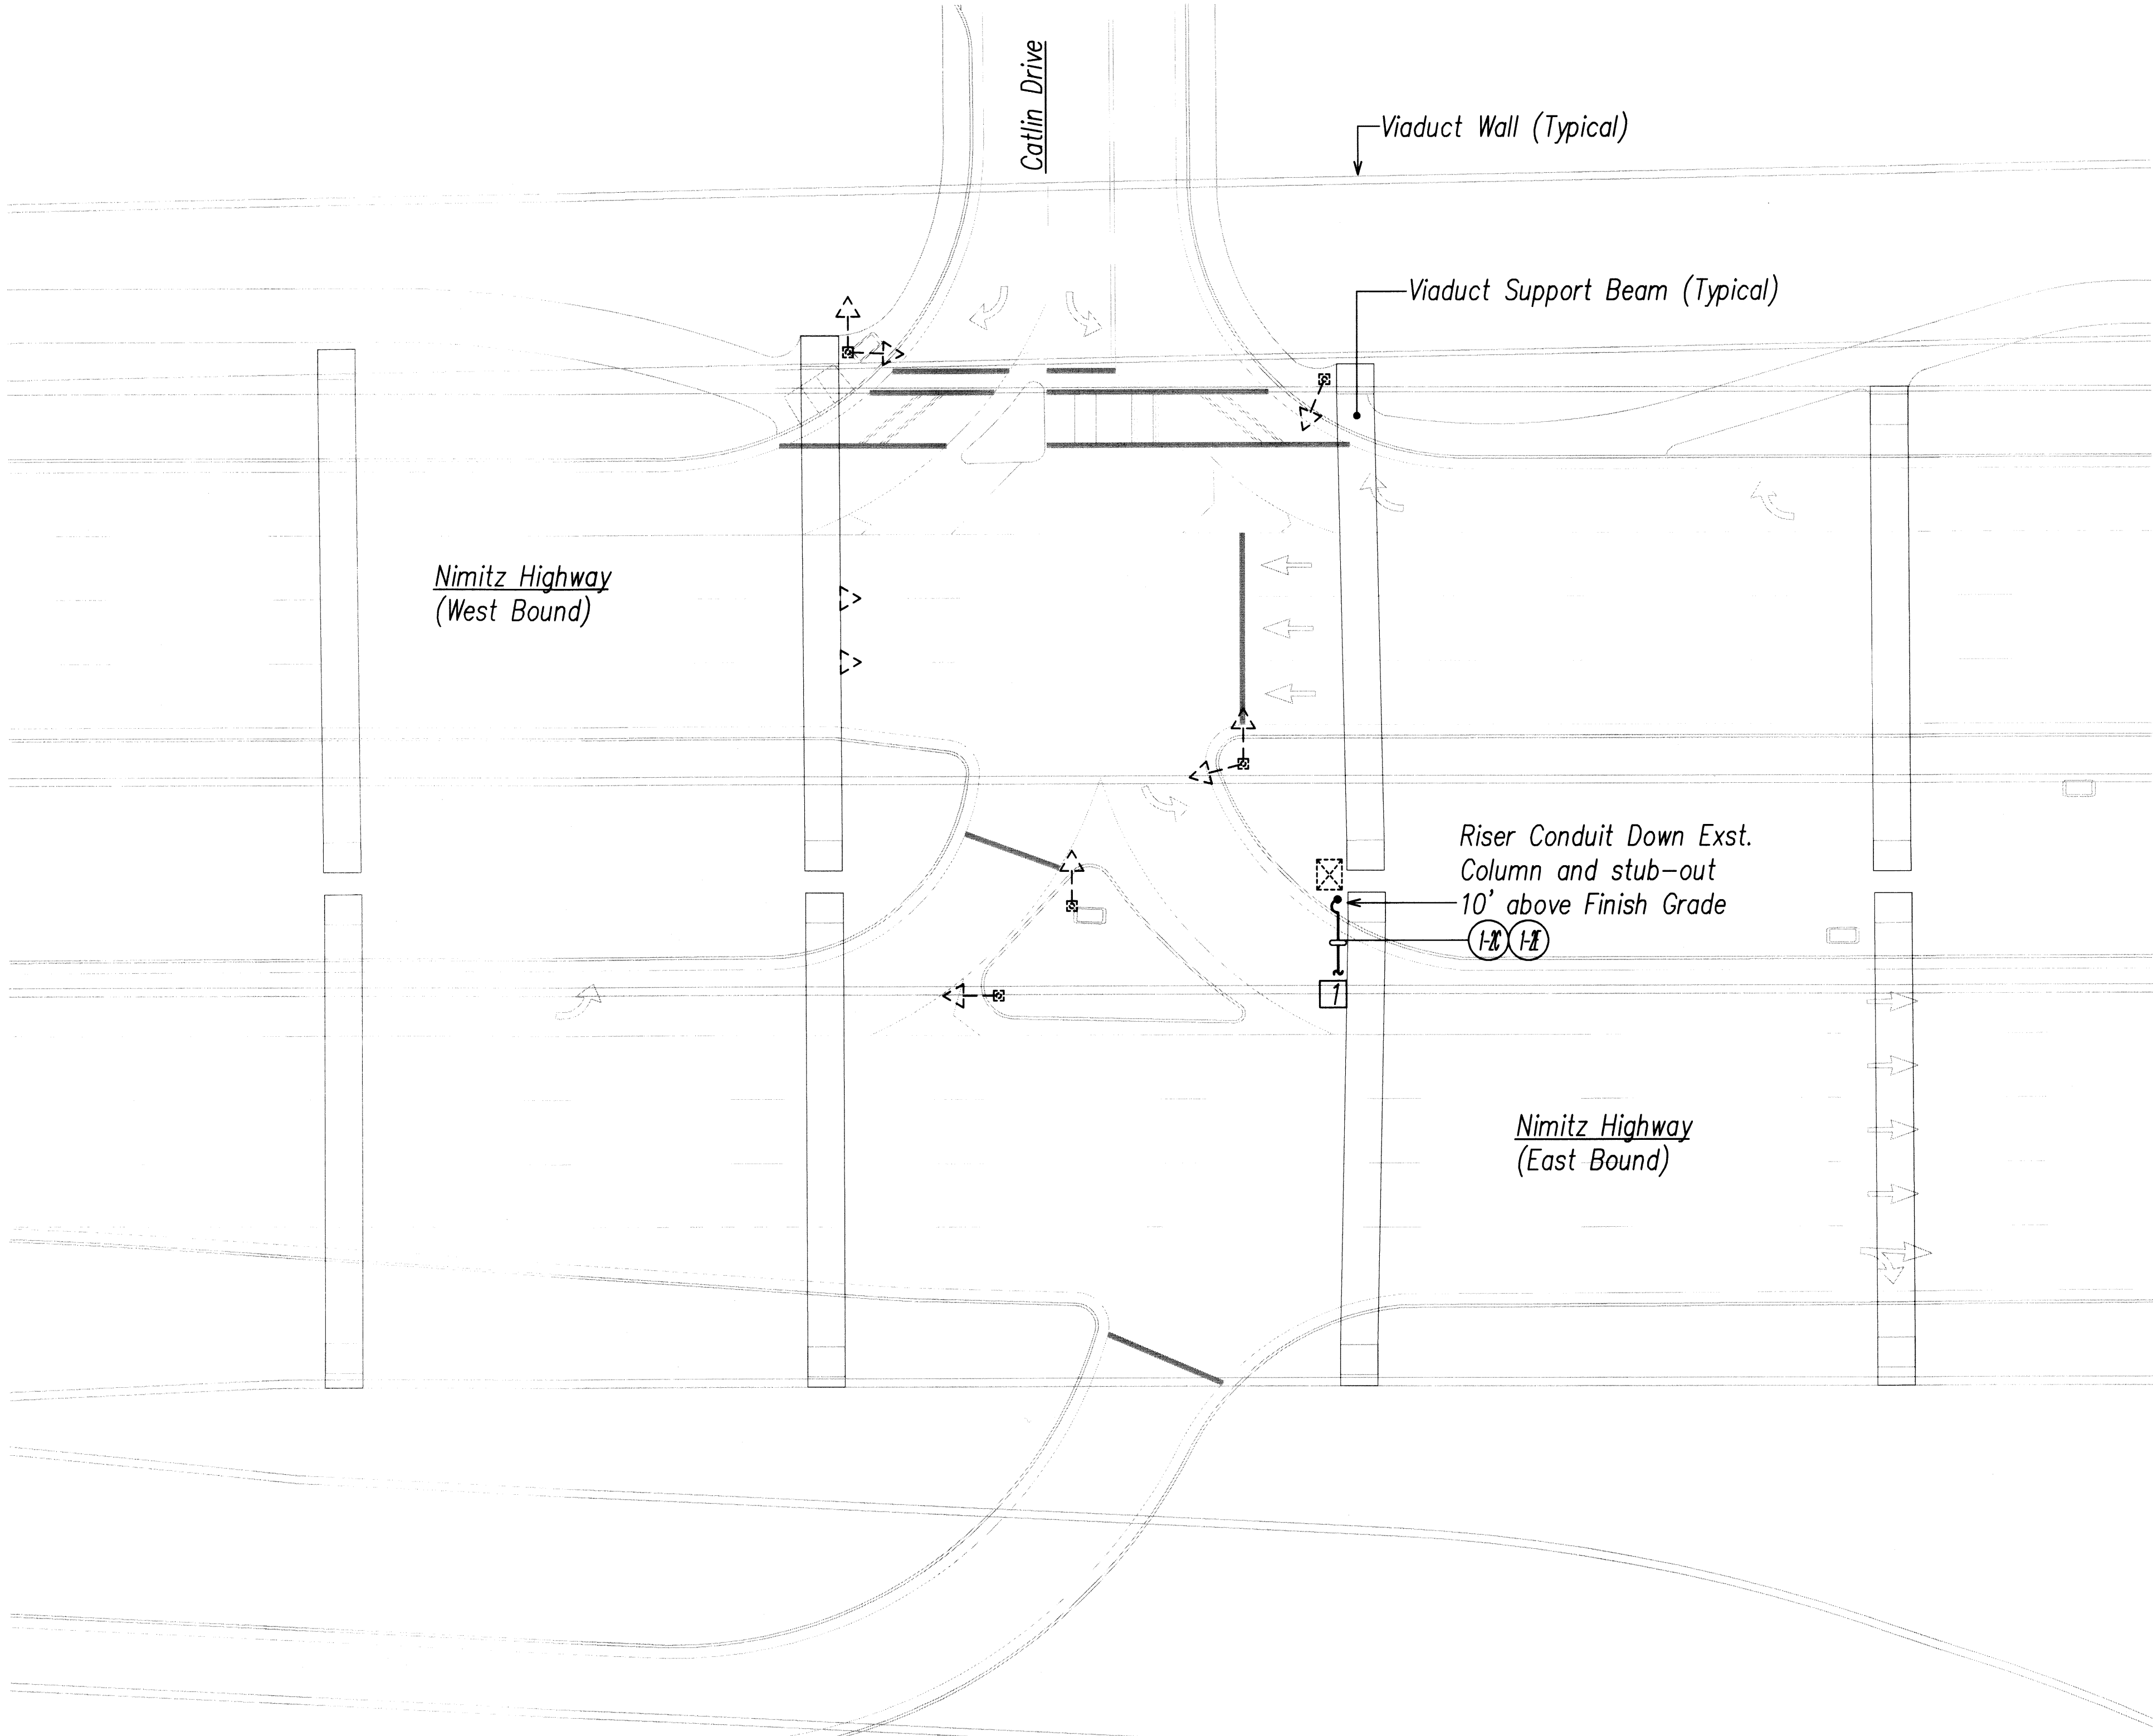


NOTE(S):  
1 Continuation from Junction Box on Sheet E-6.  
See A/E-25 for Conduit Routing Detail.

DESIGN PLAN	SURVEY PLOTTED BY	DATE
NOTED BY	DRAWN BY	
NOTED BY	DESIGNED BY	
NOTED BY	CHECKED BY	

LAST SAVE: 03/29/11 @ 08:42:48 BY: GPT PLOT SC: 1=20.000000  
C:\WORK\PROJECTS\2010\1M-0300(123)\E-24\1M-0300(123)-E-24.dwg PLOT: 1M-0300(123)-E-24.dwg PLOT: 1M-0300(123)-E-24.dwg

Catlin Distribution Plan  
SCALE: 1"=20'

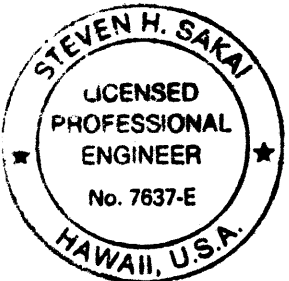

THIS WORK WAS PREPARED BY ME  
OR UNDER MY SUPERVISION  
EXP: 4/30/12

NO.	DATE	REVISION

STATE OF HAWAII  
DEPARTMENT OF TRANSPORTATION  
HIGHWAYS DIVISION

**Catlin Distribution Plan**

Freeway Management System, Phase 1C,  
Part 1A: Communication and  
Power Infrastructure  
Federal Aid Project No. 1M-0300(123)


SCALE: As Noted      DATE: 3-28-11

**SHEET No. E-16 OF 26 SHEETS**





FED. ROAD DIST. NO.	STATE	FEDERAL AID PROJ. NO.	FISCAL YEAR	SHEET NO.	TOTAL SHEETS
HAWAII	HAW.	IM-0300(123)	2011	26	65

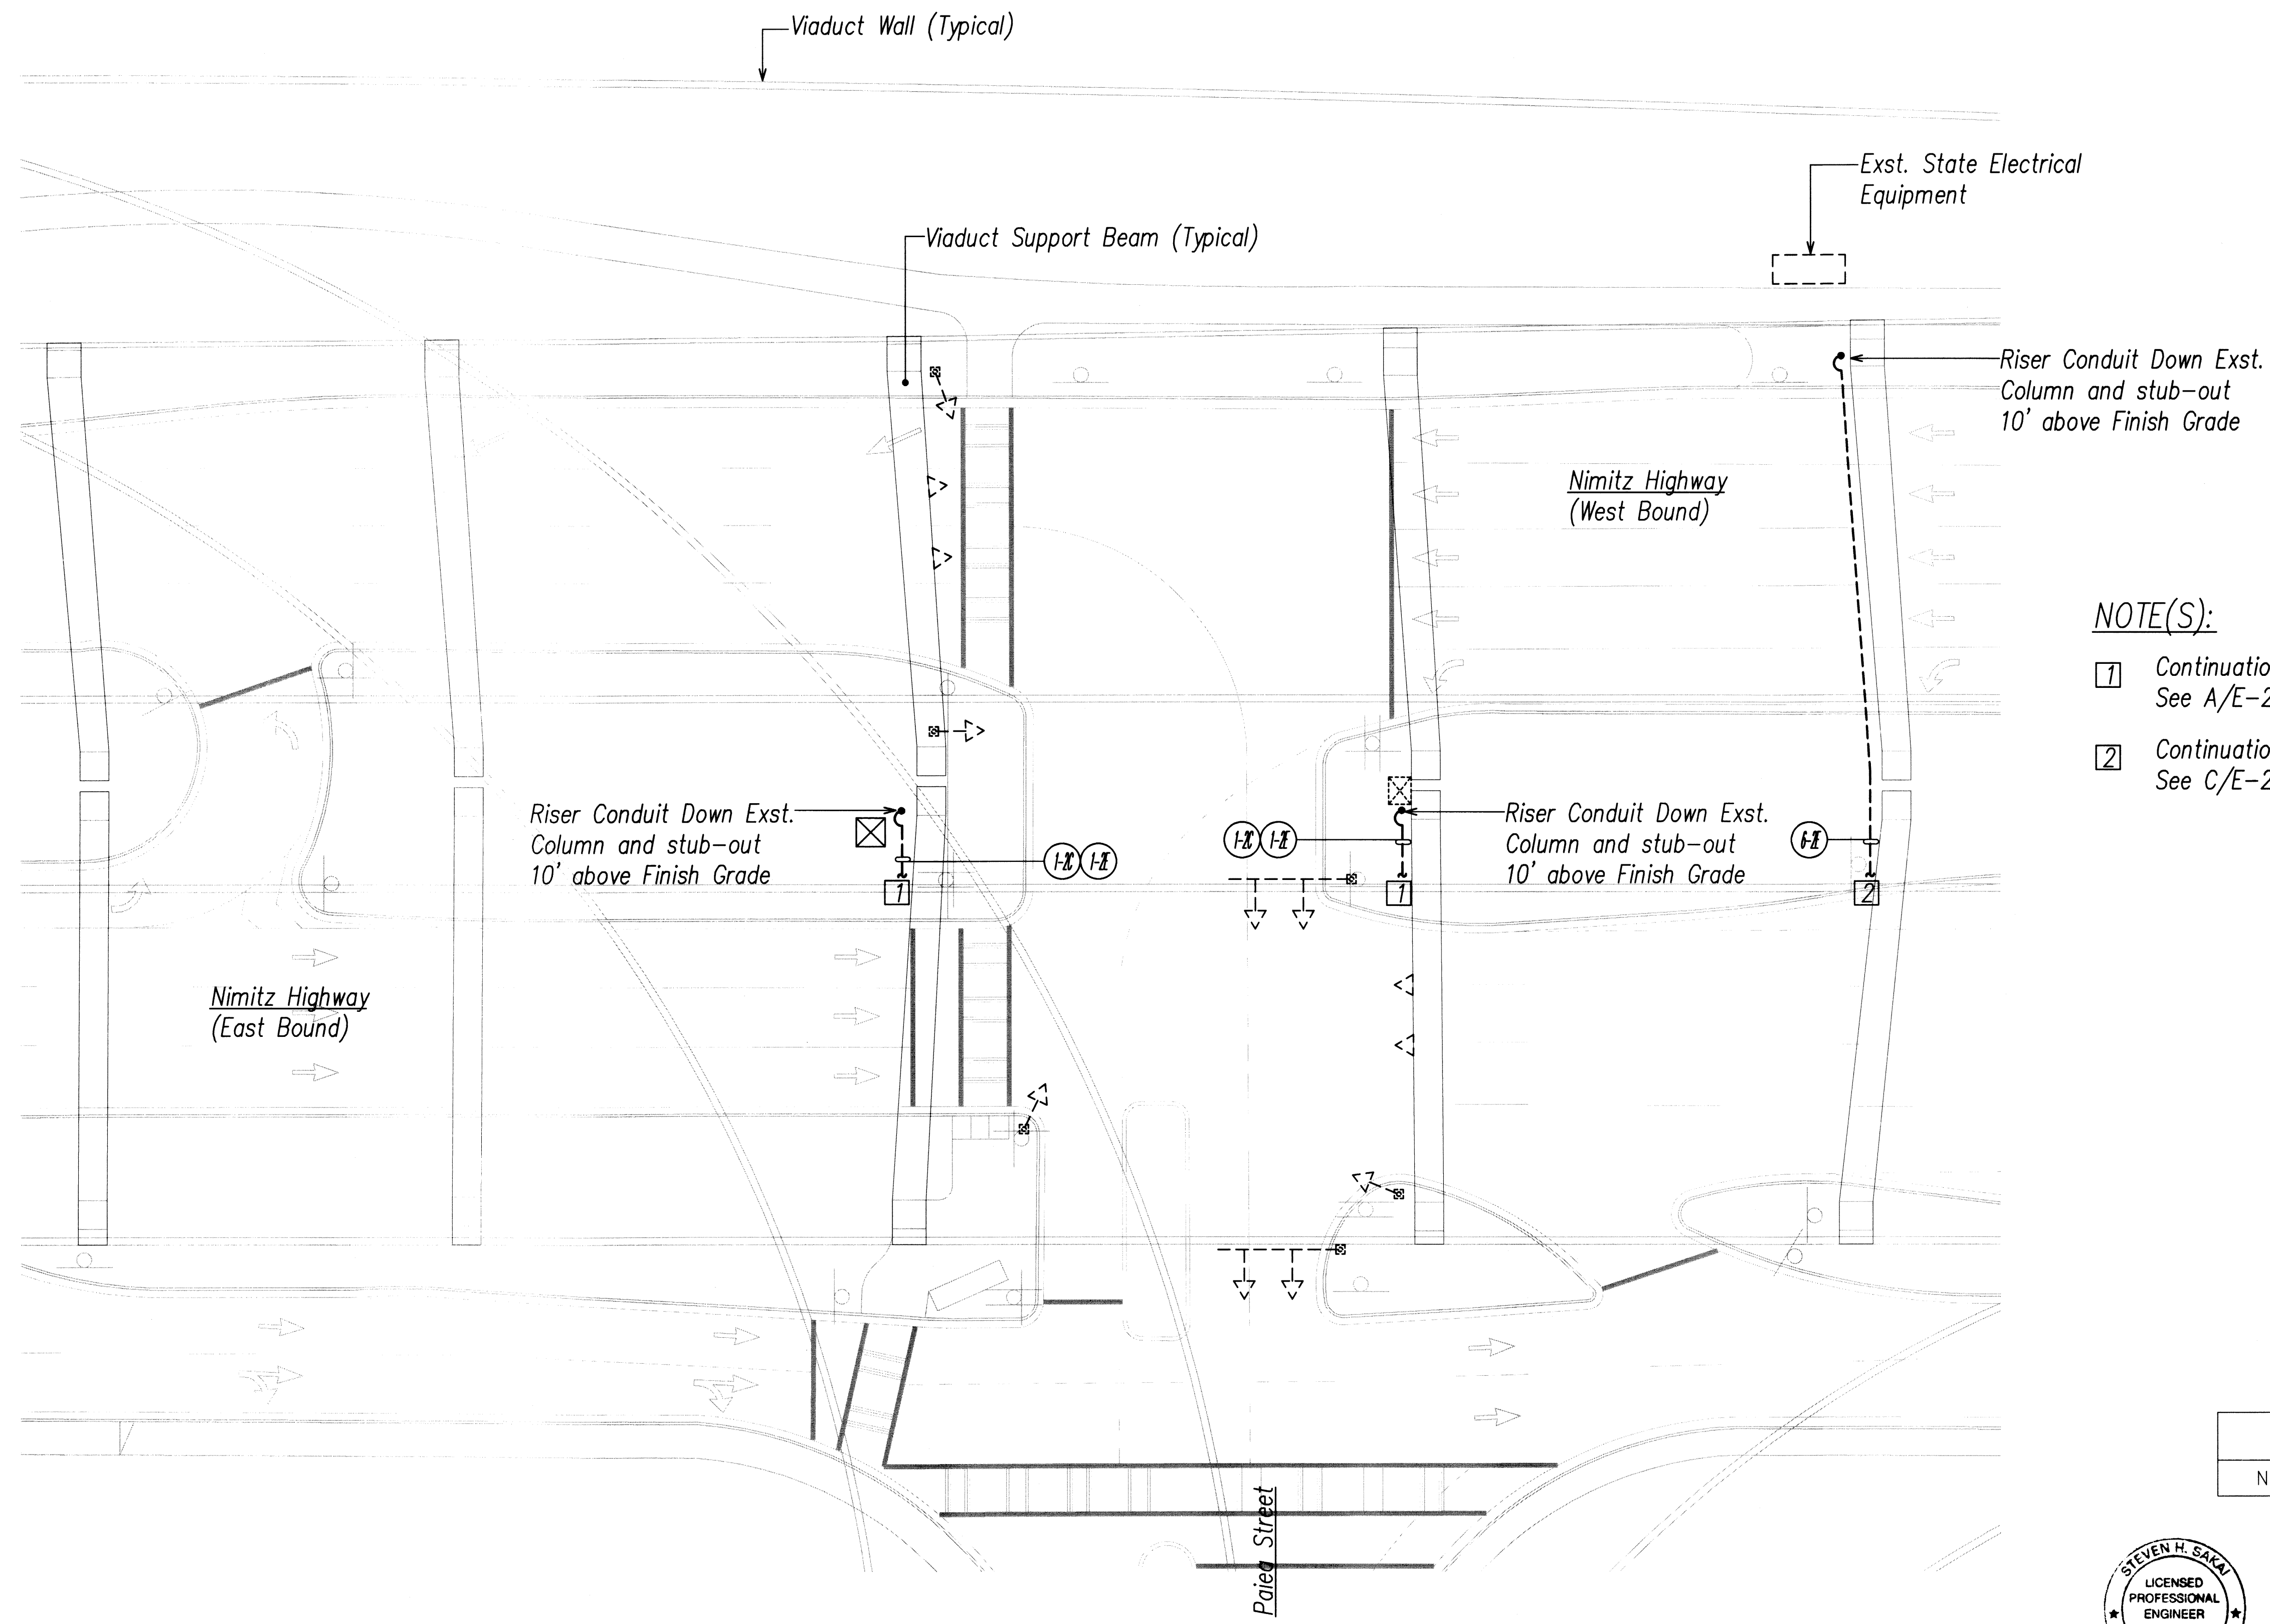


- NOTE(S):
- 1 Continuation from Junction Box on Sheet E-7. See A/E-25 for Conduit Routing Detail.
  - 2 Continuation from Junction Box on Sheet E-7. See C/E-25 for Conduit Routing Detail.

Paiea Distribution Plan  
SCALE: 1"=20'

ORIGINAL PLAN	SURVEY PLOTTED BY	DATE
NOTEBOOK	DRAWN BY	
	DESIGNED BY	
	QUANTITIES BY	
	CHECKED BY	

LAST SAVE: 03/29/11 @ 08:43:24 BY: GPT PLOT SC: 125000000  
C:\WORK\PROJECTS\125000000\125000000.DWG PLOT: 03/29/11 08:43:24 ALL DIMENSIONS: TOP VIEW: BASED ON: 210018\_OVERALL-ELE01

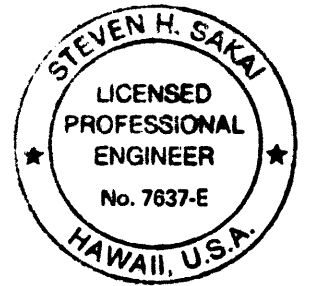

THIS WORK WAS PREPARED BY ME  
OR UNDER MY SUPERVISION  
DATE: 4/20/12

STATE OF HAWAII  
DEPARTMENT OF TRANSPORTATION  
HIGHWAYS DIVISION  
**Paiea Distribution Plan**  
  
Freeway Management System, Phase 1C,  
Part 1A: Communication and  
Power Infrastructure  
Federal Aid Project No. IM-0300(123)  
SCALE: As Noted DATE: 3-28-11  
SHEET No. E-18 OF 26 SHEETS

NO.	DATE	REVISION


















FED. ROAD DIST. NO.	STATE	FEDERAL AID PROJ. NO.	FISCAL YEAR	SHEET NO.	TOTAL SHEETS
HAWAII	HAW.	IM-0300(123)	2011	C.O. 31S-1	65

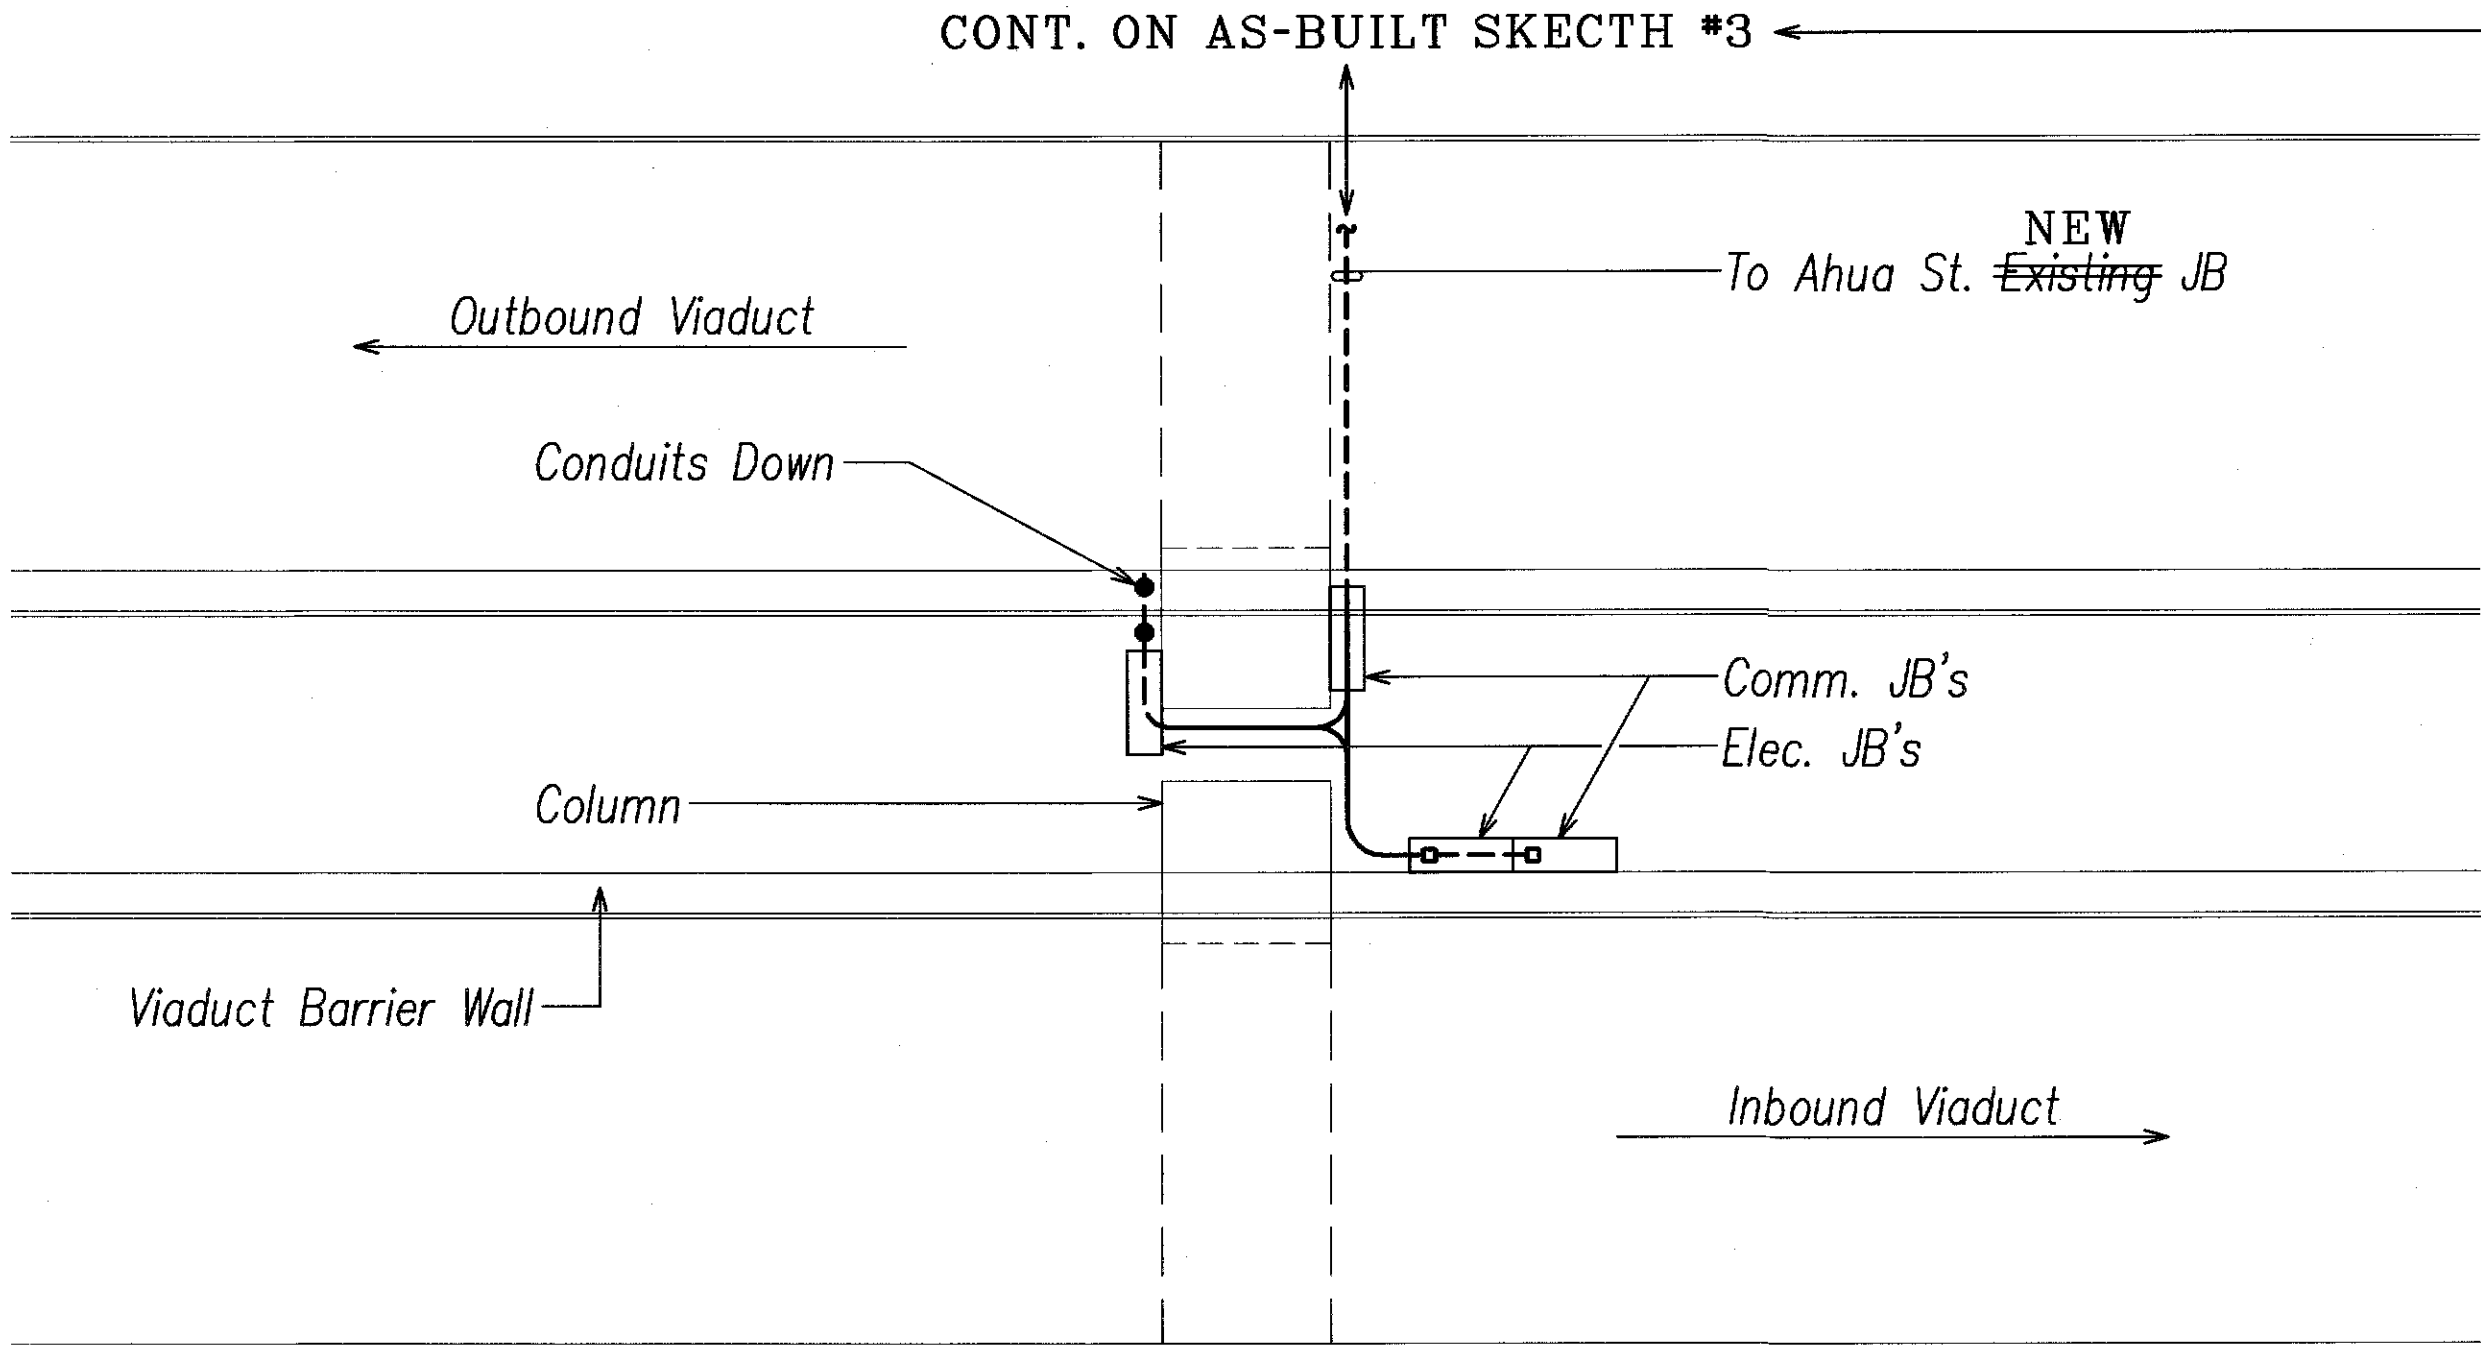

Plan View  
Viaduct at Ahua St.  
As Built Sketch #1  
n.t.s.

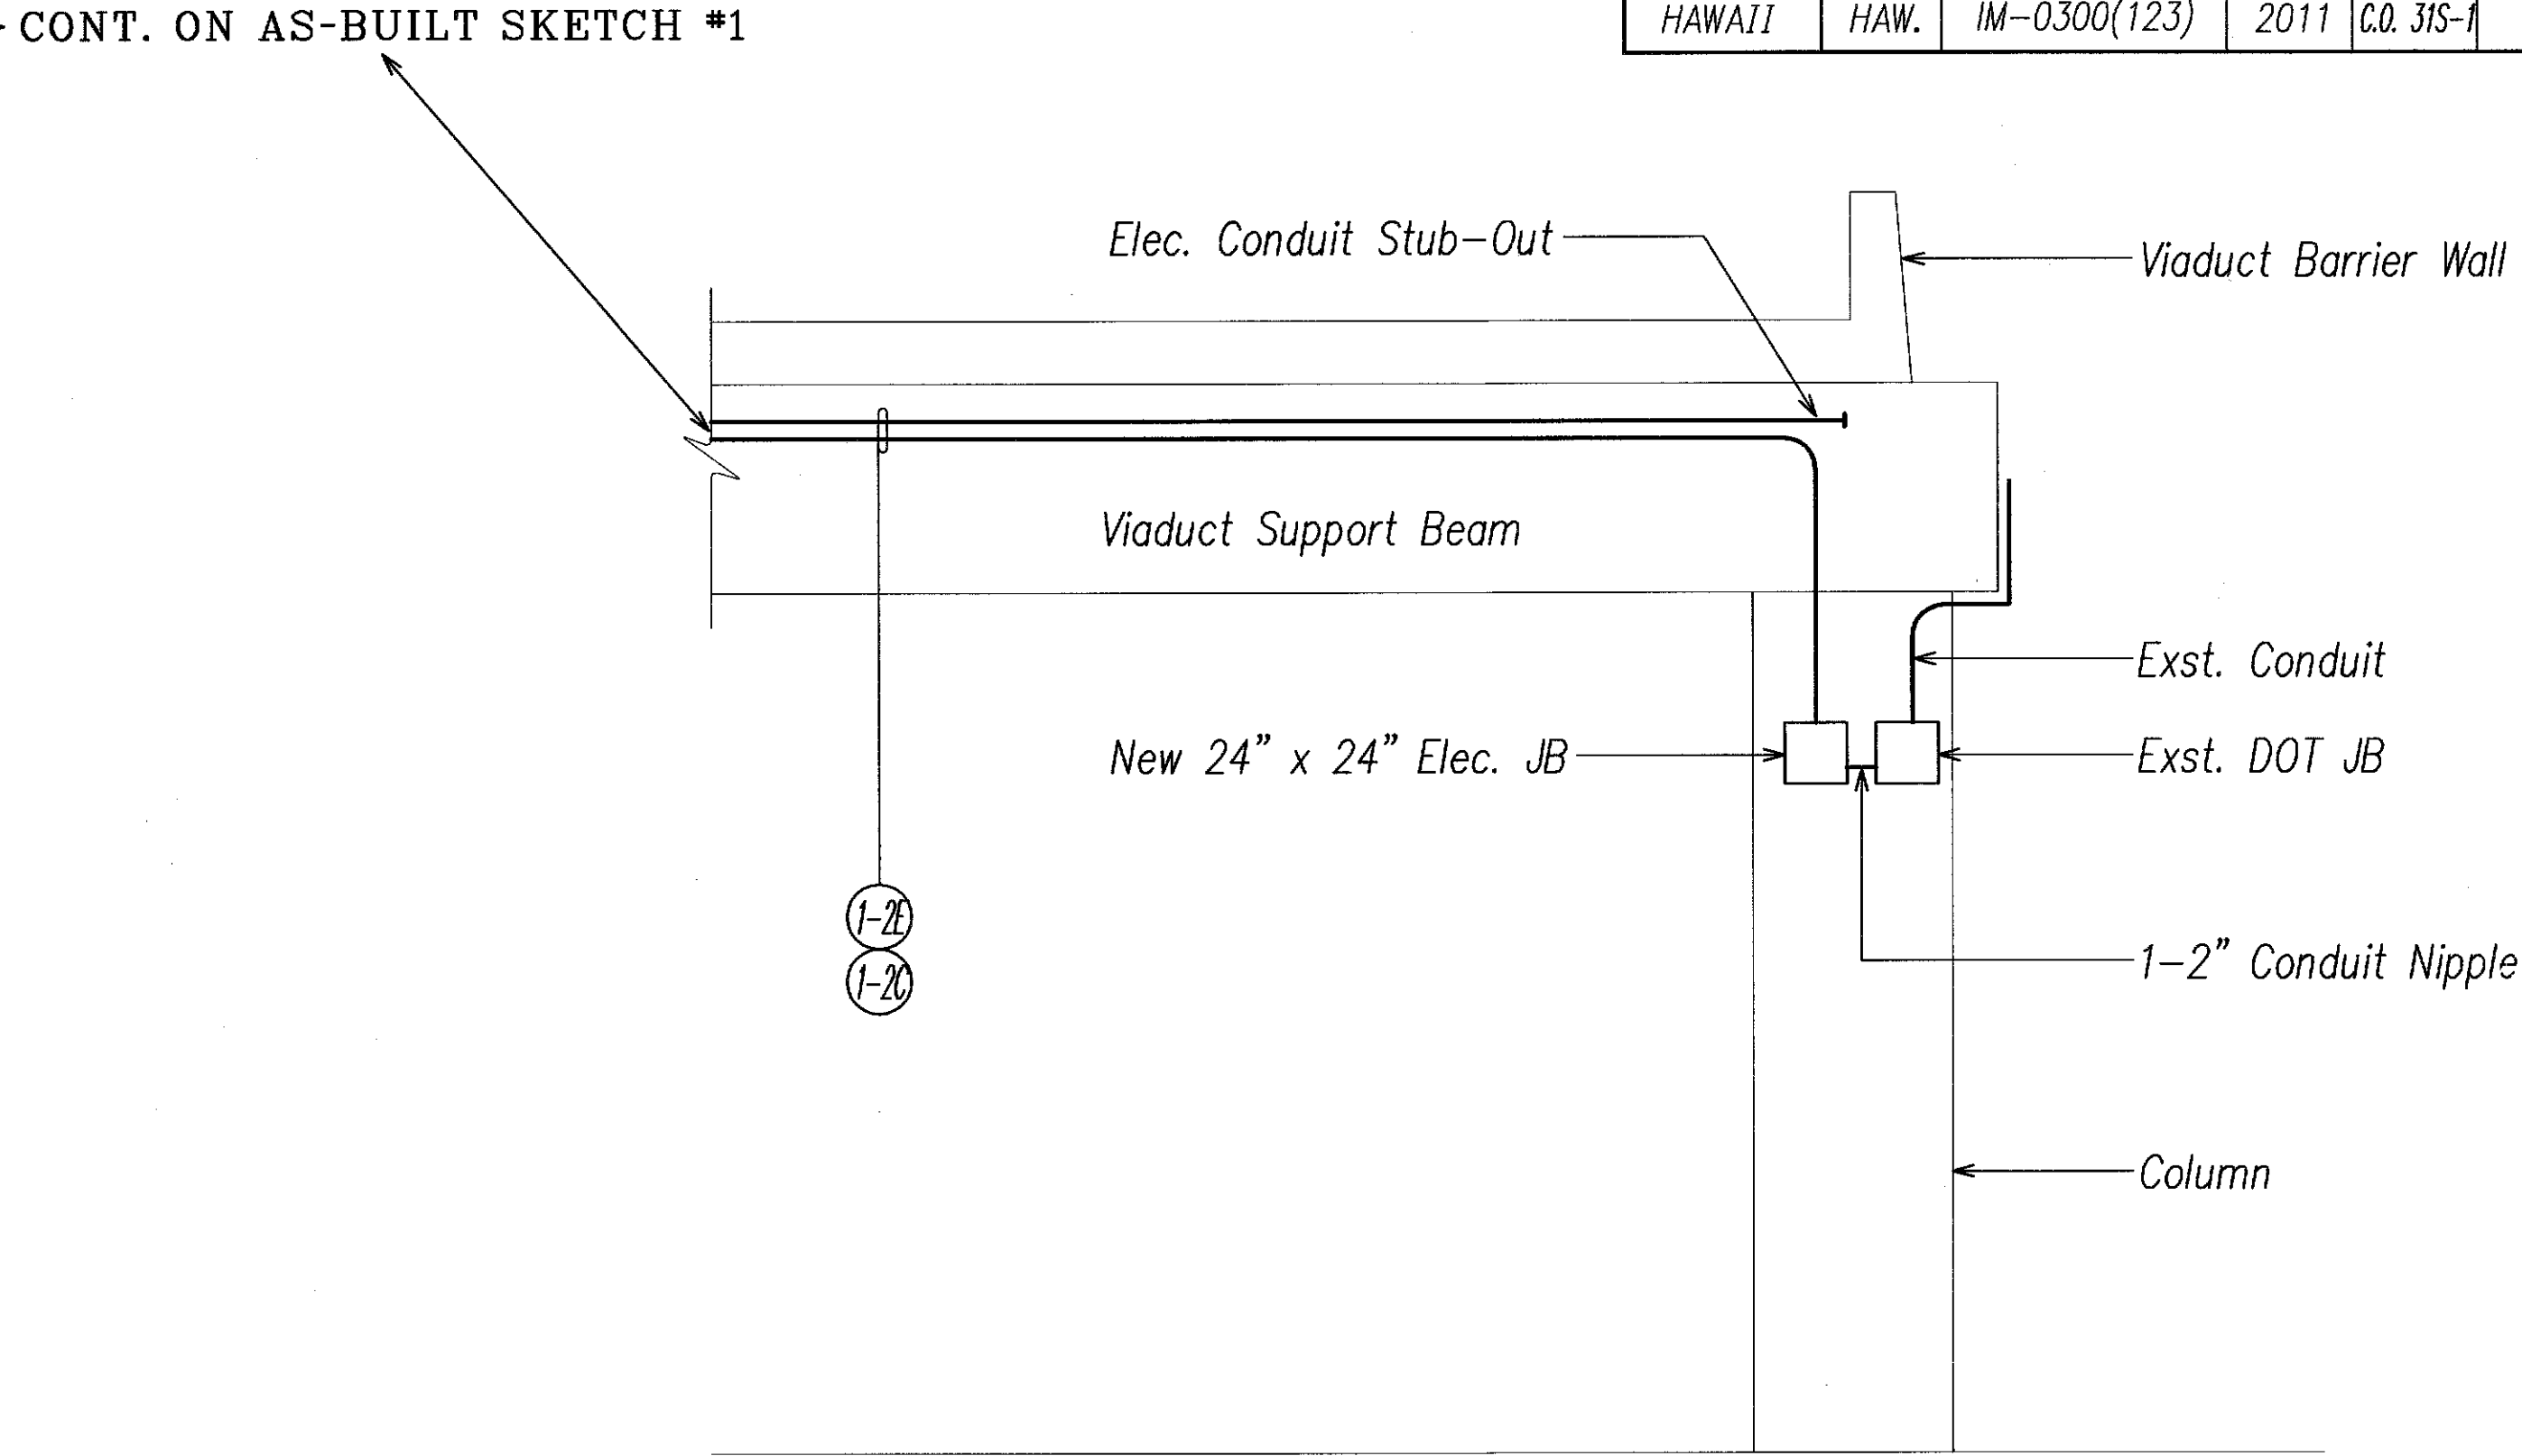

East Elevation  
At Ahua St. Median Column  
As Built Sketch #3  
n.t.s.

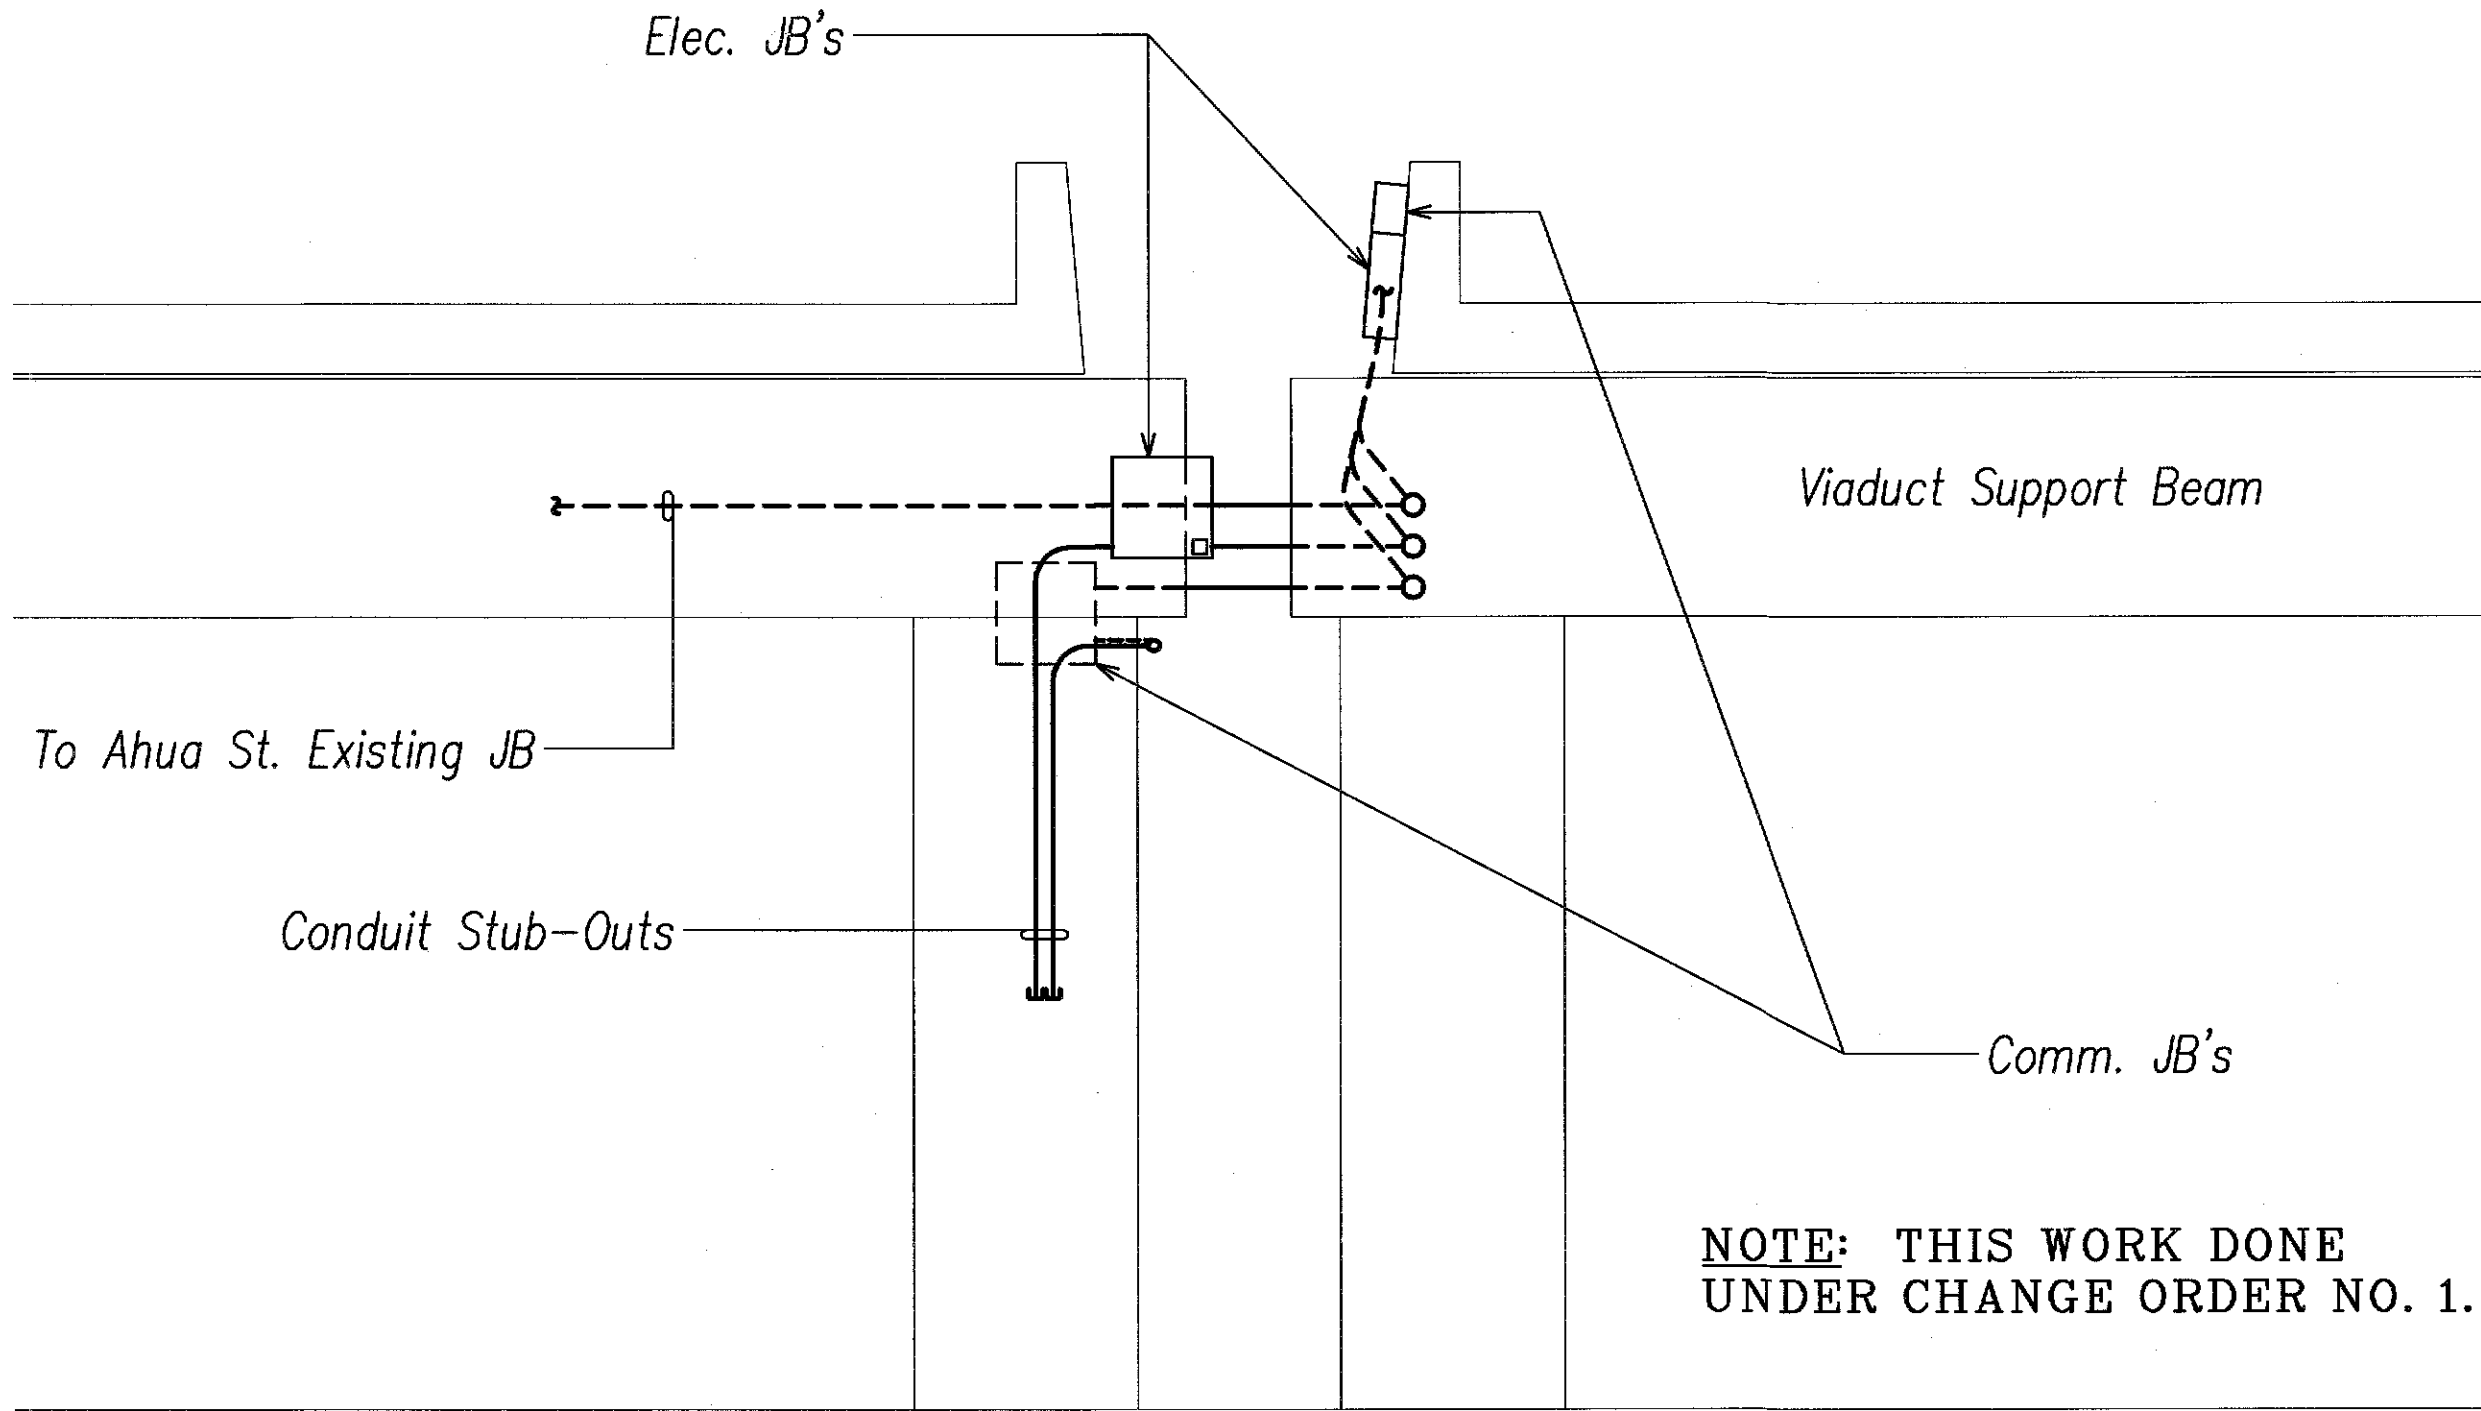

West Elevation  
At Ahua St. Median  
As Built Sketch #2  
n.t.s.

NOTE: THIS WORK DONE  
UNDER CHANGE ORDER NO. 1.


1	2/20/13	NEW SHEET, ADDED MORE JUNCTION BOXES
NO.	DATE	REVISION

**LEGEND FOR AS-BUILT POSTINGS**

~~~~~ Squiggly line for as-built deletion

==== Double line for as-built deletion

Roadway Text for as-built posting

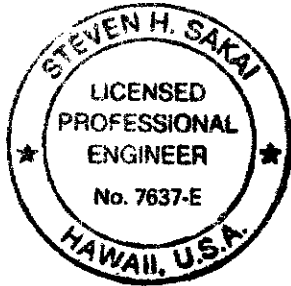

*Steven H. Sakai*  
THIS WORK WAS PREPARED BY ME  
OR UNDER MY SUPERVISION  
EXP: 4/30/12

STATE OF HAWAII  
DEPARTMENT OF TRANSPORTATION  
HIGHWAYS DIVISION

**As-Built Details**

Freeway Management System, Phase 1C,  
Part 1A: Communication and  
Power Infrastructure  
Federal Aid Project No. IM-0300(123)

SCALE: As Noted DATE: 3-28-11

SHEET No. OF 26 SHEETS

C.O. 31S-1

"AS-BUILT"

|                   |      |
|-------------------|------|
| SURVEY PLOTTED BY | DATE |
| DRAWN BY          |      |
| DESIGNED BY       |      |
| NOTED BY          |      |
| CHECKED BY        |      |
| QUANTITIES BY     |      |
| NO.               |      |

LAST DATE: 10/20/11  
Z:\Road\PROJECTS\100018\As-Built\31S-1\201108\_Asbuilt\_Asbuilt