

INDEX TO DRAWINGS	
SHEET NO.	DESCRIPTION
1	TITLE SHEET
2	STATE STANDARD PLAN SUMMARY
3	CONSTRUCTION NOTES & ABBREVIATIONS
4-8	CONSTRUCTION NOTES
9	SYMBOL LIST
10	SITE PLAN
11-31 ①	ELECTRICAL DISTRIBUTION PLANS
32	CONDUIT INSTALLATION DETAIL
33-34	CONDUIT ROUTING DETAILS
35	CONDUIT SUPPORT DETAILS
36-65	TRAFFIC CONTROL PLANS

Sheet No. ① C.O.315-1 is a Supplementary Sheet to this project. Total Sheet Count After "AS-BUILT" posting is 66 sheets.

STATE OF HAWAII

DEPARTMENT OF TRANSPORTATION

HIGHWAYS DIVISION

HONOLULU, HAWAII

AS-BUILT

PLANS FOR

FREEWAY MANAGEMENT SYSTEM, PHASE 1C,


PART 1A: COMMUNICATION AND POWER

INFRASTRUCTURE

FEDERAL-AID PROJECT NO. IM-0300(123)

DISTRICT OF HONOLULU

ISLAND OF OAHU


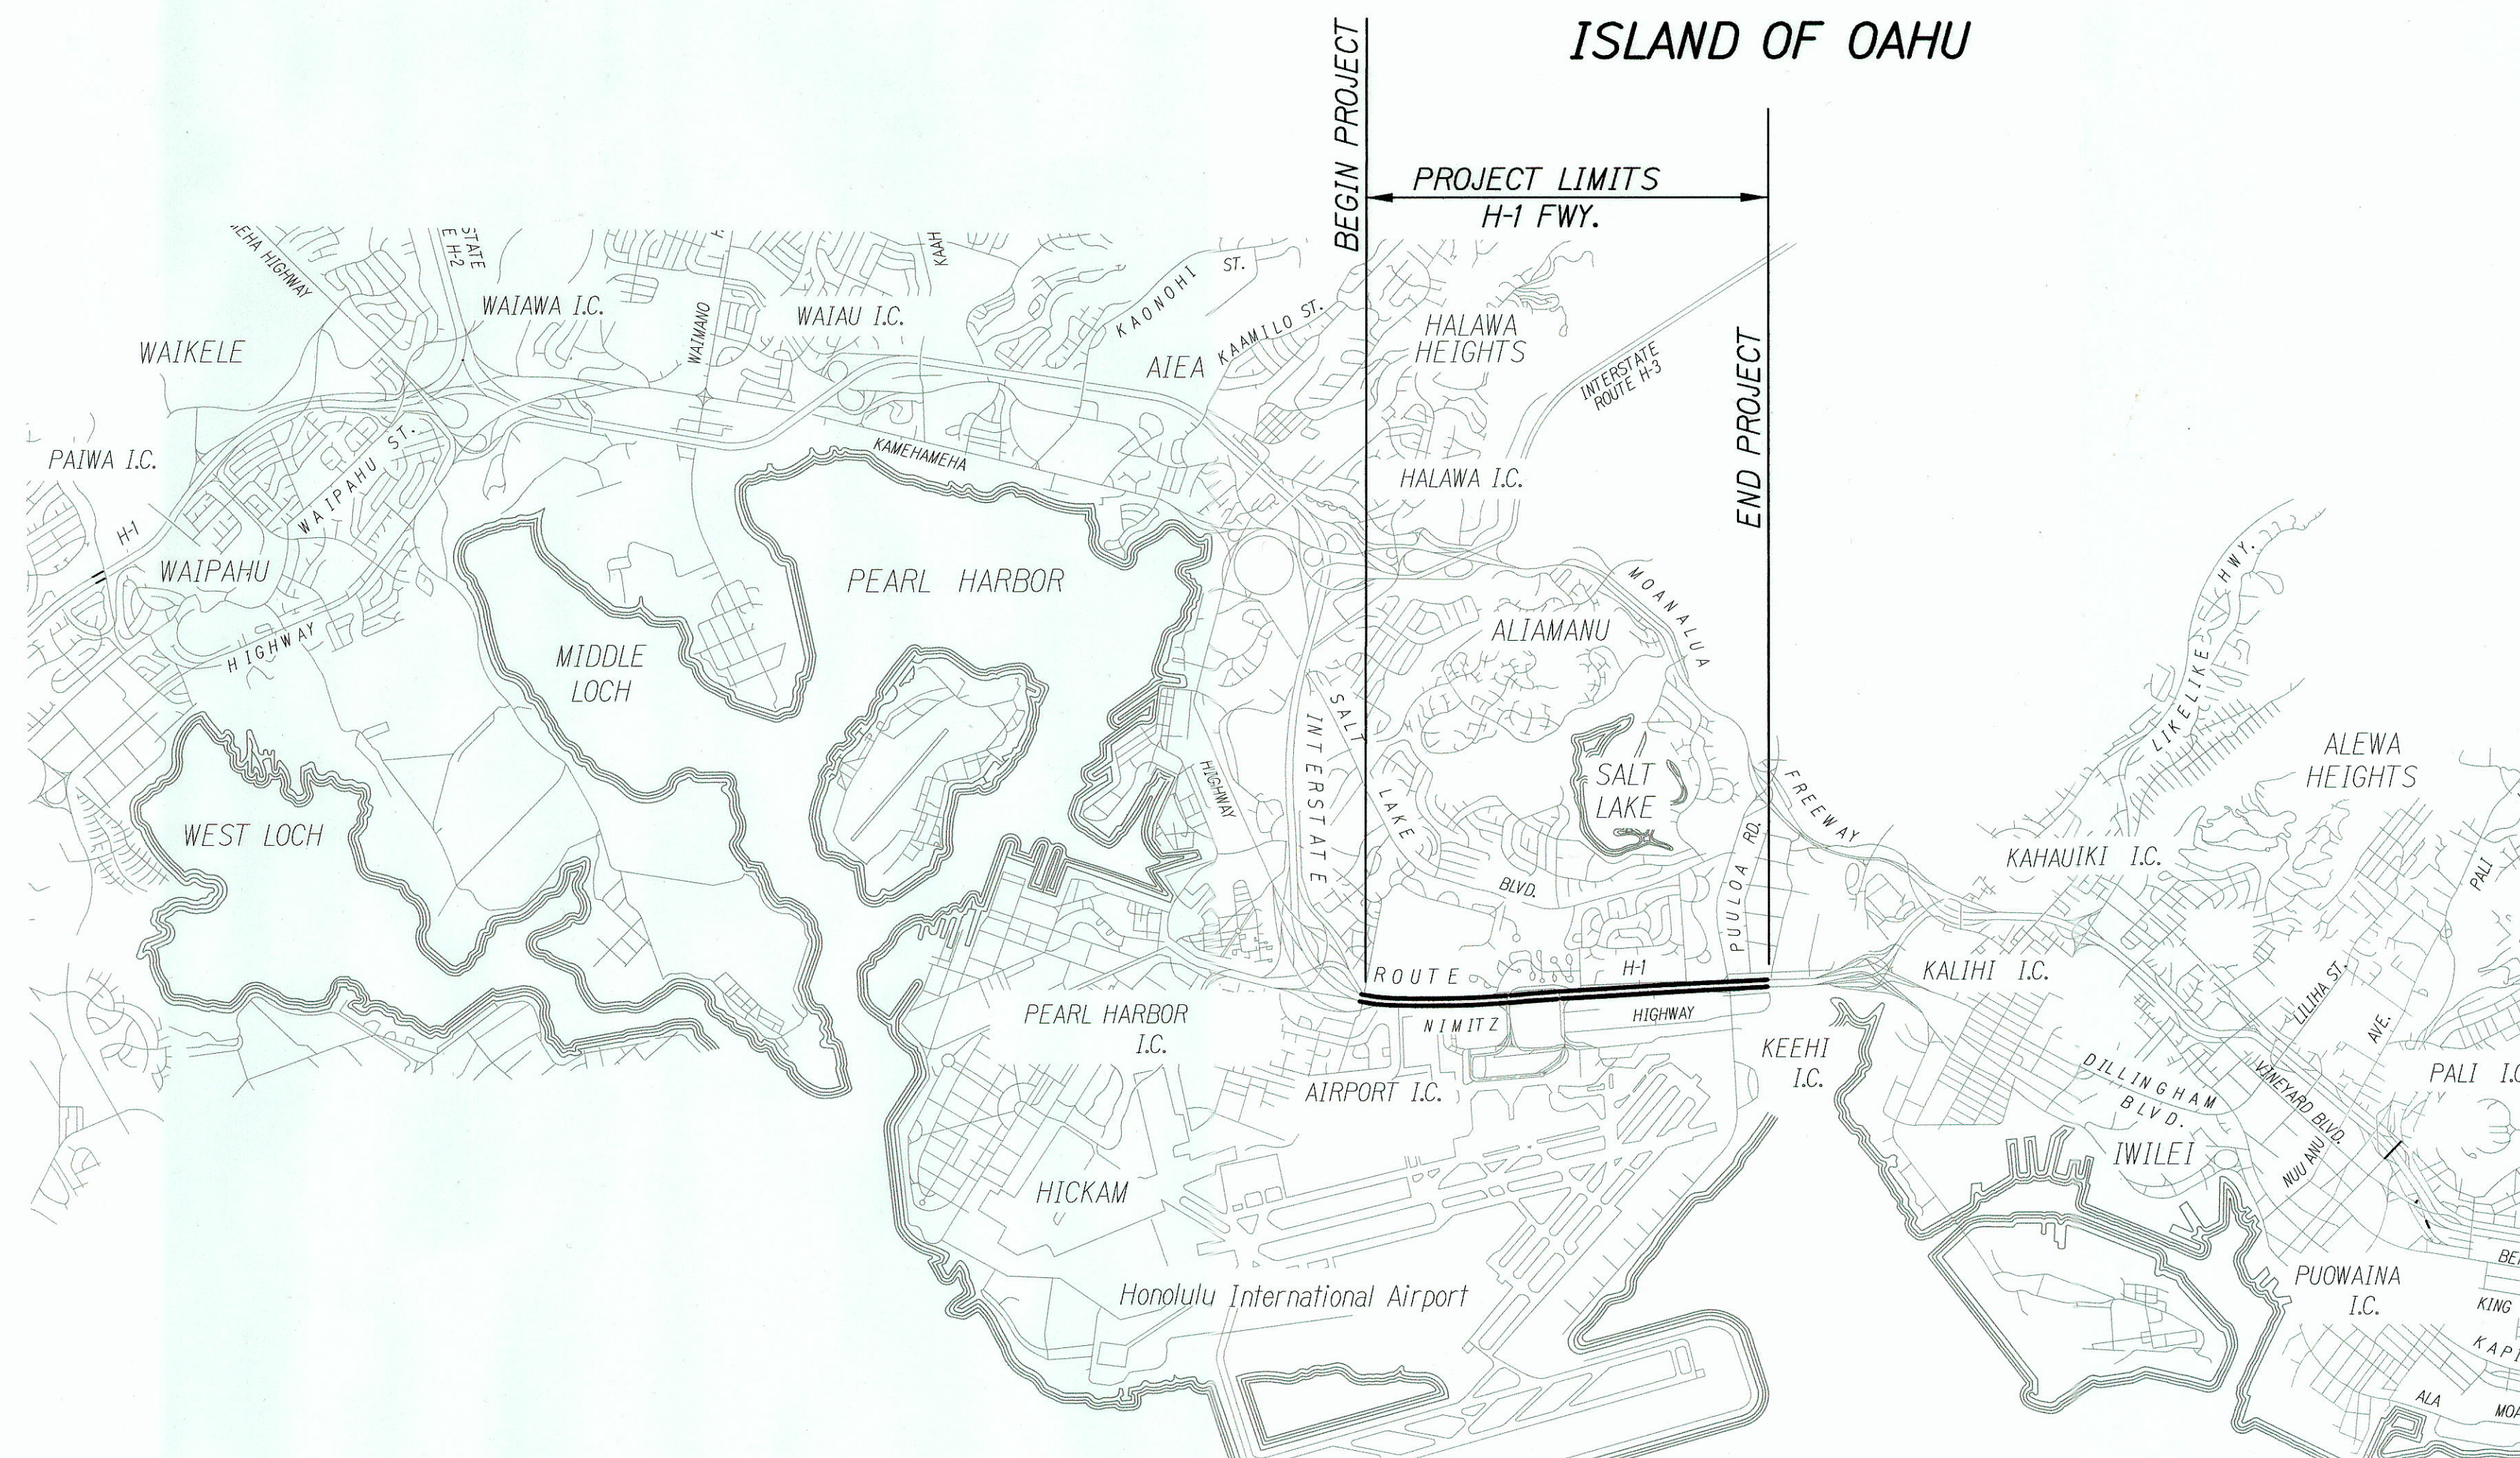


N

LAYOUT PLAN

NOT TO SCALE

FED. ROAD DIST. NO.	STATE	FEDERAL AID PROJ. NO.	FISCAL YEAR	SHEET NO.	TOTAL SHEETS
HAWAII	HAW.	IM-0300(123)	2011	1	65

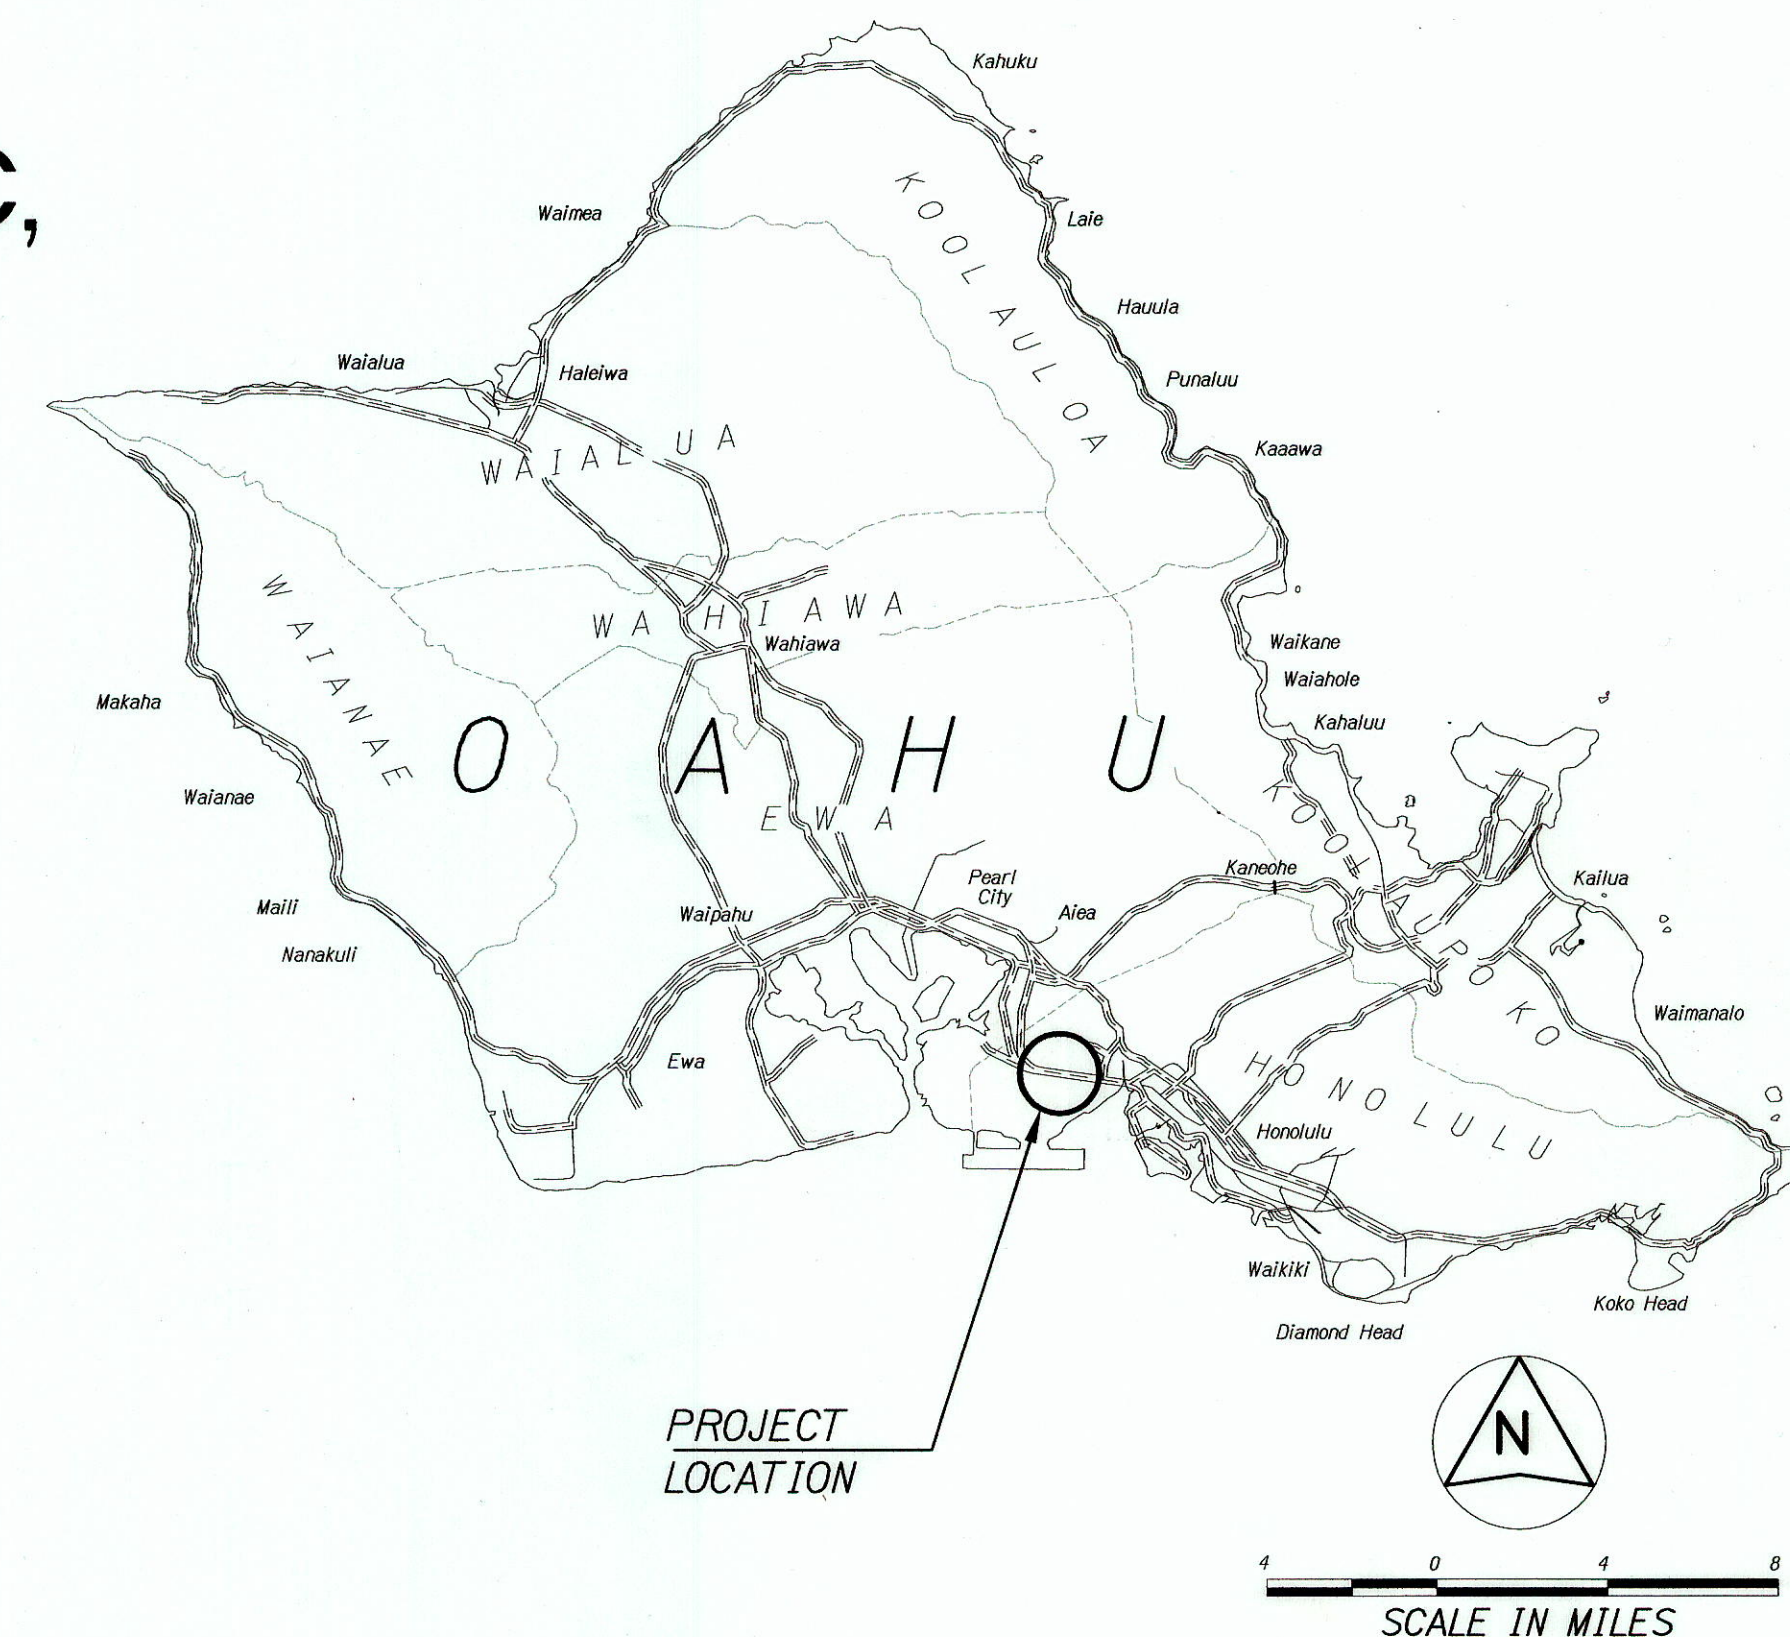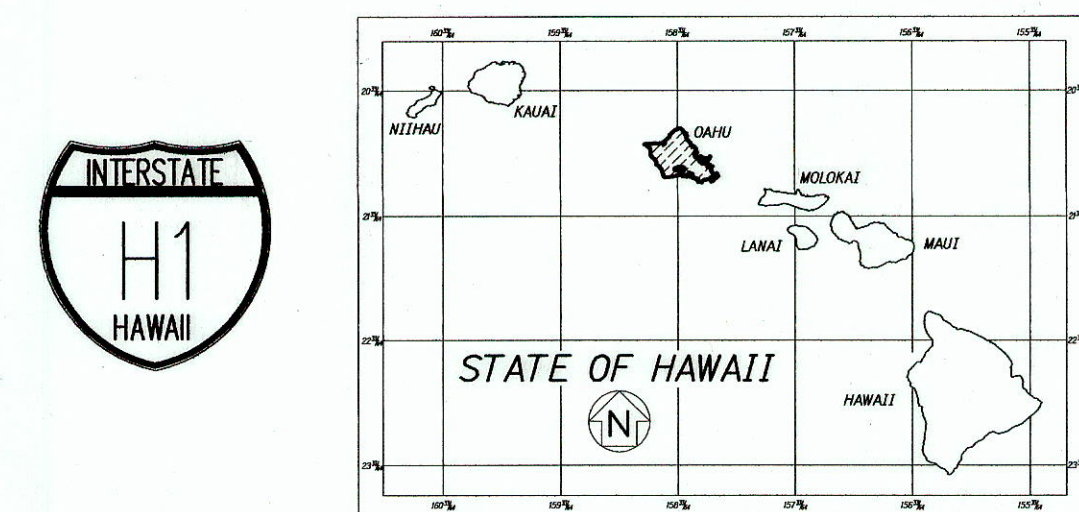

FEDERAL AID PROJECTS PREVIOUSLY CONSTRUCTED OR UNDER CONSTRUCTION

H-1 MILE POST 15.75 TO MILE POST 17.83

CHANGES MADE DURING CONSTRUCTION HAVE BEEN INCORPORATED ON THESE PLANS EXCEPT CHANGES IN THE ORIGINAL THEORETICAL QUANTITIES. FOR ACTUAL QUANTITIES, REFER TO PROJECT LEDGER AND/OR COMPUTATION BOOK.

RESIDENT ENGINEER 09/04/2011 DATE

DEPARTMENT OF TRANSPORTATION
STATE OF HAWAII

APPROVED: 4/3/11 DATE

DIR. OF TRANSPORTATION