

INDEX TO DRAWINGS	
SHEET NO.	DESCRIPTION
1	TITLE SHEET
2-3	SHEET INDEX
4-72	STRUCTURAL DRAWINGS
73-86	ELECTRICAL DRAWINGS
87-138	TRAFFIC CONTROL DRAWINGS

STATE OF HAWAII

DEPARTMENT OF TRANSPORTATION

HIGHWAYS DIVISION

HONOLULU, HAWAII

"AS-BUILT"


PLANS FOR

INTERSTATE ROUTE H-1, H-2 AND H201
DESTINATION SIGN UPGRADE / REPLACEMENT, PHASE 1



FEDERAL AID PROJECT NO. NH-IM-0300 (75)

ISLAND OF OAHU

FED. ROAD DIST. NO.	STATE	FED. AID PROJ. NO.	FISCAL YEAR	SHEET NO.	TOTAL SHEETS
HAWAII	HAW.	NH-IM-0300 (75)	2012	1	138

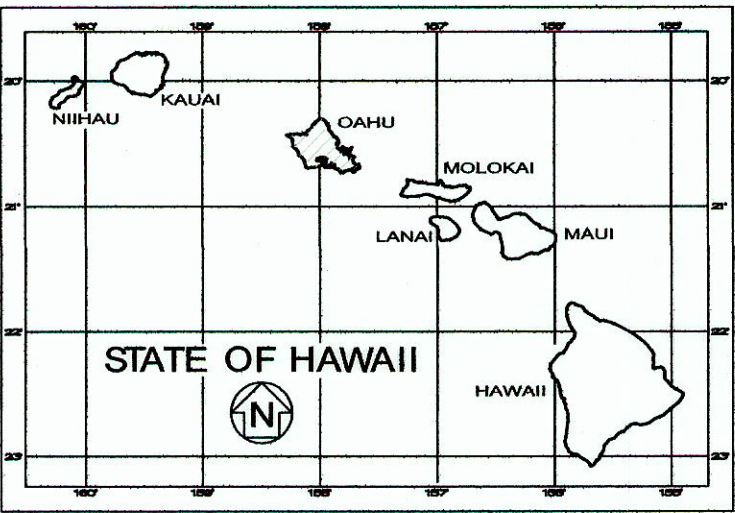

LOCATION OF PROJECT

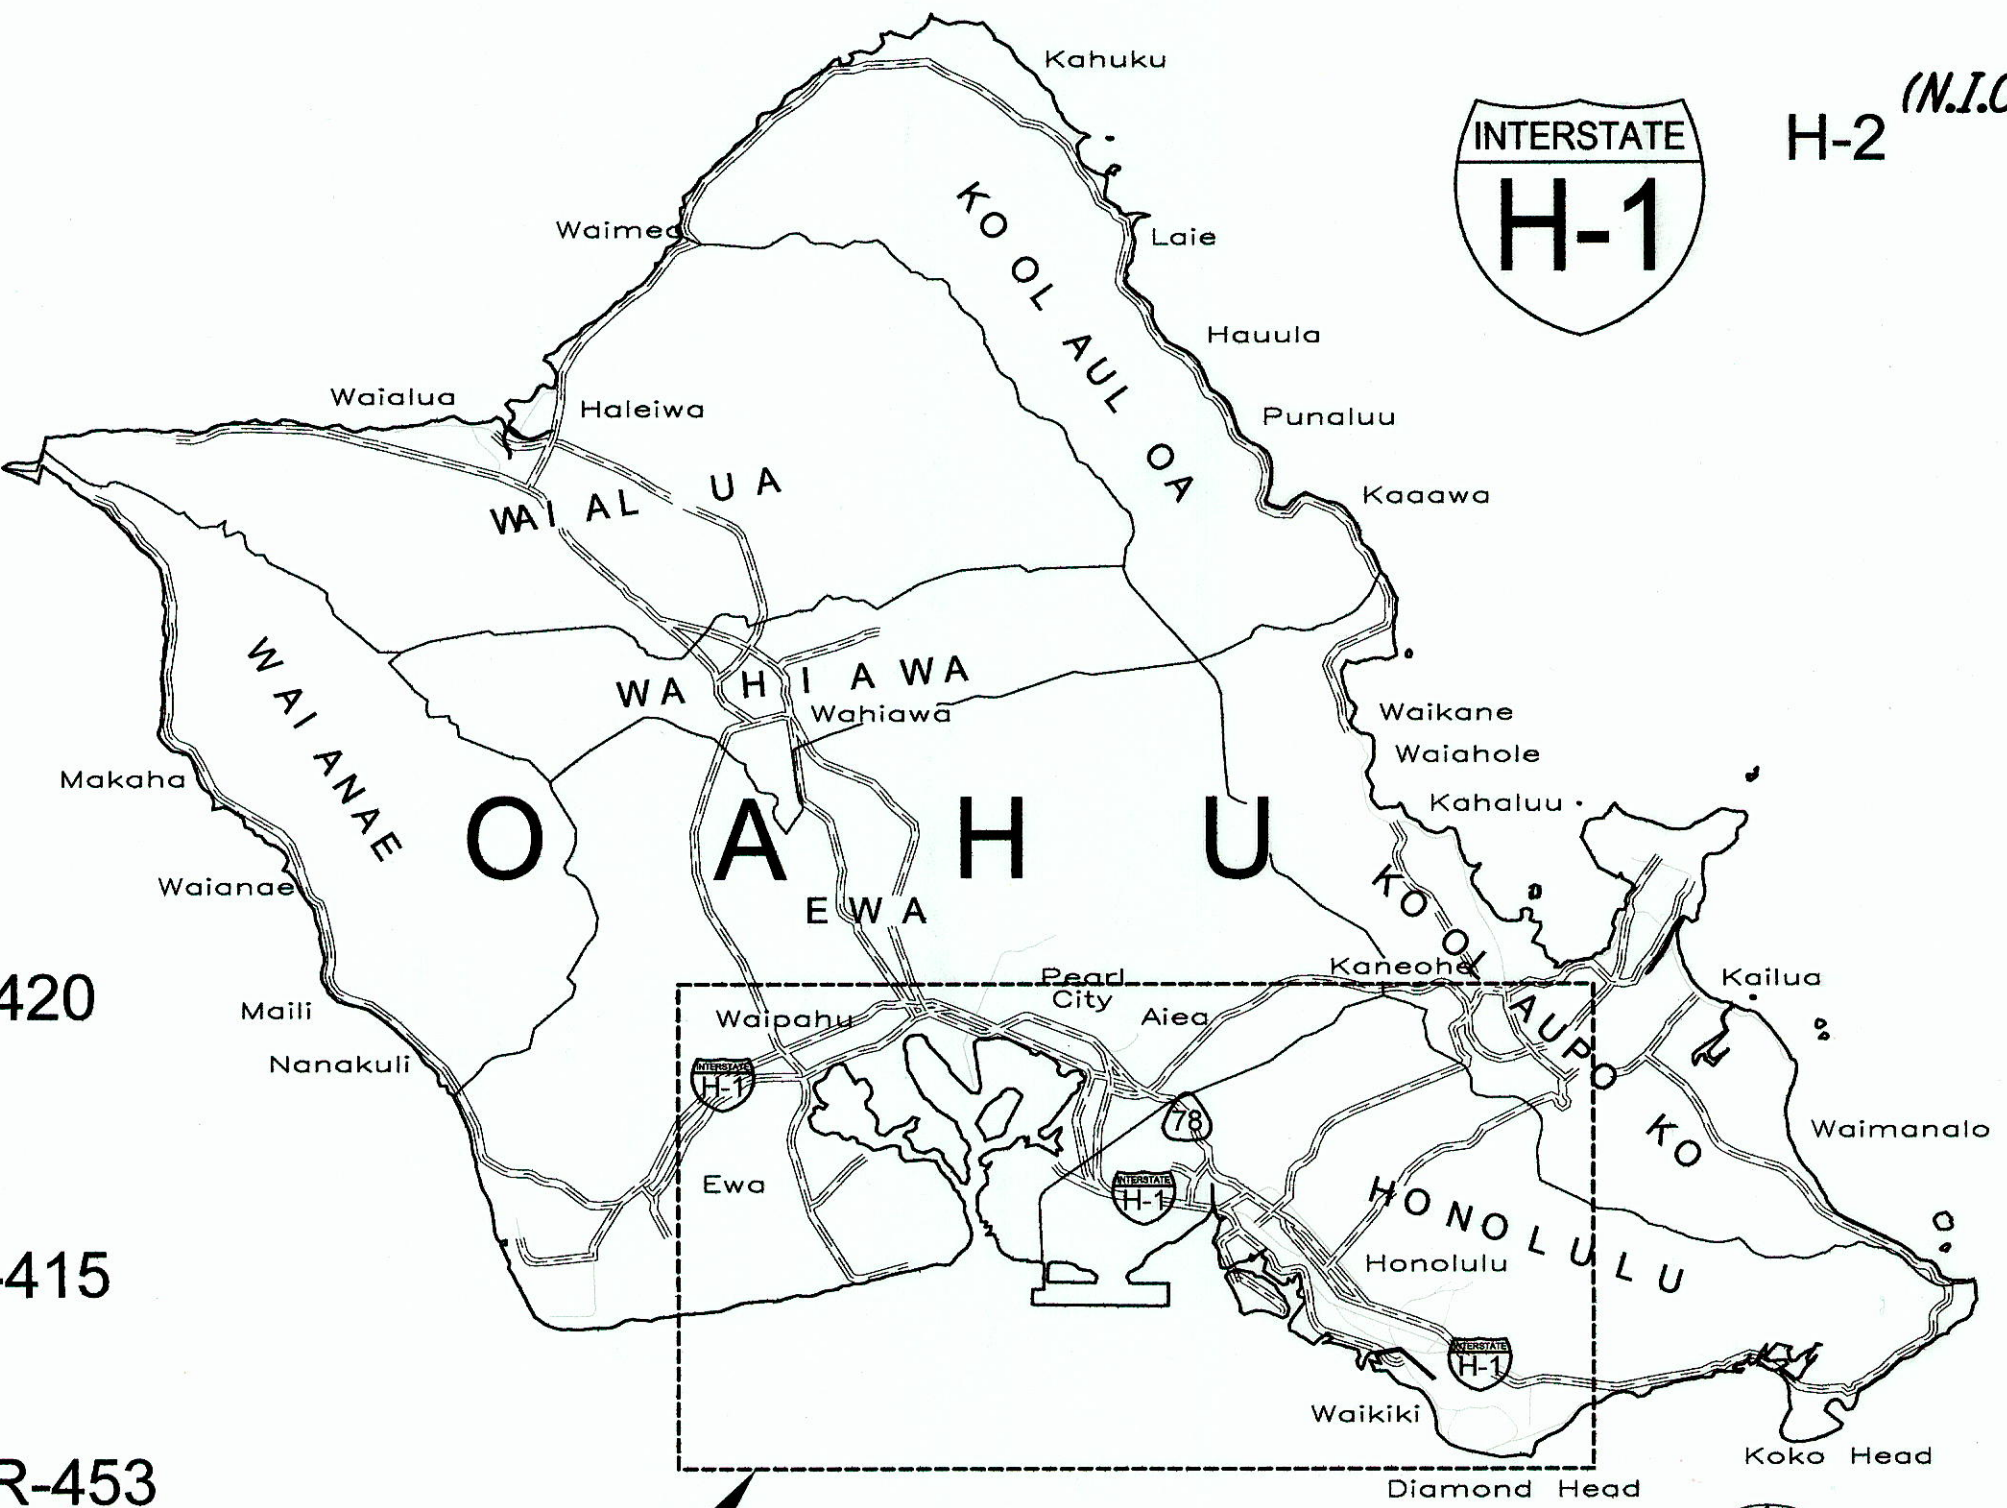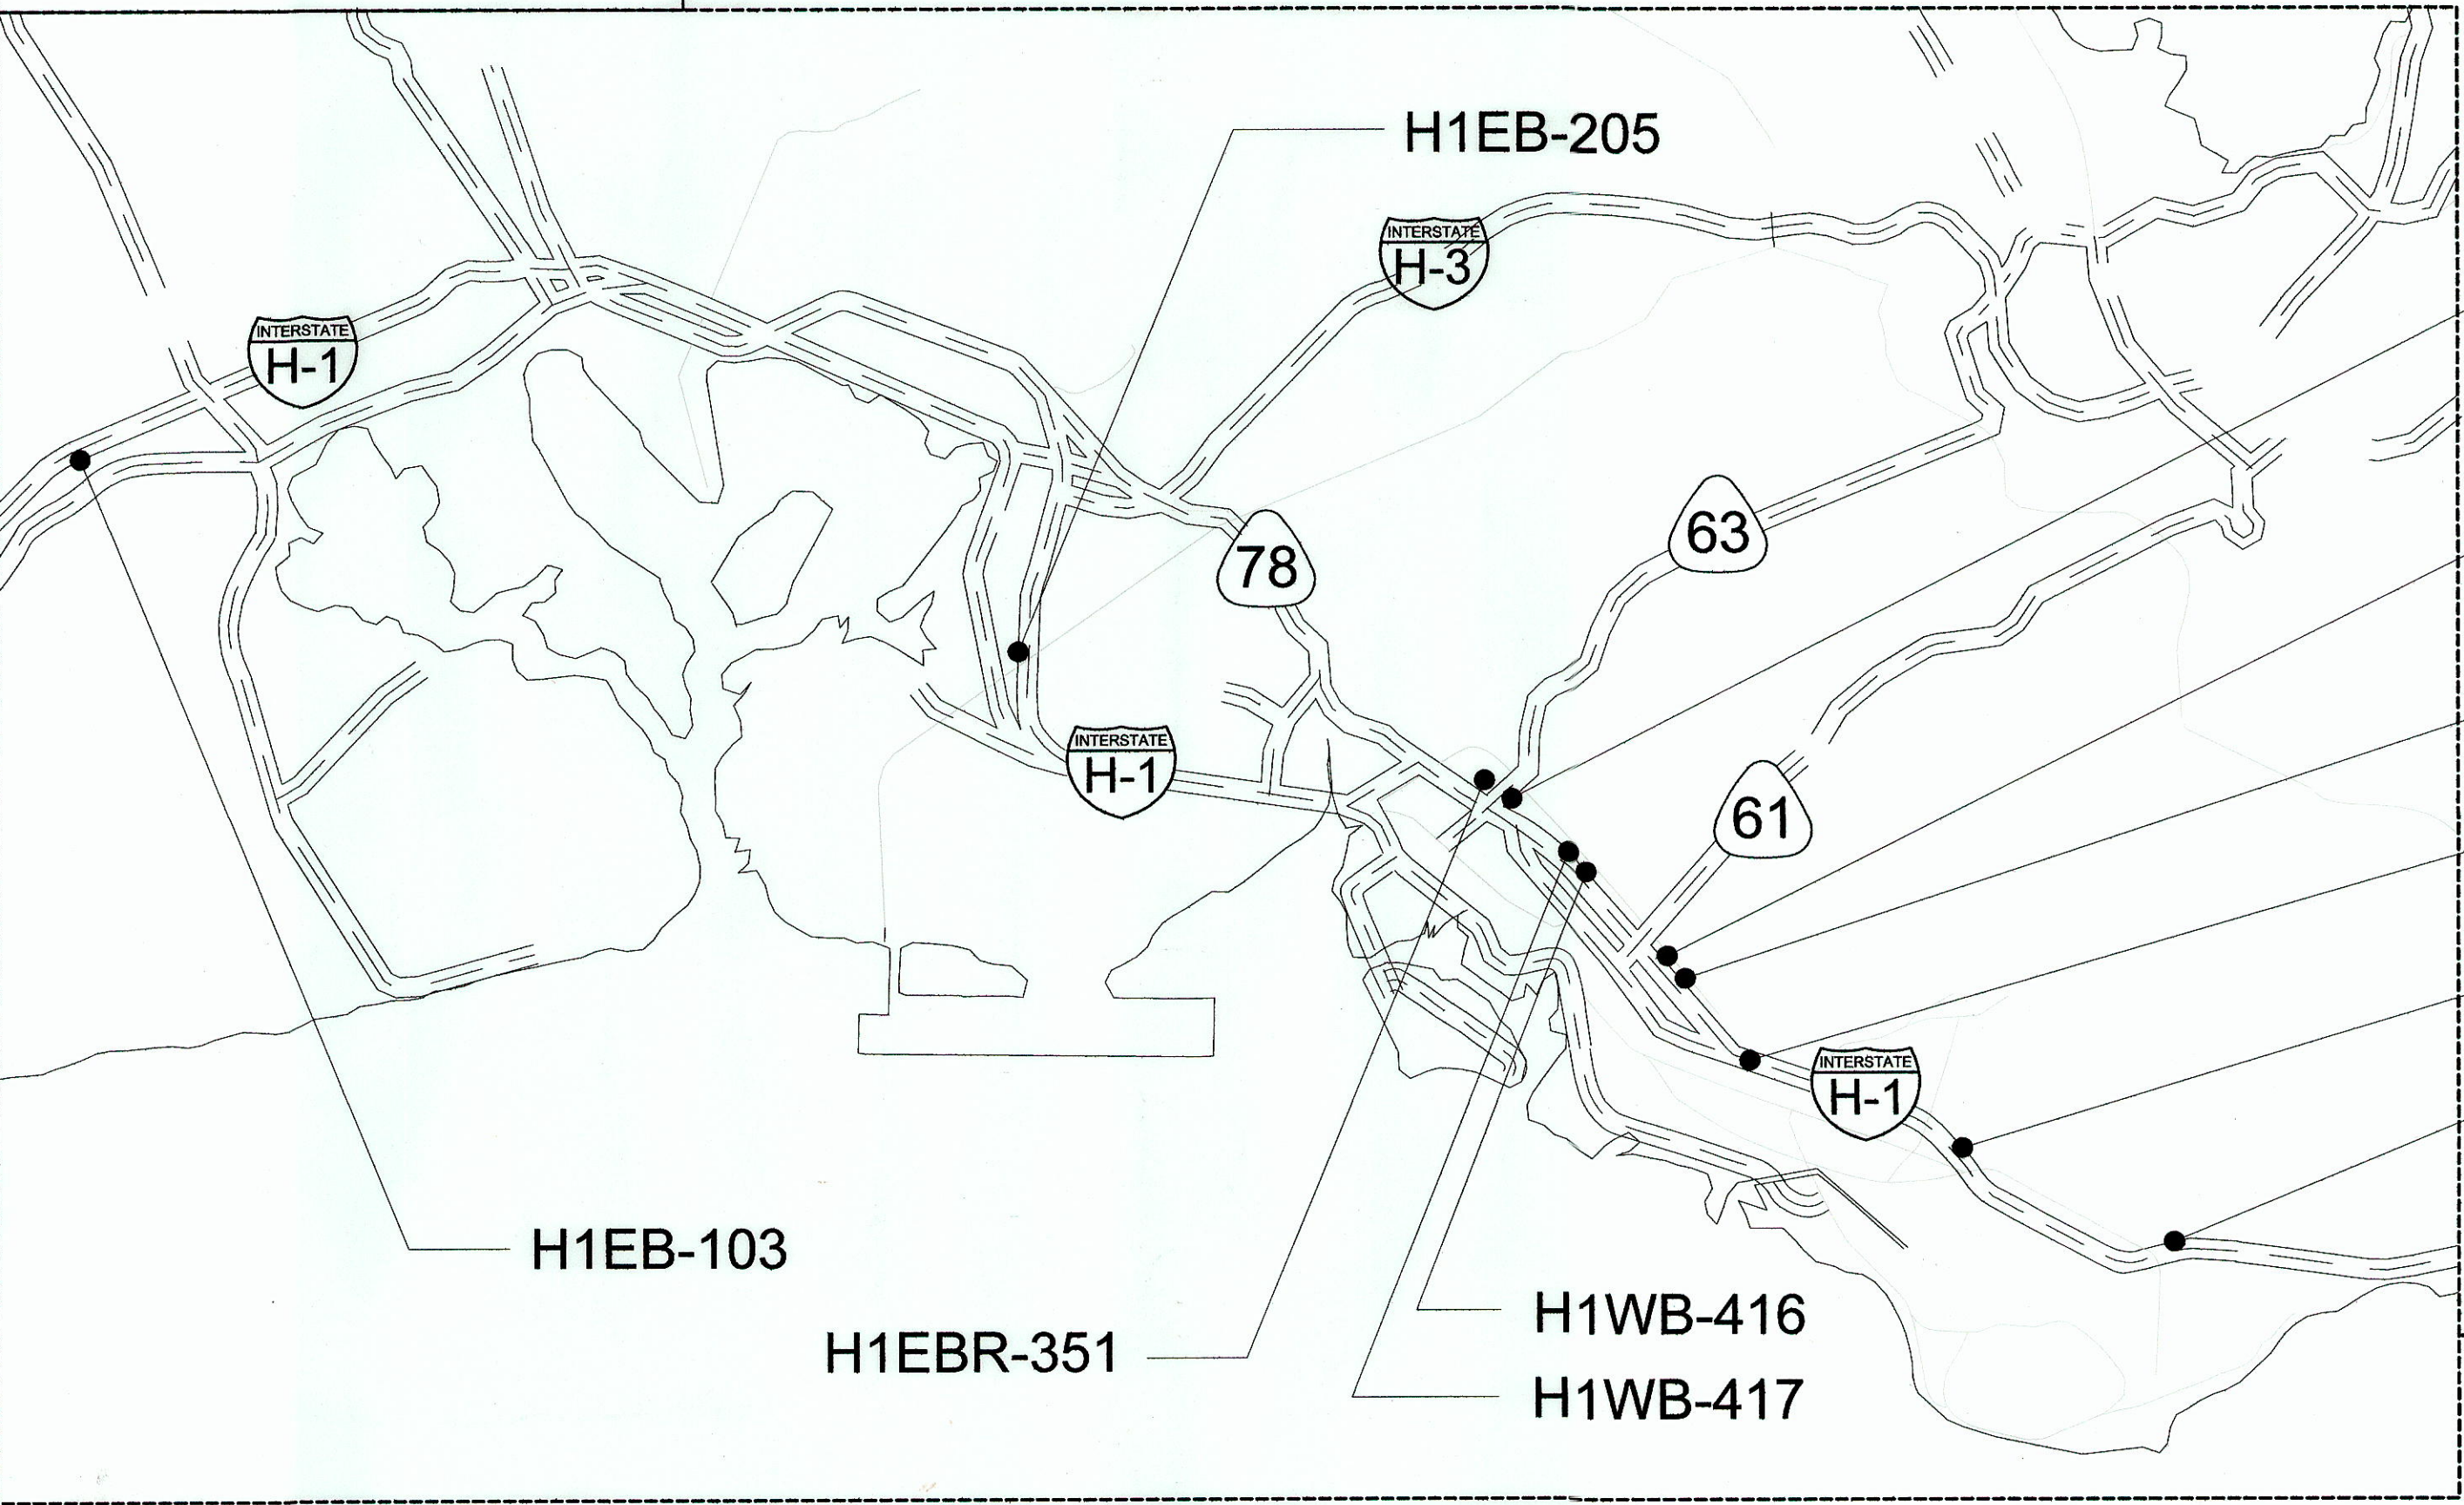

H-2 (N.I.C.)

H201 (N.I.C.)



FEDERAL AID PROJECTS PREVIOUSLY CONSTRUCTED OR UNDER CONSTRUCTION



NO SIGNIFICANT CHANGES WERE MADE DURING CONSTRUCTION ON THESE PLANS EXCEPT CHANGES IN THE ORIGINAL THEORETICAL QUANTITIES. FOR ACTUAL QUANTITIES, REFER TO PROJECT LEDGER AND/OR COMPUTATION BOOK.
Man C. H. J. 4/28/2015
RESIDENT ENGINEER DATE

DEPARTMENT OF TRANSPORTATION
STATE OF HAWAII
APPROVED:
for DIR. OF TRANSPORTATION
10/02/12
DATE

MANAGED BY
DESIGNED BY
KAI HAWAII, INC.
HWY-DB
692-7614
September 2012
PHONE
DATE