


FED. ROAD DIST. NO.	STATE	PROJ. NO.	FISCAL YEAR	SHEET NO.	TOTAL SHEETS
HAWAII	HAW.	HWY-0-08-14	2016	ADD. 11	88

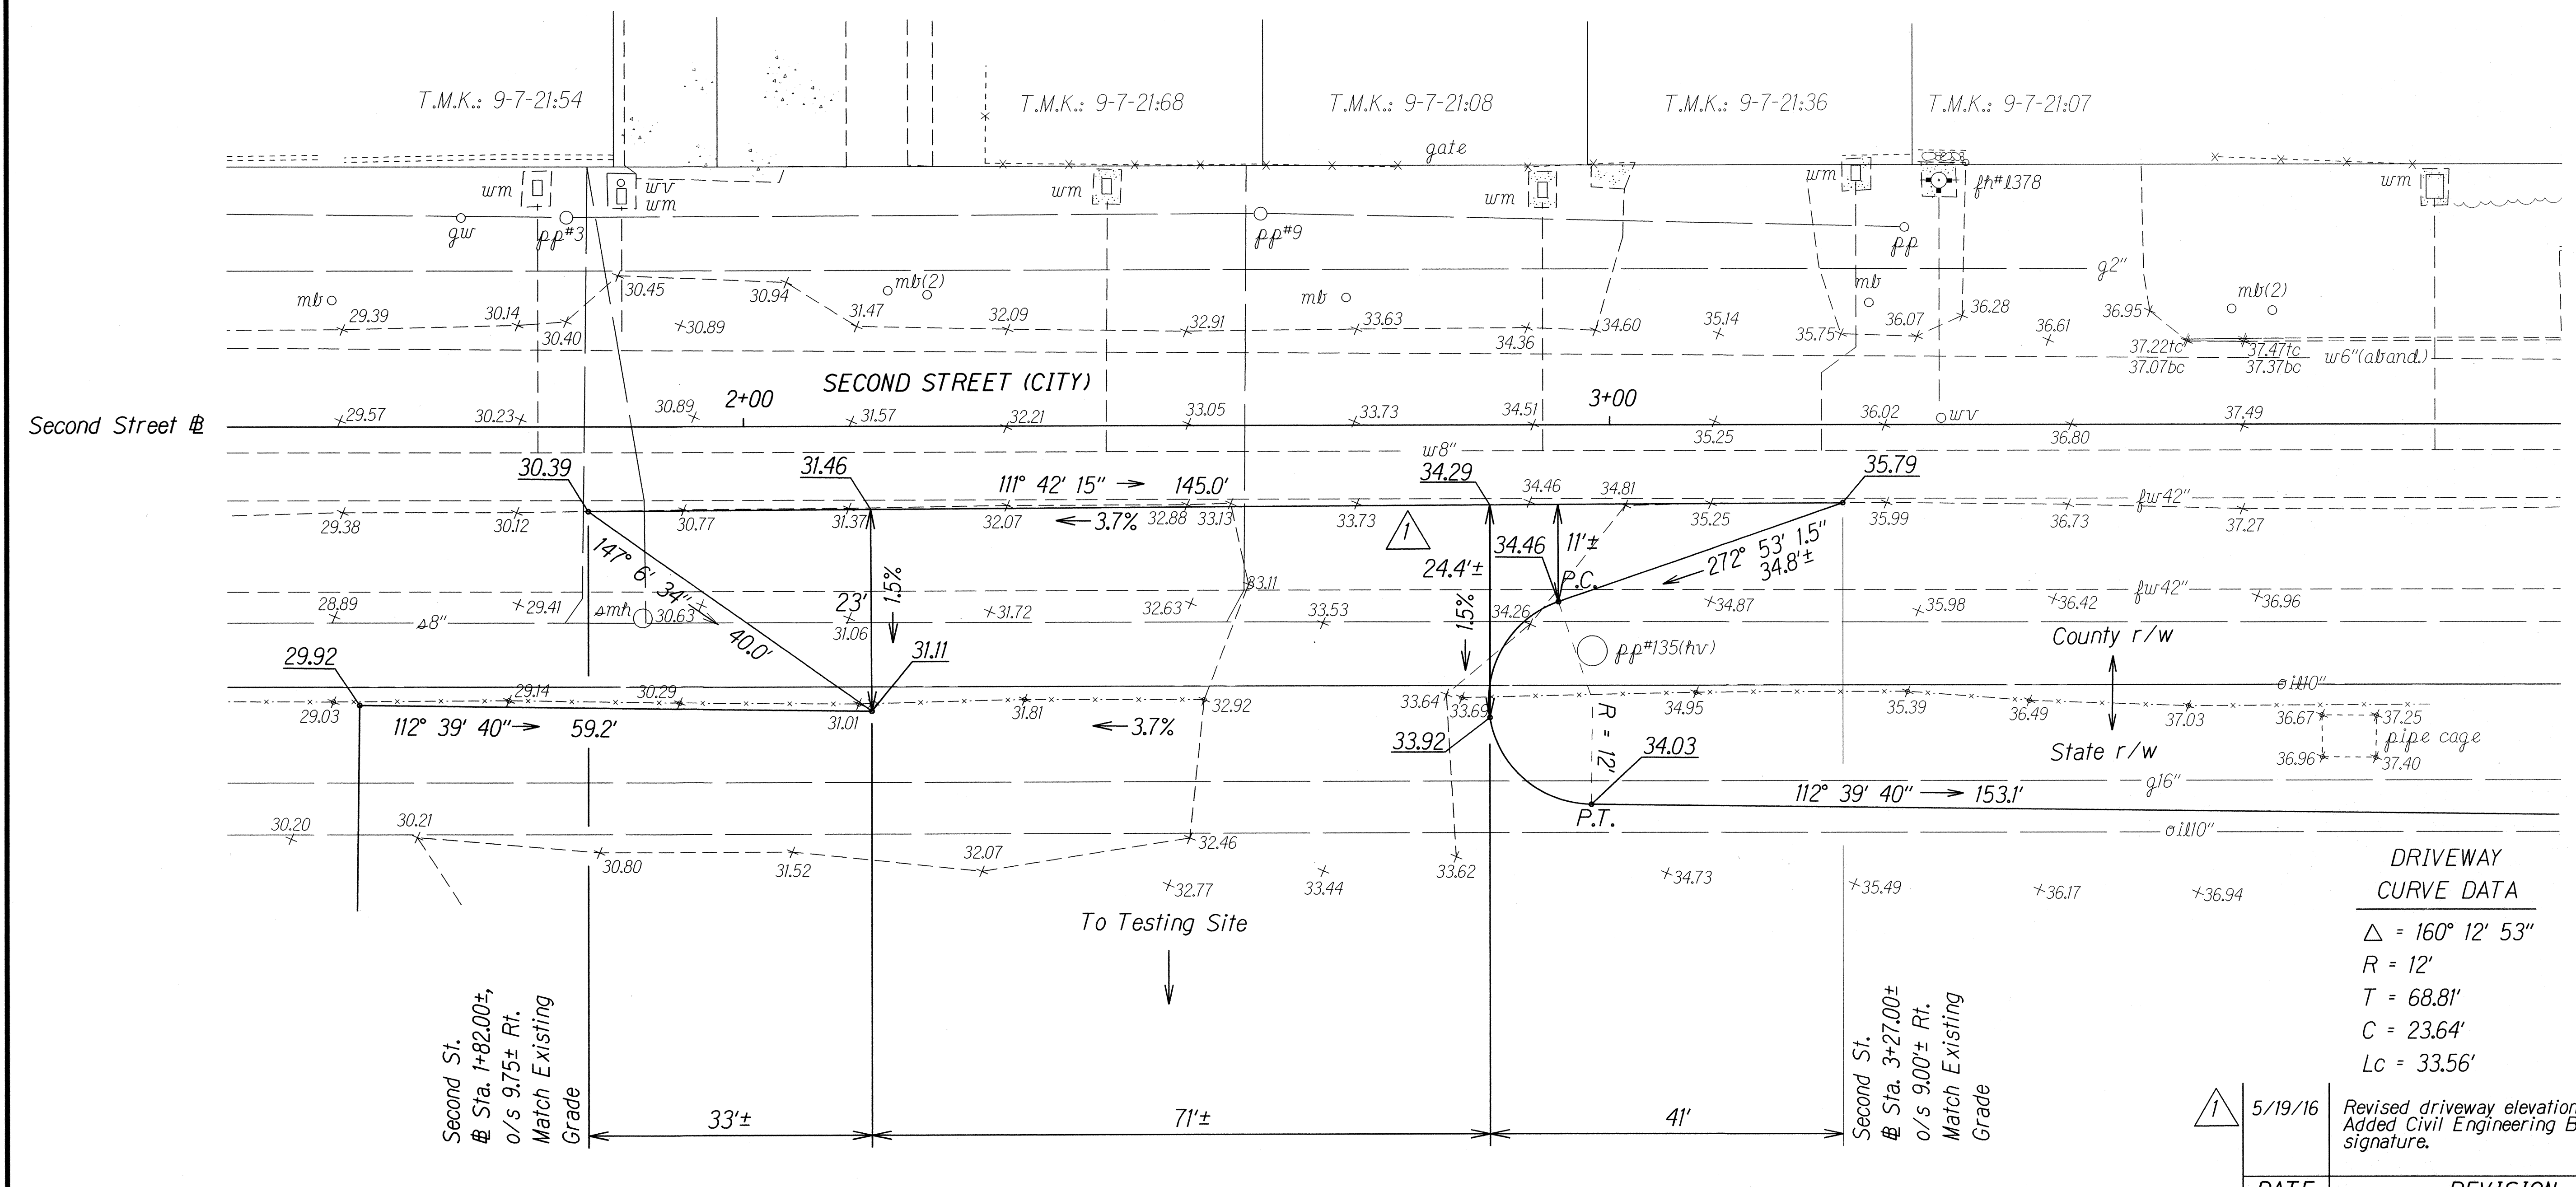

DRIVEWAY DETAIL AT SECOND ST. @ STA. 1+82± RT. to SECOND ST. @ STA. 3+27± LT.

APPROVED:

Melvin J. [Signature]
CHIEF, CIVIL ENGINEERING BRANCH, DPP
(For work within City R/W only)

5/19/16
Revised driveway elevations and slope.
Added Civil Engineering Branch signature.

DATE	REVISION
------	----------

STATE OF HAWAII
DEPARTMENT OF TRANSPORTATION
HIGHWAYS DIVISION

DRIVEWAY GRADING DETAILS

COMMERCIAL DRIVER'S LICENSE AND
MOTORCYCLE LICENSE TESTING FACILITY
EXAMINATION SITE AND OFFICE RENOVATION
Beneath Interstate Route H-1 Pearl City Viaduct
Project No. HWY-0-08-14

Scale: 1"=10' Date: May 2016

SHEET No. 1 OF 1 SHEETS