


FED. ROAD DIST. NO.	STATE	PROJ. NO.	FISCAL YEAR	SHEET NO.	TOTAL SHEETS
HAWAII	HAW.	HWY-0-08-14	2016	ADD. 10	88

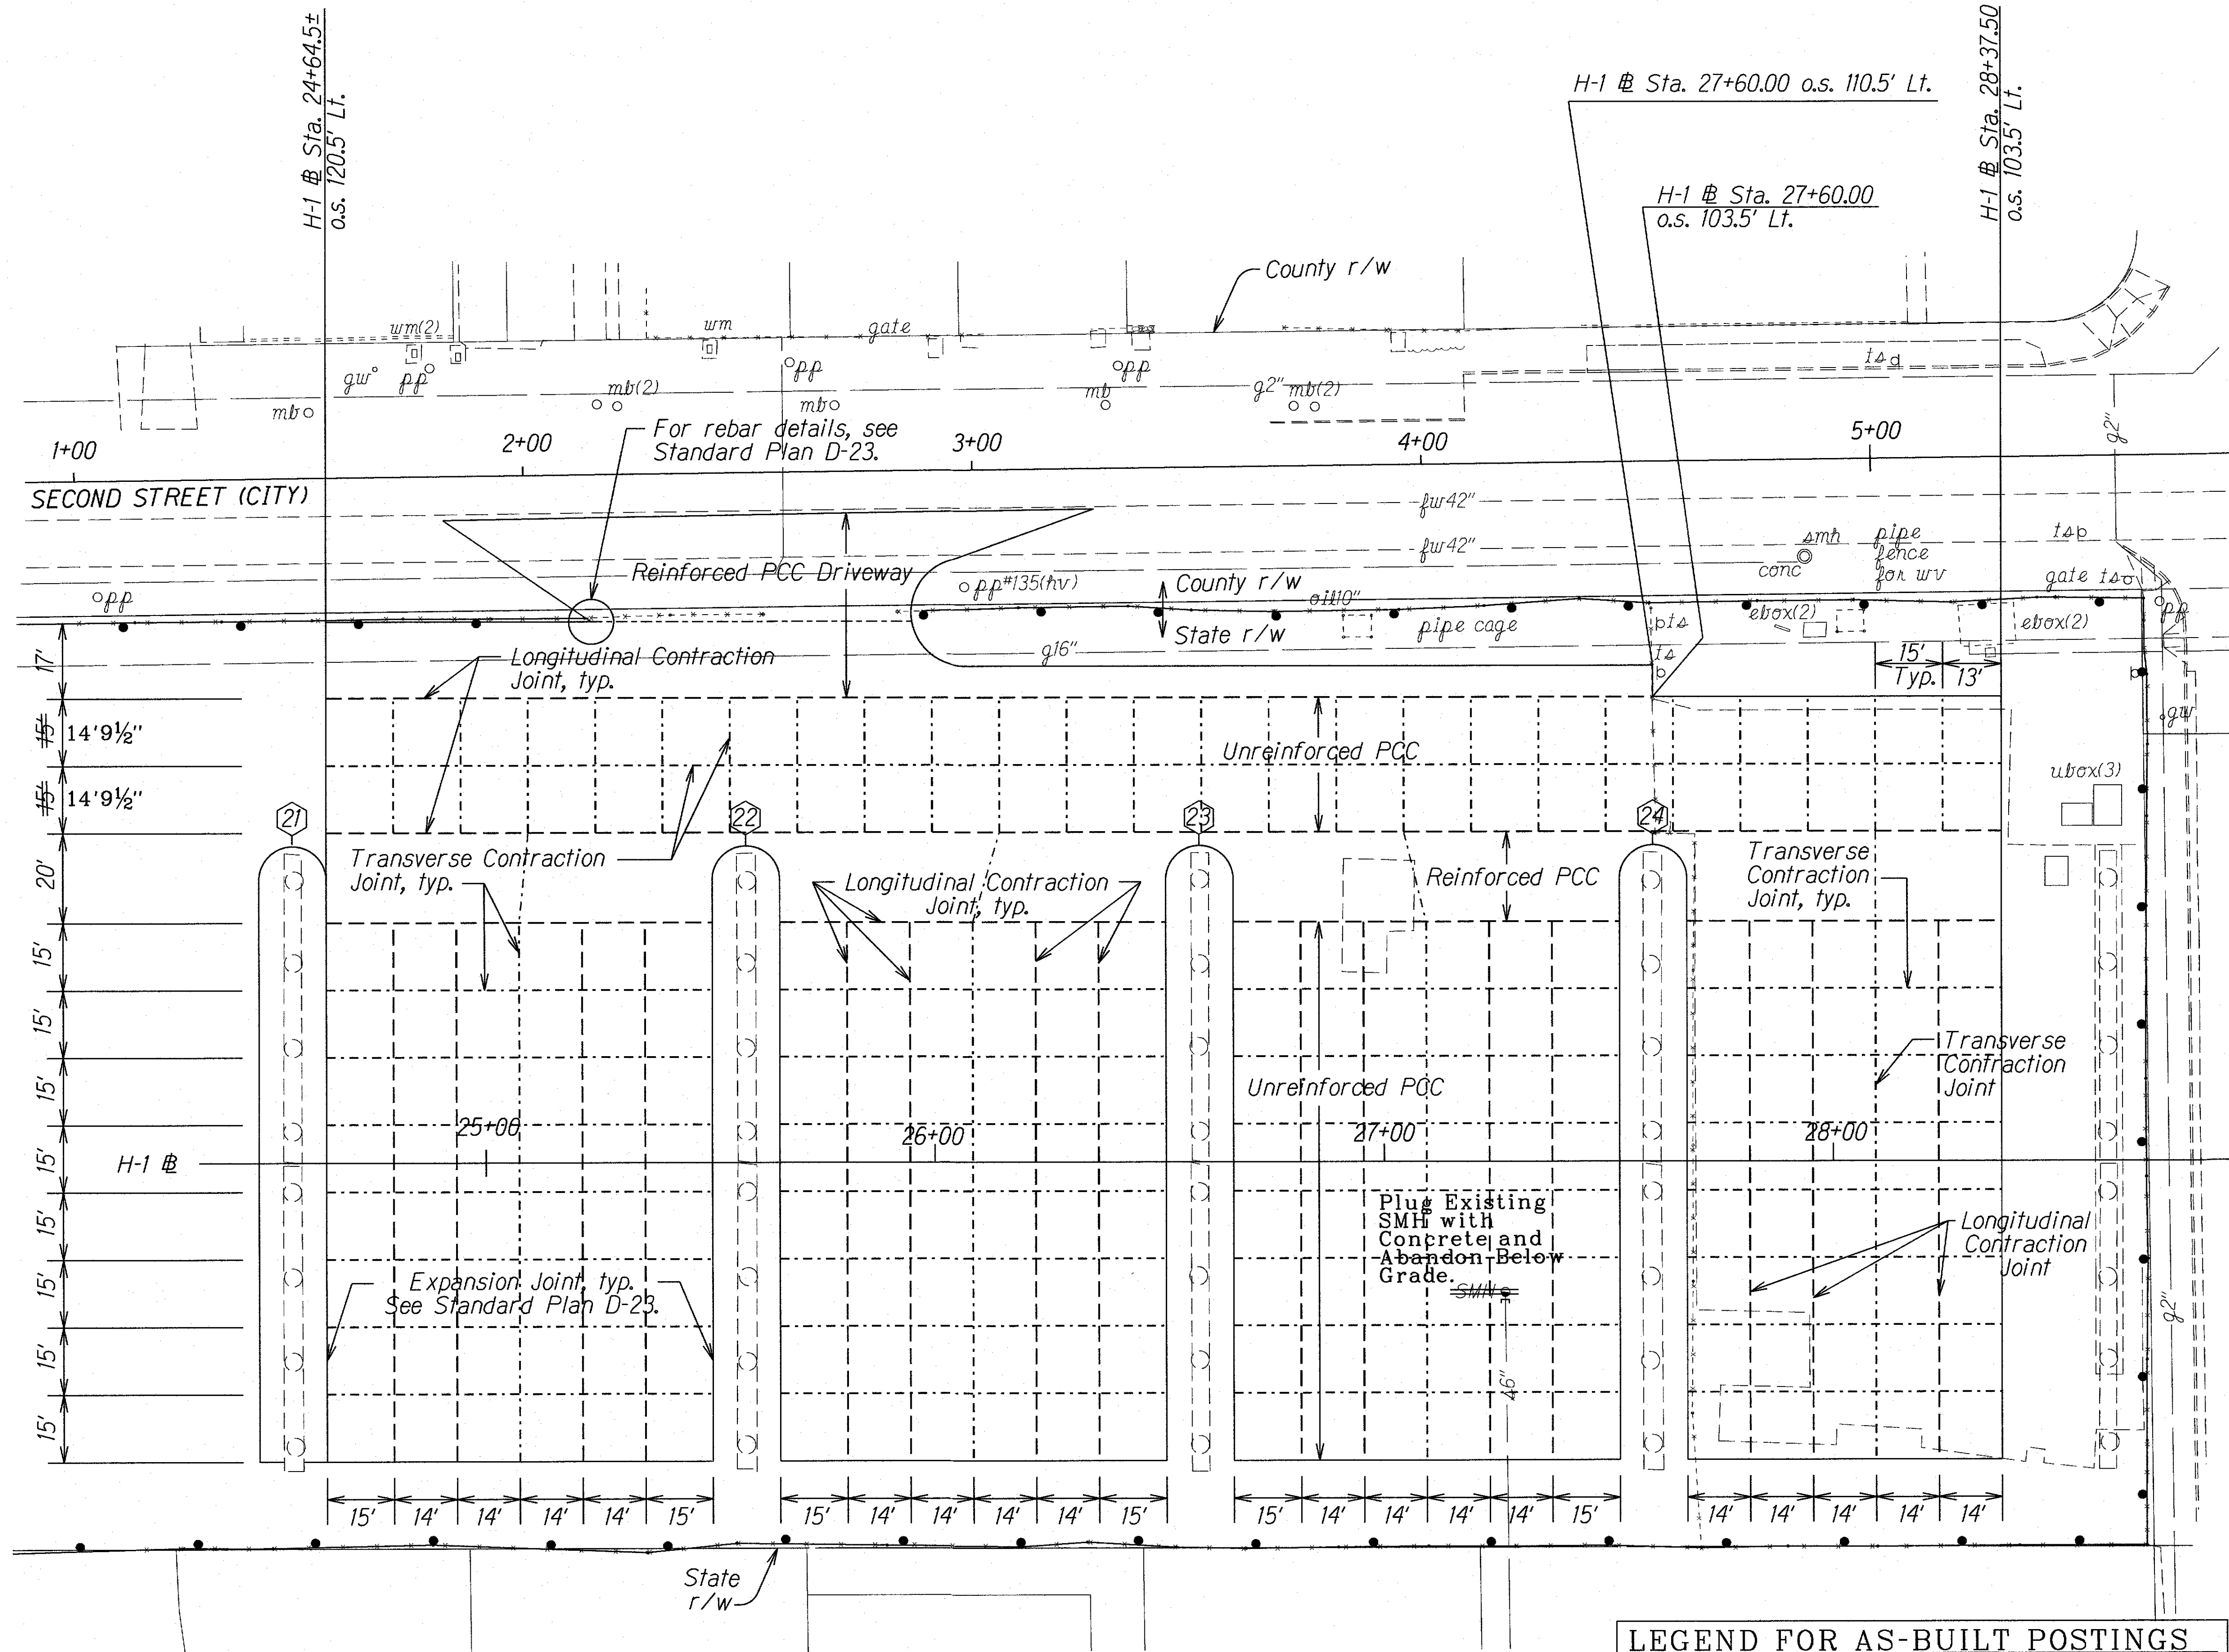

NOTES

1. Use 1" ϕ smooth dowels for transverse joints. See Standard Plan D-19.
2. Use #5 rebars for longitudinal joints. See Standard Plan D-21.
3. For Reinforced PCC, see Plan Sheet No. 9.
4. Use longitudinal joint detail for connection of Unreinforced P.C.C. to Reinforced P.C.C.
5. Use longitudinal joint detail for connection of Reinforced P.C.C. to New Concrete Barrier.
6. Do not attach Unreinforced P.C.C. to New Concrete Barrier.

LEGEND

- Transverse Contraction Joint
- Longitudinal Contraction Joint

5/19/16 Deleted City DPP CEB approval block.


DATE REVISION

STATE OF HAWAII
DEPARTMENT OF TRANSPORTATION
HIGHWAYS DIVISION
EXAMINATION SITE JOINTING PLAN
COMMERCIAL DRIVER'S LICENSE AND
MOTORCYCLE LICENSE TESTING FACILITY
EXAMINATION SITE AND OFFICE RENOVATION
Beneath Interstate Route H-1 Pearl City Viaduct
Project No. HWY-0-08-14
Scale: 1"=20' Date: May 2016

SHEET No. 1 OF 1 SHEETS

LEGEND FOR AS-BUILT POSTINGS

- Squiggly line for as-built deletion
- Double line for as-built deletion
- Roadway Text for as-built posting

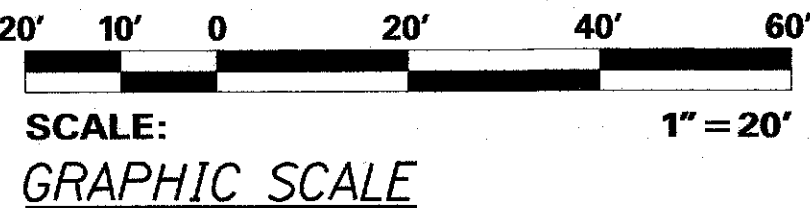

"AS-BUILT"

ADD. 10