


FED. ROAD DIST. NO.	STATE	PROJ. NO.	FISCAL YEAR	SHEET NO.	TOTAL SHEETS
HAWAII	HAW.	HWY-0-08-14	2016	13	88

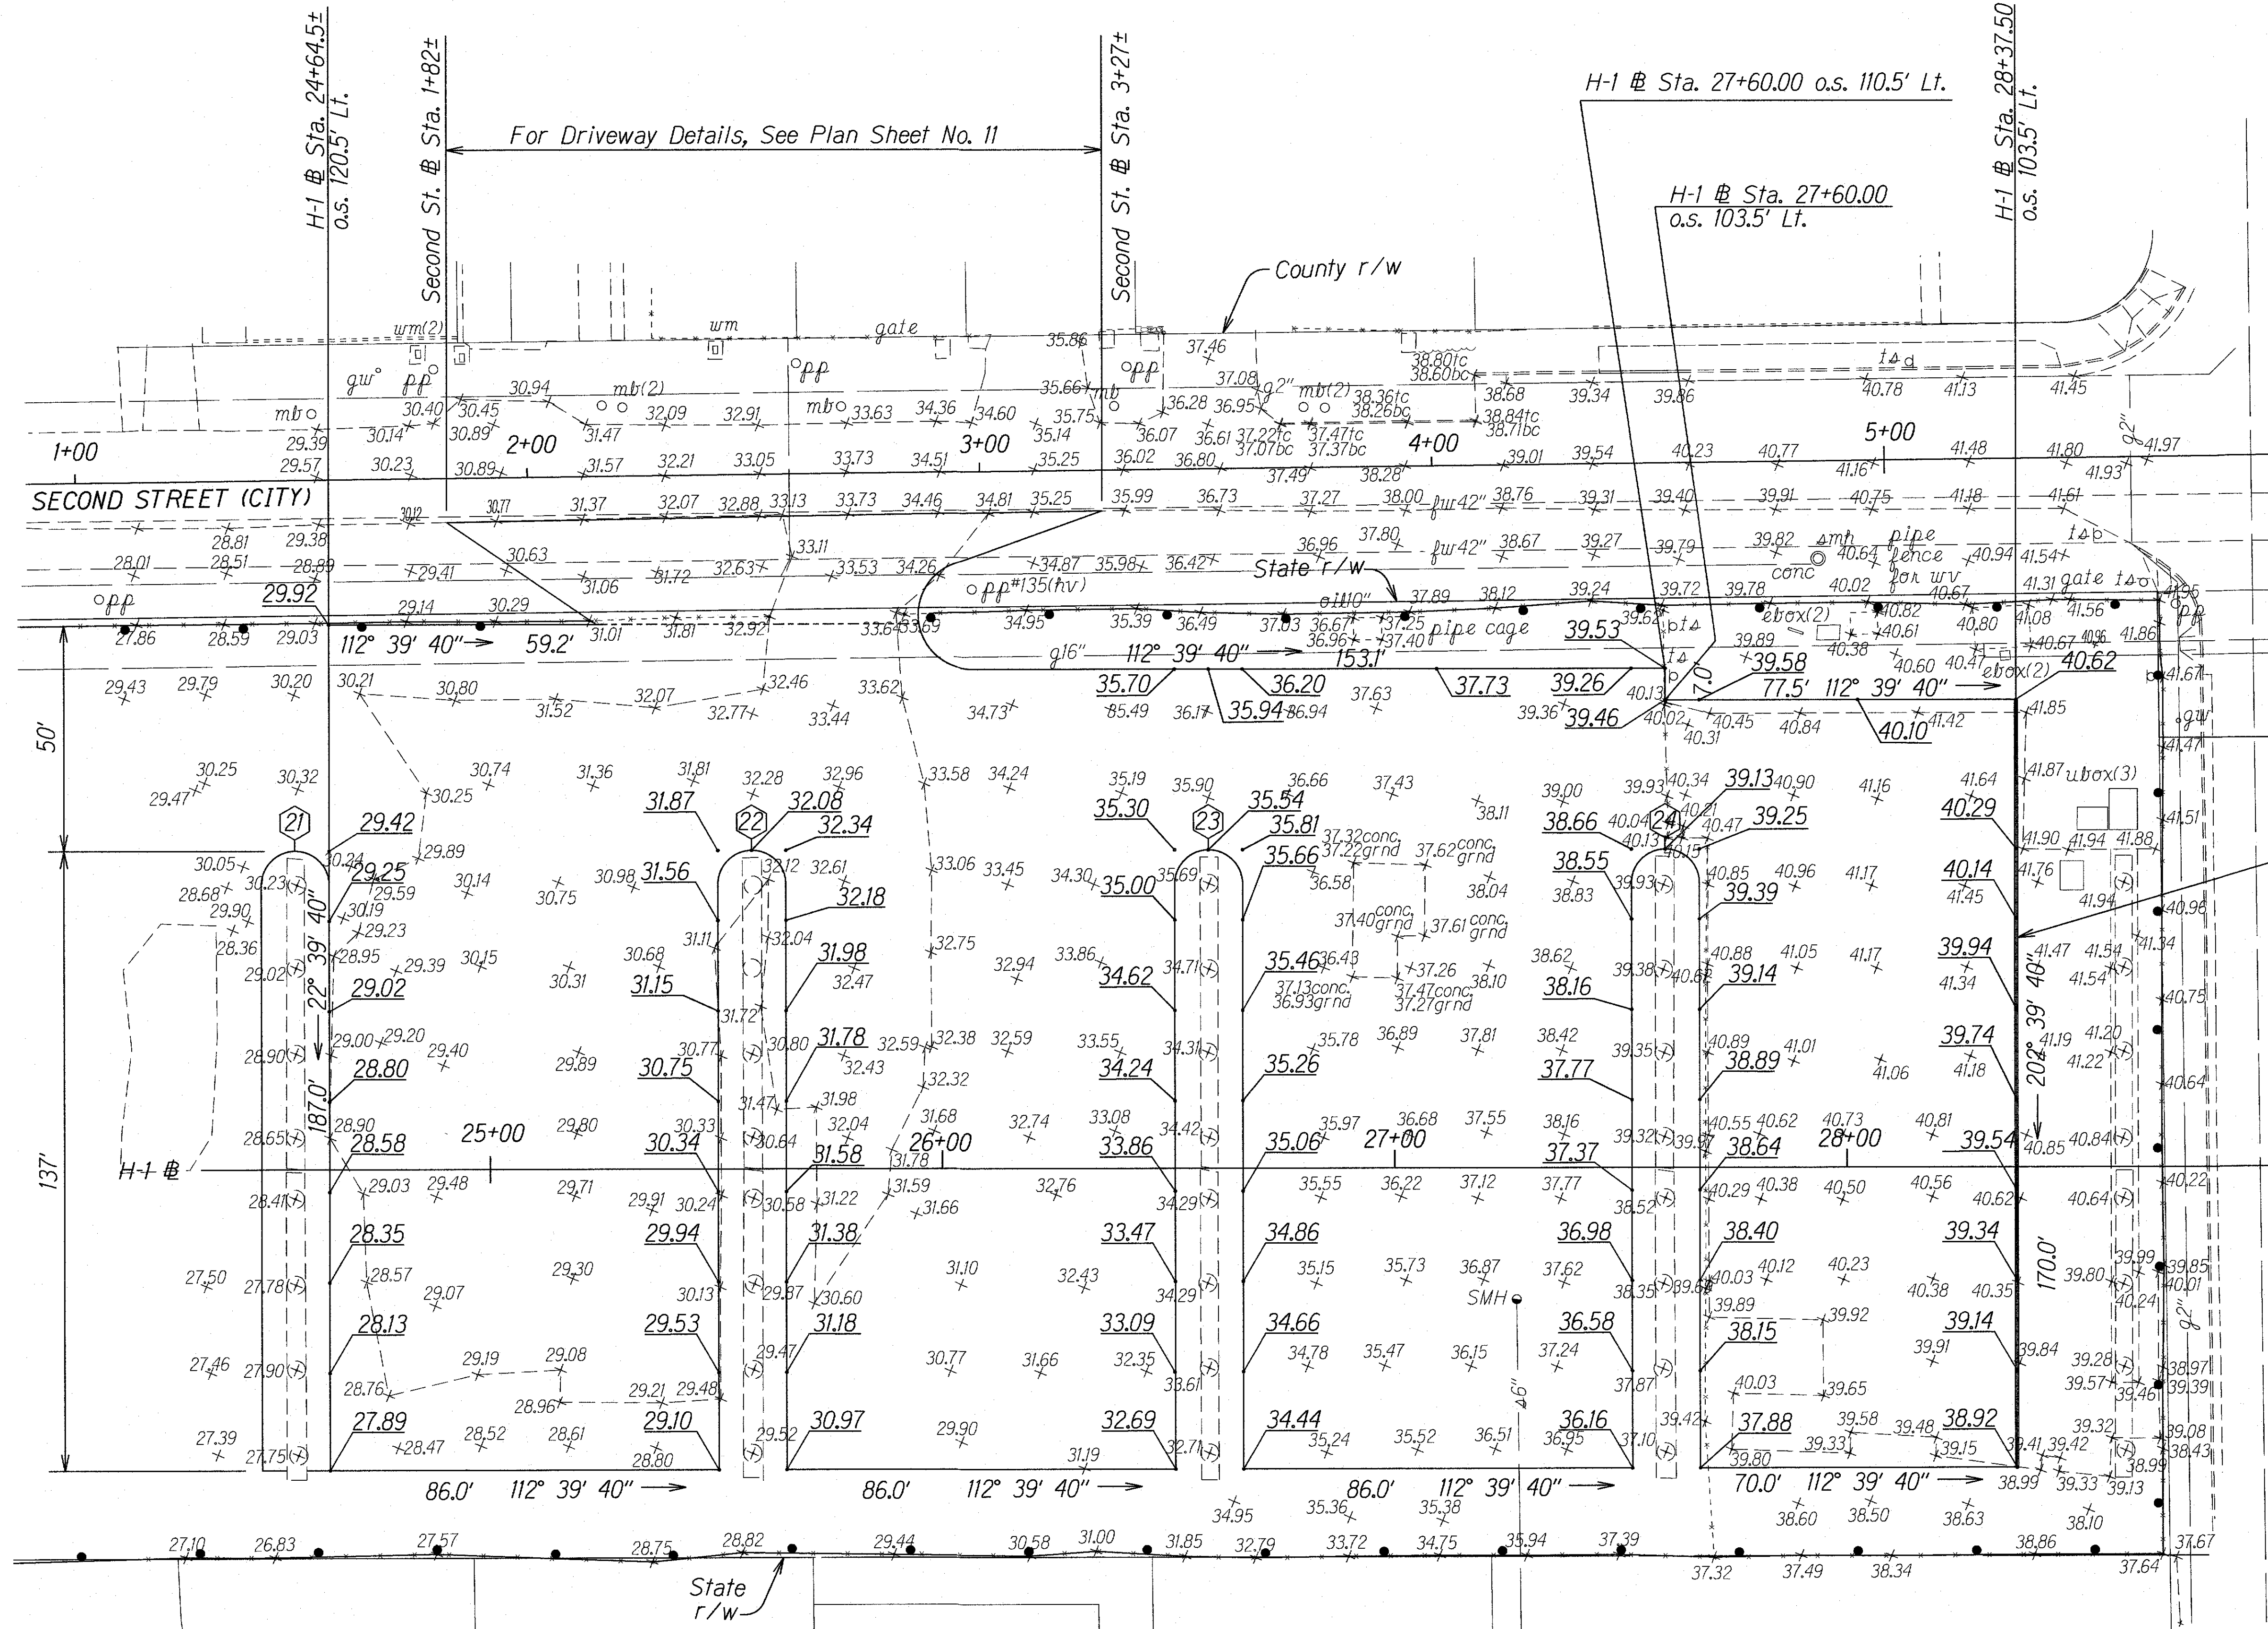

LEHUA AVENUE (CITY)

8 inch Wide Concrete Curb With Epoxy Dowels every 3 feet.

LEGEND FOR AS-BUILT POSTINGS	
	Squiggly line for as-built deletion
	Double line for as-built deletion
	Text for as-built posting


STATE OF HAWAII
DEPARTMENT OF TRANSPORTATION
HIGHWAYS DIVISION

EXAMINATION SITE PCC PAVEMENT GRADING PLAN
COMMERCIAL DRIVER'S LICENSE AND
MOTORCYCLE LICENSE TESTING FACILITY
EXAMINATION SITE AND OFFICE RENOVATION
Beneath Interstate Route H-1 Pearl City Viaduct
Project No. HWY-0-08-14
Scale: 1"=20' Date: May 2016

SHEET No. 1 OF 1 SHEETS

SURVEY PLOTTED BY	DATE
DESIGNED BY	
QUANTITIES BY	
CHECKED BY	
NOTE BOOK	
N.	

Origin of Azimuths: "Ewa Church" Δ
Bench Mark Datum: National Geodetic Survey Bench Mark "N-13" (Brass Disk)
Elevation = 41.74 Feet Mean Sea Level

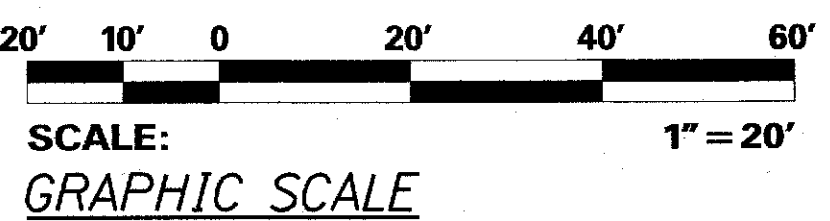

"AS-BUILT"