




FED. ROAD DIST. NO.	STATE	PROJ. NO.	FISCAL YEAR	SHEET NO.	TOTAL SHEETS
HAWAII	HAW.	HWY-0-08-14	2016	ADD. 53	88

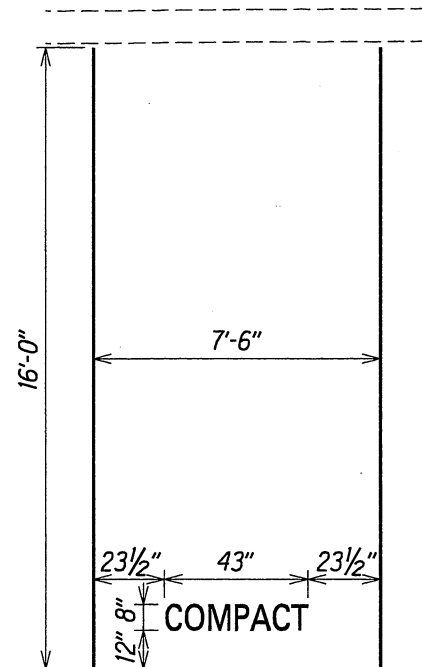

**TYPICAL COMPACT STALL DETAIL**  
N.T.S.

	6/09/16	RELOCATED SIGNS AND REVISED CALLOUT
	5/26/16	REVISED CALLOUT ADDED SIGN AND CALLOUT
DATE		REVISION
<p>STATE OF HAWAII DEPARTMENT OF TRANSPORTATION HIGHWAYS DIVISION</p> <p><b><u>OFFICE RENOVATION SITE PAVEMENT MARKING AND SIGNING PLAN</u></b></p> <p><b><u>COMMERCIAL DRIVERS LICENSE AND MOTORCYCLE LICENSE TESTING FACILITY</u></b></p> <p><b><u>EXAMINATION SITE &amp; OFFICE RENOVATION</u></b></p> <p><b><u>Beneath Interstate Route H-1 Pearl City Viaduct</u></b></p> <p><b><u>Project No. HWY-0-08-14</u></b></p> <p>Scale: 1"=10'-0"      Date: May 2016</p> <p>SHEET No. T01 OF 2 SHEETS</p>		

SURVEY PLOTTED BY	DATE
DRAWN BY	
DESIGNED BY	
QUANTITIES BY	
CHECKED BY	
ORIGINAL PLAN	
NOTE BOOK	
Idler/nesl	
na, unistral	


**KEY:**  
 ① Install New Sign, D9-25 on Fence 6" Below Top of Fence, See Sht. #TE8. ①

Accessible Parking Sign and Post, Centered with Stall. See Details on Sht. #T02

No Parking Access Aisle Sign and Post, Centered with Bollard. See Details on Sht. #T02 ① ②  
 6" Dia. Bollard @ 6'-0" O.C. See Details on Sht. #T02

**OFFICE RENOVATION SITE PAVEMENT MARKING AND SIGNING PLAN**  
1"=10'-0"

FED. ROAD DIST. NO.	STATE	PROJ. NO.	FISCAL YEAR	SHEET NO.	TOTAL SHEETS
HAWAII	HAW.	HWY-0-08-14	2016	ADD. 57	88

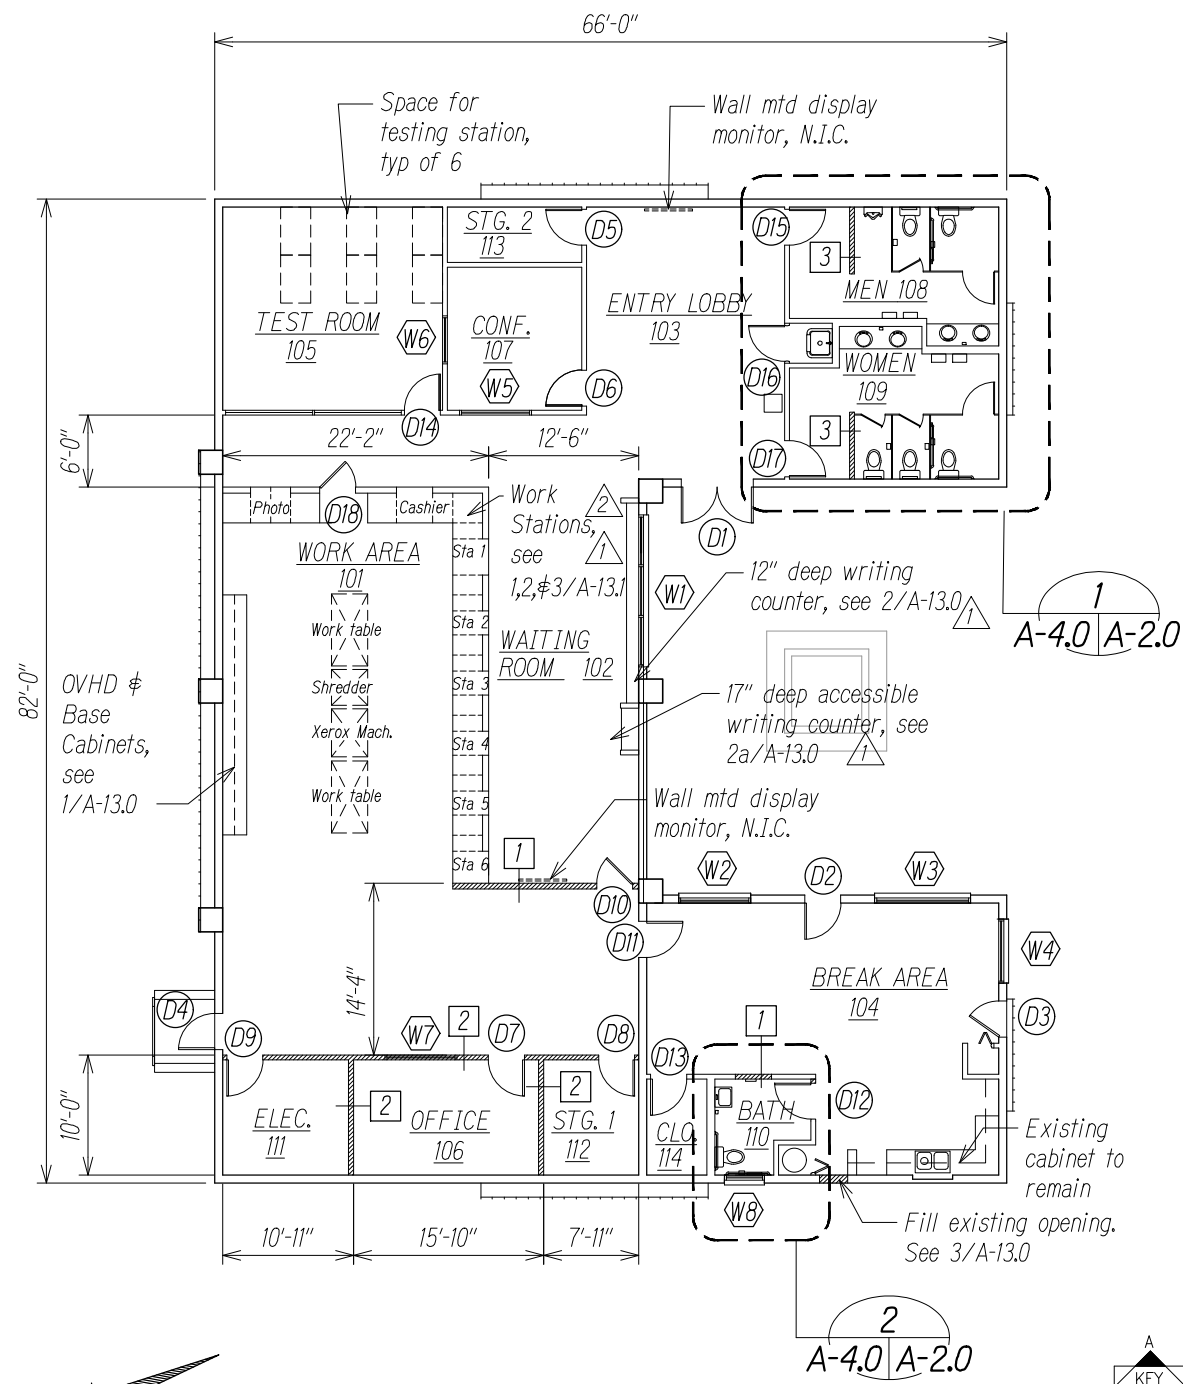



True North  
Scale

**New Floor Plan**  
Scale: 1/8" = 1'-0"

Wall legend:

Existing walls

New walls

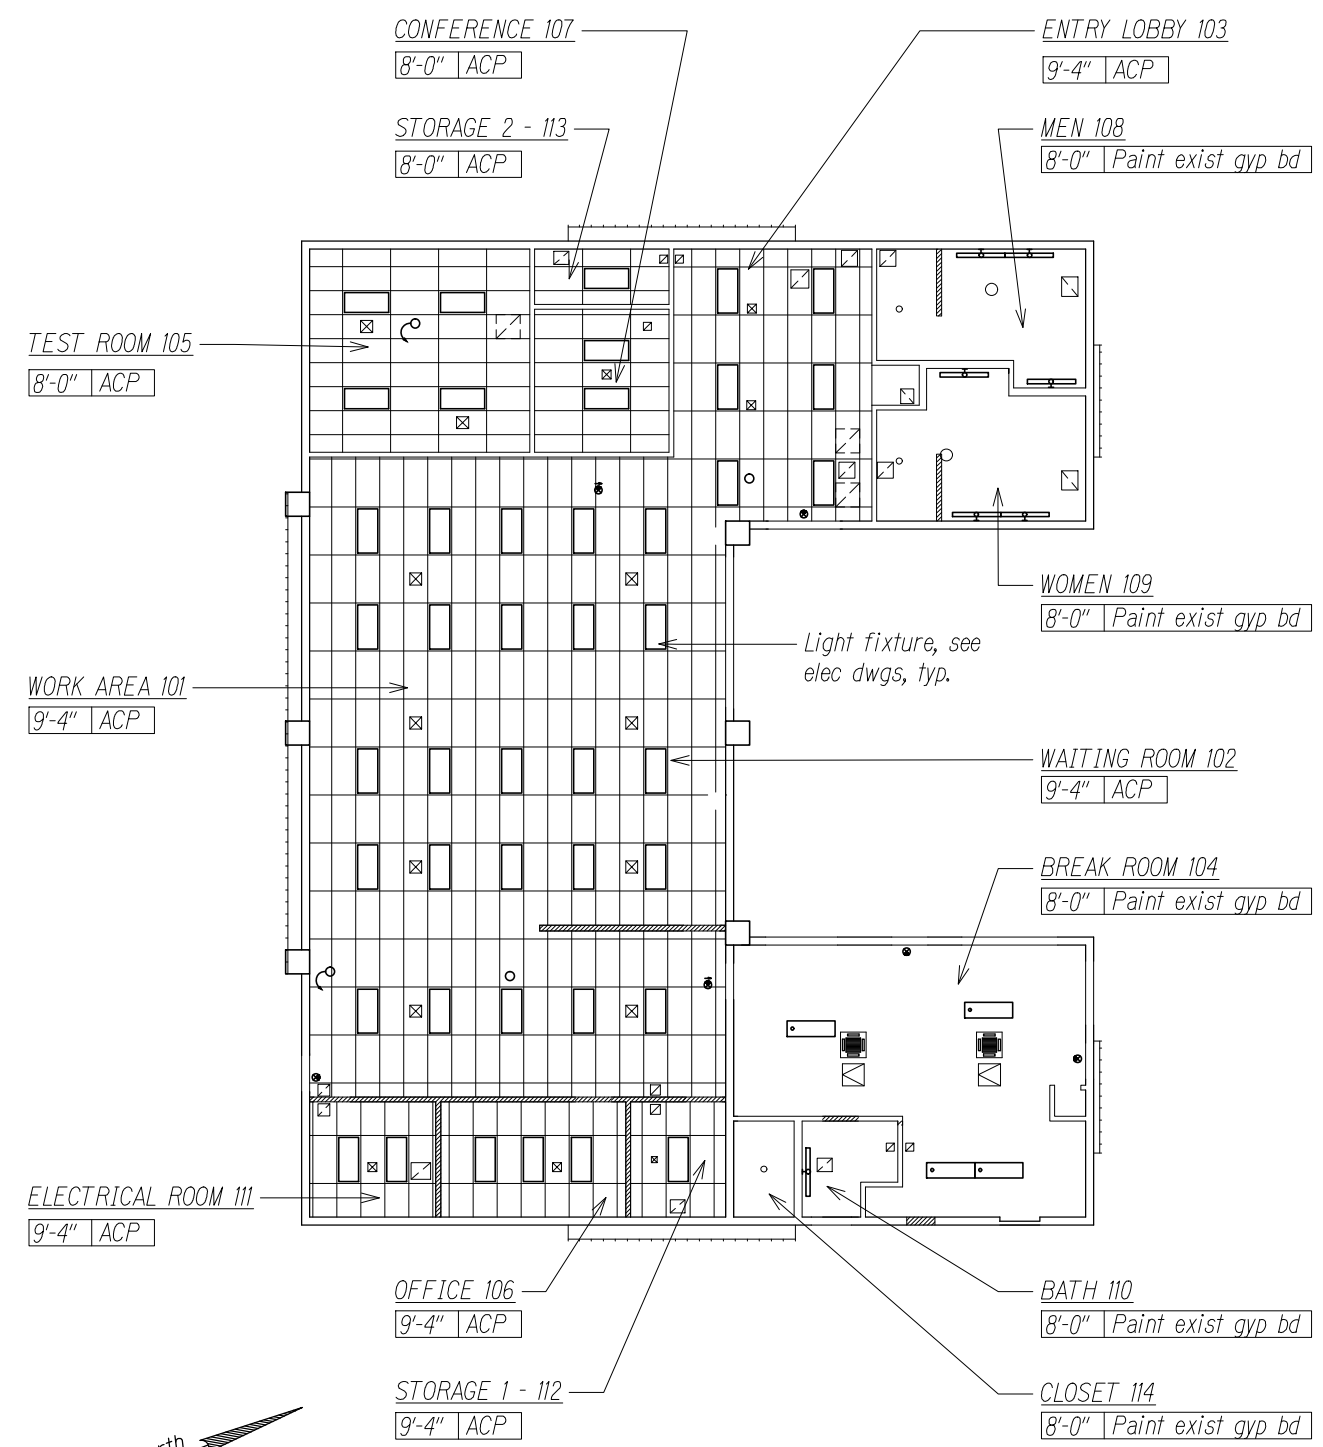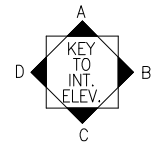

True North  
Scale

**New Reflected Ceiling Plan**  
Scale: 1/8" = 1'-0"

8 6 4 2 0 8 16FT

SCALE: 1/8" = 1'-0"

2	6/13/2016	Widened accessible stations.
1	5/20/2016	Added writing counter & revised details.
DATE	REVISION	

STEVEN D. WONG  
LICENSED PROFESSIONAL ARCHITECT  
No. 4646  
HAWAII U.S.A.

THIS WORK WAS PREPARED BY ME OR UNDER MY SUPERVISION

*Stan D. Wong*  
MITSUNAGA & ASSOCIATES, INC.  
EXP. 4/30/18

STATE OF HAWAII  
DEPARTMENT OF TRANSPORTATION  
HIGHWAYS DIVISION

**NEW FLOOR & REFLECTED CEILING PLAN**


COMMERCIAL DRIVER'S LICENSE AND  
MOTORCYCLE LICENSE TESTING FACILITY  
EXAMINATION SITE AND OFFICE RENOVATION  
Beneath Interstate Route H-1 Pearl City Viaduct  
Project No. HWY-0-08-14

Scale: 1/8" = 1'-0" Date: June 2016


SHEET No. A-3 OF 16 SHEETS

DATE	_____
DESIGNED BY	_____
CHECKED BY	_____
QUANTITIES BY	_____
TRACED BY	_____
DRAWN BY	_____
REVIEWED BY	_____
ORIGINAL PLAN	_____

FED. ROAD DIST. NO.	STATE	PROJ. NO.	FISCAL YEAR	SHEET NO.	TOTAL SHEETS
HAWAII	HAW.	HWY-0-08-14	2016	ADD. 61	88

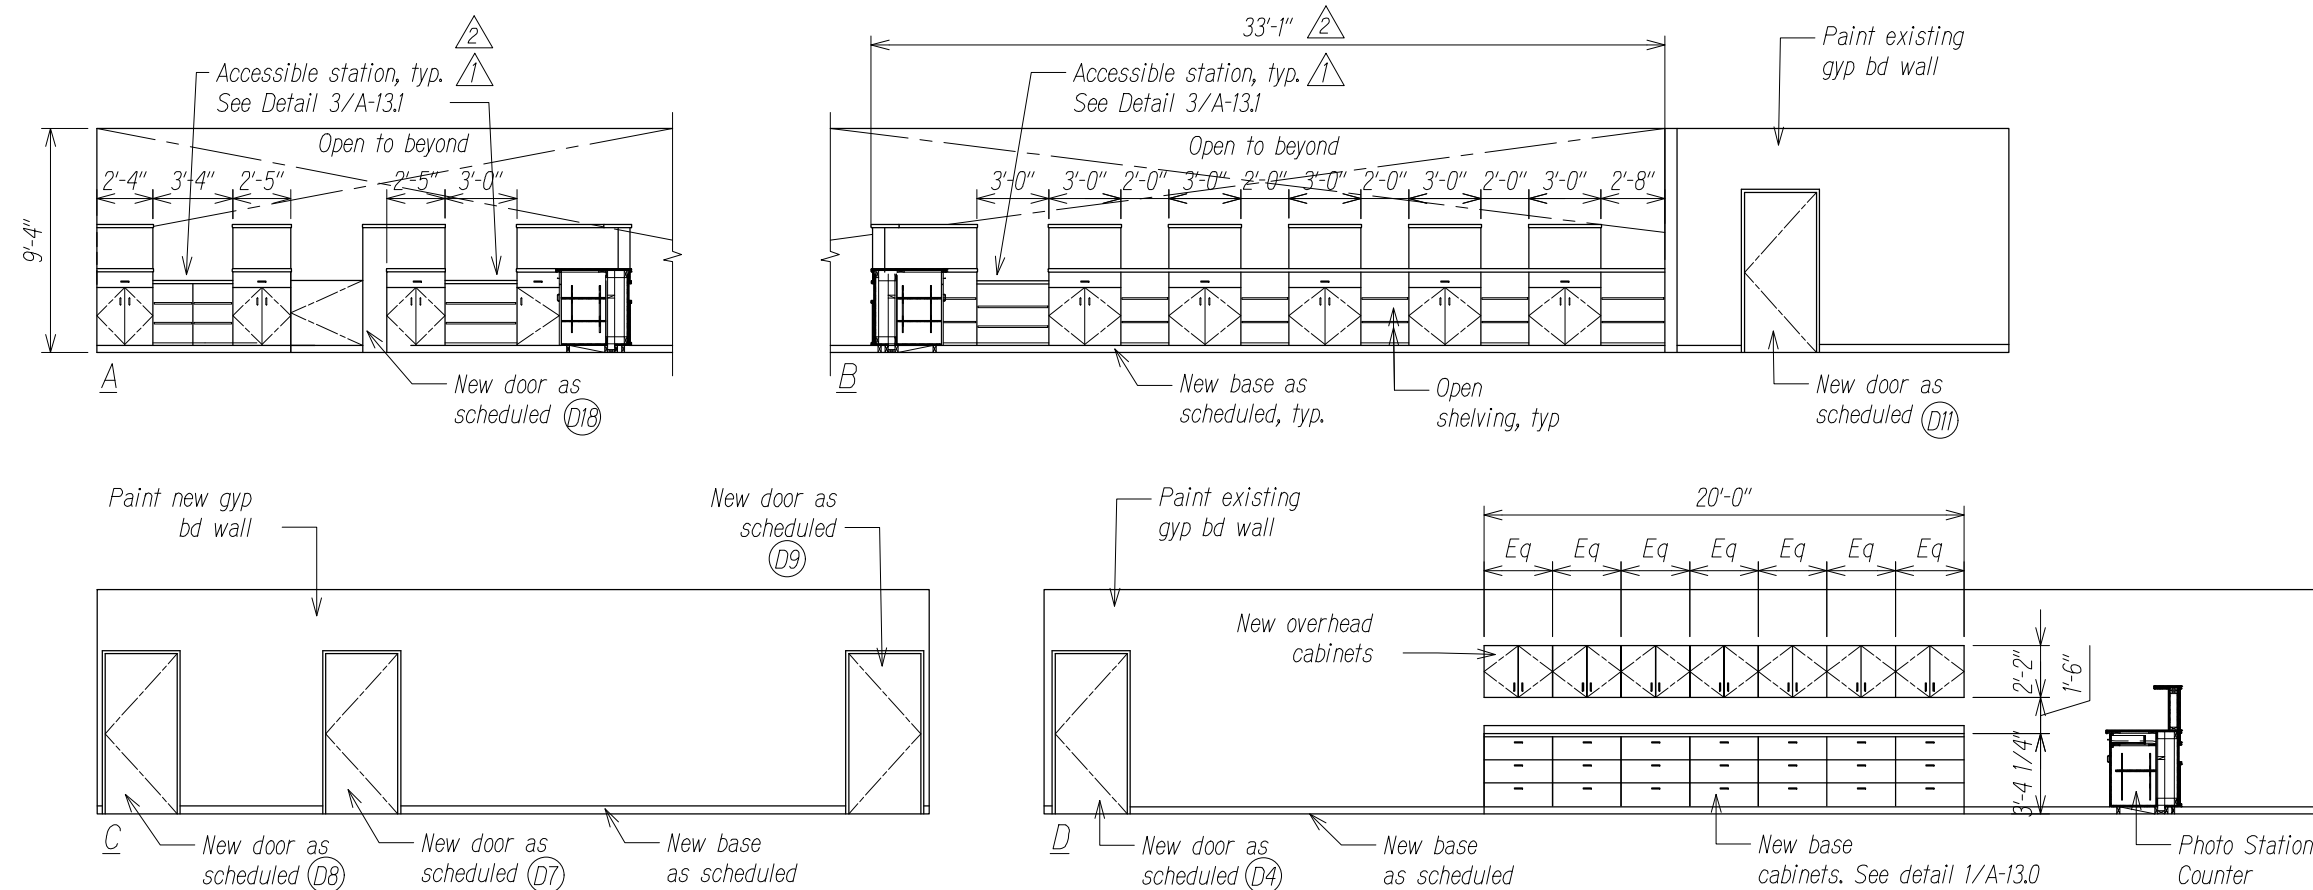

RM 101 - WORK AREA

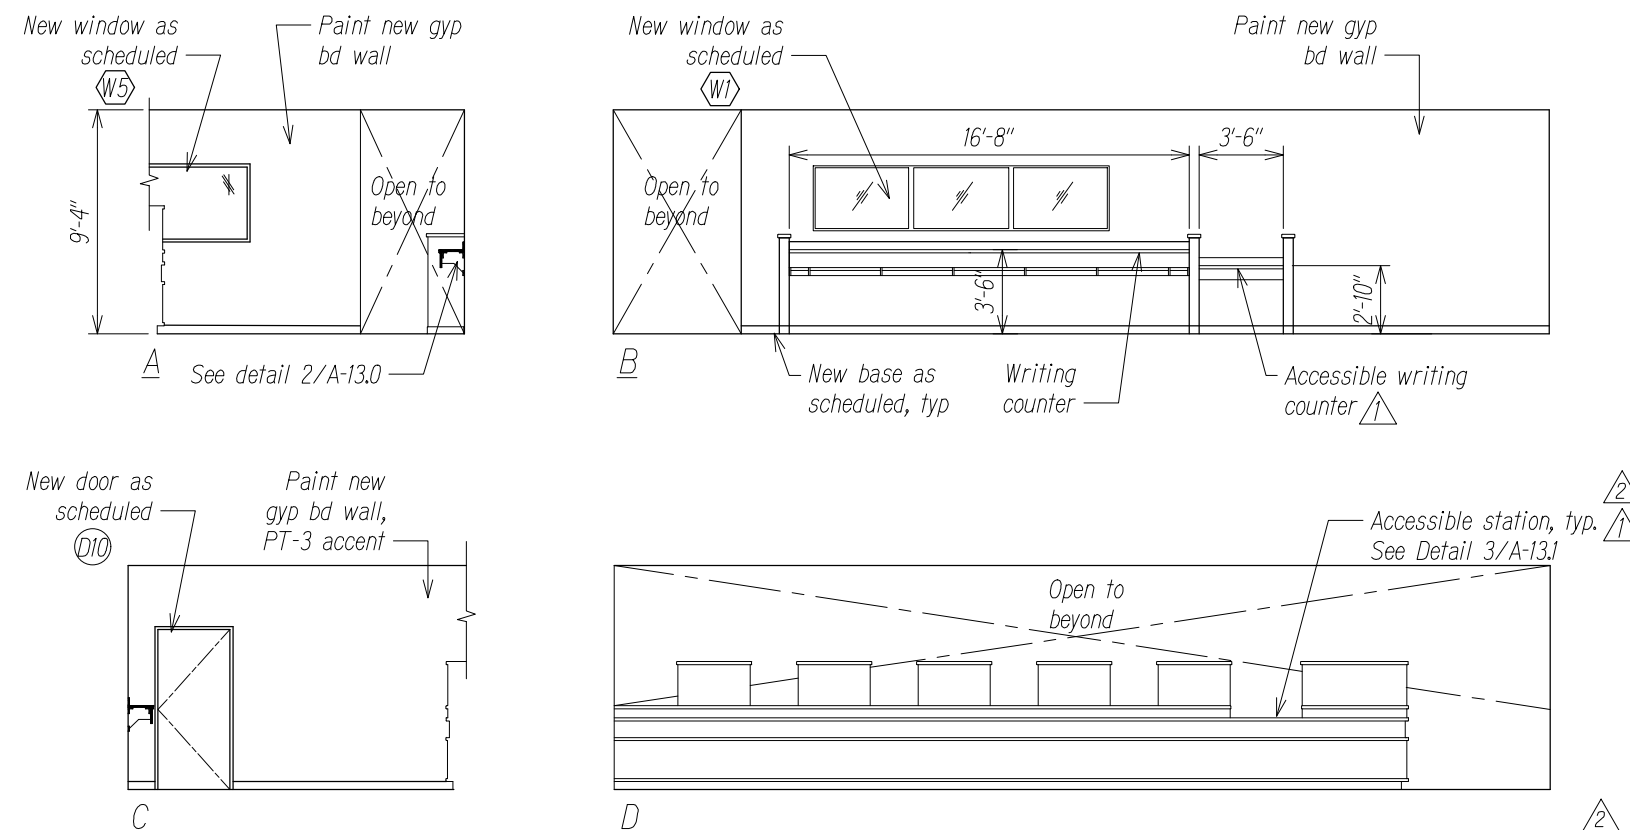

RM 102 - WAITING ROOM

<u>2</u>	6/13/2016	Widened accessible stations.
<u>1</u>	5/20/2016	Added callouts for accessible stations.
	DATE	REVISION



THIS WORK WAS PREPARED BY M  
OR UNDER MY SUPERVISION

*Stan D. King*  
MITSUNAGA & ASSOCIATES, INC.  
EXP. 4/30/18

STATE OF HAWAII  
DEPARTMENT OF TRANSPORTATION  
HIGHWAYS DIVISION

*INTERIOR ELEVATIONS*

*COMMERCIAL DRIVER'S LICENSE AND  
MOTORCYCLE LICENSE TESTING FACILITY  
EXAMINATION SITE AND OFFICE RENOVATION  
Beneath Interstate Route H-1 Pearl City Viaduct  
Project No. HWY-O-08-14*



Scale: 1/4" = 1'-0" Date: June 2016

SHEET No. A-7 OF 16 SHEETS

ORIGINAL PLAN	SURVEY PLOTTED BY _____	DATE _____
	DRAWN BY _____	" _____
NOTE BOOK	TRACED BY _____	" _____
	DESIGNED BY _____	" _____
	QUANTITIES BY _____	" _____
No. _____	CHECKED BY _____	" _____


SIGNAGE SCHEDULE					
SIGN NO.	COPY/DESCRIPTION	SIGN TYPE		MOUNT POSITION	REMARKS
		TYPE	DETAIL		
①	EXIT	SI	1/A-17.0	1	HELvetica MEDIUM TYPE
②	EXIT	SI	1/A-17.0	3	HELvetica MEDIUM TYPE
③	EXIT	SI	1/A-17.0	3	HELvetica MEDIUM TYPE
④	EXIT	SI	1/A-17.0	2	HELvetica MEDIUM TYPE

FED. ROAD DIST. NO.	STATE	PROJ. NO.	FISCAL YEAR	SHEET NO.	TOTAL SHEETS
HAWAII	HAW.	HWY-0-08-14	2016	ADD. 70S-1	88




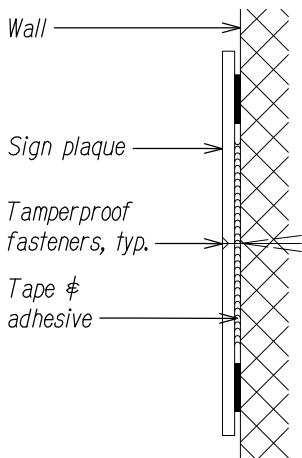
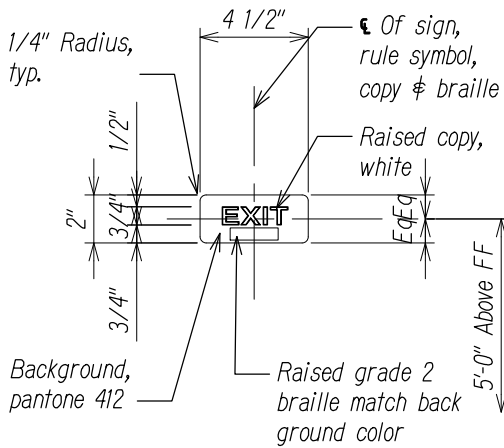


1 SIGNAGE TYPE S1  
A-17 | A-17 Scale: 3"= 1'-0"

2 MOUNTING DETAIL  
A-17 | A-17 Scale: 6"= 1'-0"

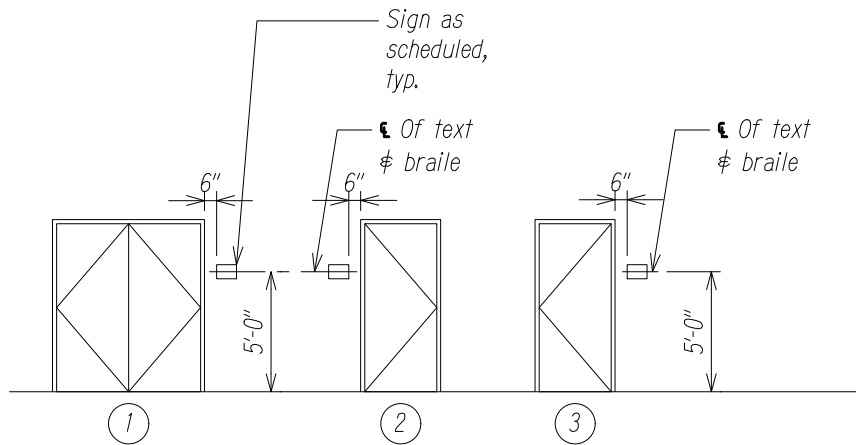

3 SIGNAGE MOUNTING POSITION  
A-17 | A-17 Scale: 1/4"= 1'-0"

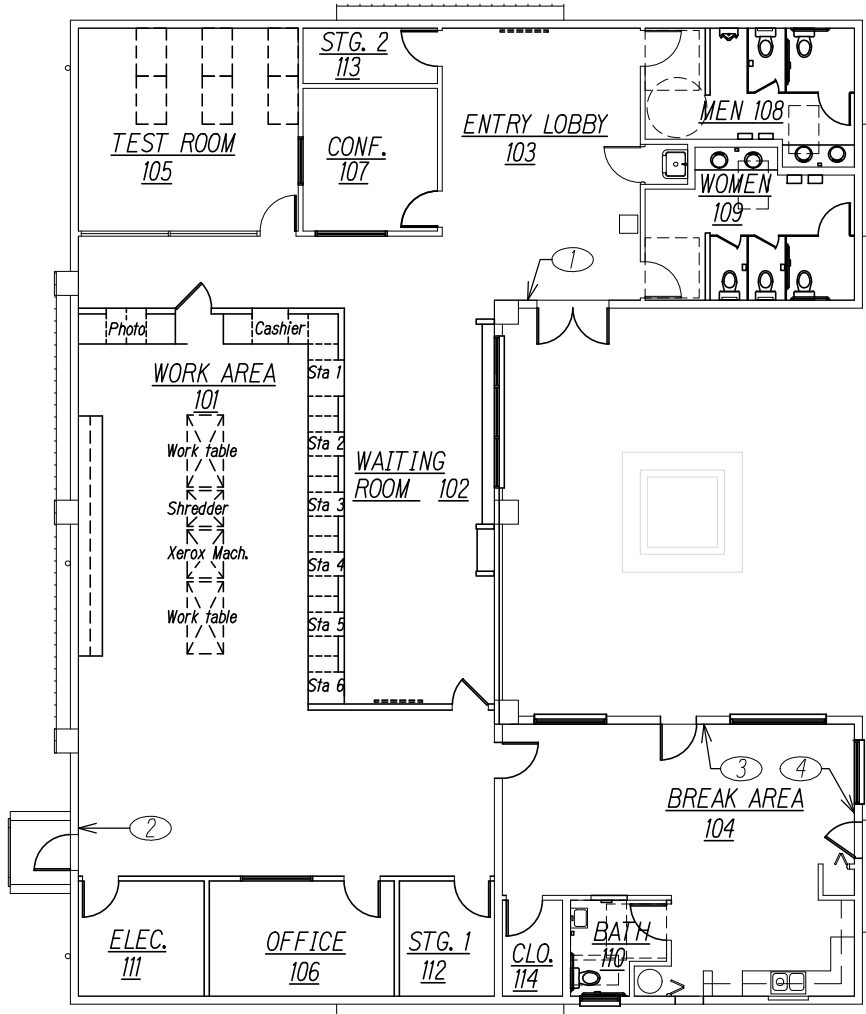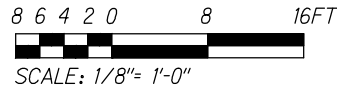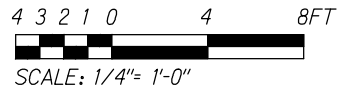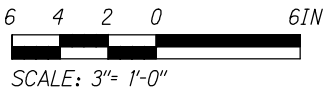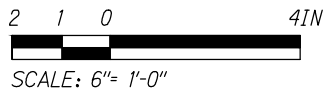

Floor Plan  
Scale: 1/8" = 1'-0"

SURVEY PLANNED BY	DATE
DRAWN BY	
TRACED BY	
DESIGNED BY	
QUANTITIES BY	
CHECKED BY	
ORIGINAL PLAN	
NOTE BOOK	
N	

6/13/2016	Added new sheet for building signage.
DATE	REVISION



STATE OF HAWAII  
DEPARTMENT OF TRANSPORTATION  
HIGHWAYS DIVISION

**SIGN SCHEDULE, TYPES, & DETAILS**  
**COMMERCIAL DRIVER'S LICENSE AND  
MOTORCYCLE LICENSE TESTING FACILITY  
EXAMINATION SITE AND OFFICE RENOVATION**  
*Beneath Interstate Route H-1 Pearl City Viaduct*  
Project No. HWY-0-08-14  
Scale: As Shown Date: June 2016

SHEET No. A-16A OF 16 SHEETS