




| FED. ROAD DIST. NO. | STATE | PROJ. NO.   | FISCAL YEAR | SHEET NO. | TOTAL SHEETS |
|---------------------|-------|-------------|-------------|-----------|--------------|
| HAWAII              | HAW.  | HWY-0-08-14 | 2016        | ADD. 46   | 88           |

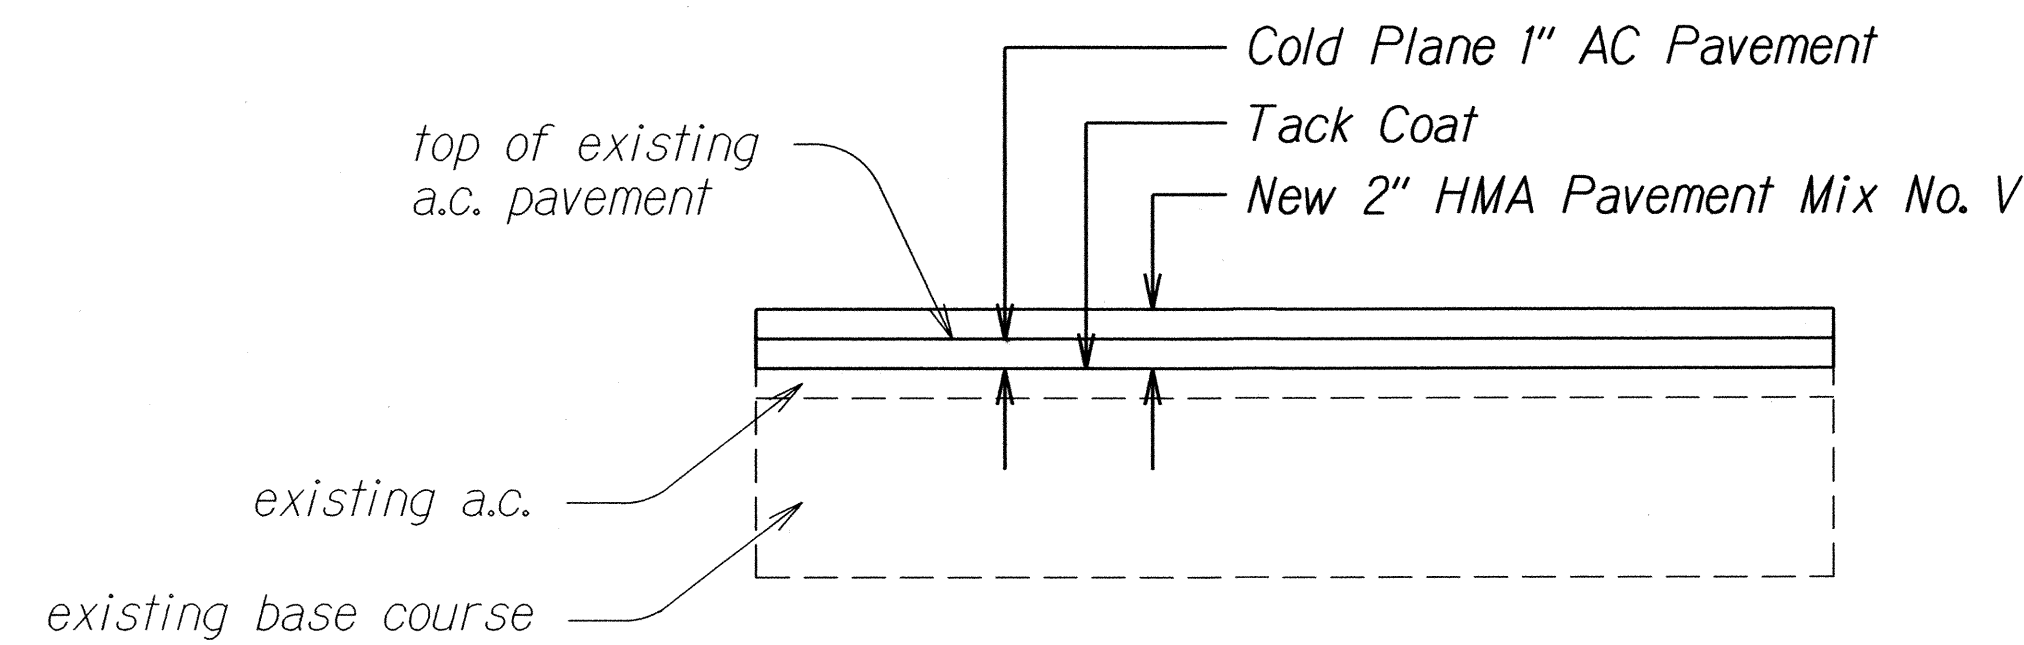


**OFFICE PARKING LOT  
A.C. PAVEMENT SECTION**  
Not to Scale

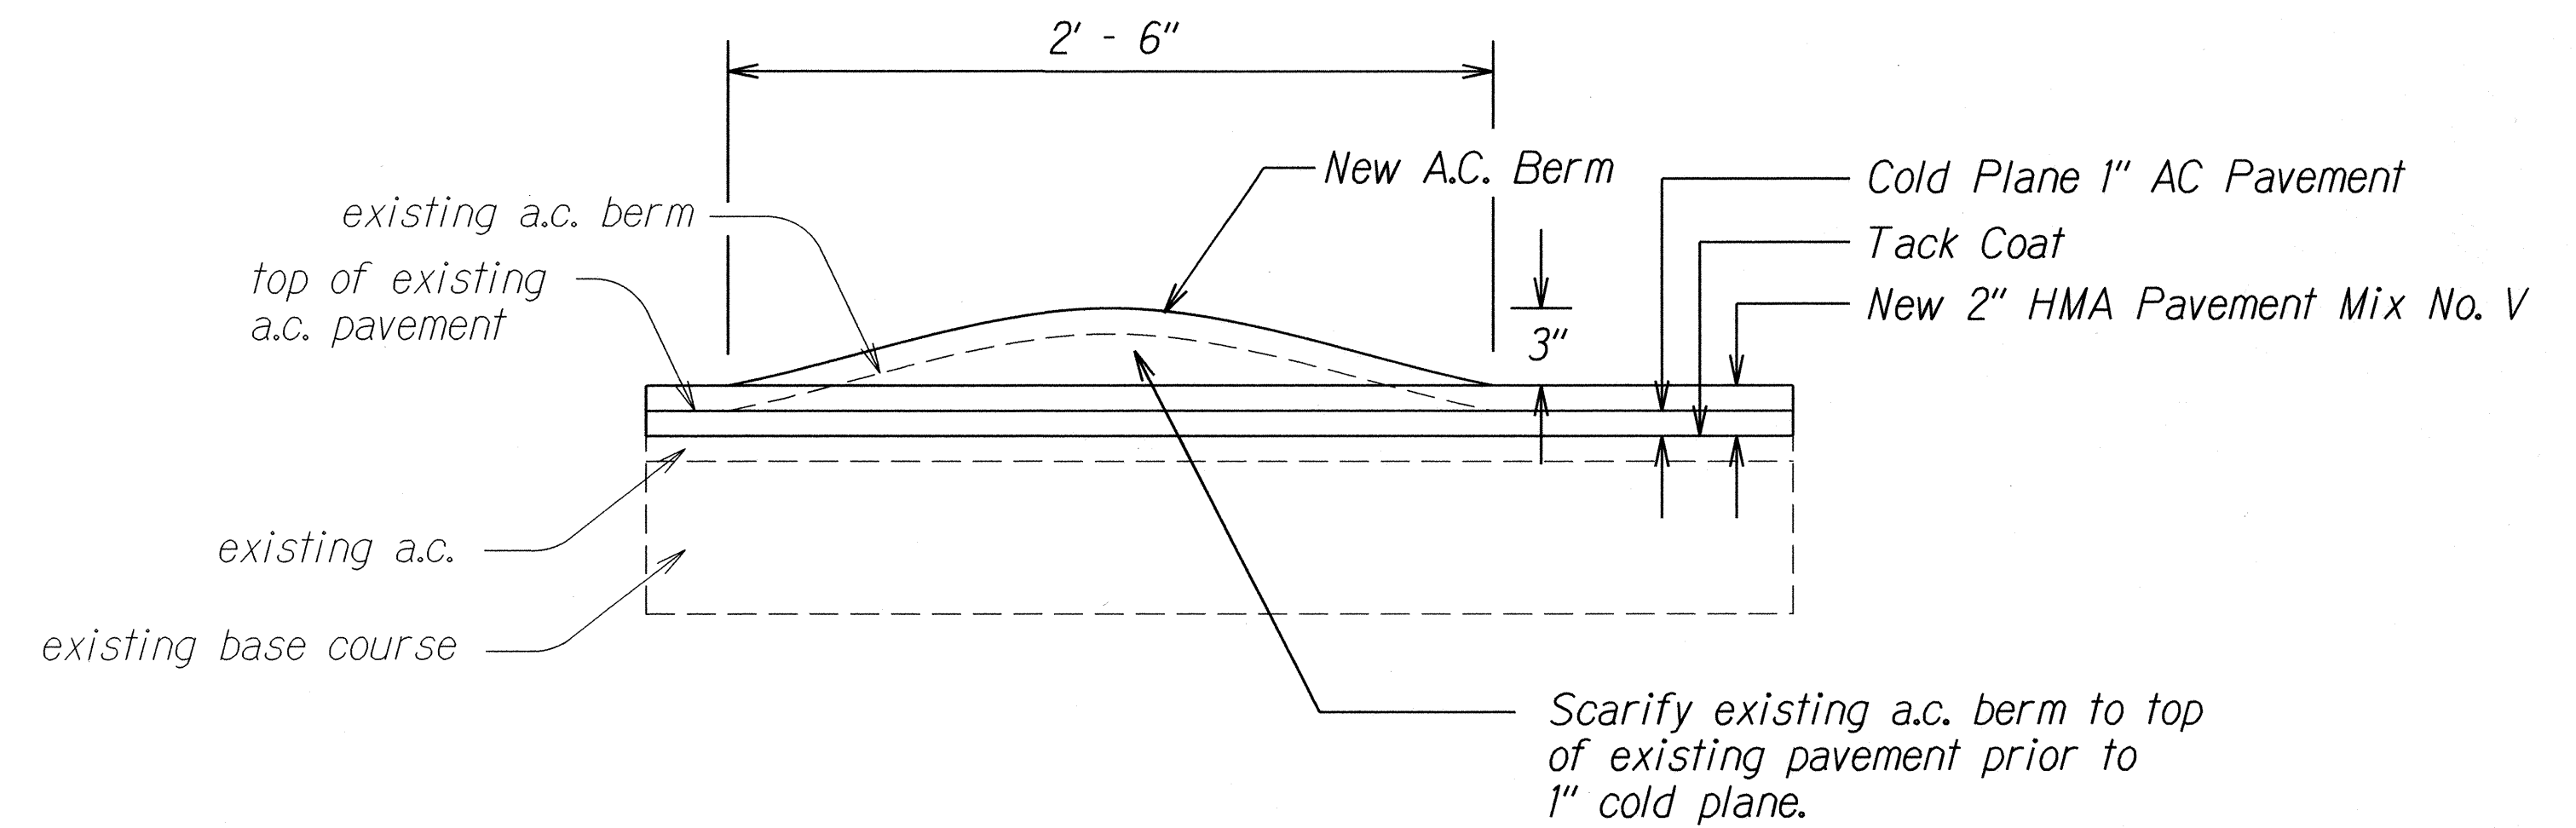

**BERM DETAIL**  
Not to Scale

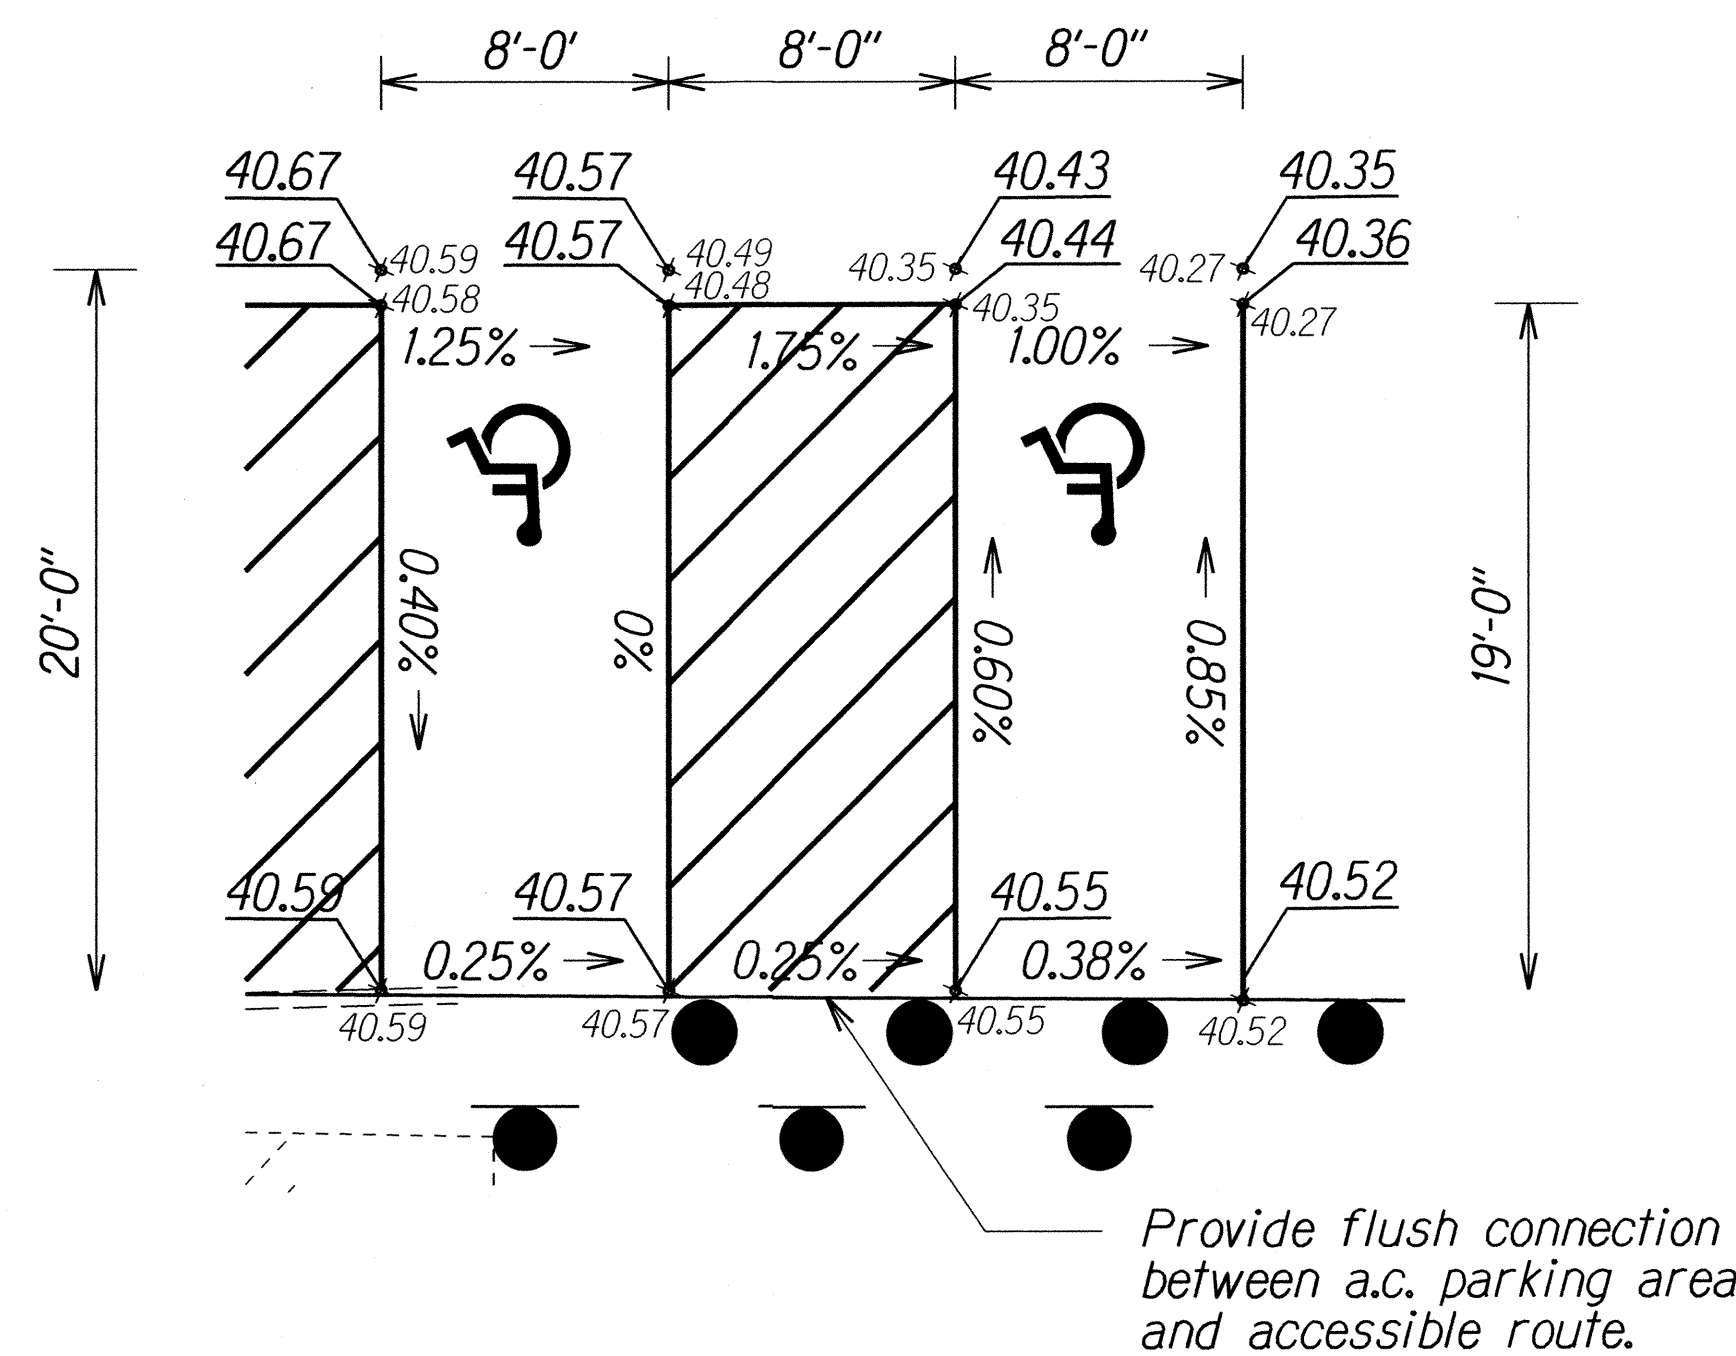

**ACCESSIBLE PARKING STALLS AND  
ACCESS AISLE GRADING DETAILS**  
Not to Scale

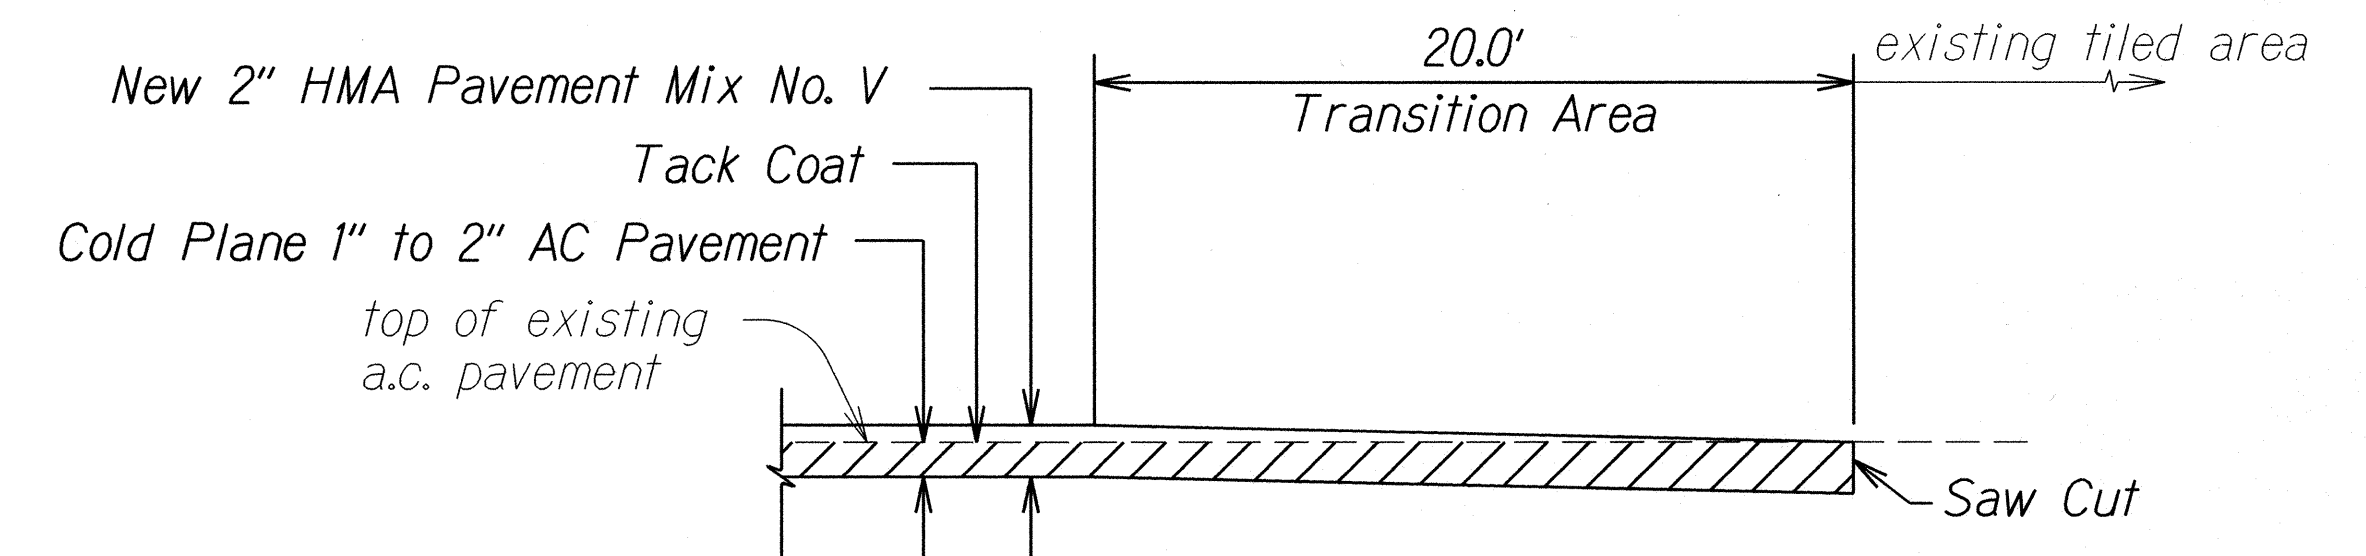

**A.C. PAVEMENT TRANSITION  
DETAIL TO EXISTING TILED AREA**  
Not to Scale

5/31/16 Added Accessible Parking Stalls and Access Aisle Grading Details.

DATE REVISION

STATE OF HAWAII  
DEPARTMENT OF TRANSPORTATION  
HIGHWAYS DIVISION  
**OFFICE RENOVATION SITE TYPICAL DETAILS**  
COMMERCIAL DRIVER'S LICENSE AND  
MOTORCYCLE LICENSE TESTING FACILITY  
EXAMINATION SITE AND OFFICE RENOVATION  
Beneath Interstate Route H-1 Pearl City Viaduct  
Project No. HWY-0-08-14  
Scale: Not to Scale Date: May 2016  
SHEET No. 1 OF 1 SHEETS