

FED. ROAD DIST. NO.	STATE	PROJ. NO.	FISCAL YEAR	SHEET NO.	TOTAL SHEETS
HAWAII	HAW.	HWY-0-08-14	2016	ADD. 12	88

H-1 Sta. 23+56.00± o/s 119.7' Lt.

Remove 206 L.F. of existing chain link fence. Install 167 L.F. of New 6' Chain Link Fence. See Standard Plan D-02 for details.

H-1 Sta. 24+65.00± to Sta. 26+10.00±


Demolish existing a.c. pavement. This work shall be paid under Item No. 203.1000.

Replace 213 L.F. of existing chain link fence with New 6' Chain Link Fence. See Standard Plan D-02 for details.

BEGIN PROJECT
Project No. HWY-0-08-14
H-1 Sta. 22+00

**LEGEND FOR
AS-BUILT POSTINGS**

- Squiggly line for as-built deletion
- Double line for as-built deletion
- Roadway Text for as-built posting

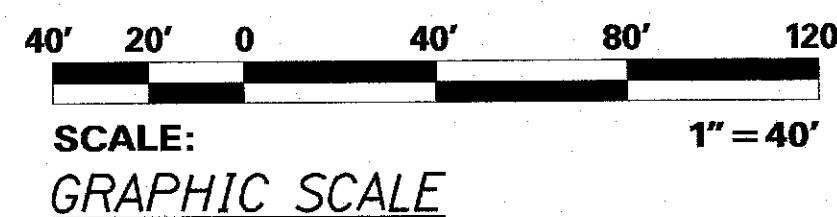

H-1 Sta. 22+75.00± o/s 77.10' Rt.

Remove 73 L.F. of existing chain link fence. Install 52 L.F. of New 6' Chain Link Fence. See Standard Plan D-02 for details.

H-1 Sta. 23+67.50± o/s 84.70' Rt.

Replace 502 L.F. of existing chain link fence with New 6' Chain Link Fence. See Standard Plan D-02 for details.

H-1 Sta. 24+65.00± to Sta. 27+07.00±

H-1 Sta. 27+60.00± to Sta. 28+39.00±

Demolish existing p.c.c. pavement. This work shall be paid under Item No. 203.1000.

Pier Lines 21 to 24

Install New Concrete Barriers around existing structural columns. See New Concrete Barrier Plans on Plan Sheet No. 18 - 25.

APPROVED:

CHIEF, TRAFFIC REVIEW BRANCH, DPP
(For work within City R/W only)

APPROVED:

CHIEF, CIVIL ENGINEERING BRANCH, DPP
(For work within City R/W only)

5/19/16
5/19/16

DATE REVISION

Added Guardrail

Added Civil Engineering Branch and Traffic Review Branch signature.
Added callout for centerline striping and stop bar work.
Revised sliding gate note.
Added label for Hugh St. in State r/w.

END PROJECT
Project No. HWY-0-08-14
Sta. 31+00

STATE OF HAWAII DEPARTMENT OF TRANSPORTATION HIGHWAYS DIVISION	
ROADWAY PLAN	
COMMERCIAL DRIVER'S LICENSE AND MOTORCYCLE LICENSE TESTING FACILITY EXAMINATION SITE AND OFFICE RENOVATION	
Beneath Interstate Route H-1 Pearl City Viaduct Project No. HWY-0-08-14	
Scale: 1"=40'	Date: May 2016
SHEET No. 1 OF 1 SHEETS	

"AS-BUILT"

C.O. ADD. 12