

INDEX TO DRAWINGS	
SHEET NO.	DESCRIPTION
1	TITLE SHEET
2	STANDARD PLANS SUMMARY
3 - 5	GENERAL NOTES AND LEGEND
6 - 8	WATER POLLUTION AND EROSION CONTROL NOTES
9	TYPICAL SECTIONS AND DETAILS
10	EXAMINATION SITE JOINTING DETAIL
11	DRIVEWAY GRADING DETAILS
12	ROADWAY PLAN
13	EXAMINATION SITE PCC PAVEMENT GRADING PLAN
14 - 17	PCC PAVEMENT CROSS SECTIONS
18 - 25	NEW CONCRETE BARRIER PLANS
26 - 27	LANDSCAPING PLANS
28 - 36	DRAINAGE PLANS
37 - 44	EXAMINATION SITE STRIPING PLAN
45	OFFICE RENOVATION SITE PLAN
46	OFFICE PARKING LOT TYPICAL DETAILS
47 - 49	OFFICE DRAINAGE PLANS
50 - 52	OFFICE SITE LANDSCAPING PLANS
53 - 54	OFFICE SITE STRIPING PLANS
55 - 88	OFFICE RENOVATION PLANS

STATE OF HAWAII

DEPARTMENT OF TRANSPORTATION

HIGHWAYS DIVISION

HONOLULU, HAWAII



"AS-BUILT"

PLANS FOR

COMMERCIAL DRIVER'S LICENSE AND MOTORCYCLE LICENSE TESTING FACILITY EXAMINATION SITE AND OFFICE RENOVATION

BENEATH INTERSTATE ROUTE H-1 PEARL CITY VIADUCT



PROJECT NO. HWY-O-08-14

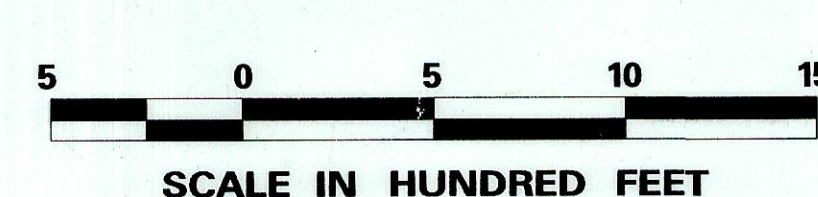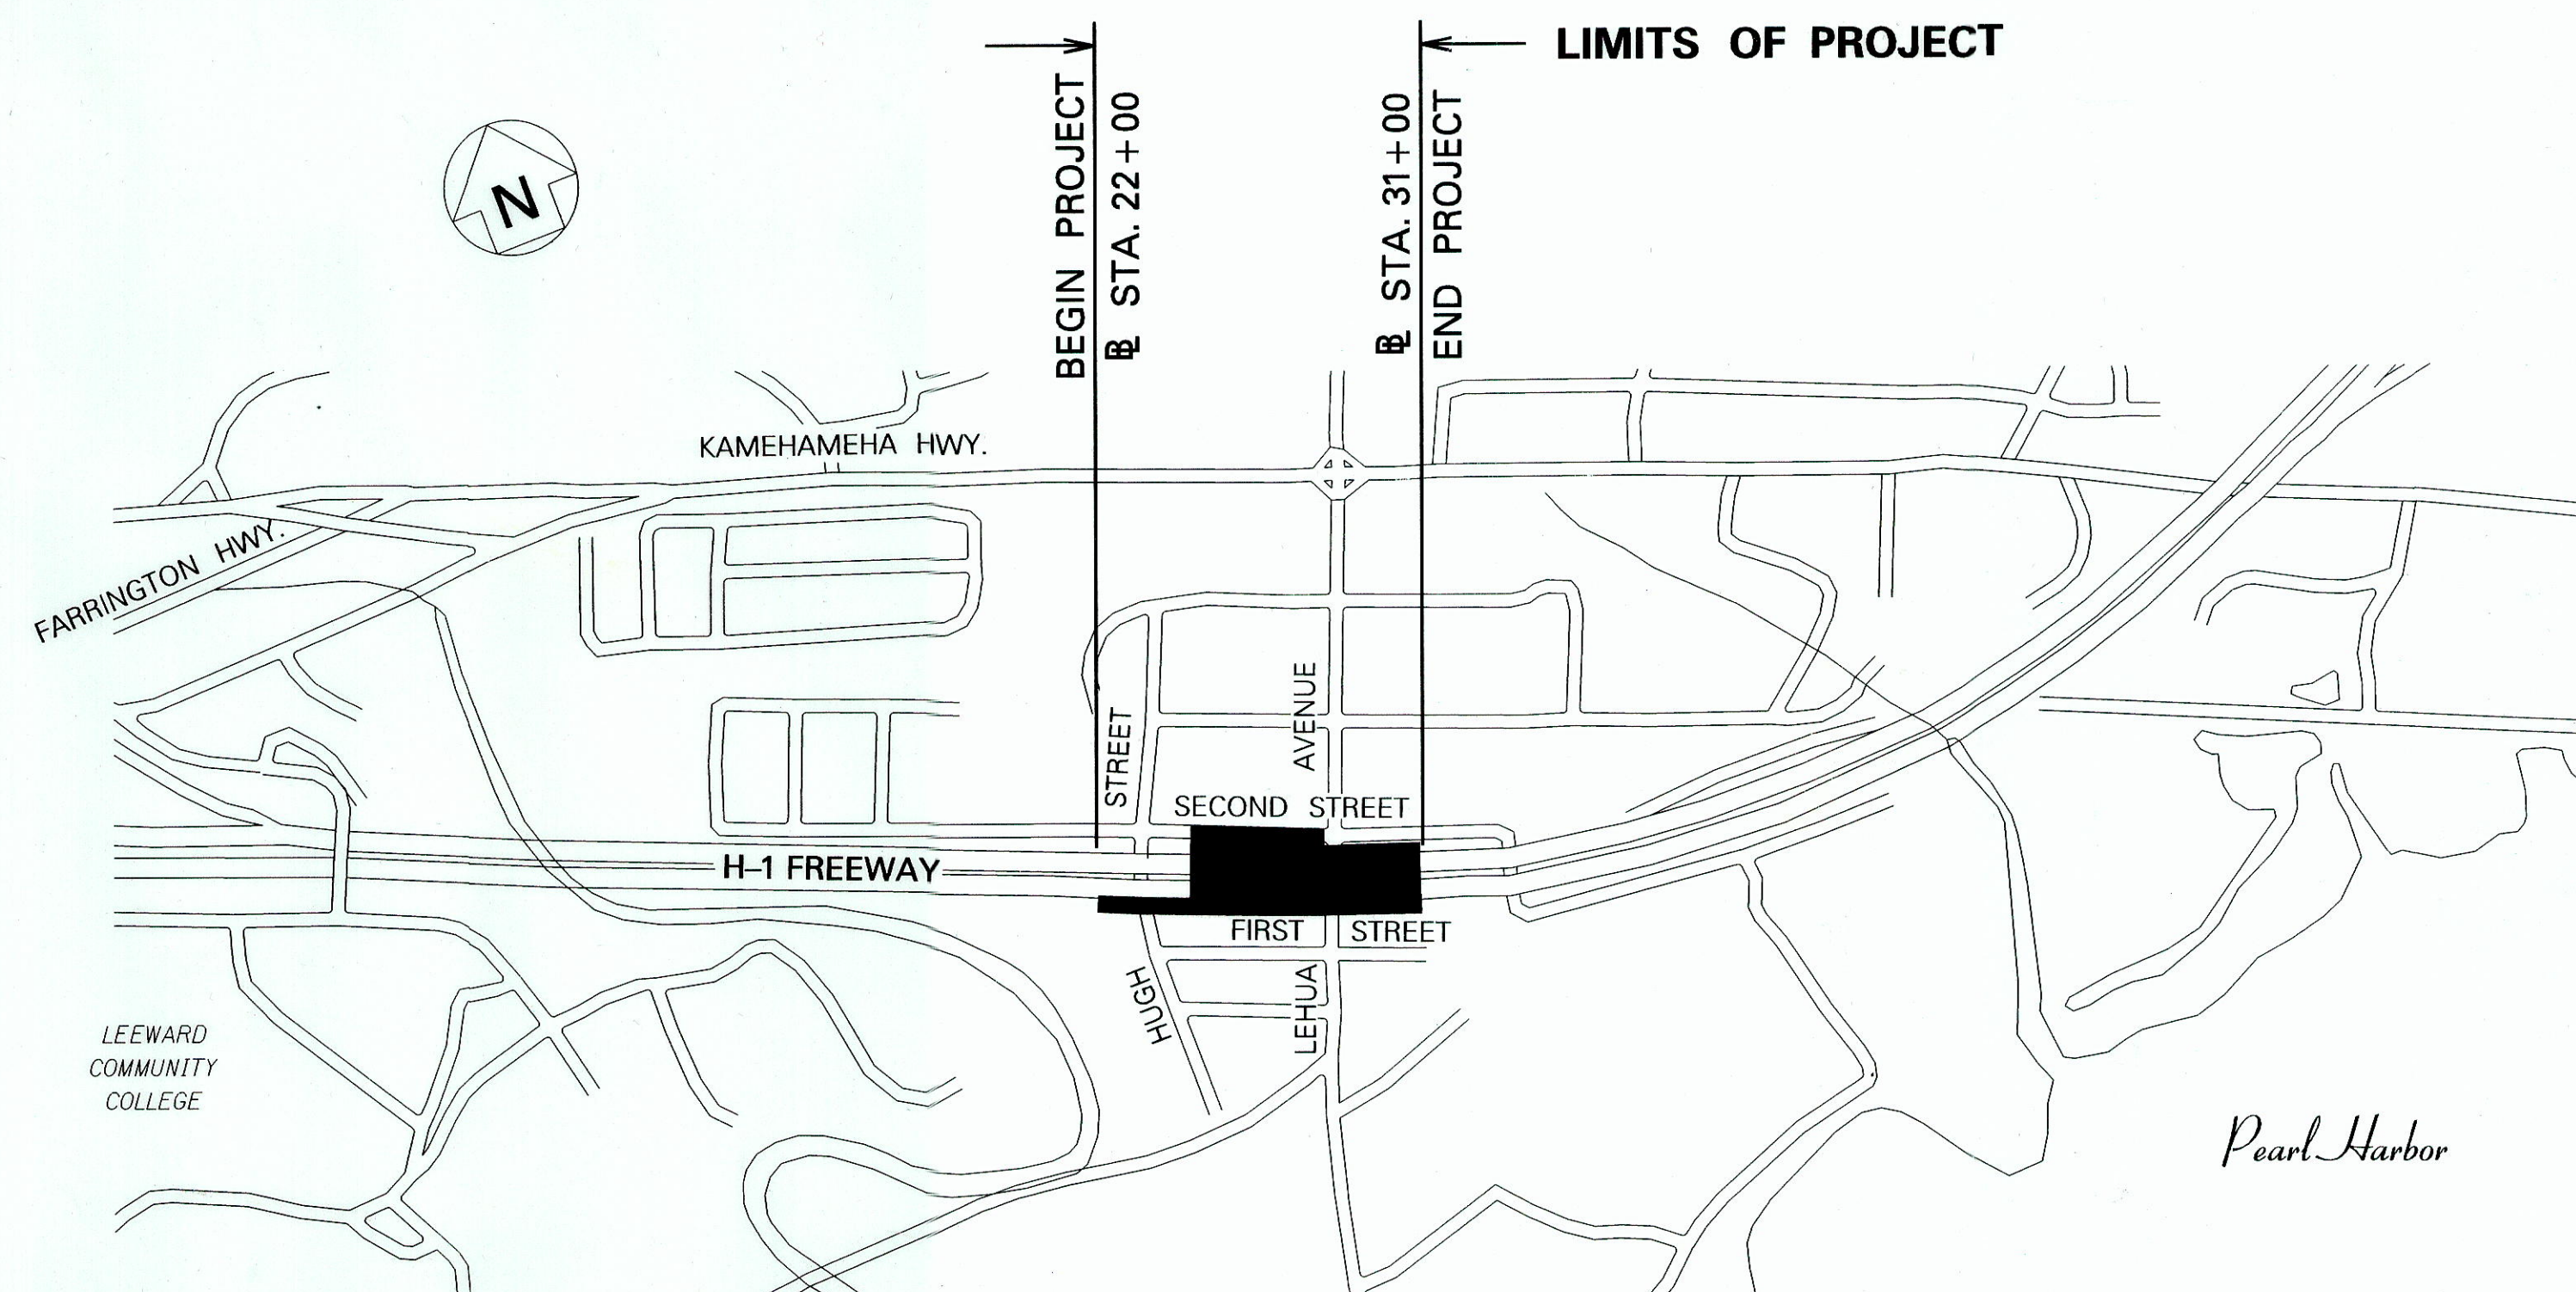

LAYOUT PLAN

GROSS LENGTH OF PROJECT..... 0.21 MILES

NET LENGTH OF PROJECT..... 0.21 MILES

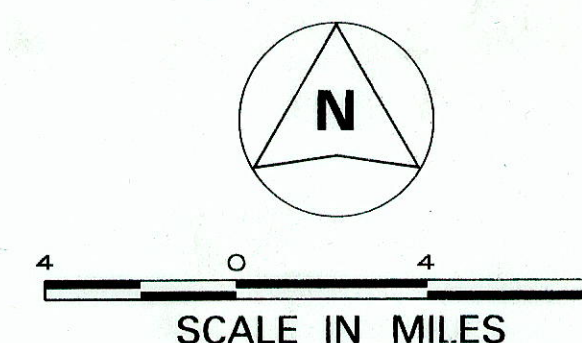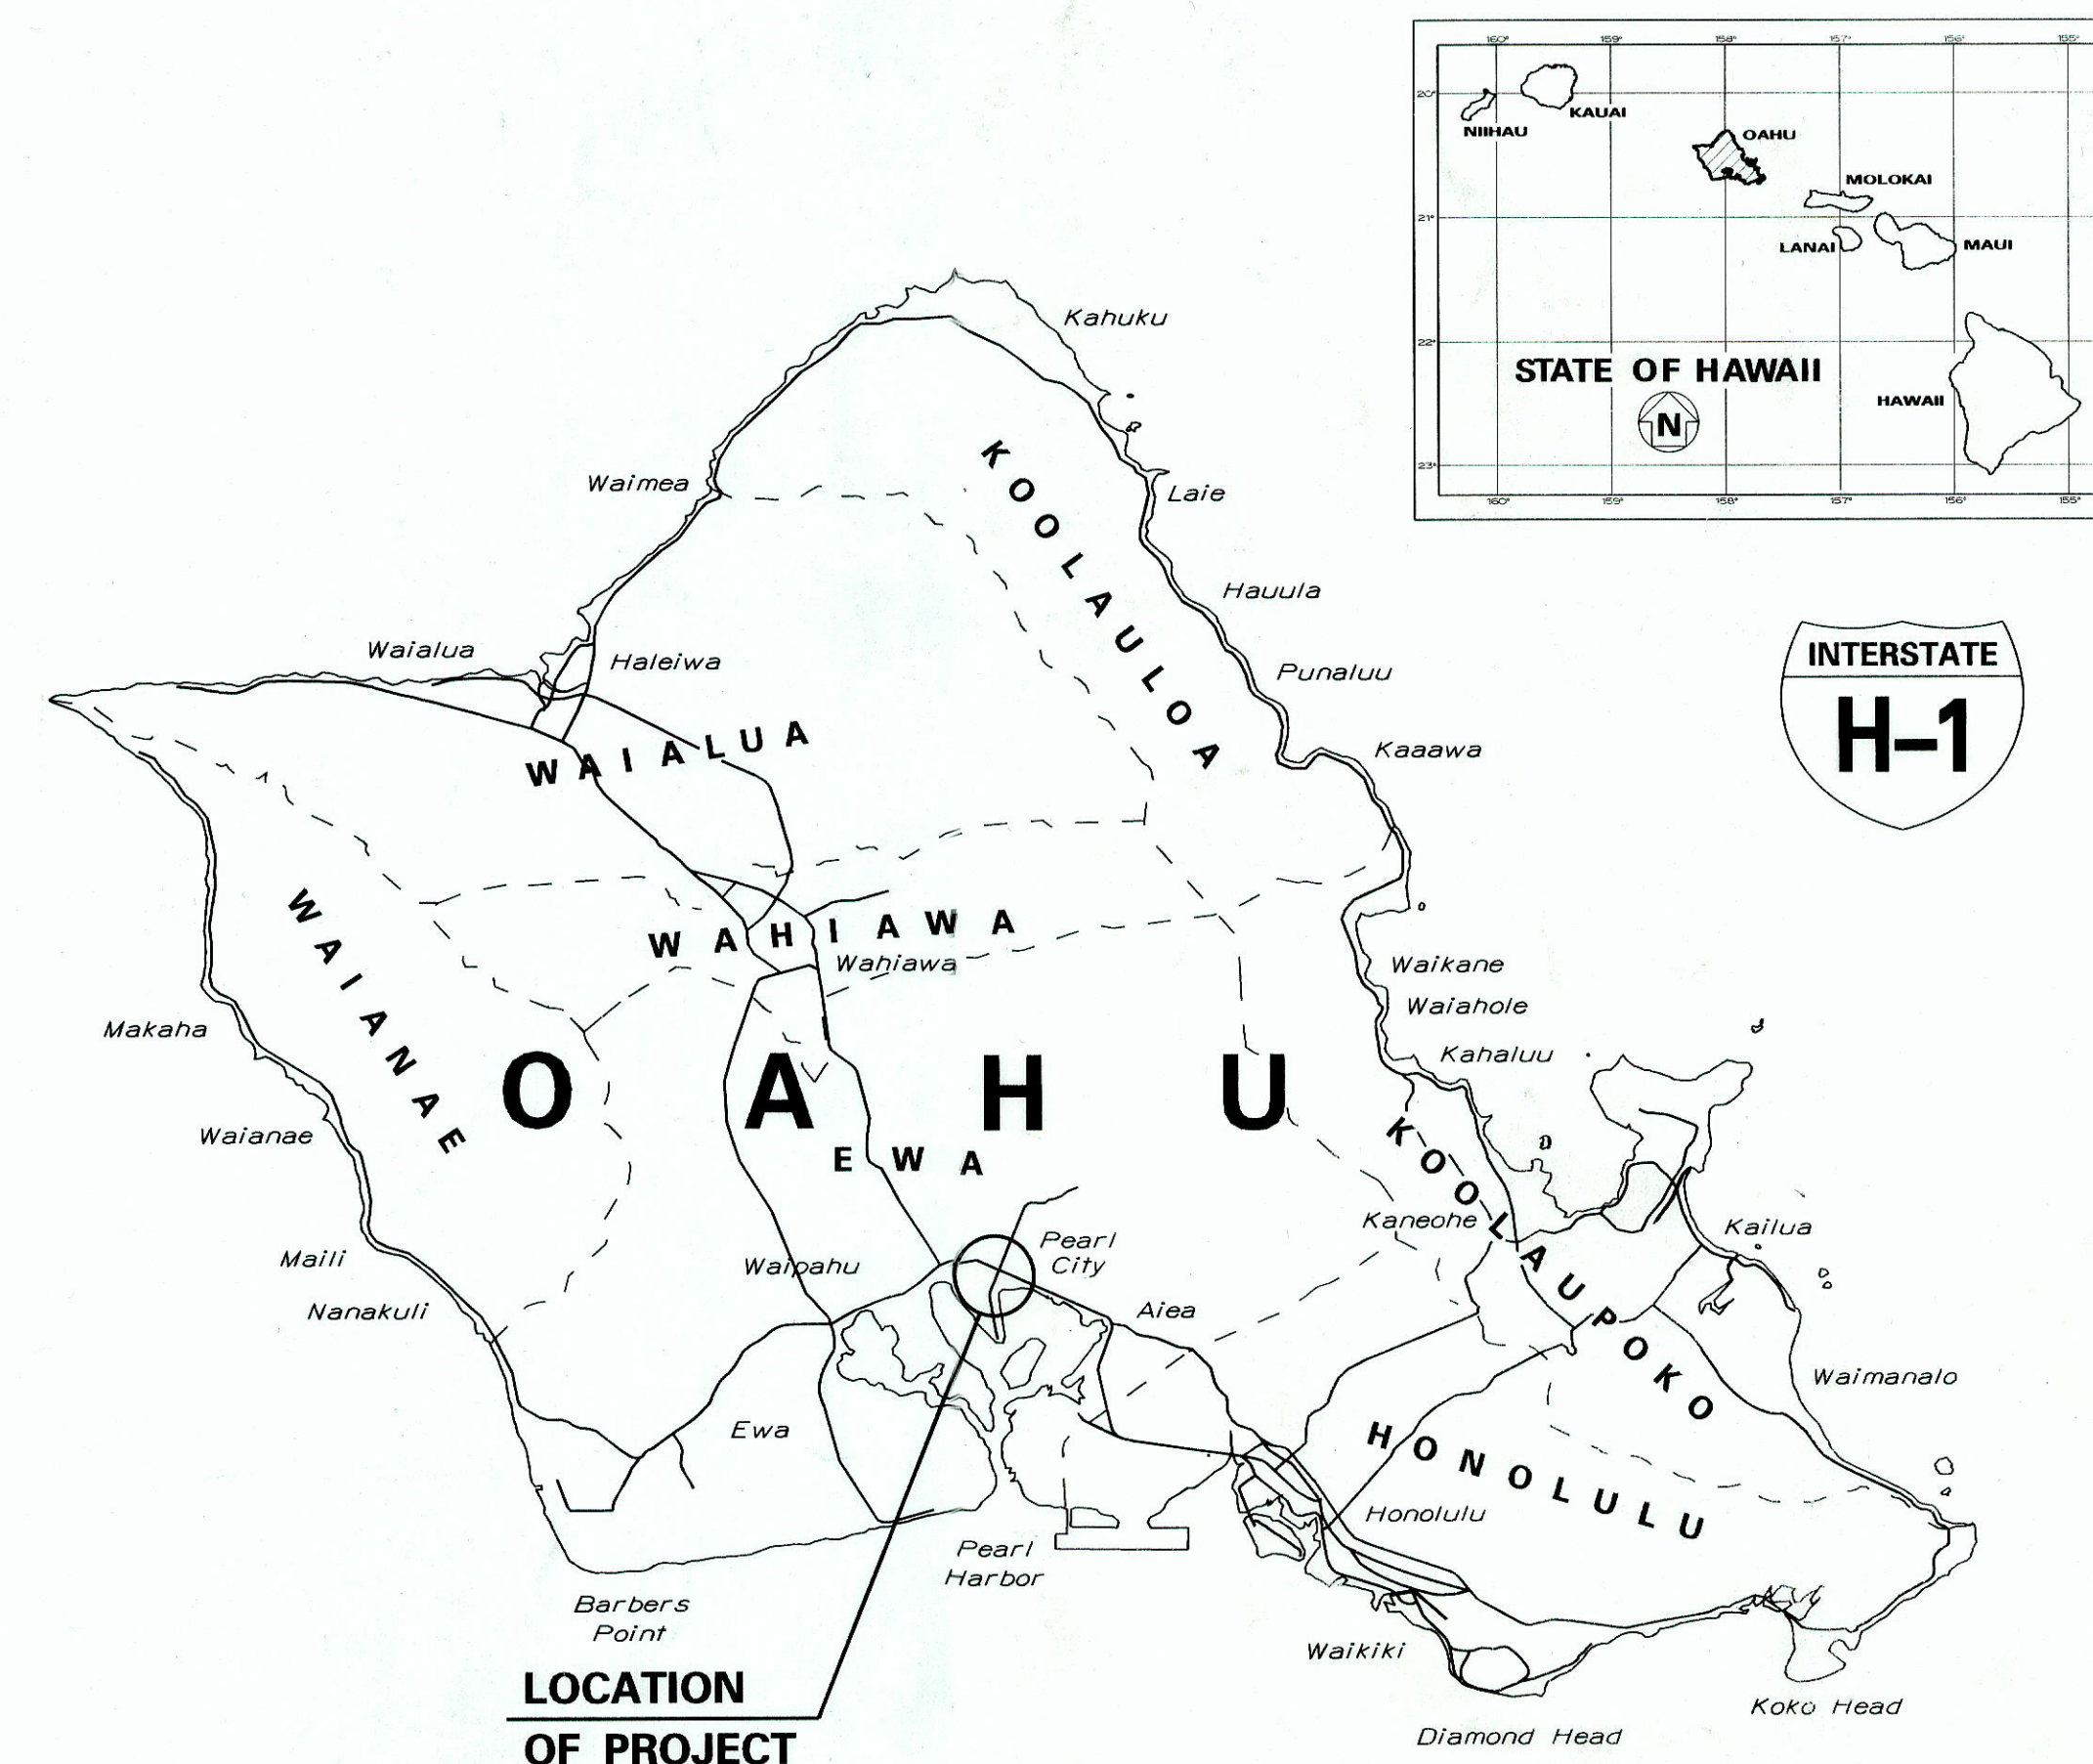

MILE POST 9.56 TO MILE POST 9.80

CHANGES MADE DURING CONSTRUCTION HAVE BEEN INCORPORATED ON THESE PLANS EXCEPT CHANGES IN THE ORIGINAL THEORETICAL QUANTITIES. FOR ACTUAL QUANTITIES, REFER TO PROJECT LEDGER AND/OR COMPUTATION BOOK.

Samuel M. [Signature] 10/10/19
RESIDENT ENGINEER DATE

APPROVED:
M. [Signature] 6/3/2016
for DIRECTOR, DEPT. OF PLANNING & PERMITTING DATE
(For work in City R/W only)

DEPARTMENT OF TRANSPORTATION STATE OF HAWAII	
APPROVED: <i>[Signature]</i> DIR. OF TRANSPORTATION	5-9-16 DATE
5/25/16 DATE	Dept. of Planning and Permitting Approval Signature REVISION