




FED. ROAD DIST. NO.	STATE	FED. AID PROJ. NO.	FISCAL YEAR	SHEET NO.	TOTAL SHEETS
HAWAII	HAW.	HWY-0-04-87	1988	8	8

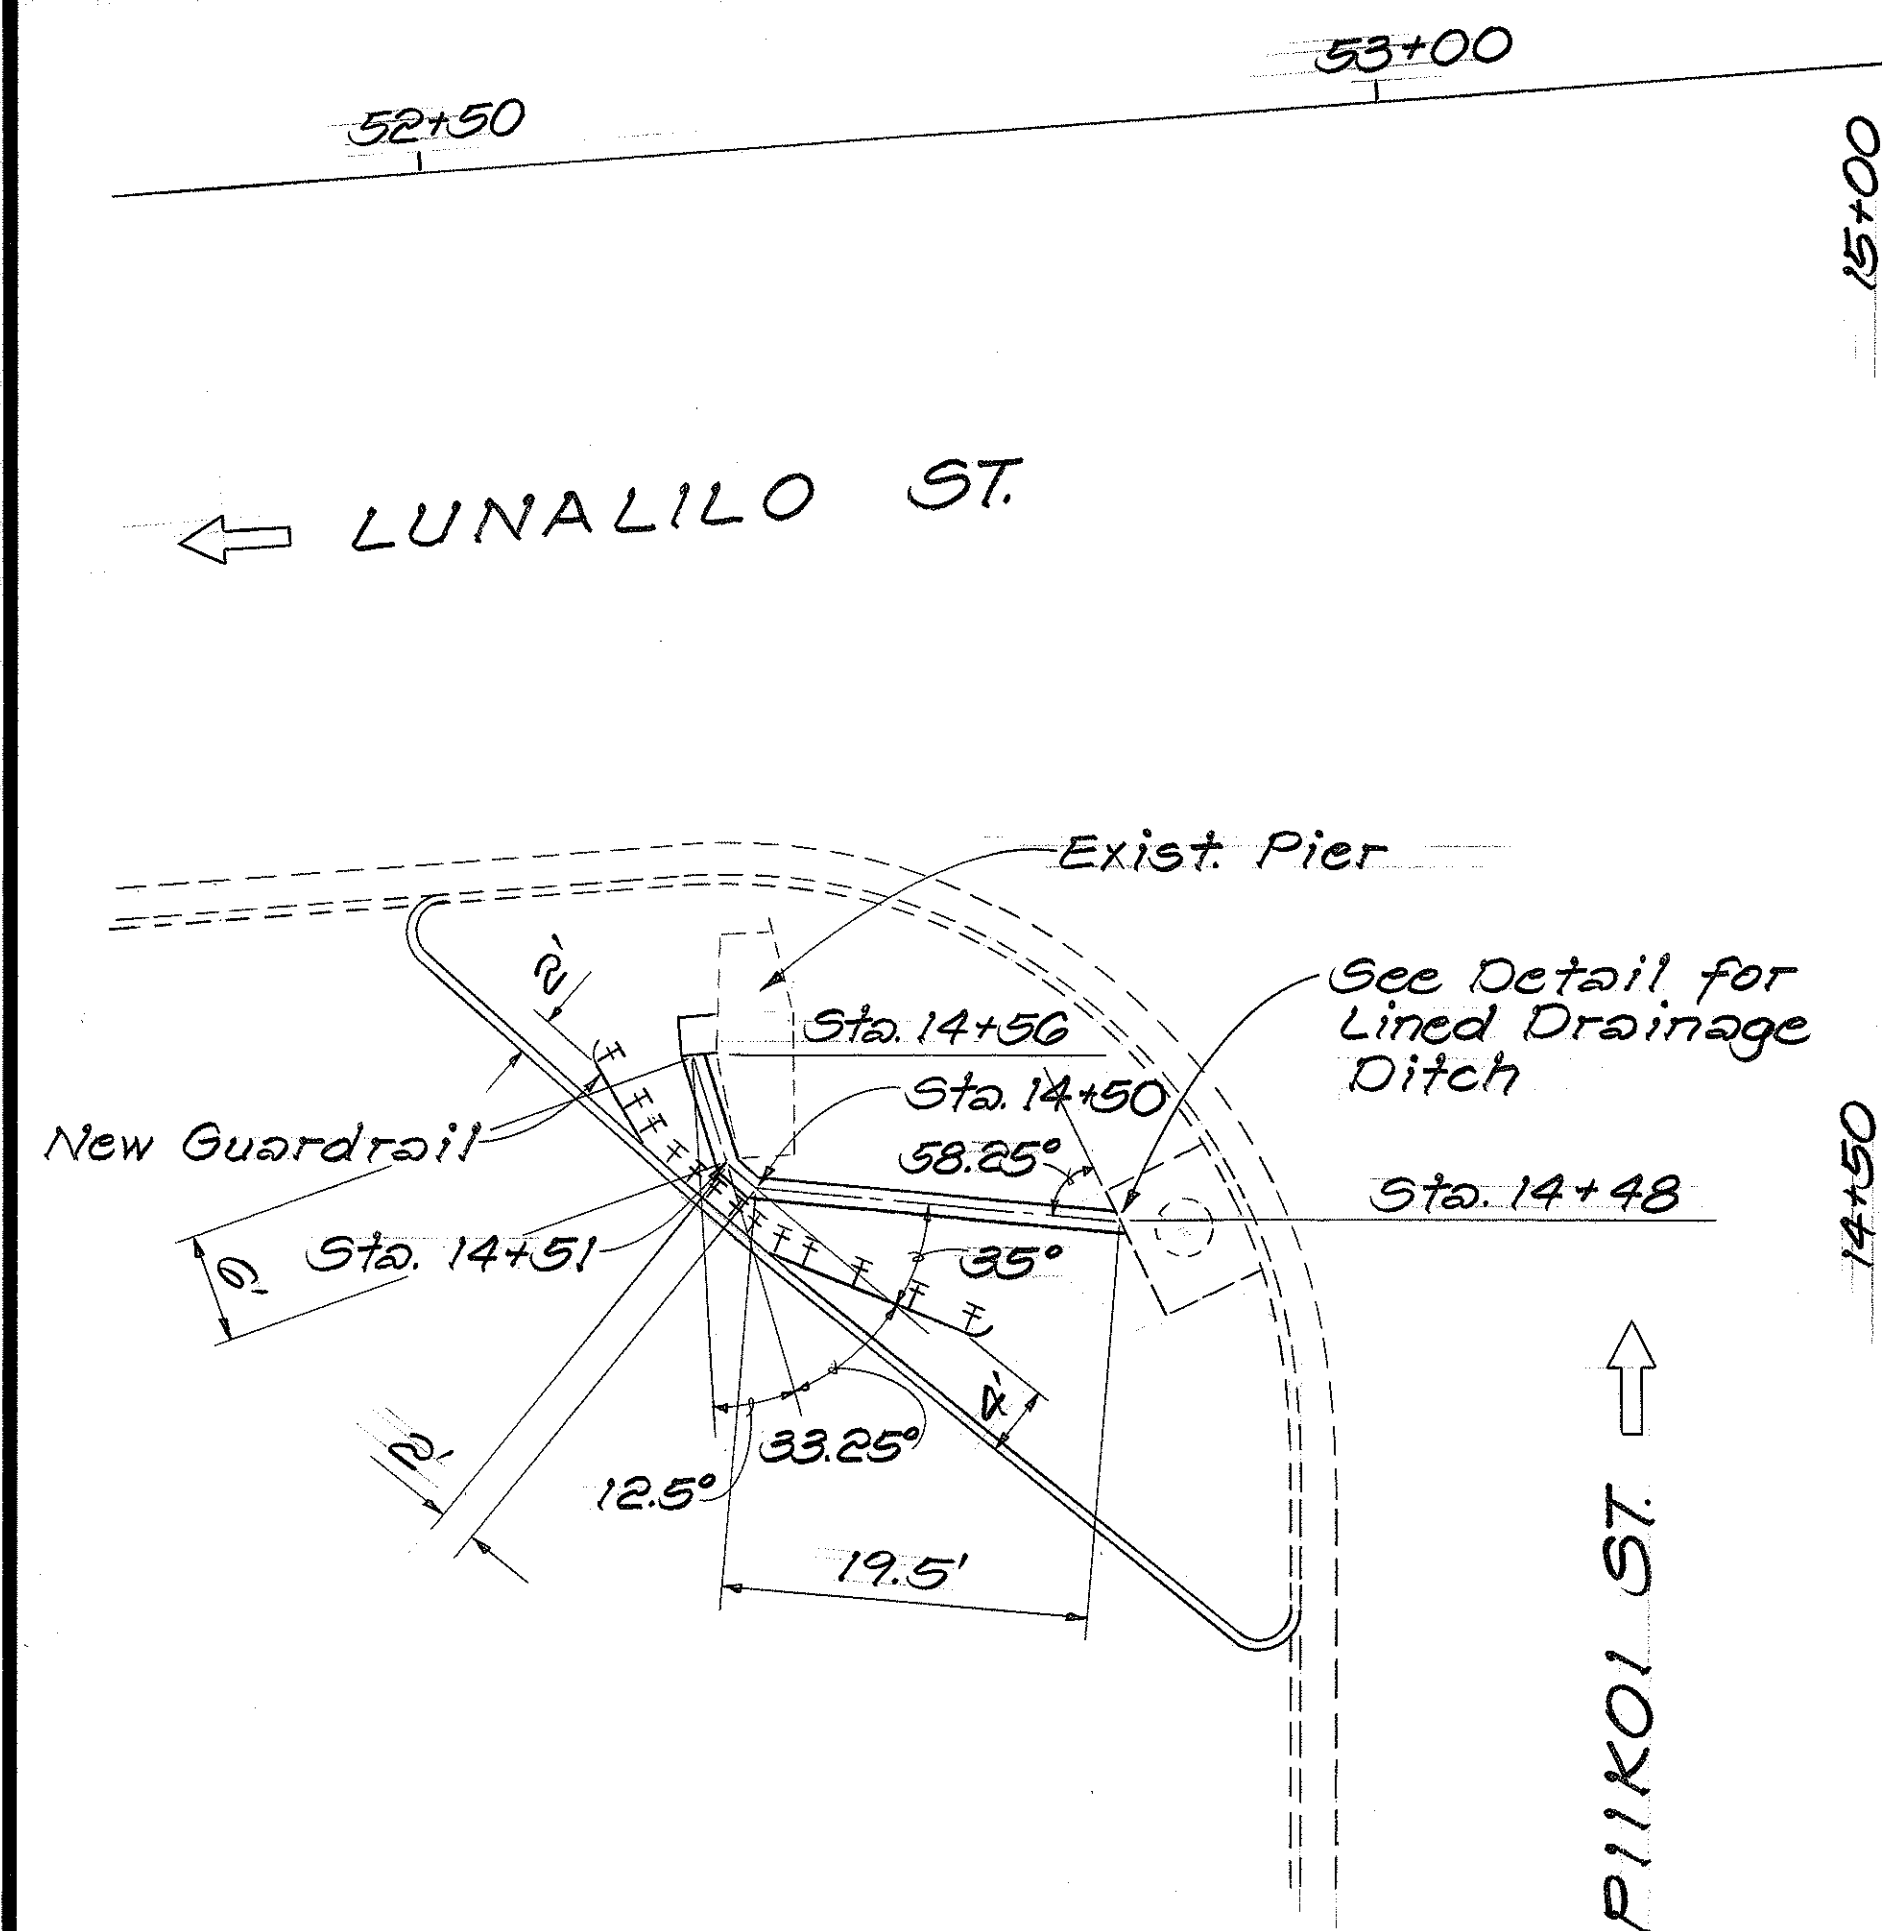

PLAN
Scale: 1" = 10'

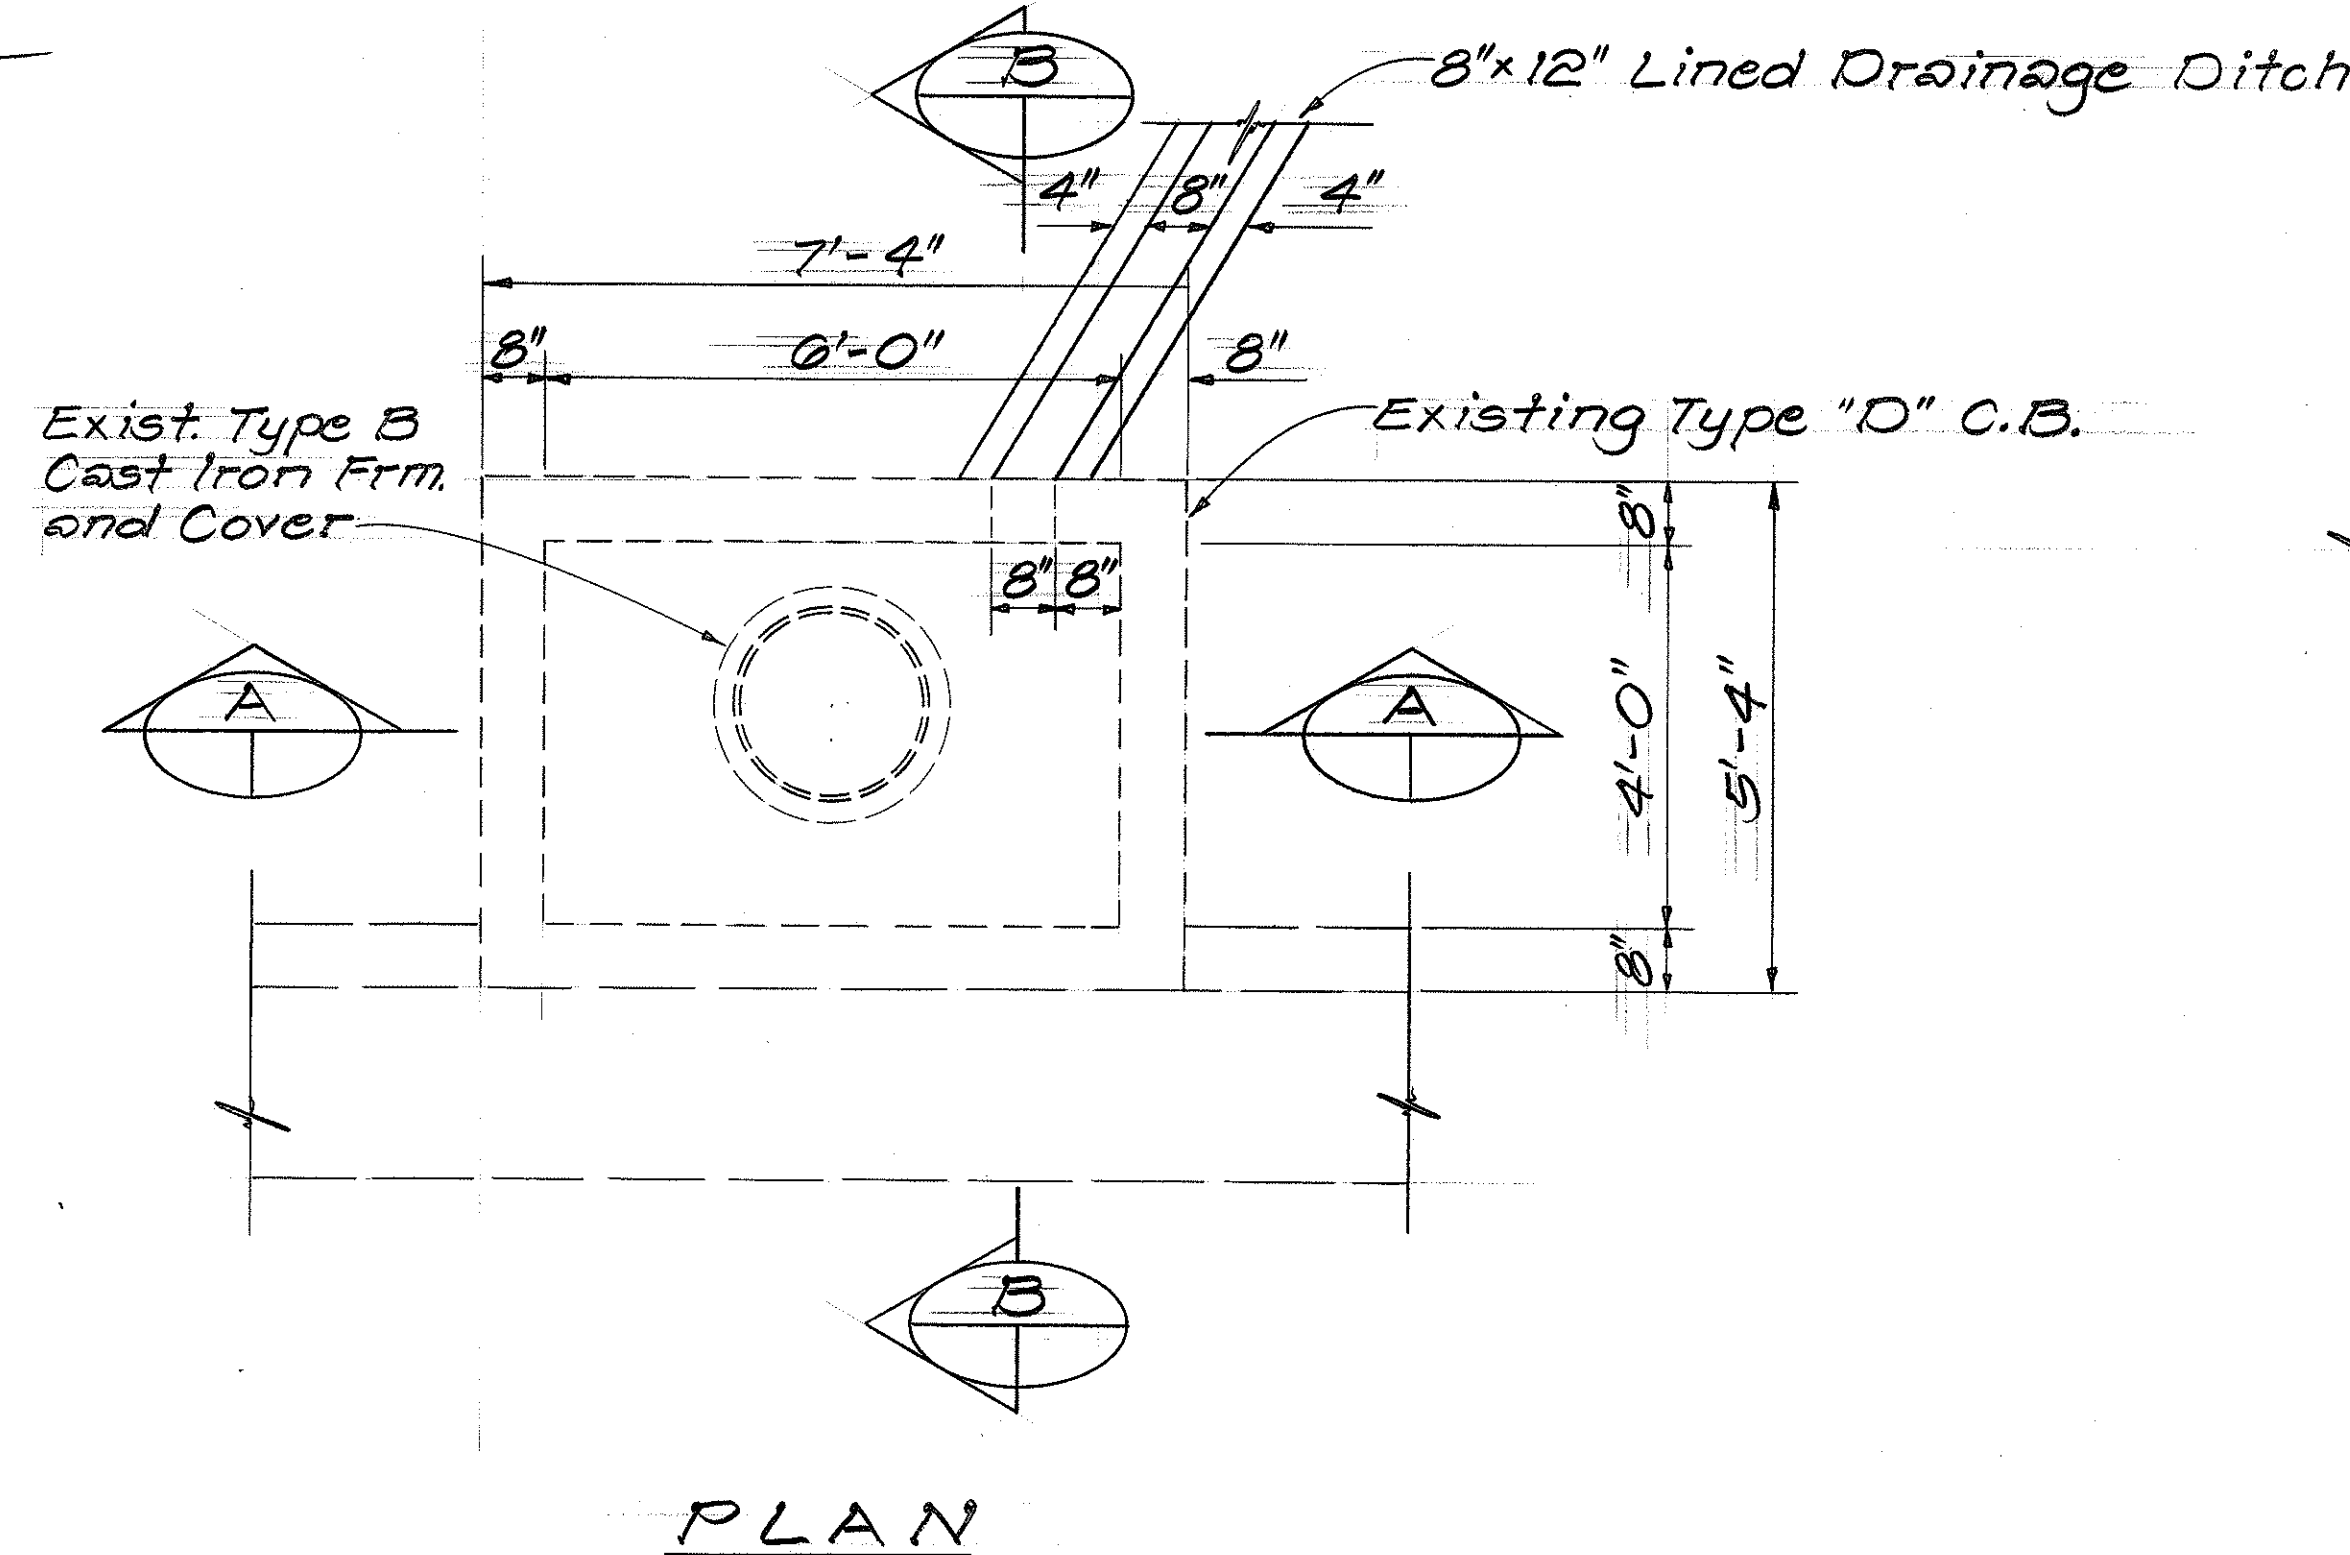


PLAN

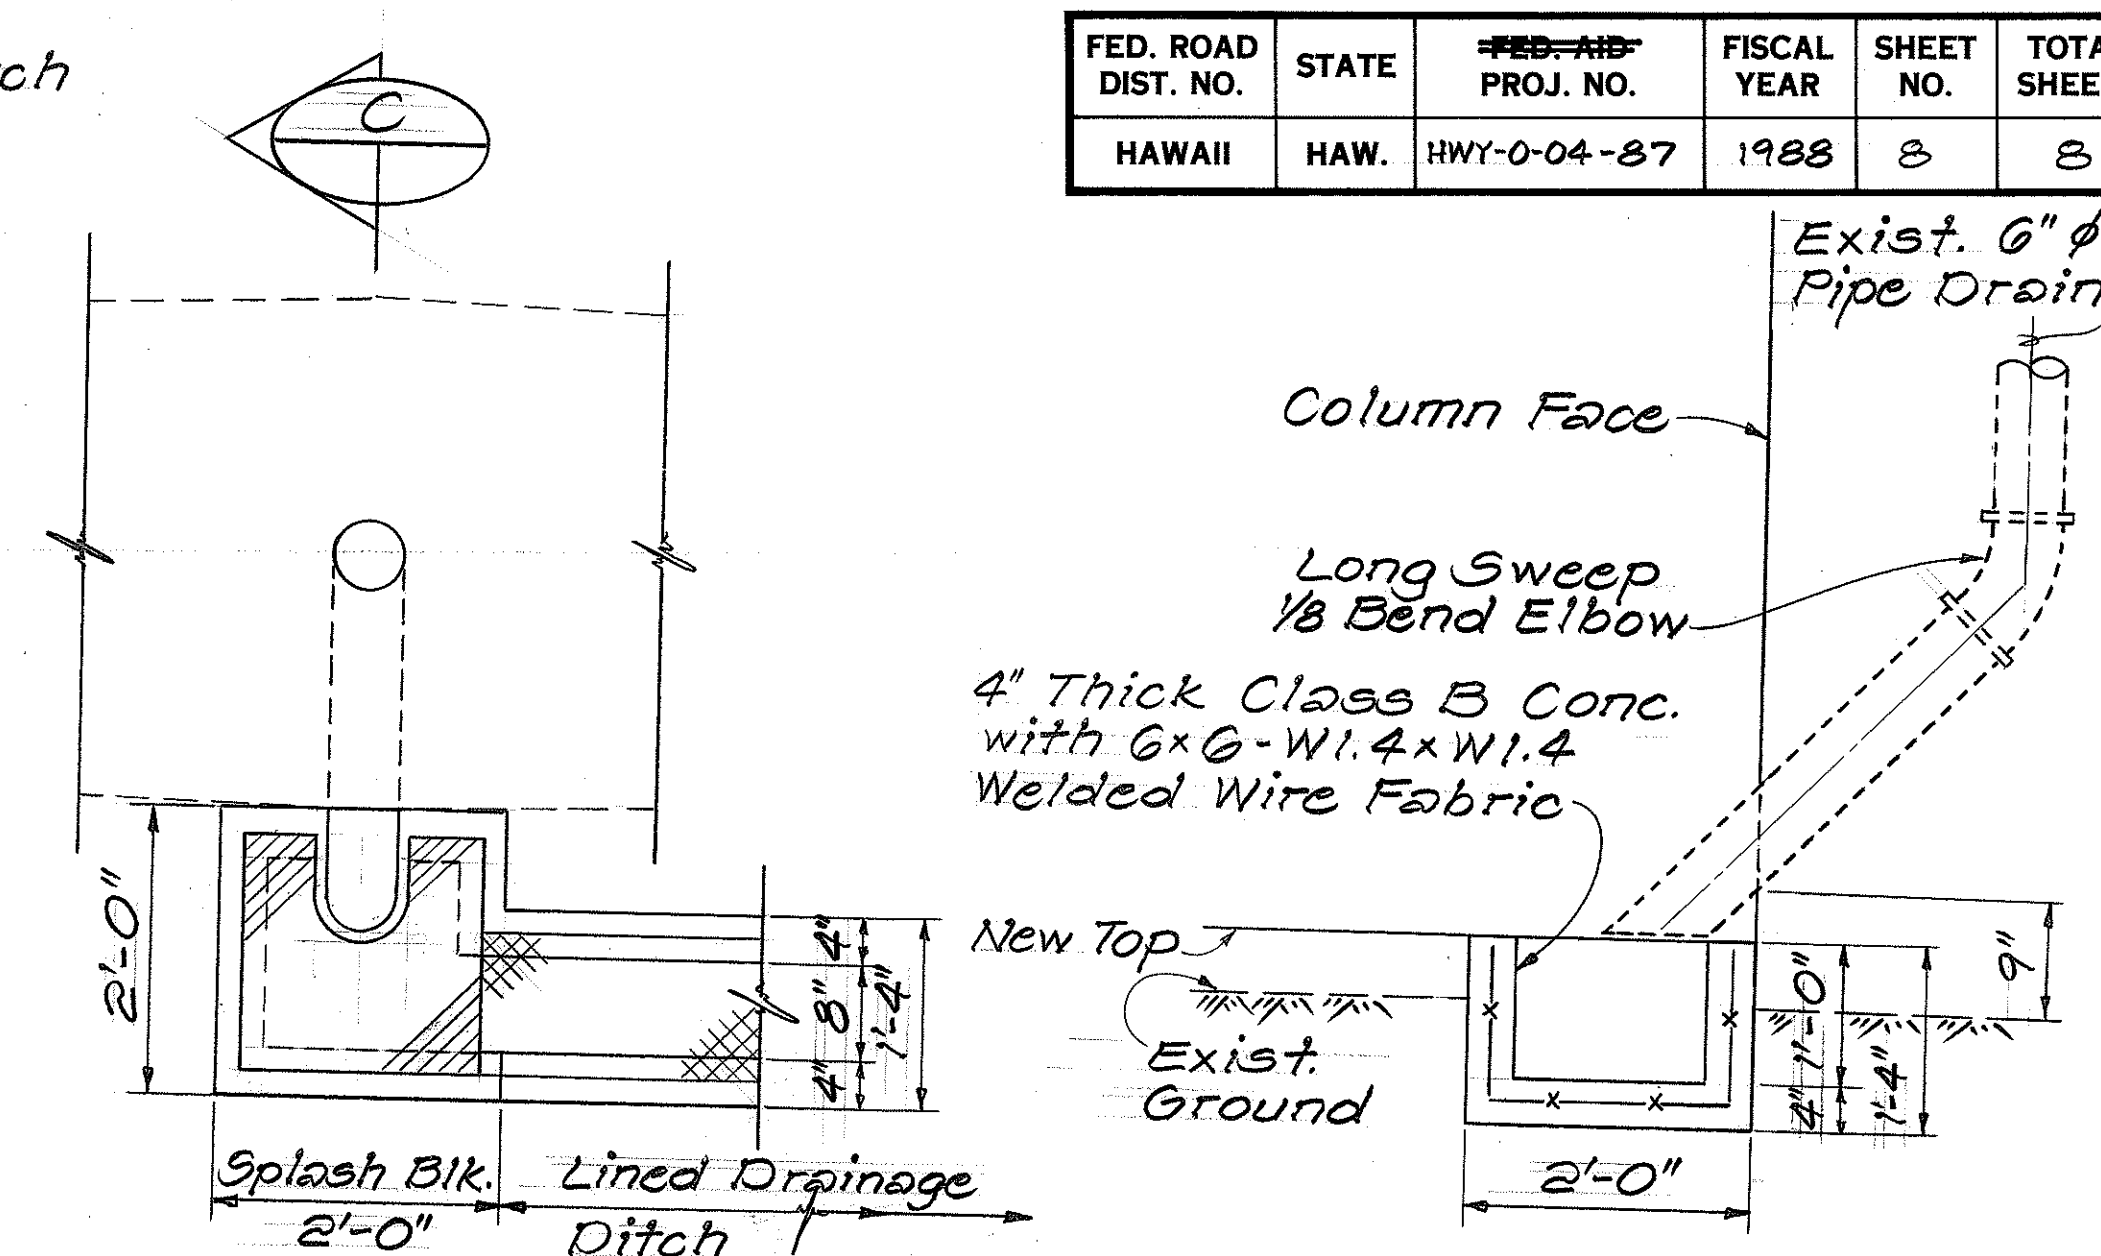

PLAN

SECTION C

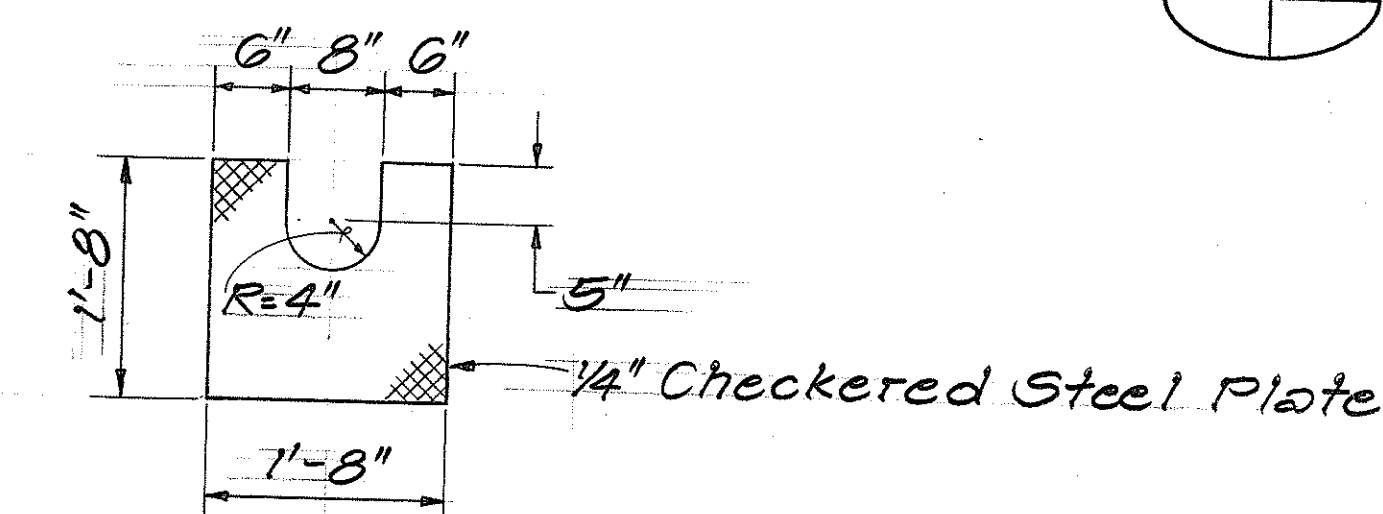


SPLASH BLOCK COVER

SPLASH BLOCK DETAILS


ଓକାଲି: $3/4" = 1'-0"$

DRAINAGE NOTES

1. Existing drainage system will be functional at all times during construction. The Contractor is to furnish materials, equipment, labor, tools and incidentals necessary to accomplish maintenance of flow. The cost shall be incidental to the various contract items.
2. Demolishing, removing and disposing a portion or the entire existing structure shall not be paid for separately, but shall be considered incidental to the various contract items.
3. Concrete shall be Class B unless otherwise noted
4. All steel parts to be galvanized in accordance with the requirements of ASTM A123.

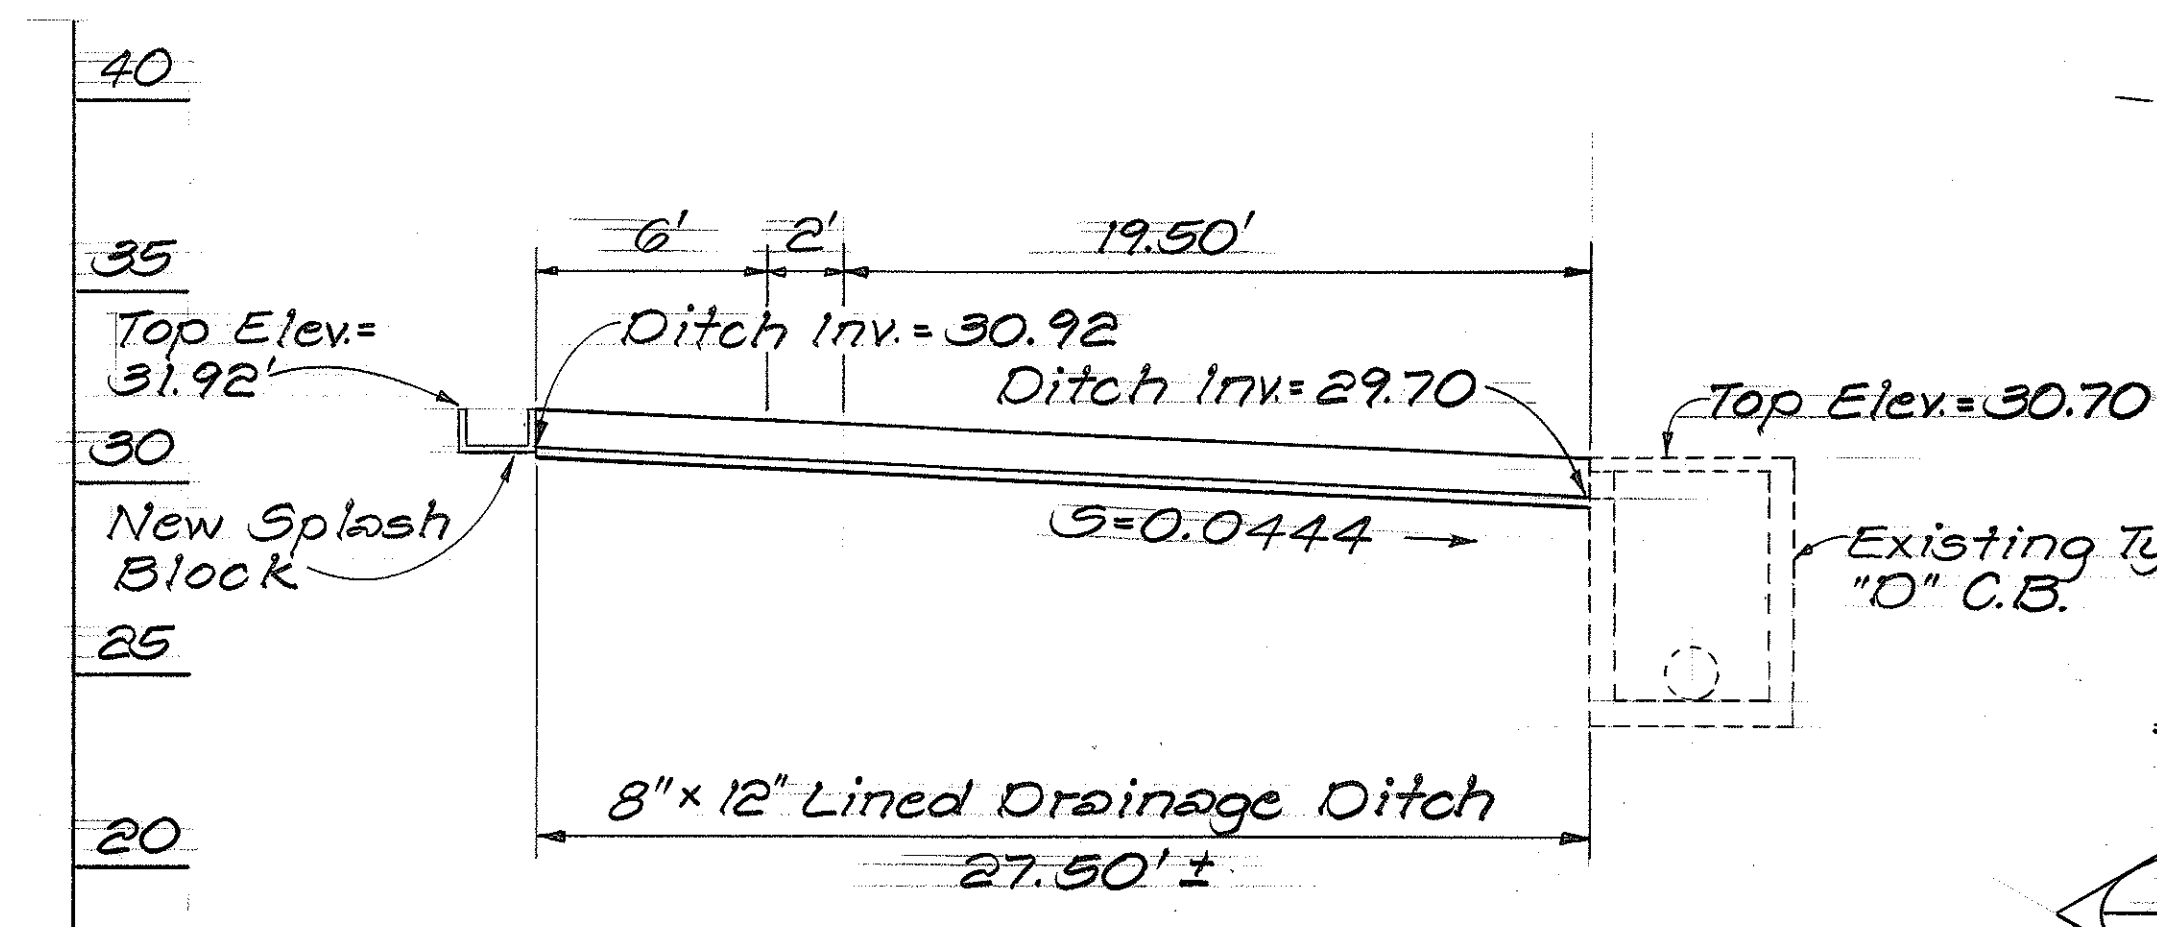


PROFILE
Scale: Hor. = 1" = 5'-0"
Vert. = 1" = 5'-0"

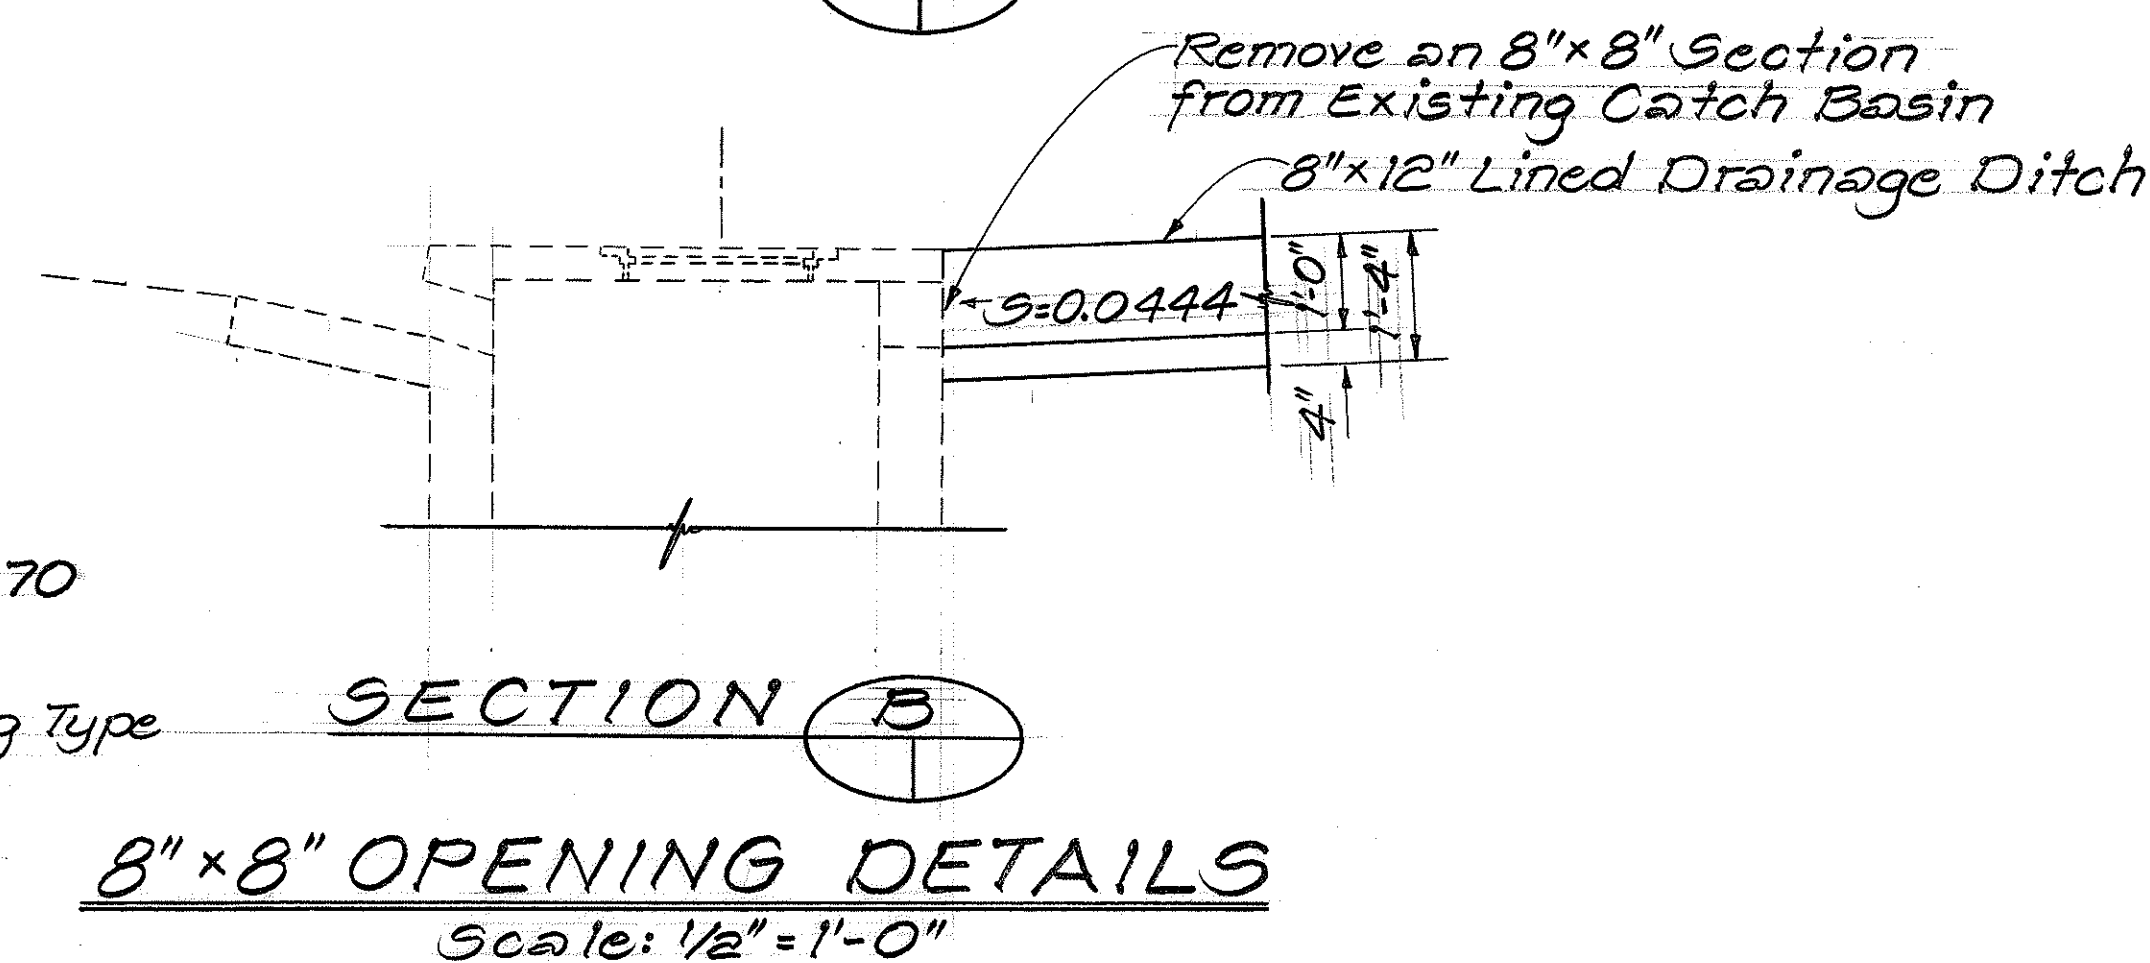

8" x 8" OPENING DETAILS

Scale: $\frac{1}{2}" = 1'-0"$

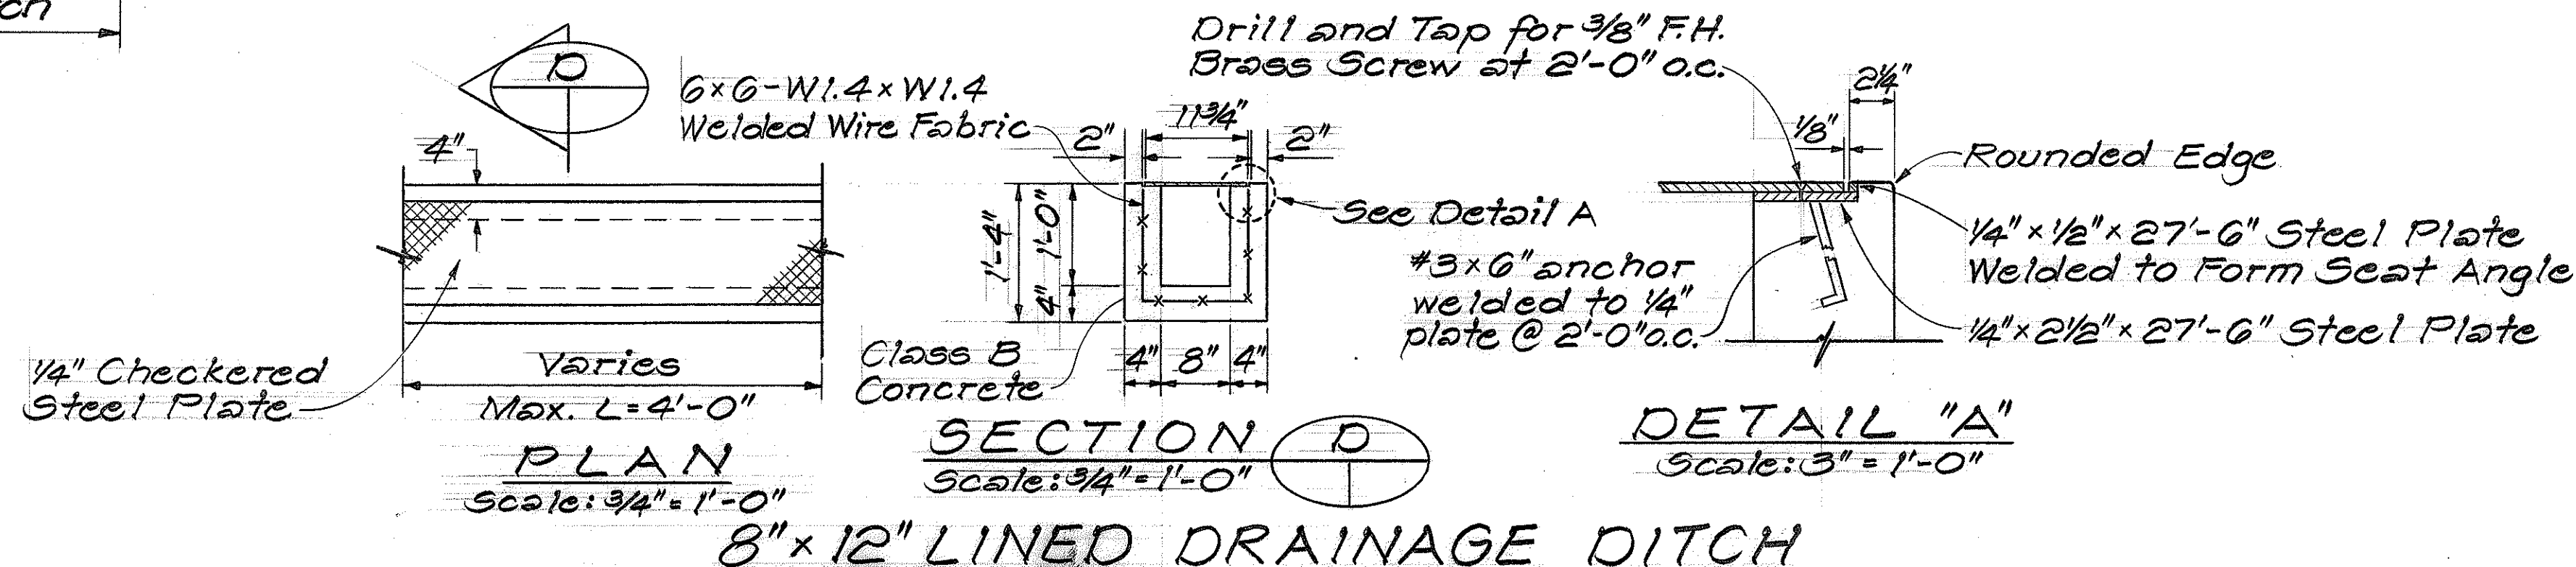

PIAN

SECTION

DETAIL "A"
(Scale: 3" = 1'-0")

8" x 12" LINED DRAINAGE DITCH

ORIGINAL PLAN	SURVEY PLOTTED BY _____ DATE _____
NOTE BOOK	DRAWN BY _____
	TRACED BY _____
	DESIGNED BY _____
	QUANTITIES BY _____
No. _____	CHECKED BY _____

STATE OF HAWAII
DEPARTMENT OF TRANSPORTATION
HIGHWAYS DIVISION
DRAINAGE PLANS
AND DETAILS
LUNALILO ST. AND PIKOI ST.
INTERSECTION IMPROVEMENTS
ADDITIONAL LN. & TRAFFIC SIGNALS
PROJ. NO. HWY-0-04-87
SCALE: AS NOTED DATE: JUN. 1988