	INDEX TO DRAWINGS
SHEET NO.	DESCRIPTION
	TITLE SHEET
2	STANDARD PLANS SUMMARY
3	TYPICAL SECTION, GENERAL NOTES & DETAILS
4	PLAN
5-6	SIGNING & PAVEMENT MARKINGS
7	CROSS SECTION
8	DRAINAGE PLANS & DETAILS
	•
:	

STATE OF HAWAII

DEPARTMENT OF TRANSPORTATION

HIGHWAYS DIVISION

"AS BUILT"

PLANS FOR


LUNALILO ST. AND PIIKOI ST.


INTERSECTION IMPROVEMENTS

ADDITIONAL LANE AND TRAFFIC SIGNALS

PROJECT NO. HWY-0-04-87

DISTRICT OF HONOLULU ISLAND OF OAHU

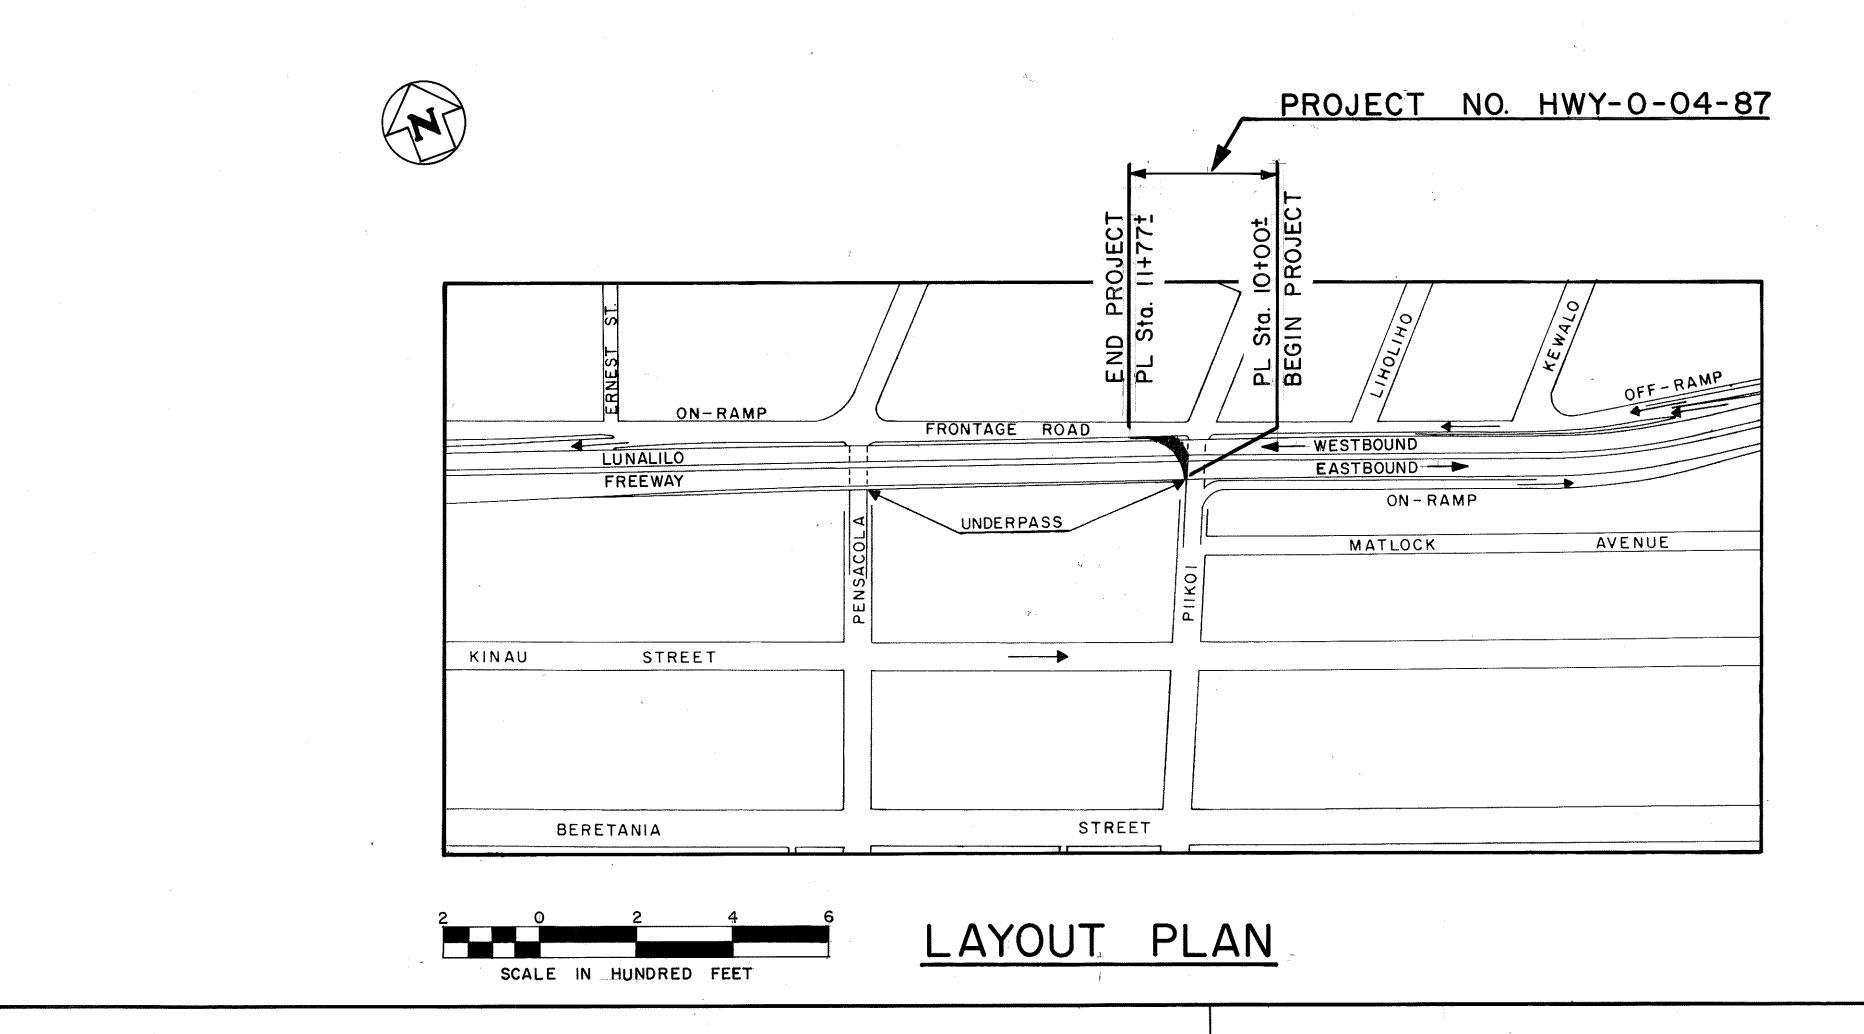

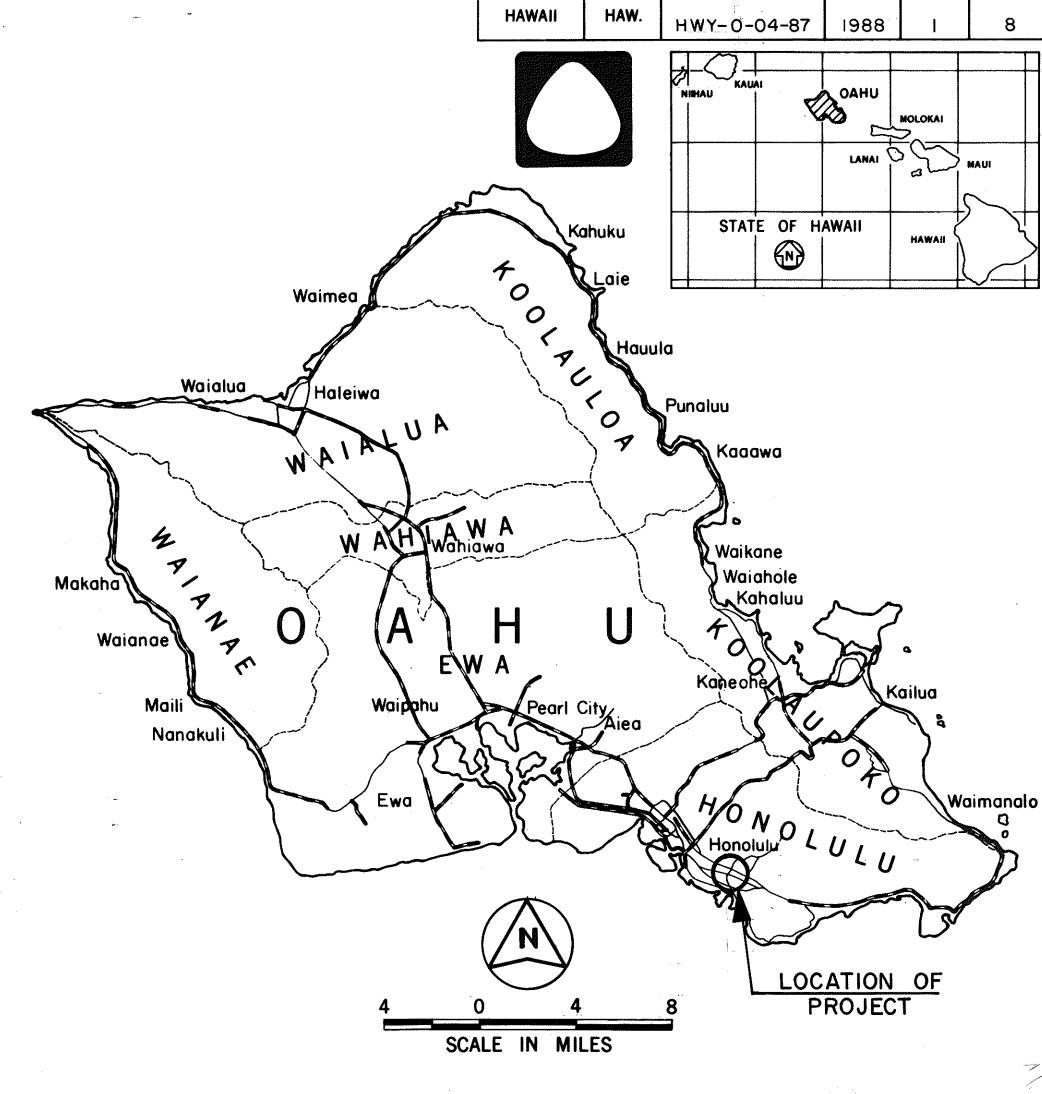

FED. ROAD DIST. NO.

FEDERAL AID PROJECTS PREVIOUSLY CONSTRUCTED OR UNDER CONSTRUCTION

CHANGES MADE DURING CONSTRUCTION HAVE BEEN INCORPORATED ON THESE PLANS EXCEPT CHANGES IN THE ORIGINAL THEORETICAL QUANTITIES. FOR ACTUAL QUANTITIES, REFER TO PROJECT LEDGER AND/OR COMPUTATION BOOK.

Sidney S.C. 25 5/2/91

RESIDENT ENGINEER DATE

DEPARTMENT OF TRANSPORTATION STATE OF HAWAII

APPROVED:

OF TRANSPORTATION DA

FISCAL SHEET TOTAL YEAR NO. SHEETS