


FED. ROAD DIST. NO.	STATE	PROJ. NO.	FISCAL YEAR	SHEET NO.	TOTAL SHEETS
HAWAII	HAW.	HWY-0-02-87	1988	5	6

Area to be resurfaced

Reconstruction Area

True North
Scale: 1"=20'-0"

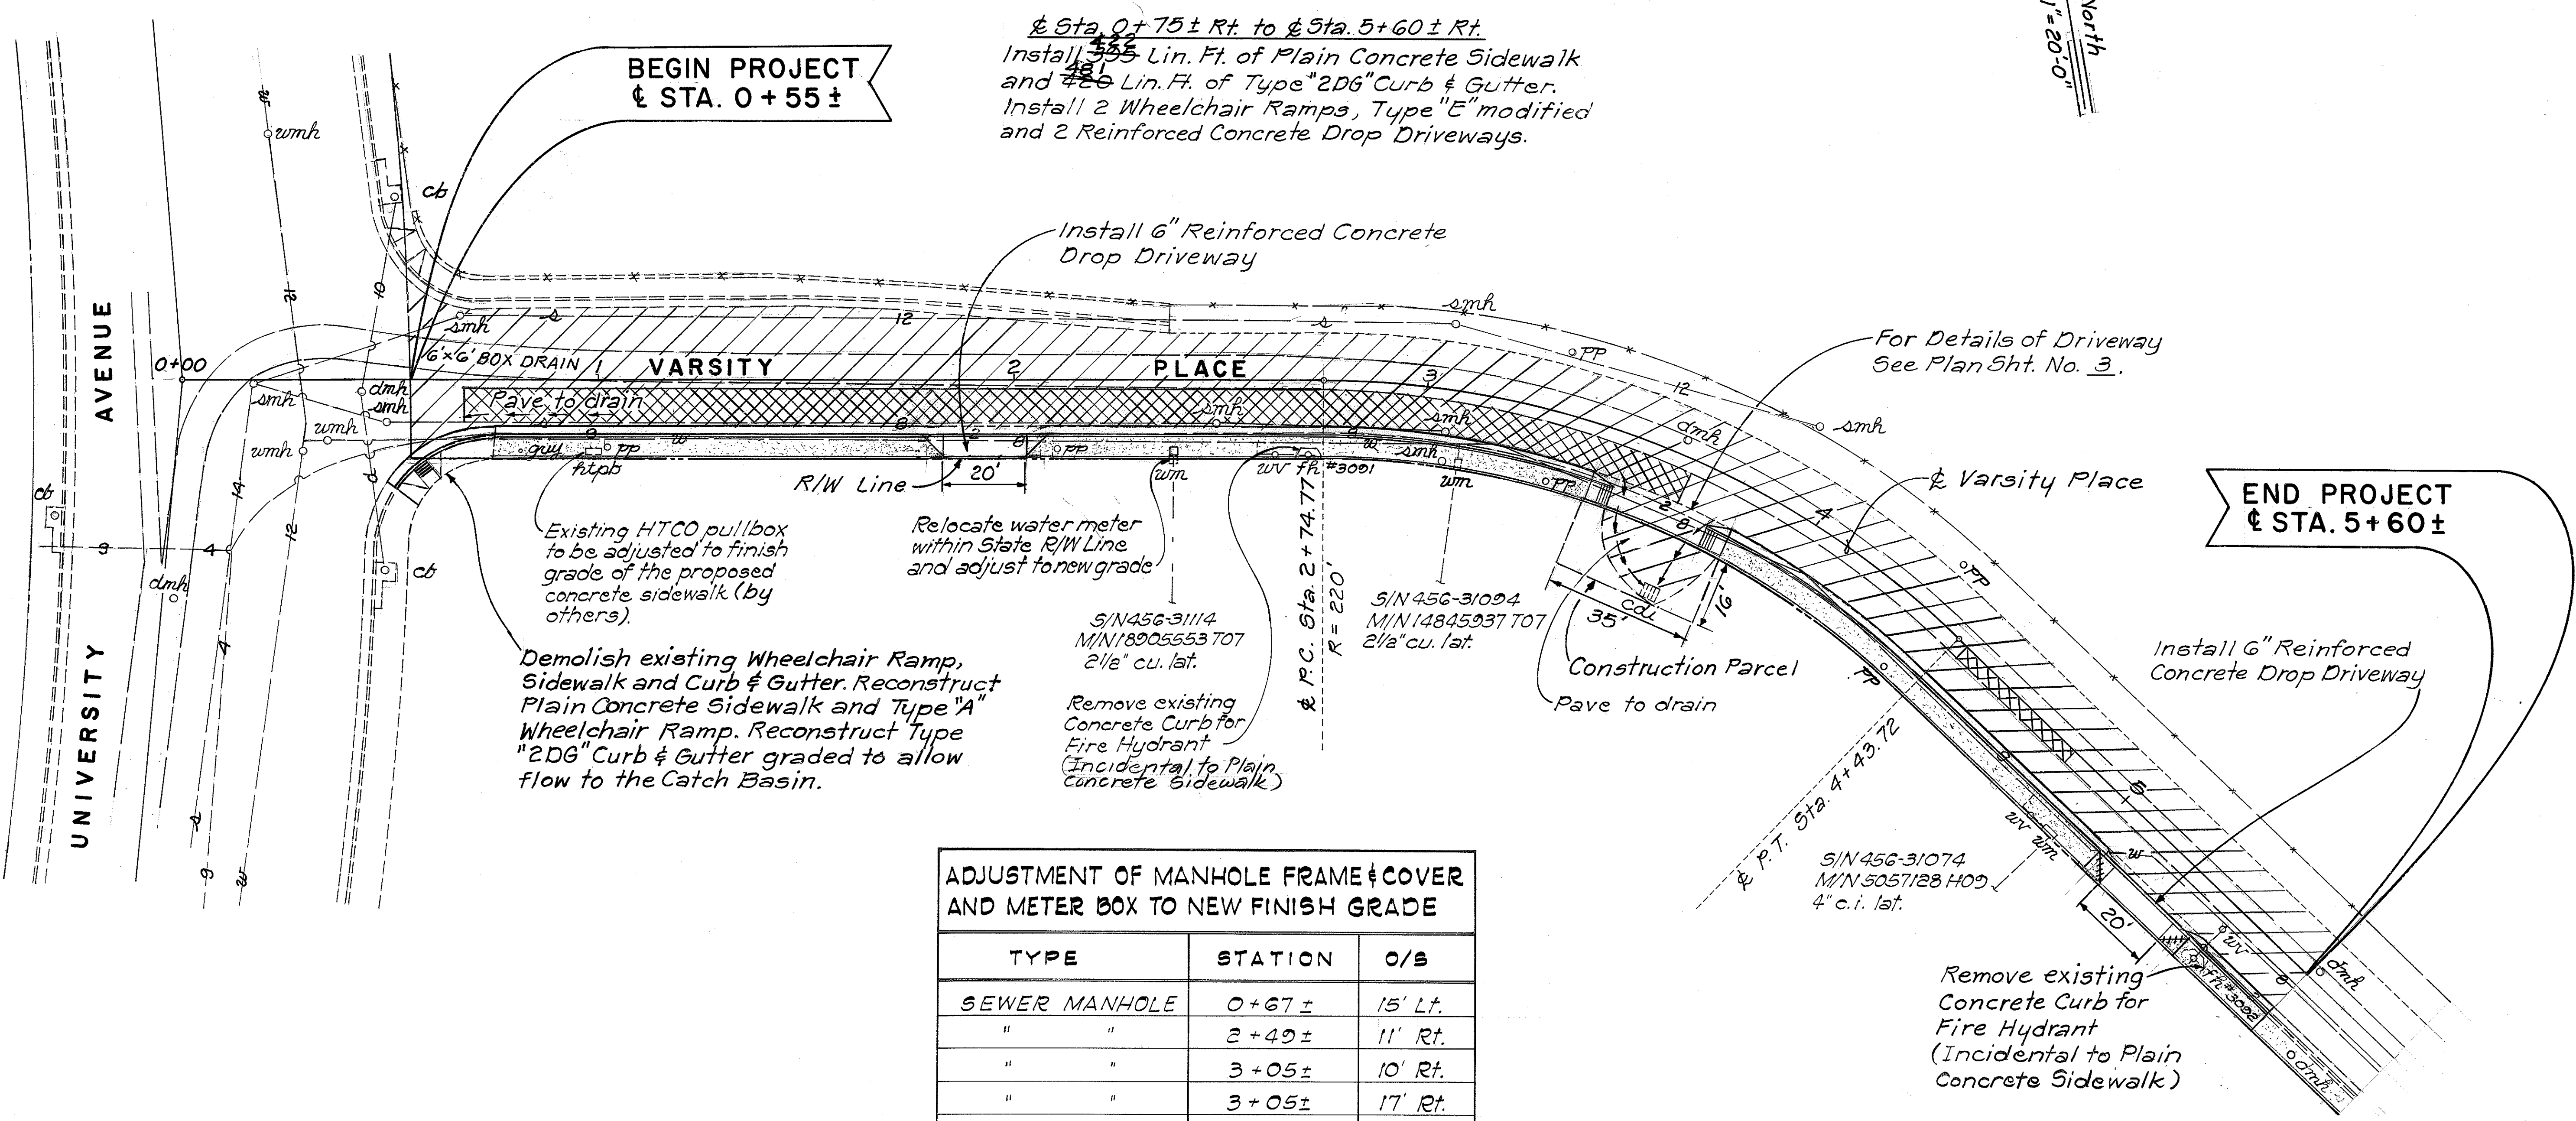

ADJUSTMENT OF MANHOLE FRAME & COVER AND METER BOX TO NEW FINISH GRADE		
TYPE	STATION	O/S
SEWER MANHOLE	0+67±	15' Lt.
"	2+49±	11' Rt.
"	3+05±	10' Rt.
"	3+05±	17' Rt.
WATER VALVE "	2+63±	18' Rt.
"	4+87±	18' Rt.
"	5+39±	6' Rt.
STORM DRAIN "	3+62±	4' Lt.
WATER METER BOX	2+38±	18' Rt.
"	3+09±	18' Rt.
"	4+92±	18' Rt.

DATE	
SURVEY PLOTTED BY	
DESIGNED BY	
TRACED BY	
NOTE BOOK	
QUANTITIES BY	
CHECKED BY	
No.	

STATE OF HAWAII

DEPARTMENT OF TRANSPORTATION

HIGHWAYS DIVISION

PLAN

Varsity Place Improvements

University Ave. Towards Kalo Place

PROJECT NO. HWY-0-02-87

Scale: 1"=20' Date: June, 1987

SHEET No. 1 OF 1 SHEETS