	INDEX TO DRAWINGS
SHEET NO.	DESCRIPTION
1	TITLE SHEET
2	STANDARD PLANS SUMMARY
3	TYPICAL SECTIONS AND GENERAL NOTES
4	TYPICAL ROADWAY DETAILS
<sub>2</sub> 5	PLAN
6,	STRIPING PLAN, LEGEND AND NOTES


STATE OF HAWAII


DEPARTMENT OF TRANSPORTATION
HIGHWAYS DIVISION
HONOLULU, HAWAII
"AS-BUILT"
PLANS FOR

VARSITY PLACE IMPROVEMENTS
UNIVERSITY AVENUE TOWARDS KALO PLACE

PROJECT NO. HWY-0-02-87

DISTRICT OF HONOLULU ISLAND OF OAHU

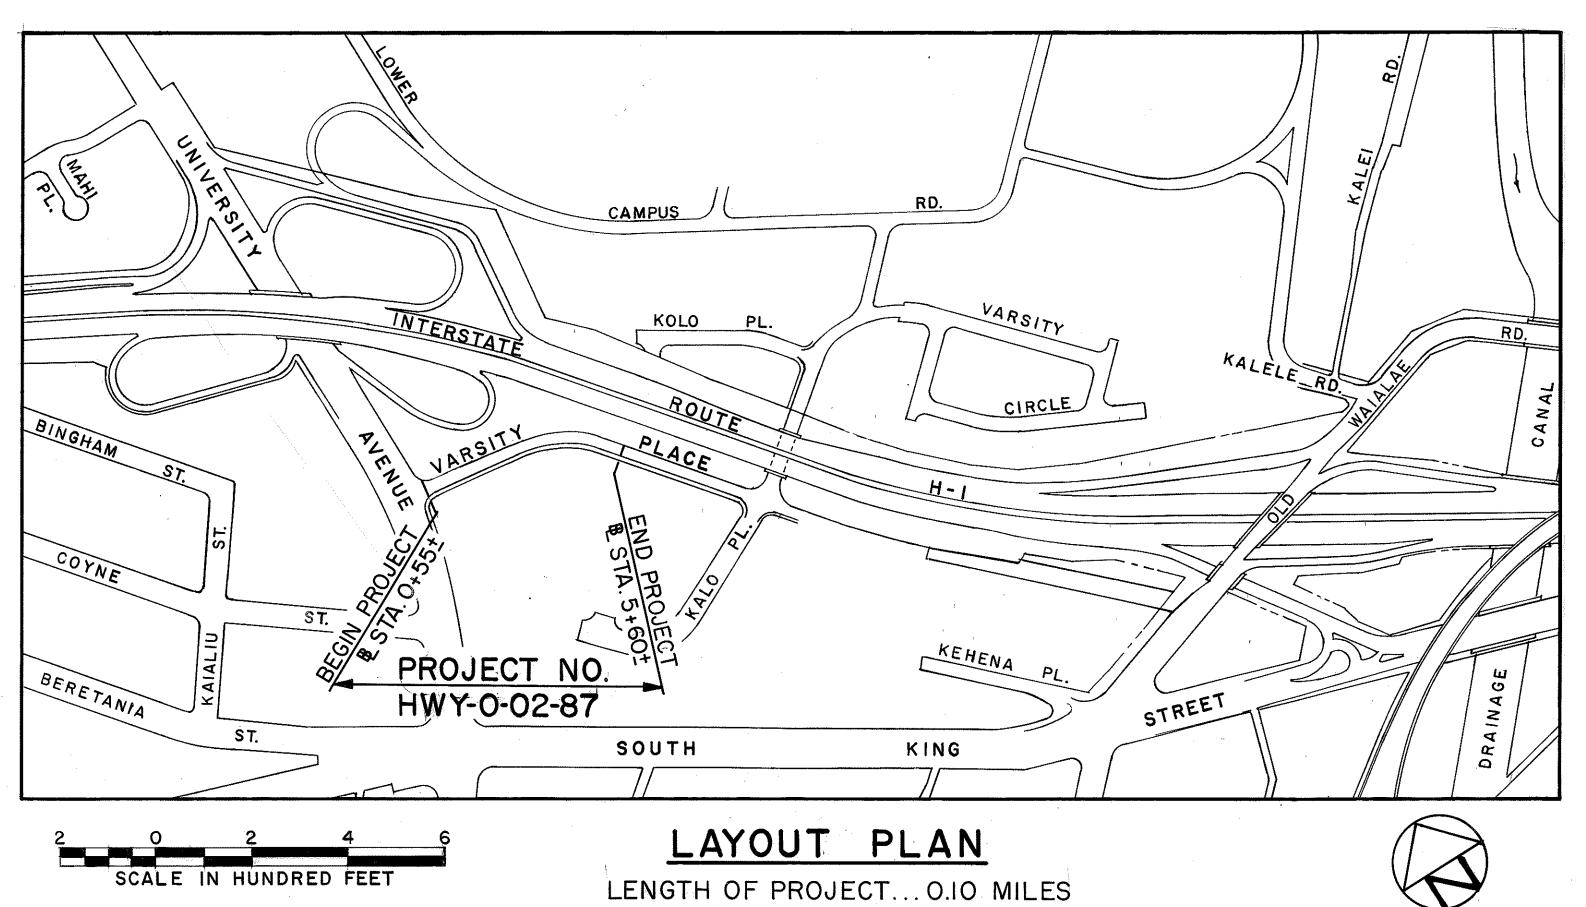

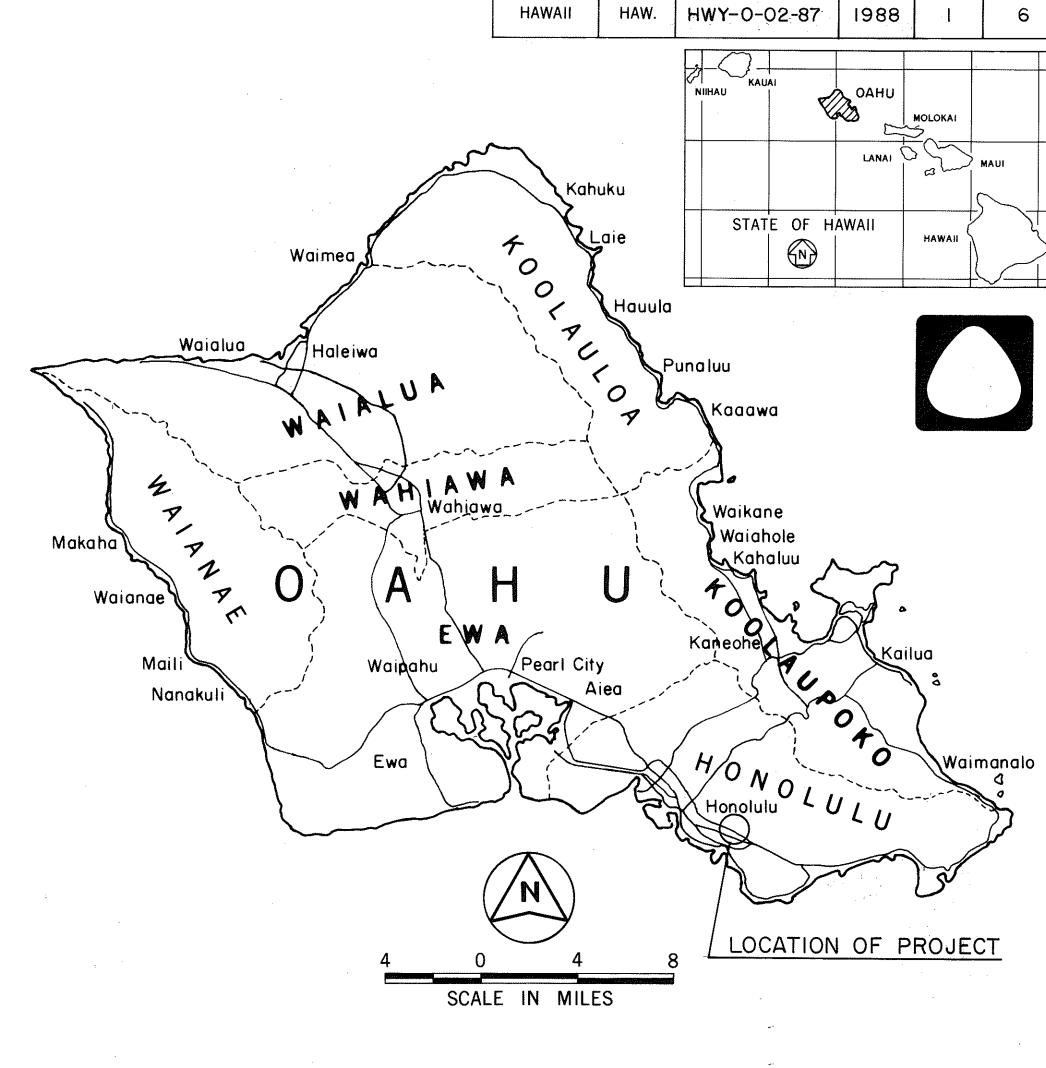

FED. ROAD DIST. NO.

CHANGES MADE DURING CONSTRUCTION HAVE BEEN INCORPORATED ON THESE PLANS EXCEPT CHANGES IN THE ORIGINAL THEORETICAL QUANTITIES, FOR ACTUAL QUANTITIES, REFER TO PROJECT LEDGER AND/OR COMPUTATION BOOK.

Resident Engineer

7/6/88 DATE

FISCAL SHEET TOTAL YEAR NO. SHEETS

PROJ. NO.

DEPARTMENT OF TRANSPORTATION
STATE OF HAWAII

APPROVED:

DD-A-6-8

AUG., 1987 DATE

548-7490 PHONE

NISHIMURA P.S. &