



FED. ROAD DIST. NO.	STATE	PROJ. NO.	FISCAL YEAR	SHEET NO.	TOTAL SHEETS
HAWAII	HAW.	HWY-0-02-87	1988	3	6

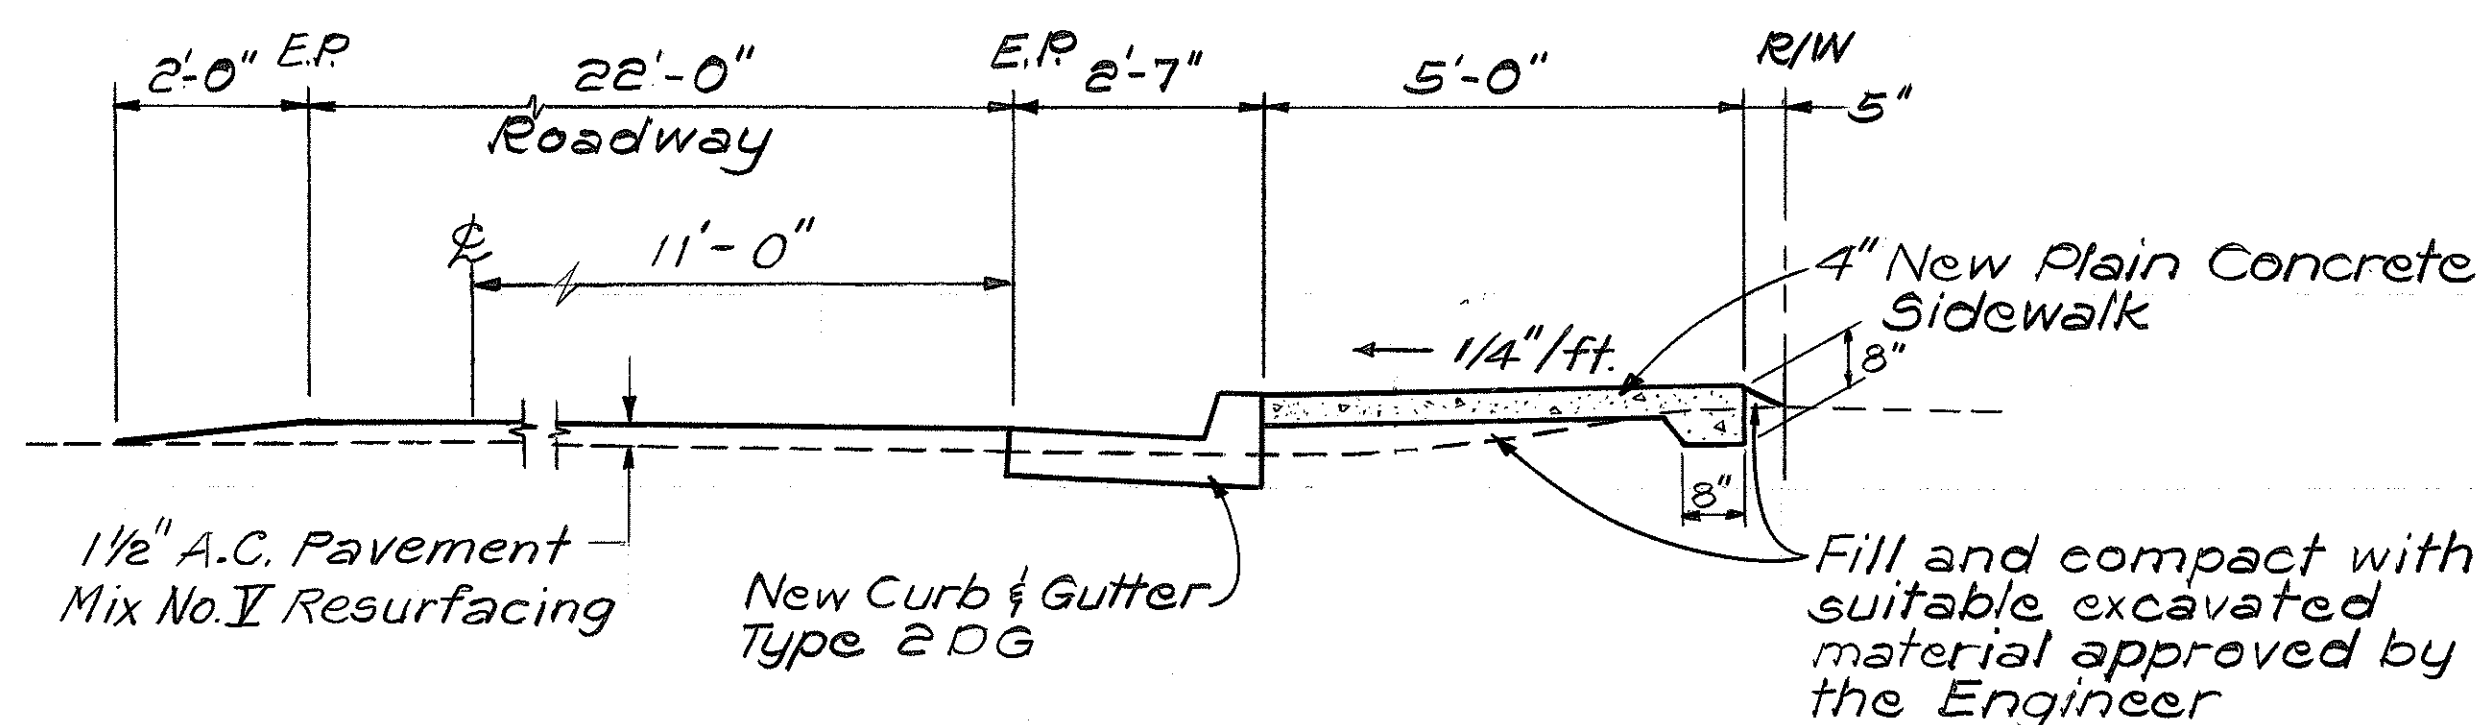


### TYPICAL ROADWAY SECTION

Scale: 1/2" = 1'-0"

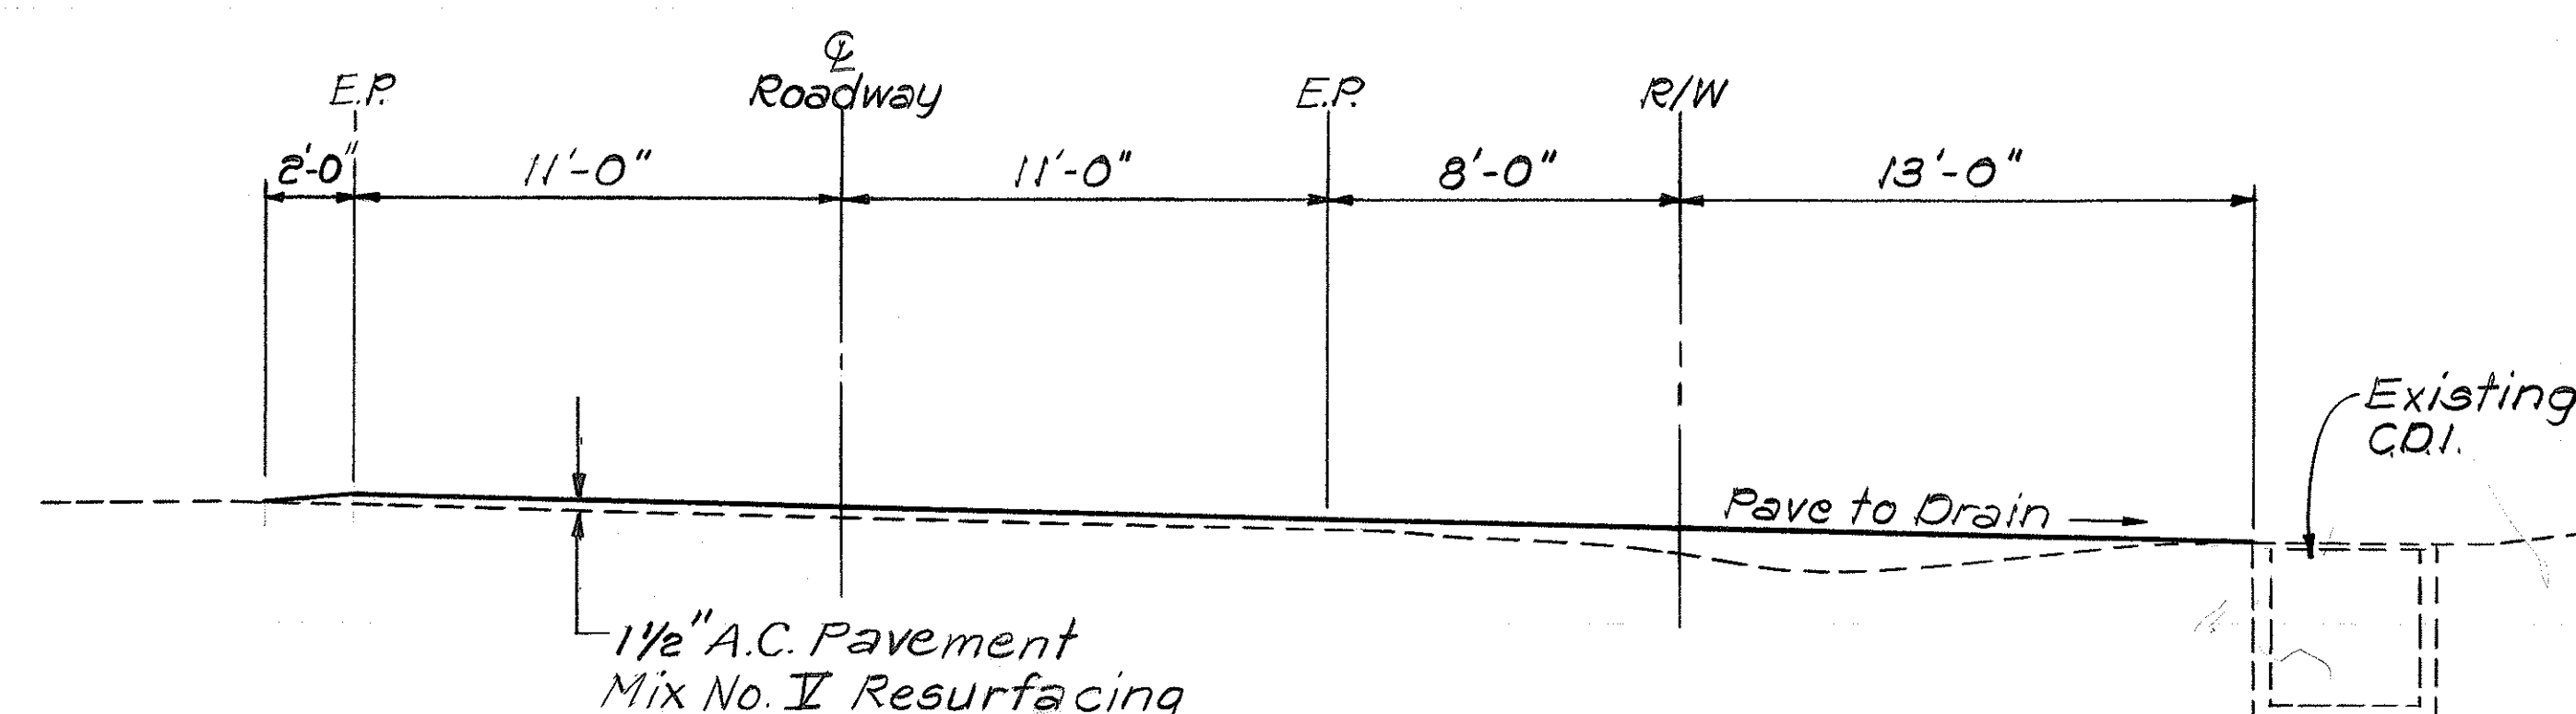

### SECTION DRIVEWAY AT STA. 3+63 ± RT.

Scale: 1/4" = 1'-0"

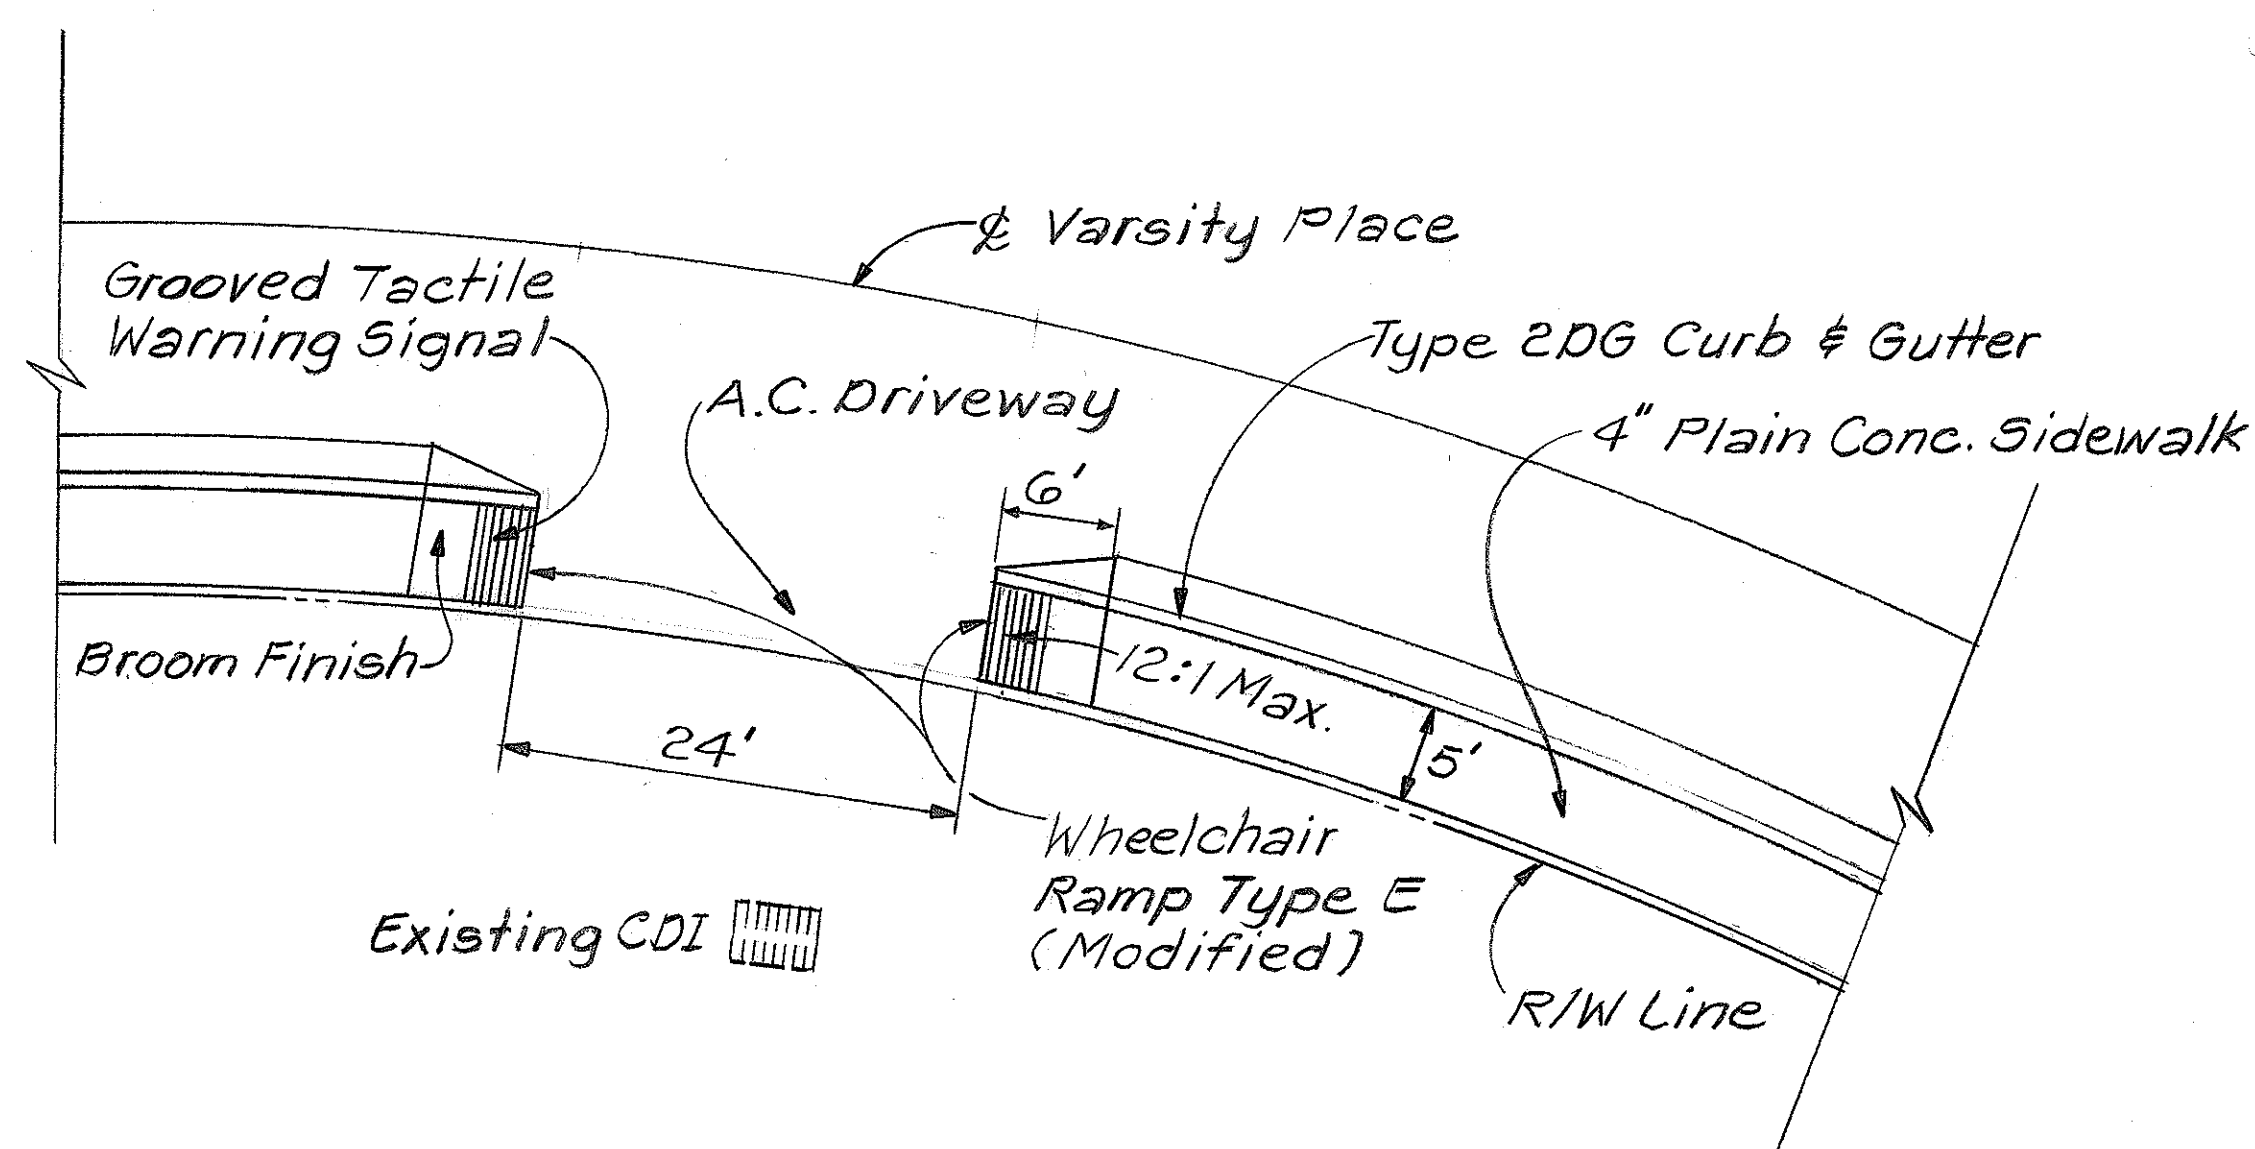

### PLAN DRIVEWAY AT STA. 3+63 ± RT.

Scale: 1" = 10'-0"

### GENERAL NOTES

1. The Scope of Work for this project consists of reconstructing and resurfacing existing pavement areas, adjusting manholes and water meters, installing new concrete sidewalks with wheelchair ramps and concrete drop driveways, and pavement striping and markers.
2. The Contractor's attention is directed to Subsection 107.13- Public Convenience and Safety; Section 645- Traffic Control of the Special Provisions and Subsection 107.21- Contractor's Responsibility for Utility Property and Services.
3. At the end of each day's work, the Contractor shall remove all equipment and other obstructions to permit free and safe passage of public traffic.
4. The existence and location of underground utilities, manholes, monuments and structures as shown on the plans are from the latest available data but the accuracy is not guaranteed. The encountering of other obstacles during the course of the work is possible. The Contractor shall be liable for any damages incurred to the existing facilities and/or improvements as a result of his operations.
5. The exact locations and limits or areas to be reconstructed and/or cold planed shall be determined in the field by the Engineer.
6. The Contractor shall remove and dispose of all existing raised pavement markers prior to the overlaying of Asphalt Concrete. This work shall be considered incidental to Asphalt Concrete Pavement, Mix No. I and will not be paid for separately.
7. All holes, depressions and wheel ruts shall be filled and compacted with Asphalt Concrete Pavement, Mix No. I prior to resurfacing. This work will be paid for under Asphalt Concrete Pavement, Mix No. I.
8. Smooth riding connections shall be constructed at all limits of resurfacing including the beginning and end of project, connecting approaches, side streets and driveways as shown on the plans and/or as directed by the Engineer.
9. The Contractor shall notify Mr. Kevin Cole, phone no. 949-4702 one week prior to paving the driveway at Sta. 3+63 ± Rt.

DATE	_____
SURVEY PLOTTED BY	_____
DESIGNED BY	_____
QUANTITIES BY	_____
CHECKED BY	_____
ORIGINAL PLAN	_____
NOTE BOOK	_____
No.	_____

STATE OF HAWAII DEPARTMENT OF TRANSPORTATION HIGHWAYS DIVISION
<b>TYPICAL SECTIONS AND GENERAL NOTES</b>
<b>Varsity Place Improvements</b> University Ave. Towards Kalo Place PROJECT NO. HWY-0-02-87
Scale: As Noted Date: June, 1987 SHEET No. 1 OF 1 SHEETS