

INDEX TO DRAWINGS	
SHEET NO.	DESCRIPTION
1	TITLE SHEET
2	GENERAL NOTES
3 - 4	WATER POLLUTION & EROSION CONTROL NOTES
5	DRAINAGE PLAN
6	DRAINAGE PLAN & PROFILE
7 - 11	DRAINAGE DETAILS

STATE OF HAWAII

DEPARTMENT OF TRANSPORTATION

HIGHWAYS DIVISION

HONOLULU, HAWAII

"AS-BUILT"

PLANS FOR

INTERSTATE ROUTE H-1


DRAINAGE IMPROVEMENTS

REPAIR OF 126-INCH CULVERT VICINITY OF OLOPANA STREET



PROJECT NO. H1E-02-06

DISTRICT OF EWA

ISLAND OF OAHU

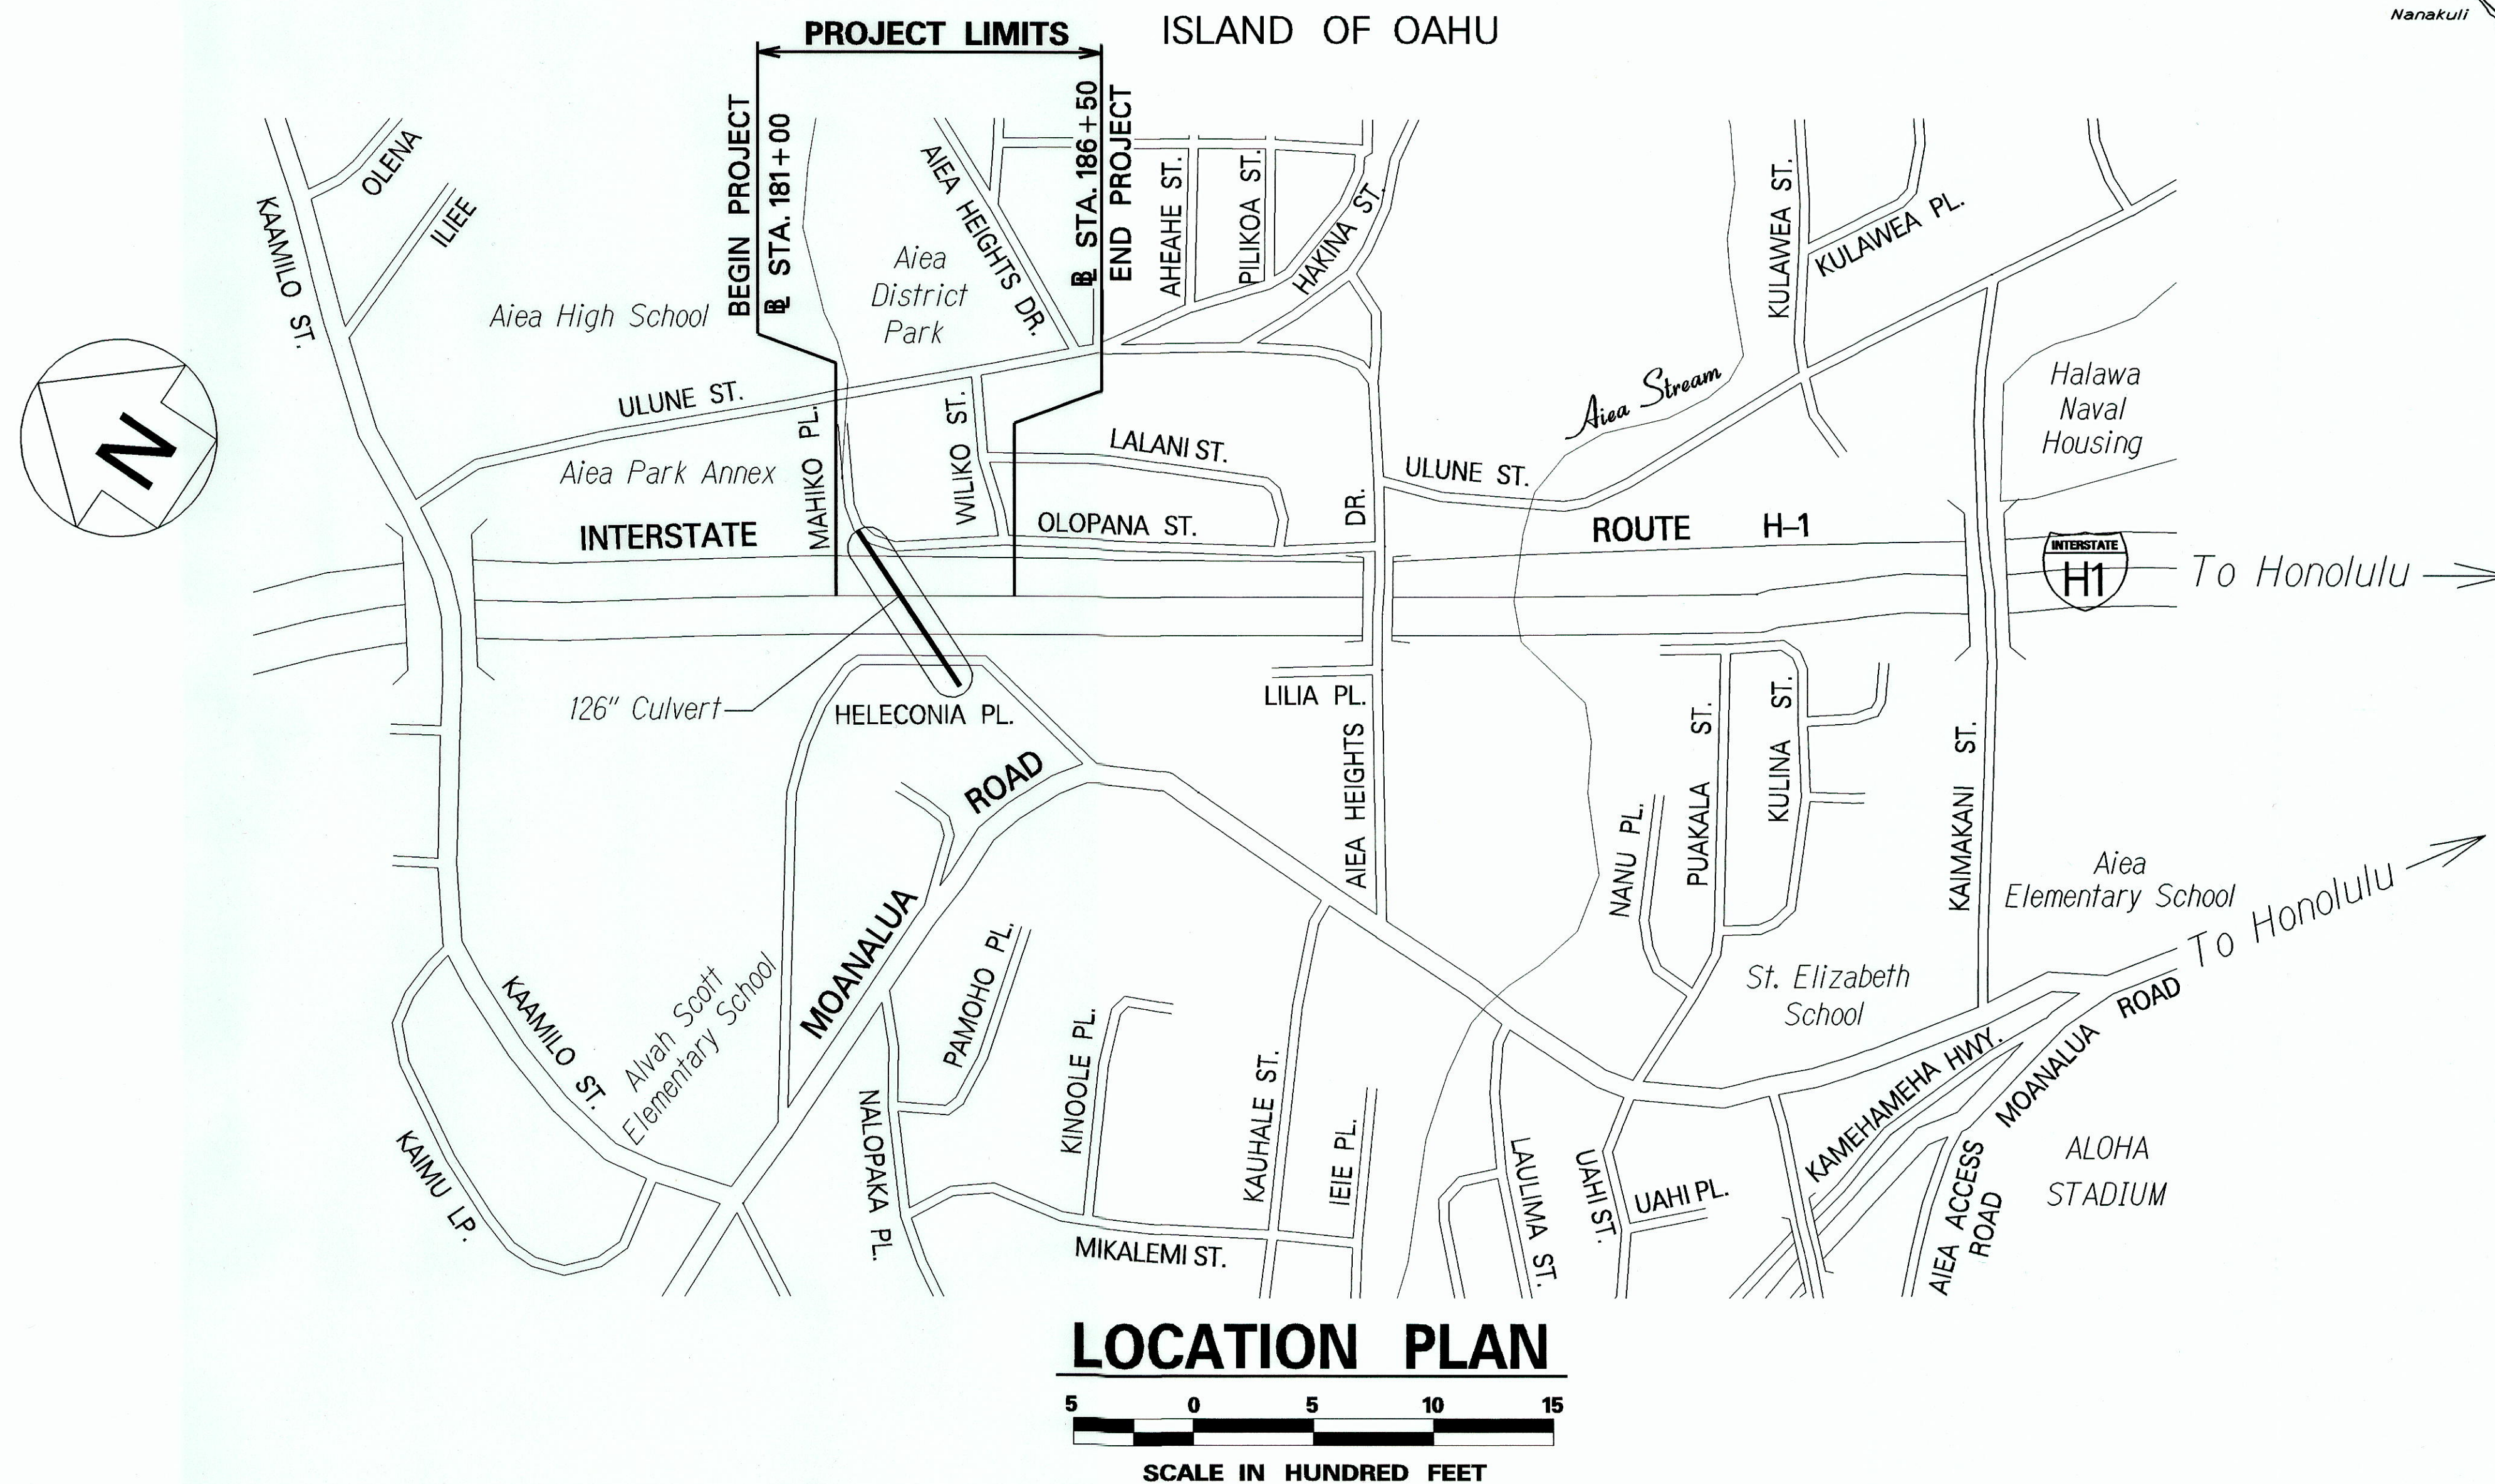

FED. ROAD DIST. NO.	STATE	PROJ. NO.	FISCAL YEAR	SHEET NO.	TOTAL SHEETS
HAWAII	HAW.	H1E-02-06	2008	1	11

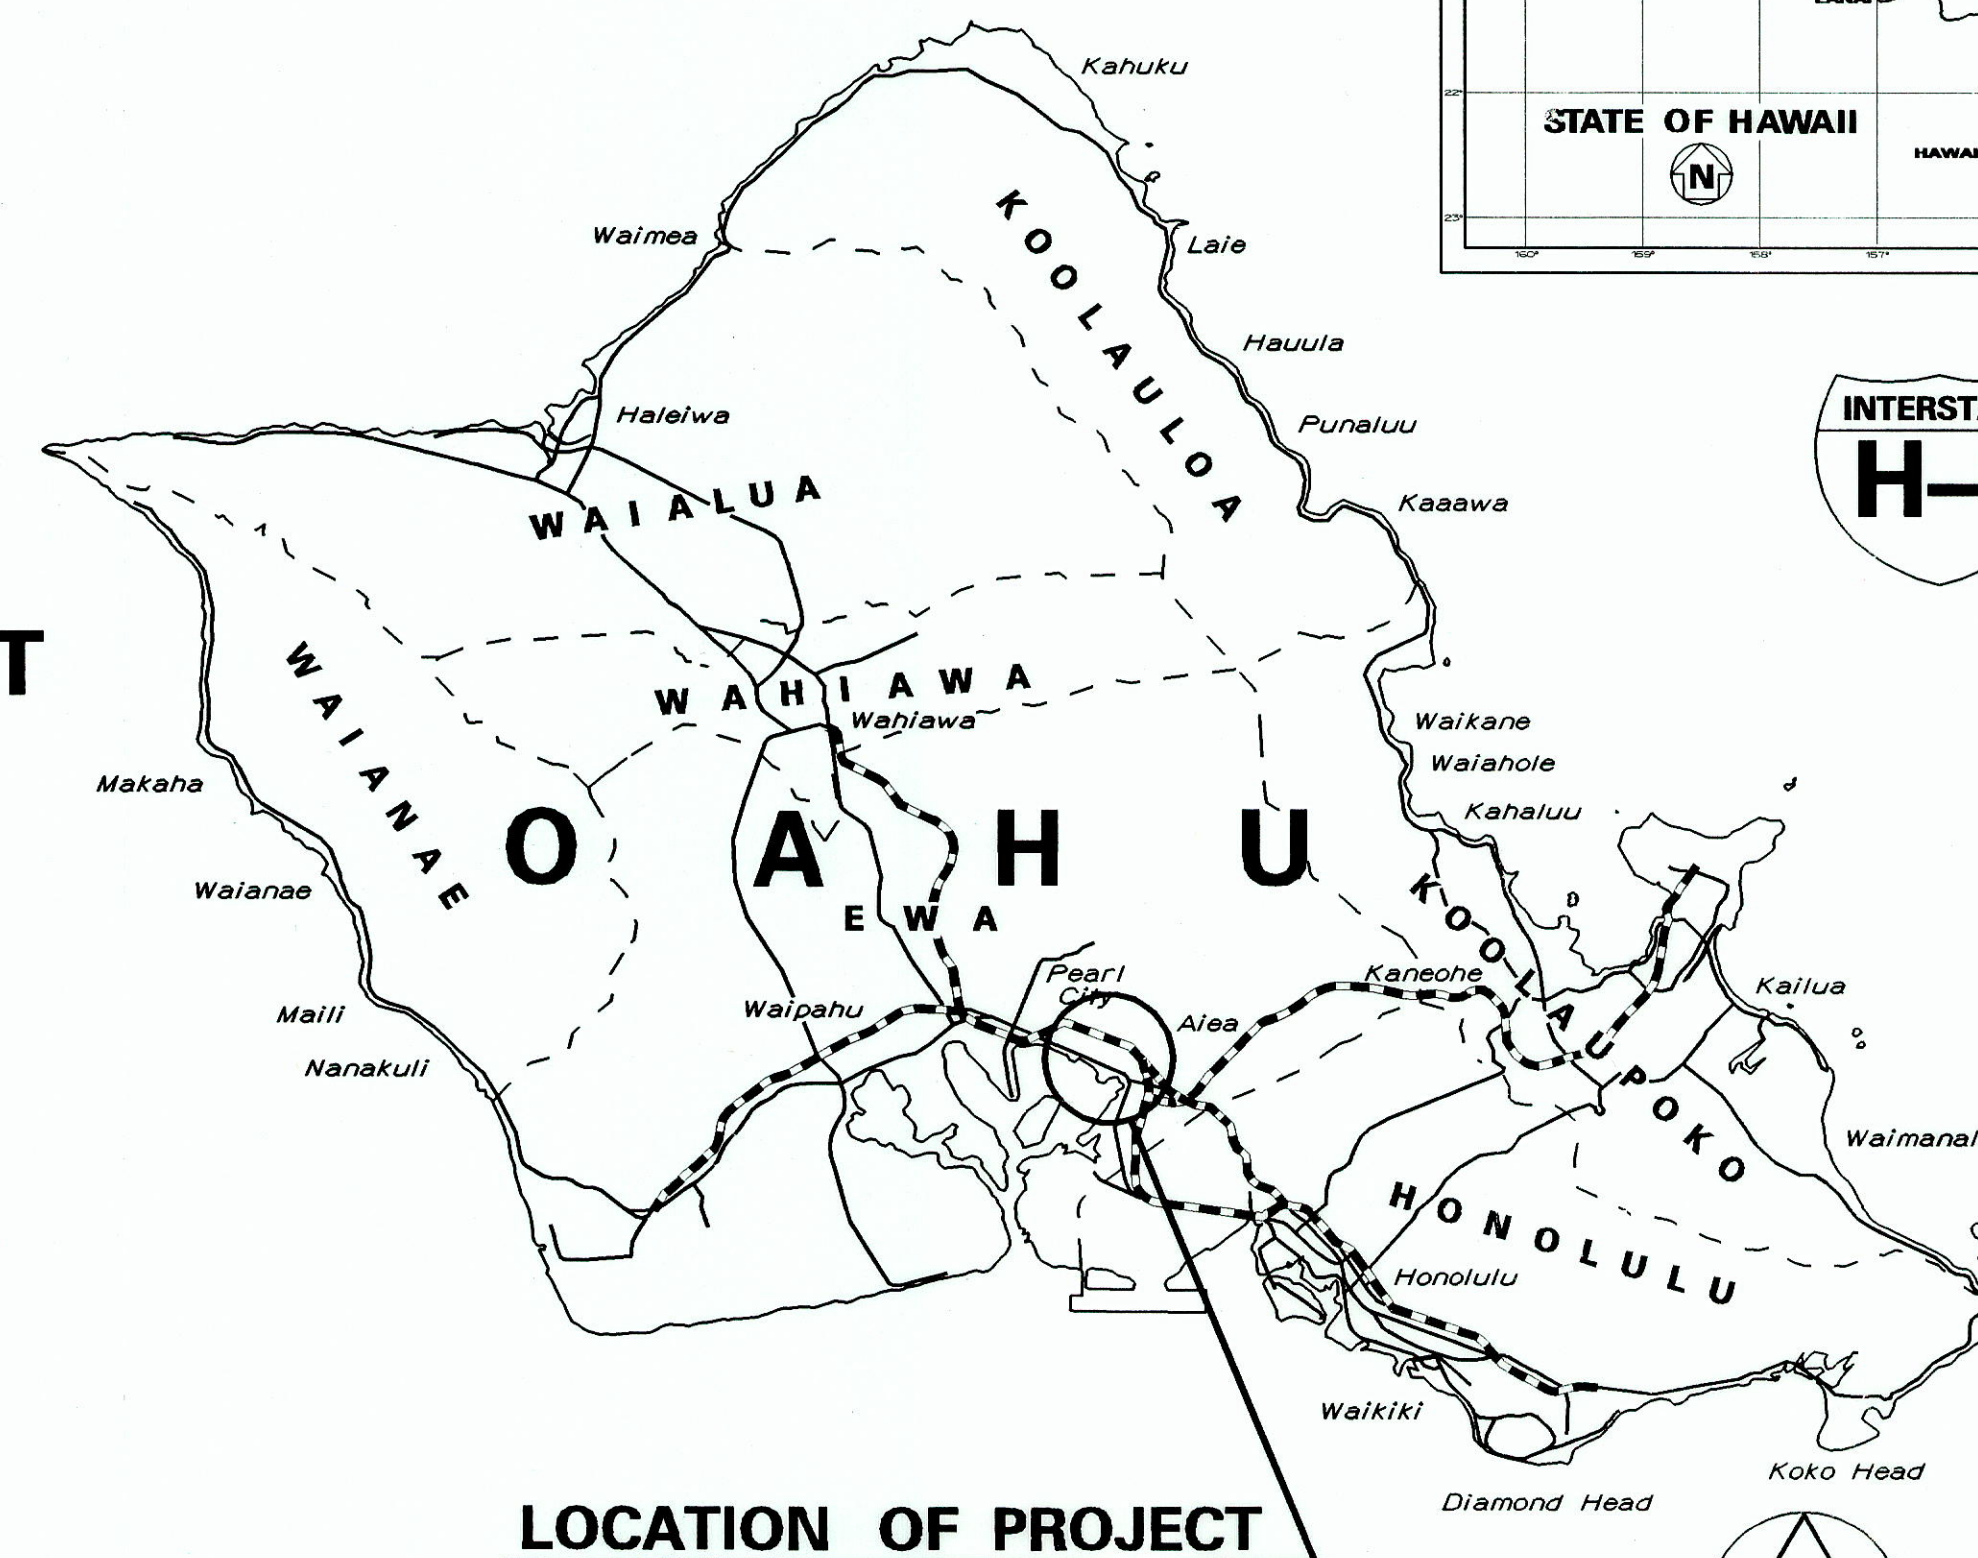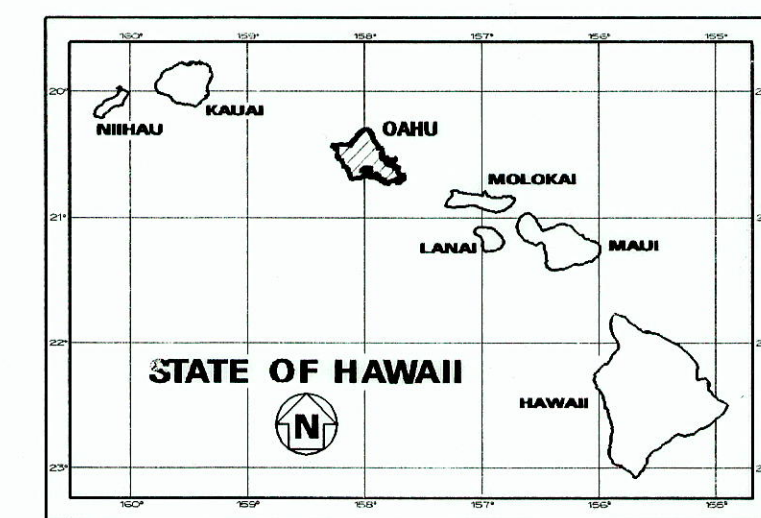

LOCATION OF PROJECT

----- FEDERAL AID INTERSTATE PROJECTS PREVIOUSLY CONSTRUCTED OR UNDER CONSTRUCTION

MILE POST 12.58 TO MILE POST 12.68

CHANGES MADE DURING CONSTRUCTION HAVE BEEN INCORPORATED ON THESE PLANS EXCEPT CHANGES IN THE ORIGINAL THEORETICAL QUANTITIES. FOR ACTUAL QUANTITIES, REFER TO PROJECT LEDGER AND/OR COMPUTATION BOOK.

Kelly Lee Sie 1/3/13
RESIDENT ENGINEER DATE

DEPARTMENT OF TRANSPORTATION
STATE OF HAWAII

APPROVED:
5.21.07
DIR. OF TRANSPORTATION DATE

DESIGNED BY
HWY-DH

P. S. & E. BY
HWY-DH

PHONE
692-7563

DATE
DEC. 2006